

NOTES

SEWER:

1. Remove existing M.H. No. 604 and build a 4' dia. type "E" drop manhole

WATER:

1. Lay approx. 297 L.F. of 6" C.I.P. one foot north (parallel) of existing 4" steel water line as shown.

2. Tie into existing 6" C.I. (sta. 9+89), and 6" gate valve (sta. 12+76) with all fittings as needed to be field verified.
3. Transfer all water service lines at the time of main connections to minimize water service disruption.

LEGEND

- Sanitary sewer manhole (proposed)
- Sanitary sewer manhole (existing)
- Storm drain manhole
- Water meter
- Pipe hydrant
- Gas meter
- Water valve
- Utility pole
- Electric line (overhead)
- Water line
- Gas line

"NOTICE TO CONTRACTORS"


It has been Standard Specifications for Public Works Construction, 1988 Edition, all references to "Standard Specifications" shall be to the Standard Specifications.

All work described on these plans to be performed under contract with the City of Albuquerque, New Mexico, and shall be subject to the terms and conditions of the Standard Specifications for Public Works Construction, 1988 Edition, and the Standard Specifications for Public Works Construction, 1988 Edition.

All work described on these plans to be performed under contract with the City of Albuquerque, New Mexico, and shall be subject to the terms and conditions of the Standard Specifications for Public Works Construction, 1988 Edition, and the Standard Specifications for Public Works Construction, 1988 Edition.


The following notes apply when completed.

- ☐ All work and utility service lines shall be installed under the supervision of the City Engineer.
- ☐ All work and utility service lines shall be installed under the supervision of the City Engineer.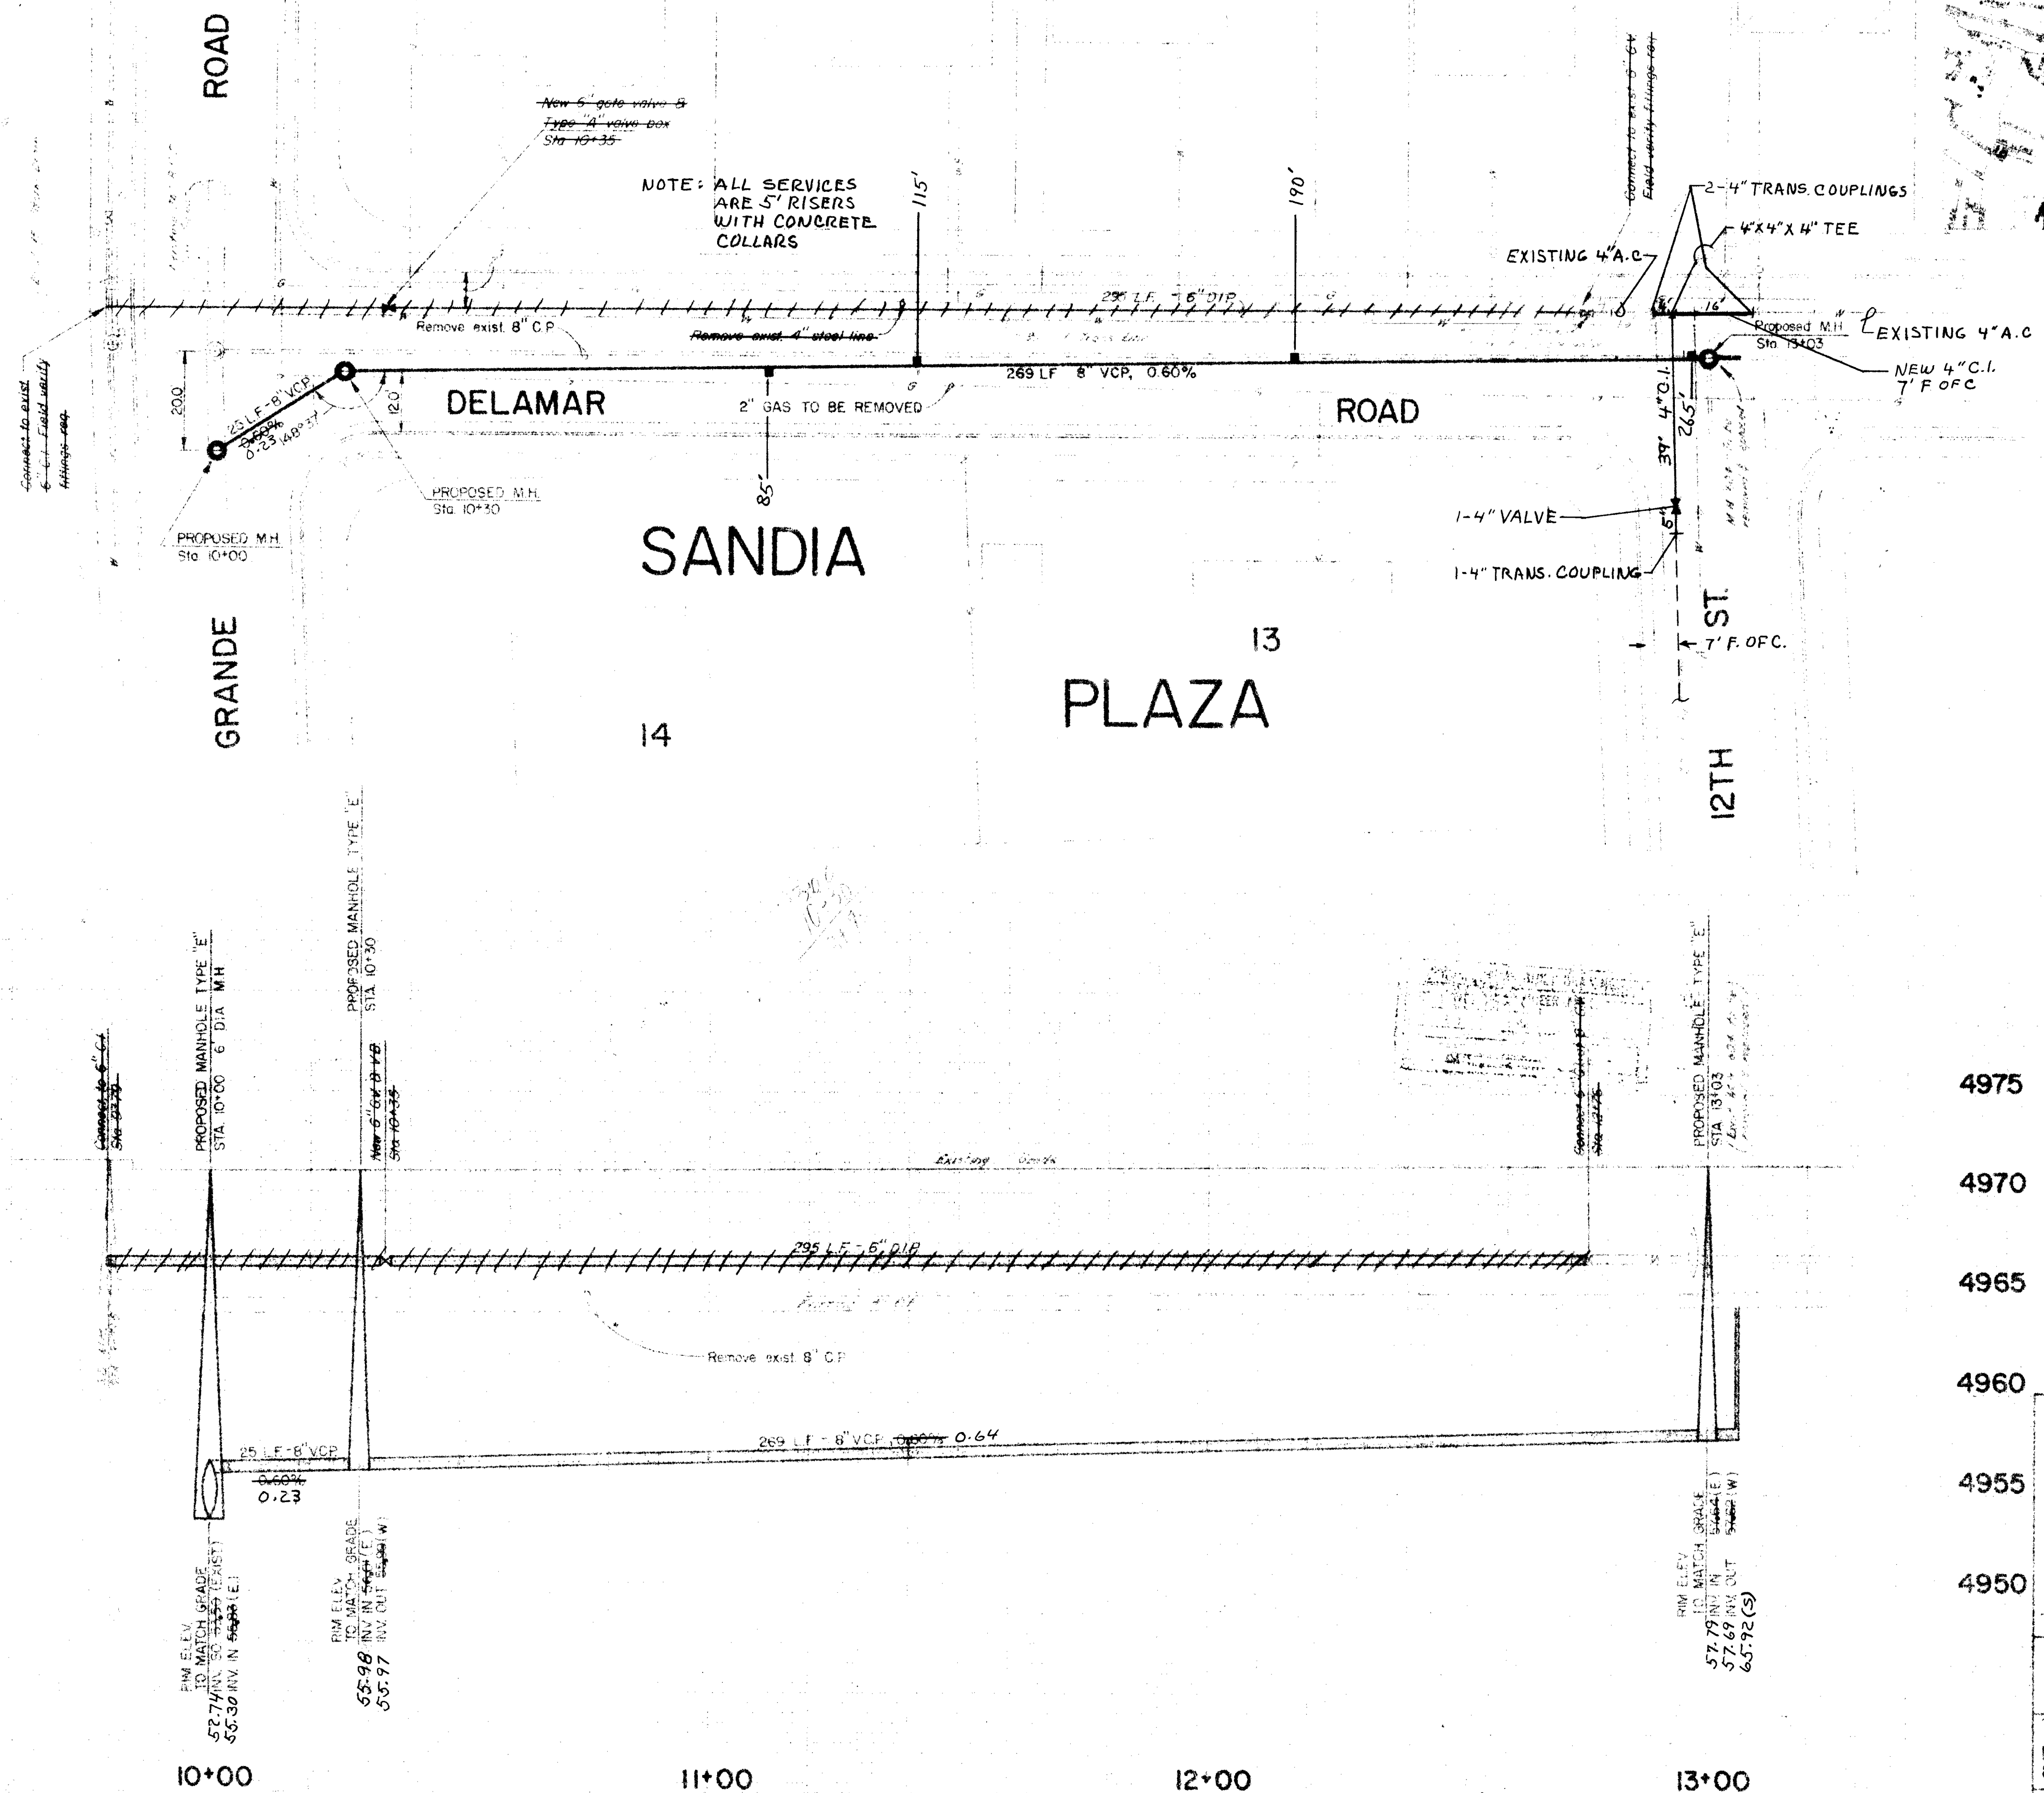
PLAN
SCALE: 1"=20'

PROFILE
SCALE: 1"=20' HORIZ.
1"=5' VERT.

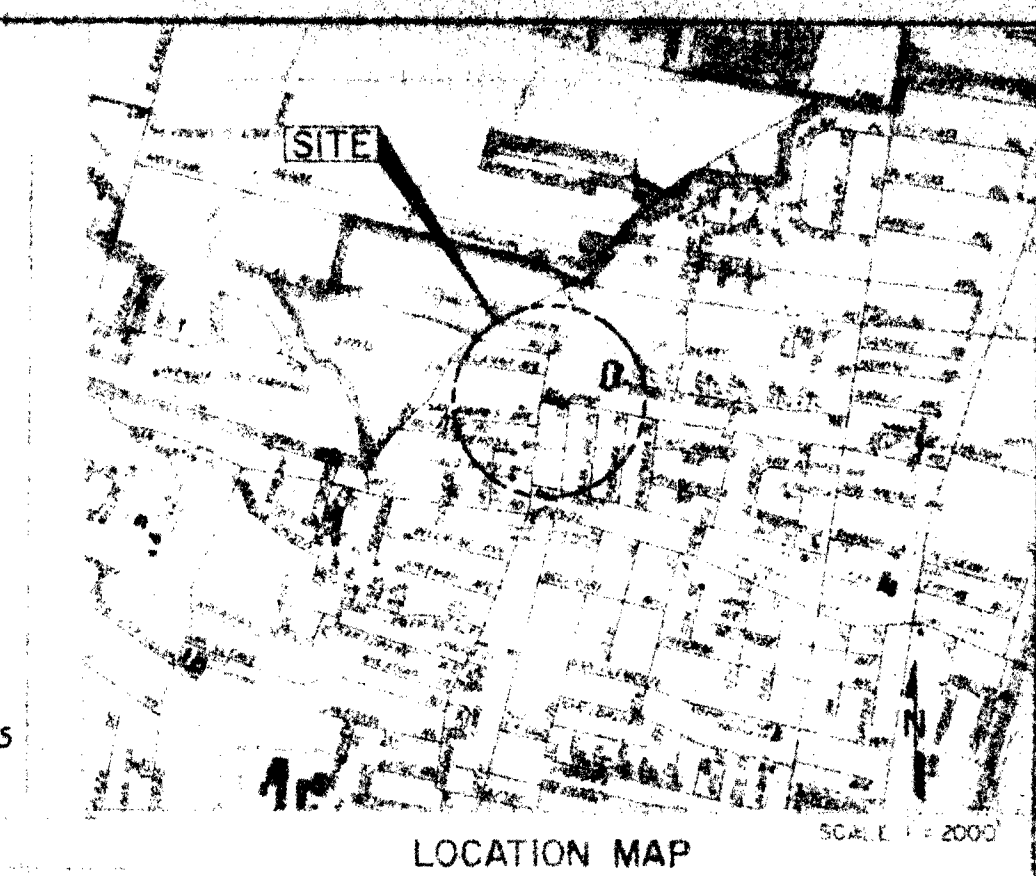

APPROVAL OF AS BUILT DRAWINGS
ASST. CITY ENGINEER - FIELD
DATE: 12/1/14

PROJECT UNDER THE GUIDANCE OF


CITY OF ALBUQUERQUE
WATER RESOURCES DEPARTMENT

TITLE: SAS REPLACEMENT DELAMAR RD. NW. BTW. M.H. 603 & M.H. 604
WATER LINE REPLACEMENT BTW. GRANDE RD. NW. & 12TH ST. NW.

APPROVALS	ENGINEER	DATE	APPROVALS	ENGINEER	DATE
City Engineer			Liquid Waste		9/1/14
ACE - Design			Traffic		
ACE - Hydrology			Water		9/1/14

DRAWING (WRD-81-14)
NO. 1247
SHEET 1 OF 2

APPROVED FOR
CONSTRUCTION
CHIEF ENGINEER, WRD DATE

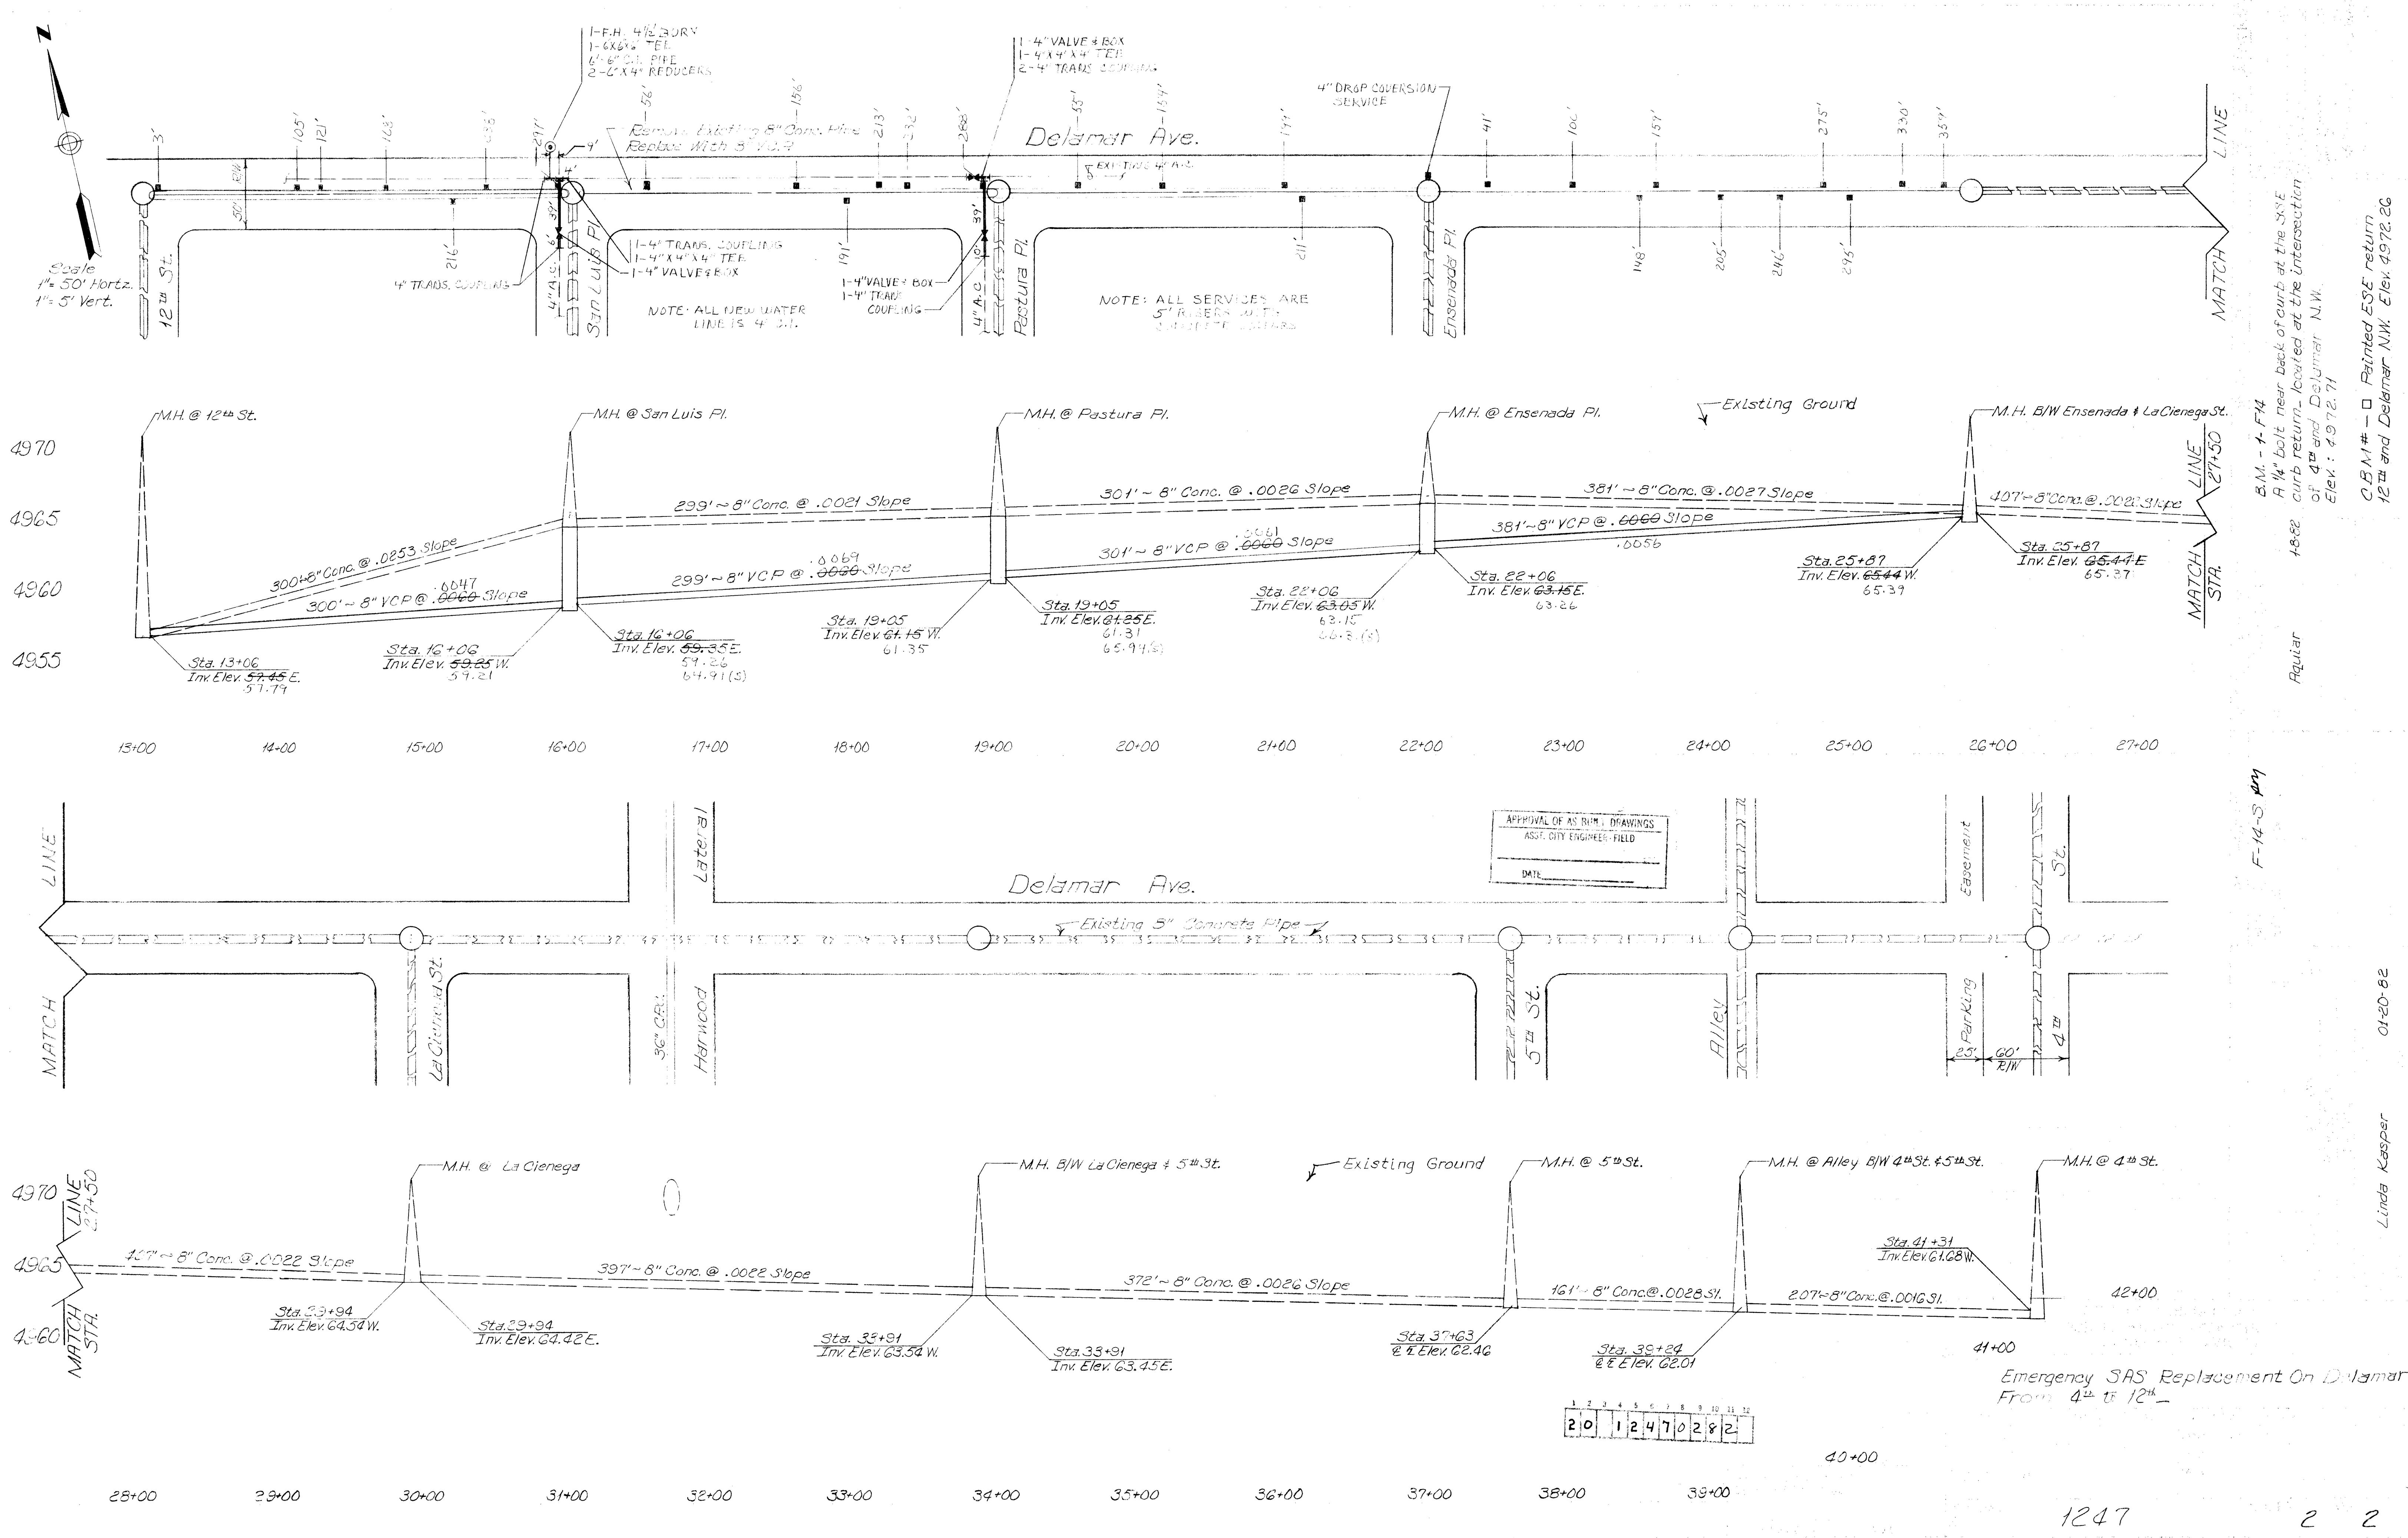

B.M. - 1 - F14
 1/4" bolt near back of curb at the S.E.
 curb return located at the intersection
 of 4th and Delamar N.W.
 Elev.: 4972.71

C.B.M. # - 1 - Painted ESE return
 12th and Delamar N.W. Elev. 4972.26

F-14-S 4/21

Linda Kasper 01-20-82