

MEDIAN OPENINGS & DRIVEWAYS

JUAN TABO AND CANDELARIA

"NOTICE TO CONTRACTORS"

- 1) New Mexico Standard Specifications for Public Works Construction - 1979 Edition will be referred to hereon as the "Standard Specification."
- 2) All work detailed on these plans to be performed under contract shall, except as otherwise stated or provided for hereon, be constructed in accordance with "Contract Documents for City-Wide Utilities and Cash Paving No. 30" and the Standard Specification."
- 3) Two working days prior to any excavation, contractor must contact Line Locating Service, 765-1234, for location of existing utilities.
- 4) Prior to construction, the contractor shall excavate and verify the horizontal and vertical locations of all obstructions. Should a conflict exist, the contractor shall notify the engineer or surveyor so that the conflict can be resolved with minimum amount of delay.

THE FOLLOWING NOTES APPLY WHEN CHECKED

- All utilities and utility service lines shall be installed prior to paving.
- Backfill compaction shall be according to specified street use. (ARTERIAL)
- Tack coat requirements shall be determined by the City Engineer.
- Sidewalks and wheelchair ramps within the curb return shall be constructed wherever a new curb return is constructed.
- If curb is depressed for a driveway, the driveway shall be constructed prior to acceptance of the curb and gutter.
- All storm drainage facilities shall be completed prior to final acceptance.

INDEX TO DRAWINGS


<u>SHEET NO.</u>	<u>DESCRIPTION</u>
1.	TITLE SHEET
2.	CANDELARIA
3.	JUAN TABO

APPROVAL OF AS BUILT DRAWINGS
 ASST. CITY ENGINEER - FIELD
[Signature]
 DATE 1/12/18


1 2 3 4 5 6 7 8 9 10 11 12
 2 0 1 2 6 0 0 1 8 2

1 2 3 4 5 6 7 8 9 10 11 12
 2 6 1 2 6 0 0 1 8 2

APPROVED FOR CONSTRUCTION <i>[Signature]</i> CITY ENGINEER	DATE	DRAWING NO. 1260	SHEET 1 OF 3
--	------	---------------------	--------------

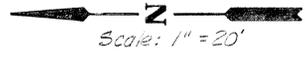

SAFEWAY NO. 965

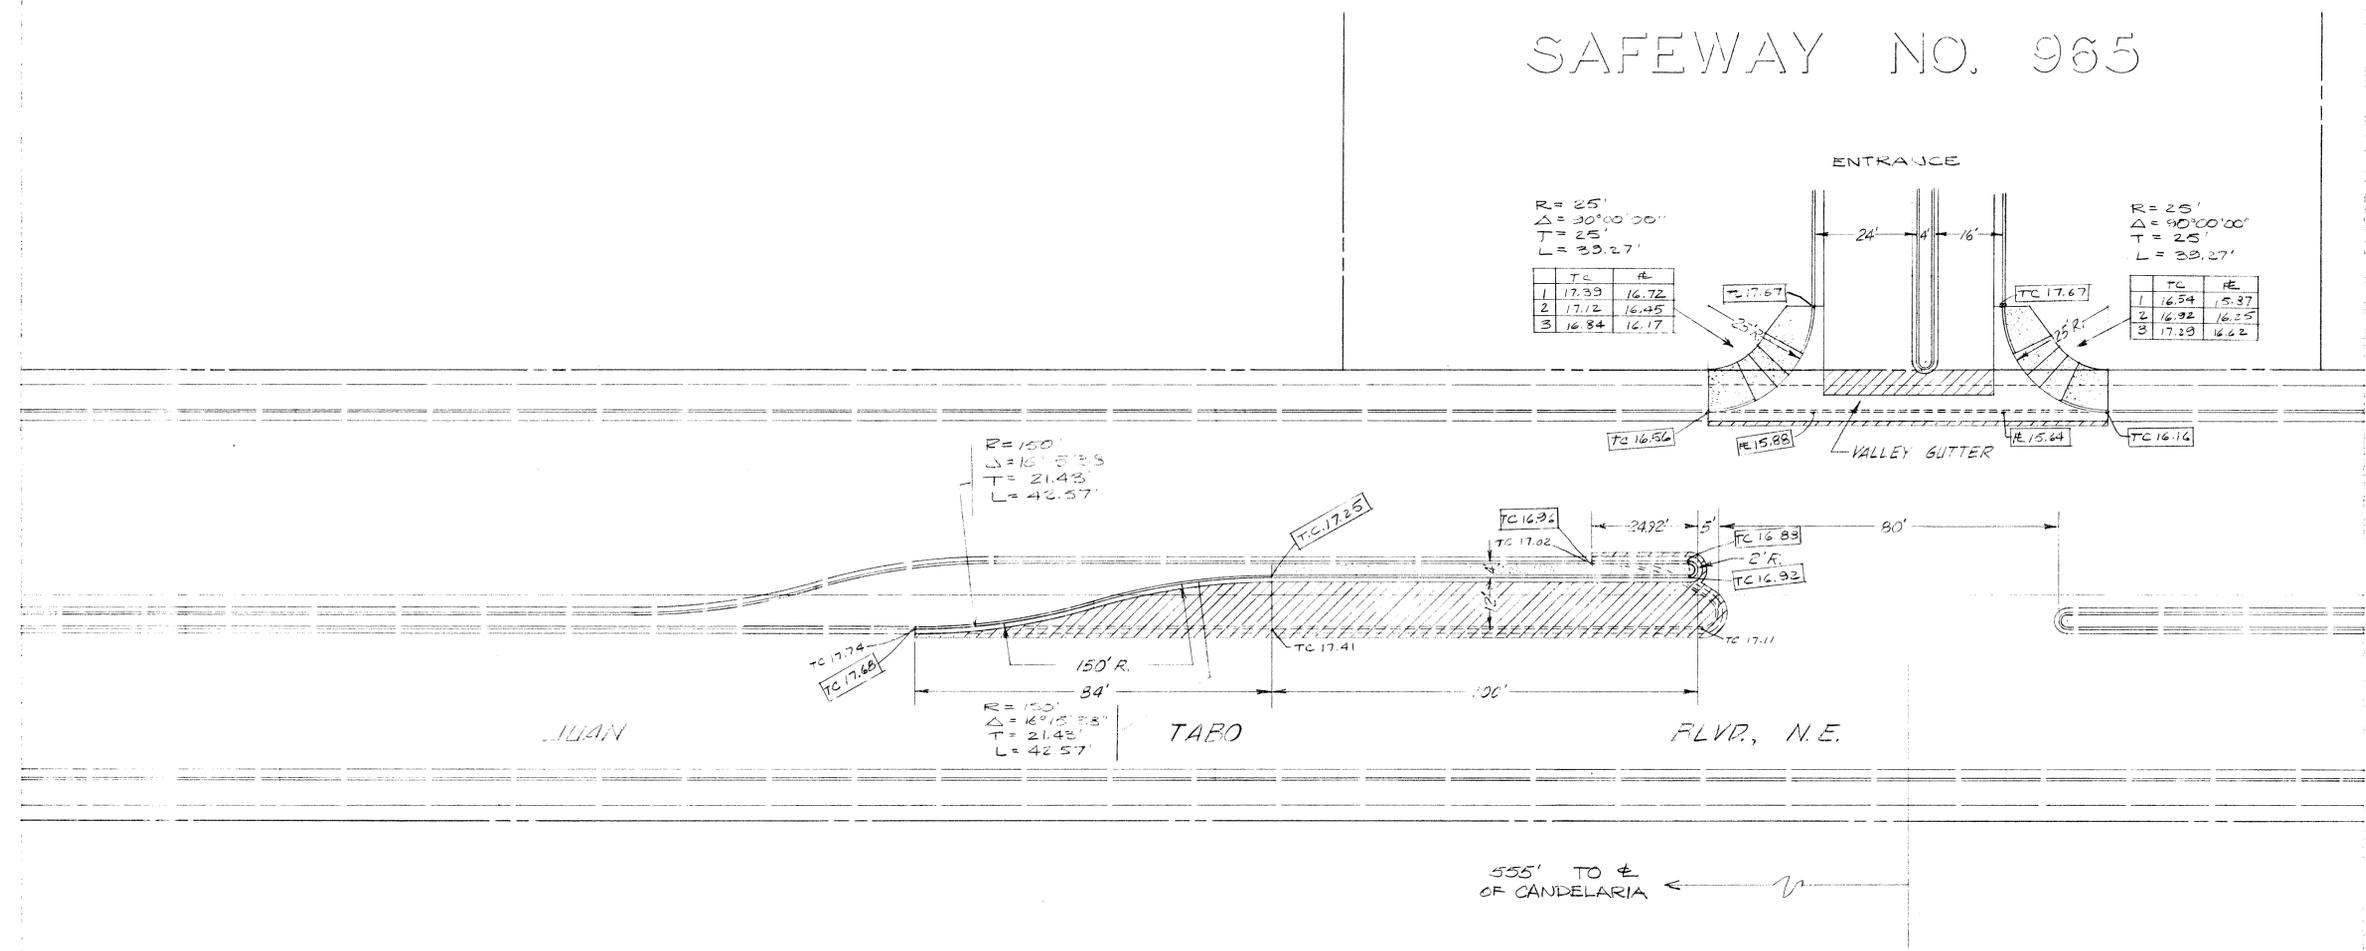

JT-2-A ELEV. 5/17/96

TRAFFIC HANDLING NOTES

1. CONTRACTOR MUST SUBMIT A CONSTRUCTION SIGNING AND BARRICADING PLAN TO TRAFFIC ENGINEERING DIVISION AND RECEIVE A BARRICADING PERMIT PRIOR TO CONSTRUCTION.
2. ALL CONSTRUCTION SIGNING AND BARRICADING TO COMPLY WITH MANUAL ON UNIFORM TRAFFIC CONTROL DEVICES, 1978 EDITION.
3. CONTRACTOR'S OPERATION, BARRICADING AND SIGNING SHALL NOT AFFECT THRU LANES OF JULIAN TABO OR CANDELARIA BETWEEN 7 AM AND 9 AM OR 4 PM AND 6 PM.

LEGEND

- CONCRETE DRIVE PAD
- AREA TO BE REMOVED & PAVED
- 4" THICK CONCRETE, SIDEWALK STANDARD
- NEW EXTENDED ASPHALT MEDIAN CURB
- NEW CONCRETE MEDIAN CURB & GUTTER
- NEW STANDARD CONCRETE CURB & GUTTER
- PROPOSED TOP OF CURB ELEVATION
- EXISTING ELEVATION

20 12600382

MR81-7
 MEDIAN REVISIONS AND DRIVEWAYS ON
 CANDELARIA AND JULIAN TABO FOR
 SAFEWAY STORE NO. 965

Handwritten signatures and dates

1 2 3 4 5 6 7 8 9 10 11 12
 26 12600382

1260 H-22 3 3

9-4-81