


INDEX

DESCRIPTION	SHEET NO.
TITLE SHEET	1
GRADING PLAN	2
PAVING LAYOUT	3
WATER LAYOUT	4
SEWER LAYOUT	5
PLAN & PROFILE-PAVING & WATER	6-7


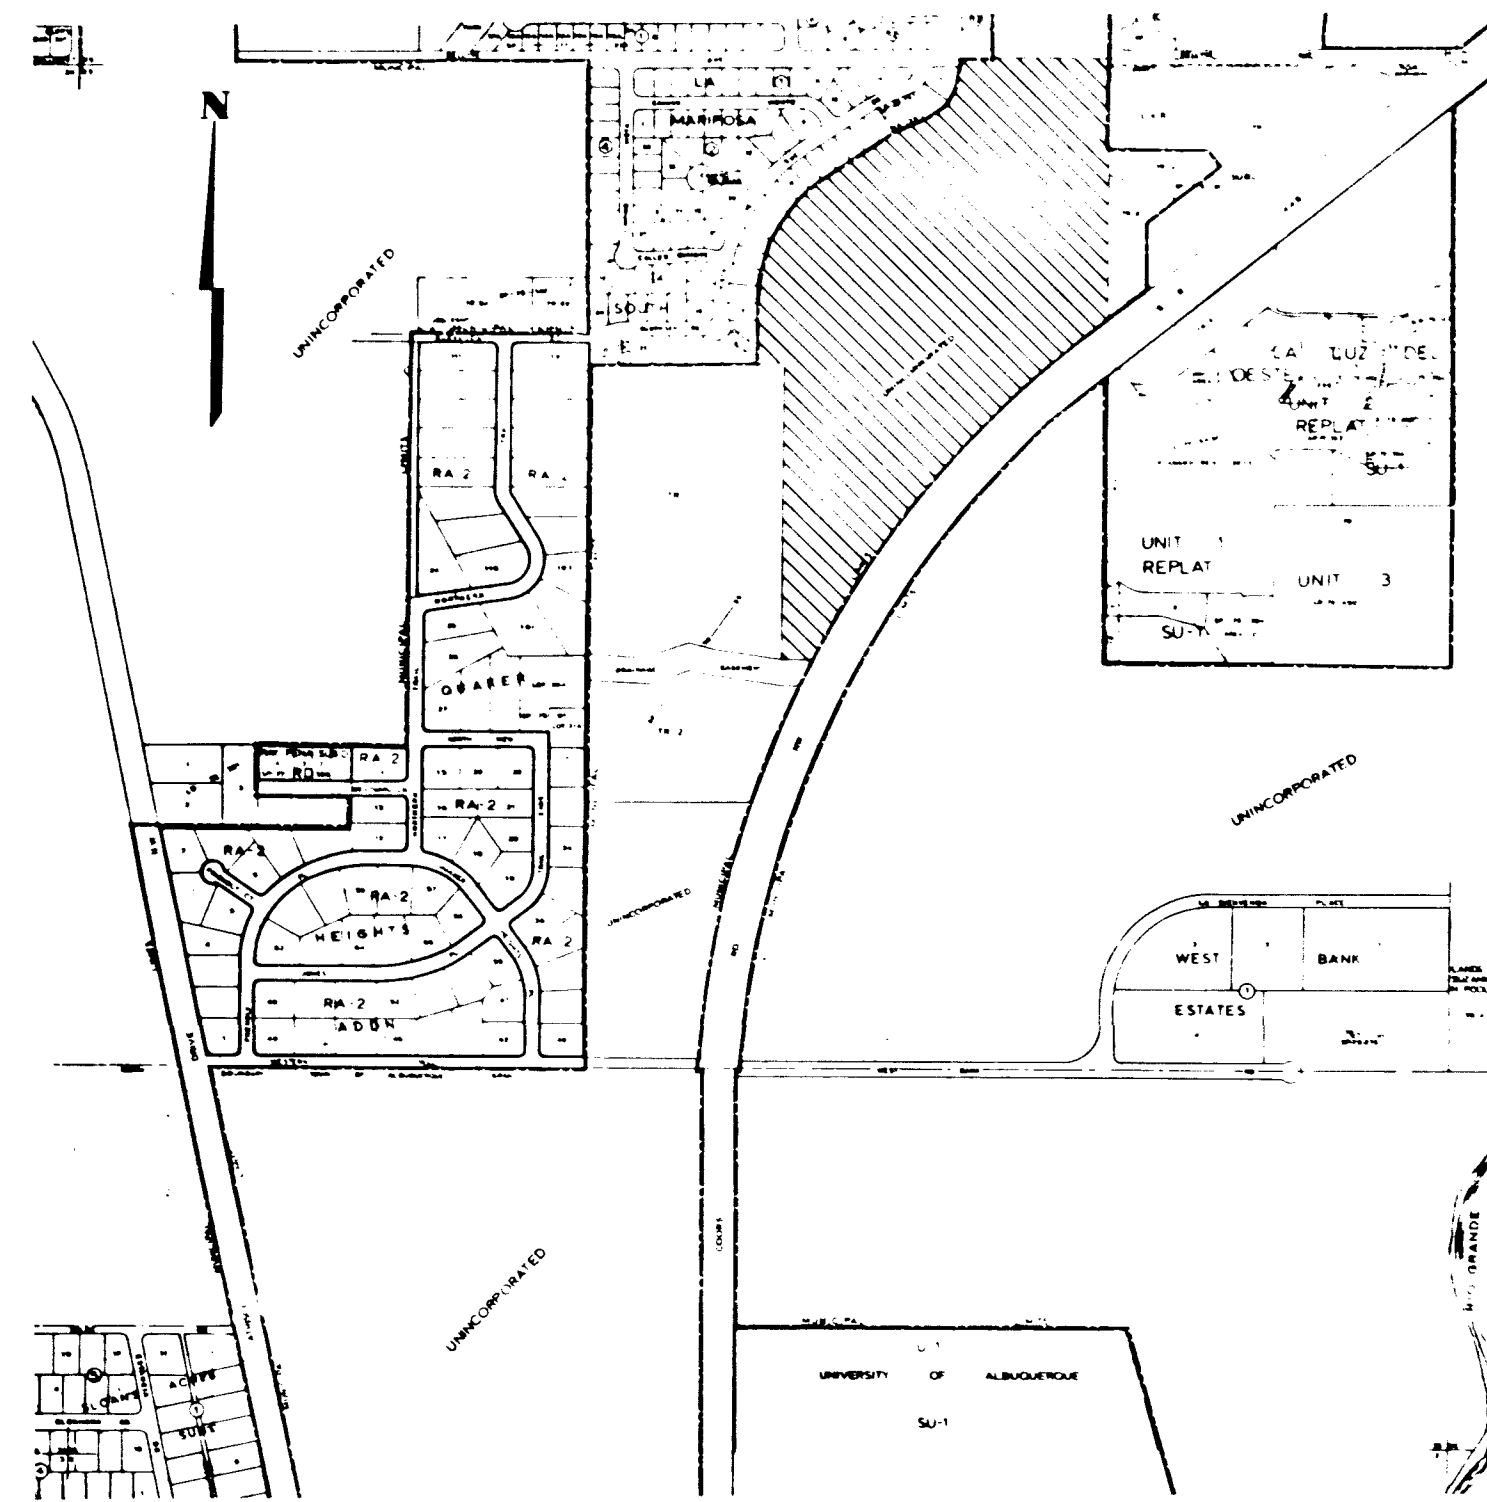


VICINITY MAP No. F-11



NOTE

THIS PROJECT IS PHASE IV
OF A PLAN SET ORIGINALLY
APPROVED UNDER NUMBER
W-28-138.

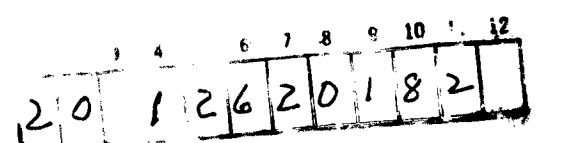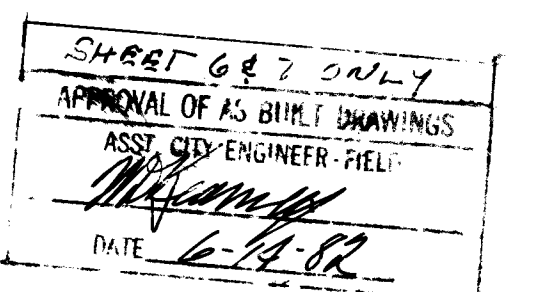

PHASE No.	ENGINEER	DATE
IV		

LA LUZ DEL OESTE

UNIT - 4 PHASE IV

R.S. Hall
CITY ENGINEER - CITY OF ALBUQUERQUE, NEW MEXICO
Approved for drainage, grading &
PUBLIC WATER SYSTEM ONLY

7/11/79
DATE

J.J. Bordenave
J.J. BORDENAVE, N.M.P.E. & L.S. NO. 5110

7/6/79
DATE

T.T. Burnett Engineering, Inc.
120 Morningside N.E.
Albuquerque, New Mexico

DRAWING NO. 1262




CITY OF ALBUQUERQUE PUBLIC WORKS DEPARTMENT ENGINEERING DIVISION					
TITLE					
APPROVALS	ENGINEER	DATE	APPROVALS	ENGINEER	DATE
City Engineer	BSM	7/1/78	Liquid Waste		
A.C.E. Design			Traffic		
A.C.E. Hydrology			Water		
DRAWING NO. 1262			SHEET OF		

APPROVED FOR CONSTRUCTION	CITY ENGINEER	DATE
------------------------------	---------------	------



Scale 1" = 50'

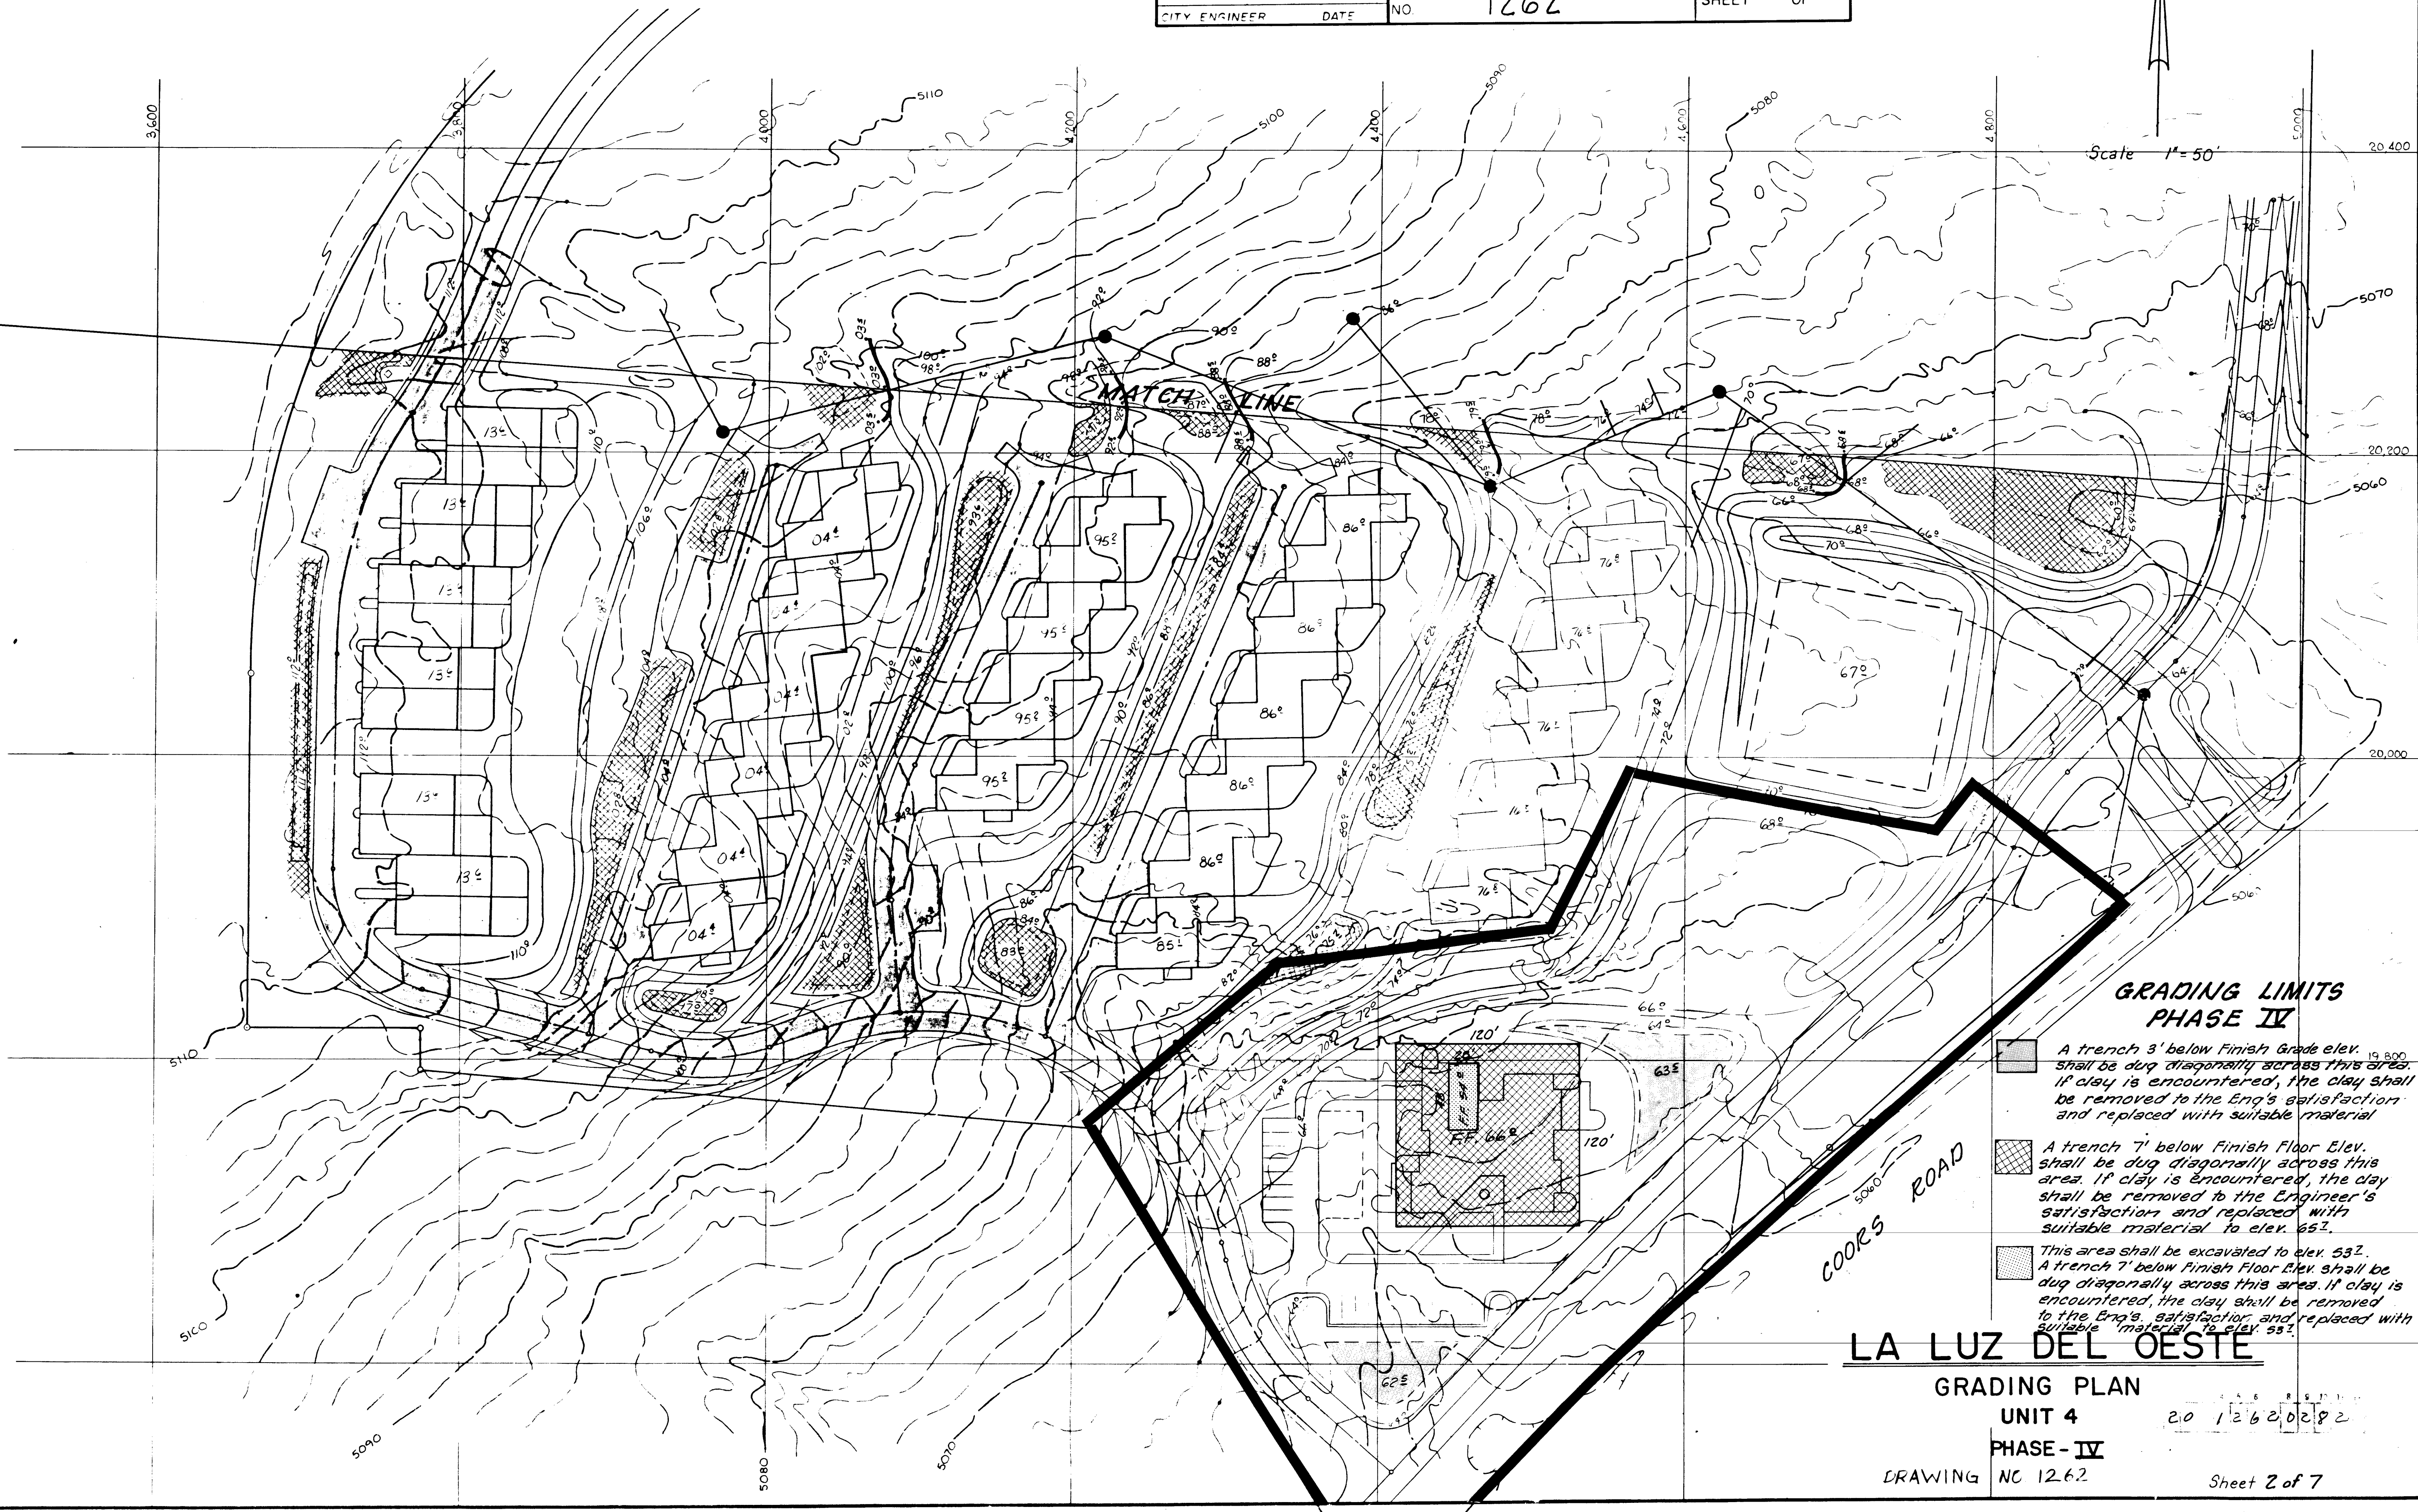

**GRADING LIMITS
PHASE IV**

- A trench 3' below Finish Grade elev. 19,800 shall be dug diagonally across this area. If clay is encountered, the clay shall be removed to the Eng's satisfaction and replaced with suitable material.
- A trench 7' below Finish Floor Elev. shall be dug diagonally across this area. If clay is encountered, the clay shall be removed to the Engineer's satisfaction and replaced with suitable material to elev. 652.
- This area shall be excavated to elev. 532. A trench 7' below Finish Floor Elev. shall be dug diagonally across this area. If clay is encountered, the clay shall be removed to the Eng's satisfaction and replaced with suitable material to elev. 552.

LA LUZ DEL OESTE

**GRADING PLAN
UNIT 4
PHASE - IV**

DRAWING NC 1262




Sheet 2 of 7

REVISIONS

Revised grade on Mill Road, 2 22 80
See sheet 9 of 12
Revised grades on Roads A, B & E, 2 22 80
See sheet 11 of 12
Revised alignment and grade on Wind Road from
Curve No G South 9/81

CURVE DATA

CURVE NO.	RADIUS	ARC	CHORD	DELTA	TANGENT
C 1	210.00'	69.64'	69.32'	19°00'00"	35.14'
C 2	230.02'	67.62'	67.47'	14°21'07"	28.96'
C 3	230.02'	77.69'	77.32'	19°21'07"	39.22'
C 4	125.00'	100.36'	97.68'	46°00'00"	53.06'
C 5	100.00'	169.30'	149.79'	97°00'00"	113.03'
C 6	110.00'	132.66'	124.77'	69°05'55"	75.74'
C 7	110.00'	33.29'	33.17'	17°20'29"	16.77'
C 8	180.00'	106.81'	105.25'	34°00'00"	55.03'
C 9	200.00'	331.61'	294.91'	95°00'00"	218.26'
C10	130.00'	77.14'	76.02'	34°00'00"	39.75'
C11	80.00'	106.12'	98.51'	76°00'00"	62.50'
C12	300.00'	167.55'	165.38'	32°00'00"	86.02'
C13	475.00'	99.48'	99.30'	12°00'00"	49.92'
C14	400.00'	265.29'	260.45'	38°00'00"	137.73'
C15	490.00'	119.73'	119.43'	14°00'00"	60.16'
C16	119.74'	83.59'	81.91'	40°00'00"	43.58'
C17	327.96'	327.82'	314.35'	57°16'19"	179.08'
C18	56.00'	38.12'	37.39'	39°00'00"	19.83'
C19	150.00'	130.90'	126.79'	58°00'00"	69.95'
C20	80.00'	40.49'	40.06'	29°00'00"	20.69'
C21	65.00'	31.77'	31.45'	28°00'00"	16.21'
C22	190.00'	72.95'	72.51'	22°00'00"	36.93'
C23	65.00'	56.72'	54.94'	50°00'00"	30.31'
C24	180.00'	91.11'	90.14'	29°00'00"	46.55'
C 3	229.96'	76.45'	76.10'	19°02'56"	38.58'
C 4	145.00'	108.31'	105.81'	42°47'47"	56.82'
C 5	110.00'	190.06'	167.29'	98°59'53"	128.79'
C 6	152.92'	106.83'	104.68'	40°01'43"	55.70'
C18	41.72'	28.40'	27.85'	39°00'00"	14.77'
C19	125.00'	130.90'	125.00'	60°00'00"	72.17'
C 2	230.02'	32.69'	32.66'	8° 06' 51"	16.31'
C 3	122.00'	27.34'	27.28'	12° 50' 20"	13.73'
C 7	169.15'	64.60'	64.20'	21° 52' 56"	52.70'
C7A	169.15'	77.16'	76.51'	26° 00' 45"	59.28'
C7B	3947.72'	495.38'	495.05'	07° 11' 23"	248.01'

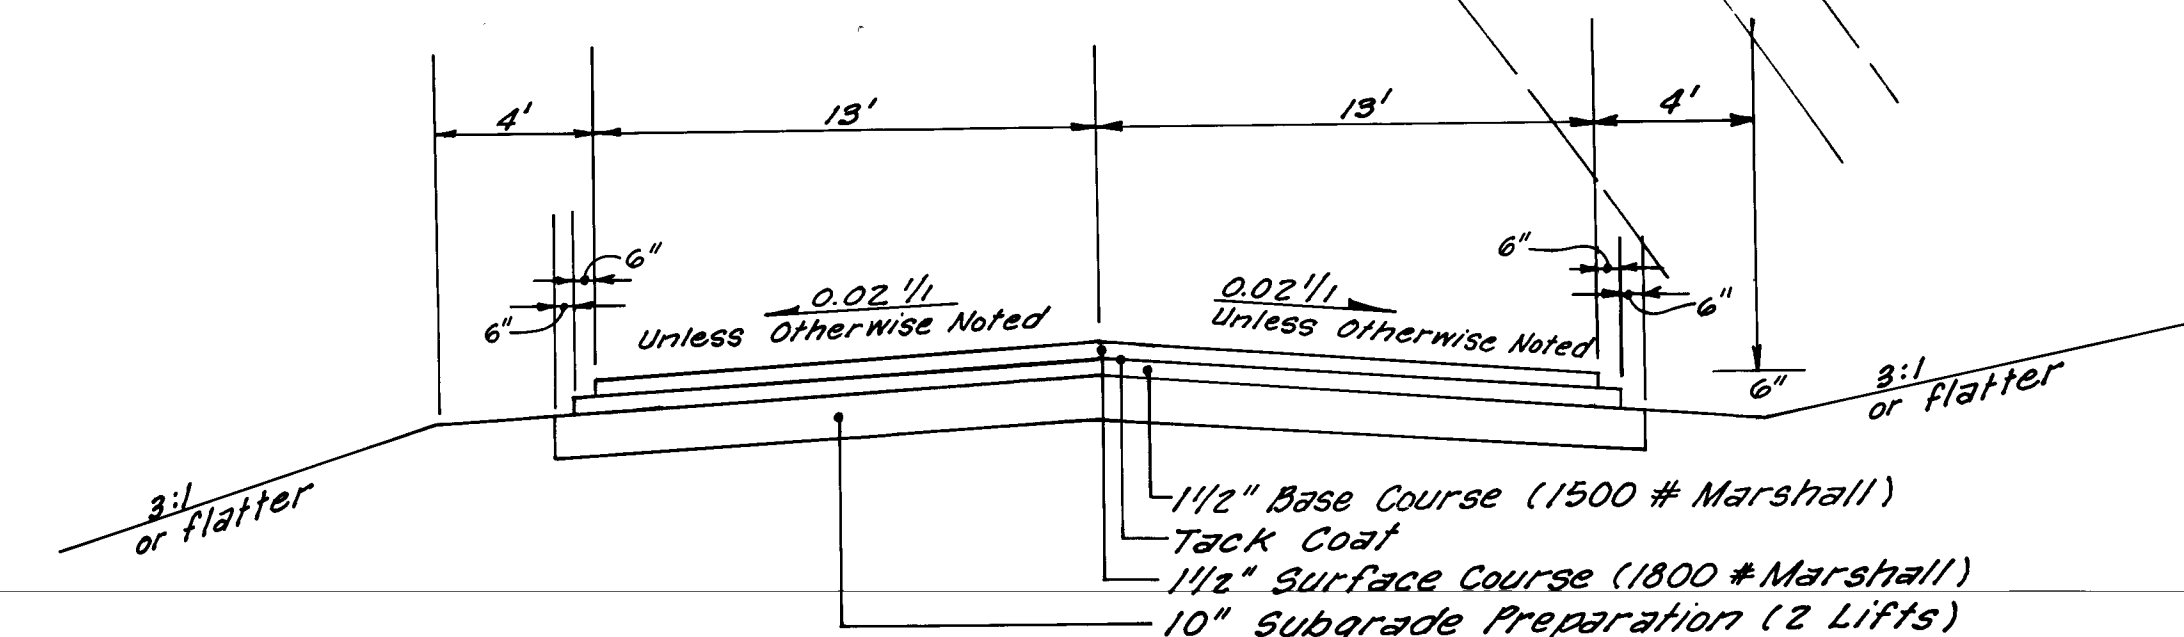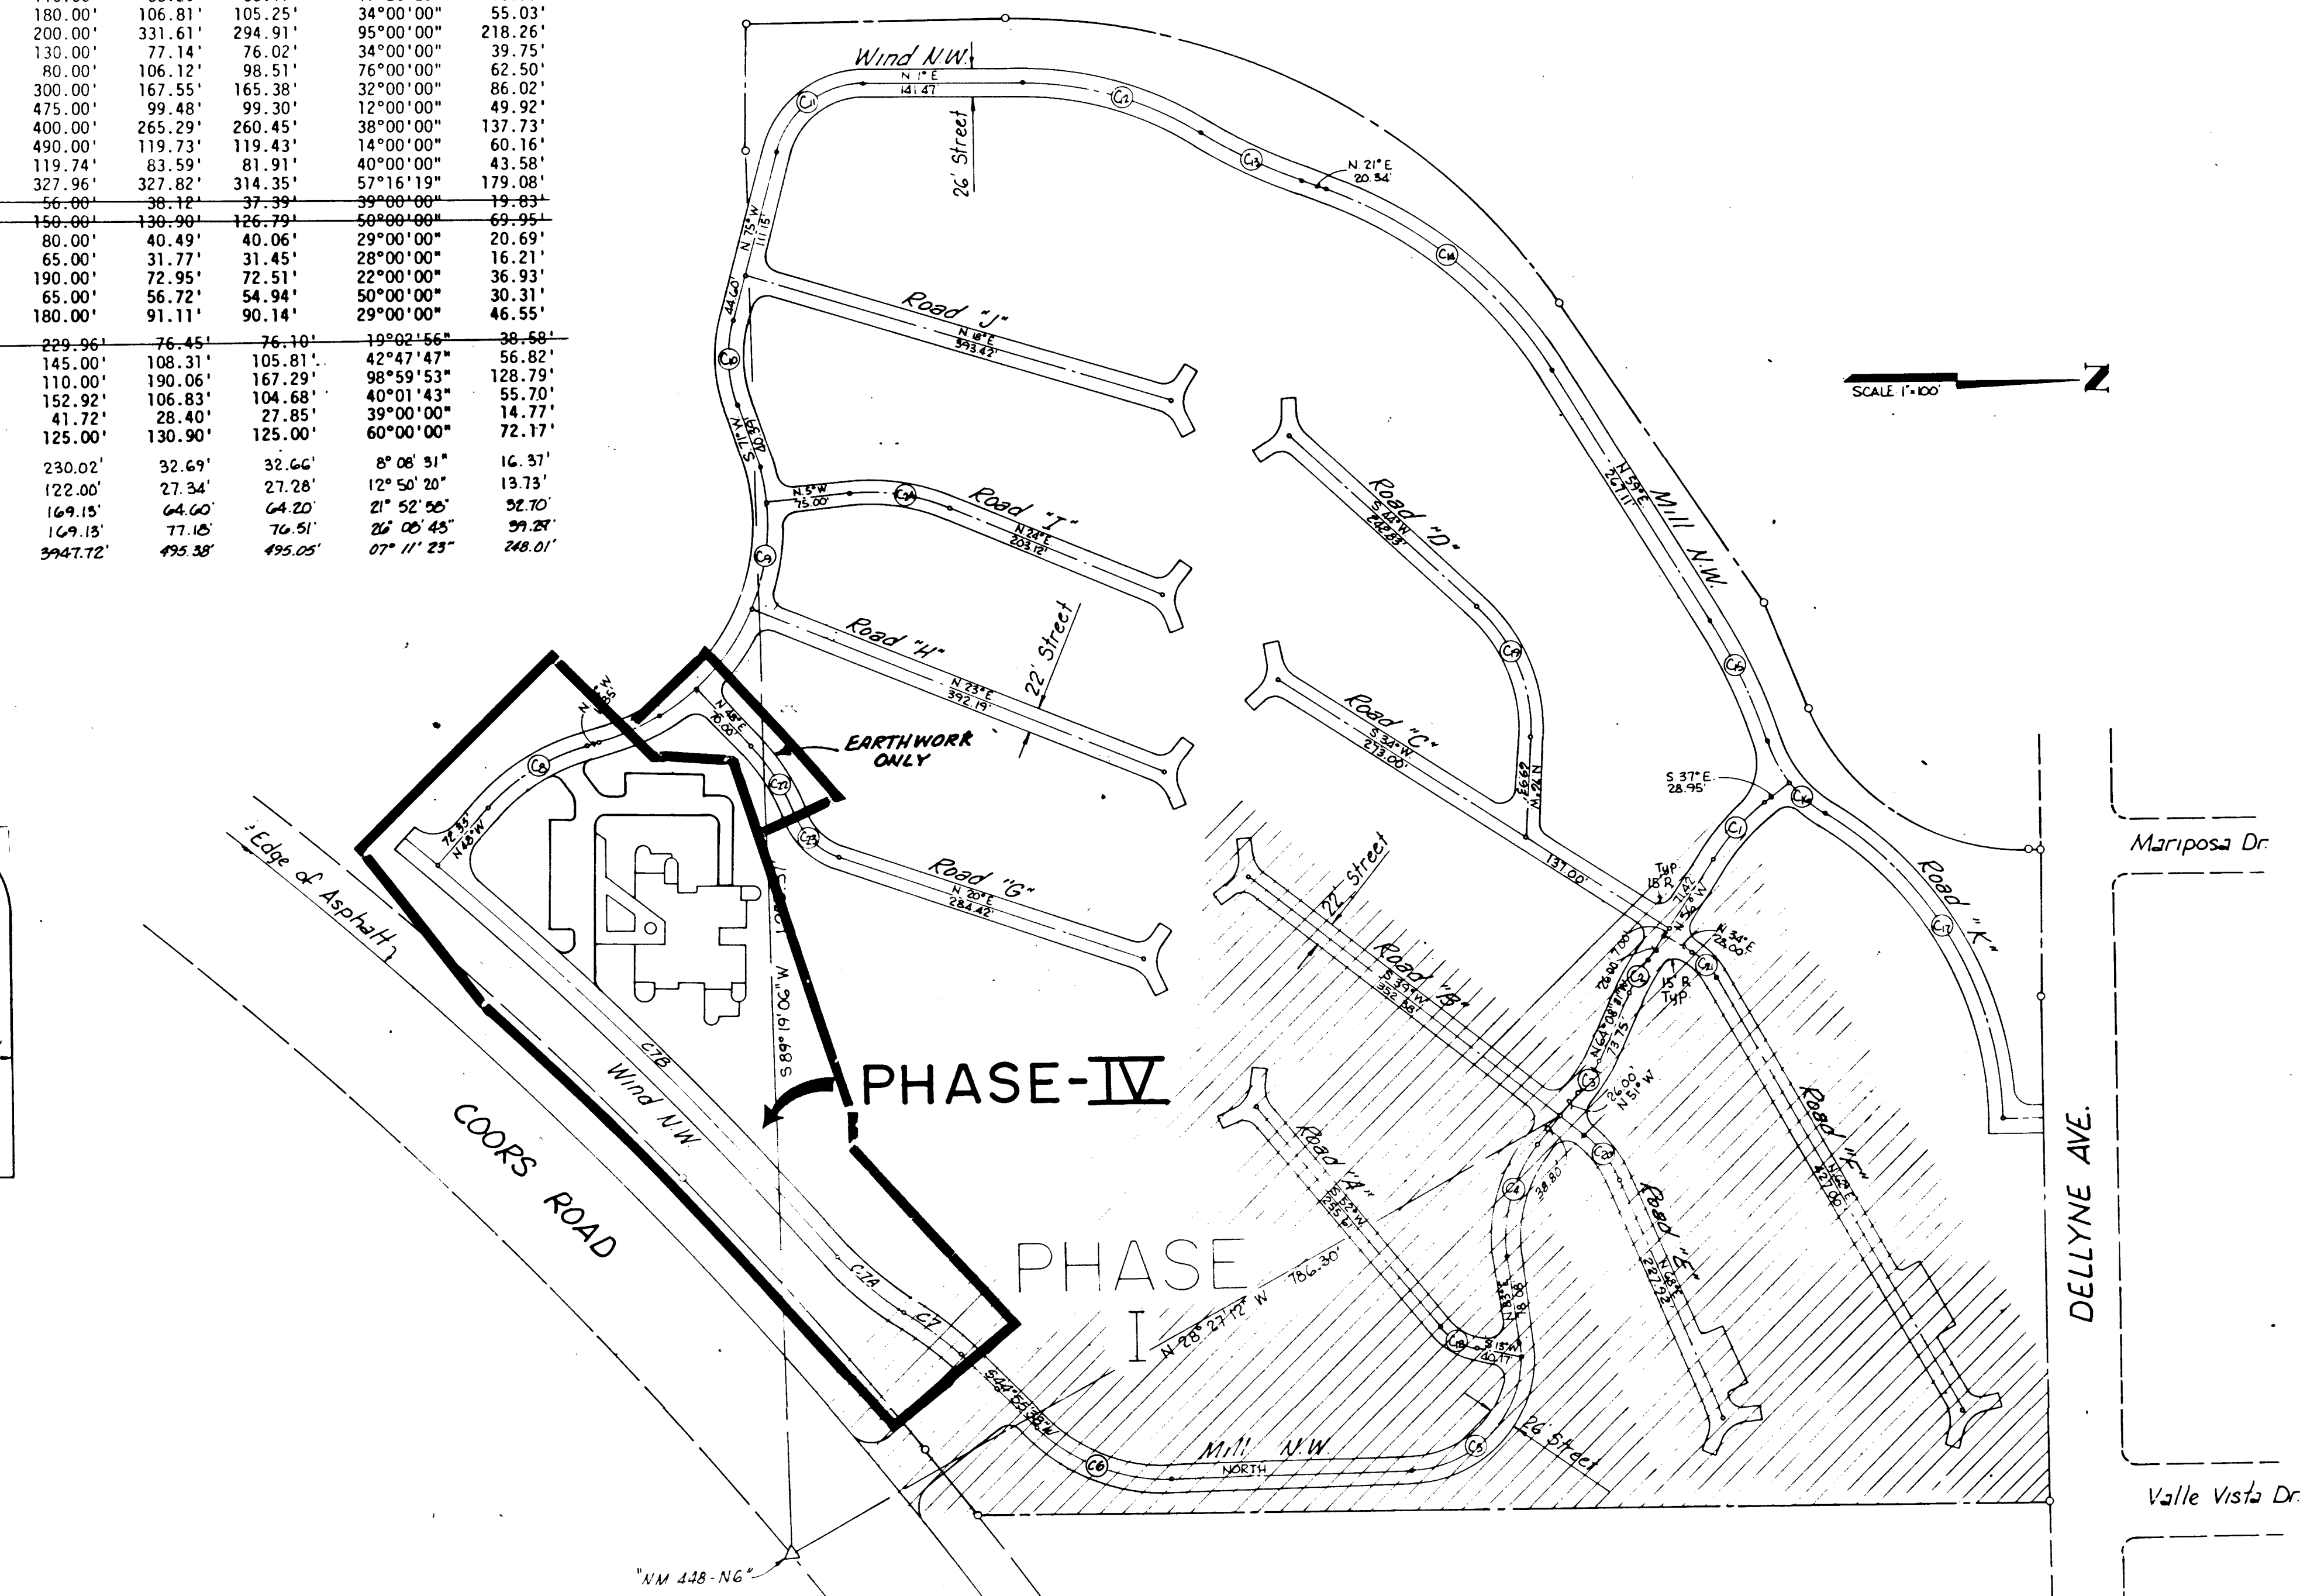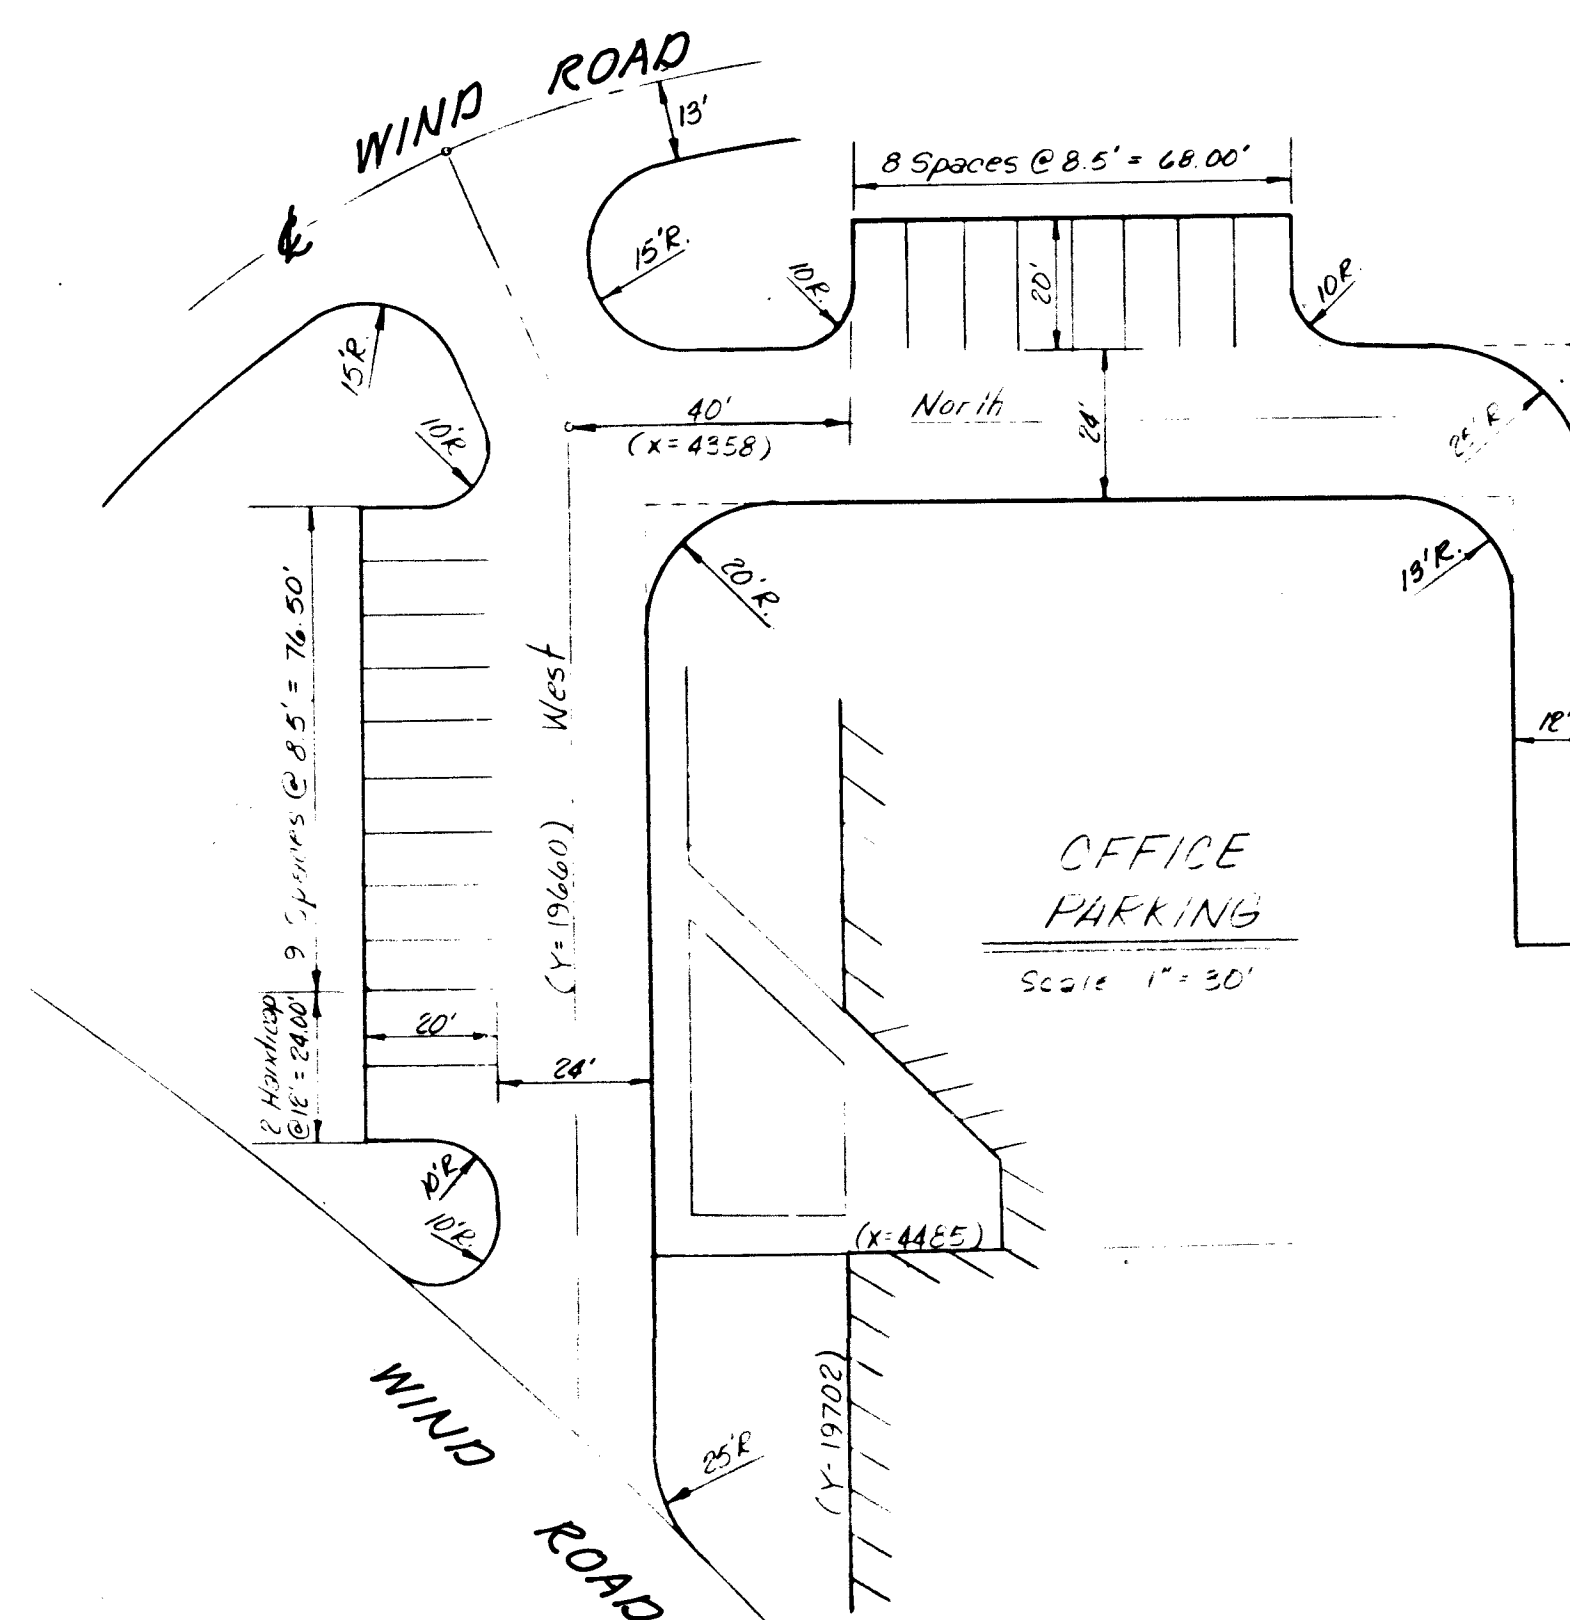


STREET SECTION (WIND N.W. & PARKING AREA)

APPROVED FOR
CONSTRUCTION
CITY ENGINEER DATE

CITY OF ALBUQUERQUE PUBLIC WORKS DEPARTMENT ENGINEERING DIVISION					
TITLE: LA LUZ DEL OESTE UNIT 4 PAVING LAYOUT PHASE-IV					
APPROVALS	ENGINEER	DATE	APPROVALS	ENGINEER	DATE
City Engineer			Liquid Waste	NA	10/1/77
A.C.E. Design	10/1/77		Traffic	NA	10/1/77
A.C.E. Hydrology	10/1/77		Water	NA	10/1/77
DRAWING N.O. 1262			SHEET 3 OF 7		


--	--	
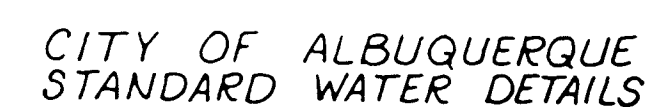


CITY ENGINEER DATE

CITY OF ALBUQUERQUE PUBLIC WORKS DEPARTMENT ENGINEERING DIVISION					
TITLE					
LA LUZ DEL OESTE UNIT 4 WATER LAYOUT PHASE-IV					
APPROVALS	ENGINEER	DATE	APPROVALS	ENGINEER	DATE
City Engineer	<i>[Signature]</i>	7/1/56	Liquid Waste	<i>[Signature]</i>	7/1/56
A.C.E. Design	<i>[Signature]</i>	6/1/57	Traffic	N.A.	
A.C.E. Hydrology	<i>[Signature]</i>	10/17/79	Water	<i>[Signature]</i>	12/1/79
DRAWING NO.			SHEET 4 OF 7		
1262					

[illegible]

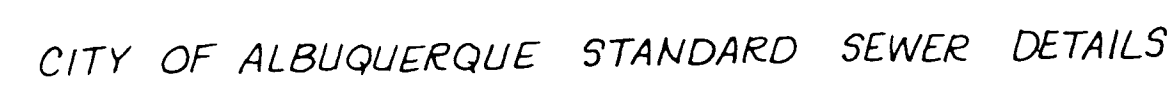



1. All manholes are 4' in diameter.
2. All sewer lines are private lines.

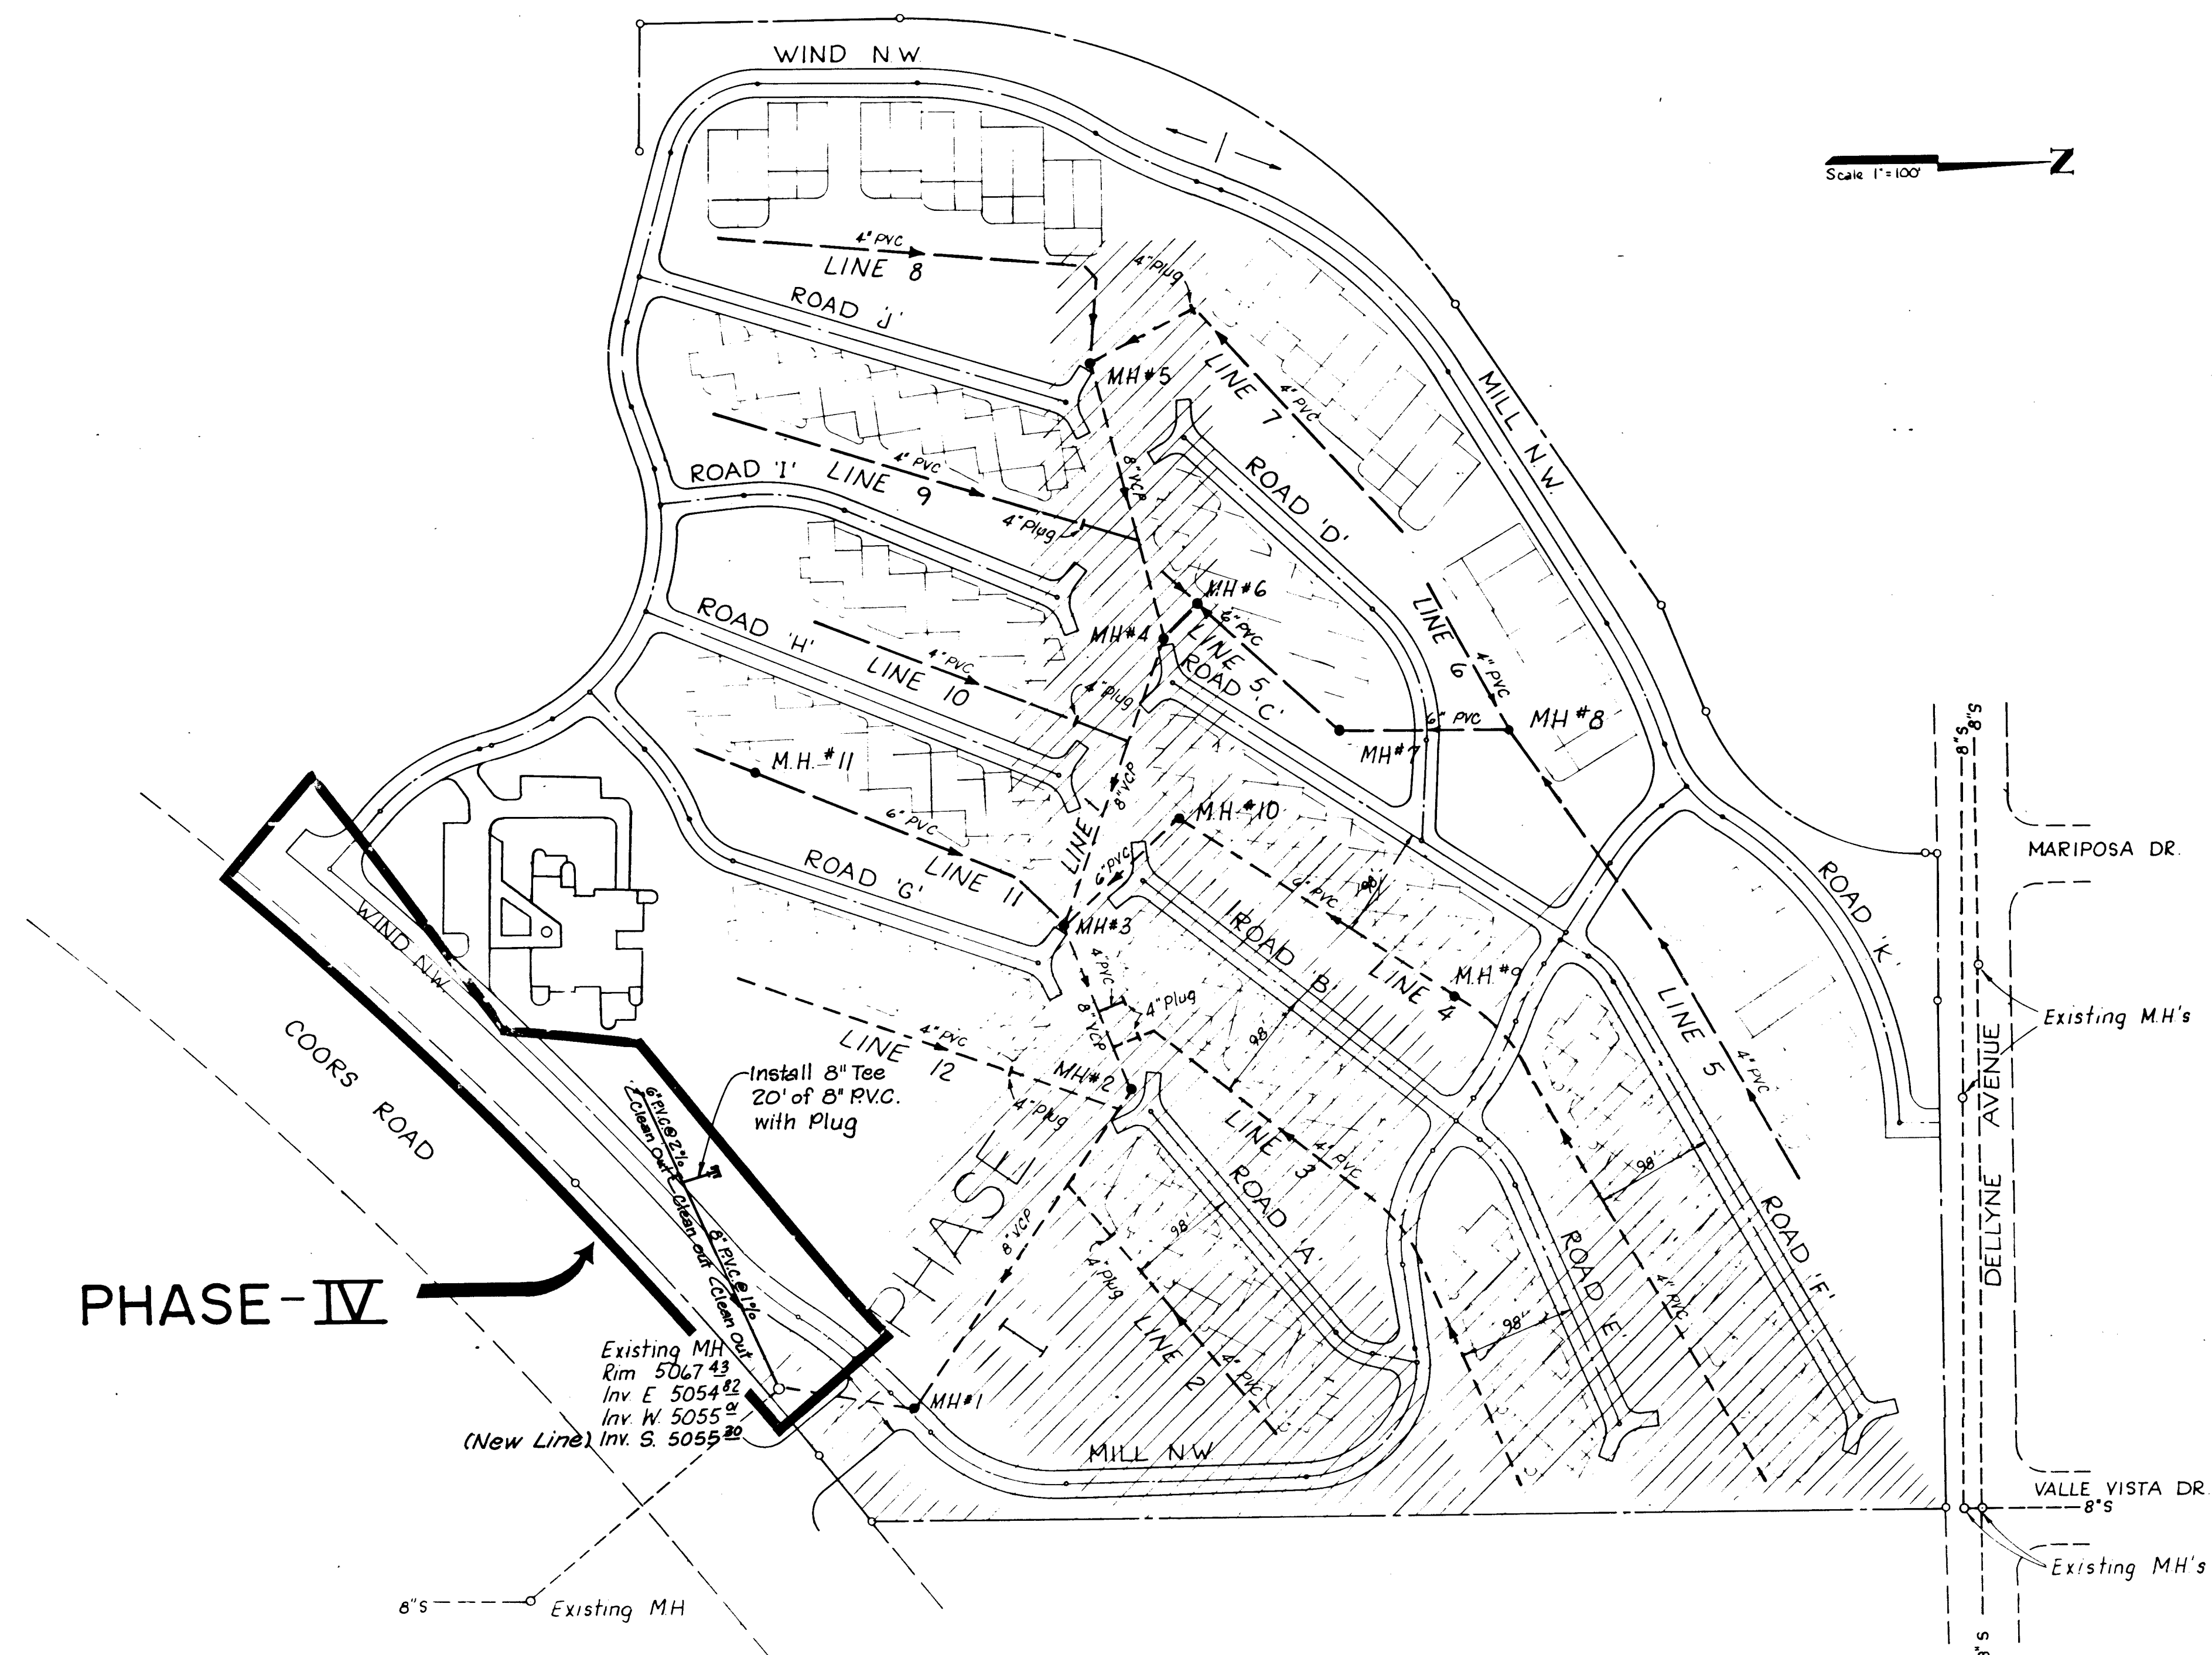

Scale 1"=100'  N

[illegible]


CITY OF ALBUQUERQUE PUBLIC WORKS DEPARTMENT ENGINEERING DIVISION					
TITLE LA LUZ DEL OESTE UNIT 4 SEWER LAYOUT - PHASE-IV					
APPROVALS	ENGINEER	DATE	APPROVALS	ENGINEER	DATE
City Engineer			Liquid Waste	<i>Paul A. [Signature]</i>	7/2/78
A.C.E Design	<i>[Signature]</i>	8/1/78	Traffic	<i>[Signature]</i>	7/1/78
A.C.E Hydrology	<i>[Signature]</i>	7/1/78	Water	<i>Paul A. [Signature]</i>	7/2/78
APPROVED FOR CONSTRUCTION			DRAWING NO. 1262		
CITY ENGINEER DATE			SHEET 5 OF 7		

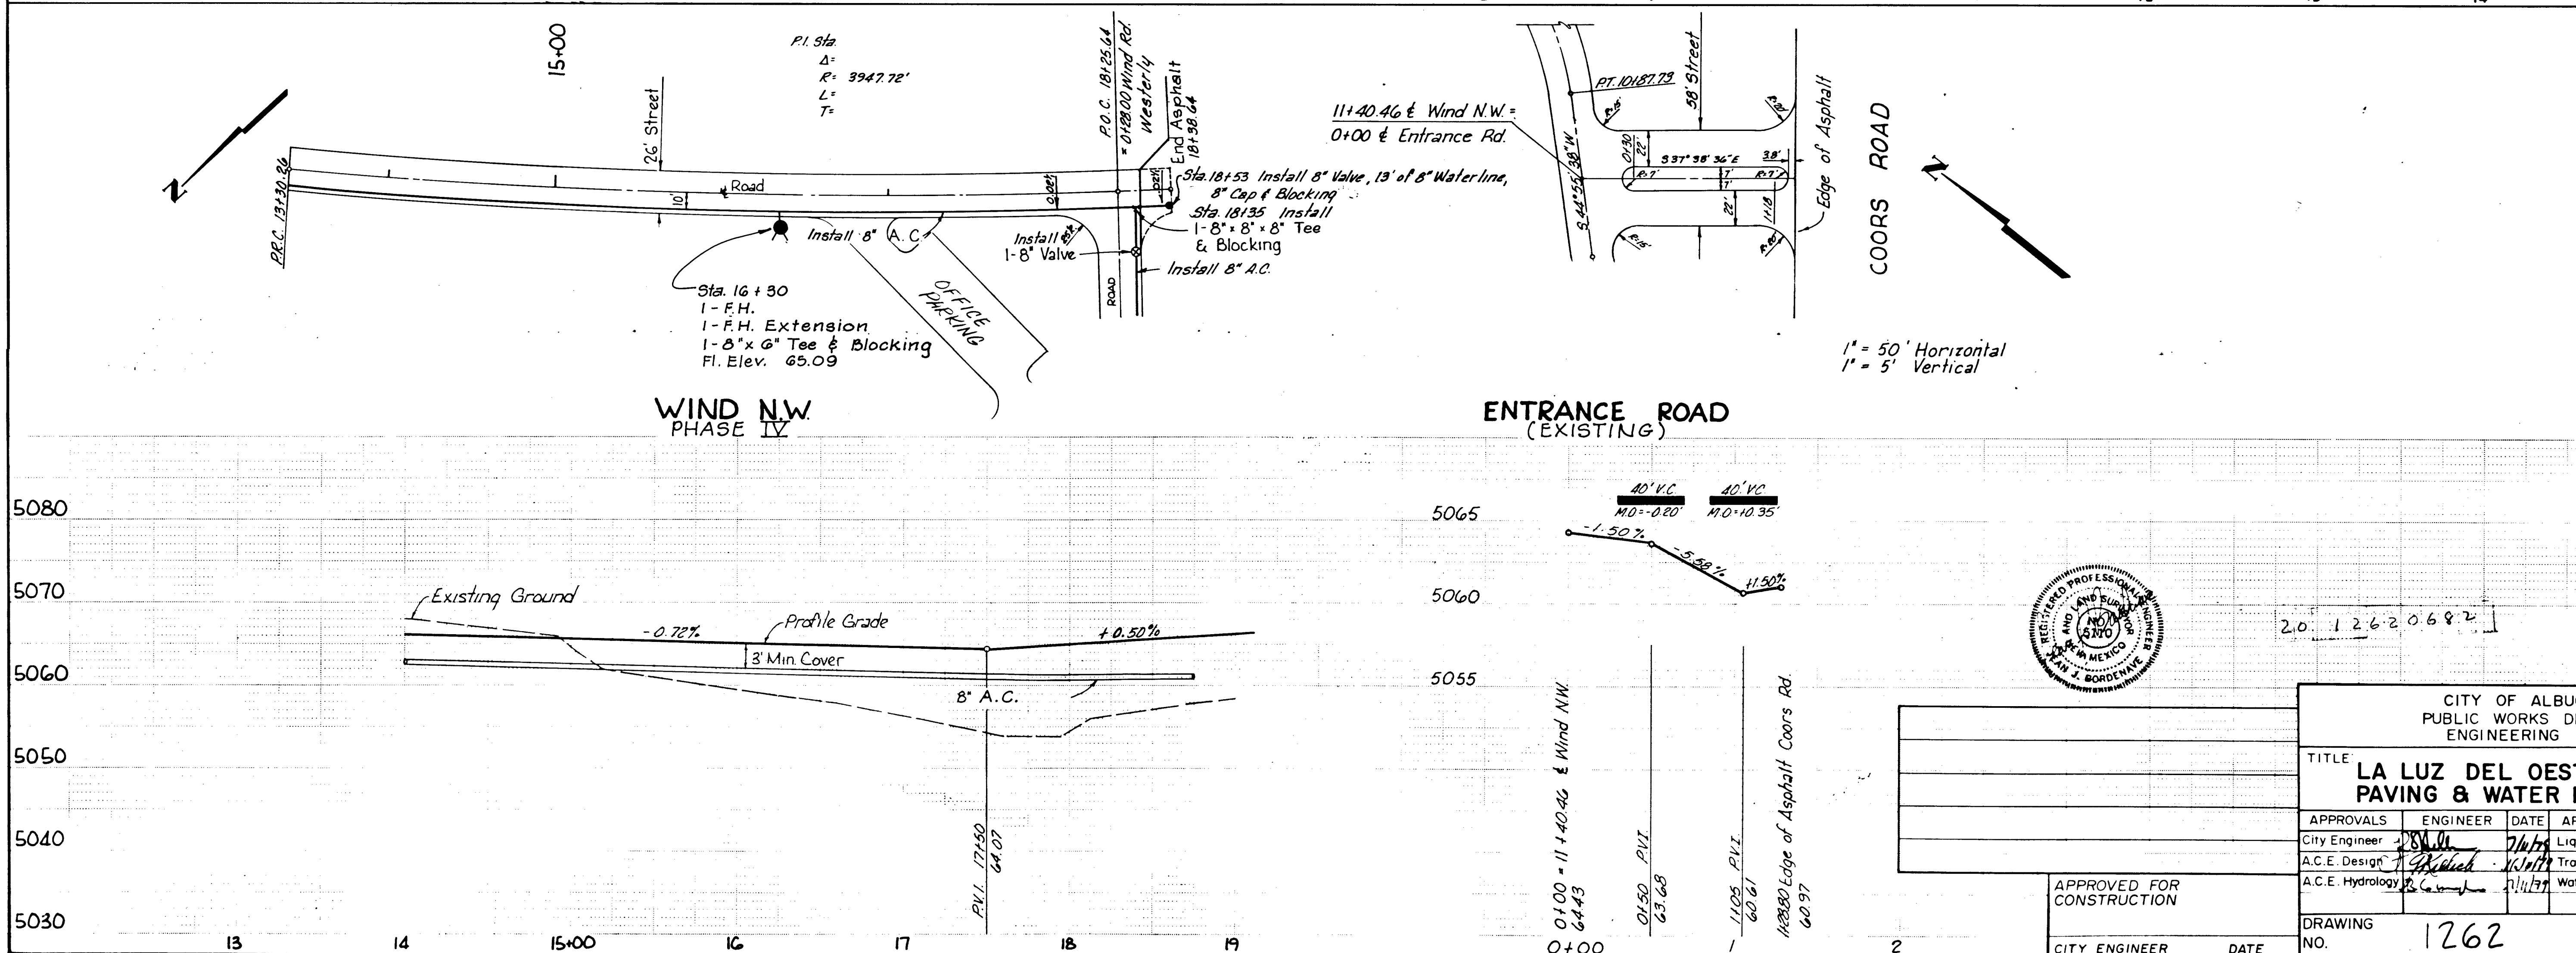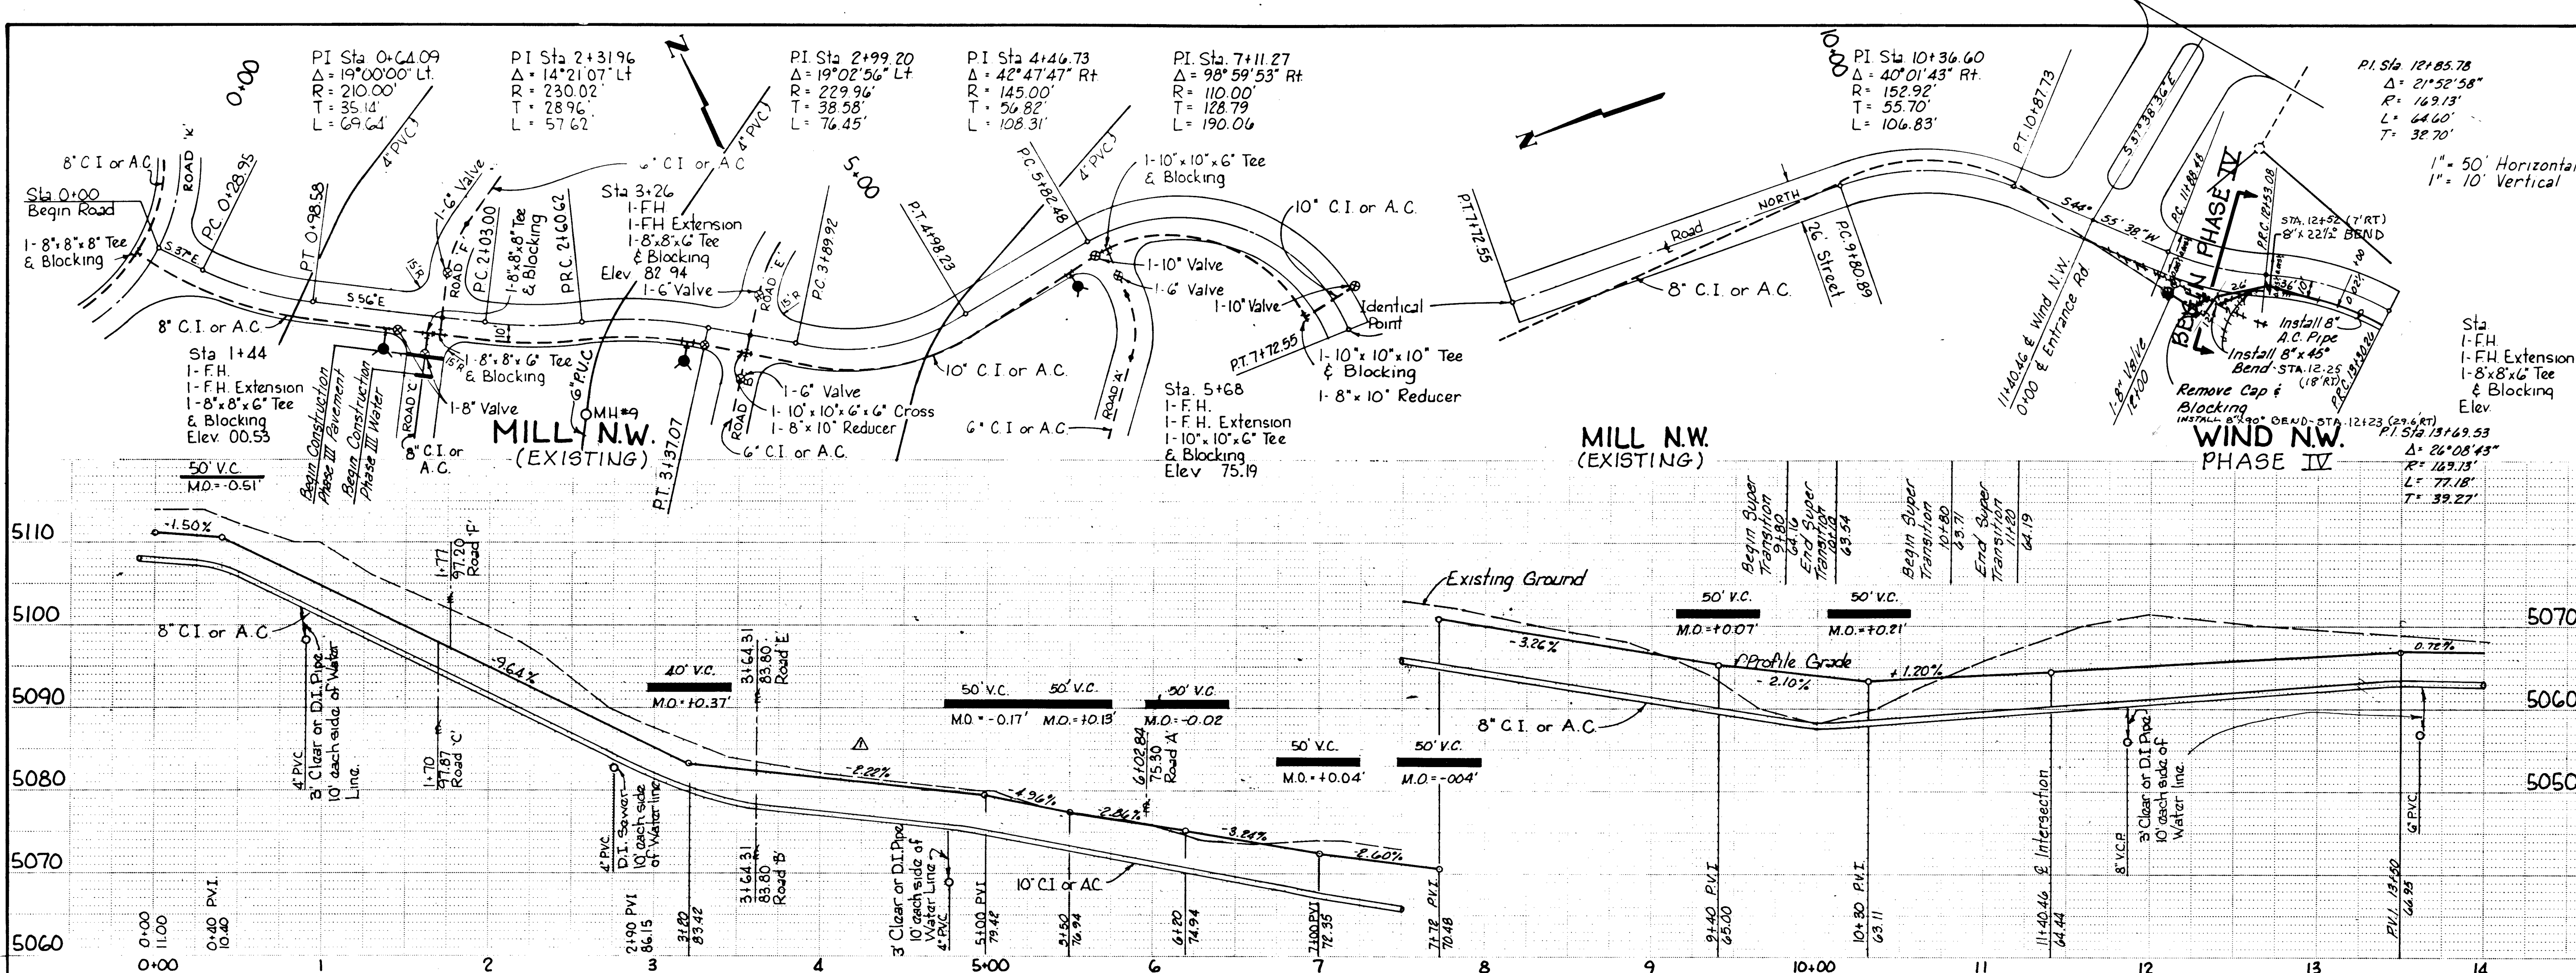

QUERQUE E PARTMENT DIVISION										TE UNIT 4 PLAN & PROFILE									
APPROVALS					ENGINEER					DATE									
Chief Engineer					[Signature]					11/19									
Checker					[Signature]					11/17									
SHEET 6 OF 7																			
T B										DESIGNED BY: T. T. BURNETT ENGINEERING INC. 120 MORNINGSIDE DRIVE N.E. ALBUQUERQUE, NEW MEXICO 87108									
NO. DATE										REMARKS									
BY																			
REFERENCES										MAP NO. F-118									
EST. NO.										W.O. NO.									
NO.										BY									
DATE										DATE									
BENCH MARKS										N.M. 448-N6 Elev. 5058.89									
CONTRACTOR										WORK ACCEPTED BY R. Remezon DATE 6/82 CORRECTED BY F. F. T. L. S. W. DATE 6/82									
AS-BUILT INFORMATION										MICRO-FILM INFORMATION									
RECORDED BY										DATE									



CITY OF ALBUQUERQUE PUBLIC WORKS DEPARTMENT ENGINEERING DIVISION					
TITLE LA LUZ DEL OESTE UNIT 4 PAVING & WATER PLAN & PROFILE					
APPROVALS	ENGINEER	DATE	APPROVALS	ENGINEER	DATE
City Engineer	<i>[Signature]</i>	7/1/77	Liquid Waste	<i>[Signature]</i>	7/1/77
A.C.E. Design	<i>[Signature]</i>	7/1/77	Traffic	<i>[Signature]</i>	7/1/77
A.C.E. Hydrology	<i>[Signature]</i>	7/1/77	Water	<i>[Signature]</i>	7/1/77
DRAWING NO. 1262			SHEET 6 OF 7		

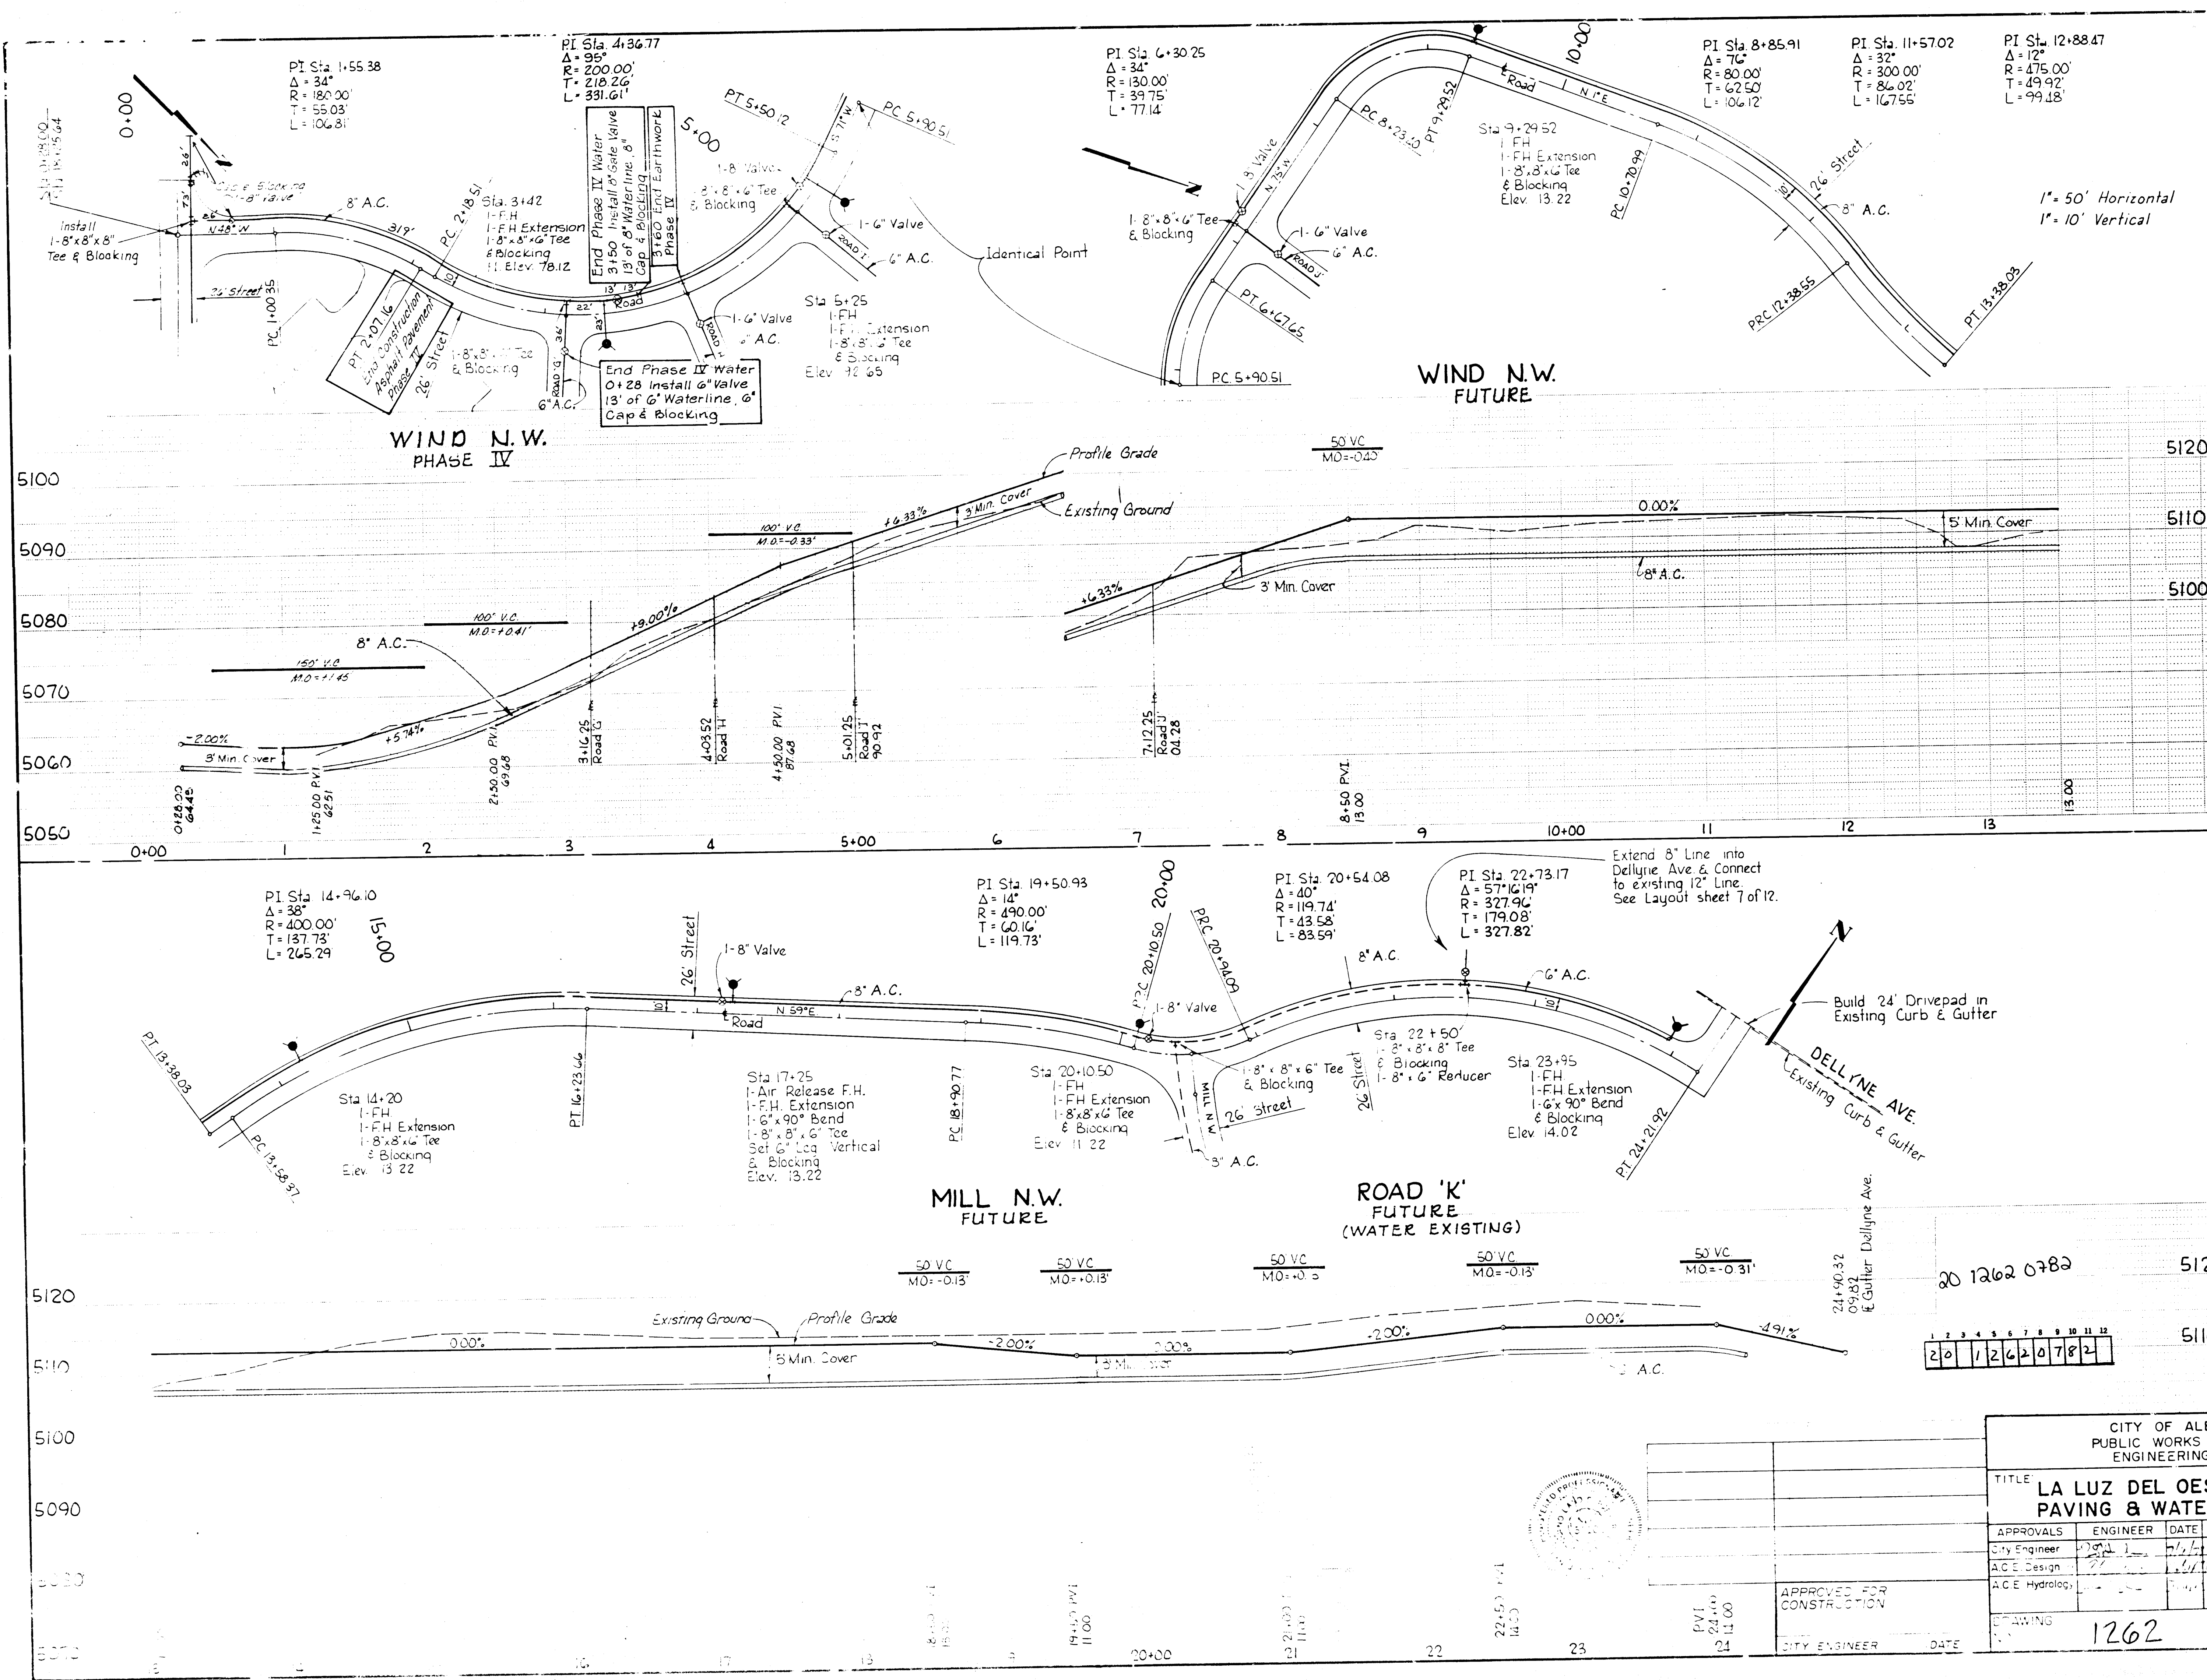

AS-BUILT INFORMATION			SURVEY INFORMATION			REFERENCES		
CONTRACTOR	ELV. 5058.89	DATE	NO.	BY	DATE	MAP NO.	EST. NO.	BY
WORKING DRAWING NO.	1262	DATE	NO.	BY	DATE	MAP NO.	EST. NO.	BY
REVISIONS								
NO.	DATE	REVISIONS	NO.	DATE	REVISIONS	NO.	DATE	REVISIONS
1	12/6/21	DESIGNED BY: T. BURNETT ENGINEERING INC.	1	12/6/21	DESIGNED BY: T. BURNETT ENGINEERING INC.	1	12/6/21	DESIGNED BY: T. BURNETT ENGINEERING INC.
2	12/6/21	1700 MORNINGSIDE DRIVE N.E. ALBUQUERQUE, NEW MEXICO 87108	2	12/6/21	1700 MORNINGSIDE DRIVE N.E. ALBUQUERQUE, NEW MEXICO 87108	2	12/6/21	1700 MORNINGSIDE DRIVE N.E. ALBUQUERQUE, NEW MEXICO 87108
3	12/6/21		3	12/6/21		3	12/6/21	
4	12/6/21		4	12/6/21		4	12/6/21	
5	12/6/21		5	12/6/21		5	12/6/21	
100	12/6/21		100	12/6/21		100	12/6/21	

CITY OF ALBUQUERQUE
PUBLIC WORKS DEPARTMENT
ENGINEERING DIVISION

TITLE: LA LUZ DEL OESTE UNIT 4
PAVING & WATER PLAN & PROFILE

APPROVALS	ENGINEER	DATE	APPROVALS	ENGINEER	DATE
City Engineer			City Engineer		
C.E. Design			C.E. Design		
C.E. Hydrology			C.E. Hydrology		

DRAWING: 1262 SHEET 7 7