

Extension of Forest Hills Dr
1265

SCANNED
BY LASSON

CITY OF ALBUQUERQUE

EXTENSION

OF

FOREST HILLS DRIVE


PREPARED FOR

SOUTHWEST COMMUNITY HEALTH SERVICES

FEBRUARY 1982


INDEX

COVER SHEET & VICINITY MAP	1
FOREST HILLS DRIVE	2
MEDIAN PLAN	3
FRONTAGE ROAD	4
CROSS-SECTIONS AND DETAILS	5

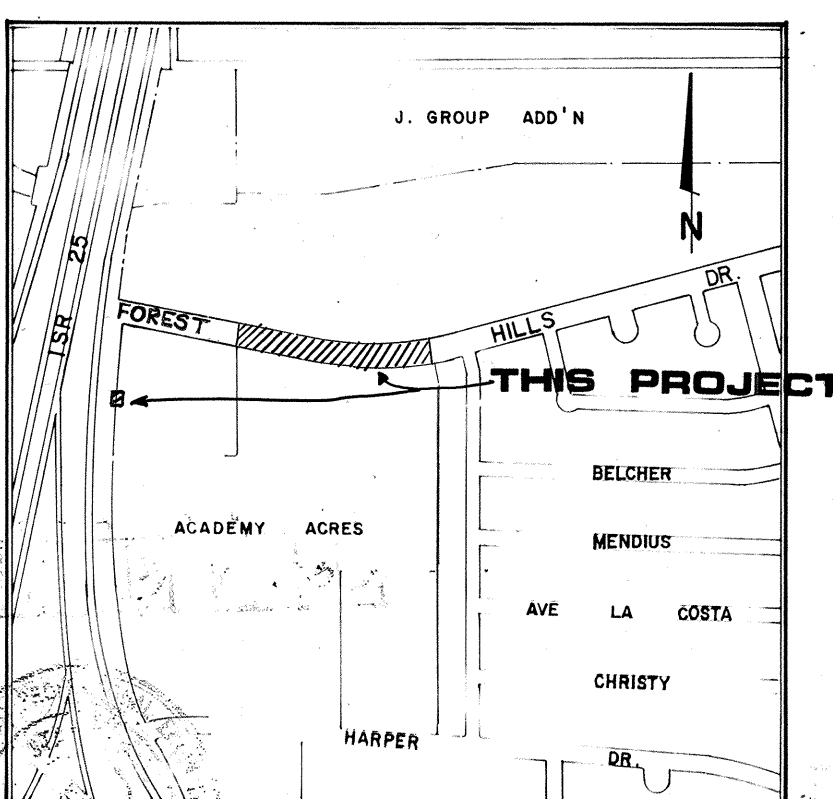

VICINITY MAP

E 18

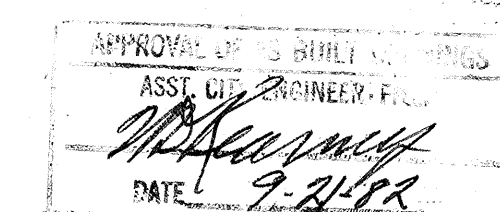

26 1265 0182

APPROVALS	ENGINEER	DATE
CITY ENGINEER	Richard E. Hall	3/4/82
TRAFFIC ENGINEER		
WATER RESOURCES		




5-24-82




Boyle Engineering Corporation

consulting engineers

1521

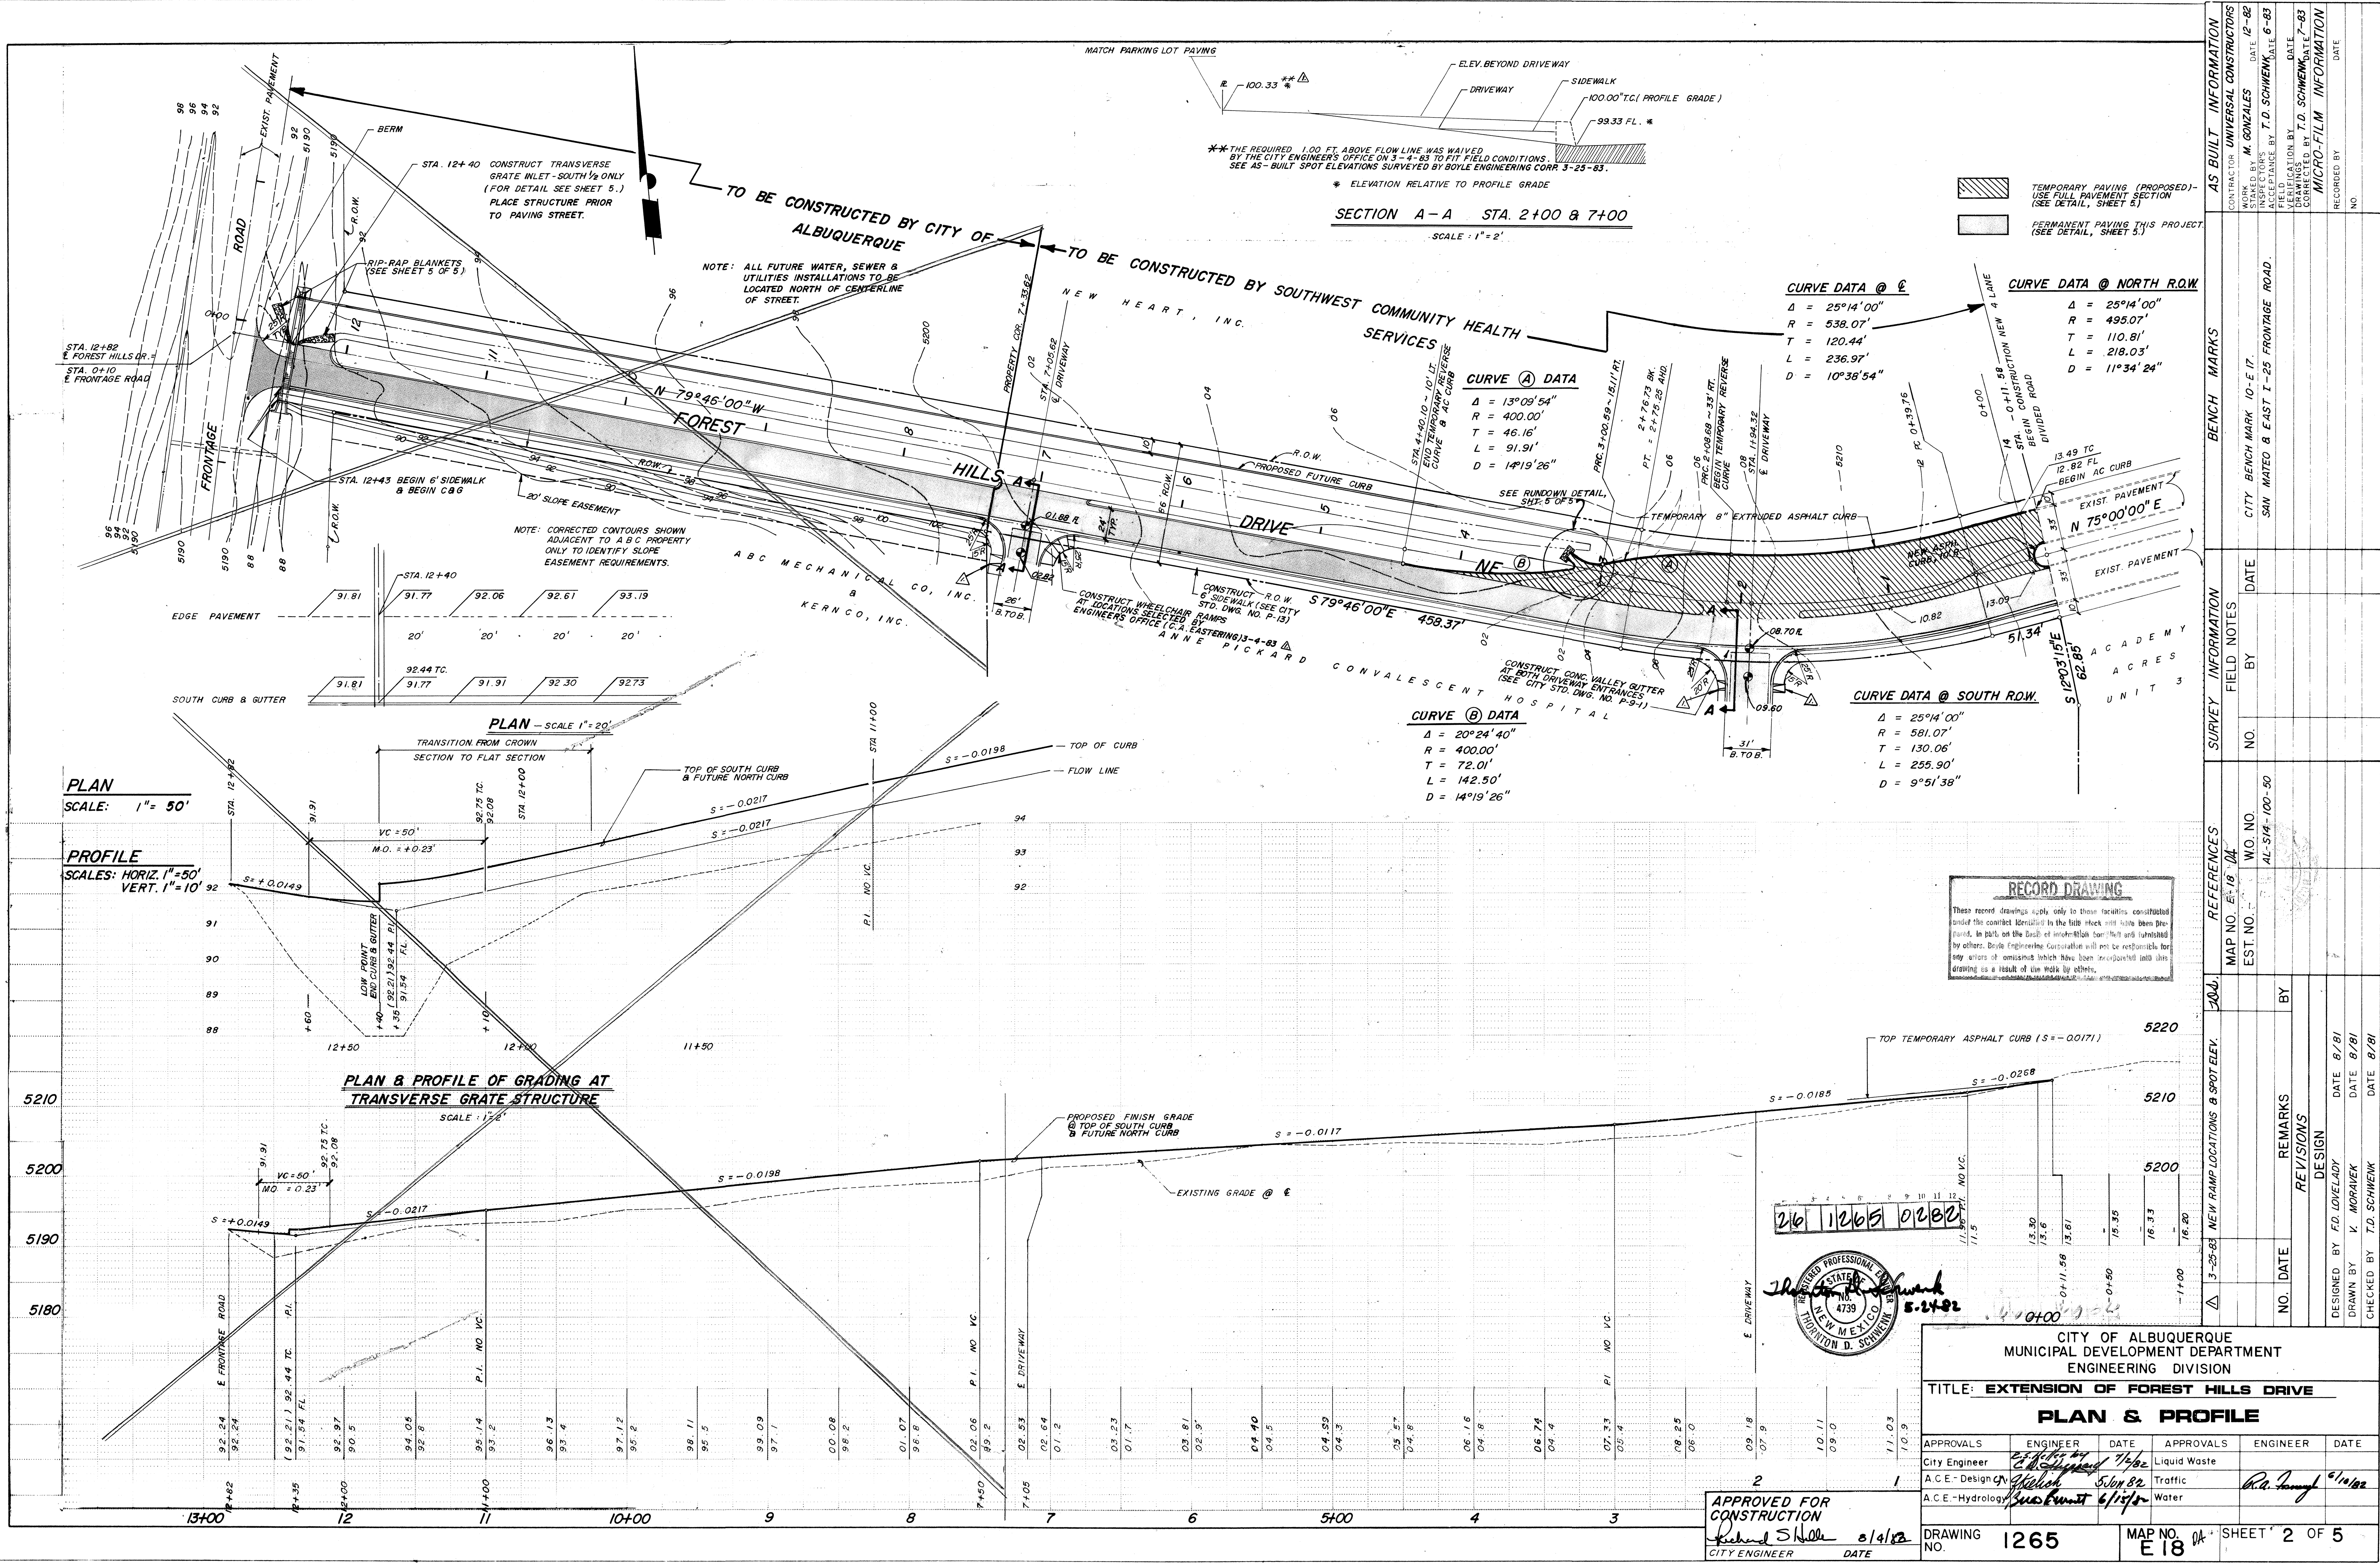



216 1265 0282

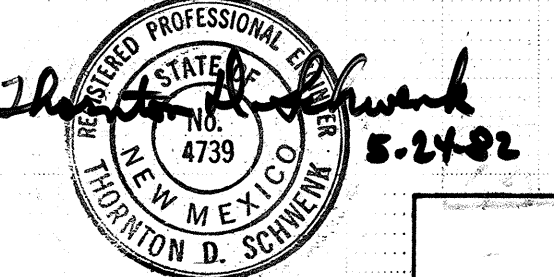

APPROVED FOR CONSTRUCTION
Richard S. Schwenk 8/1/82
CITY ENGINEER DATE

CITY OF ALBUQUERQUE MUNICIPAL DEVELOPMENT DEPARTMENT ENGINEERING DIVISION					
TITLE: EXTENSION OF FOREST HILLS DRIVE					
PLAN & PROFILE					
APPROVALS	ENGINEER	DATE	APPROVALS	ENGINEER	DATE
City Engineer	T.D. Schwenk	8/1/82	Liquid Waste		
A.C.E. - Design	John Schwenk	5/1/82	Traffic	R.A. Schwenk	6/1/82
A.C.E. - Hydrology	John Schwenk	6/1/82	Water		
DRAWING NO.	1265	MAP NO.	E 18	SHEET	2 OF 5

1522

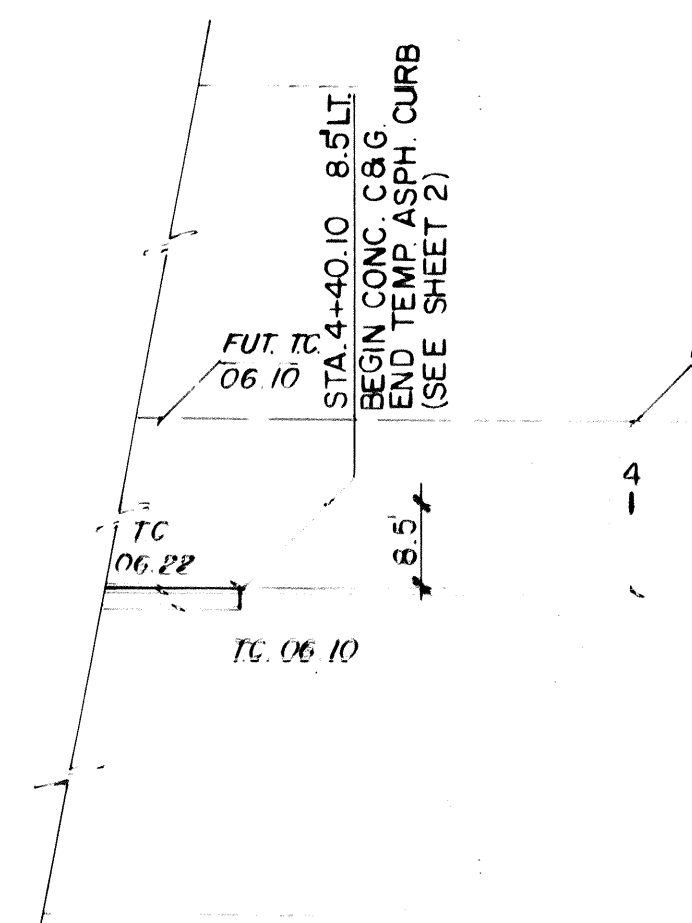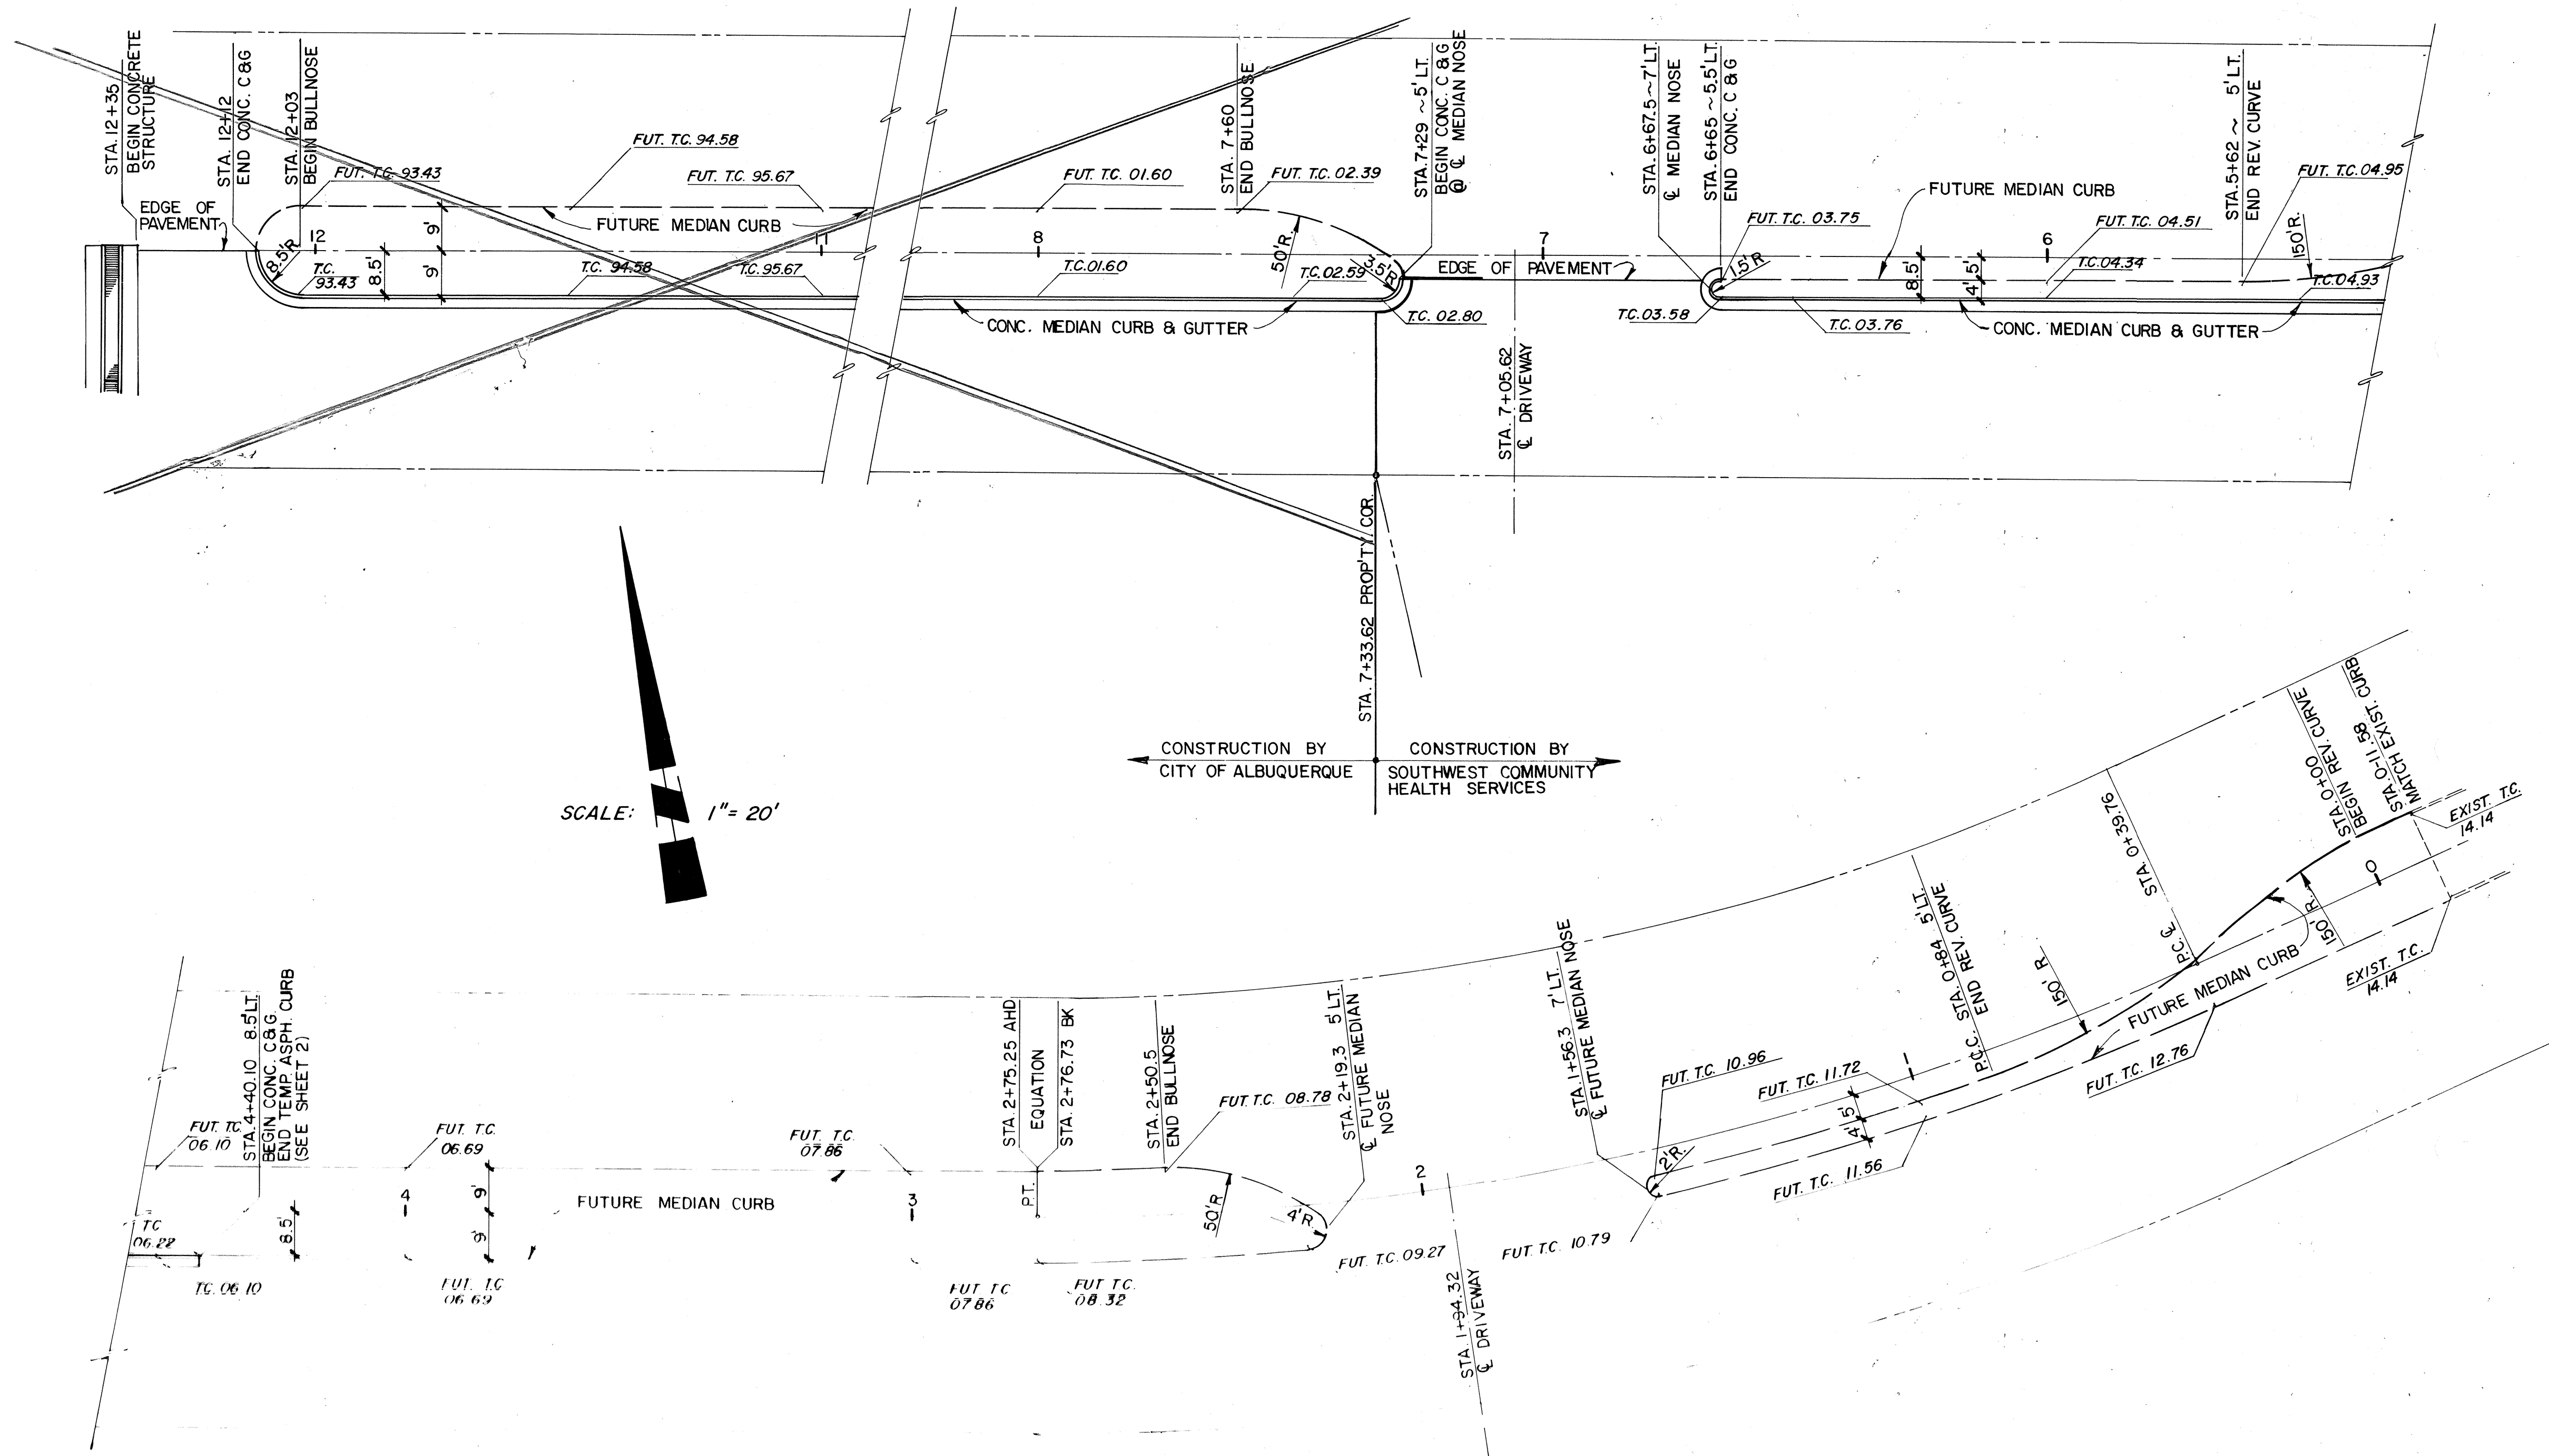

SCALE: 1" = 20'

CONSTRUCTION BY
CITY OF ALBUQUERQUE

CONSTRUCTION BY
SOUTHWEST COMMUNITY
HEALTH SERVICES


RECORD DRAWING

These record drawings apply only to those facilities constructed under the contract identified in the title block and have been prepared, in part, on the basis of information compiled and furnished by others. City of Albuquerque Engineering Division will not be responsible for any errors or omissions which have been made in the preparation of this drawing as a result of the information furnished by others.

26 1265 03182


CITY OF ALBUQUERQUE MUNICIPAL DEVELOPMENT DEPARTMENT ENGINEERING DIVISION					
TITLE: EXTENSION OF FOREST HILLS DRIVE MEDIAN PLAN					
APPROVALS	ENGINEER	DATE	APPROVALS	ENGINEER	DATE
City Engineer	<i>[Signature]</i>	7/10/82	Liquid Waste		
A.C.E. - Design	<i>[Signature]</i>	5/10/82	Traffic	<i>[Signature]</i>	7/10/82
A.C.E. - Hydrology	<i>[Signature]</i>	6/15/82	Water		
DRAWING NO. 1265		MAP NO. E18		SHEET 3 OF 5	

SURVEY INFORMATION		BENCH MARKS		AS BUILT INFORMATION	
NO.	BY	DATE	CITY BENCH MARK 10-E 17.	CONTRACTOR UNIVERSAL CONSTRUCTORS	DATE 12-82
			SAN MATEO & EAST I-25 FRONTAGE ROAD.	WORK STAKED BY M. GONZALES	DATE 12-82
				FIELD ACCEPTANCE BY T.D. SCHWENK	DATE 6-83
				REVISIONS	DATE
				CORRECTED BY T.D. SCHWENK	DATE 6-83
				RECORDED BY	DATE
				NO.	







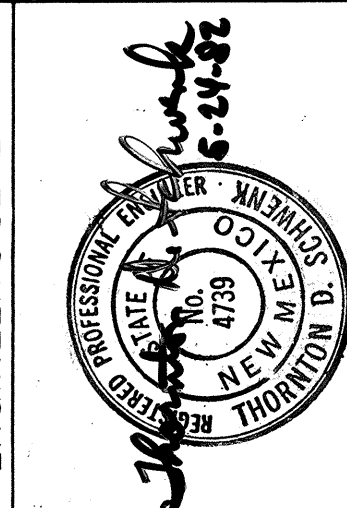


1502

1521

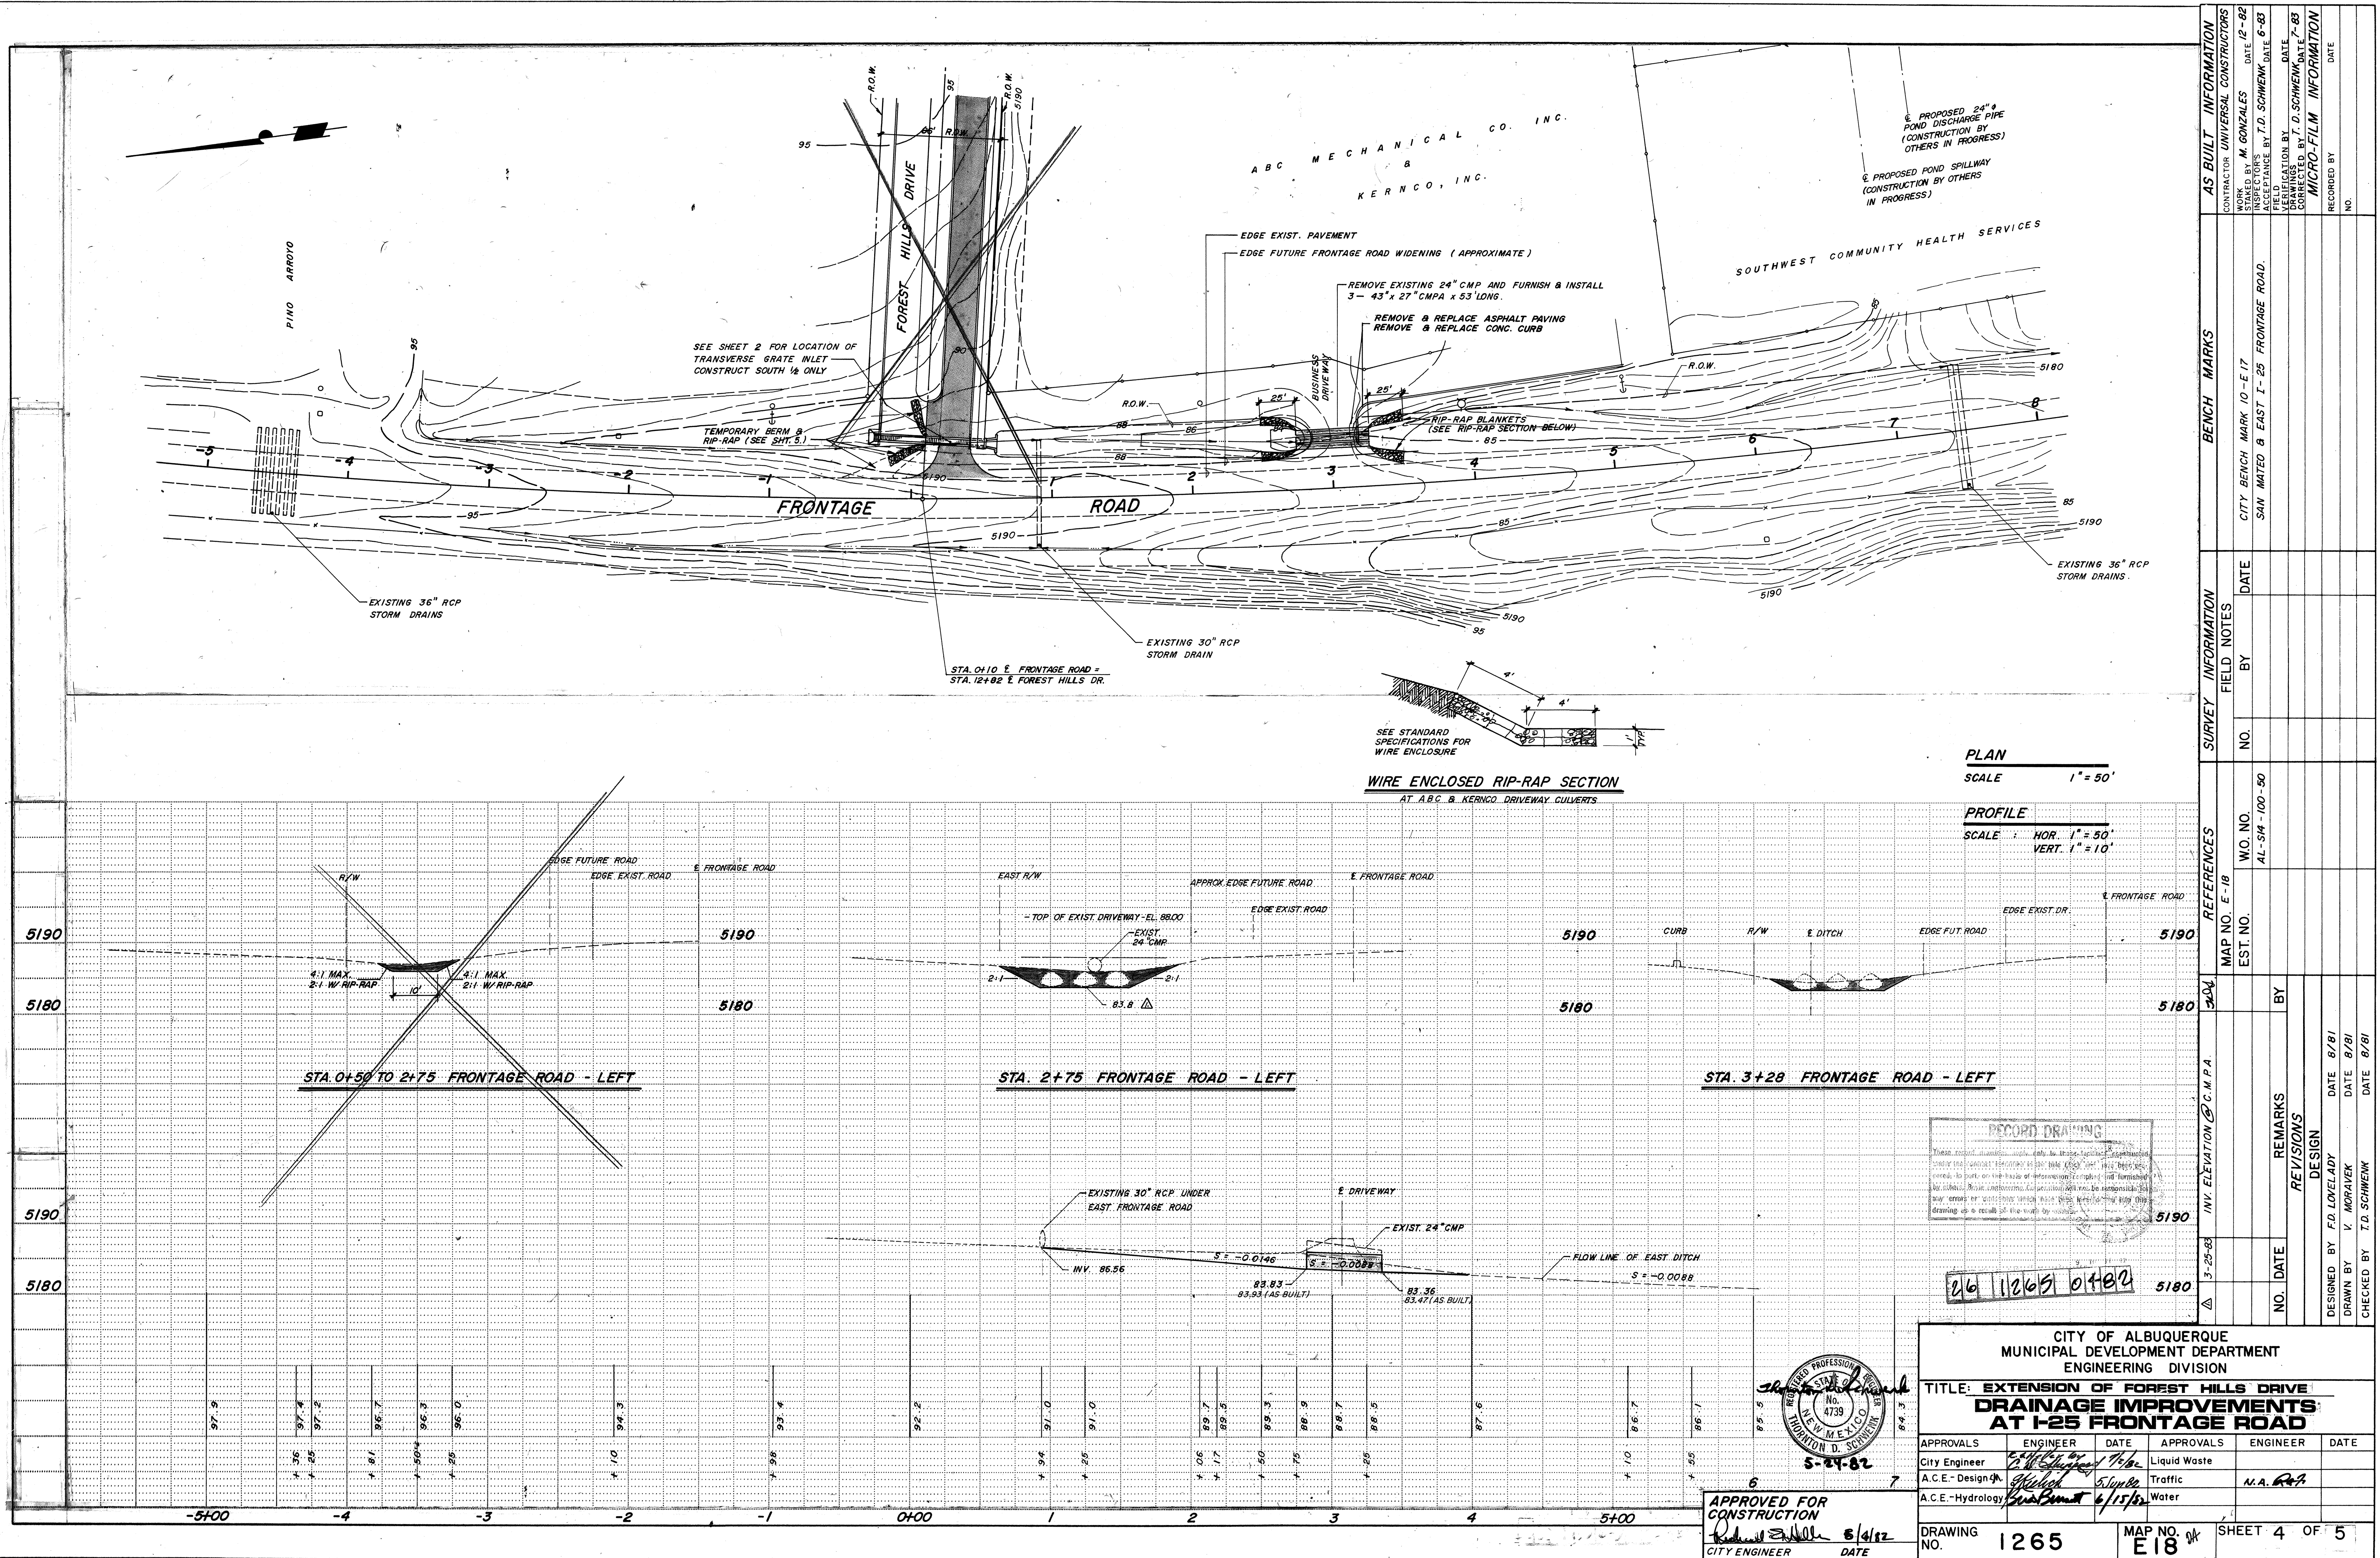

AS BUILT INFORMATION		BENCH MARKS		SURVEY INFORMATION		REFERENCES		REVISIONS	
CONTRACTOR	UNIVERSAL CONSTRUCTORS	CITY BENCH MARK	10-17	NO.	BY	MAP NO. E-18	EST. NO.	NO.	DATE
WORK	STAKED BY M. GONZALES	SAN MATEO & EAST I-25 FRONTAGE ROAD	DATE 12-82			W.O. NO.	AL-S4-100-50		
INSPECTOR'S	FIELD		DATE 6-83						
FIELD	FIELD		DATE						
VERIFICATION	DATE		DATE						
CORRECTED BY T.D. SCHWEM	DATE 7-83		DATE						
MICRO-FILM	INFORMATION		DATE						
RECORDED BY	NO.		DATE						

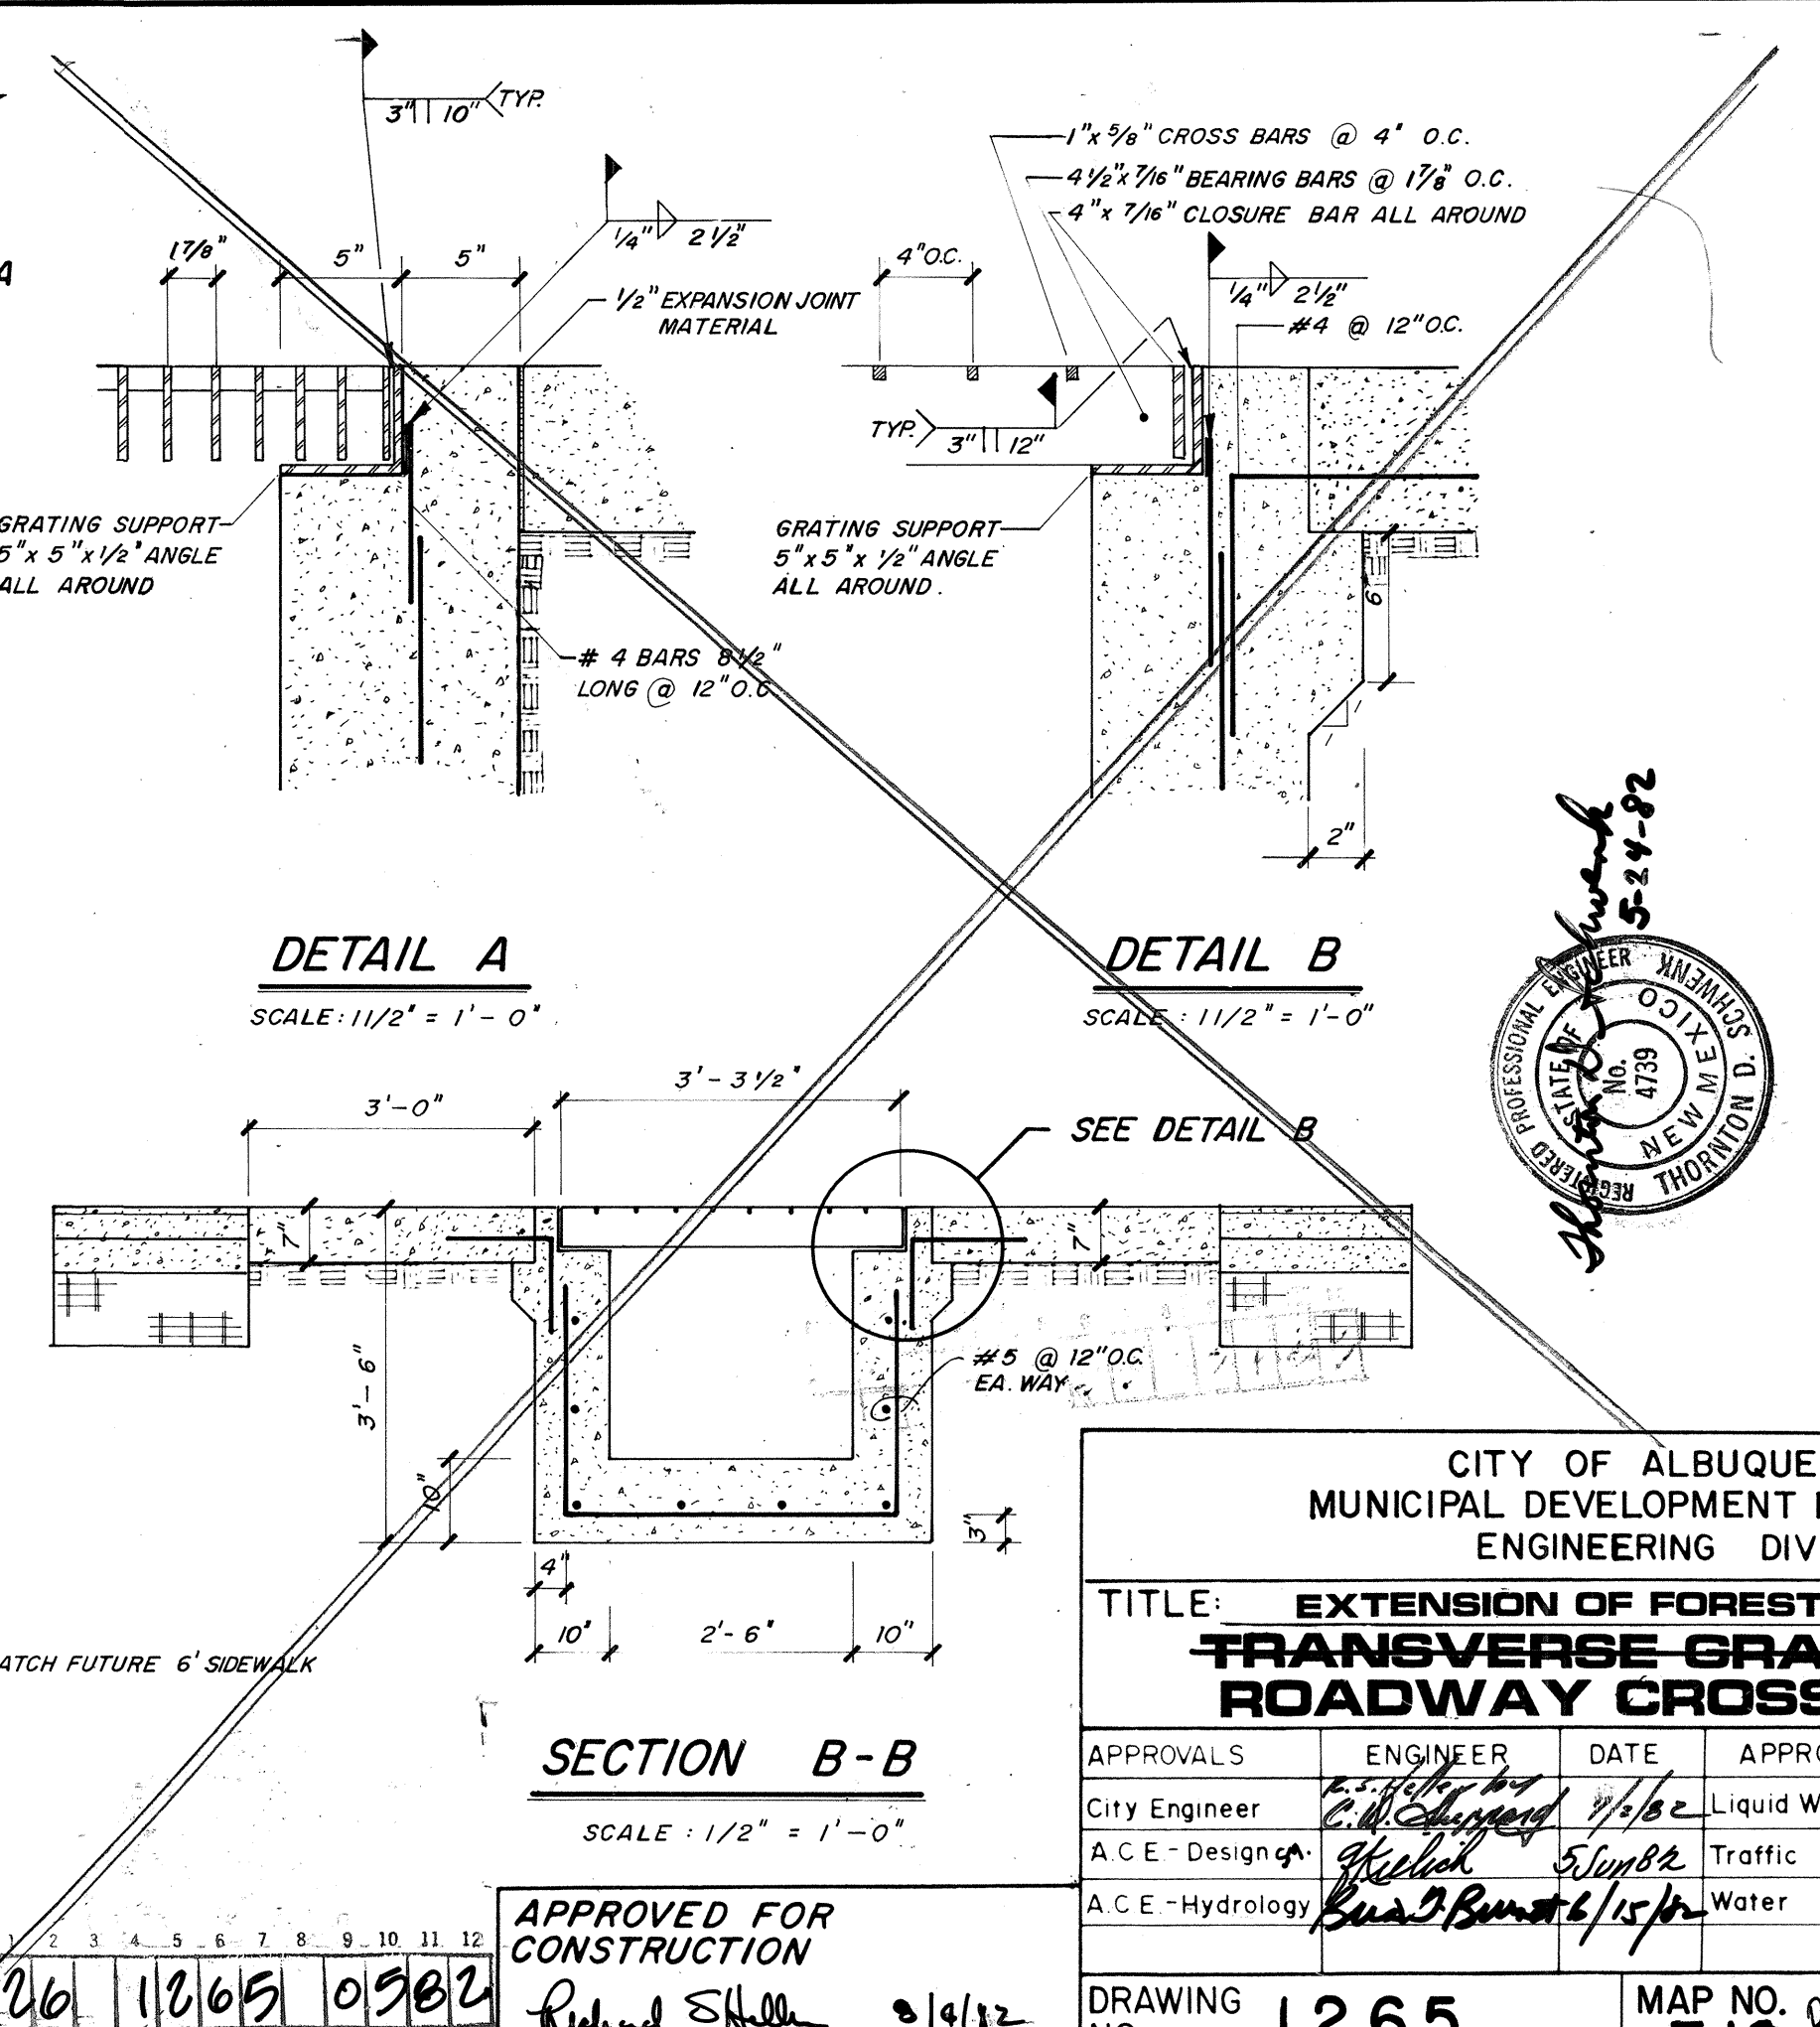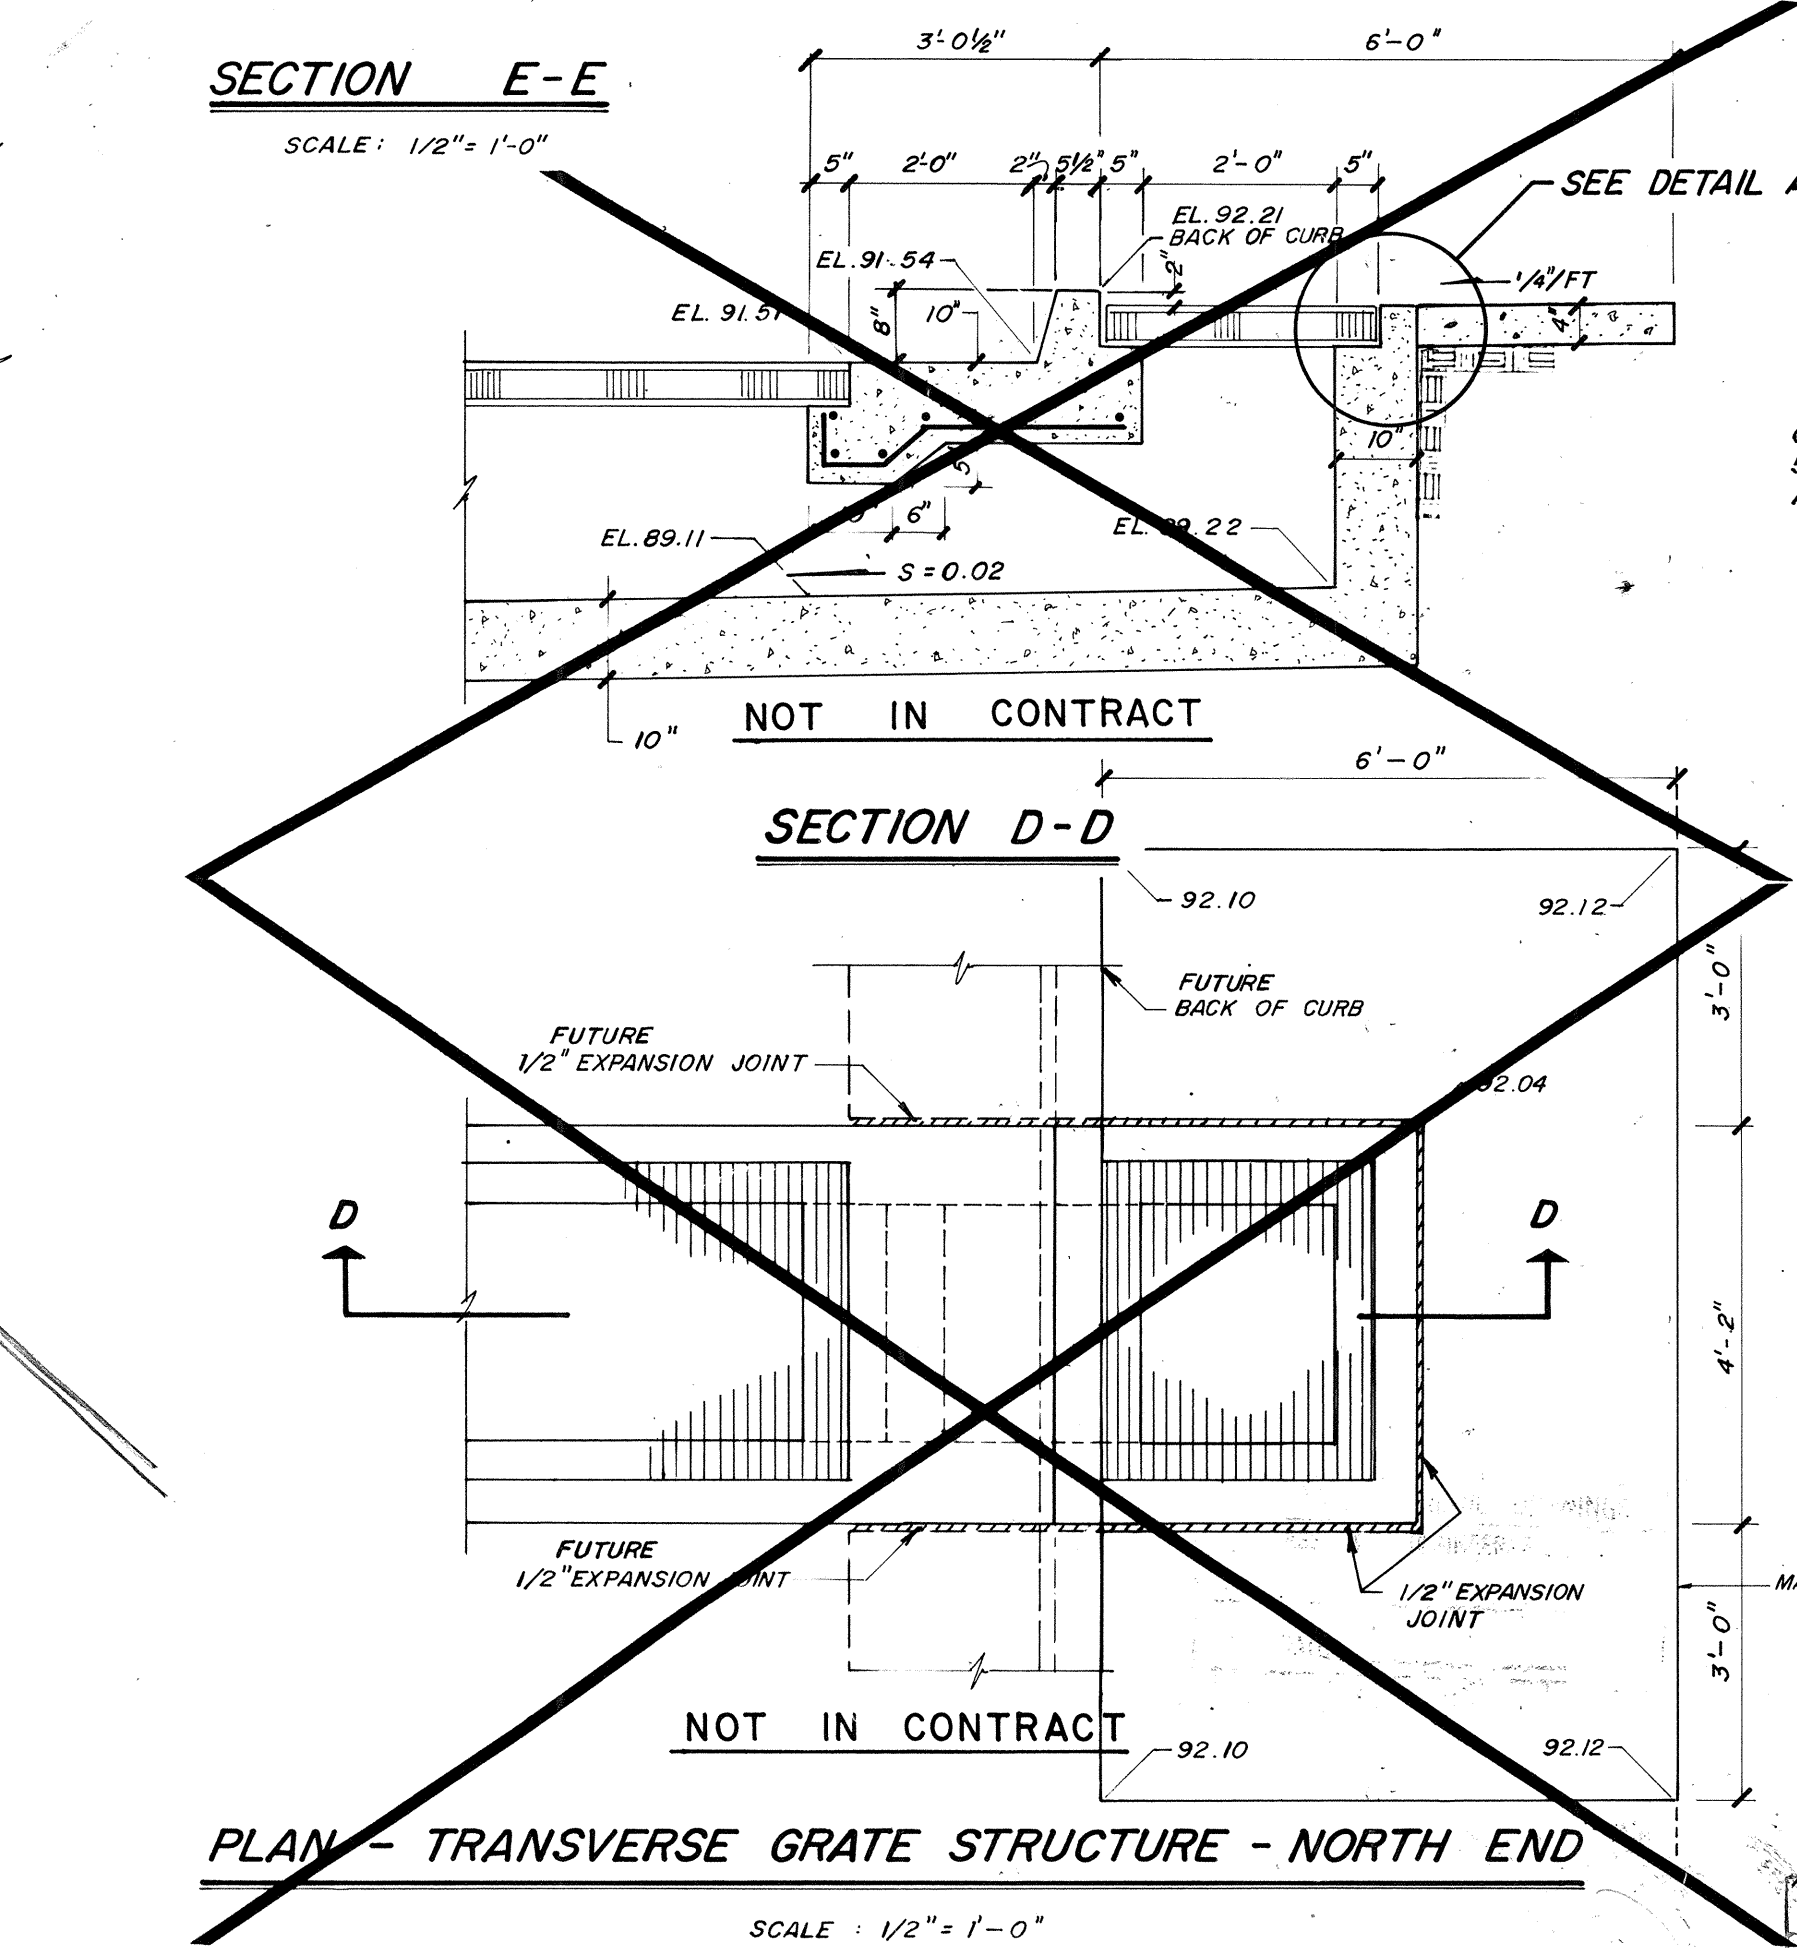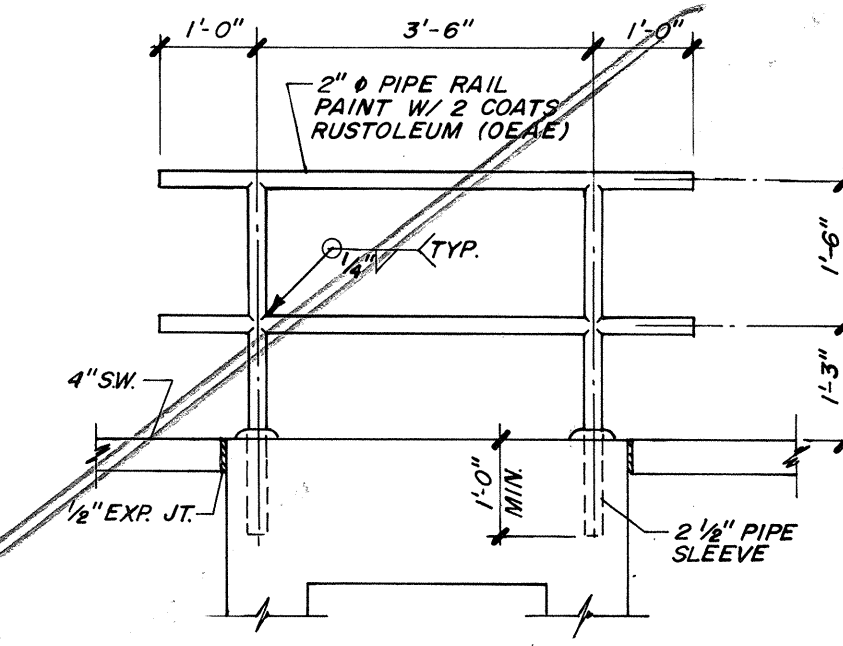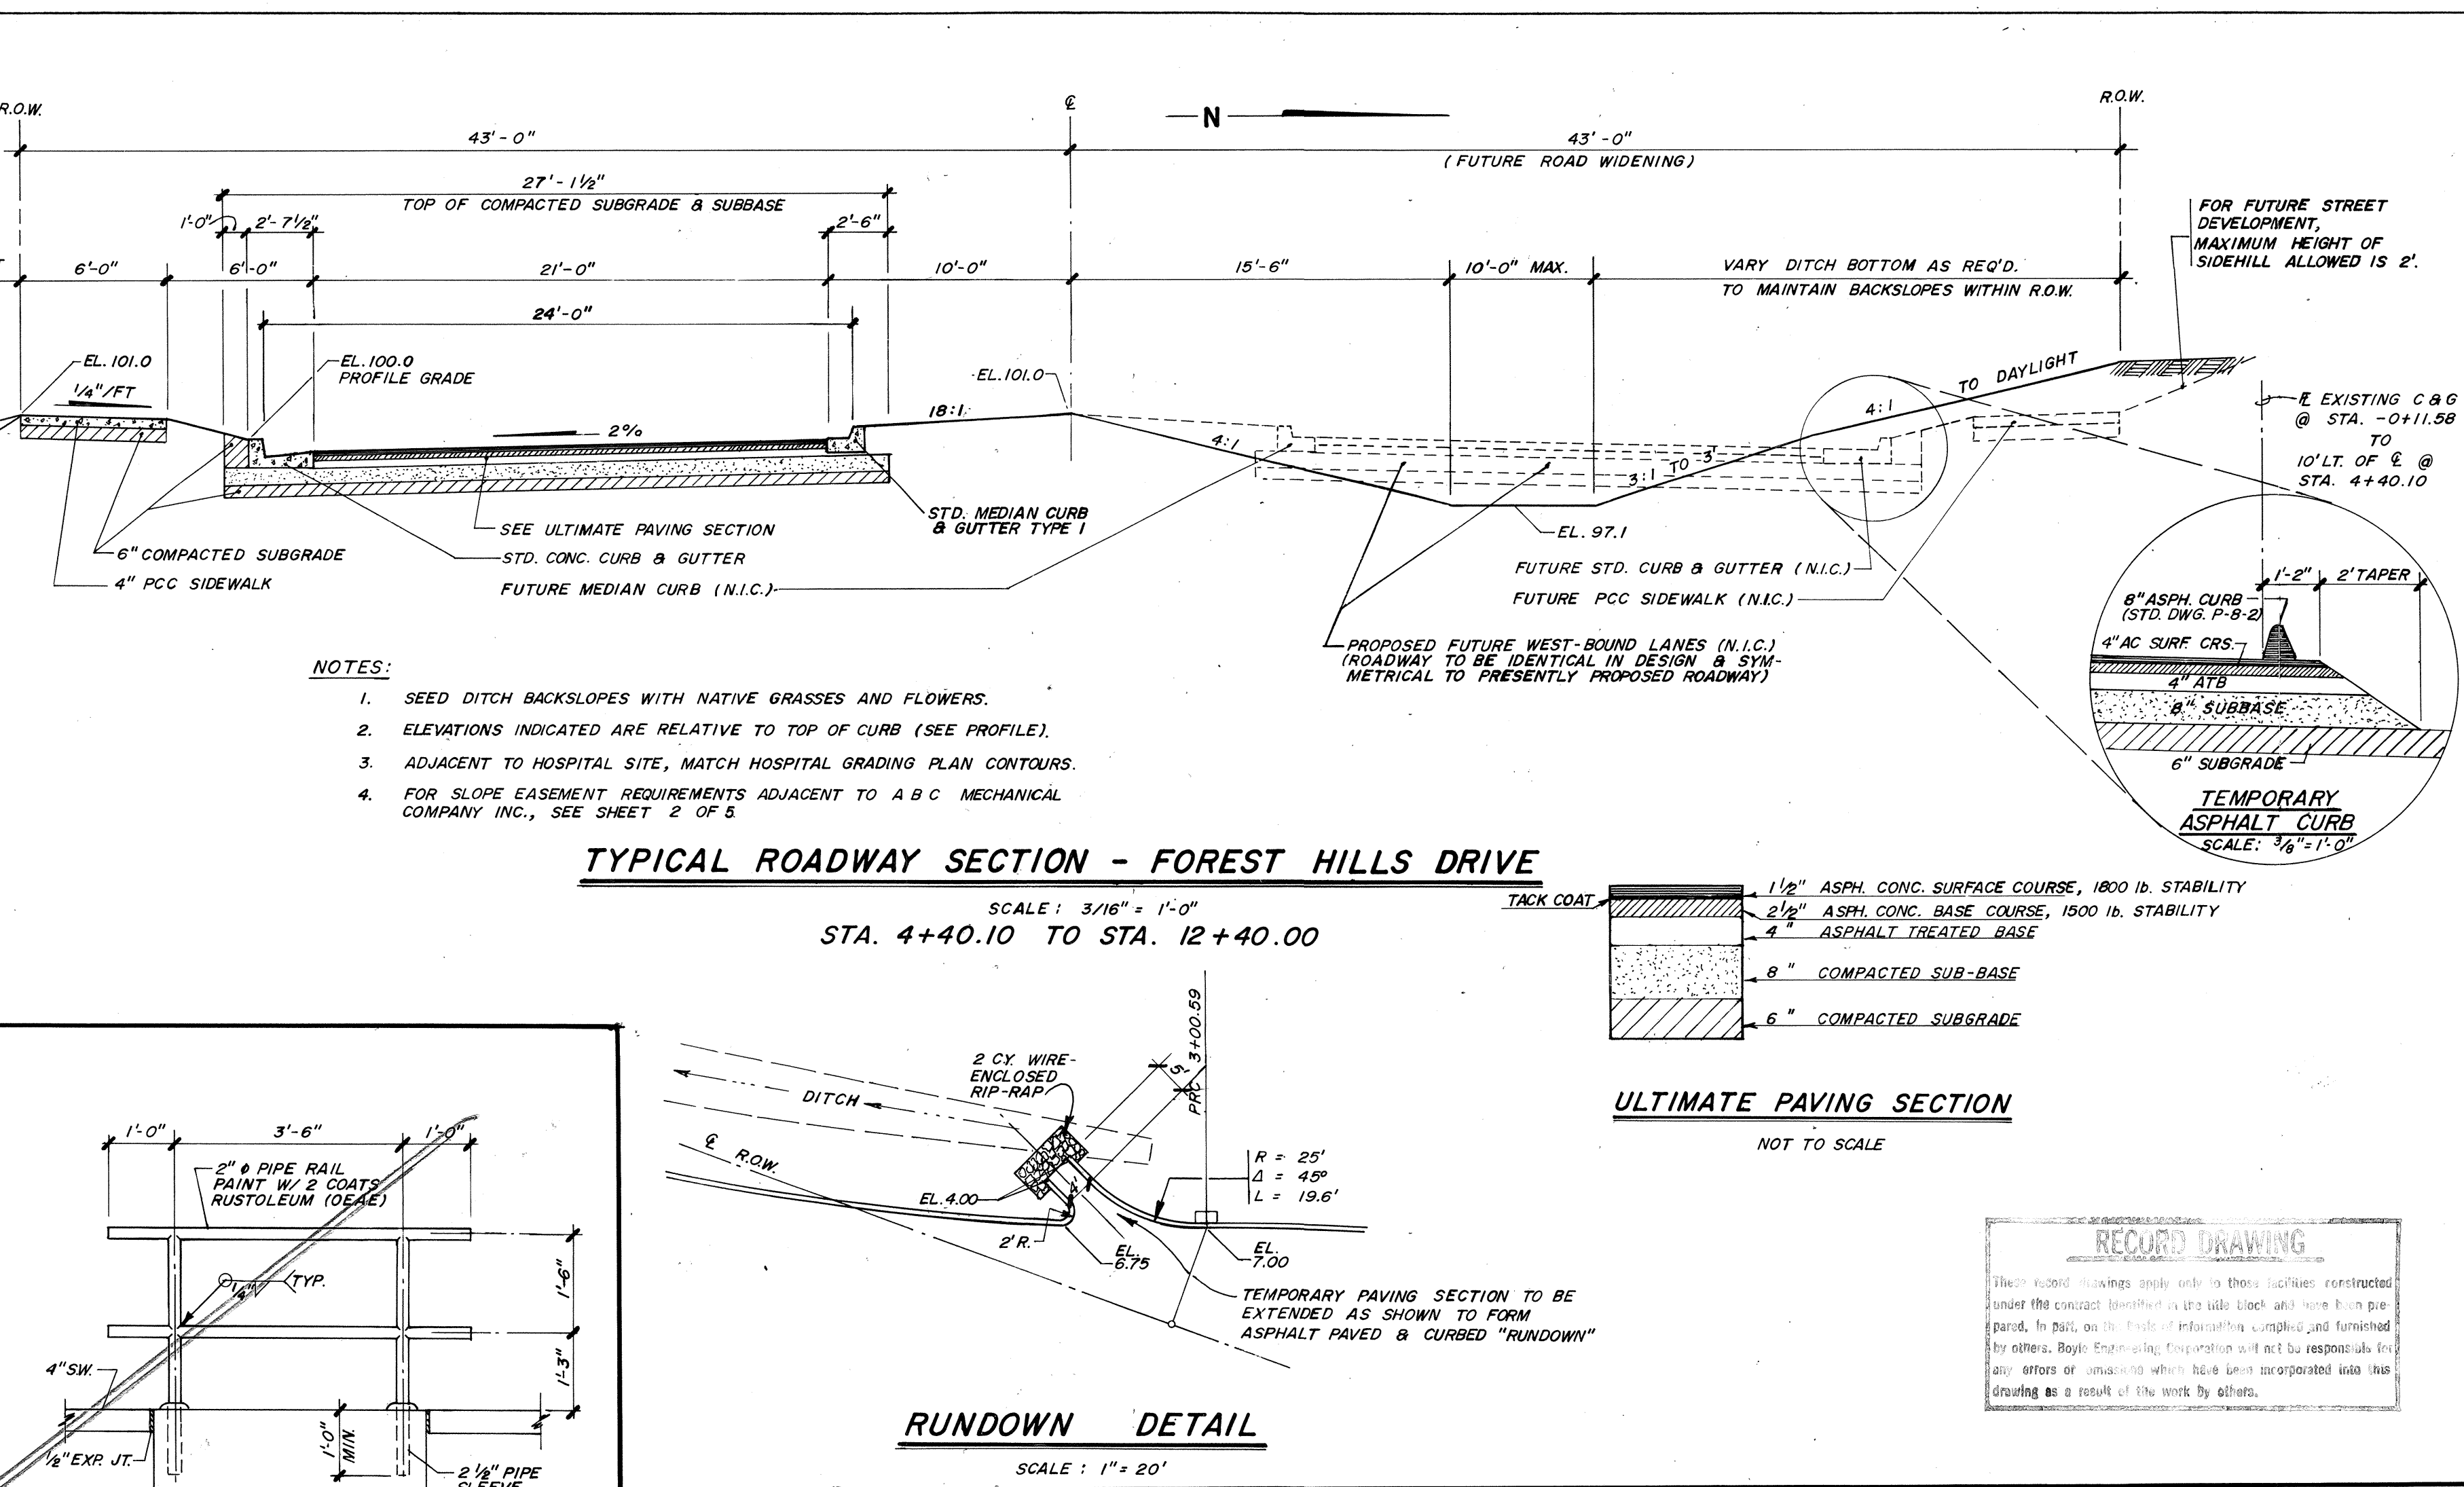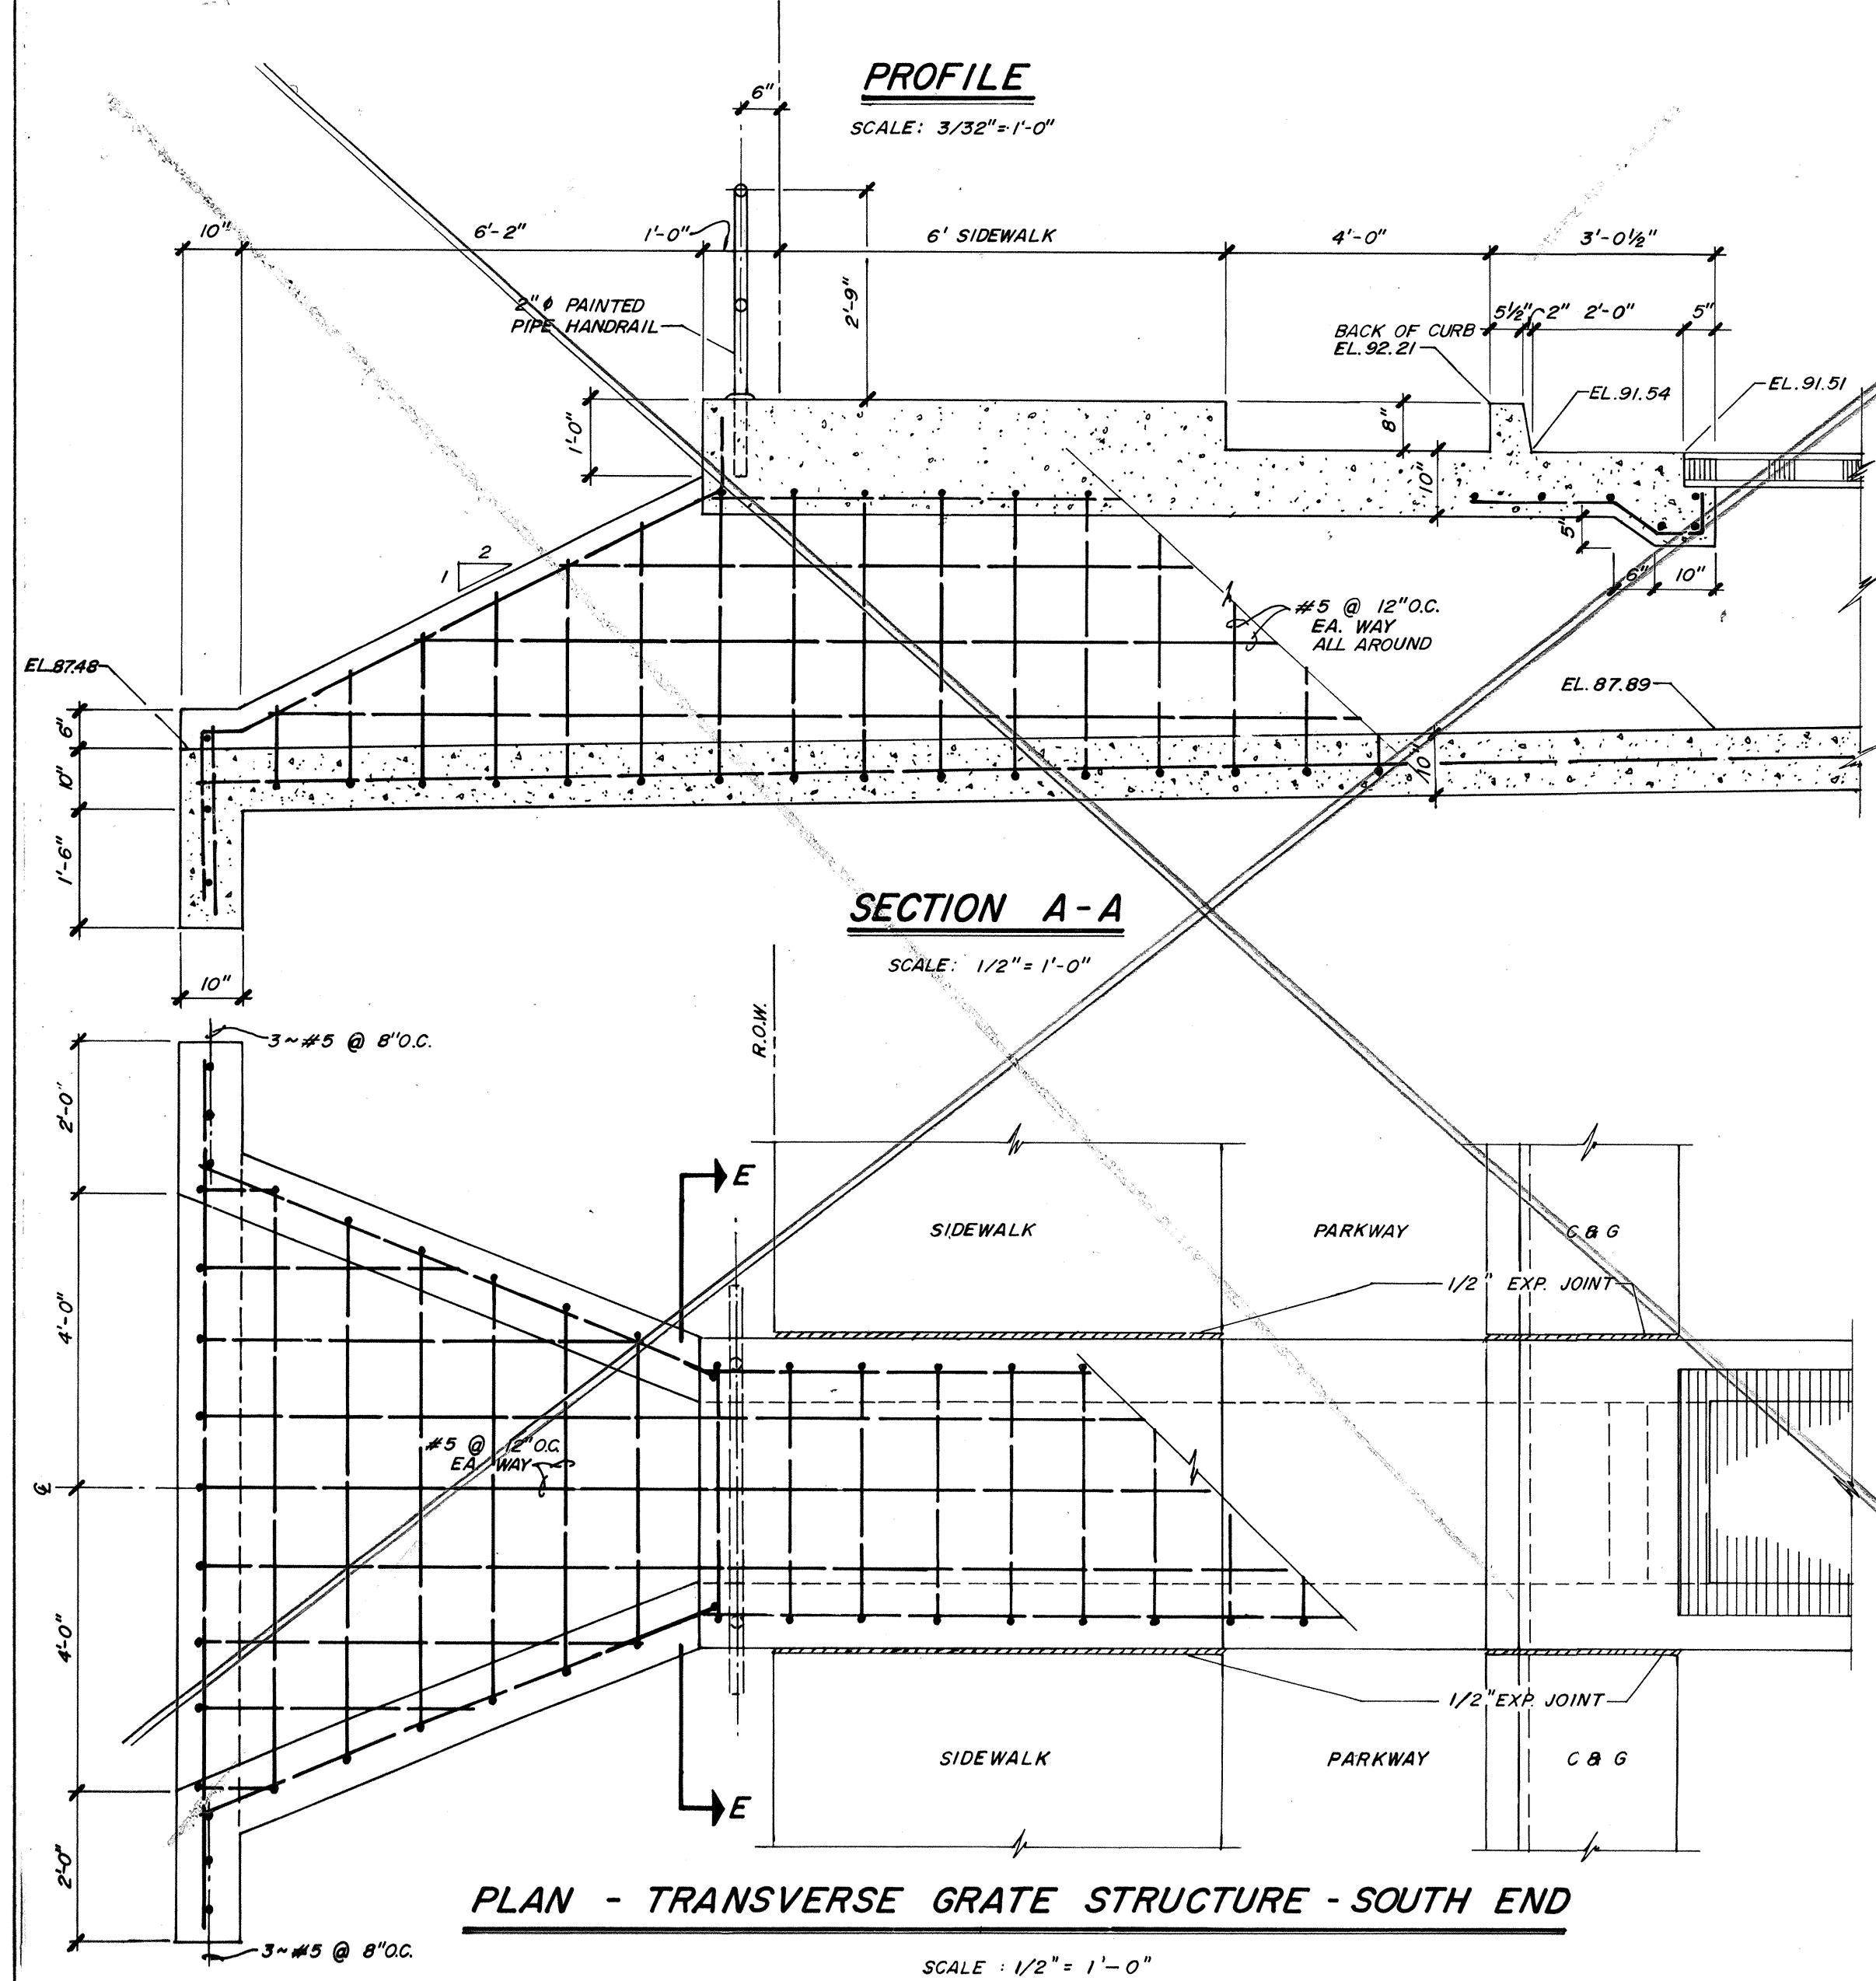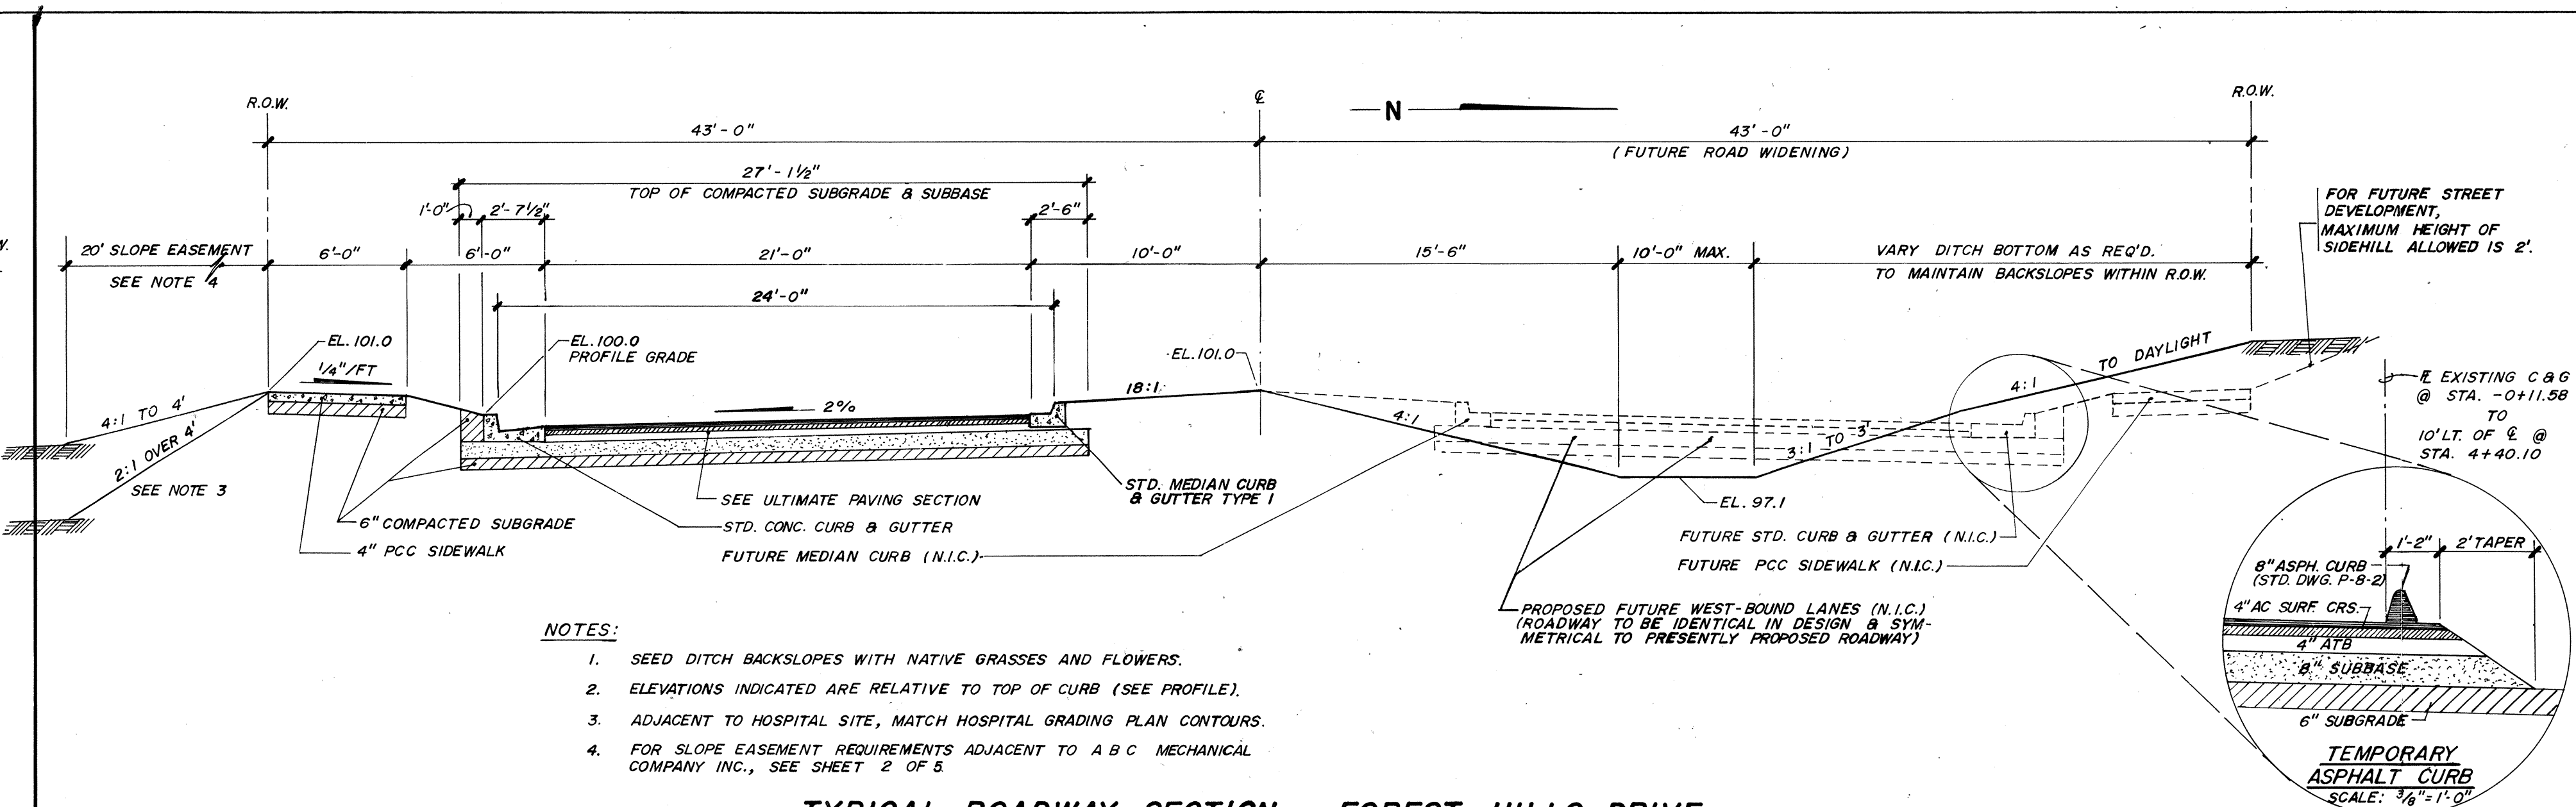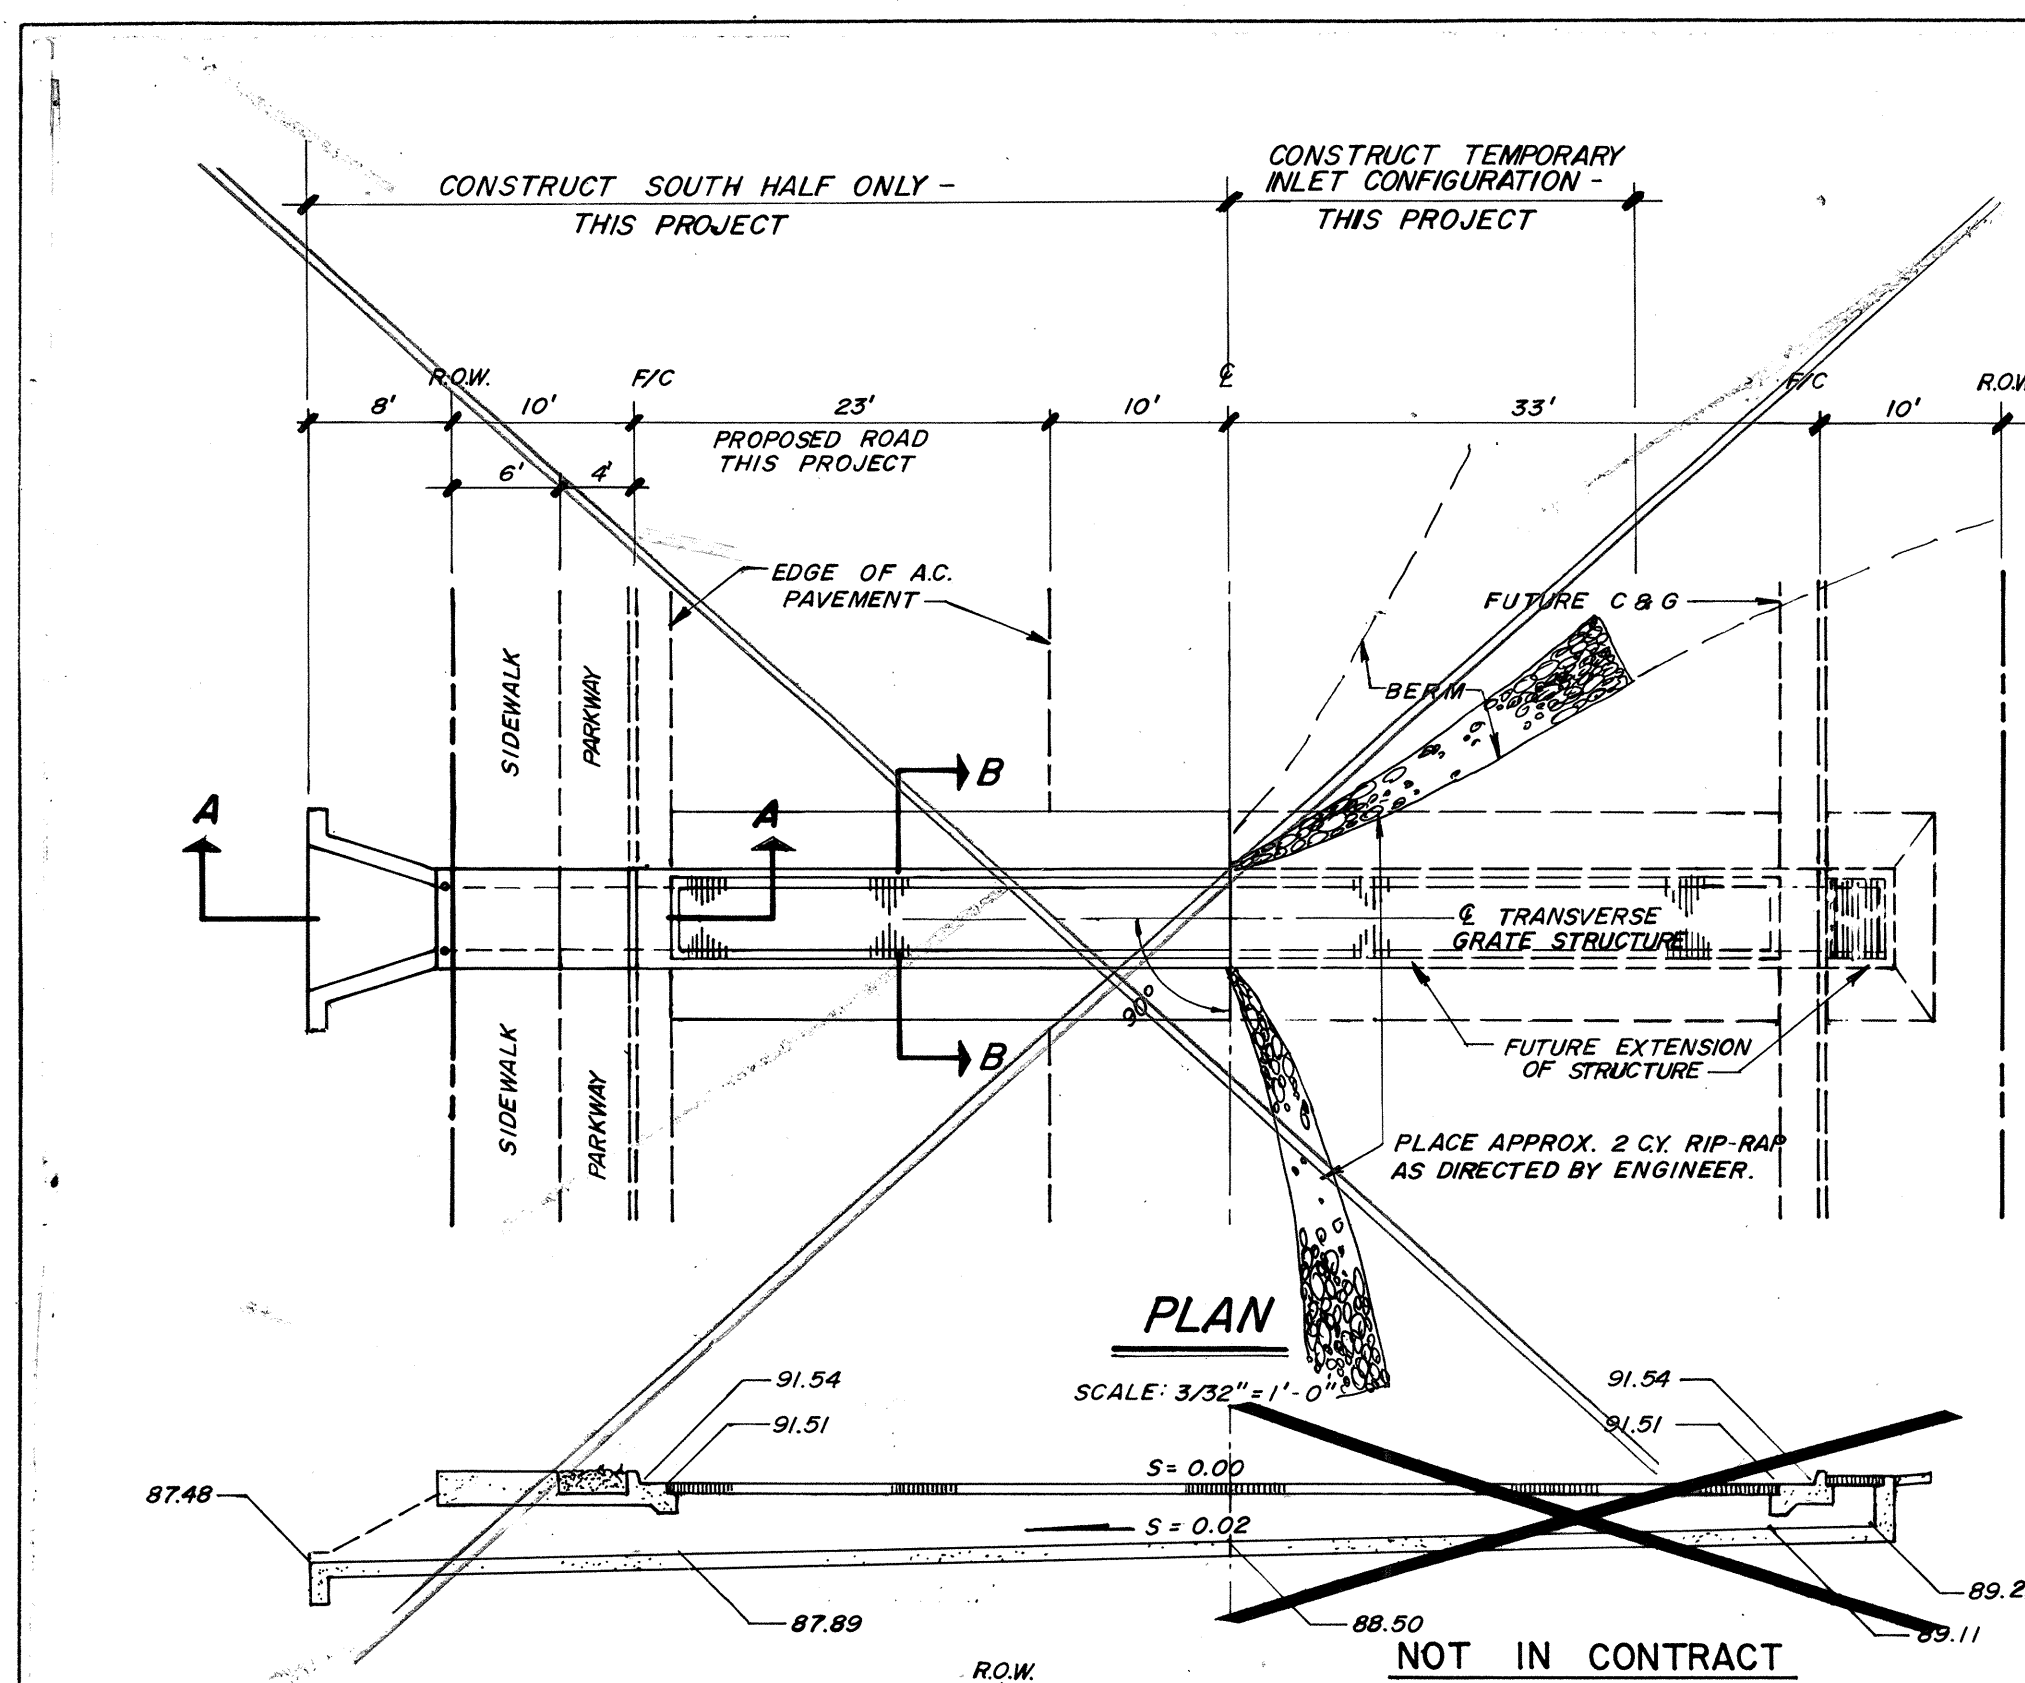[illegible]