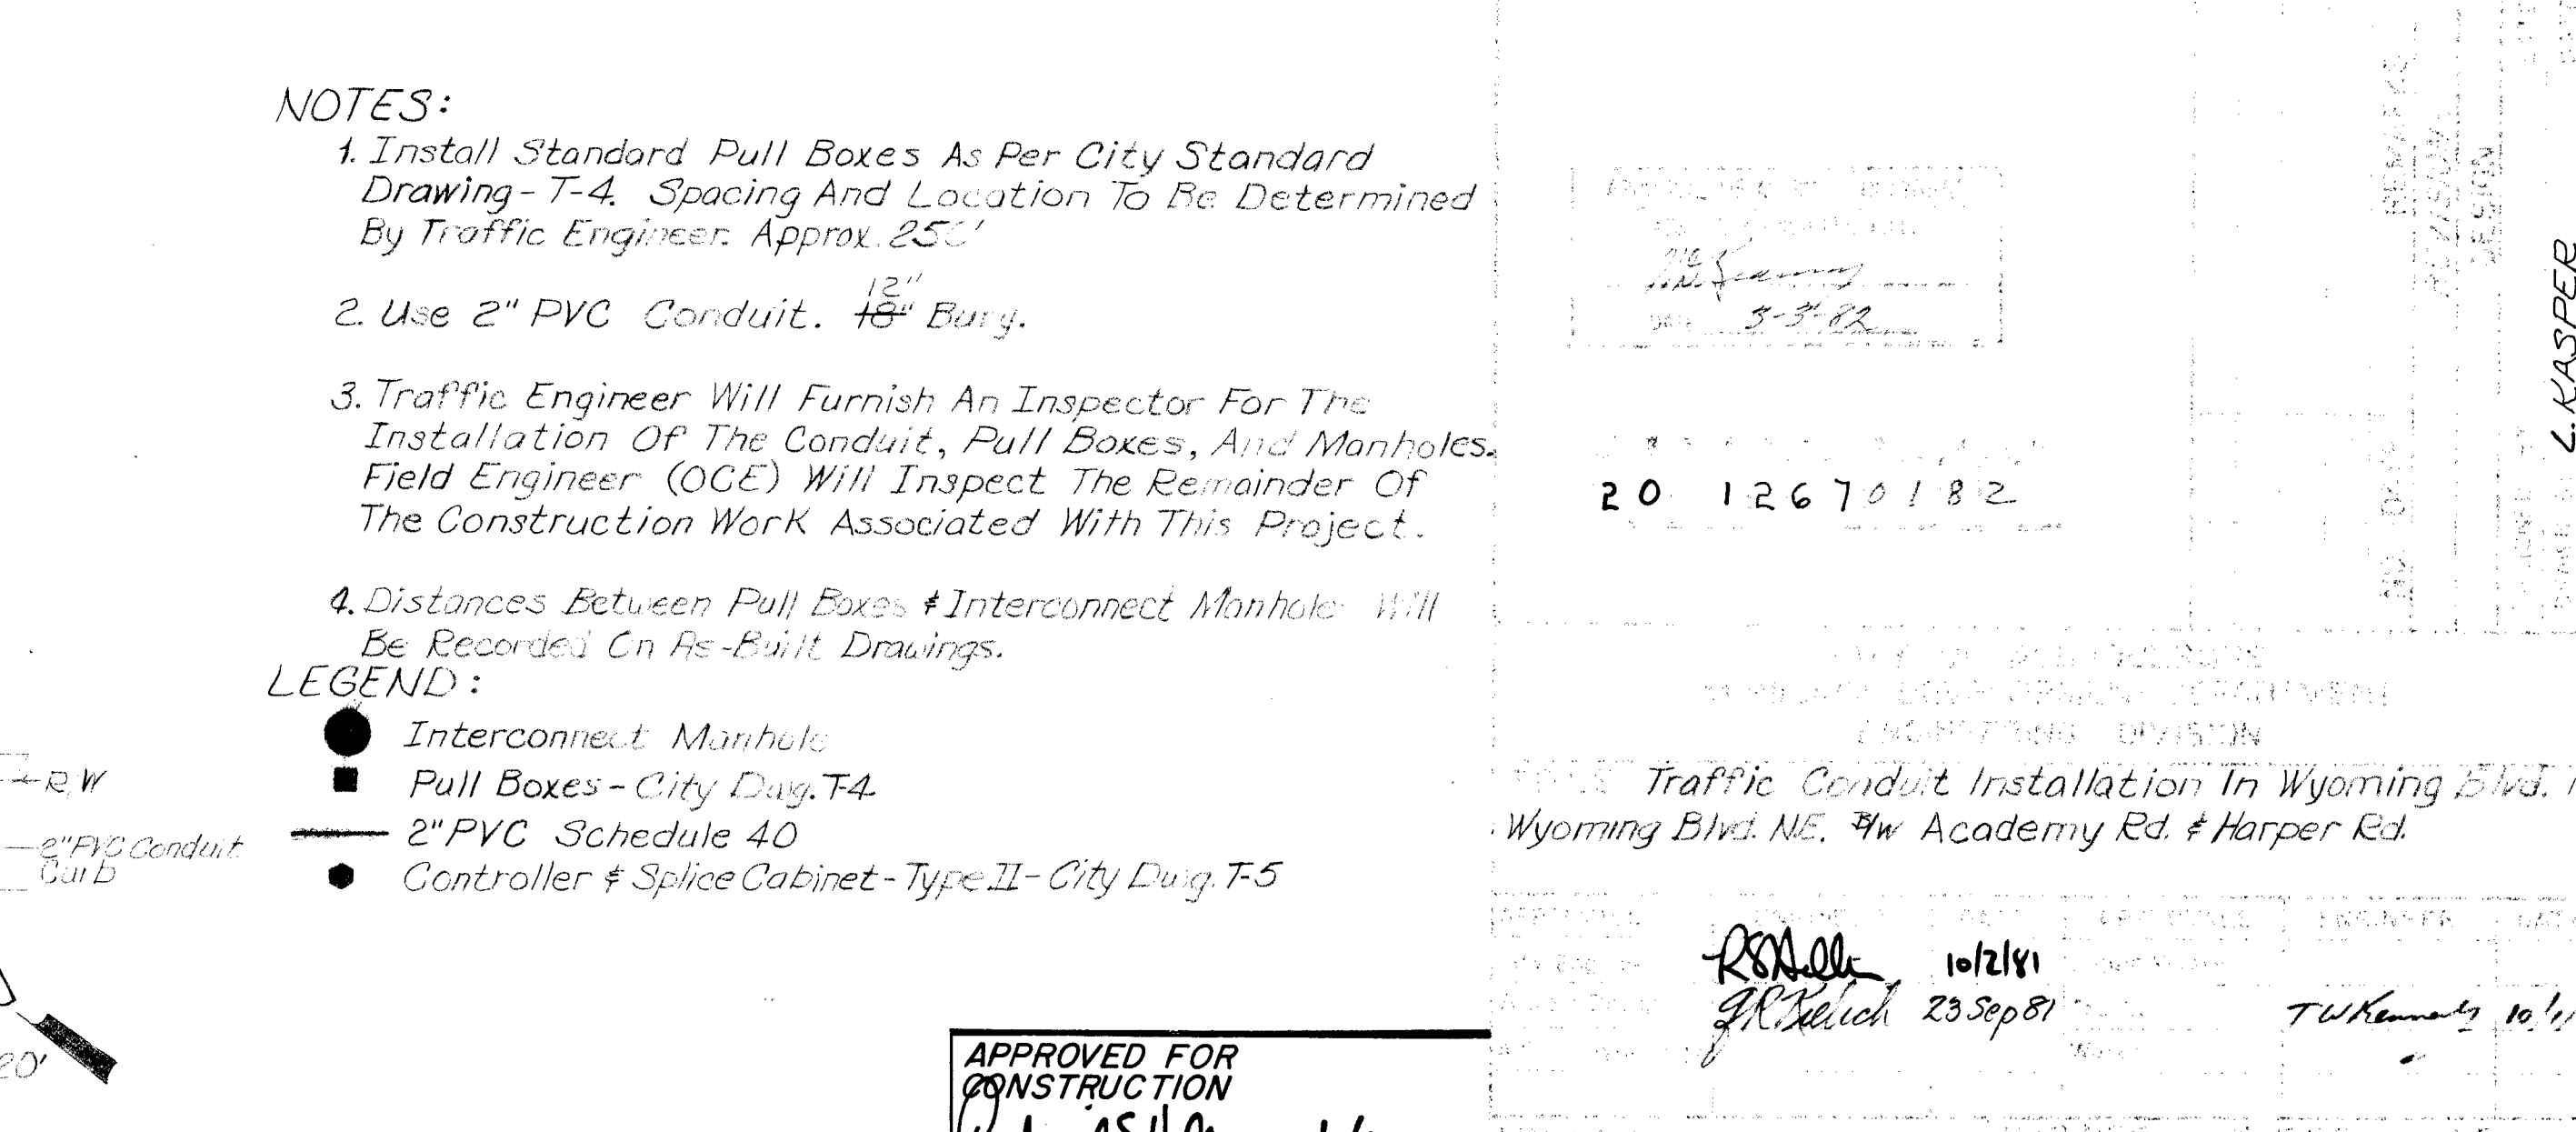
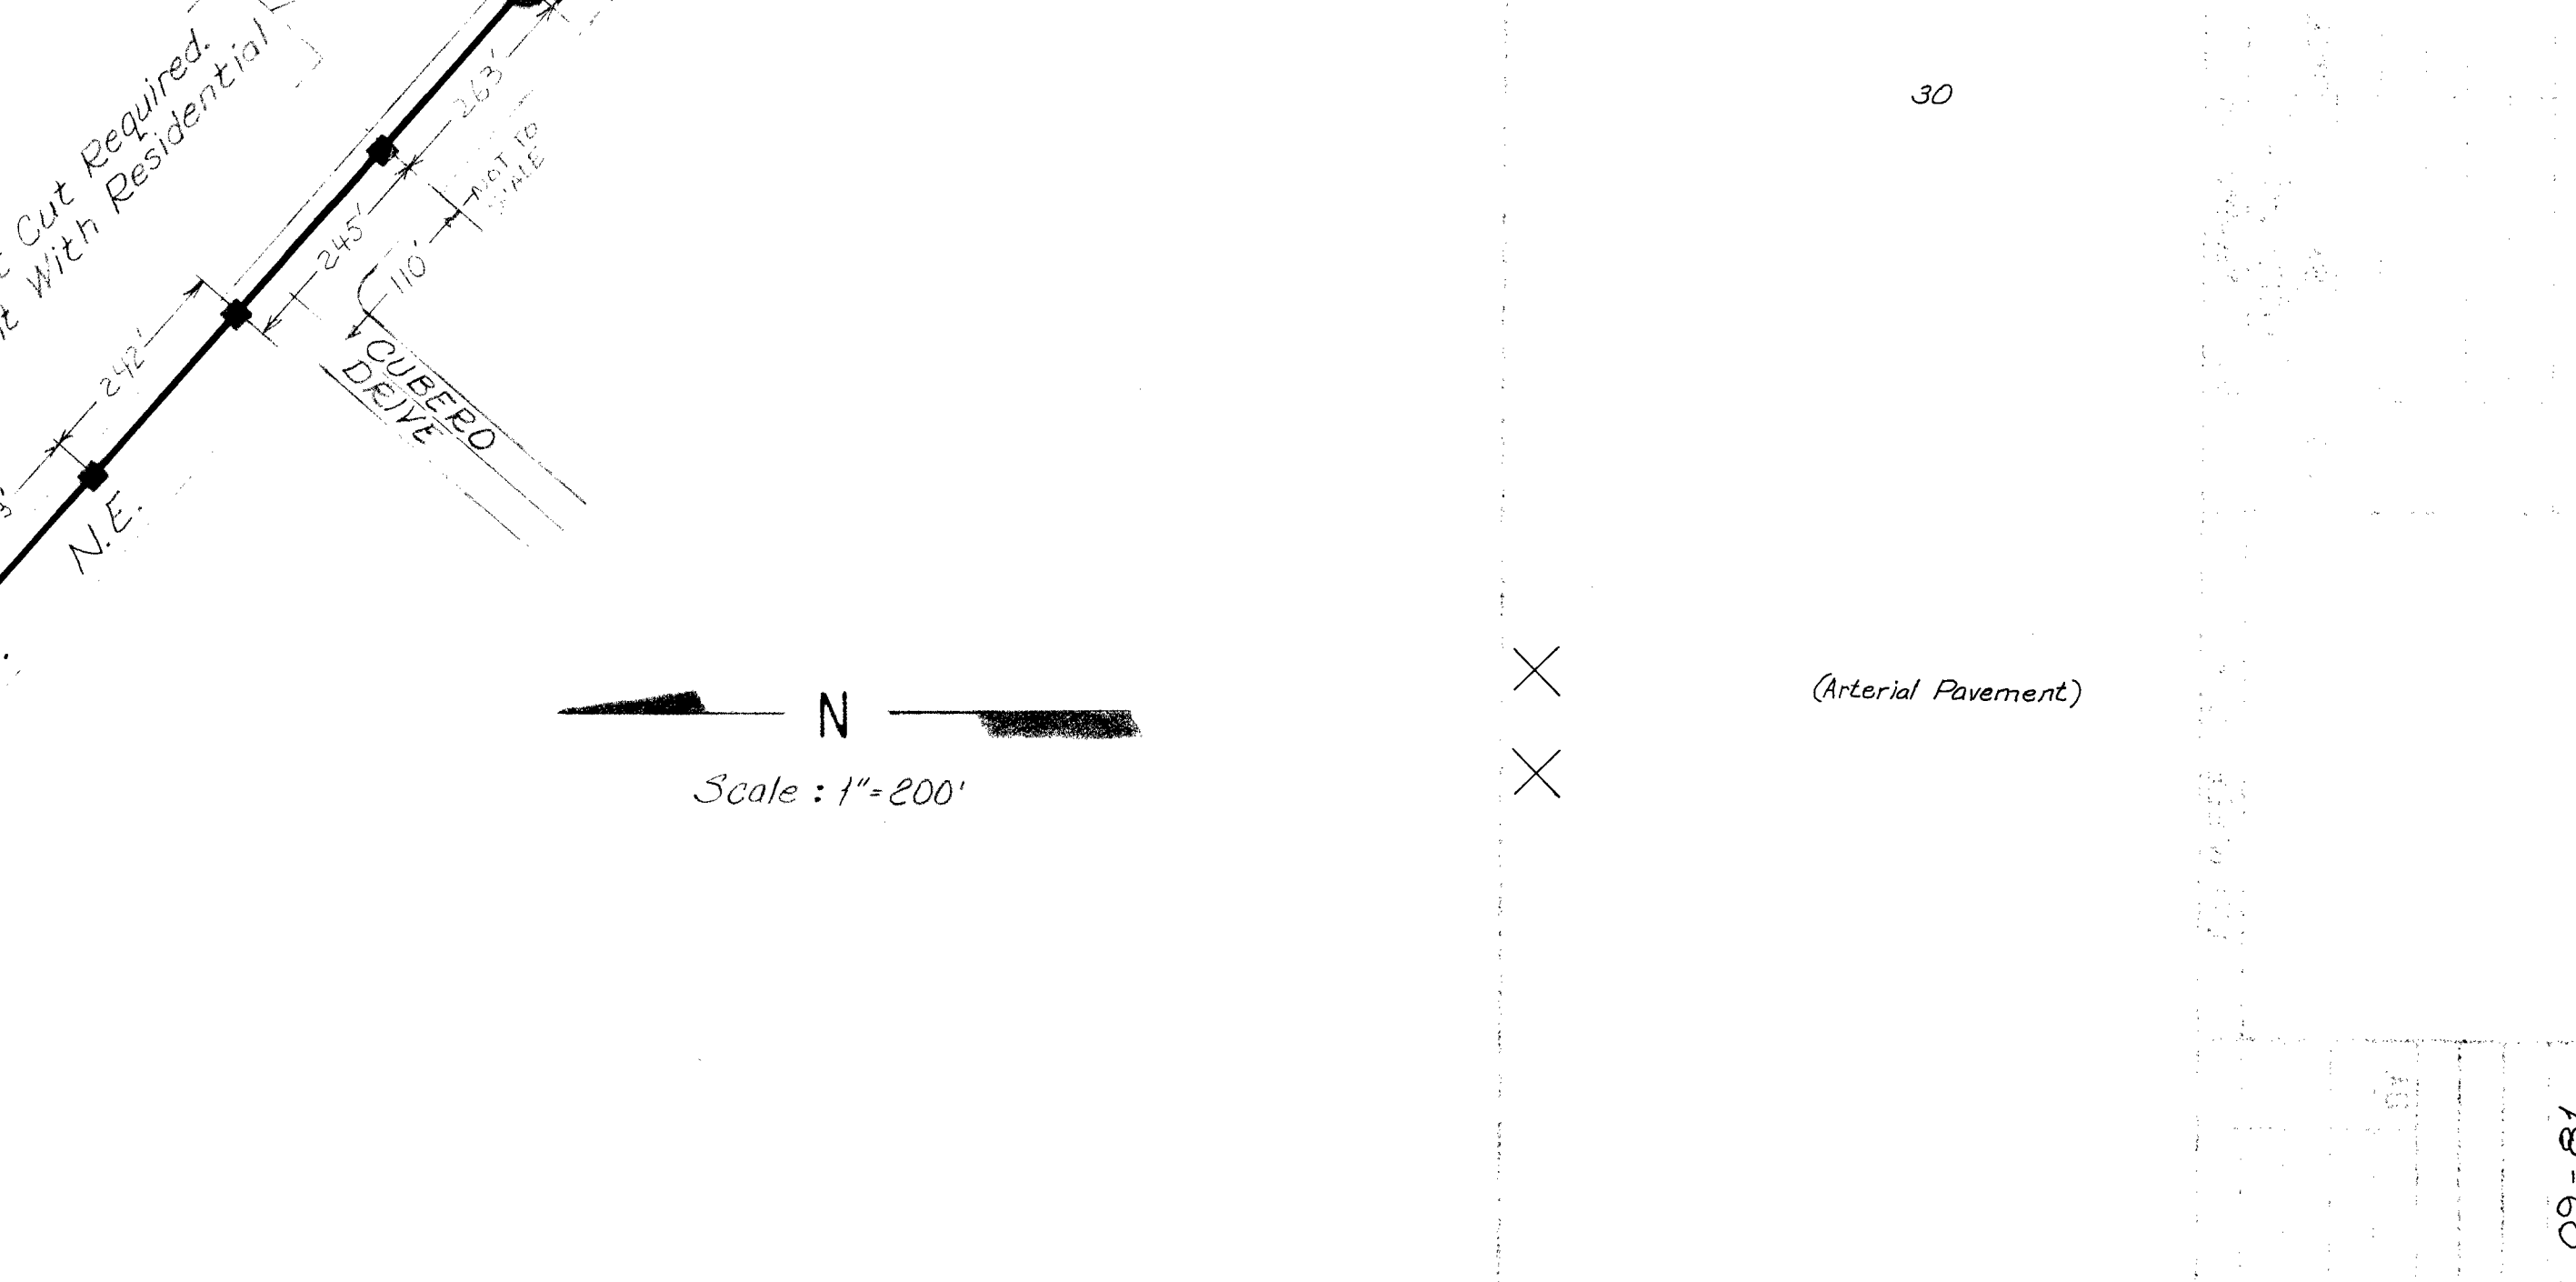
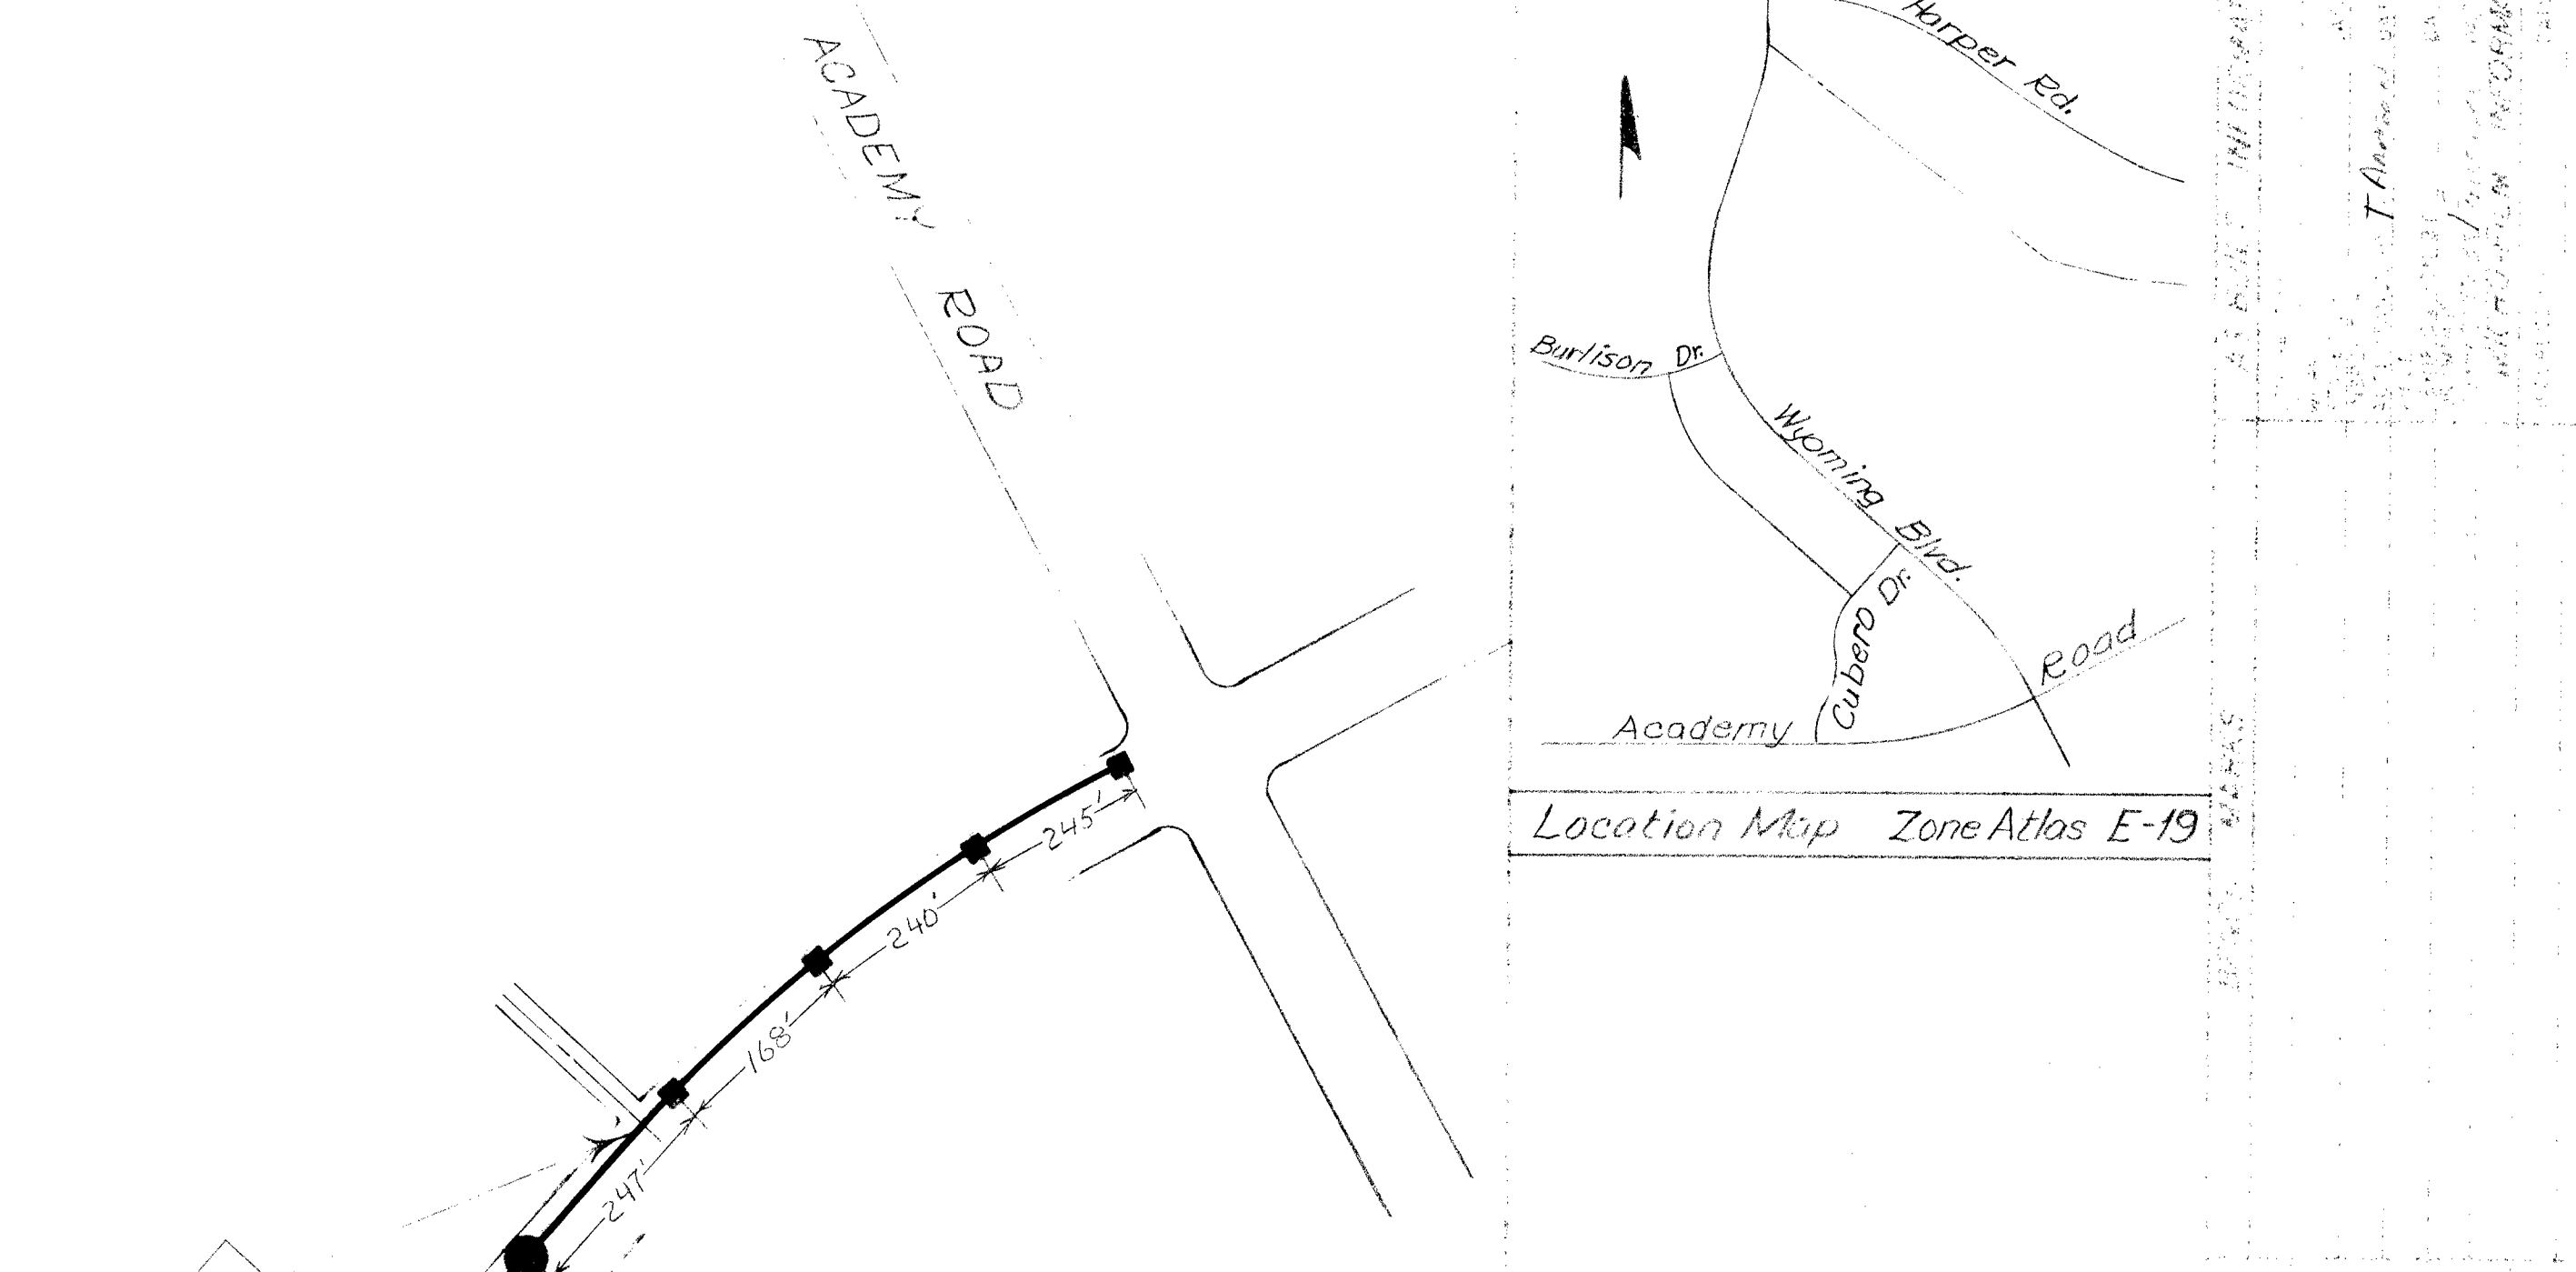
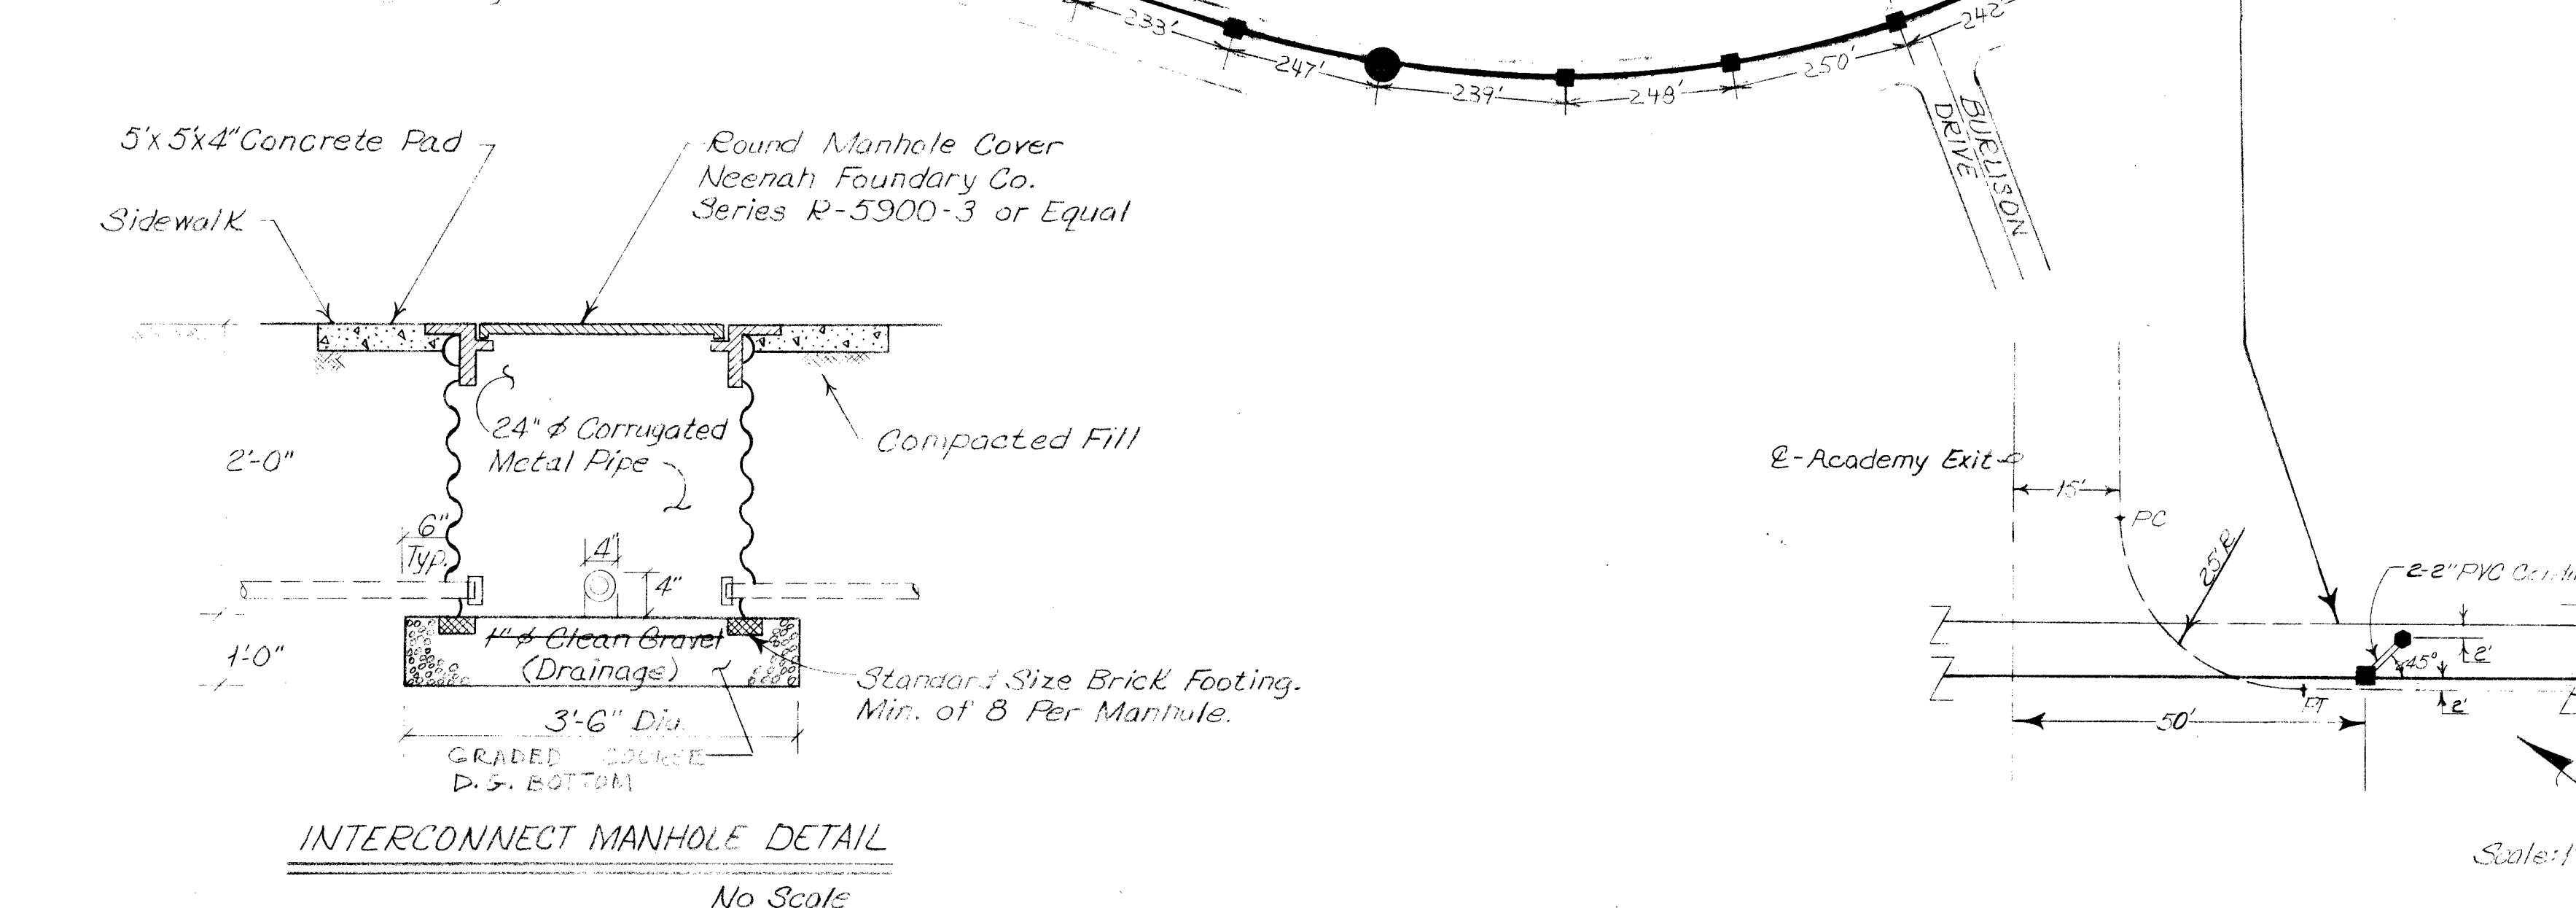
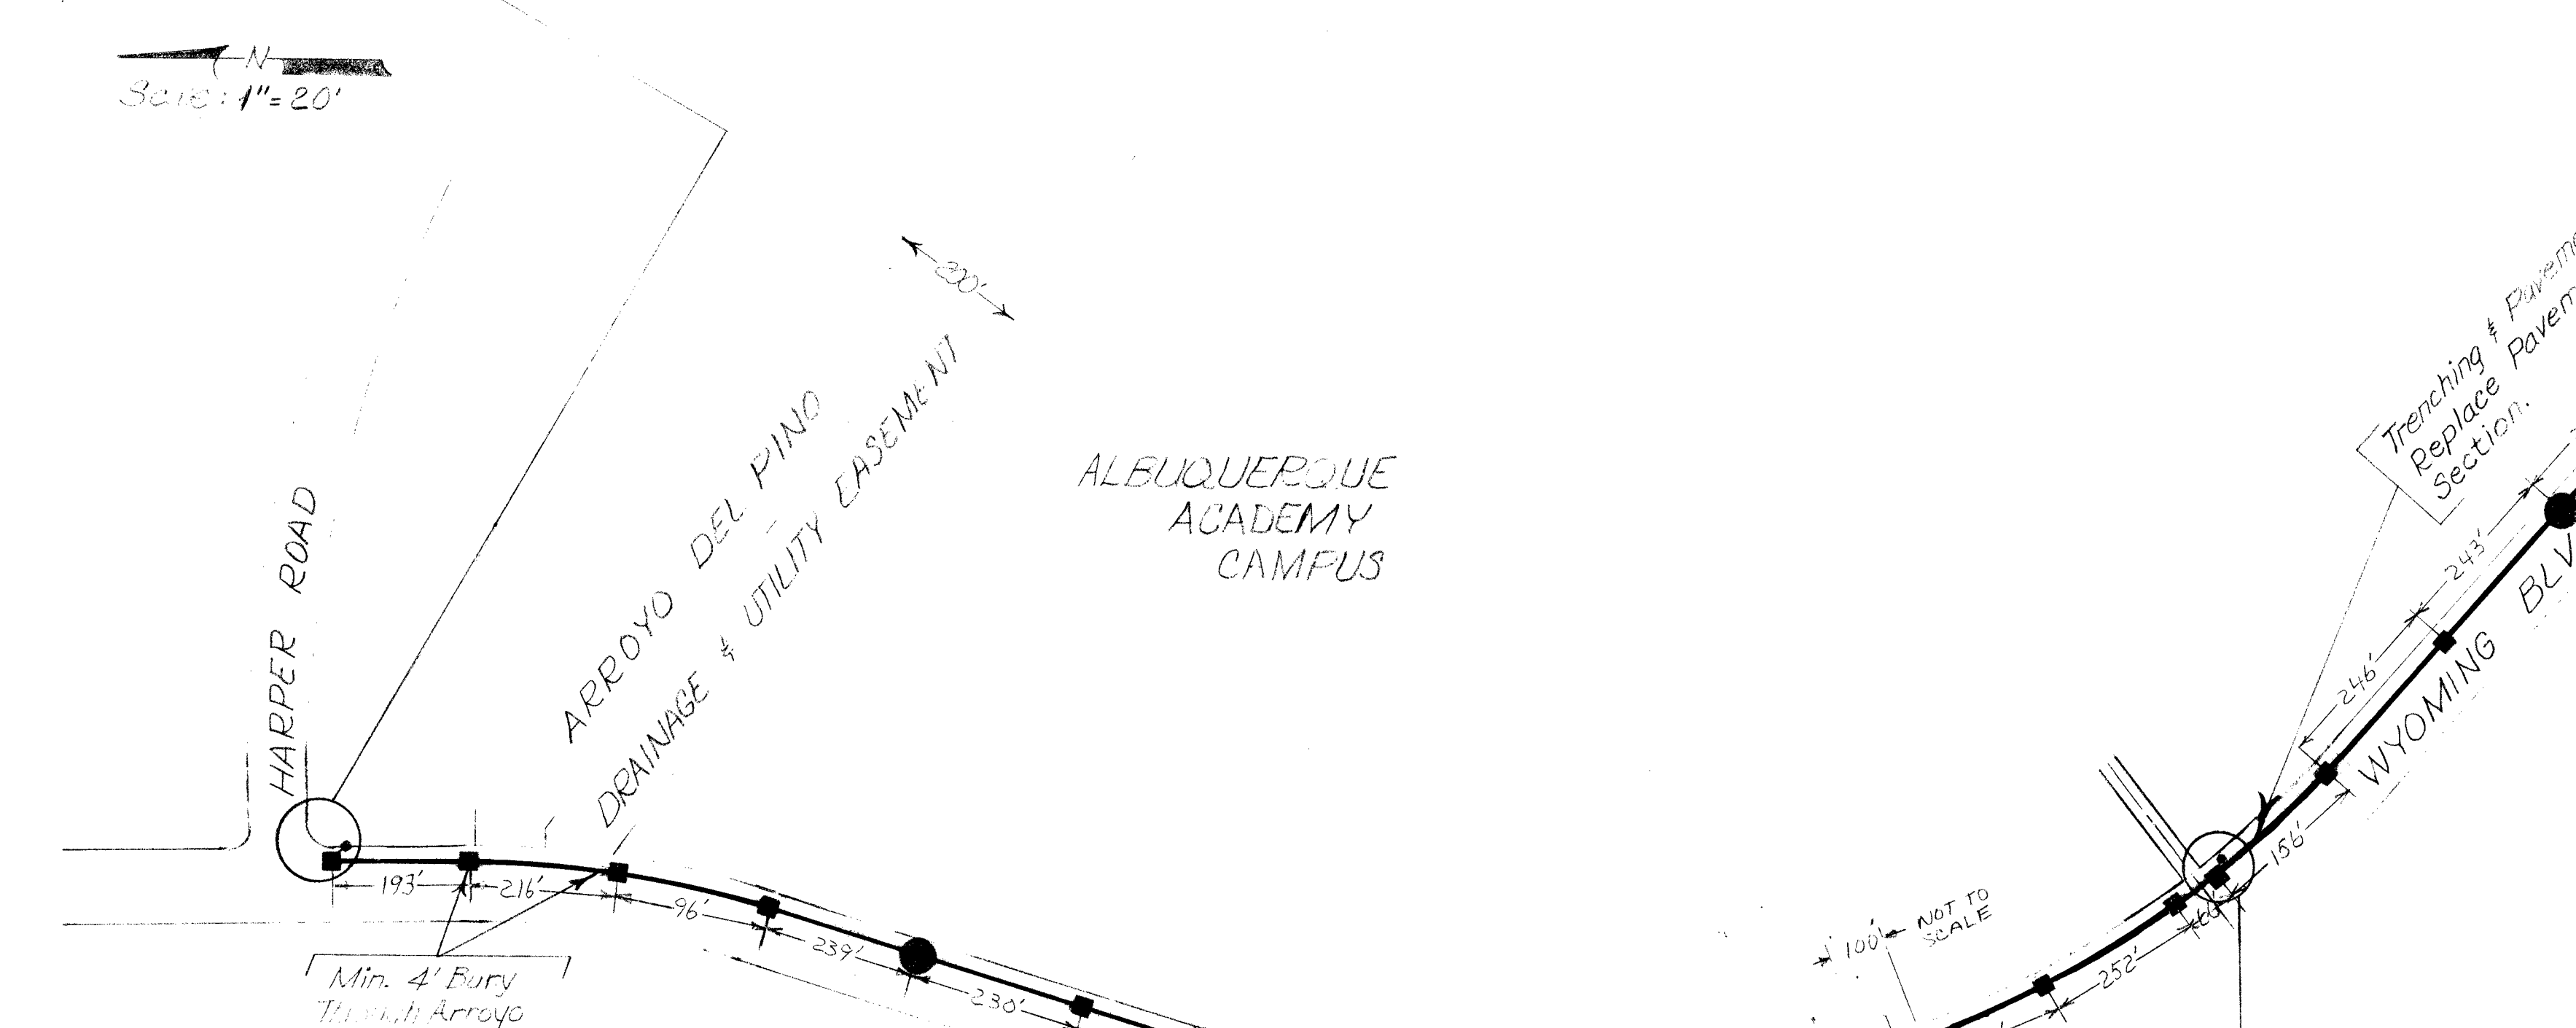
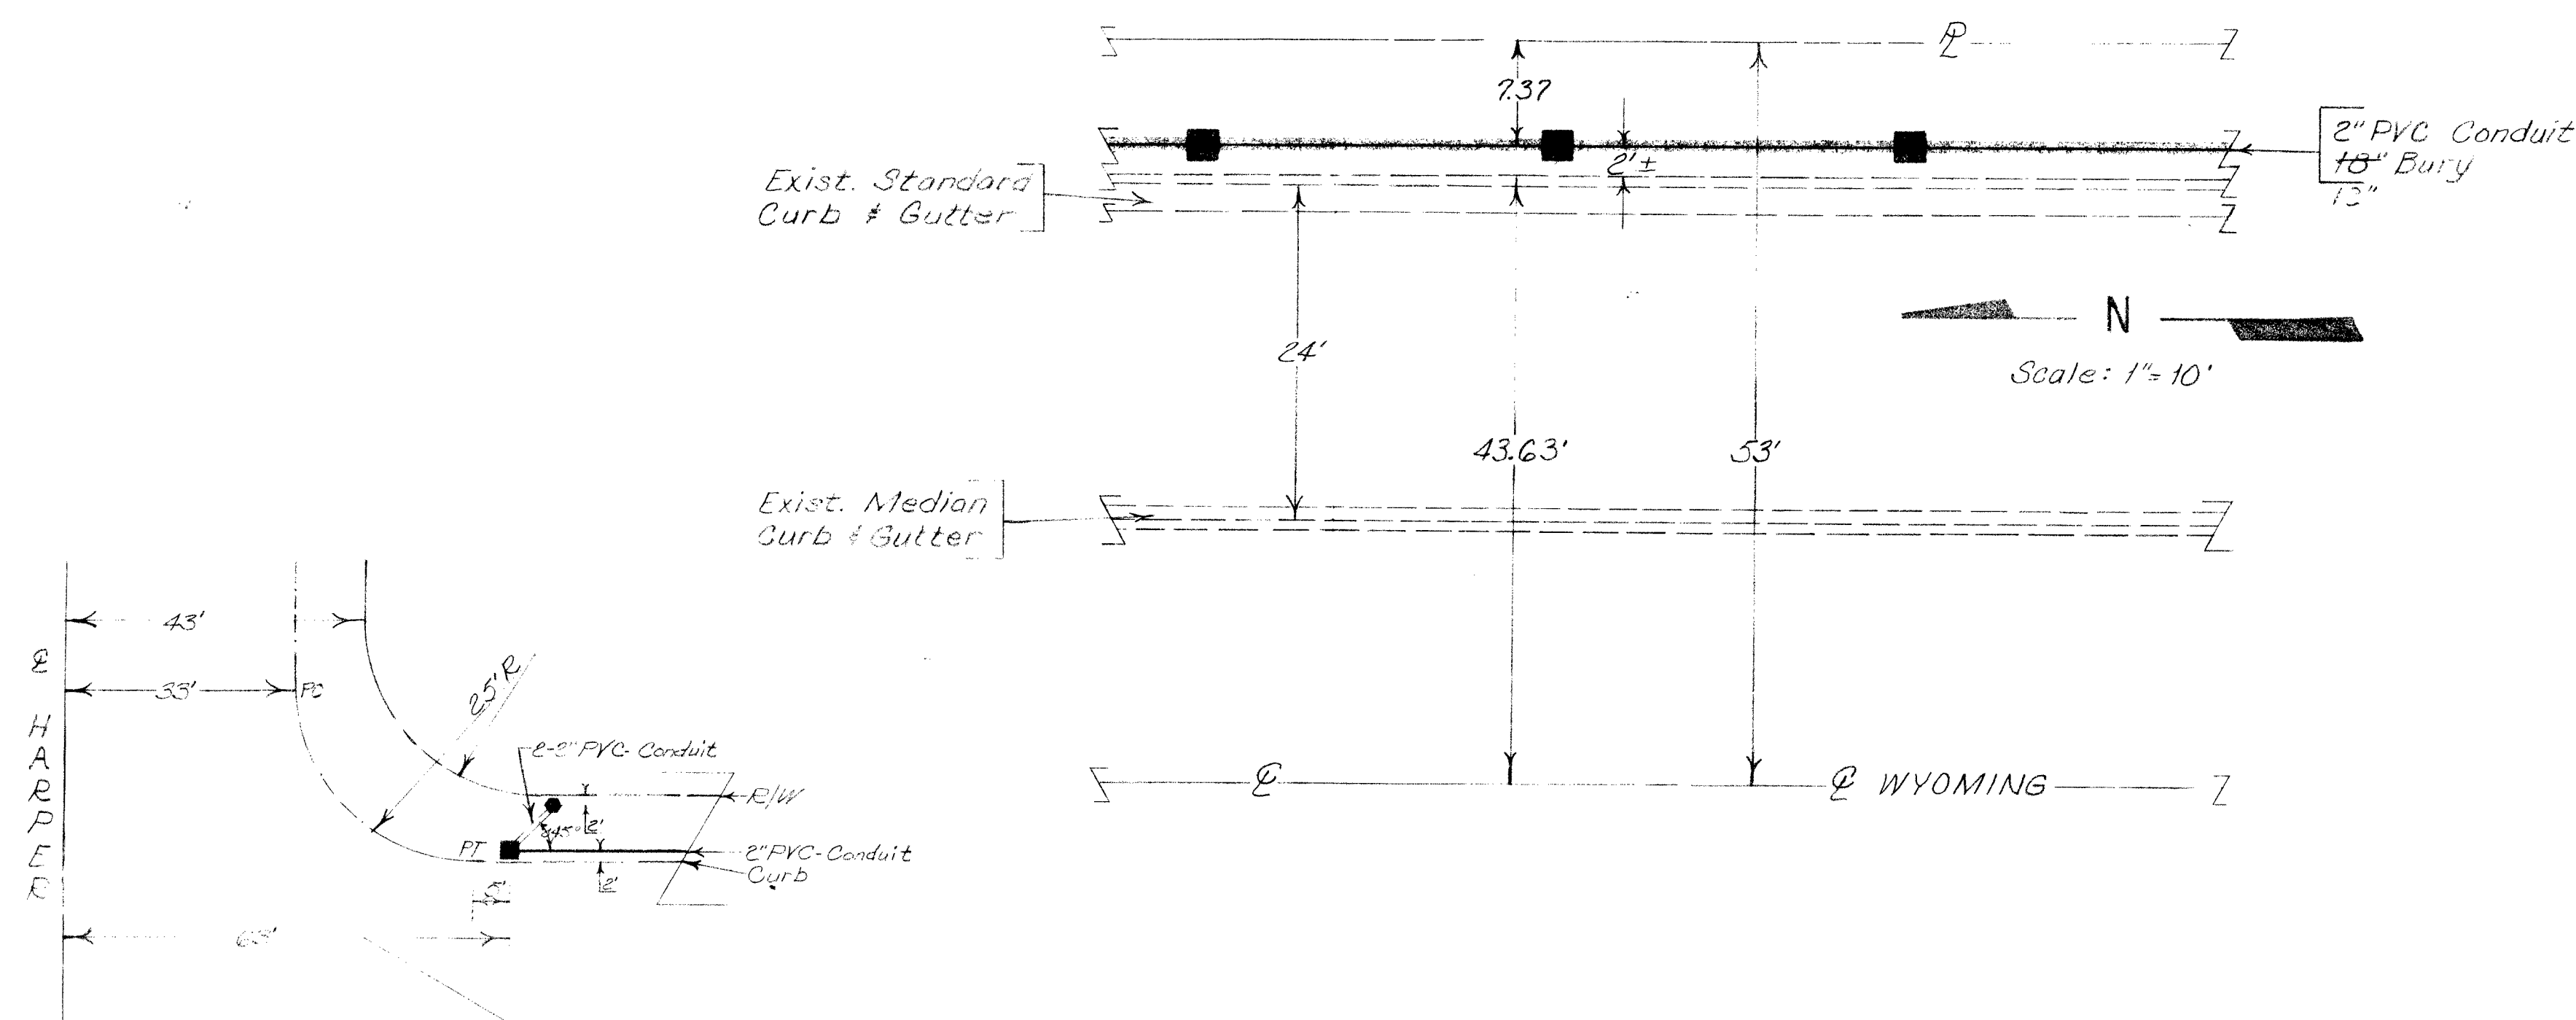


NOTES:

1. Install Standard Pull Boxes As Per City Standard Drawing-T-4. Spacing And Location To Be Determined By Traffic Engineer. Approx. 250'
2. Use 2" PVC Conduit. 18" Bury.
3. Traffic Engineer Will Furnish An Inspector For The Installation Of The Conduit, Pull Boxes, And Manholes. Field Engineer (OGE) Will Inspect The Remainder Of The Construction Work Associated With This Project.
4. Distances Between Pull Boxes & Interconnect Manhole Will Be Recorded On As-Built Drawings.

LEGEND:

- Interconnect Manhole
- Pull Boxes - City Dwg. T-4
- 2" PVC Schedule 40
- Controller & Splice Cabinet - Type II - City Dwg. T-5

APPROVED FOR
CONSTRUCTION
CITY ENGINEER
DATE

10/6/81

1267

E-19

1

1