


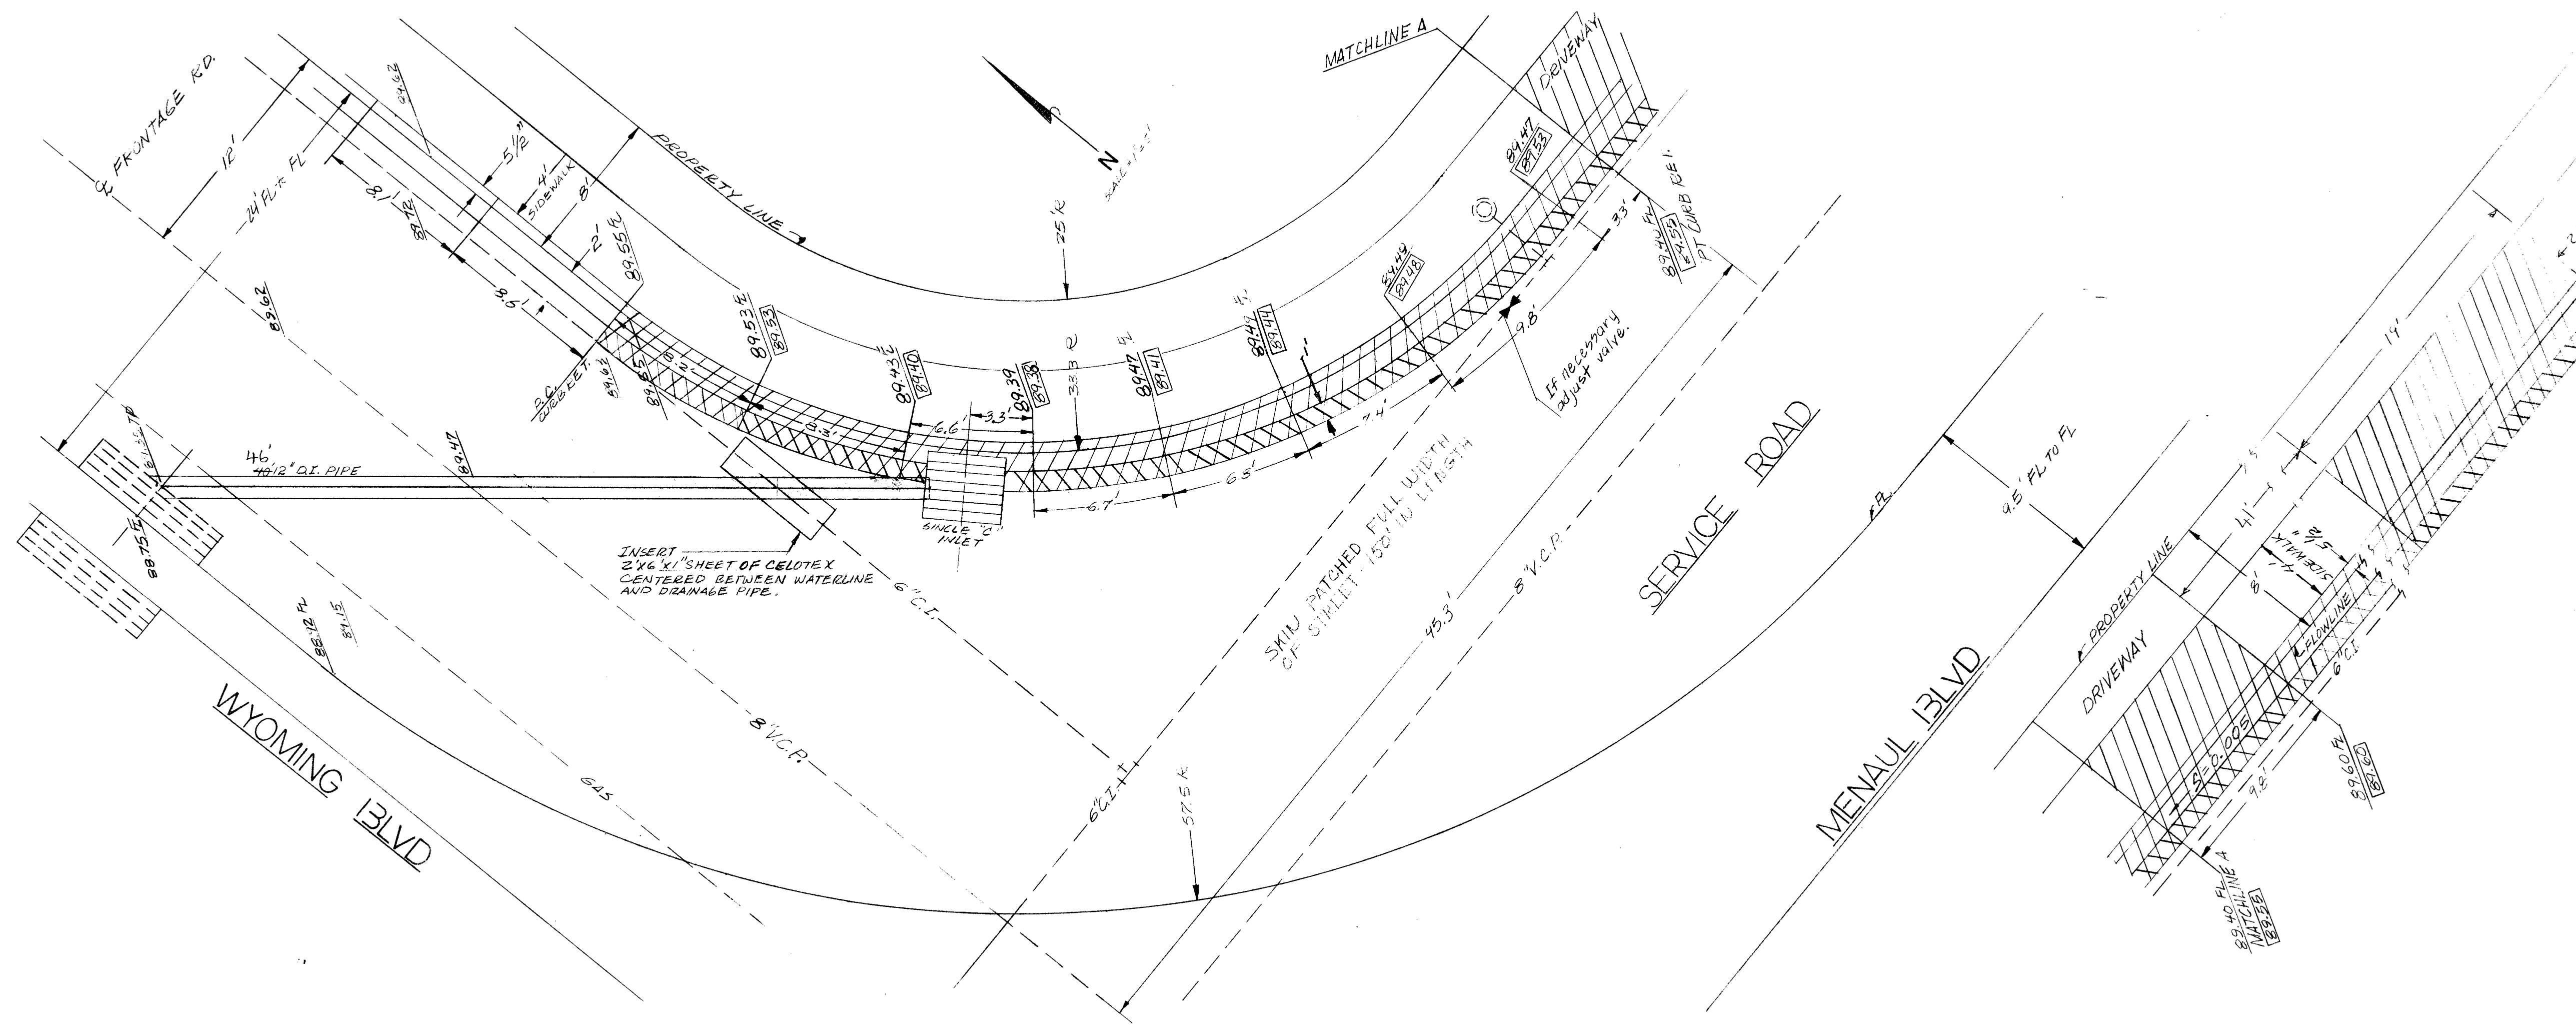

"NOTICE TO CONTRACTORS"

- 1) New Mexico Standard Specification for Public Works Construction - 1979 Edition will be referred to hereon as the "Standard Specification."
- 2) All work detailed on these plans to be performed under contract shall, except as otherwise stated or provided for herein, be constructed in accordance with "Contract Documents for City-Wide Utilities and Cash Paving No. 30" and the "Standard Specification."
- 3) Two working days prior to any excavation, contractor must contact Line Locating Service, 763-1234, for location of existing utilities.
- 4) Prior to construction, the contractor shall excavate and verify the horizontal and vertical locations of all obstructions. Should a conflict exist, the contractor shall notify the engineer or surveyor so that the conflict can be resolved with minimum amount of delay.

THE FOLLOWING NOTES APPLY WHEN CHECKED


- ☐ All utilities and utility service lines shall be installed prior to paving.
- ☒ Backfill compaction shall be according to specified street use. (RESIDENTIAL)
- ☐ Tack coat requirements shall be determined by the City Engineer.
- ☐ Sidewalks and wheelchair ramps within the curb return shall be constructed wherever a new curb return is constructed.
- ☐ If curb is depressed for a driveway, the driveway shall be constructed prior to acceptance of the curb and gutter.
- ☐ All storm drainage facilities shall be completed prior to final acceptance.

NOTES:

1. Prior to cutting existing catch-basin and installing pipe, all utility lines in proposed area of pipe shall be exposed. Minor field adjustments may be required.
2. Remove existing curb & gutter and replace with new standard curb & gutter as per new grades.
3. Top of new curb to match existing sidewalk.
4. Remove and replace one foot wide pavement, adjacent to curb removal sections.

LEGEND

- REMOVE EXISTING AND INSTALL NEW STANDARD CURB & GUTTER.
- 89.54 EXISTING FLOWLINE ELEVATION.
- 89.84 NEW FLOWLINE ELEVATION.
- XXXX REMOVE EXISTING PAVEMENT AND REPLACE WITH RESIDENTIAL PAVING.

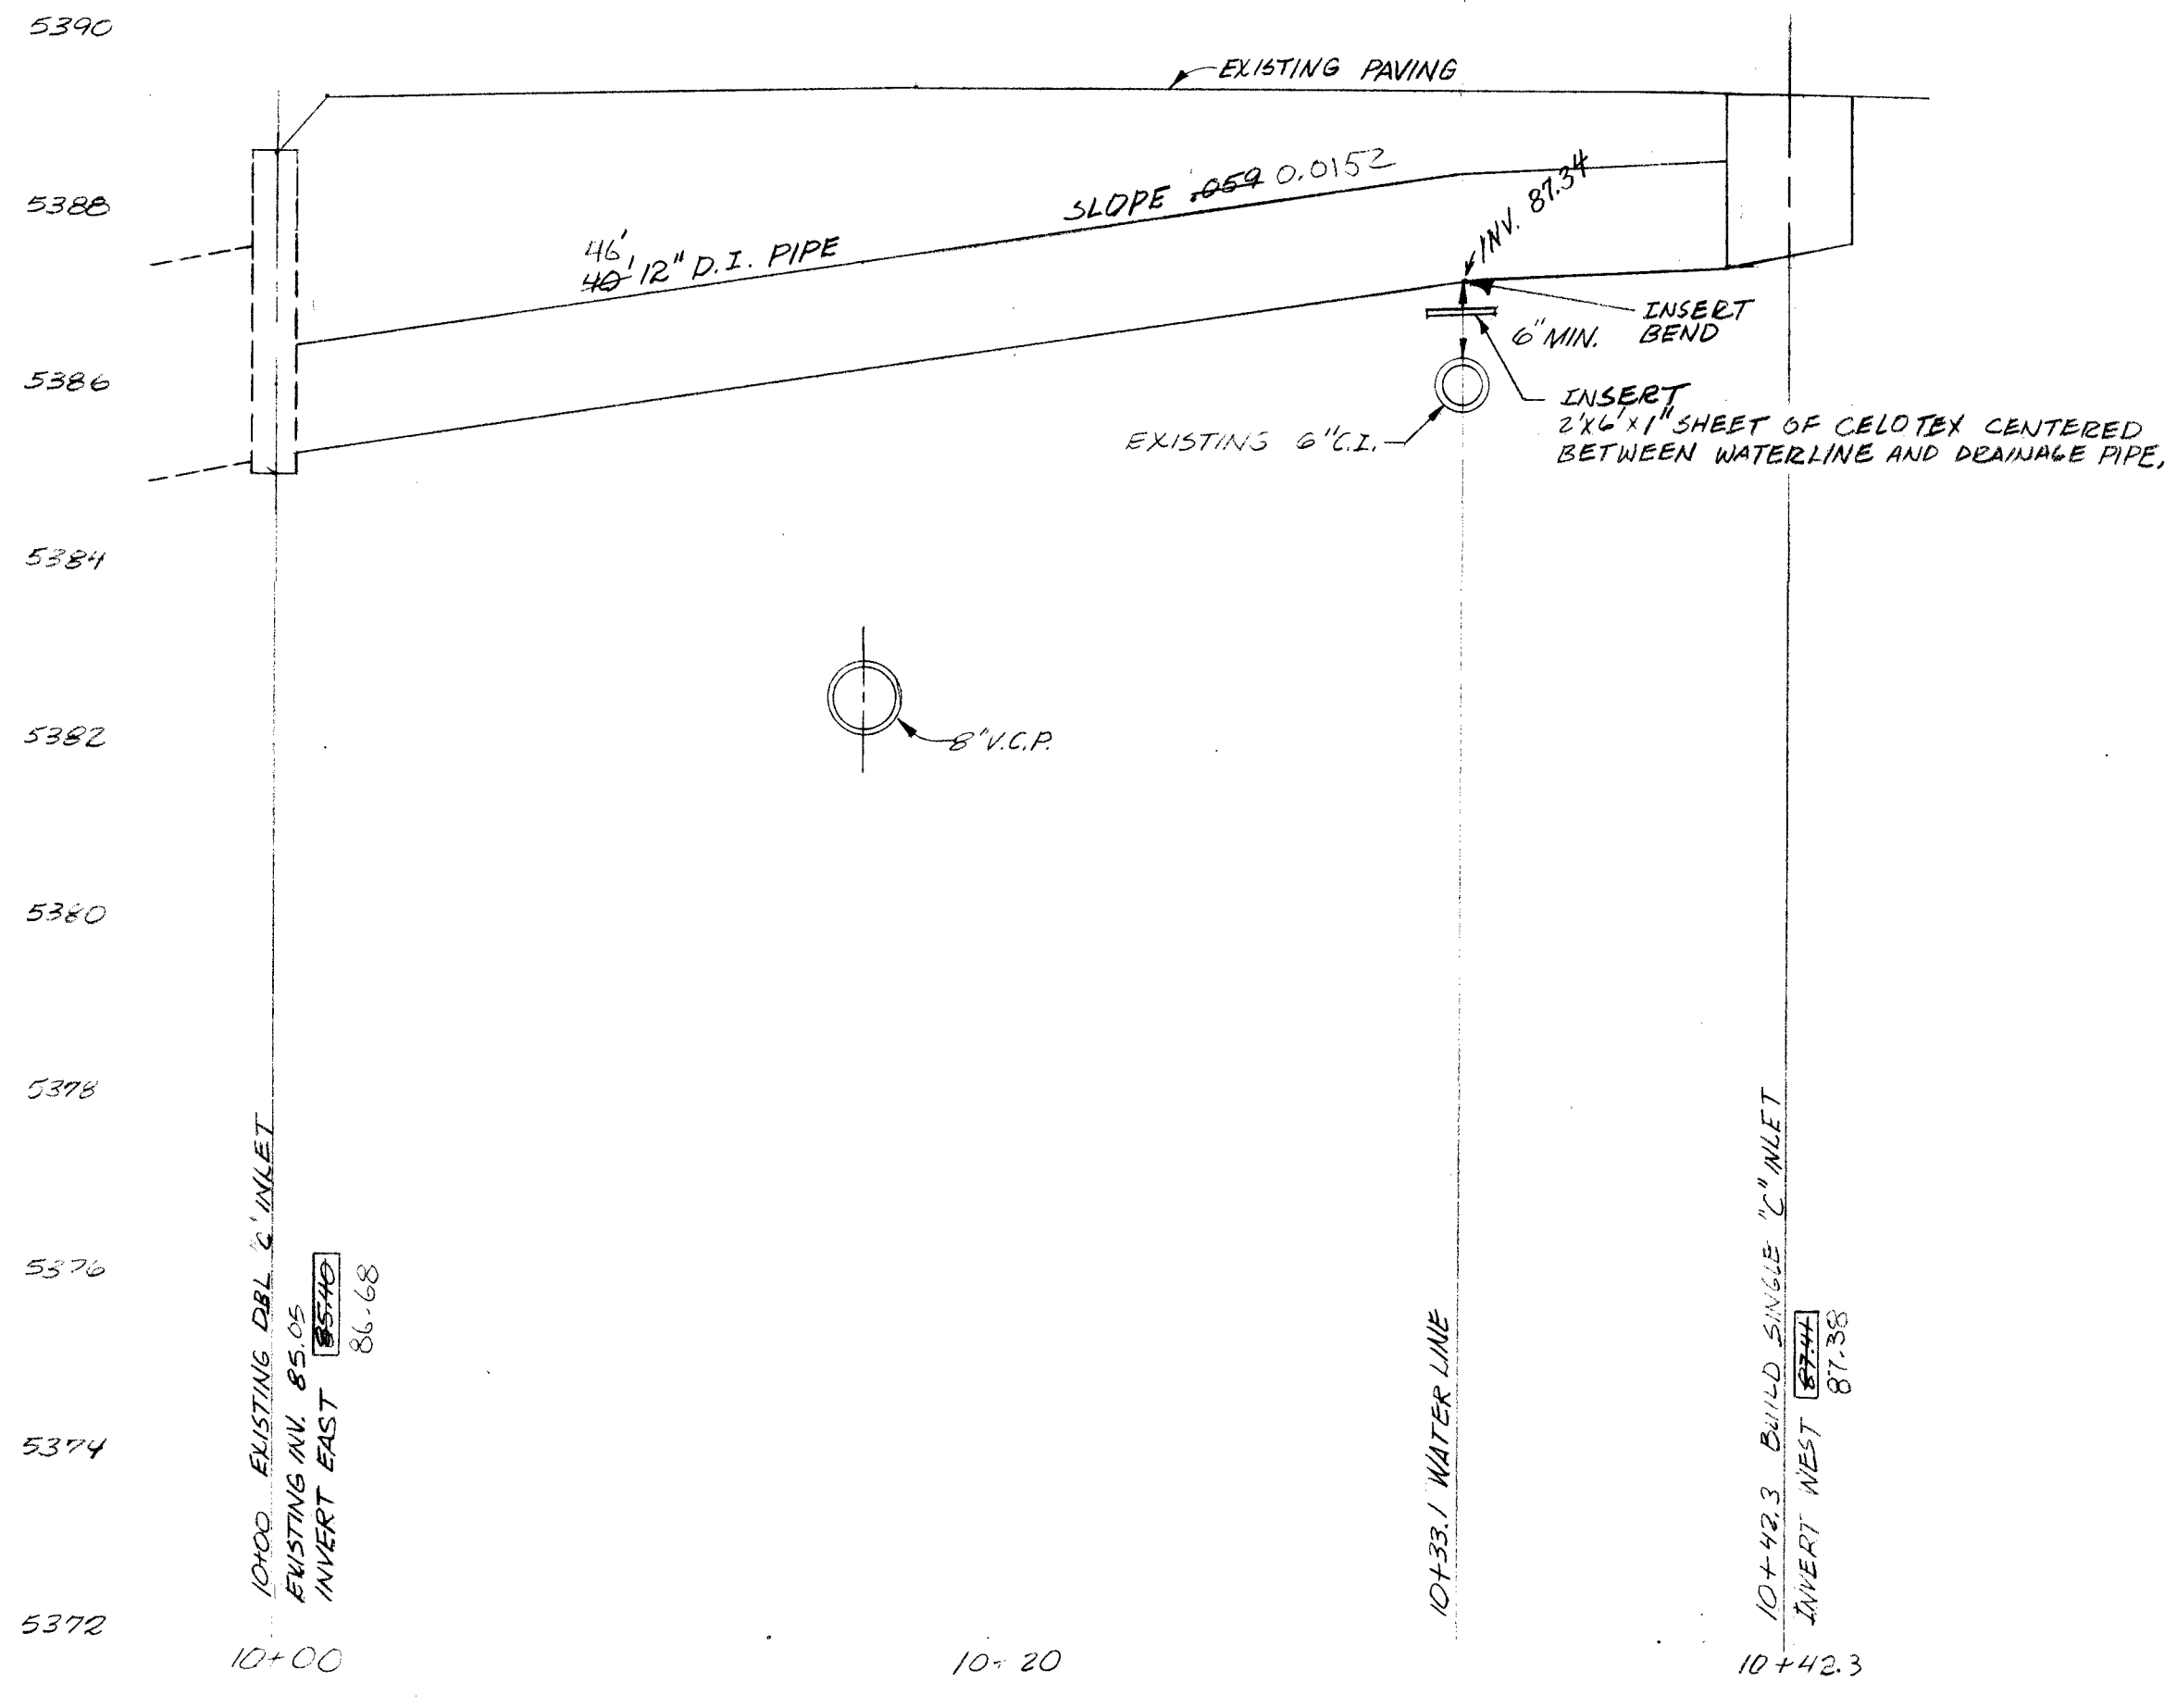

26 1 2 4 9 0 1 8 2

APPROVAL OF AN BUREAU ENGINEER
 DATE 9-28-82
 26 1 2 4 9 0 1 8 2

MENAU & WYOMING SERVICE RD. DRAINAGE

ST. ENGR. *[Signature]* 3/15/82
[Signature] 18/4/82
[Signature] 3-18-82
 1269 H-20 1 1

B.M. Standard ACS brass tablet, stamped 12-4-20
 Located at the ENE curb return of Wyoming Blvd and Menaul Blvd. Elev. 8340.057

18 Mar 82
 2-18-82

Q.R. Kallish
 E.N.E.Z.