




1. CONTRACTOR MUST SUBMIT A CONSTRUCTION SIGNING AND BARRICADING PLAN TO TRAFFIC ENGINEERING DIVISION AND RECEIVE A BARRICADING PERMIT PRIOR TO CONSTRUCTION.
2. ALL CONSTRUCTION SIGNING AND BARRICADING TO COMPLY WITH MANUAL ON UNIFORM TRAFFIC CONTROL DEVICES, 1978 EDITION.
3. CONTRACTOR'S OPERATION, BARRICADING AND SIGNING SHALL NOT AFFECT THRU LANES OF ACADEMY RD. BETWEEN 7 AM AND 9 AM OR 4 PM AND 6 PM.

AREA TO BE REMOVED AND PAVED TO ARTERIAL STD. (A.C.)
 REMOVE ASPHALT CURBING
 CONCRETE MEDIAN CURB & GUTTER TO BE CONSTRUCTED
 EXTRUDED ASPHALT CURB TO BE CONSTRUCTED

21.80 T/C
 19.63 FE

PROPOSED FLOWLINE ELEVATIONS
 EXISTING ELEVATIONS @ E

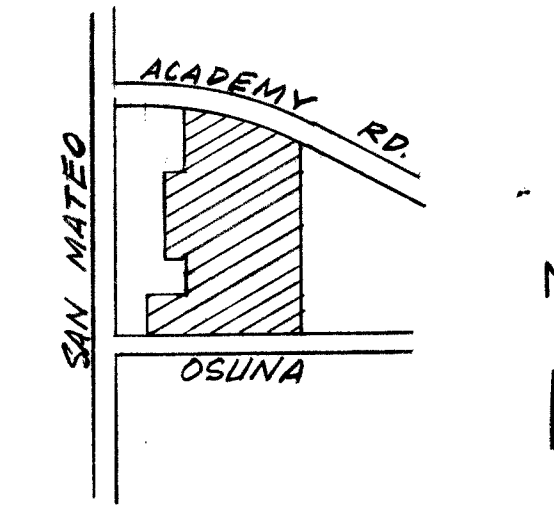

LOCATION MAP

- 1) New Mexico Standard Specification for Public Works Construction, 1979 Edition will be referred to hereon as the "Standard Specification."
- 2) All work detailed on these plans to be performed under contract shall, except as otherwise stated or provided for hereon, be constructed in accordance with "Contract Documents for City-Wide Utilities and Cash Paving No. 30 and the Standard Specification."
- 3) Two working days prior to any excavation, contractor must contact Line Locating Service, 765-1234, for location of existing utilities.
- 4) Prior to construction, the contractor shall excavate and verify the horizontal and vertical locations of all obstructions. Should a conflict exist, the contractor shall notify the engineer or surveyor so that the conflict can be resolved with minimum amount of delay.

- ☐ All utilities and utility service lines shall be installed prior to paving.
- ☒ Backfill compaction shall be according to specified street use. (Arterial)
- ☒ Tack coat requirements shall be determined by the City Engineer.
- ☐ Sidewalks and wheelchair ramps within the curb returns shall be constructed wherever a new curb return is constructed.
- ☐ If curb is depressed for a drivepad, the drivepad shall be constructed prior to acceptance of the curb and gutter.
- ☐ All storm drainage facilities shall be completed prior to final acceptance.

1	2	3	4	5	6	7	8	9	10	11	12
2	6		1	2	7	0		0	1	8	3

APPROVAL OF AS BUILT DRAWINGS
ASST. CITY ENGINEER - FIELD
[Signature]
DATE *10/1/83*

CITY OF ALBUQUERQUE
MUNICIPAL DEVELOPMENT DEPARTMENT
ENGINEERING DIVISION *MR 81- 8*

TITLE: *MEDIAN REVISIONS ON ACADEMY RD. EAST
OF SAN MATEO FOR ACADEMY BUSINESS PARK*

APPROVALS	ENGINEER	DATE	APPROVALS	ENGINEER	DATE
City Engineer	<i>[Signature]</i>	11/5/01	Liquid Waste		
A.C.E - Design	<i>[Signature]</i>	24 Dec 01	Traffic	<i>[Signature]</i>	12/31/01
A.C.E - Hydrology			Water		

APPROVED FOR
CONSTRUCTION
[Signature] 6/9/82
CITY ENGINEER DATE

DRAWING NO.	1270	MAP NO.	E-18	SHEET	1	OF	1
-------------	------	---------	------	-------	---	----	---

1570