

LOWER 9E WATERLINE FROM LOMAS BLVD. TO PETE DASKALOS HEIGHTS ADDITION ALBUQUERQUE, NEW MEXICO

INDEX

SHEET NO.

1.


TITLE SHEET AND VICINITY MAP

2.



LOWER 9E WATERLINE STA. 0+00 TO STA. 21+00

3.

LOWER 9E WATERLINE STA. 21+00 TO STA. 33+58.74

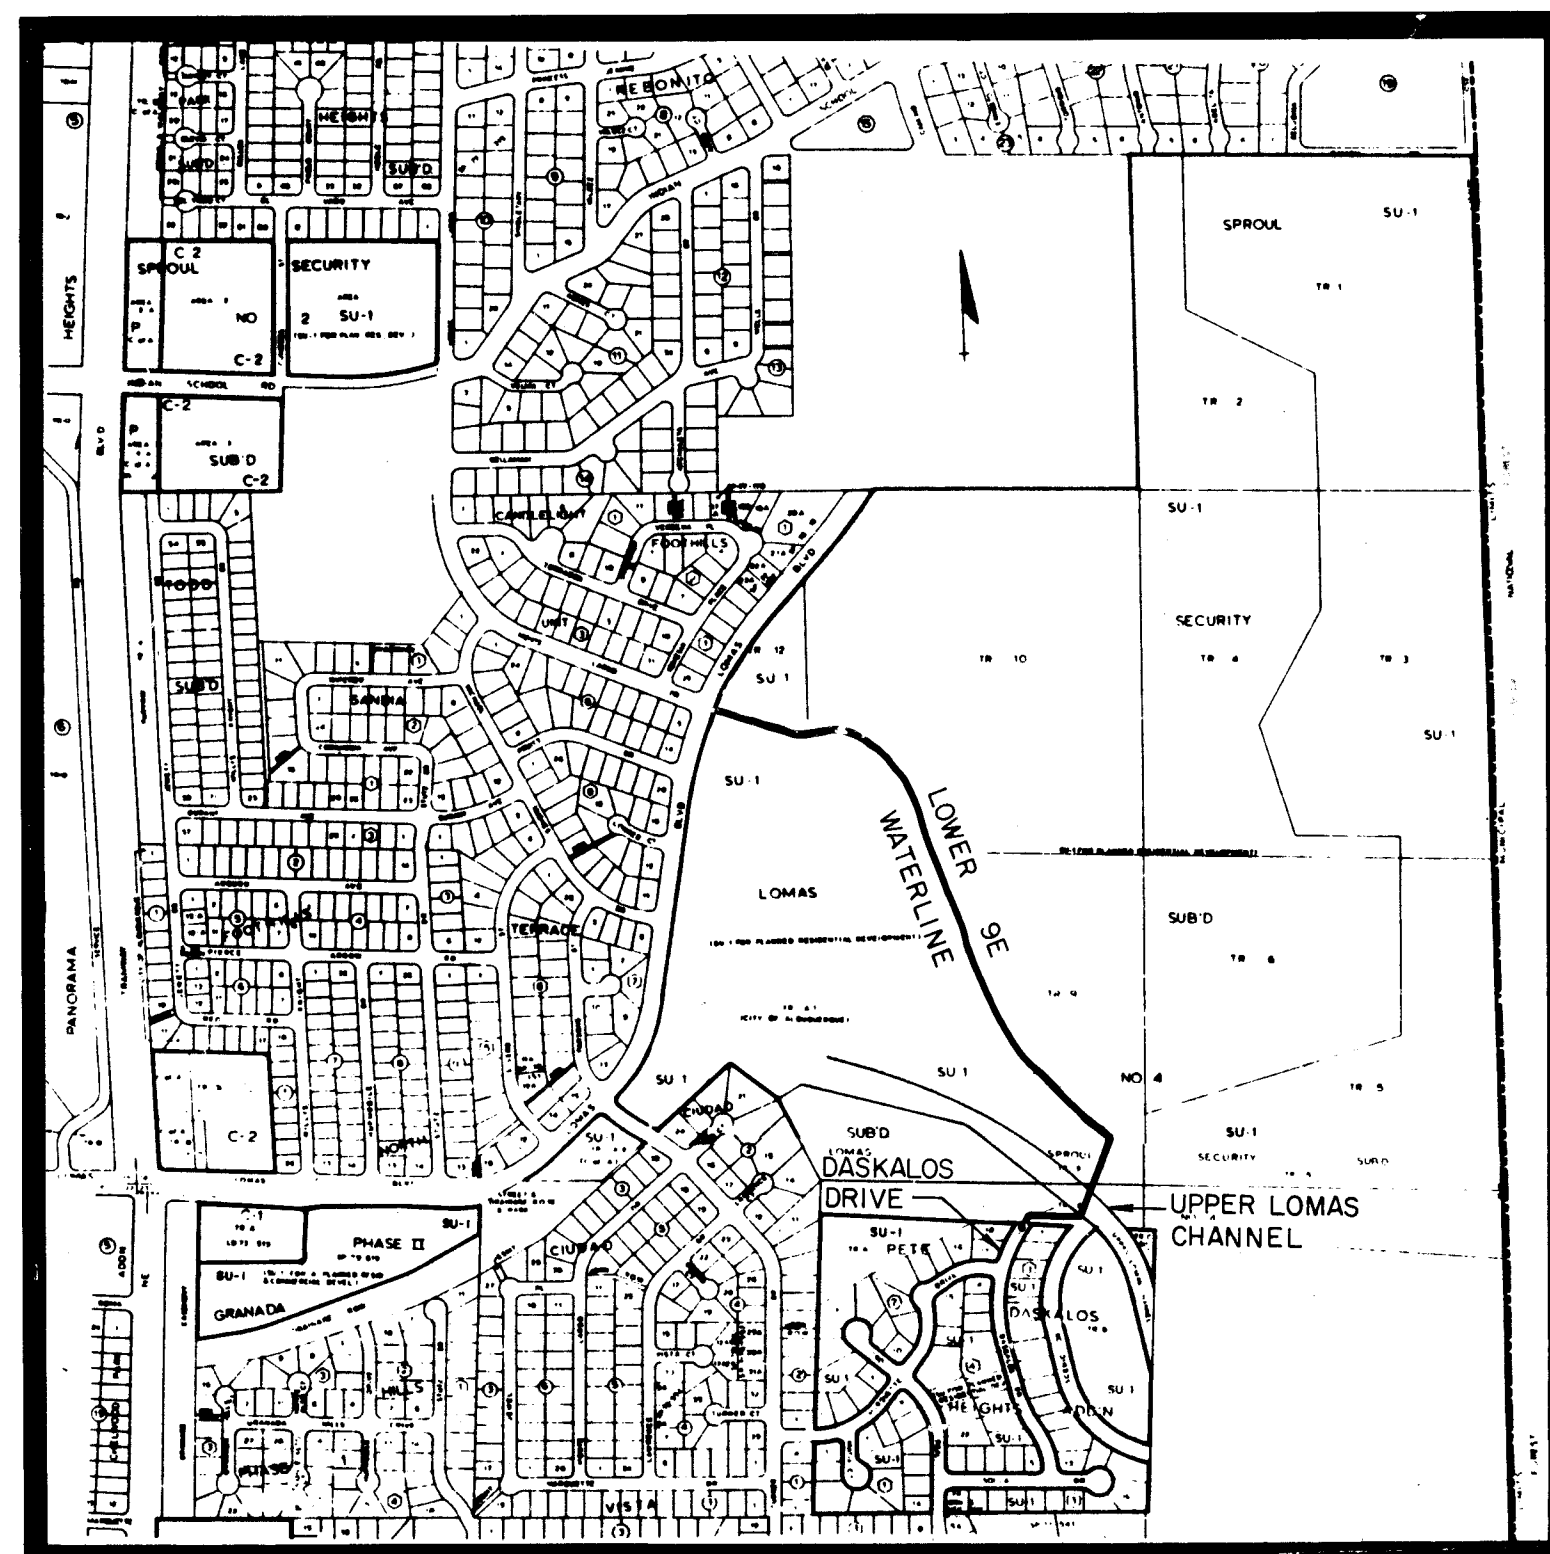

J-23
VICINITY MAP

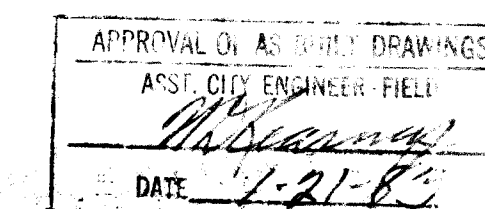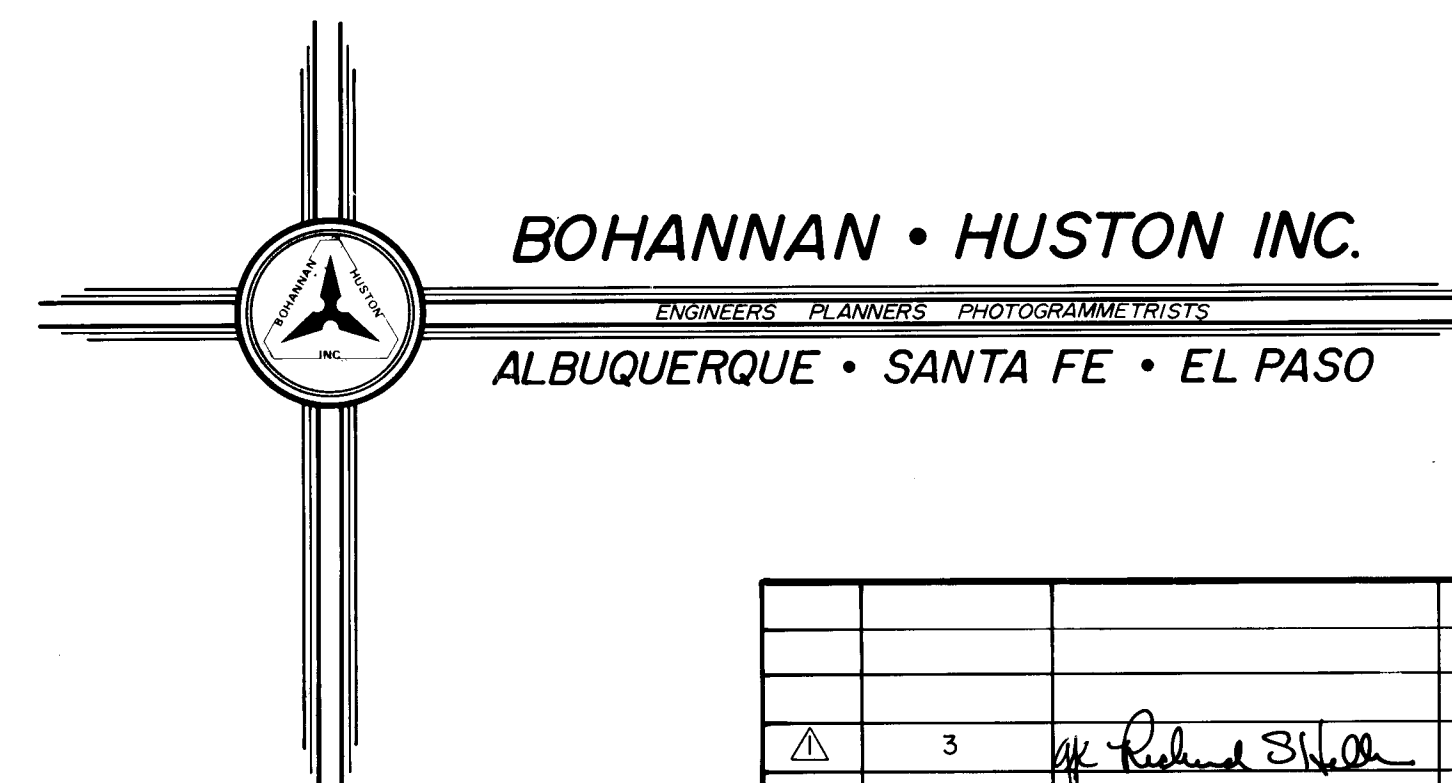

26 12940182

REV	SHEETS	CITY ENGINEER	DATE	USER	DEPT.	DATE	USER	DEPT.	DATE
△	3	[Signature]	9-9-82	[Signature]	Water Resources	9-8-82			
APPROVAL OF REVISIONS									



NOTICE TO CONTRACTORS

- New Mexico Standard Specifications for Public Works Construction-1979 Edition will be referred to hereon as the "Standard Specification."
- All work detailed on these plans to be performed under contract shall, except as otherwise stated or provided for hereon, be constructed in accordance with "Contract Documents for City-Wide Utilities and Cash Paving No. 30" and the Standard Specification."
- Two working days prior to any excavation, contractor must contact Line Locating Service, 765-1234, for location of existing utilities.
- Prior to construction, the contractor shall excavate and verify the horizontal and vertical locations of all obstructions. Should a conflict exist, the contractor shall notify the engineer or surveyor so that the conflict can be resolved with a minimum amount of delay.

THE FOLLOWING NOTES ALSO APPLY WHEN CHECKED

- ☒ All utilities and utility service lines shall be installed prior to paving.
- ☒ Backfill compaction shall be according to specified street use.
- ☐ Tack coat requirements shall be determined by the City Engineer.
- ☐ Sidewalks and wheelchair ramps within the curb returns shall be constructed wherever a new curb return is constructed.
- ☐ If curb is depressed for a driveway, the driveway shall be constructed prior to acceptance of curb and gutter.
- ☐ All storm drainage facilities shall be completed prior to final acceptance.
- ☐ The requestor or developer shall be responsible for repair or replacement of all curb and gutter or sidewalk damaged after approval by the City Engineer of work completed by the Contractor.



APPROVED FOR RECORD DRAWINGS	APPROVED FOR CONSTRUCTION
ASST. CITY ENGINEER, FIELD	CITY ENGINEER
CITY OF ALBUQUERQUE	
APPROVALS	ENGINEER DATE
A.C.E. DESIGN	[Signature] 1/21/82
WATER RESOURCES	[Signature] 1/21/82
CITY ENGINEER	[Signature] 1/21/82
PROJECT 1294	
MAP NO. J-23	
SHEET 3	

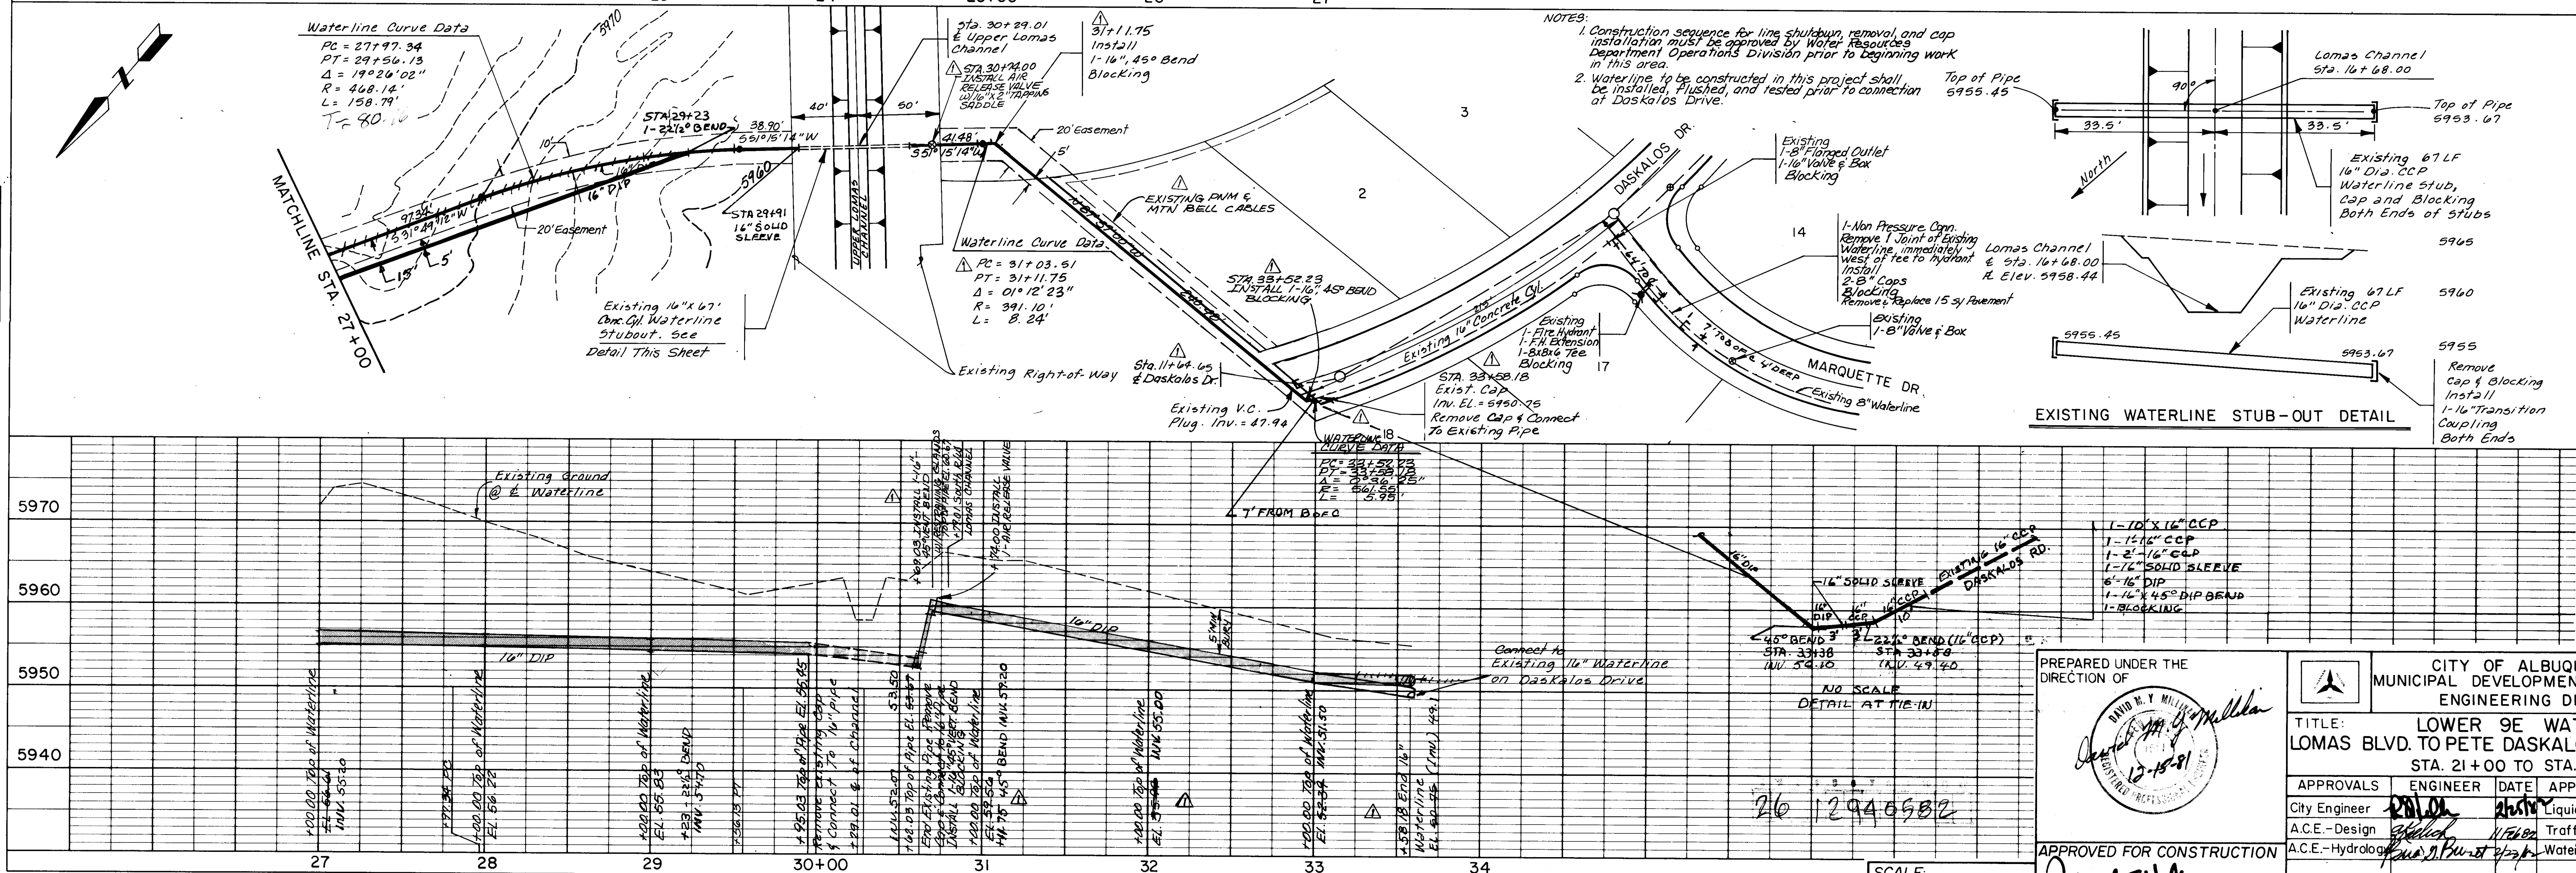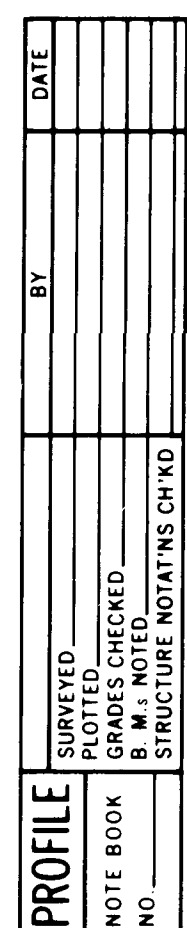[illegible]

PREPARED UNDER THE
DIRECTION OF





		CITY OF ALBUQUERQUE MUNICIPAL DEVELOPMENT DEPARTMENT ENGINEERING DIVISION					
TITLE: LOWER 9E WATERLINE LOMAS BLVD. TO PETE DASKALOS HEIGHTS ADDITION STA. 21+00 TO STA. 33+58.74							
APPROVALS	ENGINEER	DATE	APPROVALS	ENGINEER	DATE		
City Engineer	<i>[Signature]</i>	<i>2/15/02</i>	Liquid Wastes	<i>[Signature]</i>	<i>2/15/02</i>		
A.C.E. - Design	<i>[Signature]</i>	<i>1/15/02</i>	Traffic				
A.C.E. - Hydrology	<i>[Signature]</i>	<i>2/15/02</i>	Waterways	<i>[Signature]</i>	<i>2/15/02</i>		
DRAWING NO. 1294			SHEET 3 OF 3				

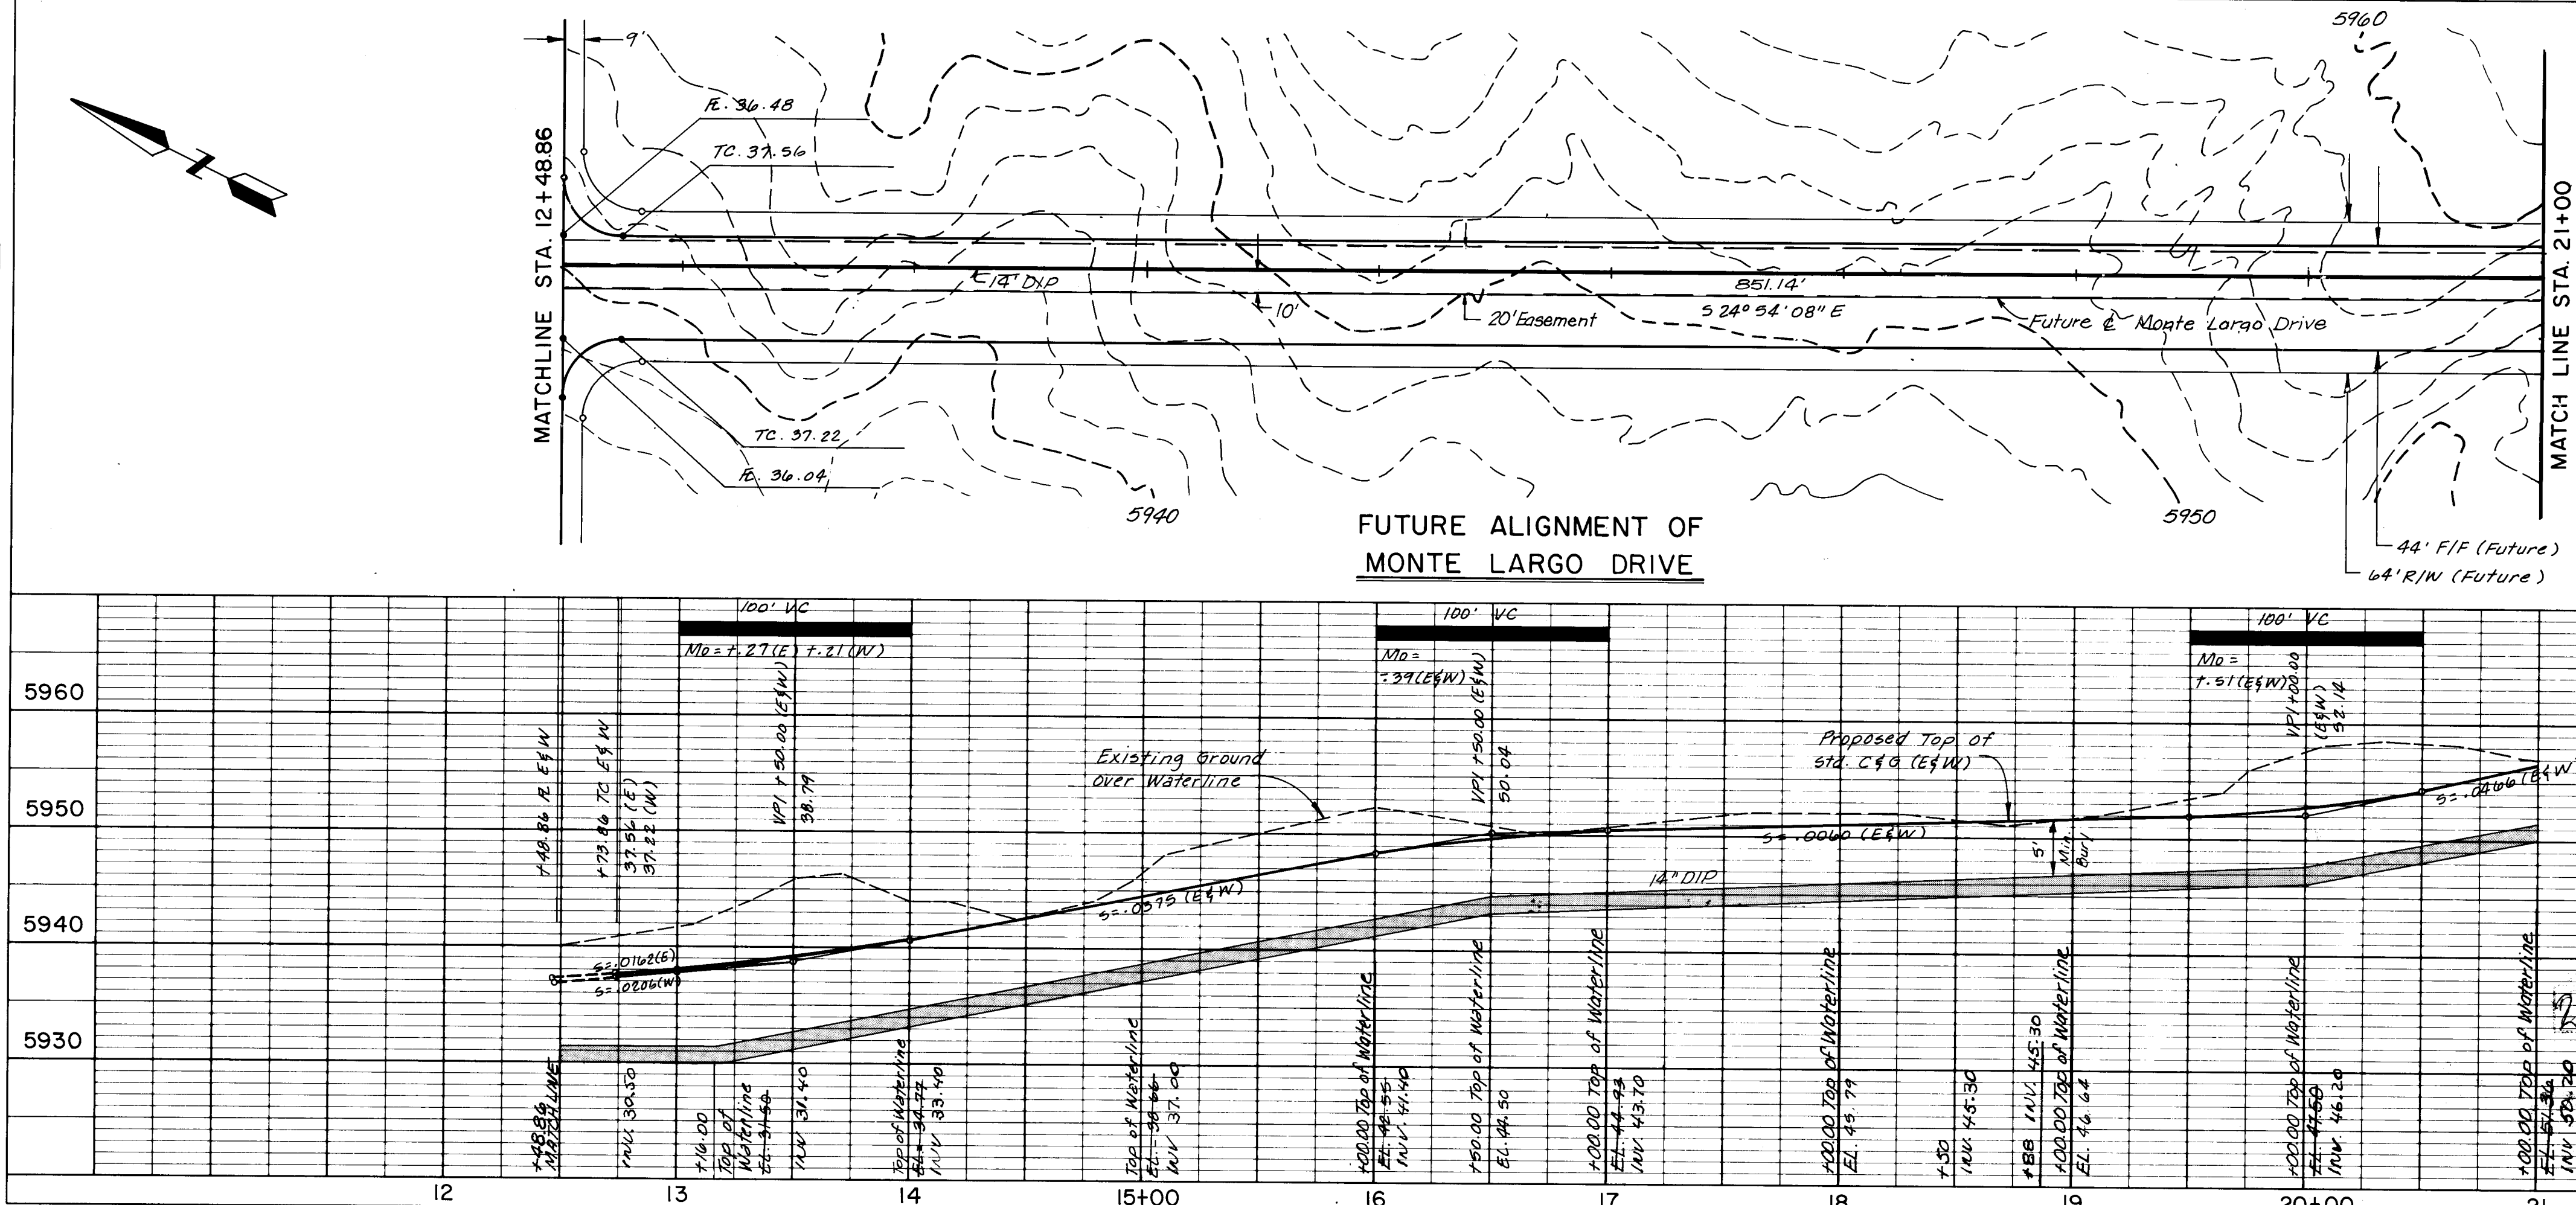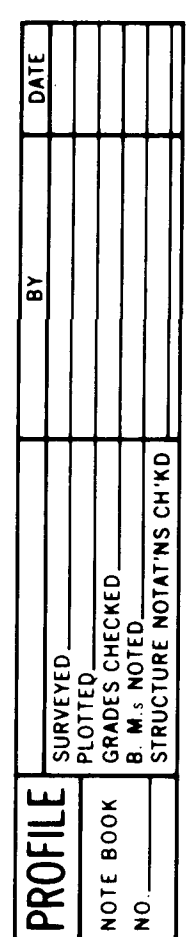

- NOTES:**
1. All stationing shown is based on the centerline of the proposed 14" & 16" Waterline.
 2. Rigid Joints are to be used on 16" Conc. Cyl. Waterline.
 3. Air Release Valves per City Std. Drwg. W-24-1 or approved equal.
 4. Waterline is to be Located 10' North or West of Future Street centerline unless otherwise shown.
 5. Waterline shall be installed per Supplemental General Conditions Section 18.1, for City-Wide Utilities and Cash Paving 30 and New Mexico Standard Specifications for Public Works Construction.
 6. Electronic Marker Disks shall be placed in accordance with Supplemental Technical Specifications, Section 131, for City-Wide Utilities and Cash Paving #30.
 7. Concrete Blocking on the 14" Waterline shall be in accordance Per City Std. Drwg. -22.
 8. No street grading will be required with this contract.
 9. Backfill over the waterline shall be 90% Density per specification D-1557 ASTM.
 10. Proposed waterline shall have a minimum of 5' of Bury from Top of Pipe to Top of Ground.
 11. Waterline shall be backfilled to a minimum height of 5' 0" above top of waterline for width of easement.
 12. This project for construction of waterline only.
 13. Rock Excavation shall be paid for in accordance with Section 550.13 of the Supplemental Technical Specifications for City-Wide Utilities & Cash Paving No. 30.

[illegible]

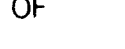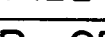PREPARED UNDER THE DIRECTION OF 	CITY OF ALBUQUERQUE MUNICIPAL DEVELOPMENT DEPARTMENT ENGINEERING DIVISION						
	TITLE: LOWER 9E WATERLINE LOMAS BLVD. TO PETE DASKALOS HEIGHTS ADDITION STA. 0+00 TO STA. 21+00						
APPROVED FOR CONSTRUCTION  5/14/84 CITY ENGINEER DATE	APPROVALS	ENGINEER	DATE	APPROVALS	ENGINEER	DATE	
	City Engineer		5/15/84	Liquid Waste		5/15/84	
	A.C.E.-Design		5/16/84	Traffic		5/16/84	
	A.C.E.-Hydrology		5/16/84	Water		5/16/84	
DRAWING NO.			1294			SHEET 2 OF 3	