


CITY OF ALBUQUERQUE					
MUNICIPAL DEVELOPMENT DEPARTMENT					
ENGINEERING DIVISION					
TITLE:					
APPLE LANE - WATER, SAS & STORM DRAIN					
APPROVALS	ENGINEER	DATE	APPROVALS	ENGINEER	DATE
City Engineer	<i>C. A. Chappell</i>	1/14/82	Liquid Waste	<i>W. B. J.</i>	1-11-83
A C E - Design	<i>A. K. Kish</i>	1/20/82	Traffic	<i>W. B. J.</i>	4/20/83
A C E - Hydrology	<i>Paul Smith</i>	6-2-83	Water	<i>W. B. J.</i>	11-8-83
DRAWING NO.	1297		MAP NO.	H-12	
			SHEET	1	OF 4


1501

SCALE 1" = 40'

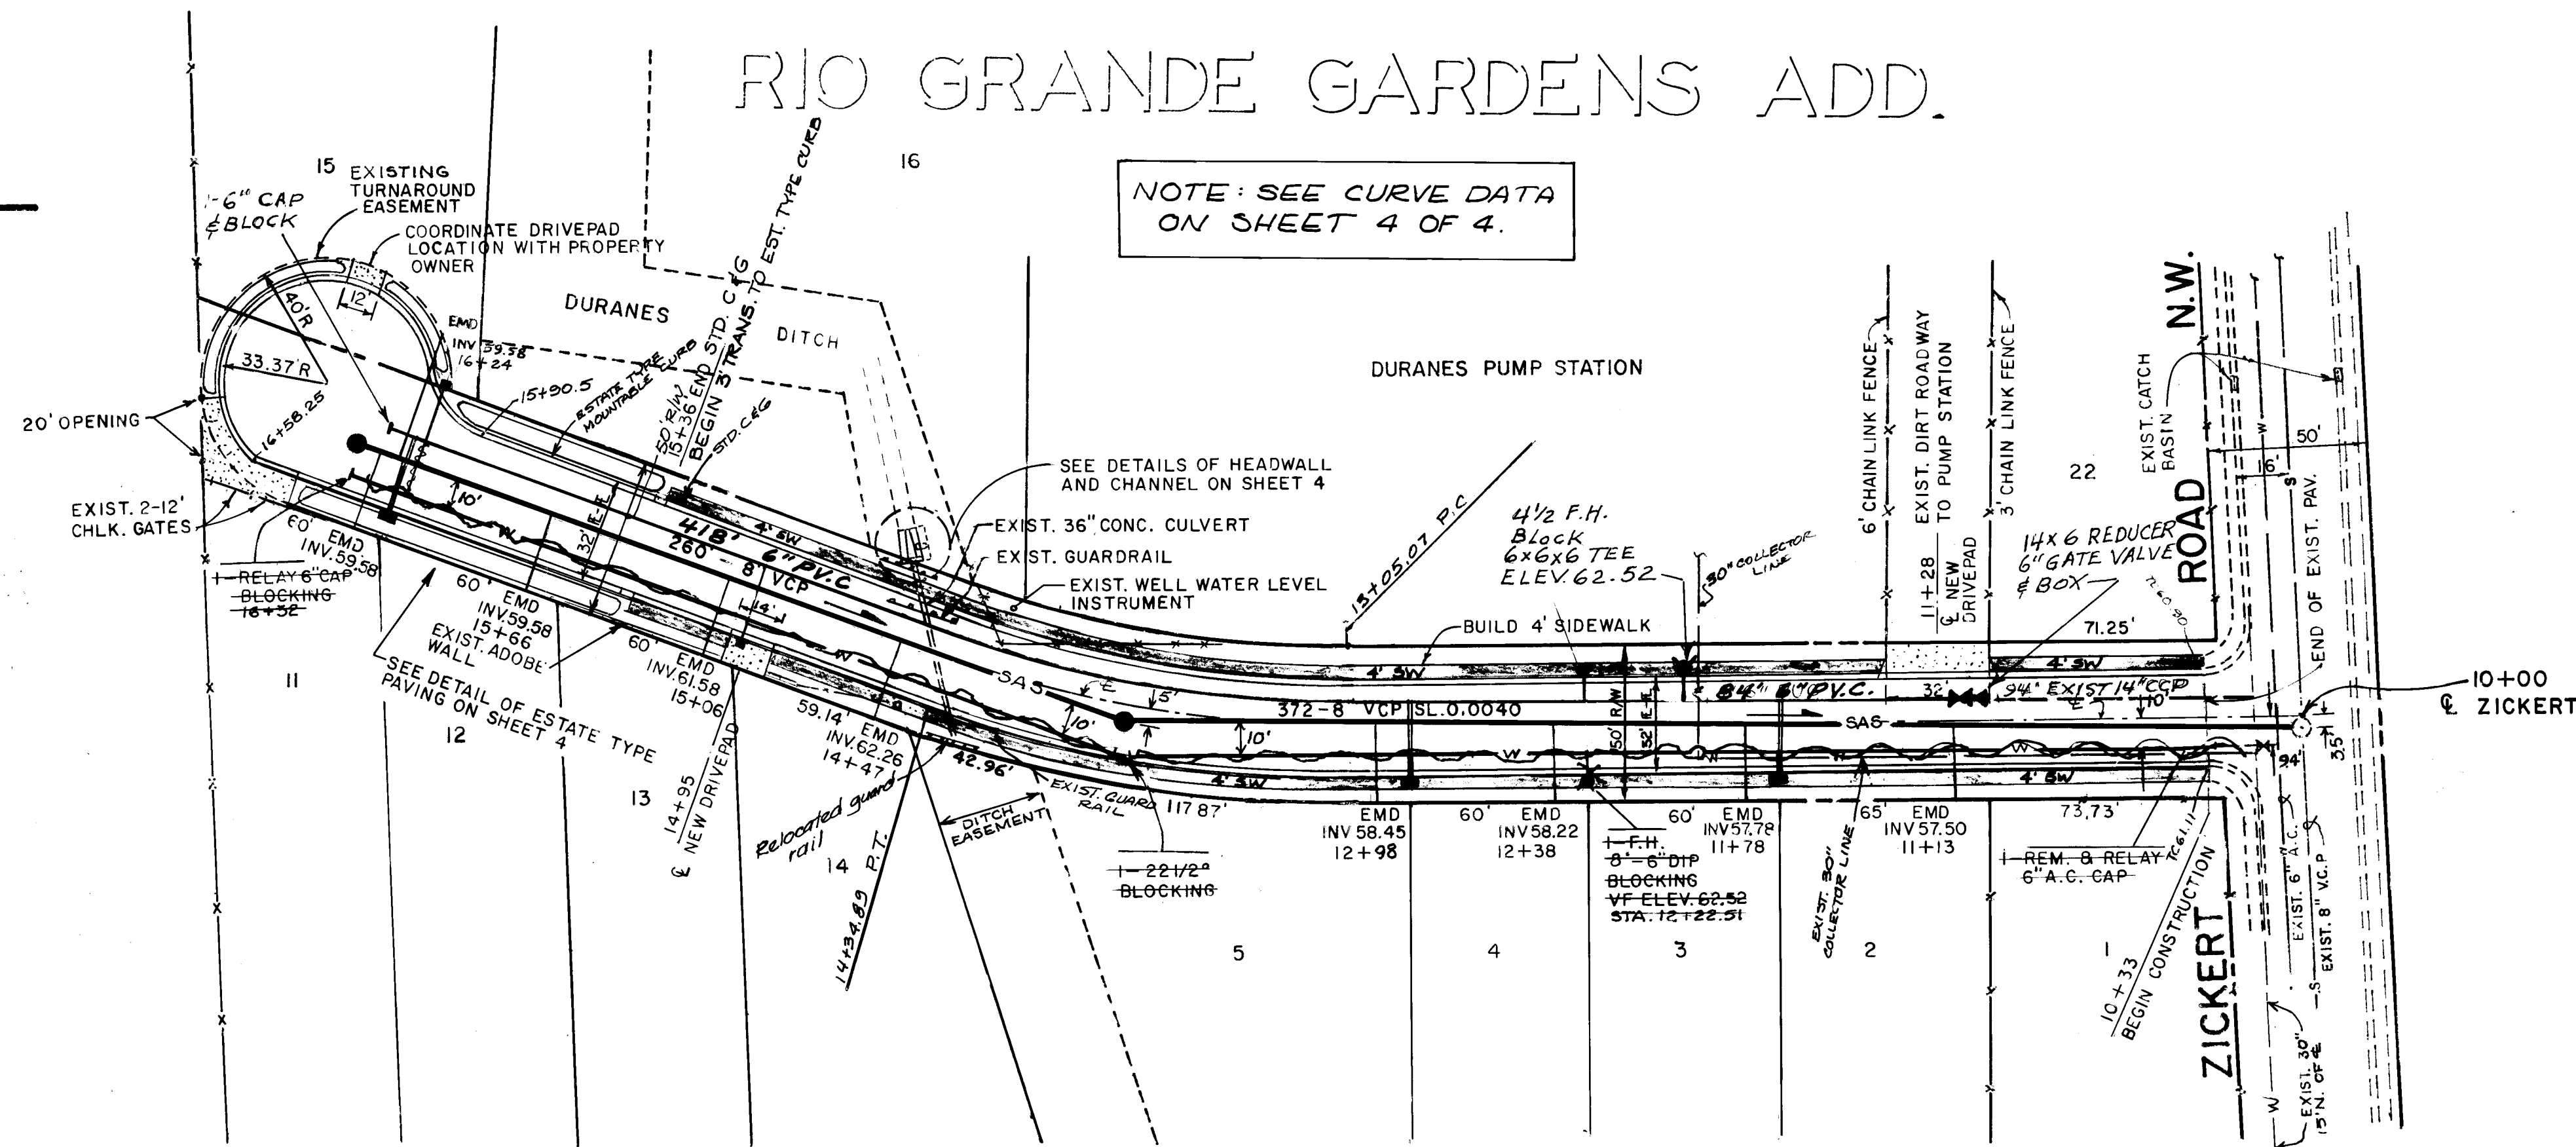

APPLE LANE N.W.

50' V.C. M.O. = +.22
90' V.C. M.O. = -.85
70' V.C. M.O. = +.30

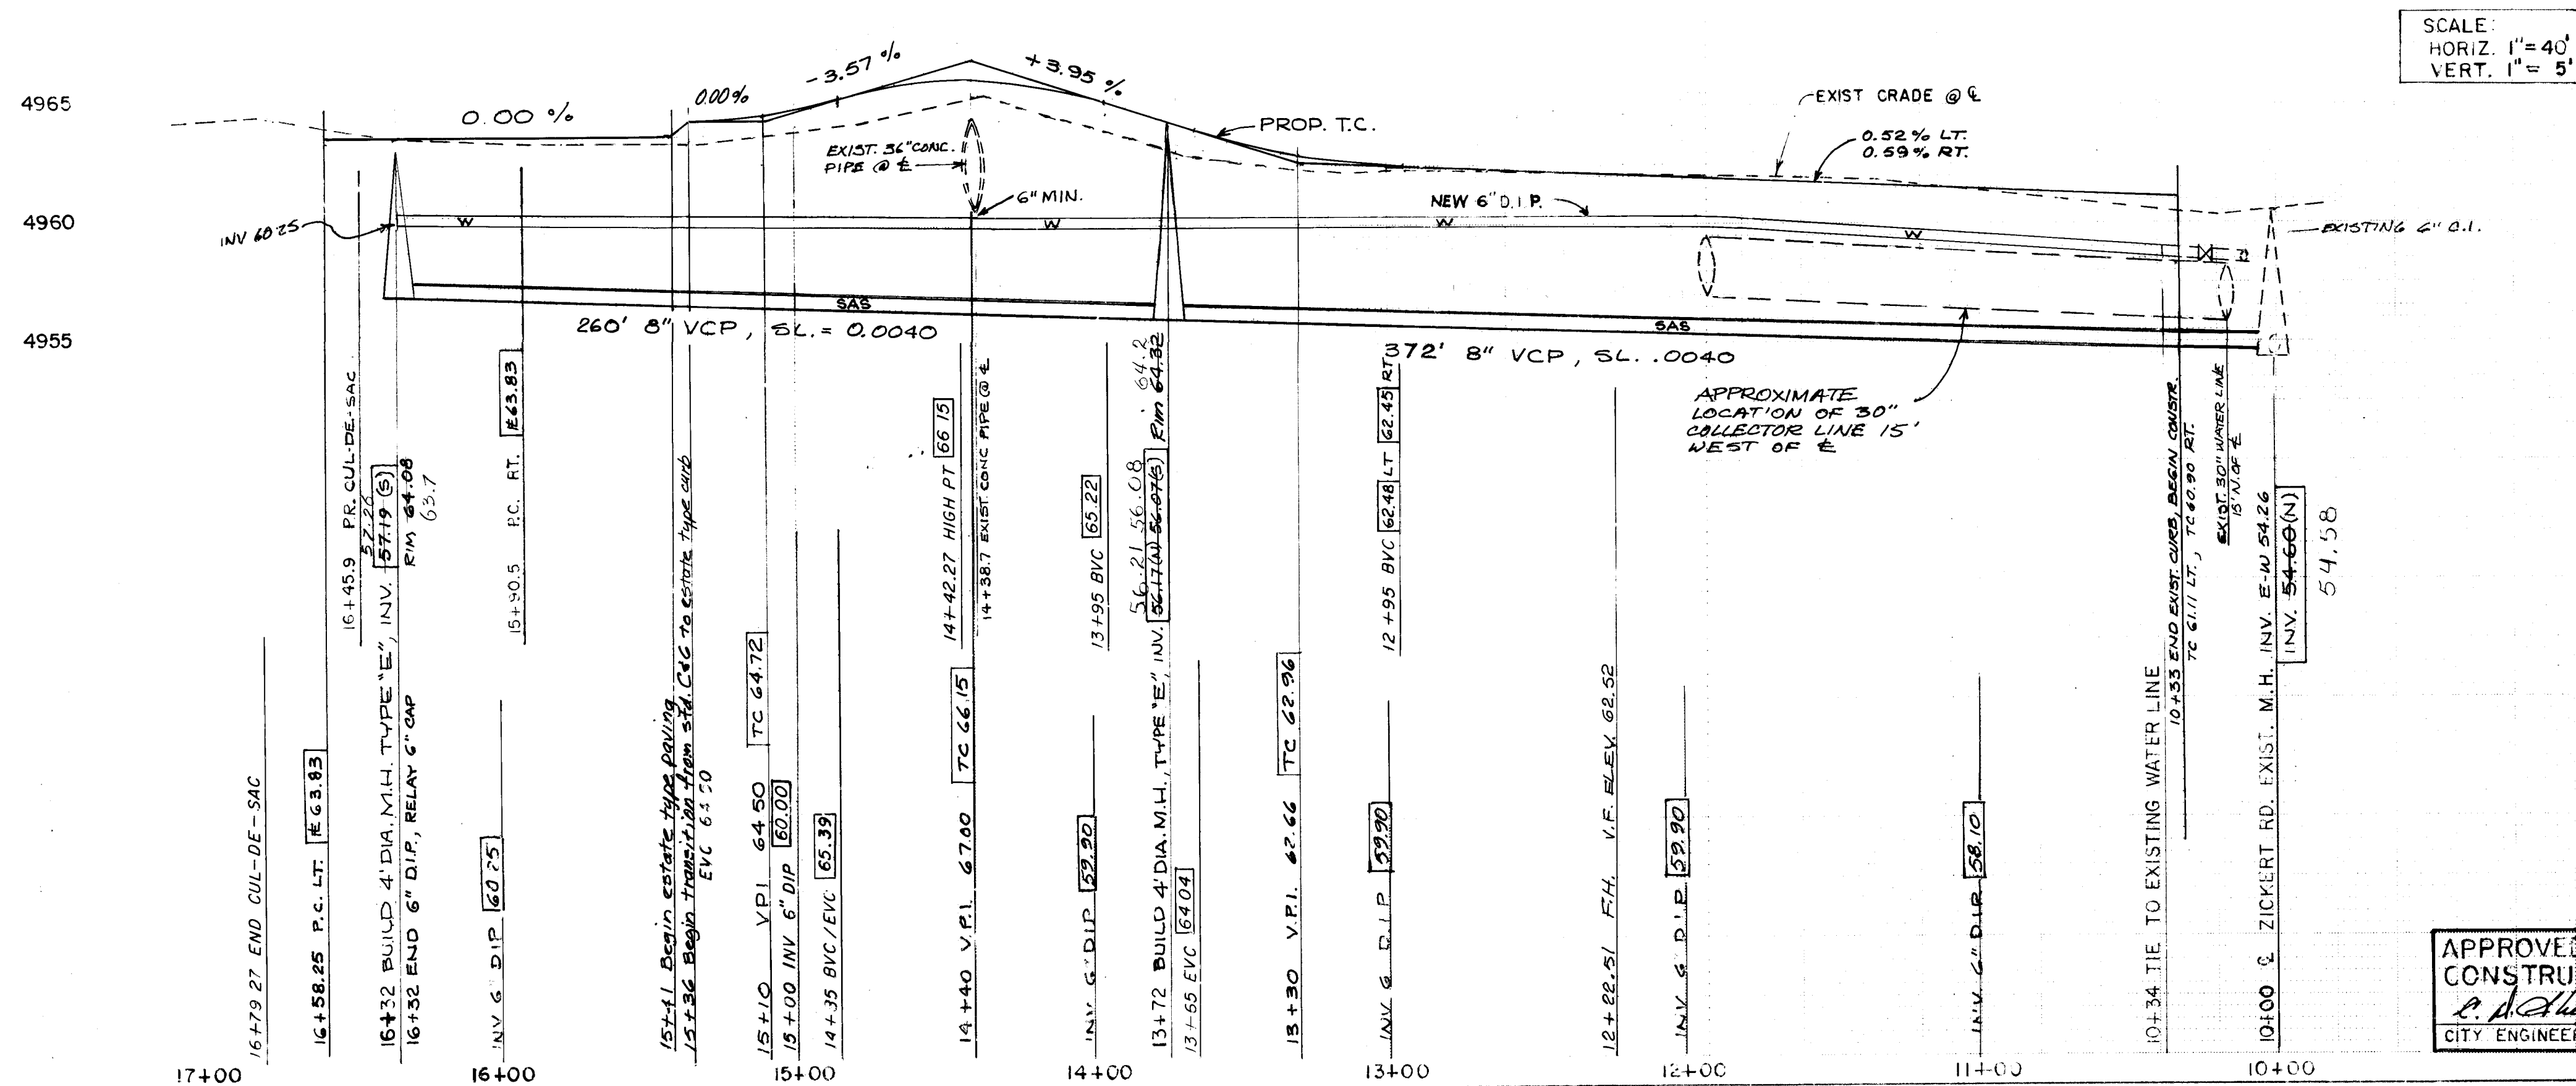

SCALE:
HORIZ. 1" = 40'
VERT. 1" = 5'

LEGEND

- SAS — EXIST. SANITARY SEWER LINE
- W — EXIST. WATER LINE
- — — — — EXIST. CURB & GUTTER
- V — EXIST. WATER VALVE
- SAS — PROP. SANITARY SEWER LINE
- W — PROP. WATER LINE
- — — — — PROP. 4' SIDEWALK
- — — — — PROP. DOUBLE WATER SERV. CONN.
- — — — — PROP. SINGLE WATER SERV. CONN.
- — — — — PROP. SAN. SEWER SERVICE LINE
- — — — — PROP. FIRE HYDRANT

26 1297 0264

CITY OF ALBUQUERQUE
MUNICIPAL DEVELOPMENT DEPARTMENT
ENGINEERING DIVISION
TITLE PAVING, WATER & SANITARY SEWER ON APPLE LANE N.W.
FROM ZICKERT RD. TO DEAD-END.

APPROVED FOR
CONSTRUCTION
CITY ENGINEER
DATE

APPROVALS
City Engineer
A.C.E. Design
A.C.E. Hydrology
ENGINEER
DATE
APPROVALS
City Engineer
A.C.E. Design
A.C.E. Hydrology
ENGINEER
DATE

DRAWING NO. 1297
MAP NO. H-12
SHEET 2 OF 4



AS BUILT INFORMATION
MICRO FILM INFORMATION

7 H13 ACS BRASS TABLET INTER. INDIAN
SCHOOL RD. 4 RIO GRANDE BVD. ELEV. 4961.60
1-6-82 CBM - WNW RET. @ INTERSECTION OF ZICKERT &
APPLE LANE N.W.
ELEV. T.C. 4960.83

NO. PS-24
DATE
BY P. AQUAR

ENGINEER'S SEAL
REVISIONS
NO. DATE
BY

REVISIONS
NO. DATE
BY
S. MIRANDA
T. SANCHEZ
4/10/83

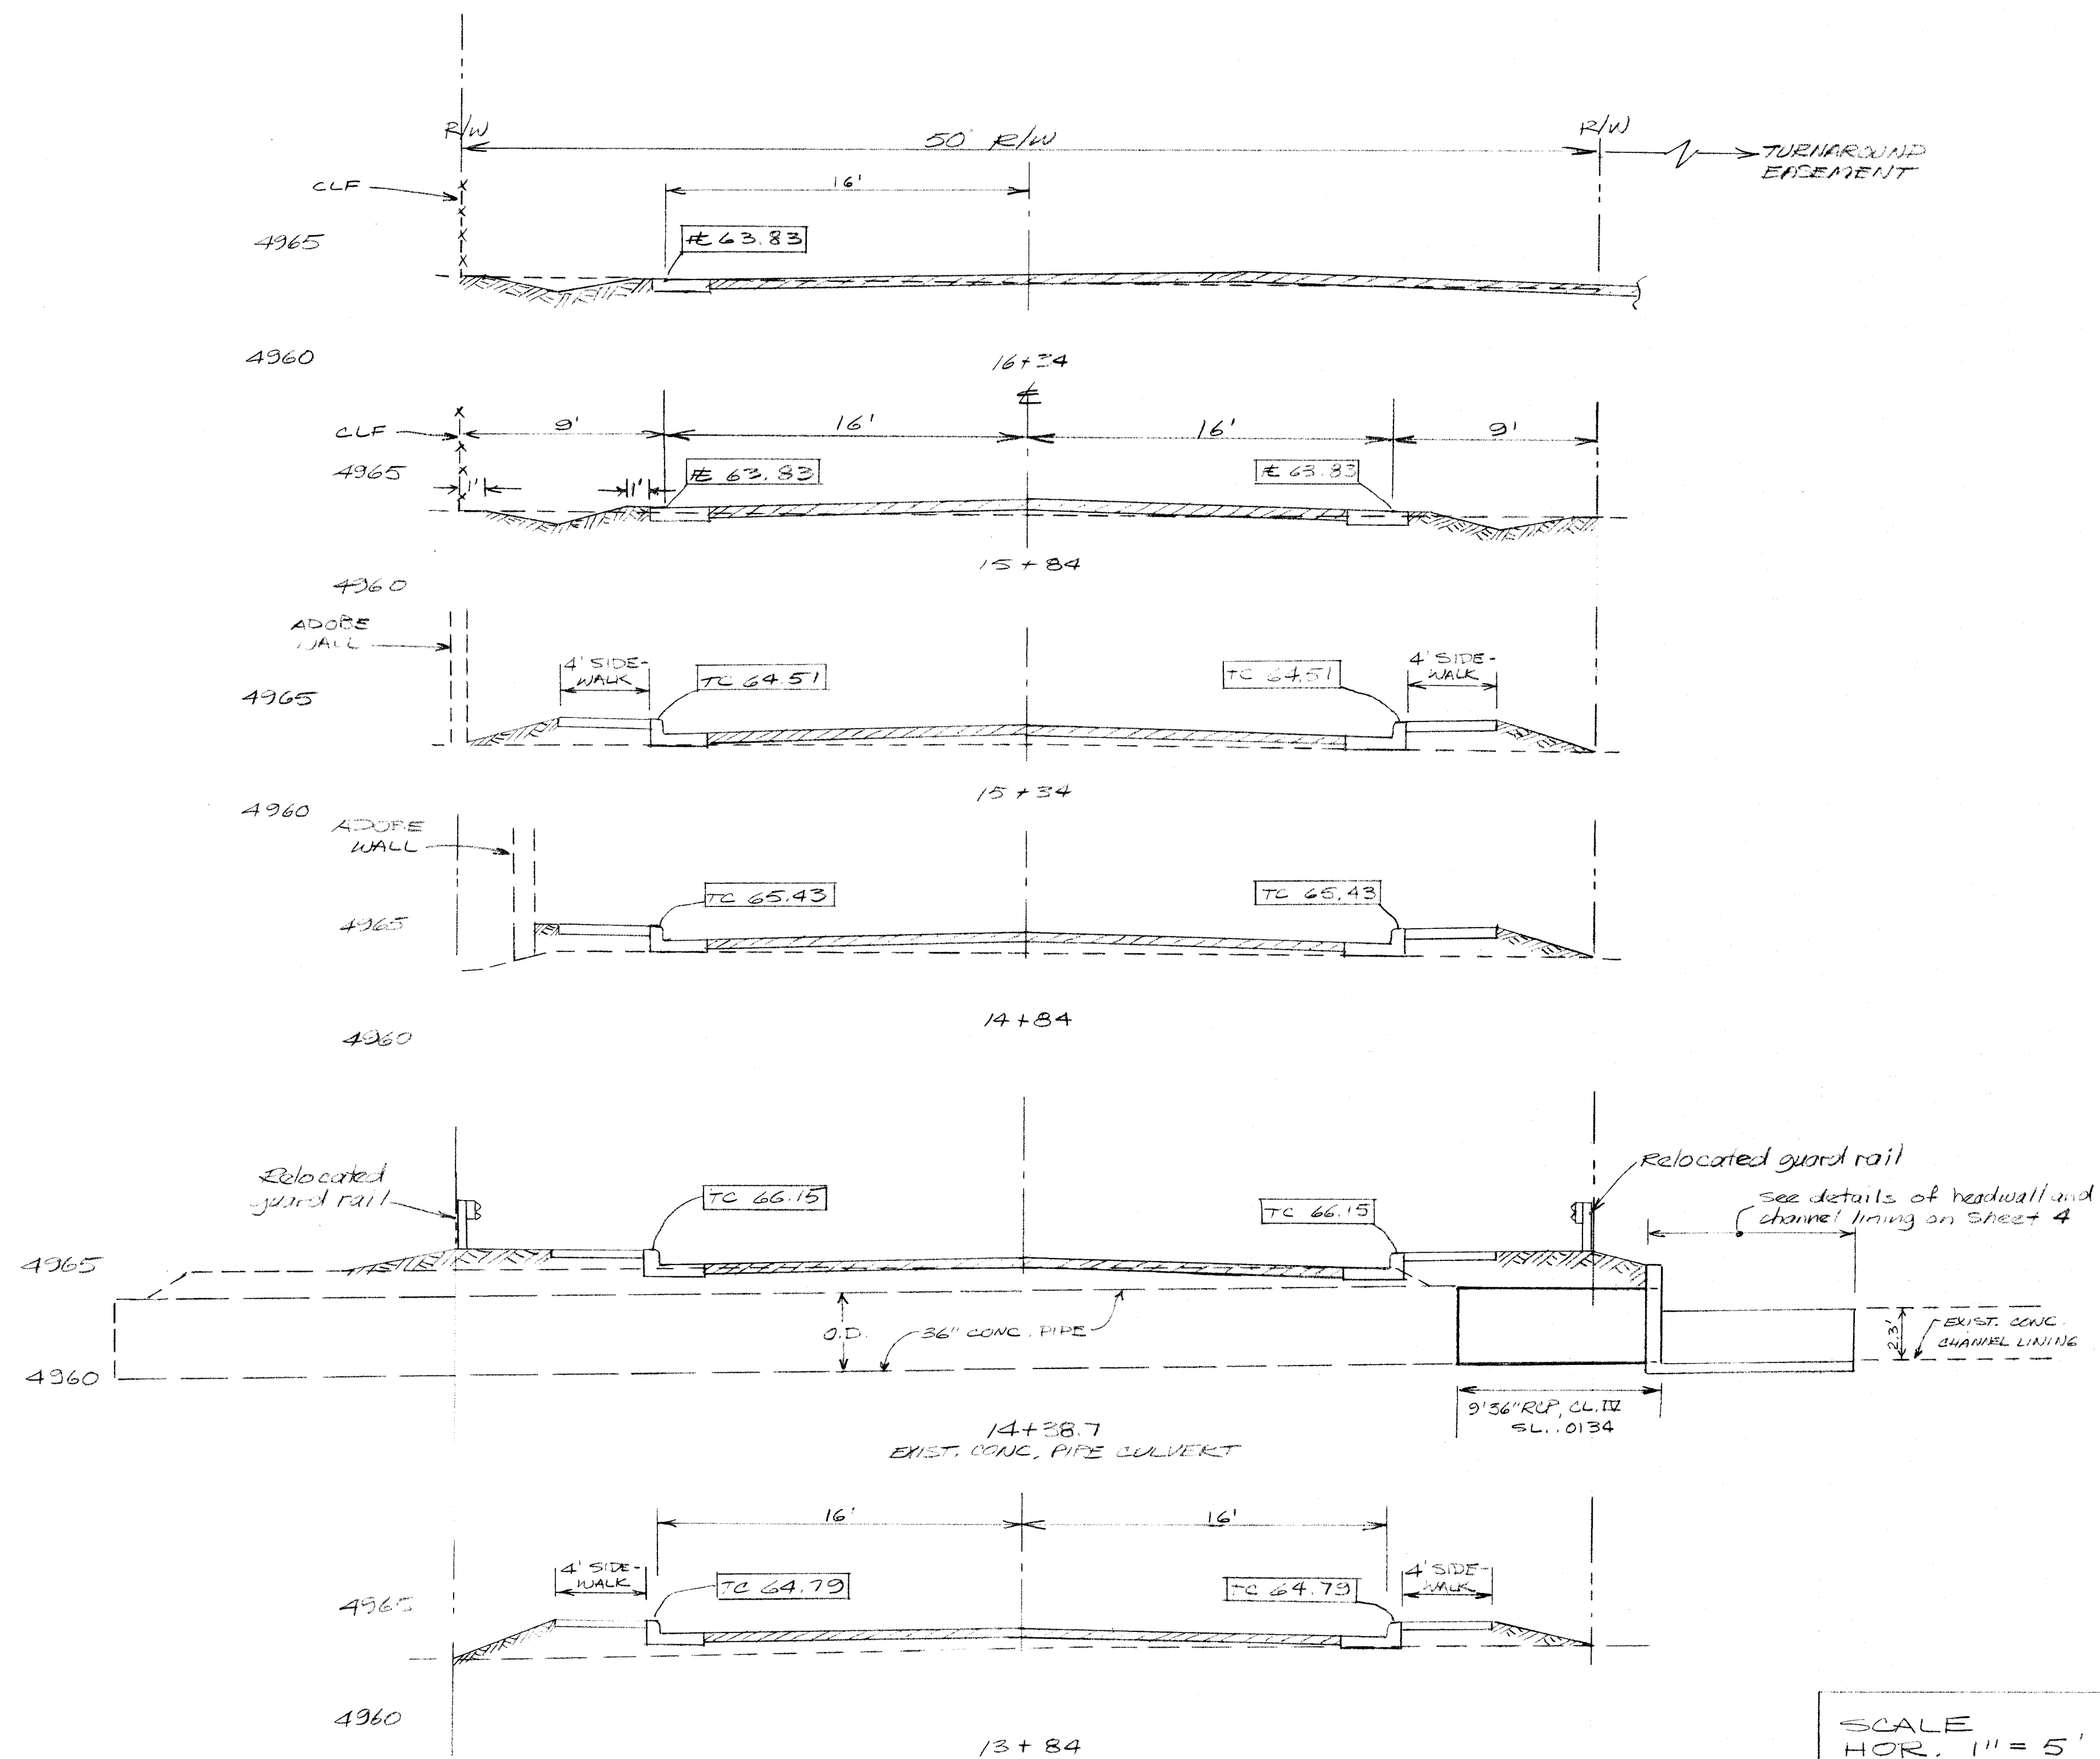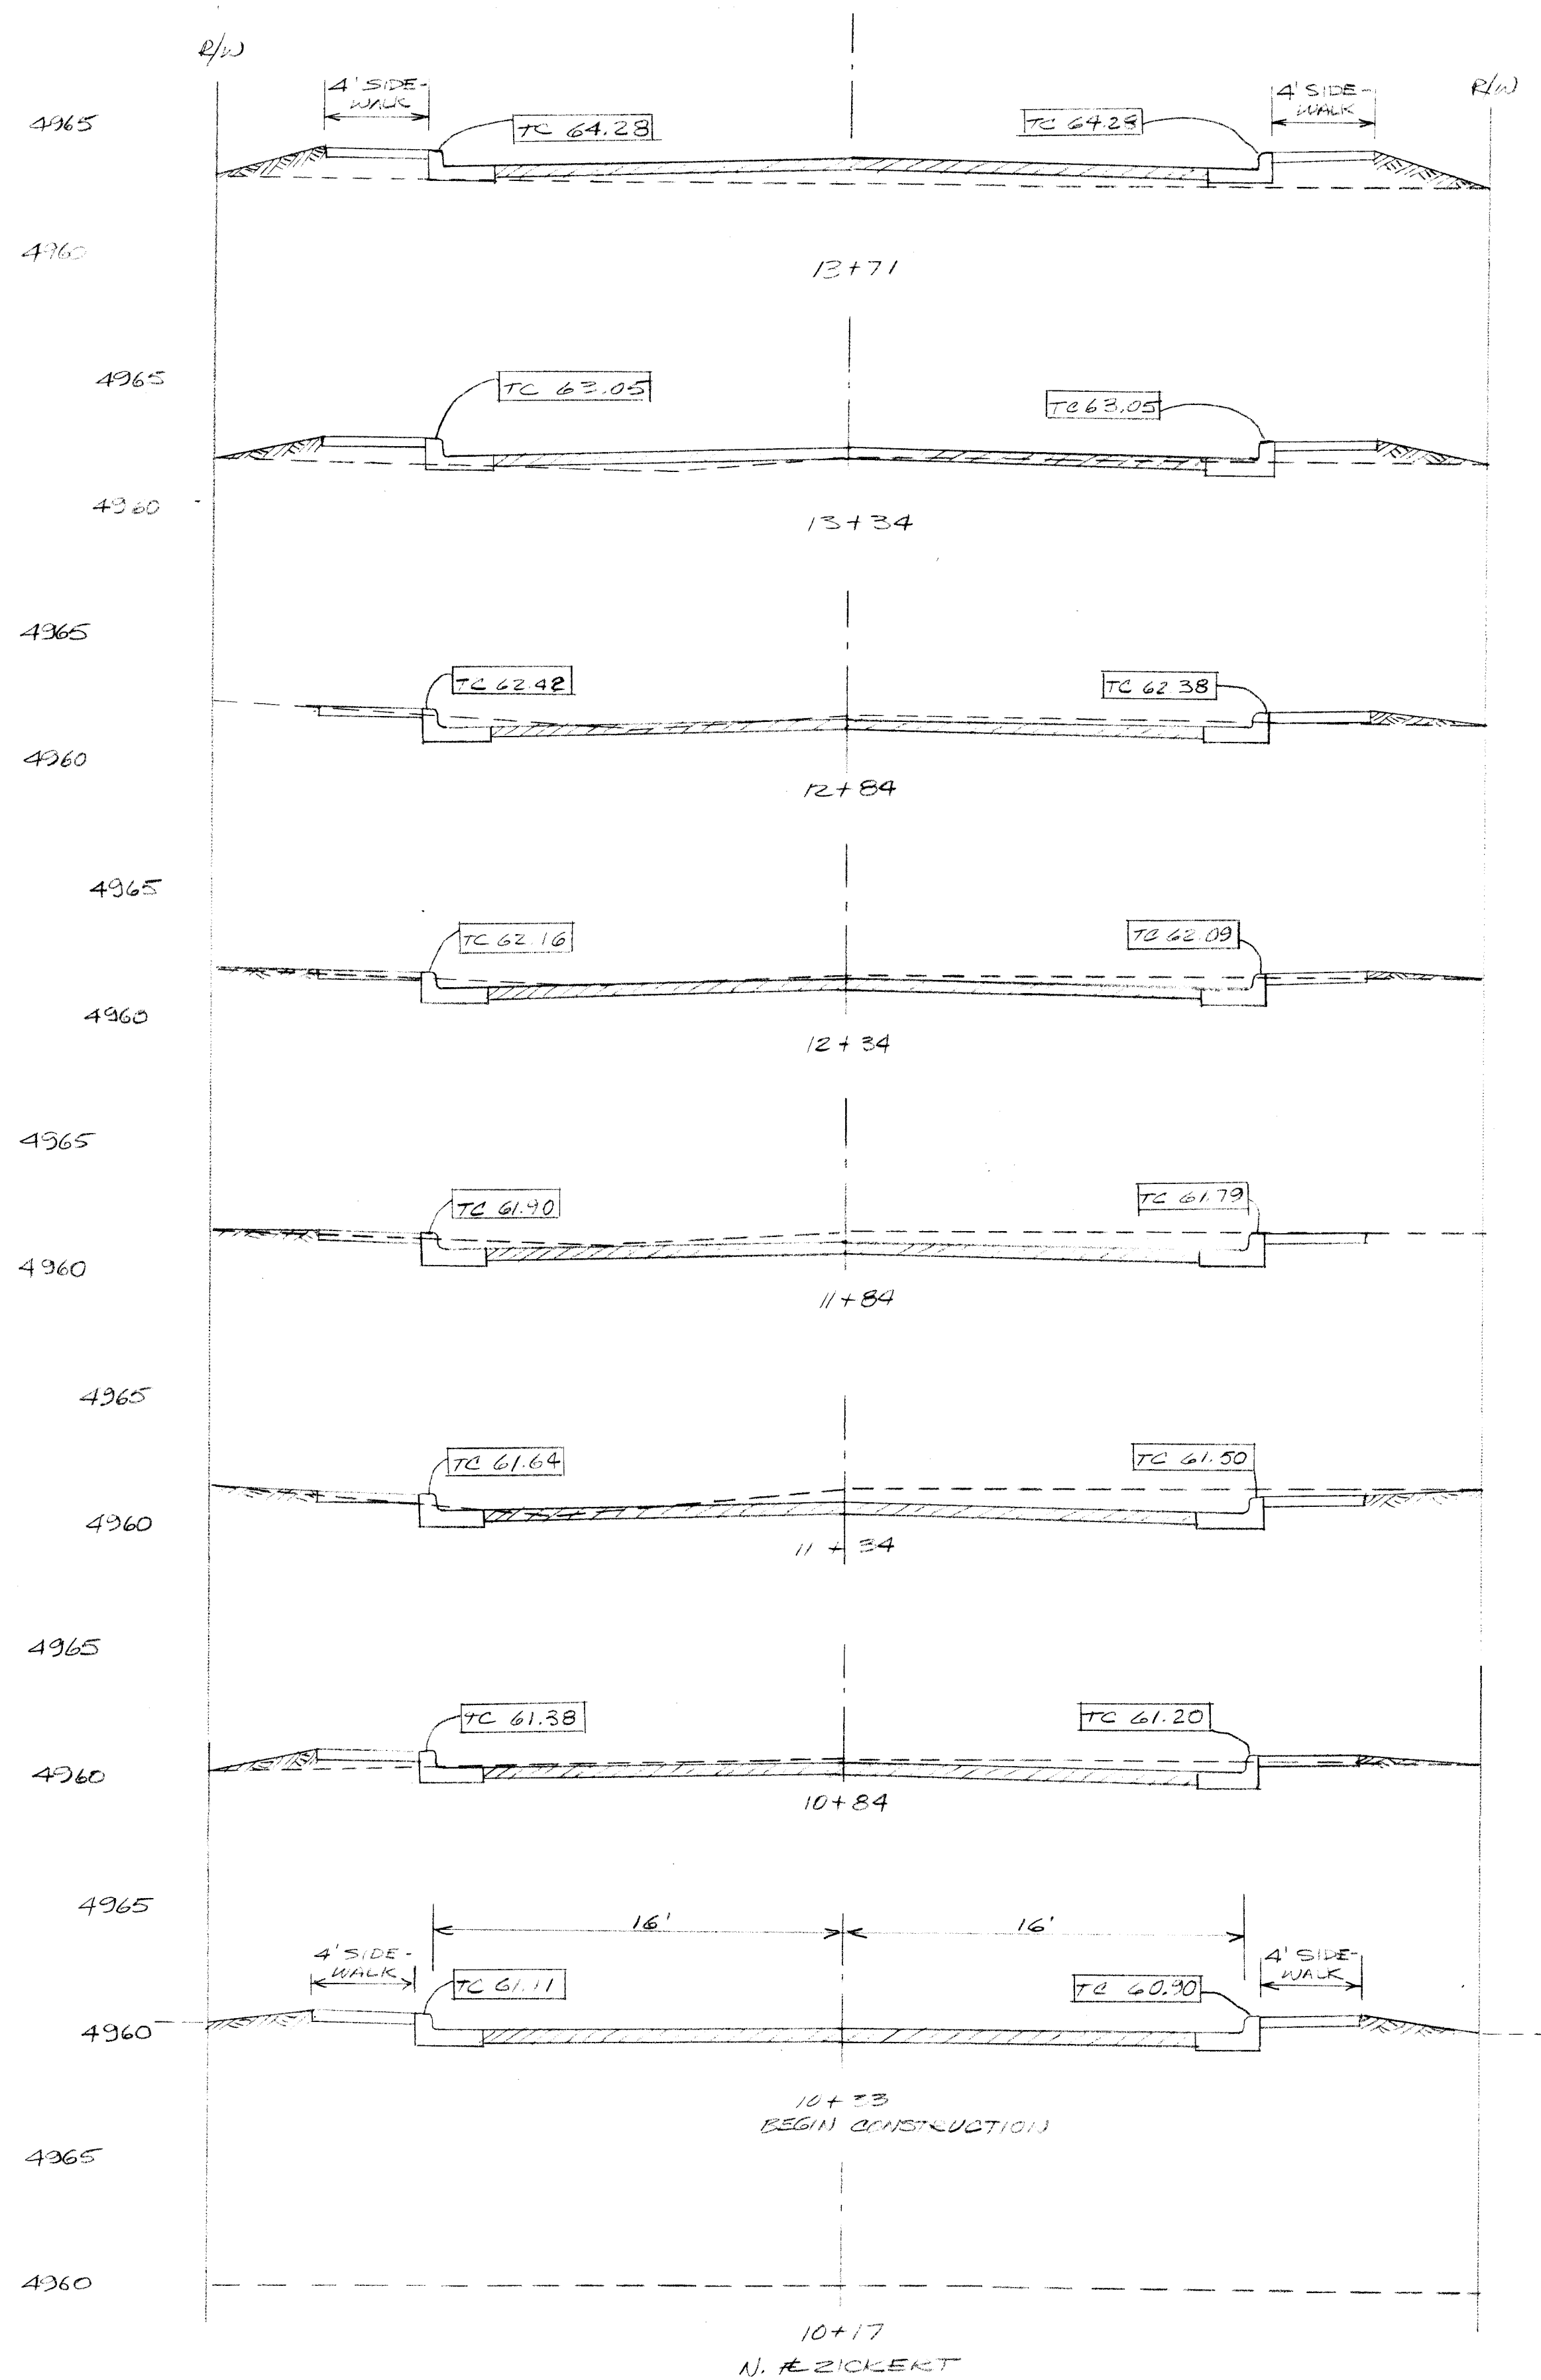

APPLE LANE, NW, PAVING
CROSS SECTIONS

26 1297 0384

2/10/83

2/10/83
6/10/83
1297

CBM - WNW RET AT INTER.
ZICKERT & APPLE LANE
TC ELEV. 4960.83

PS24 AGUIAR 16-82




THIS BRASS TABLET INTER INDIAN
SCH RD. & RIO GRANDE BLVD.
ELEV. 4961.60

3/13/82
6/10/83



S. MIRALDA
B. EMMETT
12/10/83

NA
NA
NA

3 4

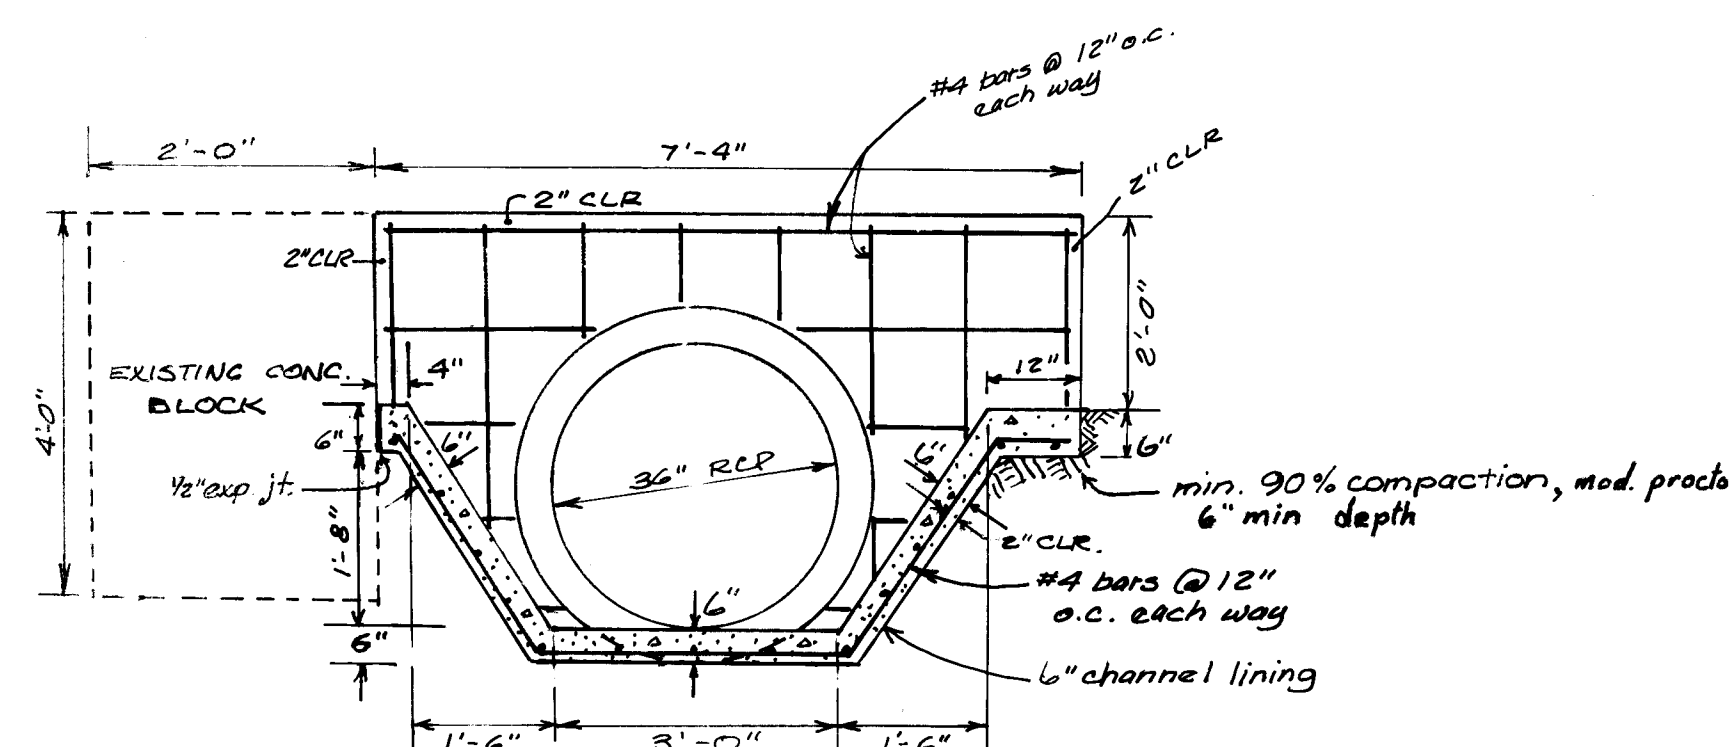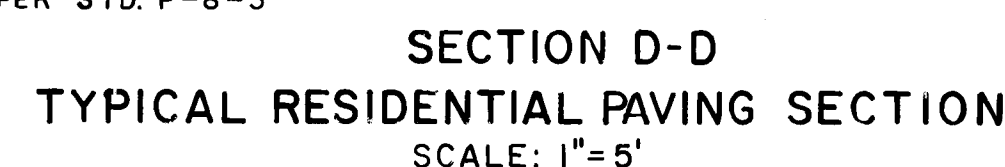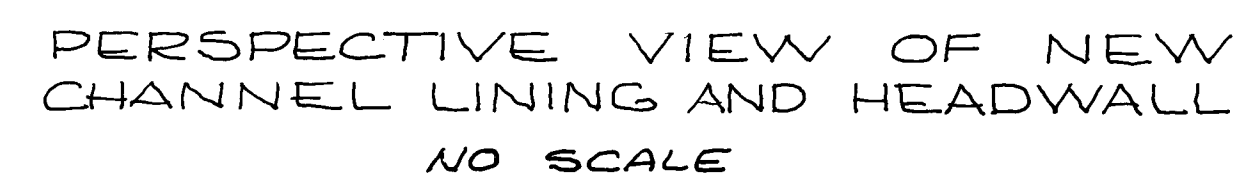

SECTION B-B
SCALE 1" = 2'

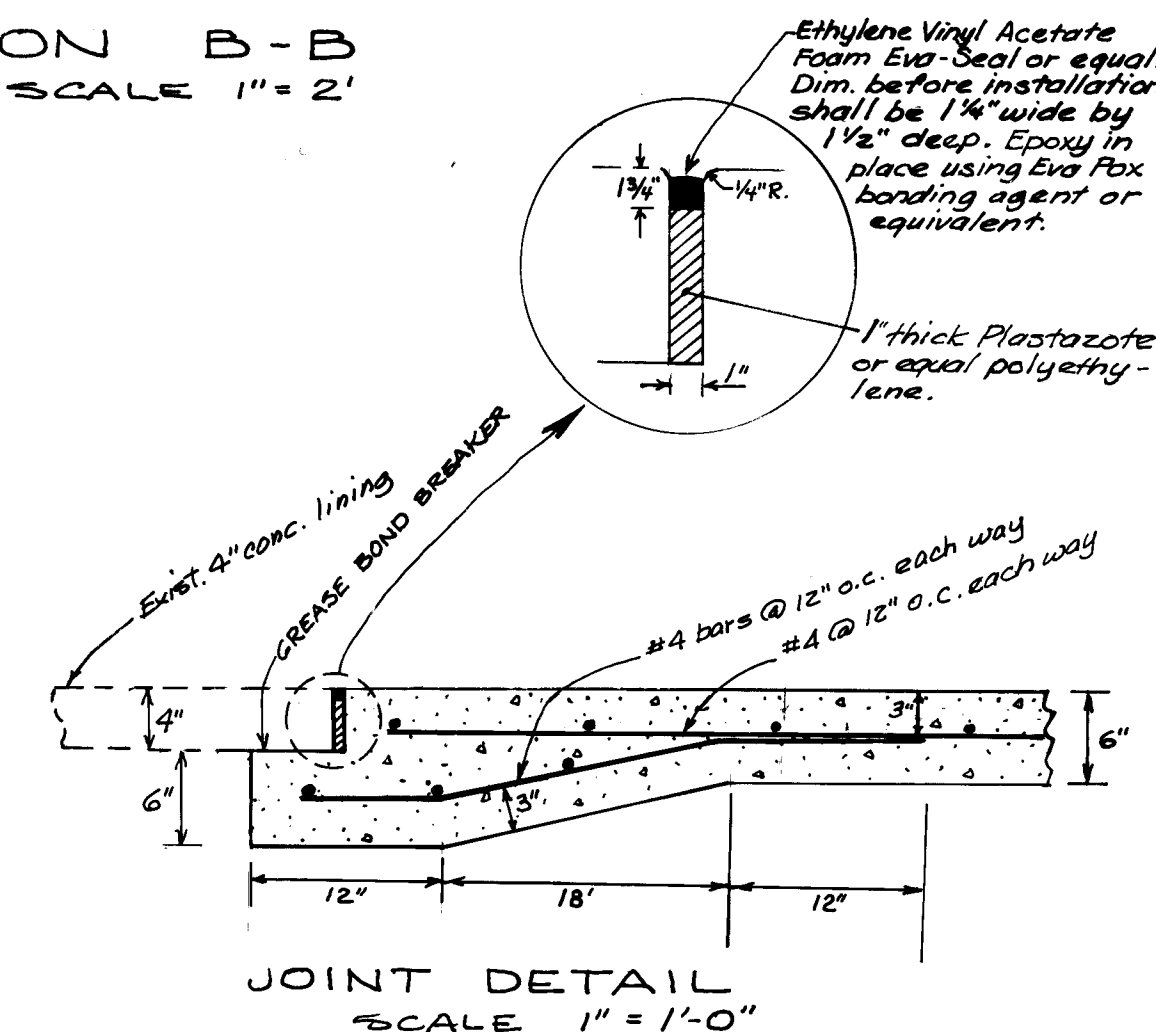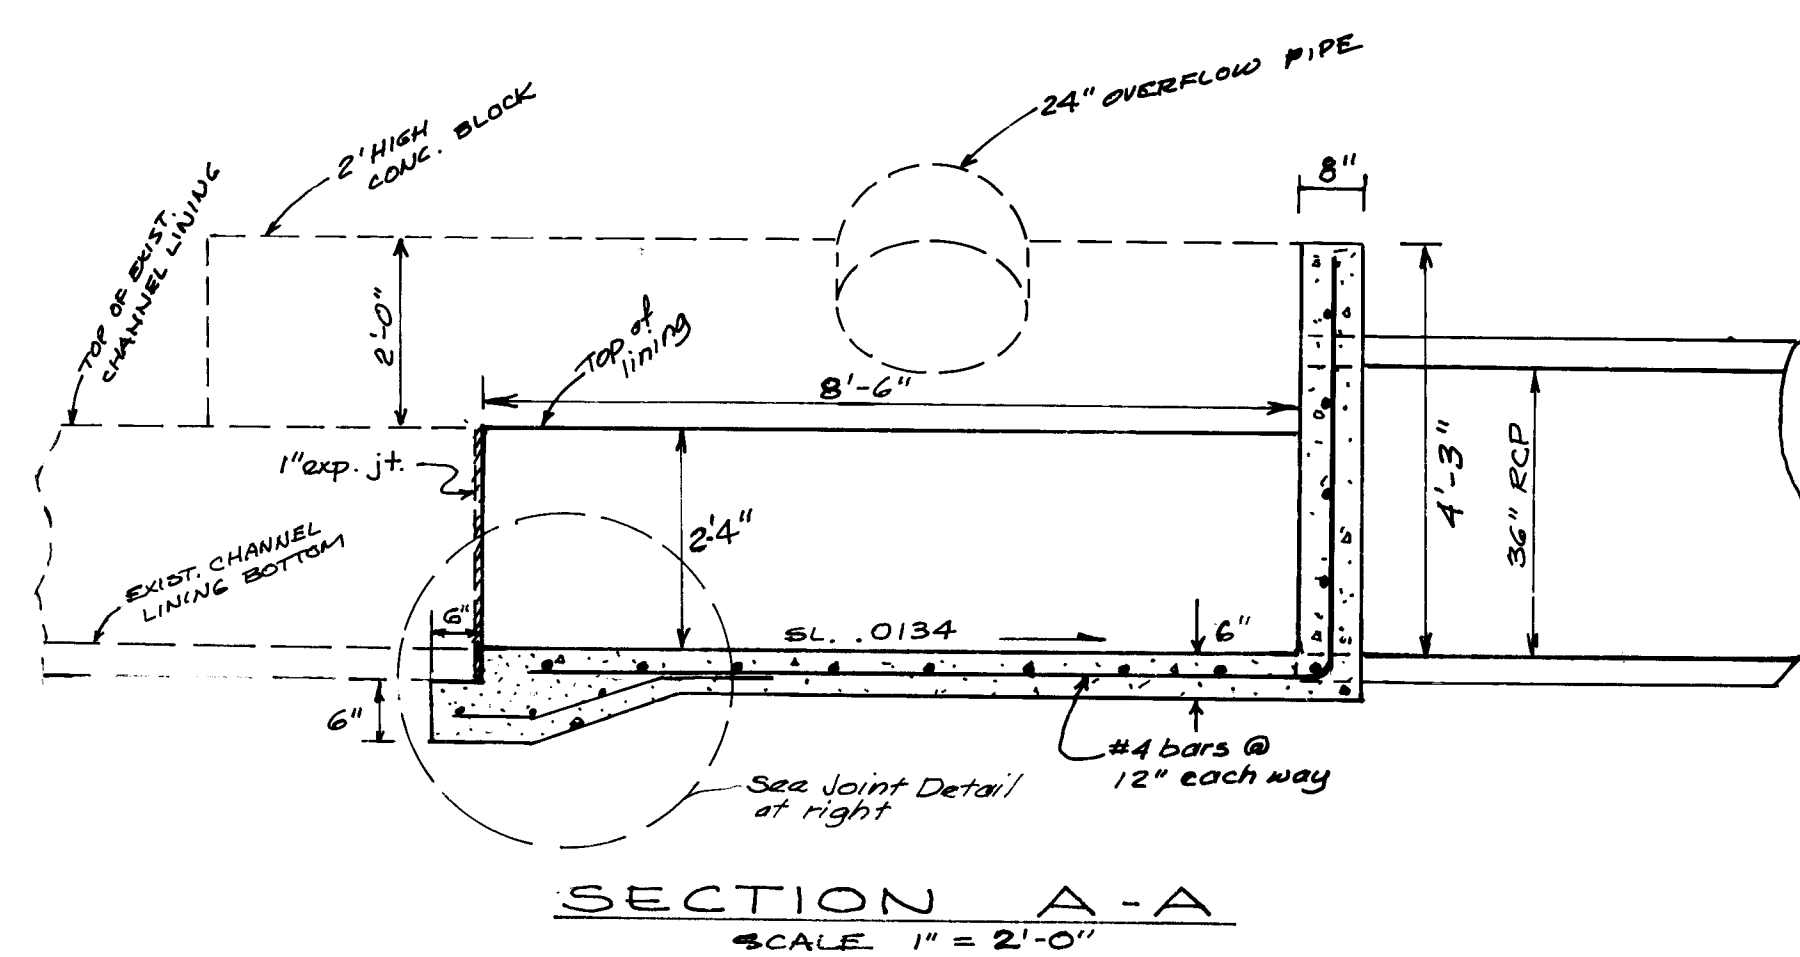

ENGINEER'S SEAL				SURVEY INFORMATION		BENCH MARKS		AS BUILT INFORMATION	
				FIELD NOTES					
NO.	DATE	REMARKS	BY	NO.	BY	DATE	CBM - WNW RET AT INTER OF	CONTRACTOR	
				PS 24	AQUIAR	1-6-82	ZICKERT AND APPLE LAINE	WORK STAKED BY	DATE
							TC ELEV. 4960.83	ACCEPTANCE BY	DATE
								FIELD VERIFICATION BY	DATE
								DRAWINGS	DATE
								CORRECTED BY	DATE
								MICRO-FILM INFORMATION	
								RECORDED BY	DATE
								NO.	

26 1297 0484

CITY OF ALBUQUERQUE
MUNICIPAL DEVELOPMENT DEPARTMENT
ENGINEERING DIVISION

TITLE: APPLE LANE, N.W., N. of ZICKERT
Construction details of channel lining and
headwall for 36" RCP, *estate type paving*

APPROVALS	ENGINEER	DATE	APPROVALS	ENGINEER	DATE
City Engineer	<i>C. D. H. Jones</i>	<i>10/10/83</i>	Liquid Waste	<i>WJ</i>	
A.C.E. - Design	<i>Robert Wilson</i>	<i>10/10/83</i>	Traffic	<i>WJ</i>	<i>10/10/83</i>
A.C.E. - Hydrology	<i>B. J. Jones</i>	<i>6-21-83</i>	Water	<i>WJ</i>	
QA	<i>A. R. Jones</i>	<i>6/10/83</i>			

DRAWING NO. **1297**
 MAP NO. **H.12**
 SHEET **4** OF **4**