
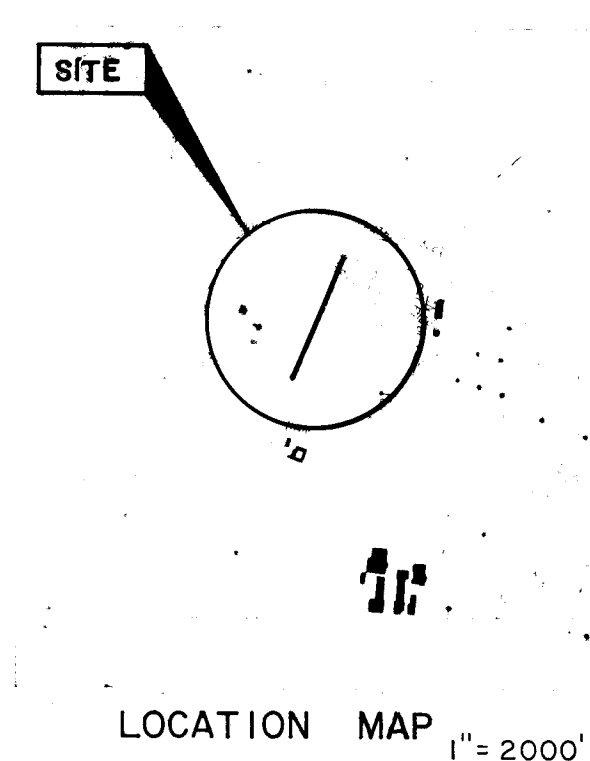
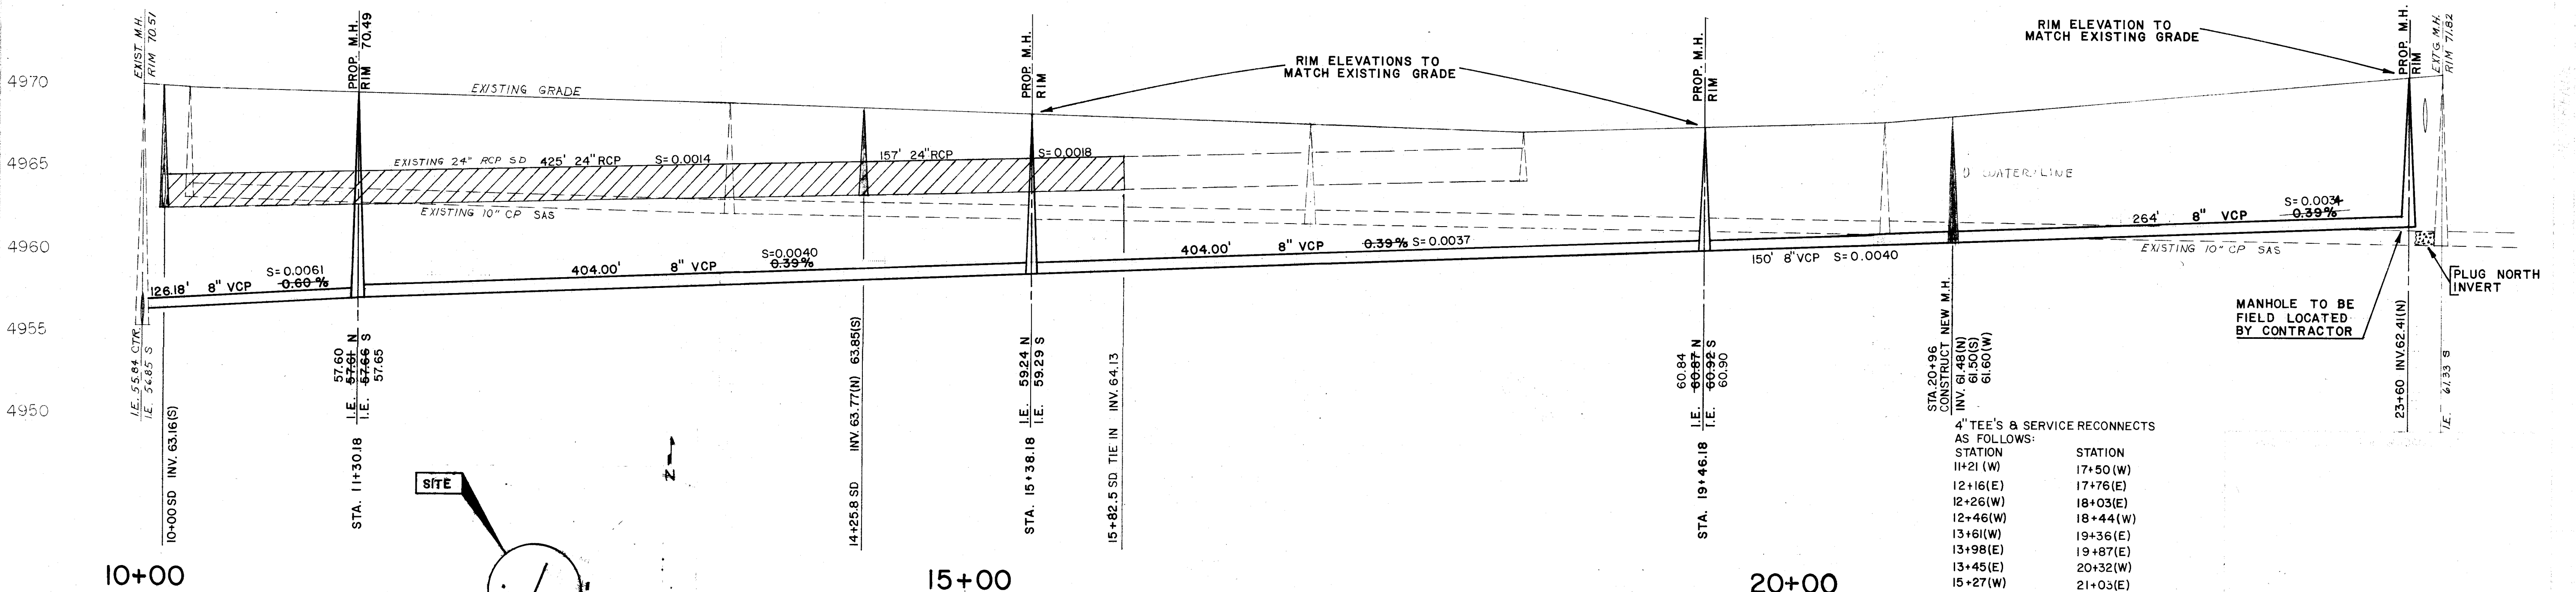


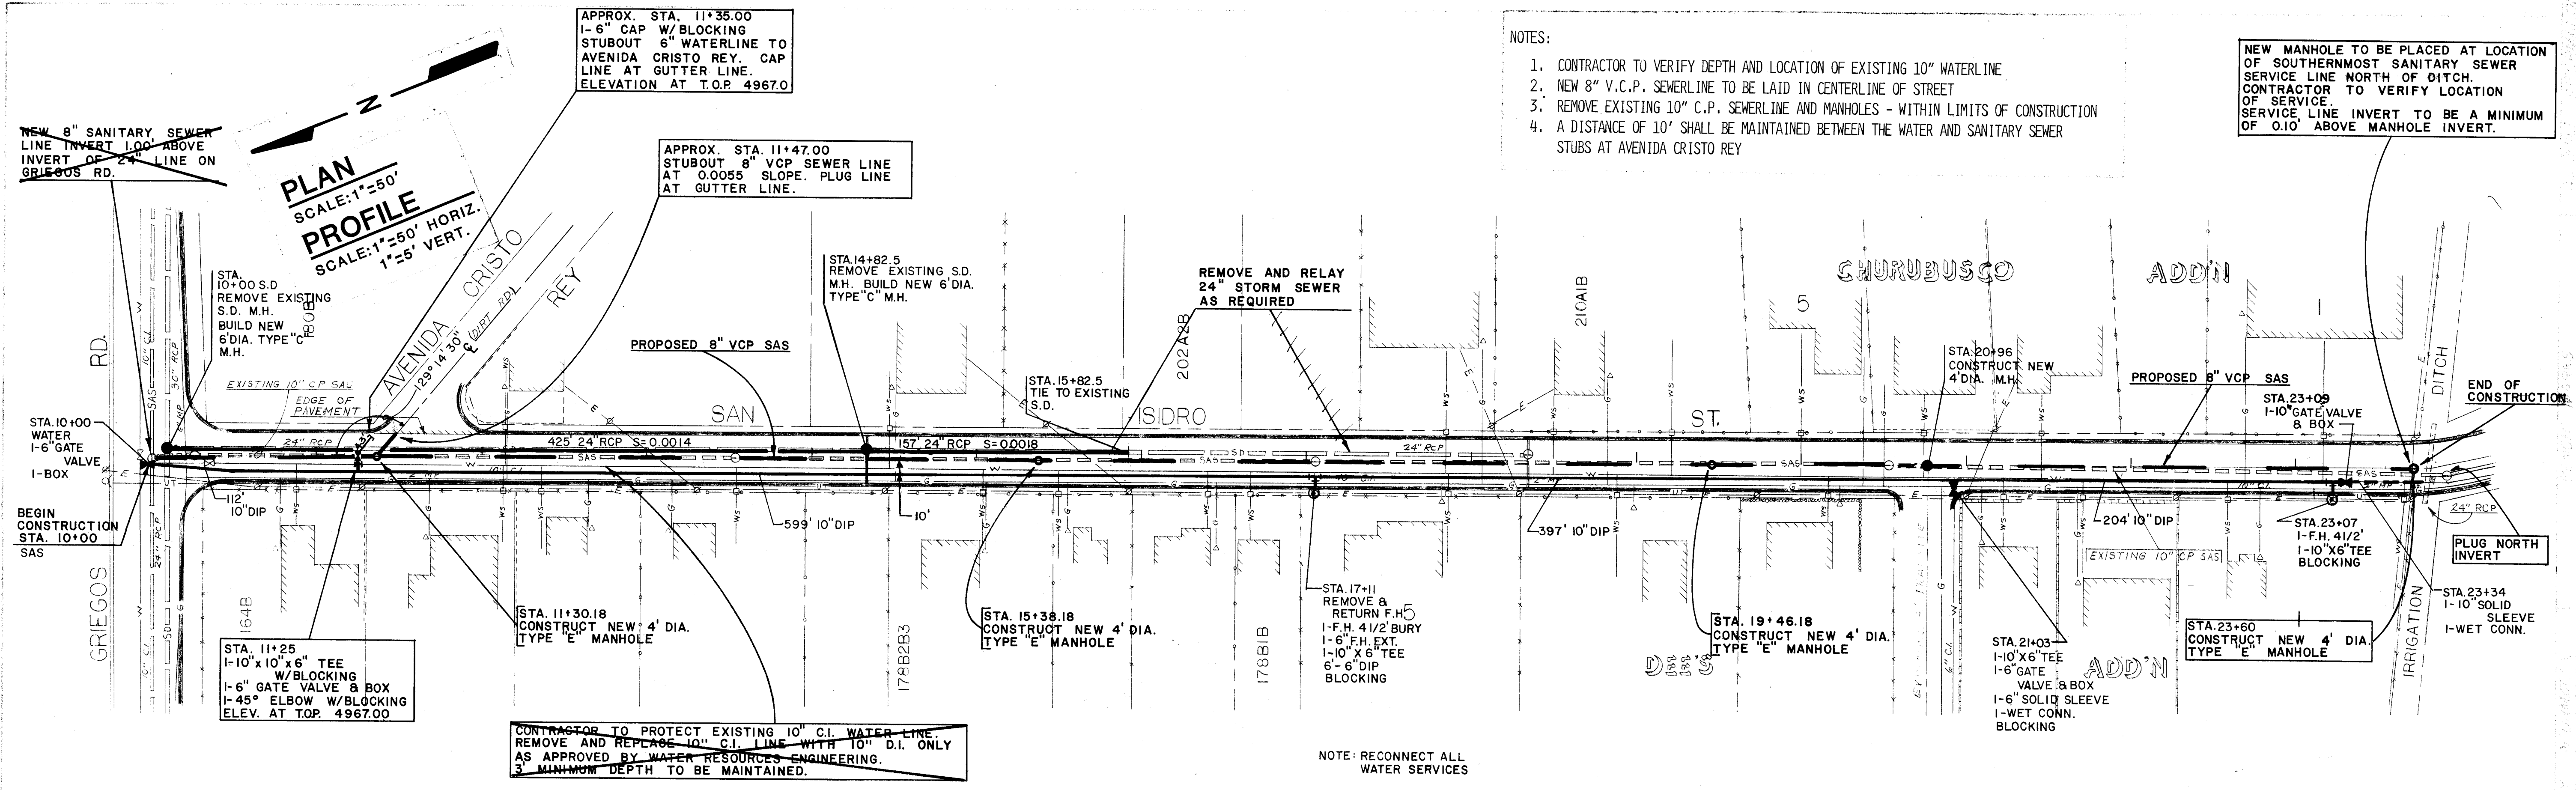

- LEGEND**
- EXISTING SANITARY SEWER
 - PROPOSED SANITARY SEWER
 - ⊙ EXISTING STORM SEWER
 - ⊙ WATER METER
 - ⊙ WATER VALVE
 - ⊙ FIRE HYDRANT
 - ⊙ POWER POLE
 - ⊙ GAS METER
 - EXISTING STORM DRAIN
 - EXISTING SANITARY SEWER
 - PROPOSED SANITARY SEWER
 - EXISTING WATER LINE
 - ELECTRIC POWER LINE
 - WATER SERVICE
 - GAS LINE
 - UNDERGROUND TELEPHONE LINE
 - PROPERTY LINE
 - CURB AND GUTTER
 - CHAIN LINK FENCE
 - WOODEN FENCE
 - WIRE FENCE
 - ROCK WALL
 - BLOCK WALL

STA. 20+96
CONSTRUCT NEW M.H.
INV. 61.48(N)
61.48(S)
61.60(W)

4" TEE'S & SERVICE RECONNECTS
AS FOLLOWS:

STATION	STATION
11+21 (W)	17+50 (W)
12+16 (E)	17+76 (E)
12+26 (W)	18+03 (E)
12+46 (W)	18+44 (W)
13+61 (W)	19+36 (E)
13+98 (E)	19+87 (E)
13+45 (E)	20+32 (W)
15+27 (W)	21+03 (E)
15+58 (W)	21+19 (W)
15+70 (E)	21+69 (E)
16+27 (E)	21+76 (W)
16+54 (W)	22+50 (W)
16+89 (W)	22+91 (E)
16+98 (E)	23+60-4" STUB (W)
17+18 (W)	

EMERGENCY SANITARY SEWER REPLACEMENT
SAN ISIDRO ST. N.W.
INCLUDING WATER & STORM DRAIN