


KLASSEN ADDITION

LEGEND

- Existing Asphalt Paving.
- Proposed Residential Paving
- Existing Conc. Sidewalk
- Existing Curb & Gutter.
- New Conc. Drivepad
- Construction Easement to be Acquired


SCALE: 1" = 5'

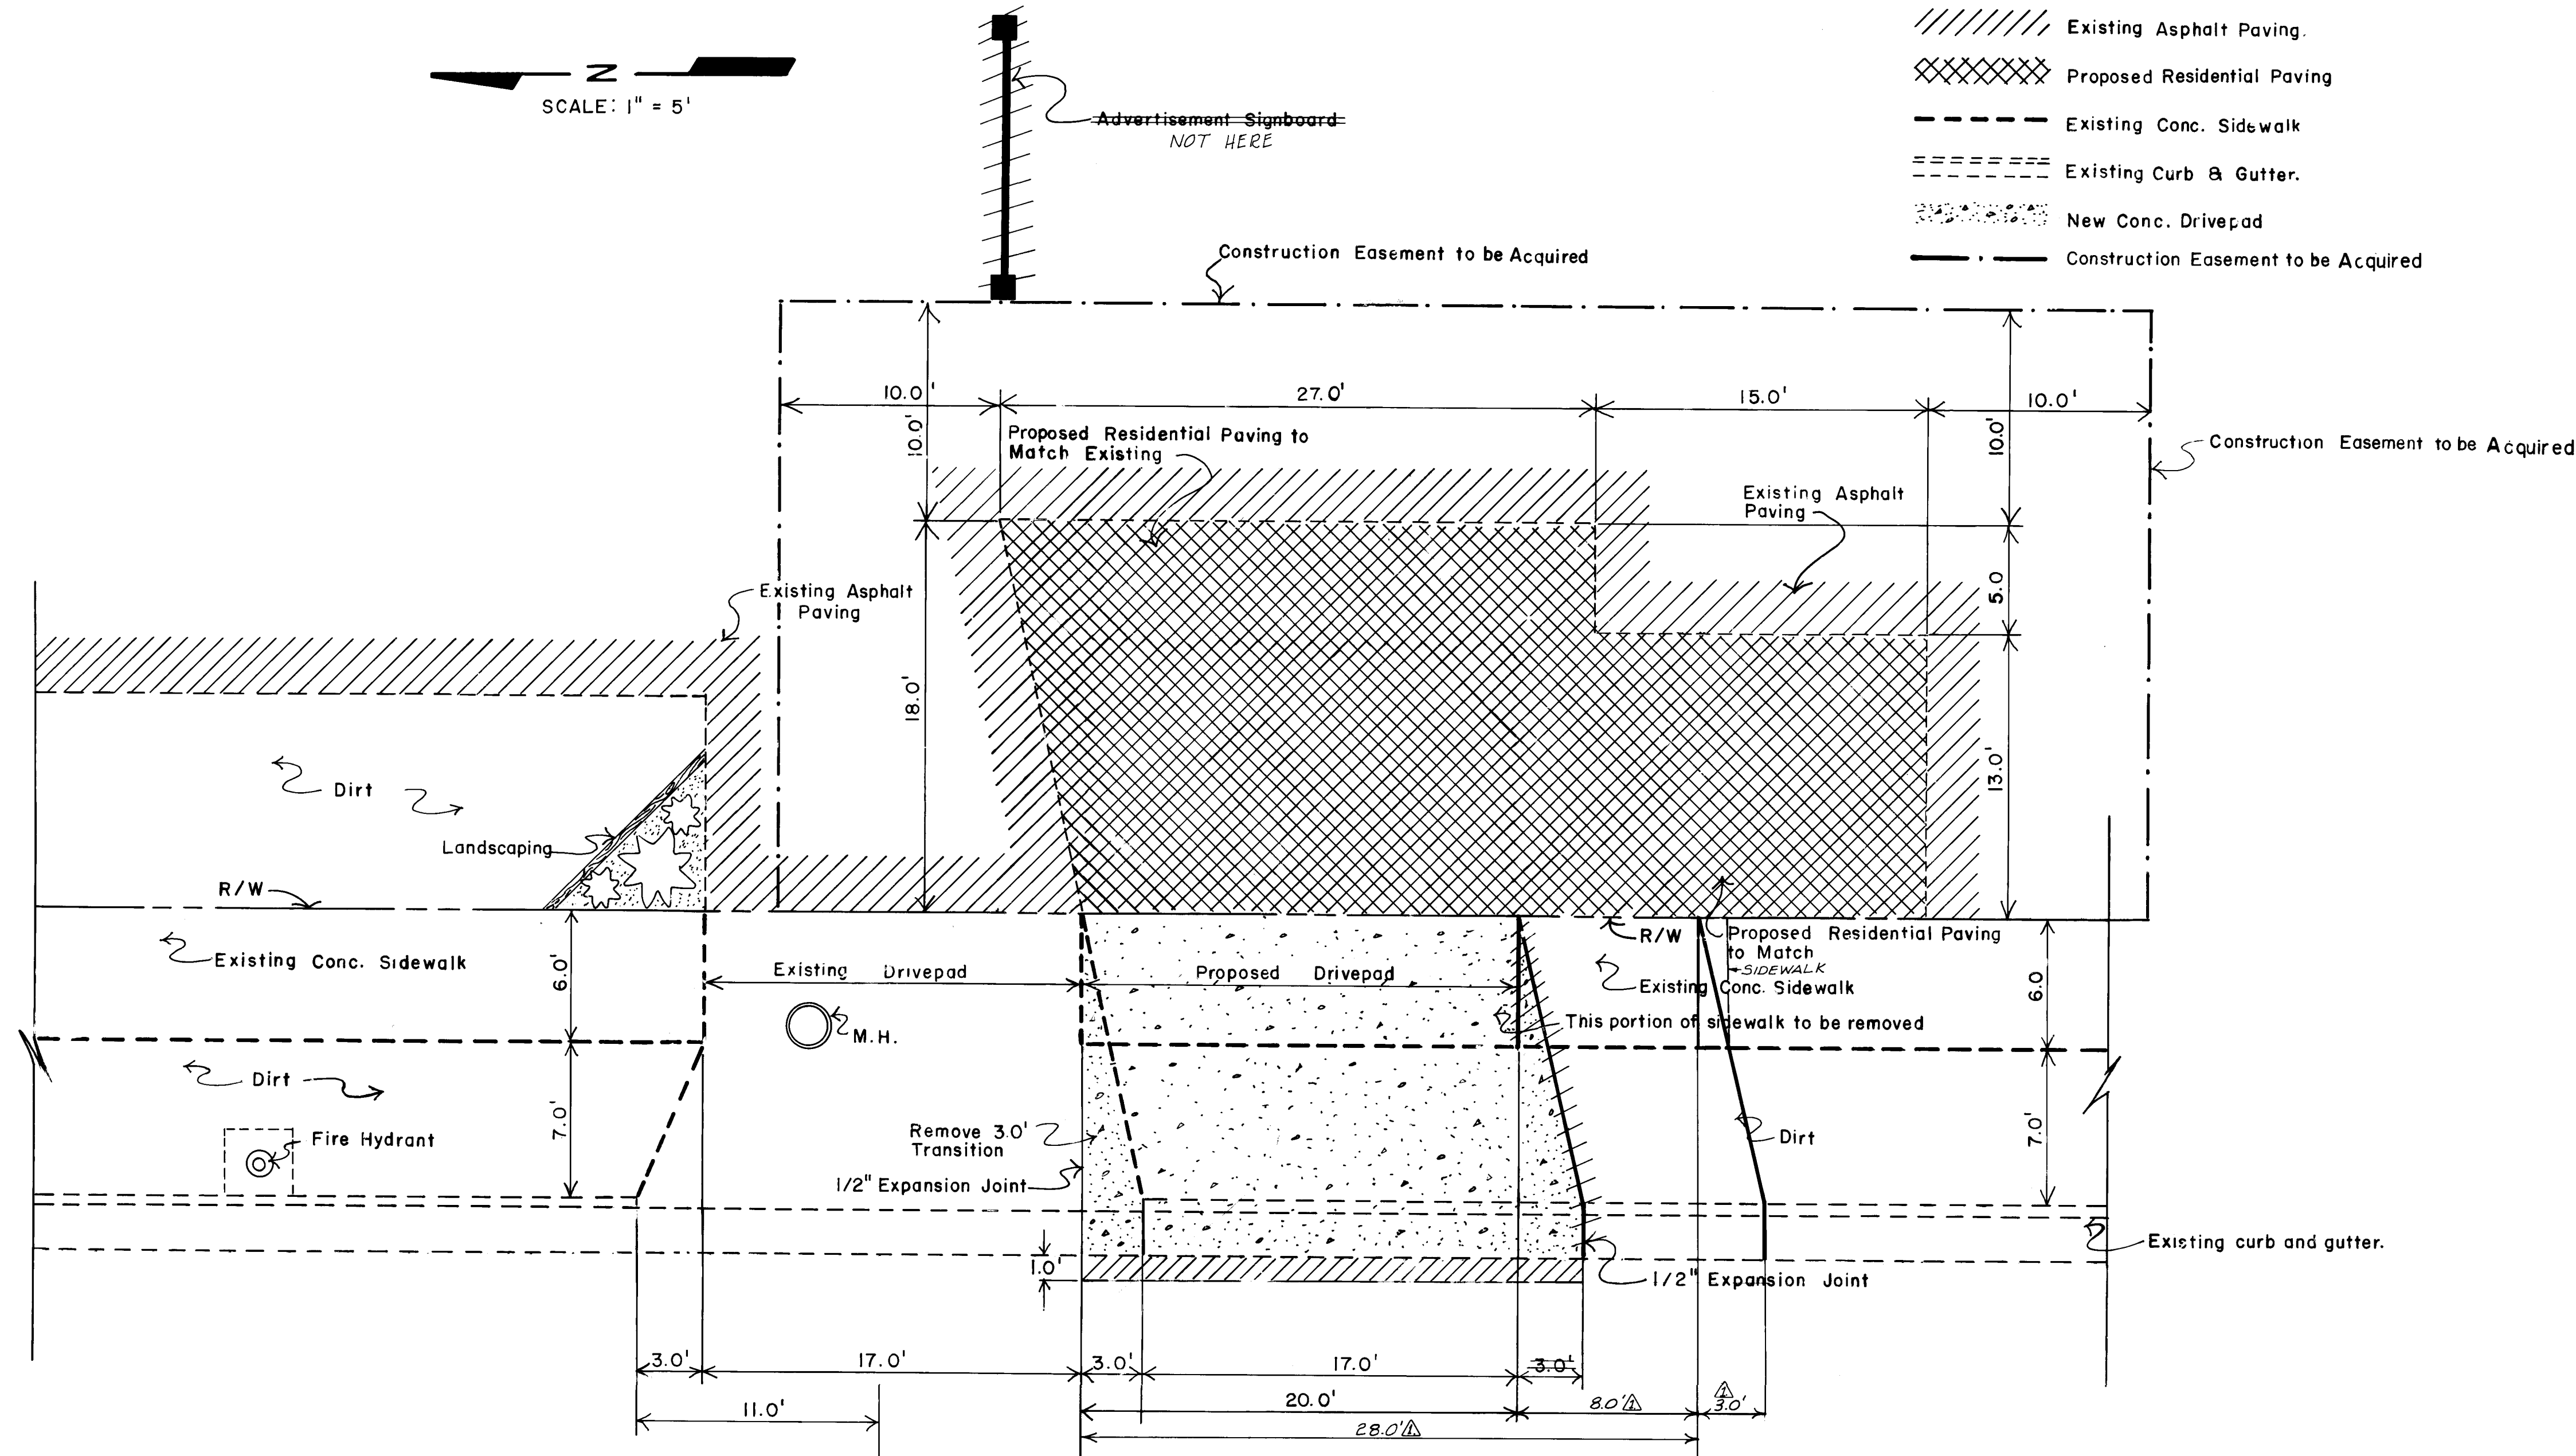

SAN

MATEO

BLVD

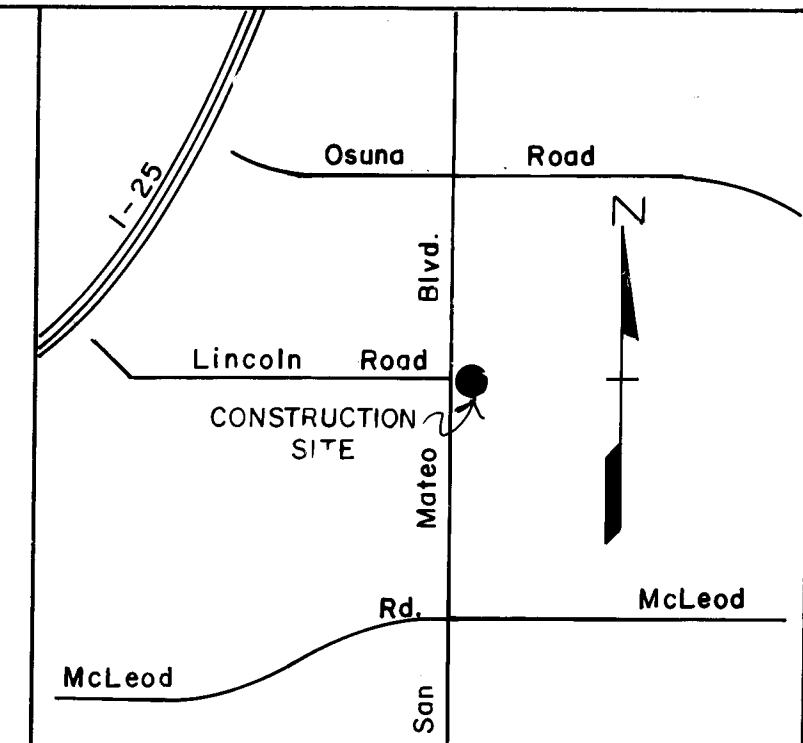

"NOTICE TO CONTRACTORS"

- 1) New Mexico Standard Specification for Public Works Construction - 1979 Edition will be referred to hereon as the "Standard Specification."
- 2) All work detailed on these plans to be performed under contract shall, except as otherwise stated or provided for hereon, be constructed in accordance with "Contract Documents for City-Wide Utilities and Cash Paving No. 30" and the Standard Specification."
- 3) Two working days prior to any excavation, contractor must contact Line Locating Service, 765-1234, for location of existing utilities.
- 4) Prior to construction, the contractor shall excavate and verify the horizontal and vertical locations of all obstructions. Should a conflict exist, the contractor shall notify the engineer or surveyor so that this conflict can be resolved with minimum amount of delay.

THE FOLLOWING NOTES APPLY WHEN CHECKED

- ☒ All utilities and utility service lines shall be installed prior to paving.
- ☒ Backfill compaction shall be according to specified street use. (ARTERIAL)
- ☐ Tack coat requirements shall be determined by the City Engineer.
- ☒ Sidewalks and wheelchair ramps within the curb return shall be constructed wherever a new curb return is constructed.
- ☐ If curb is decreased for a drivepad, the drivepad shall be constructed prior to acceptance of the curb and gutter.
- ☐ All storm drainage facilities shall be completed prior to final acceptance.

AS BUILT INFORMATION		BENCH MARKS		SURVEY INFORMATION		ENGINEER'S SEAL	
CONTRACTOR	DATE	NOT REQUIRED FOR THIS PROJECT	DATE	NO.	BY		
WORK BY	DATE						
FIELD BY	DATE						
ACCEPTANCE BY	DATE						
REVISIONS	DATE						
CORRECTED BY	DATE						
NO.							

CITY OF ALBUQUERQUE
MUNICIPAL DEVELOPMENT DEPARTMENT
ENGINEERING DIVISION

TITLE: Drivepad Expansion on San Mateo Between Osuna Rd. & McLeod Rd.

APPROVED FOR CONSTRUCTION	ENGINEER	DATE	APPROVALS	ENGINEER	DATE
City Engineer	R. M. Salazar	2/11/82	Liquid Waste		
A.C.E. - Design	R. M. Salazar	1/14/82	Traffic	R. M. Salazar	2/12/82
A.C.E. - Hydrology			Water		

CITY ENGINEER	R. M. Salazar	DATE	2/11/82	DRAWING NO.	1339	MAP NO.	F-18	SHEET	1	OF	1
---------------	---------------	------	---------	-------------	------	---------	------	-------	---	----	---

Russell B. Smith
9-16-86

26 13390186