

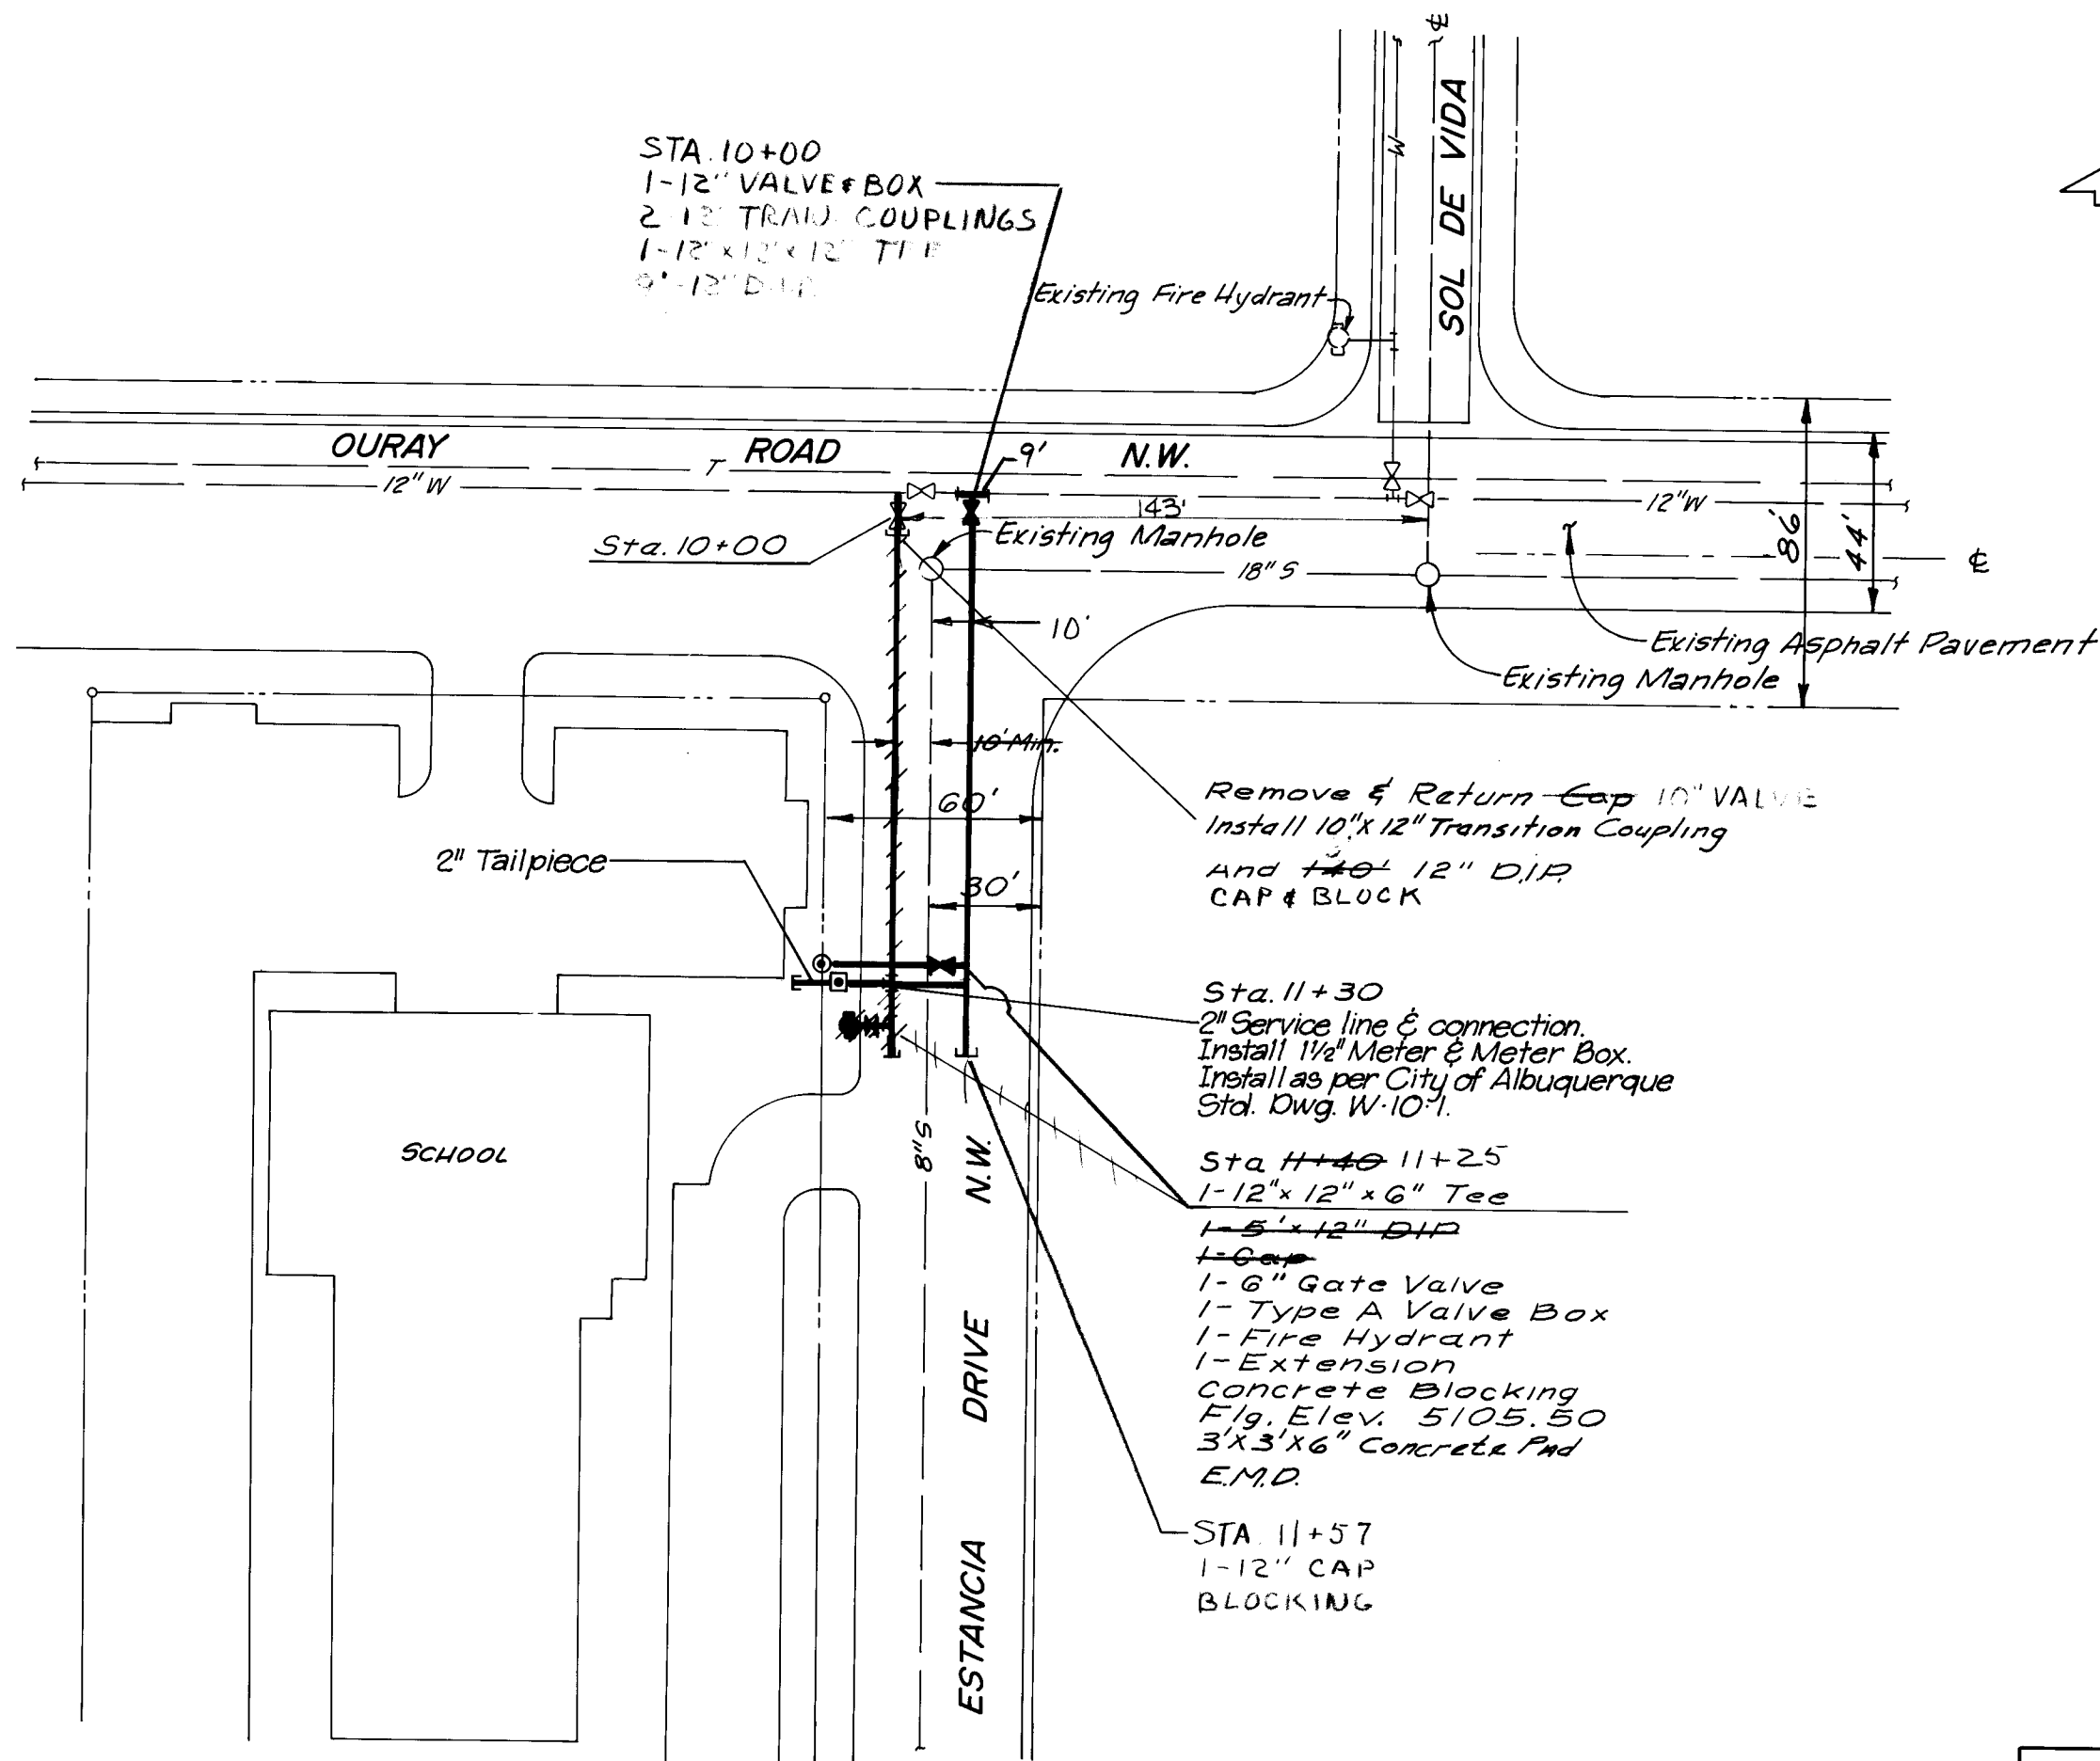


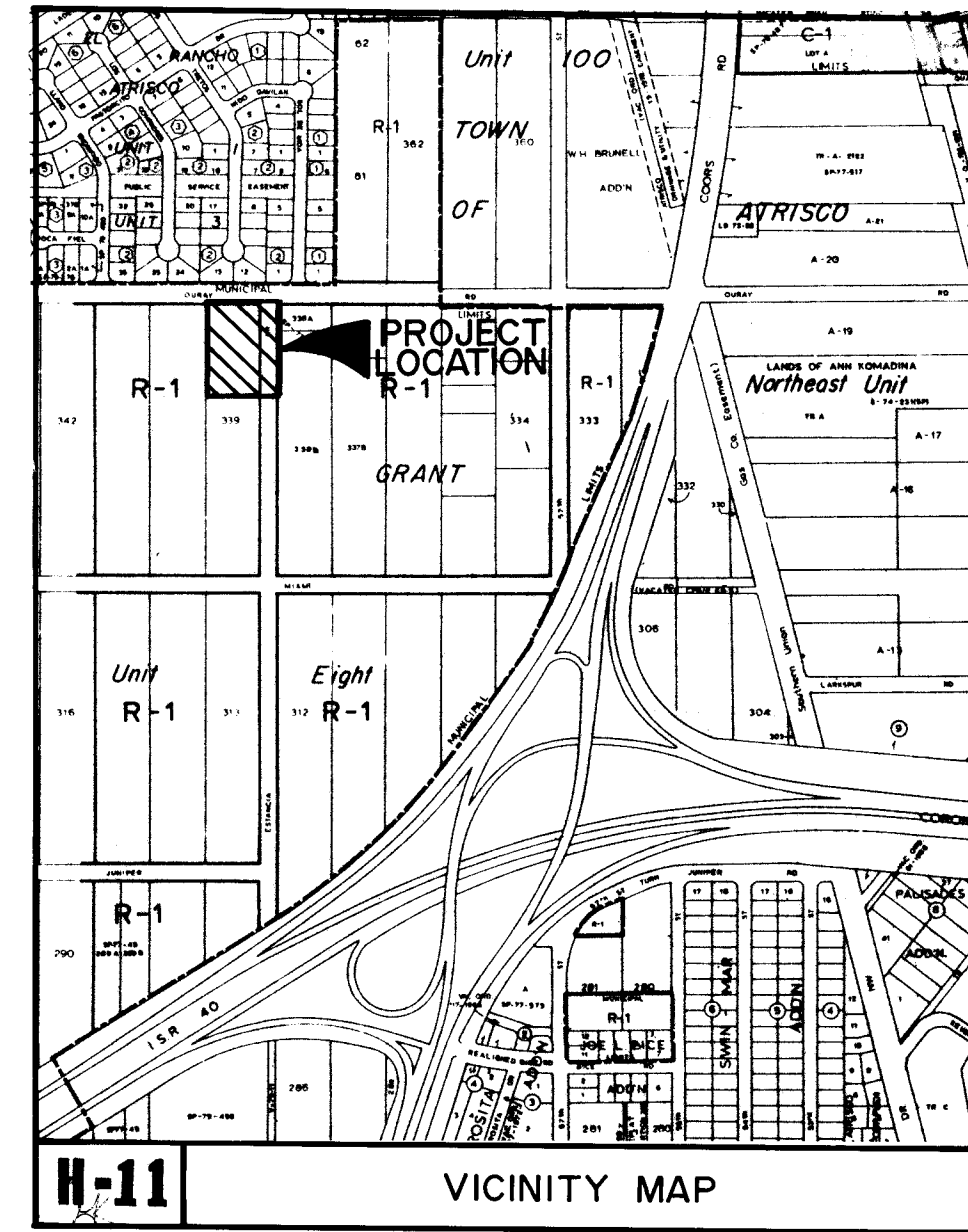

SCALE:  
HORIZONTAL: 1" = 50'  
VERTICAL: 1" = 5'

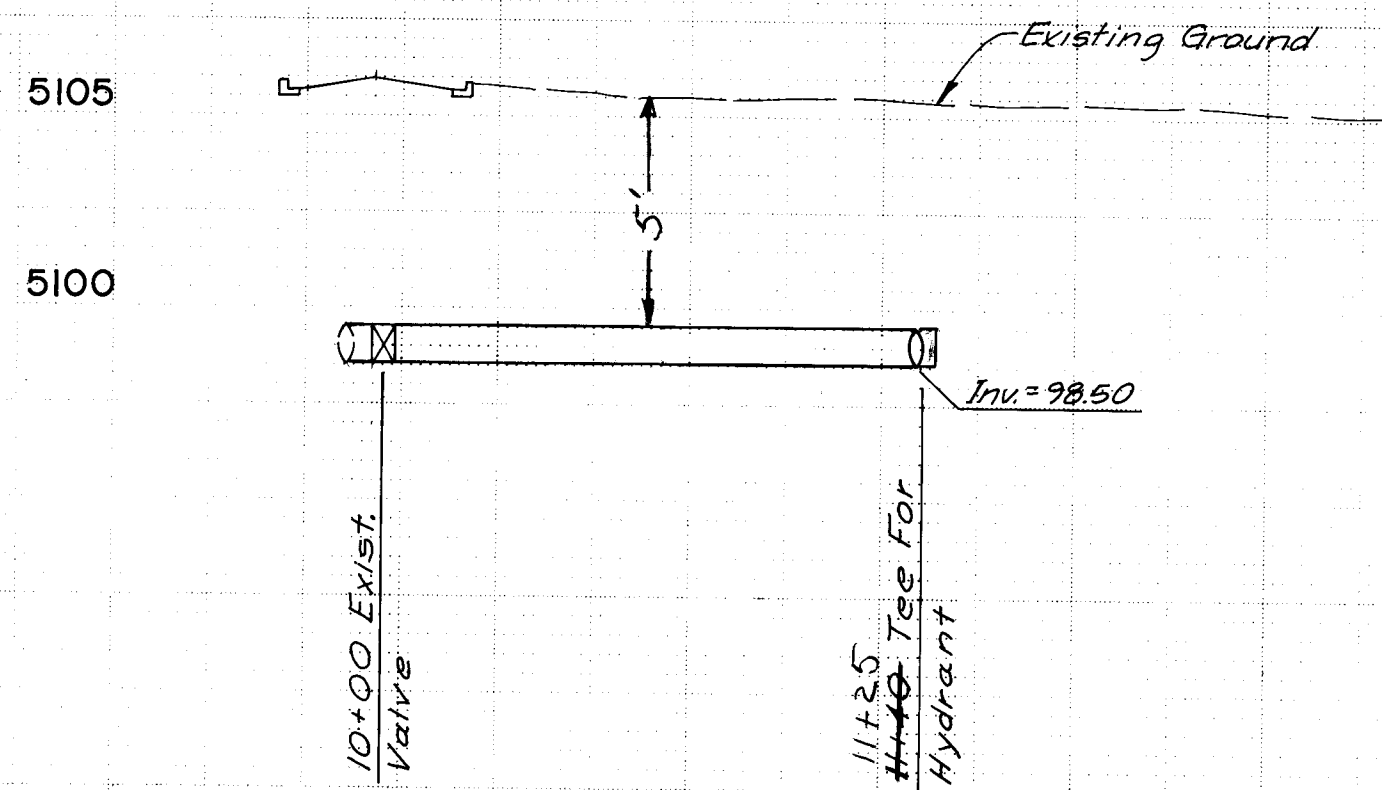

#### NOTICE TO CONTRACTORS


1. New Mexico Standard Specifications for Public Works Construction-1979 Edition will be referred to hereon as the "Standard Specification."
2. All work detailed on these plans to be performed under contract shall, except as otherwise stated or provided for hereon, be constructed in accordance with "Contract Documents for City-Wide Utilities and Cash Paving No. 30 and the Standard Specification."
3. Two working days prior to any excavation, contractor must contact Line Locating Service, 765-1234, for location of existing utilities.
4. Prior to construction, the contractor shall excavate and verify the horizontal and vertical locations of all obstructions. Should a conflict exist, the contractor shall notify the engineer or surveyor so that the conflict can be resolved with a minimum amount of delay.

#### THE FOLLOWING NOTES ALSO APPLY WHEN CHECKED

- ☐ All utilities and utility service lines shall be installed prior to paving.
- ☒ Backfill compaction shall be according to specified street use.
- ☐ Tack coat requirements shall be determined by the City Engineer.
- ☐ Sidewalks and wheelchair ramps within the curb returns shall be constructed wherever a new curb return is constructed.
- ☐ If curb is depressed for a driveway, the driveway shall be constructed prior to acceptance of curb and gutter.
- ☐ All storm drainage facilities shall be completed prior to final acceptance.
- ☒ The requestor or developer shall be responsible for repair or replacement of all curb and gutter or sidewalk damaged after approval by the City Engineer of work completed by the Contractor.

201 13430182

APPROVAL OF AS BUILT DRAWINGS  
ASSIST. CHIEF ENGINEER FIELD  
DATE 11/25/81

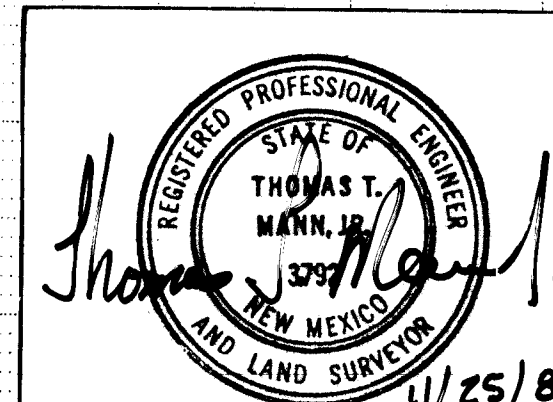

JOB NO. 1-115  
APPROVED FOR CONSTRUCTION  
DATE 11/25/81

| CITY OF ALBUQUERQUE<br>MUNICIPAL DEVELOPMENT DEPARTMENT<br>ENGINEERING DIVISION |          |          |              |          |         |
|---------------------------------------------------------------------------------|----------|----------|--------------|----------|---------|
| TITLE: FIRE HYDRANT INSTALLATION AT<br>ESTANCIA NW. AND OURAY N.W.              |          |          |              |          |         |
| APPROVALS                                                                       | ENGINEER | DATE     | APPROVALS    | ENGINEER | DATE    |
| City Engineer                                                                   | Robble   | 12/2/81  | Liquid Waste | NA       | 12/2/81 |
| A.C.E. - Design                                                                 | Shuler   | 11/22/81 | Traffic      | Shuler   | 12/2/81 |
| A.C.E. - Hydrology                                                              |          | 11/22/81 | Water        |          | 12/2/81 |
| DRAWING NO. 1343                                                                |          |          | SHEET 1 OF 1 |          |         |

| AS BUILT INFORMATION   |                                | BENCH MARKS |  | SURVEY INFORMATION |          | REFERENCES                                         |    | REMARKS |      |
|------------------------|--------------------------------|-------------|--|--------------------|----------|----------------------------------------------------|----|---------|------|
| CONTRACT NO.           | 4CS "NM 448-N3" Elev = 5099.53 | DATE        |  | MAP NO. H-11       | EST. NO. | W.O. NO.                                           | BY | NO.     | DATE |
| INSPECTOR'S NAME       | INSPECTOR'S NAME               | DATE        |  | FIELD NOTES        | BY       |                                                    |    |         |      |
| ACCEPTANCE DATE        | ACCEPTANCE DATE                | DATE        |  |                    |          |                                                    |    |         |      |
| VERIFICATION DATE      | VERIFICATION DATE              | DATE        |  |                    |          |                                                    |    |         |      |
| CORRECTION DATE        | CORRECTION DATE                | DATE        |  |                    |          |                                                    |    |         |      |
| MICRO-FILM INFORMATION |                                | RECORDED BY |  | ENGINEERS          |          | 811 DALLAS N.E. - ALBUQUERQUE - NEW MEXICO - 87102 |    |         |      |