
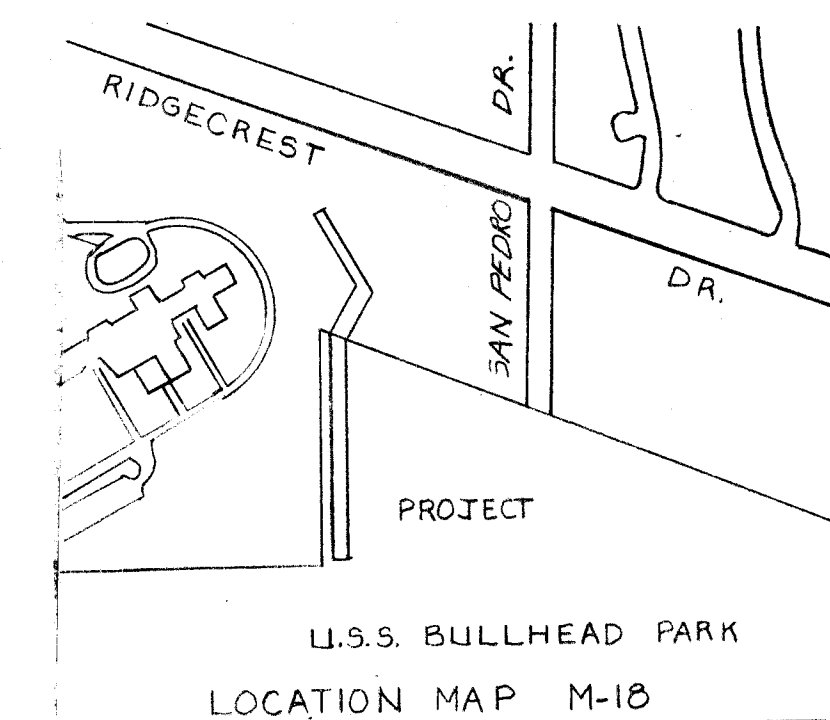


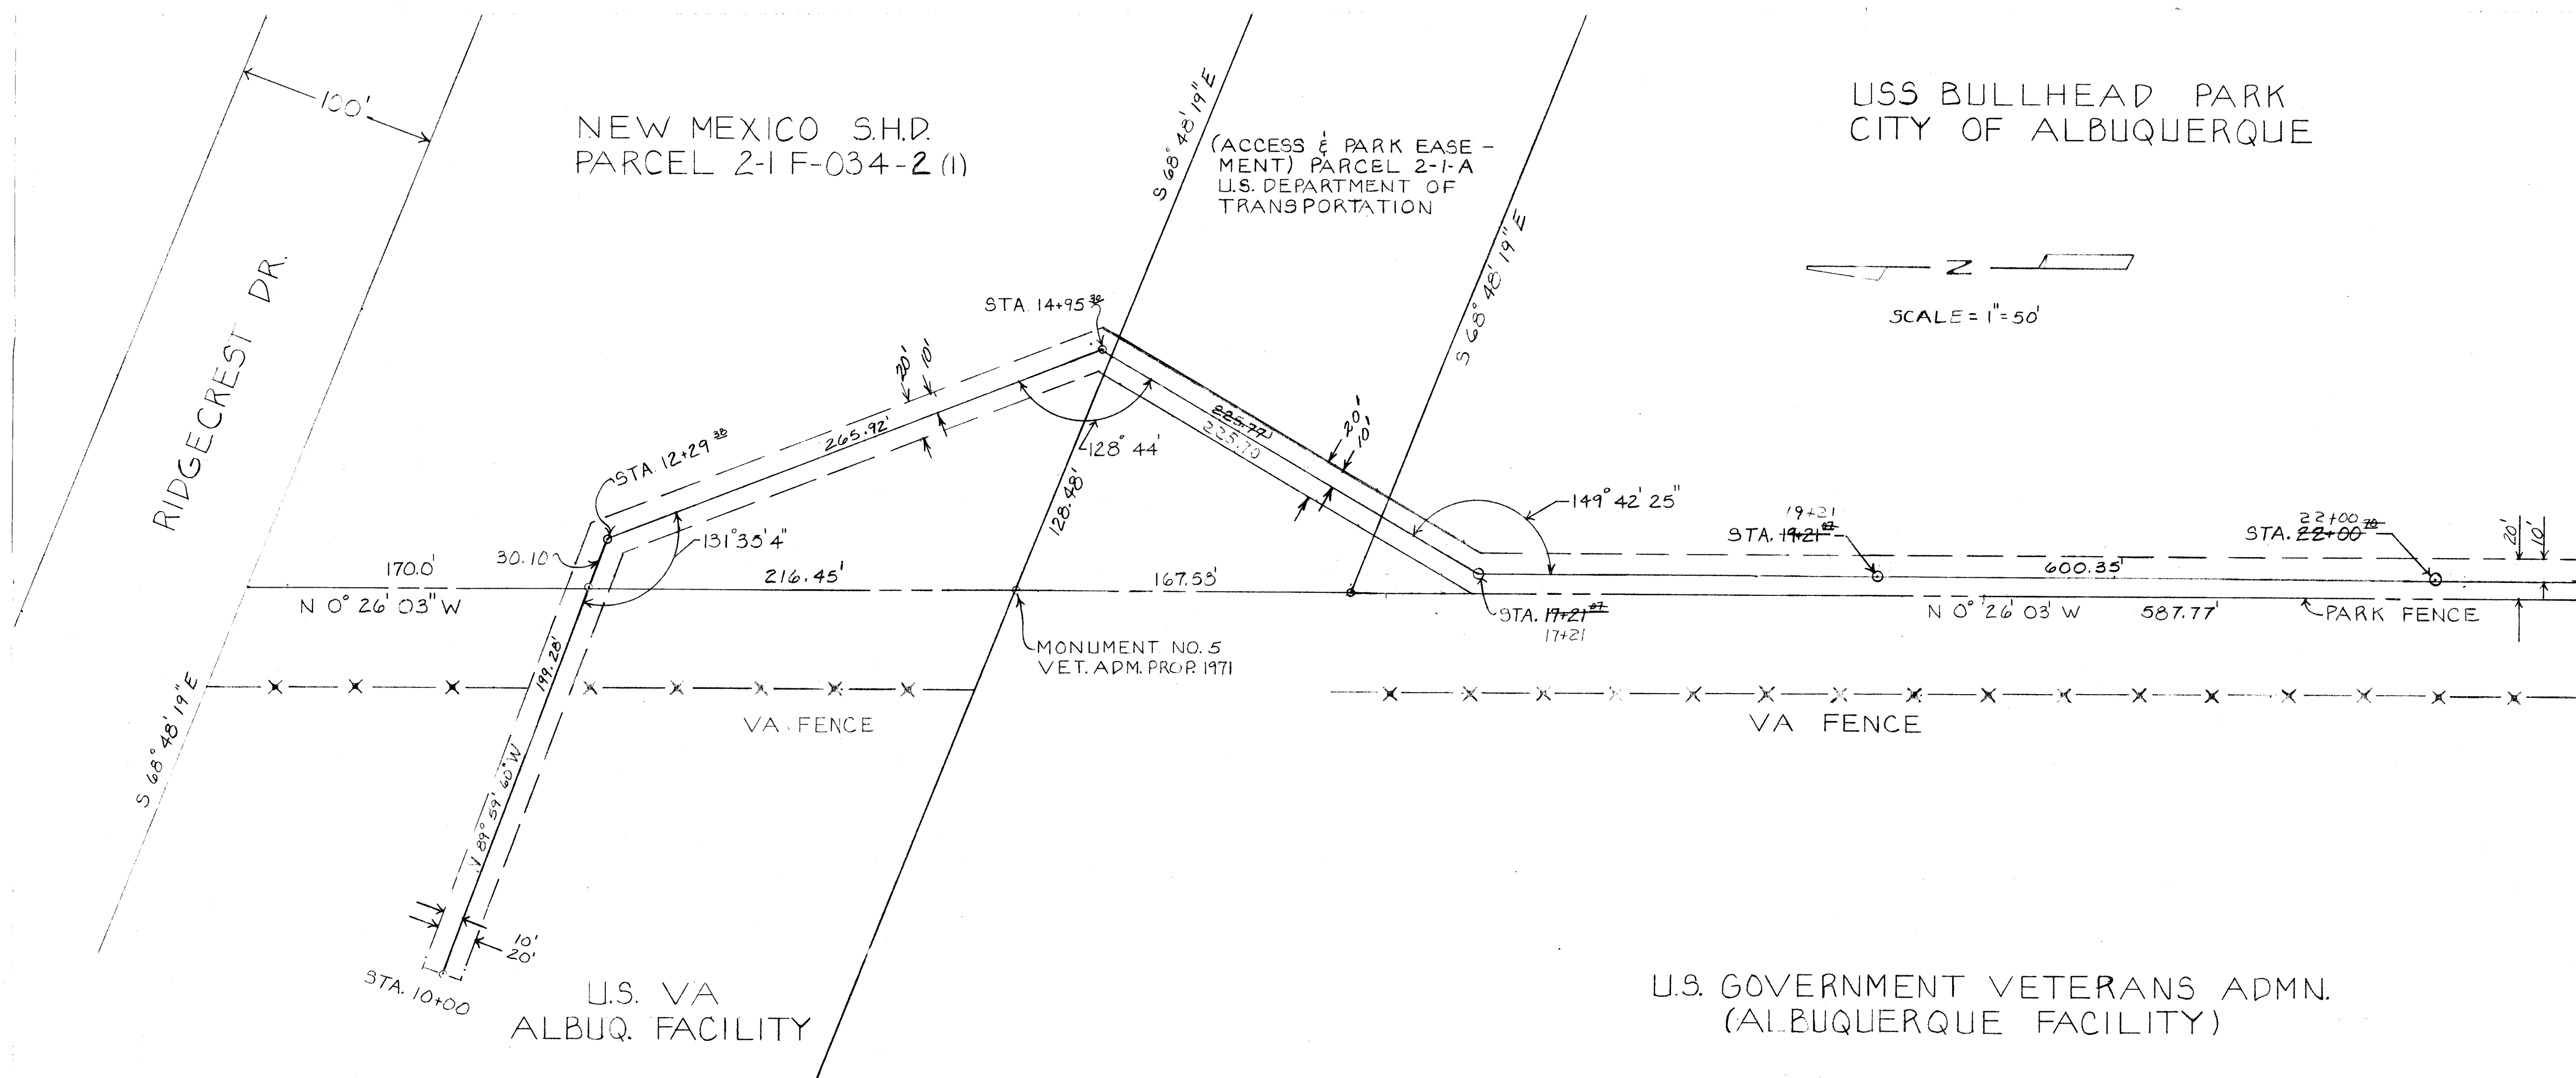

"NOTICE TO CONTRACTORS"

- 1) New Mexico Standard Specification for Public Works Construction - 1973 Edition will be referred to hereon as the "Standard Specification."
- 2) All work detailed on these plans to be performed under contract shall, except as otherwise stated or provided for hereon, be constructed in accordance with "Contract Documents for City-Wide Utilities and Cash Paving No. 30, and the Standard Specification."
- 3) Two working days prior to any excavation, contractor must contact Line Locating Service, 765-1234, for location of existing utilities.
- 4) Prior to construction, the contractor shall excavate and verify the horizontal and vertical locations of all obstructions. Should a conflict exist, the contractor shall notify the engineer or surveyor so that the conflict can be resolved with minimum amount of delay.

THE FOLLOWING NOTES APPLY WHEN CHECKED

- ☐ All utilities and utility service lines shall be installed prior to paving.
- ☒ Backfill compaction shall be according to specified street use. (RESIDENTIAL).
- ☒ Tack coat requirements shall be determined by the City Engineer.
- ☐ Sidewalks and wheelchair ramps within the curb returns shall be constructed wherever a new curb return is constructed.
- ☐ If curb is used for a driveway, the driveway shall be constructed prior to acceptance of the curb and gutter.
- ☐ All storm drainage facilities shall be completed prior to final acceptance.

NOTES:

1. ALL NEW MANHOLES WILL CONFORM TO CITY STANDARD DWG. S-2-2 FOR TYPE "E" 4' DIAMETER
2. RIM ELEVATION WILL NOT BE HIGHER THAN ADJACENT GROUND.
3. 24 FT. GRADED TEMPORARY ACCESS ROAD WILL BE REQUIRED FROM SAN PEDRO AVE. CURB CUT TO VA ACCESS ROAD CURB CUT. THIS TEMPORARY ACCESS ROAD IS TO PROVIDE VEHICLE MOVEMENT (ESPECIALLY AMBULANCES) DURING THE EXCAVATION OF THE EXISTING ACCESS ROAD.
4. COORDINATE WORK ON THIS PROJECT WITH MR. AL BOBERG PARKS & RECREATION, 766-5080 OR 766-7856.

5350

5345

5340

5335

20 1 3 7 0 1 8 2

BRASS CAP 10' EAST OF EASEMENT

U.S.S. BULLHEAD PARK
SANITARY SEWER LINE
PLAN & PROFILE OF STA. 10+00 TO STA. 22+77.95

DATE: 3/2/82

U.S.S. BULLHEAD PARK
SANITARY SEWER LINE
PLAN & PROFILE OF STA. 10+00 TO STA. 22+77.95

3/2/82

PARKS & RECREATION


1349


M-18

1

3

BOB KIELICH
ELLEN CONCINI

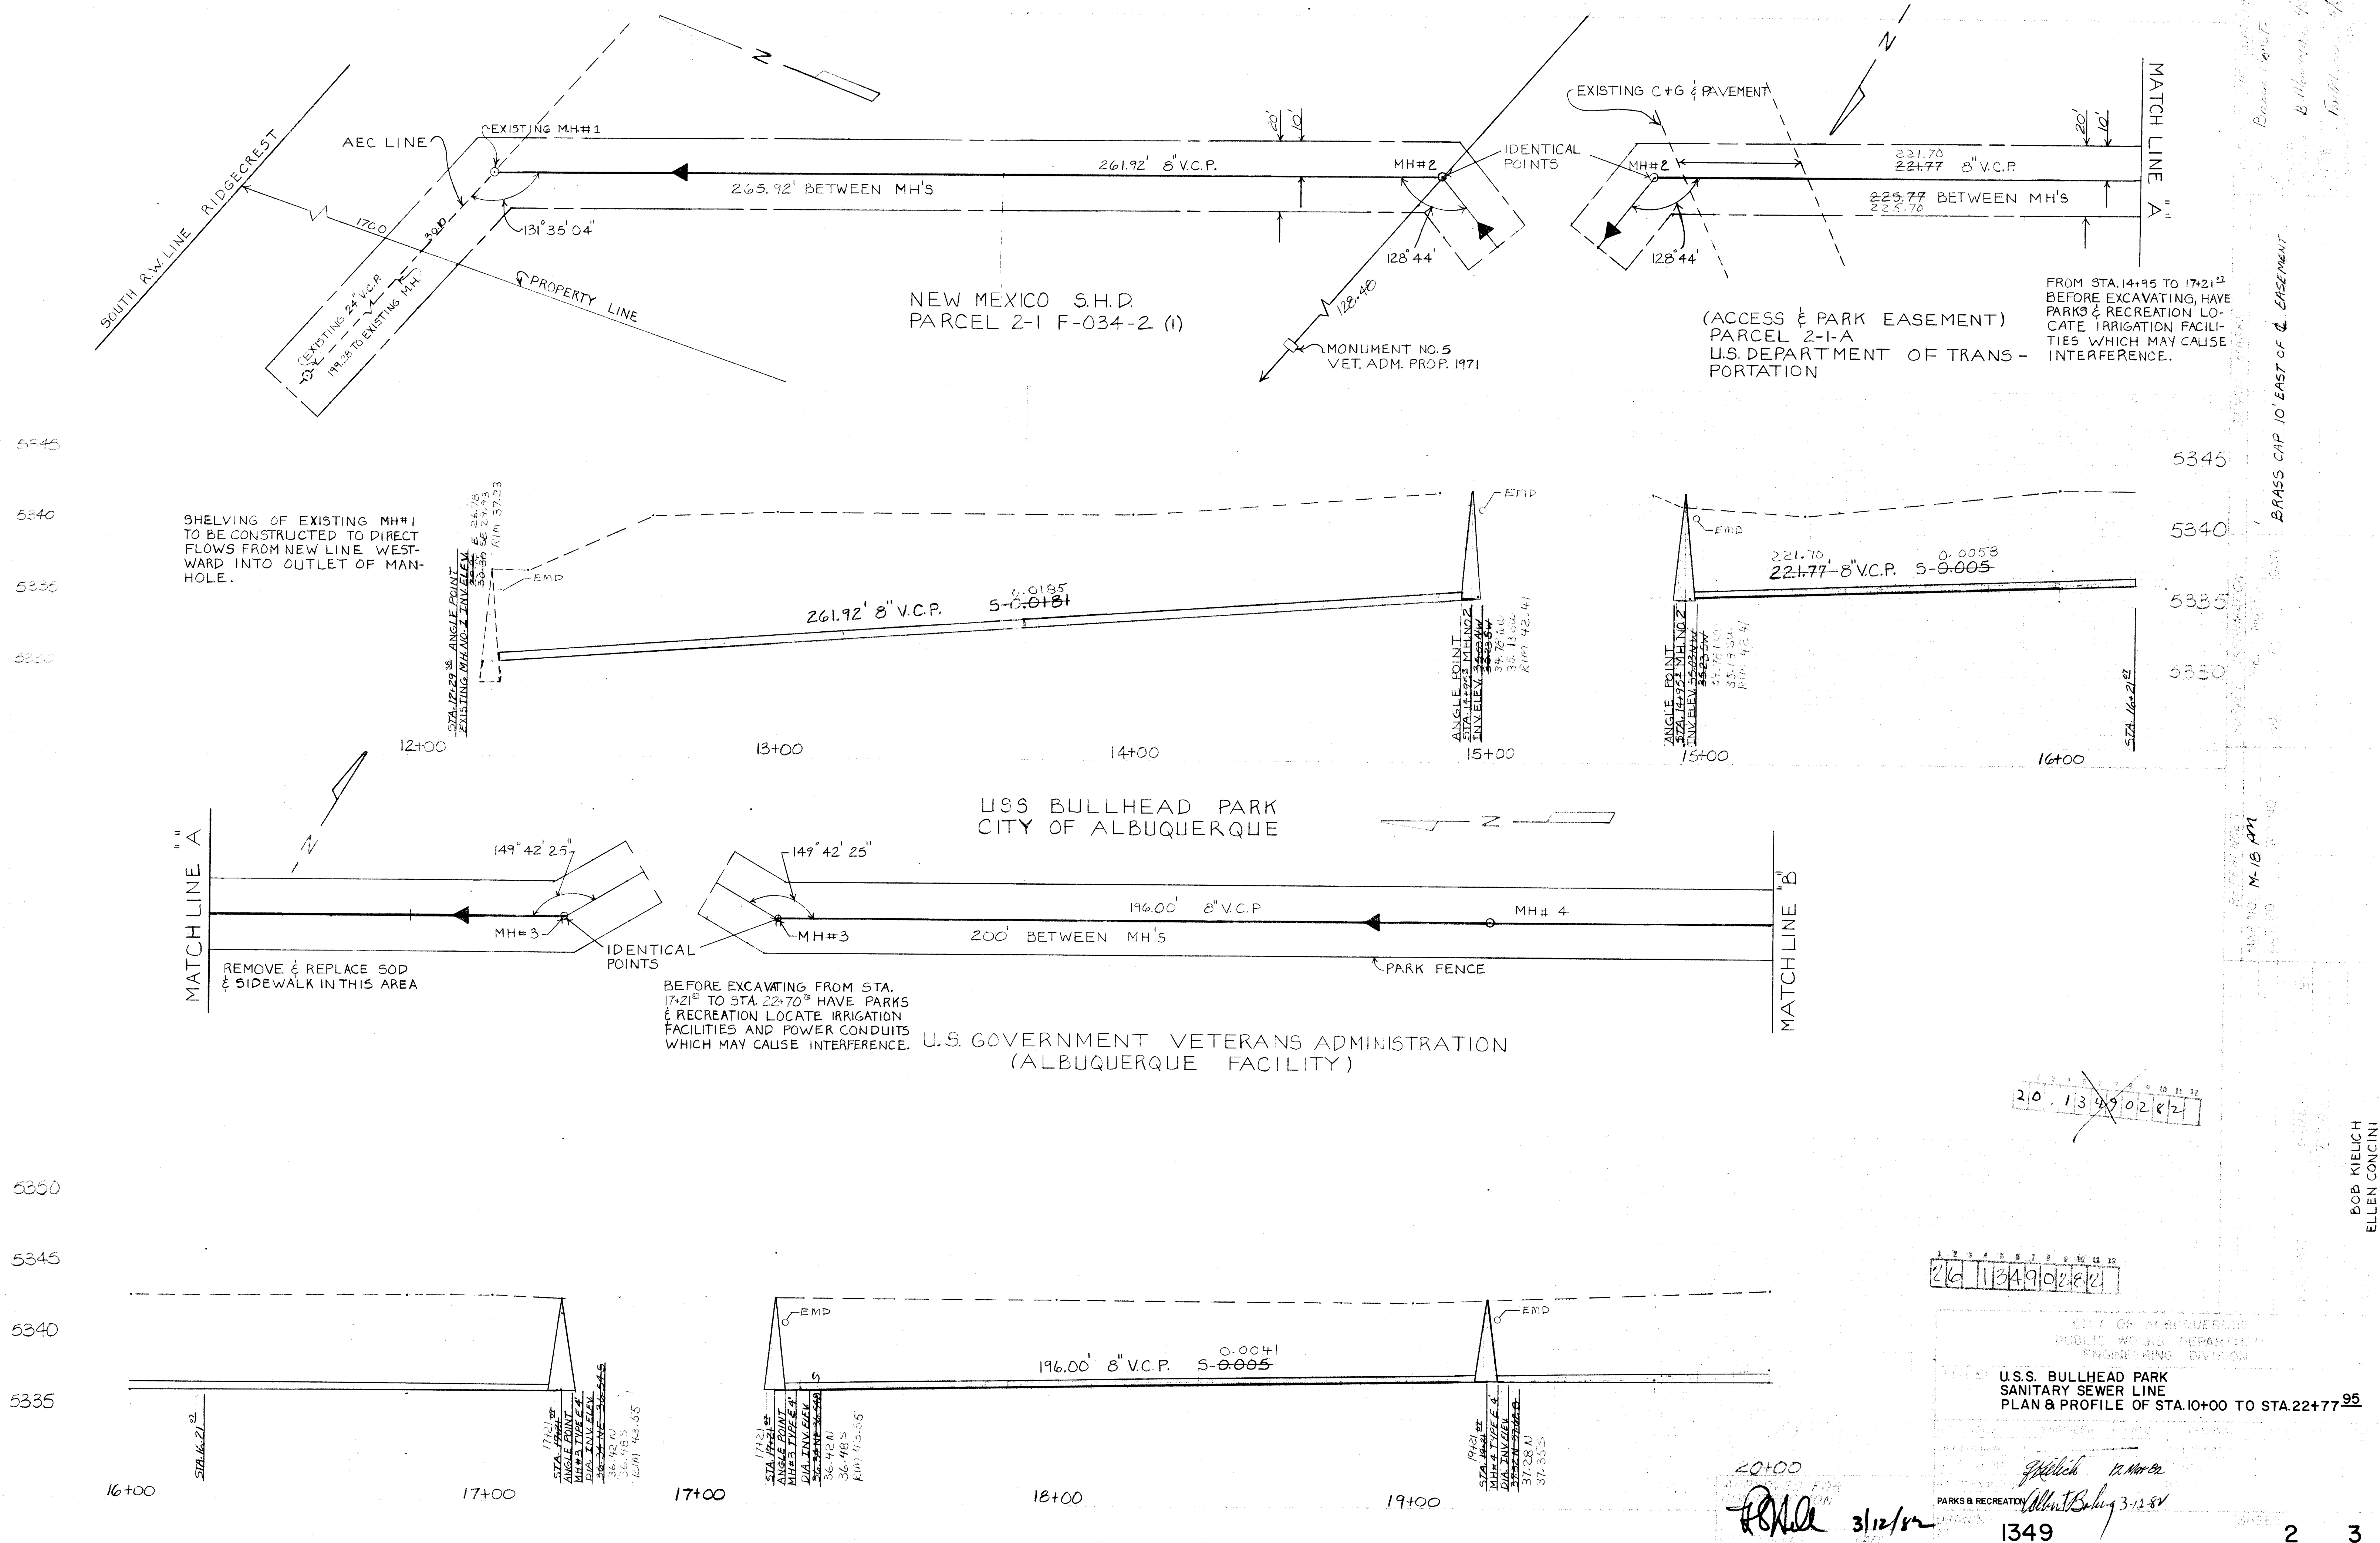

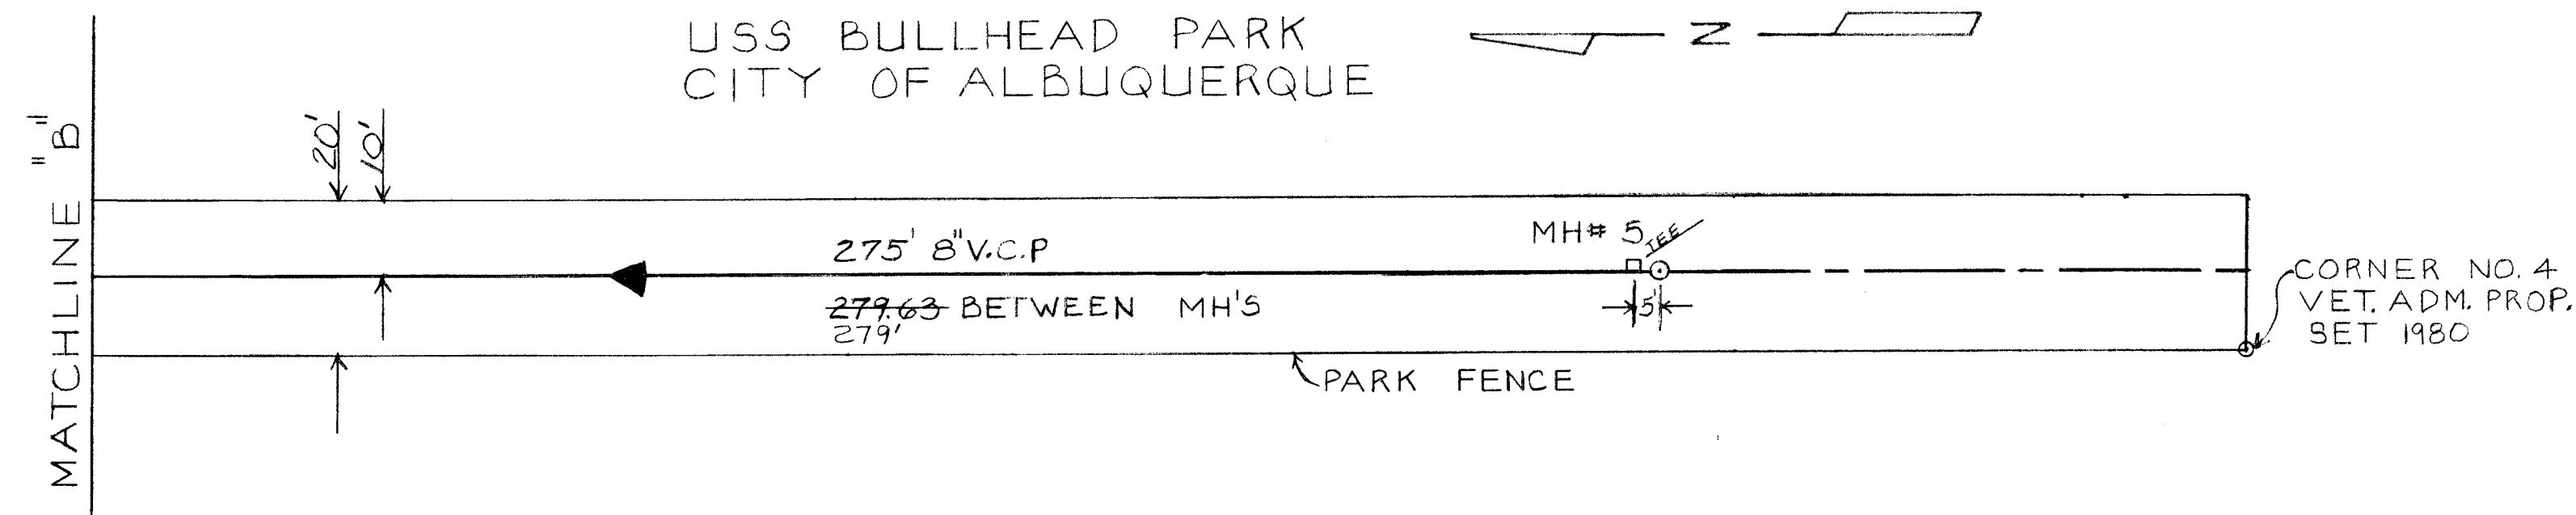


SCALE:
 HORZ. 1" = 20'
 VERT. 1" = 5'

U.S. GOVERNMENT VETERANS ADMINISTRATION
 (ALBUQUERQUE FACILITY)

5345

5340

5335

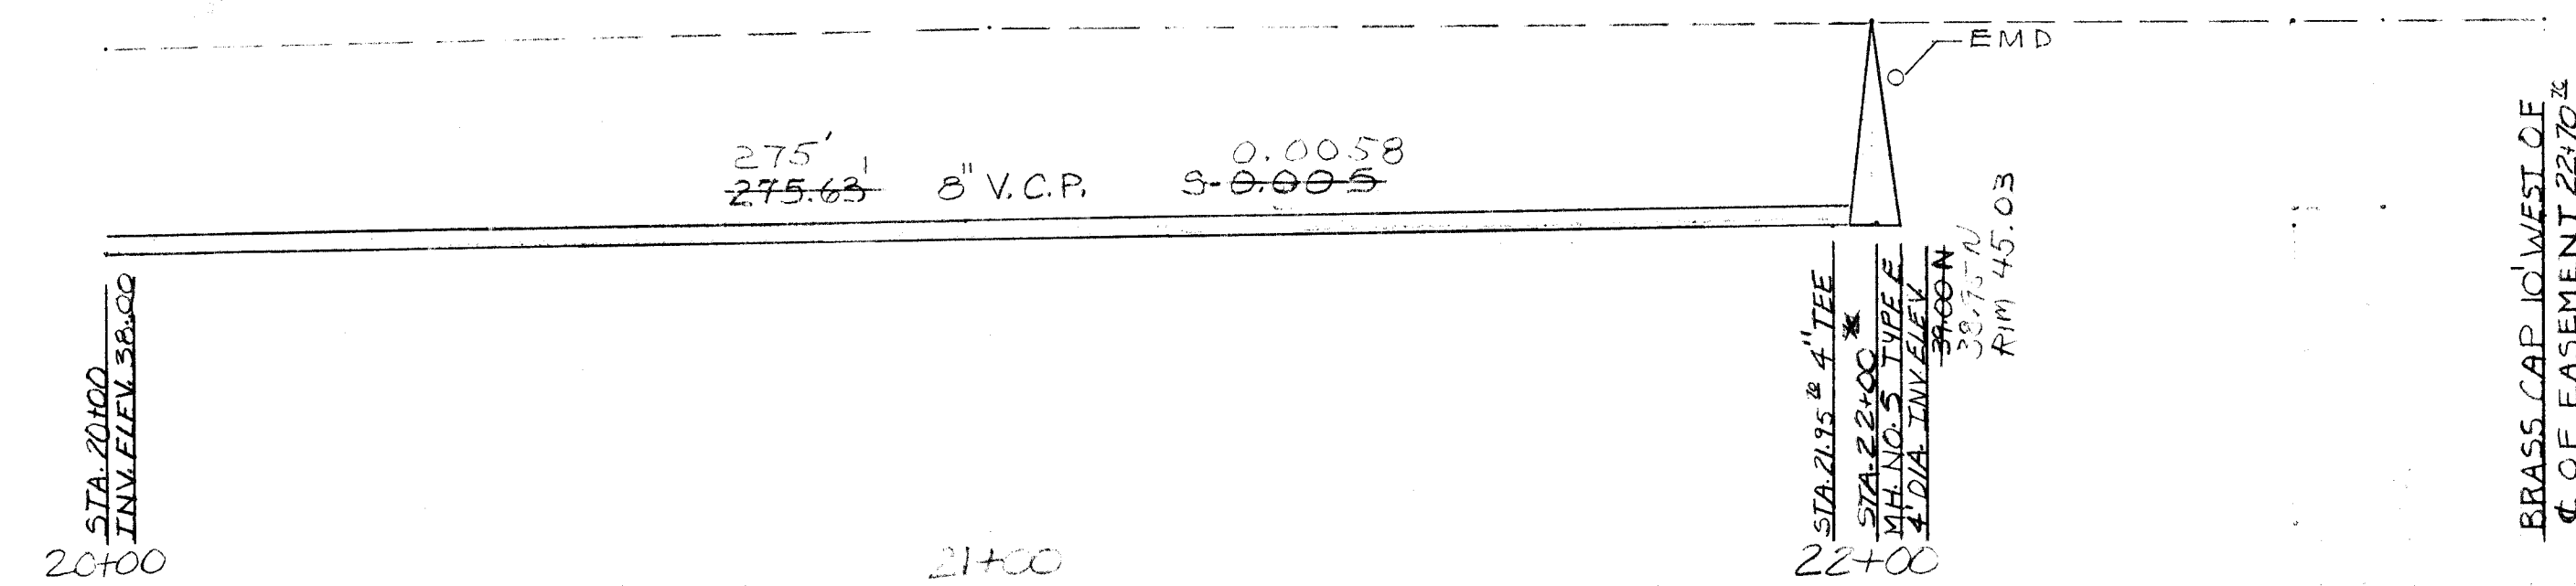

23+00

20 13490382

26 13490382

3/12/82

CITY OF ALBUQUERQUE
 PUBLIC WORKS DEPARTMENT
 ENGINEERING DIVISION

U.S.S. BULLHEAD PARK
 SANITARY SEWER LINE
 PLAN & PROFILE OF STA. 10+00 TO STA. 22+77 95

APPROVED FOR
 [Signature] 12/1/82

PARKS & RECREATION
 [Signature]

1349

3 3

BRASS CAP 10' EAST OF EASEMENT

M-18 AM

BOB KIELICH
 ELLEN CONCINI