

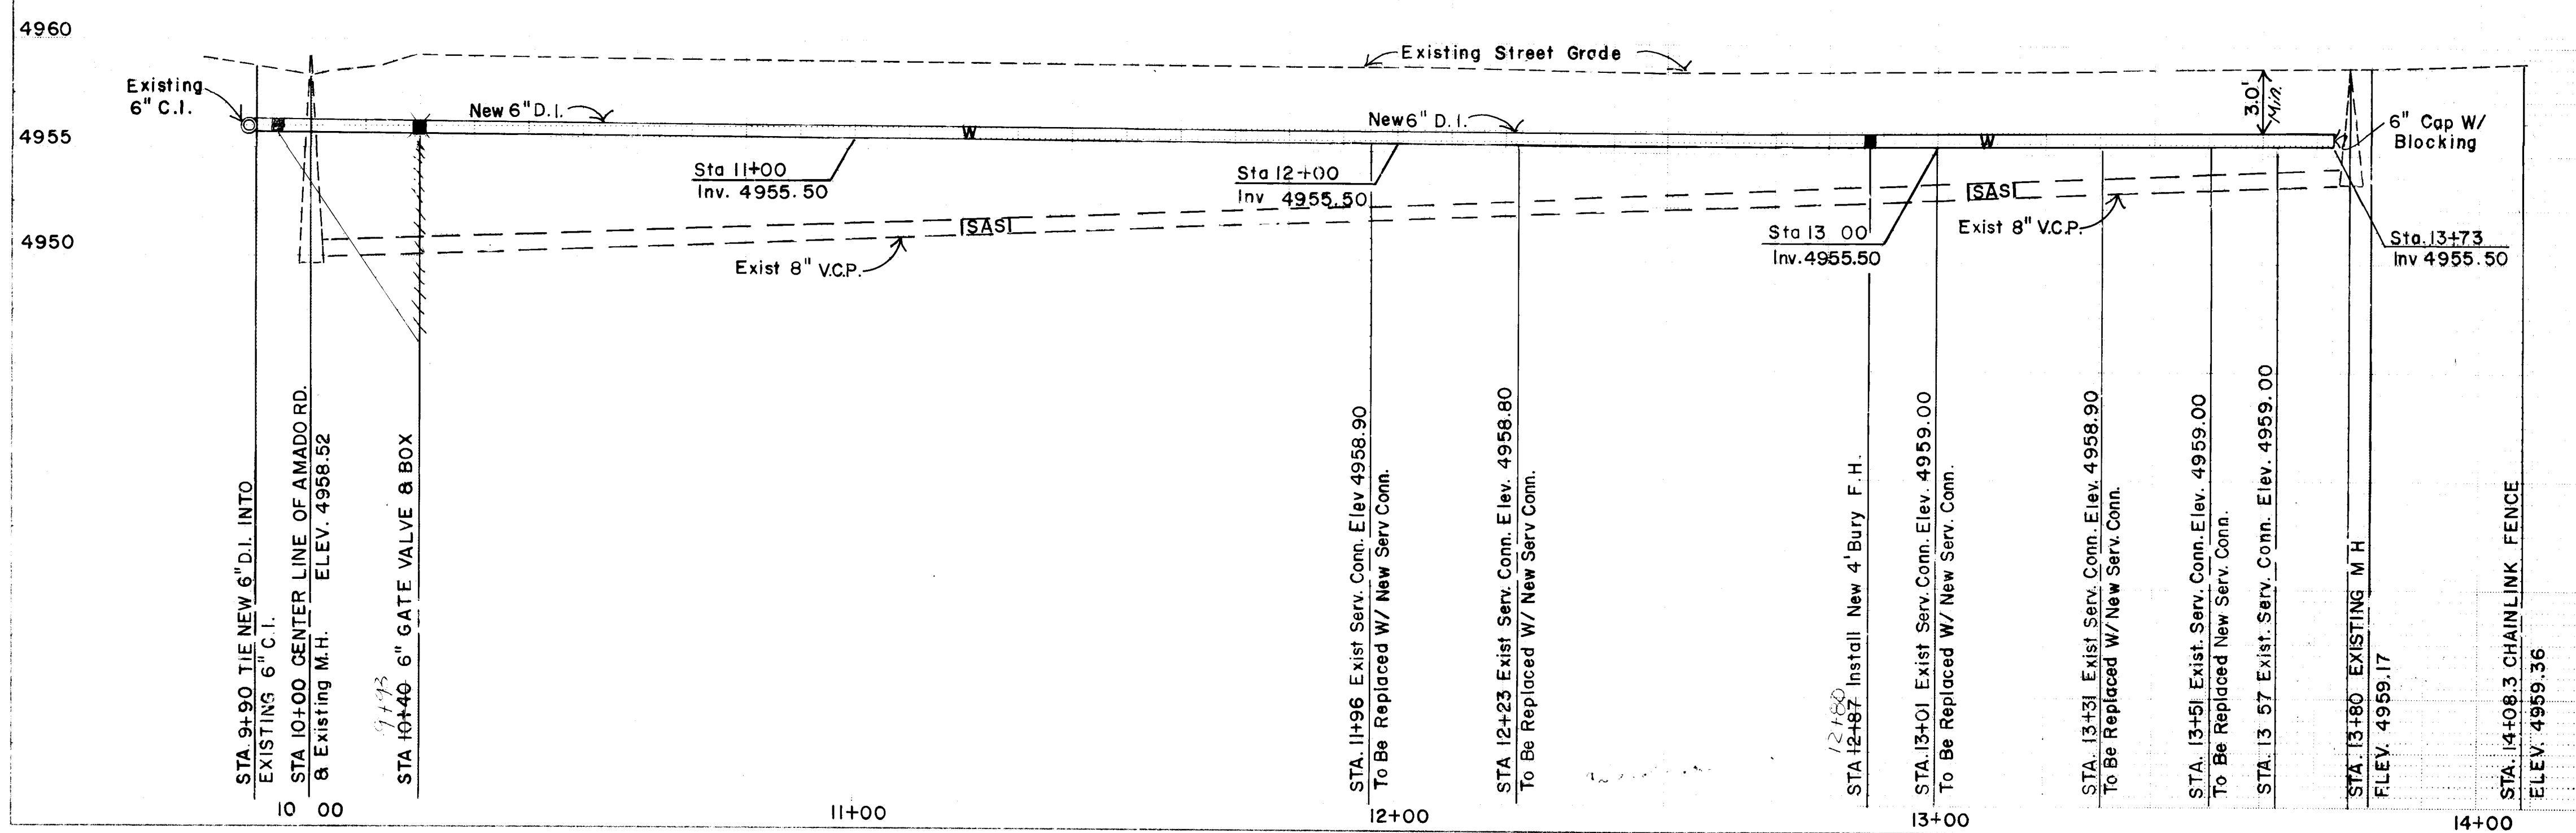


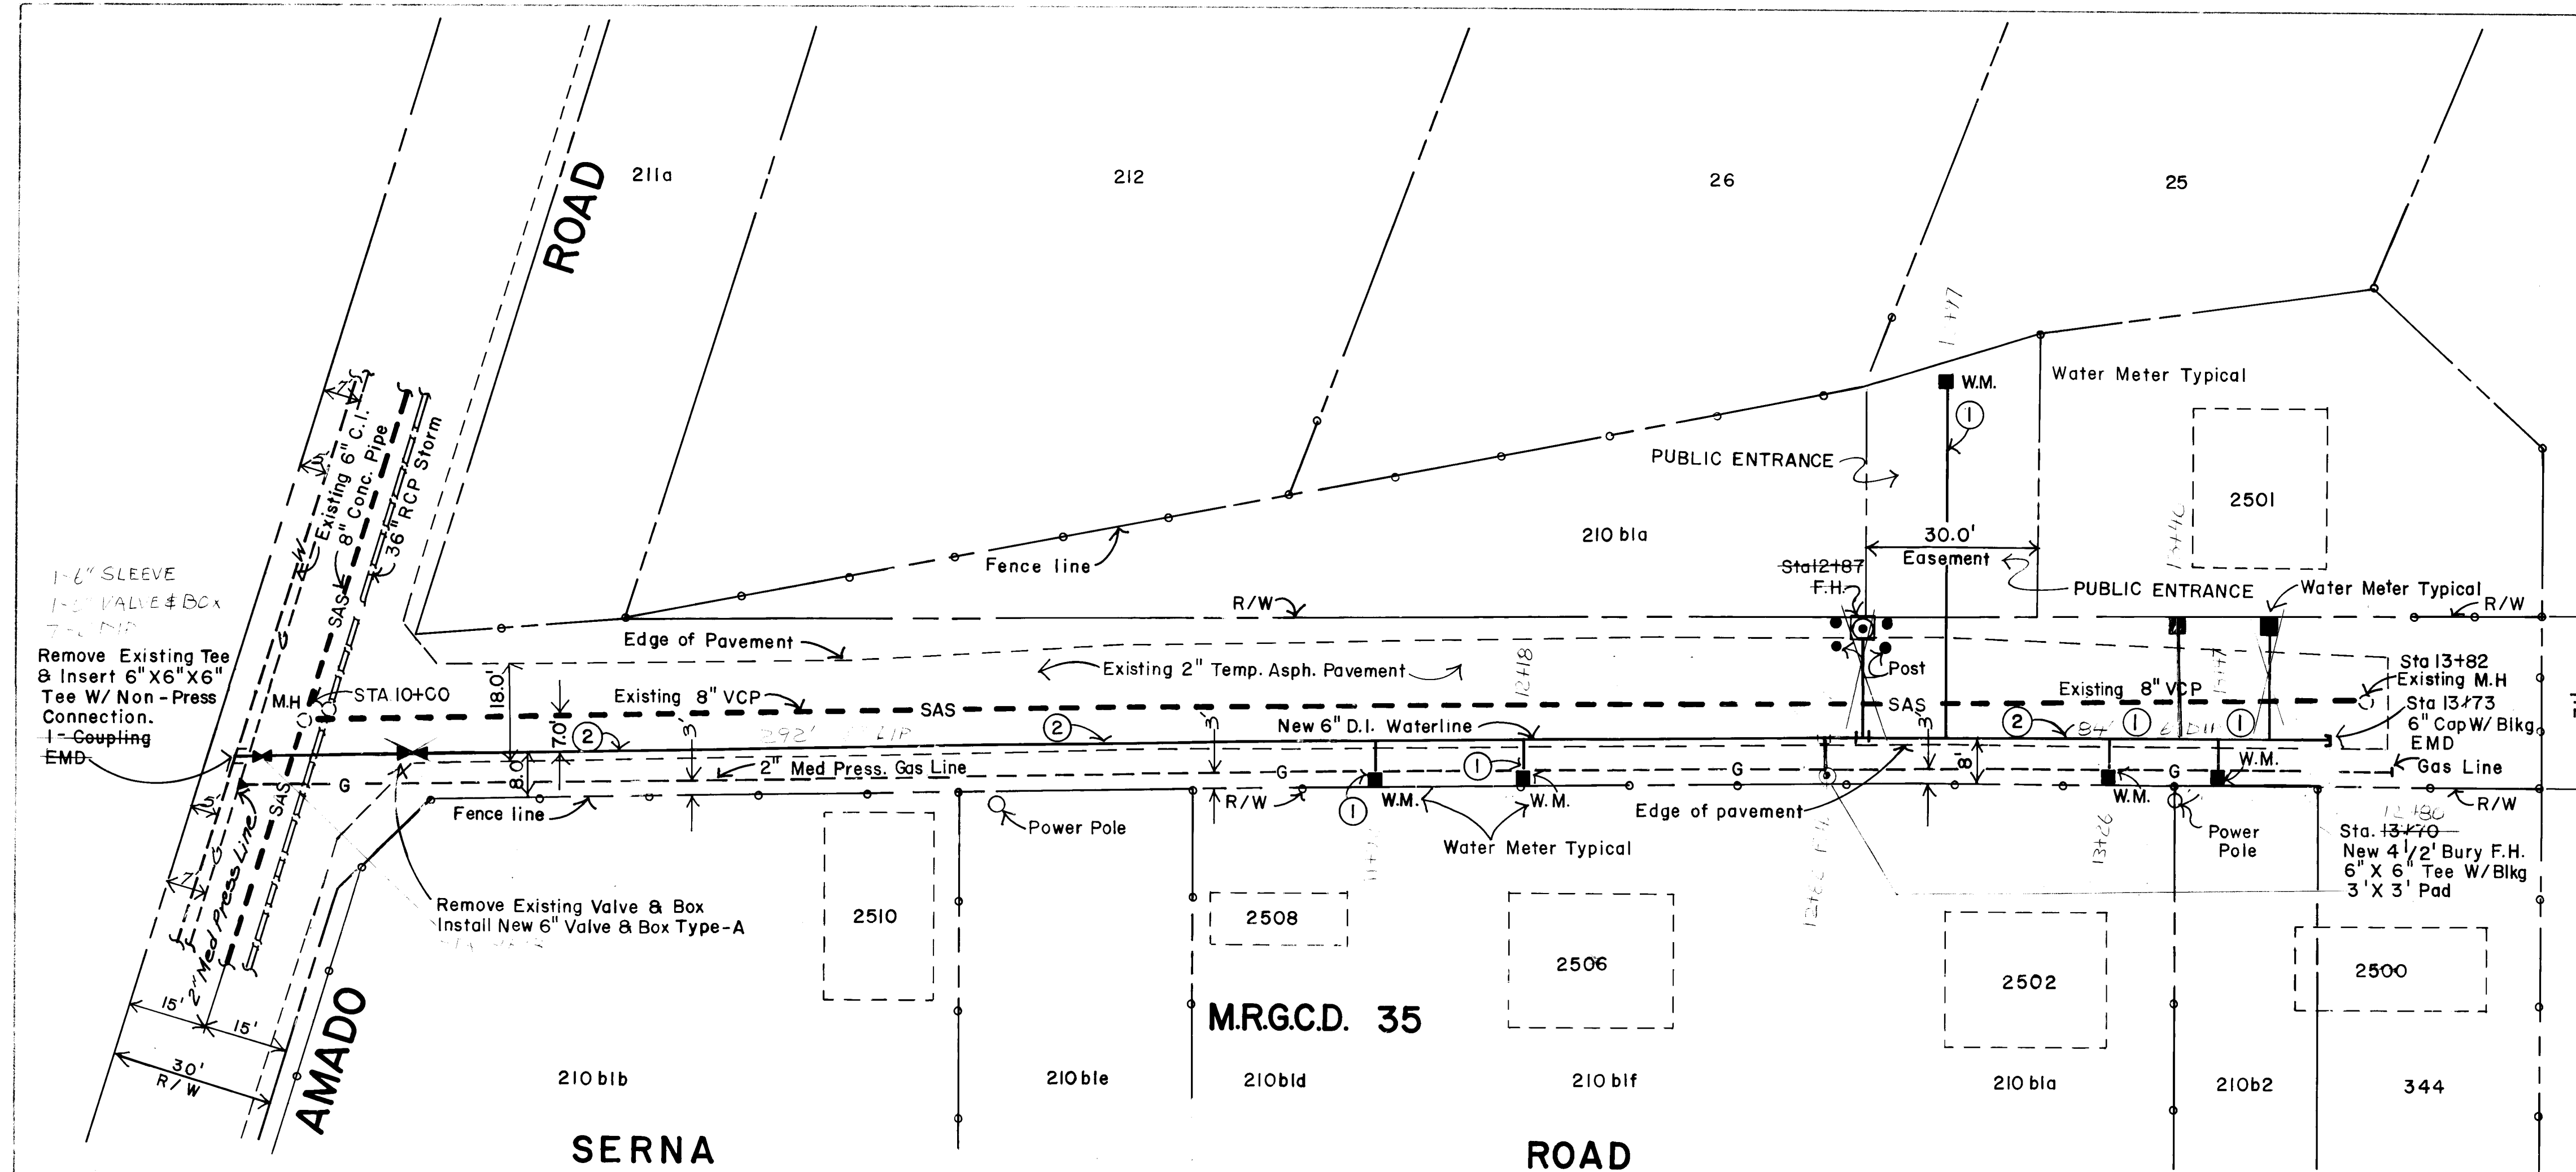

SCALE:
VERT. 1" = 5'
HORIZ 1" = 20'

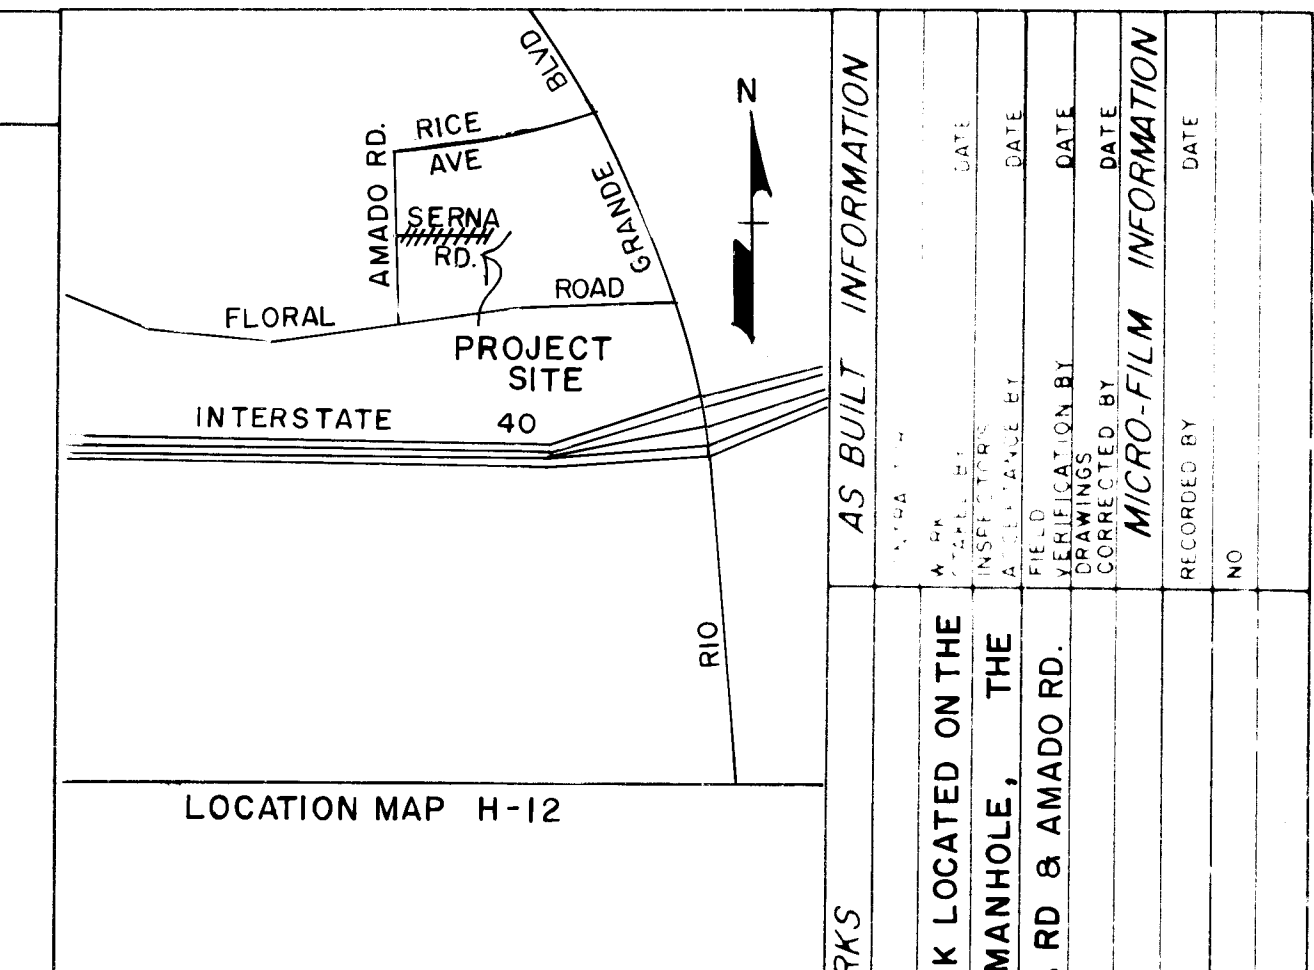

"NOTICE TO CONTRACTORS"

- 1) New Mexico Standard Specification for Public Works Construction - 1979 Edition will be referred to hereon as the "Standard Specification."
- 2) All work detailed on these plans to be performed under contract shall, except as otherwise stated or provided for hereon, be constructed in accordance with "Contract Documents for City-Wide Utilities and Cash Paving No. 30" and the "Standard Specification."
- 3) Two working days prior to any excavation, contractor must contact Line Locating Service, 765-1234, for location of existing utilities.
- 4) Prior to construction, the contractor shall excavate and verify the horizontal and vertical locations of all obstructions. Should a conflict exist, the contractor shall notify the engineer or surveyor so that the conflict can be resolved with minimum amount of delay.

THE FOLLOWING NOTES APPLY WHEN CHECKED

- ☐ All utilities and utility service lines shall be installed prior to paving.
- ☒ Backfill compaction shall be according to specified street use. (Residential)
- ☐ Tack coat requirements shall be determined by the City Engineer.
- ☐ Sidewalks and wheelchair ramps within the curb returns shall be constructed wherever a new curb return is constructed.
- ☐ If curb is depressed for a driveway, the driveway shall be constructed prior to acceptance of the curb and gutter.
- ☐ All storm drainage facilities shall be completed prior to final acceptance.

GENERAL NOTES

- 1) REMOVE AND REPLACE EXISTING SERVICES, METERS AND BOXES.
- 2) REMOVE EXISTING 2" ST. PIPE. & INSTALL NEW 6" D.I. PIPE.

APPROVED FOR CONSTRUCTION
CITY ENGINEER
DATE 6/1/82

CITY OF ALBUQUERQUE MUNICIPAL DEVELOPMENT DEPARTMENT ENGINEERING DIVISION			
TITLE: WATERLINE REPLACEMENT ON SERNA ROAD EAST OF AMADO ROAD.			
APPROVALS	ENGINEER	DATE	APPROVALS
City Engineer	R. Salazar	5/27/82	APPROVED FOR CONSTRUCTION
A.C.E. Design	W. Salazar	8/10/82	APPROVED FOR CONSTRUCTION
A.C.E. Hydrology	W. Salazar	8/10/82	APPROVED FOR CONSTRUCTION
DESIGNED BY	S. MIRANDA	DATE	4-29-82
DRAWN BY	R. SALAZAR	DATE	4-29-82
CHECKED BY	C. TOMLINSON	DATE	4-29-82
DRAWING NO. 1351		MAP NO. H-12 SHEET 1 OF 1	