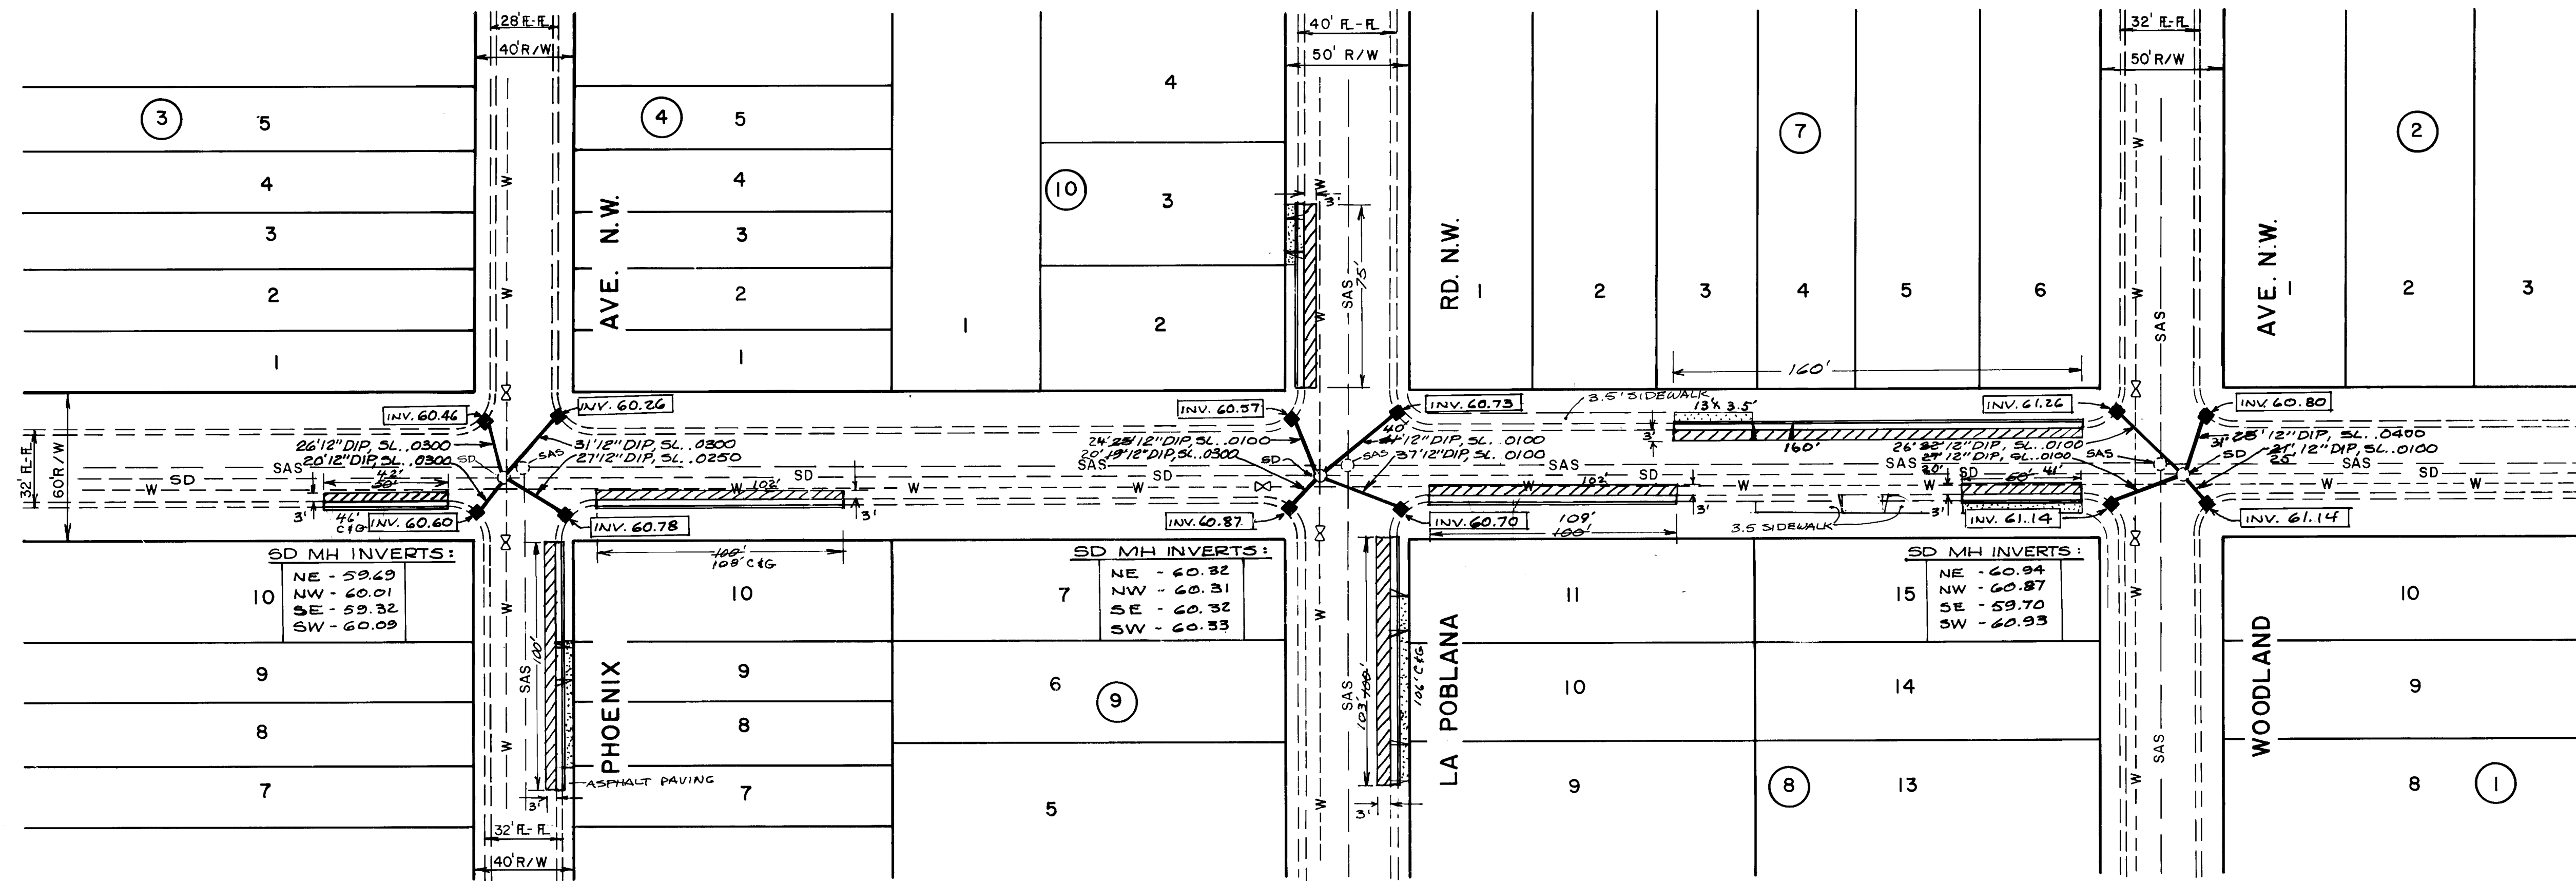



CITY REALTY CO'S ADDITION NO. I

MANDELL ADDITION

NO. II

SCALE
HORIZ. 1" = 40'

THIRD STR. NW

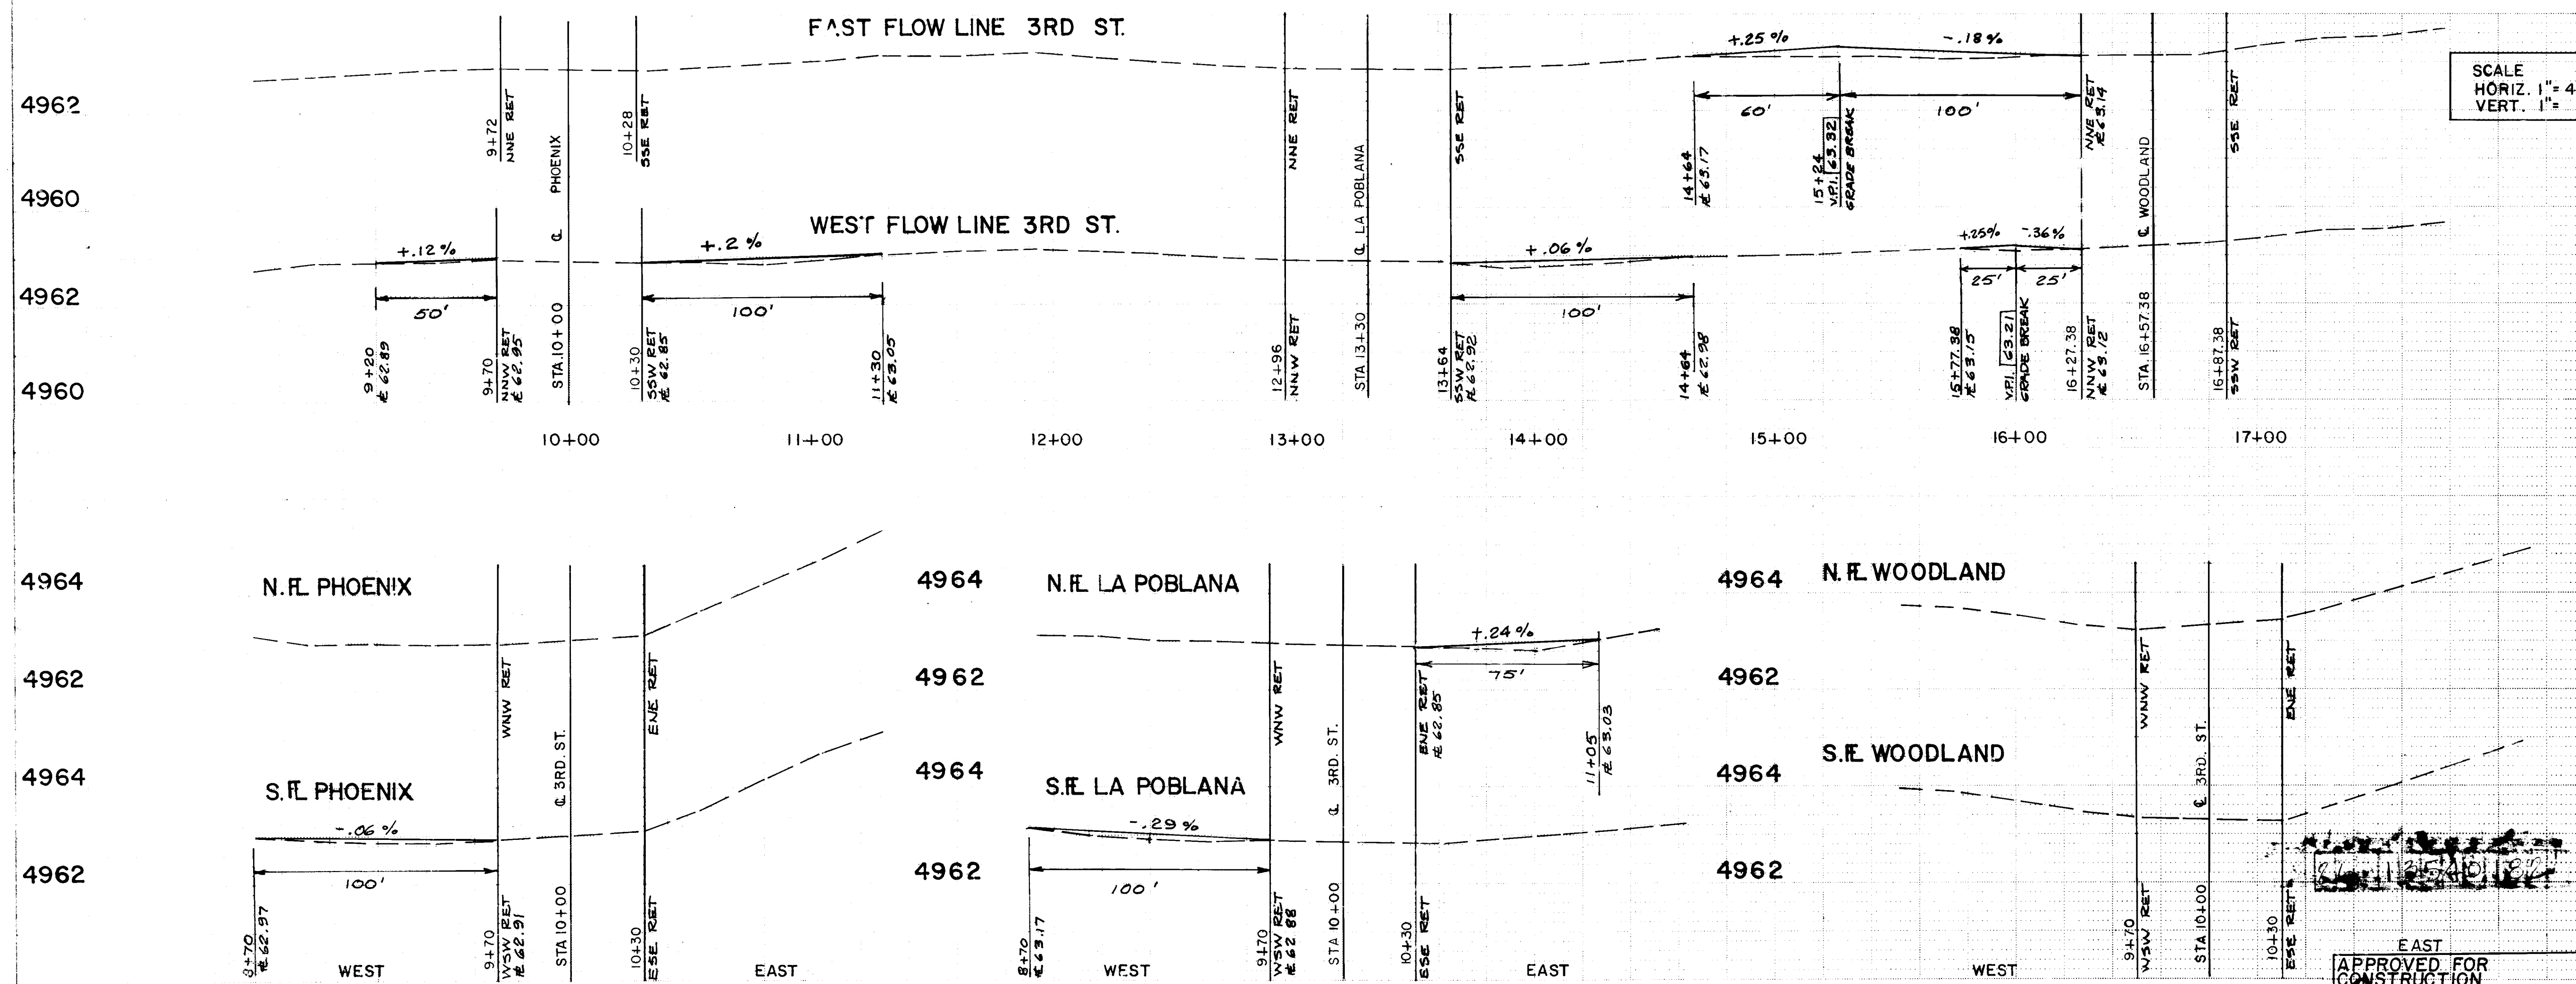

"NOTICE TO CONTRACTORS"

- 1) New Mexico Standard Specification for Public Works Construction - 1979 Edition will be referred to herein as the "Standard Specification."
- 2) All work detailed on these plans to be performed under contract shall, except as otherwise stated or provided for herein, be constructed in accordance with "Contract Documents for City-Wide Utilities and Cash Paving No. 30" and the Standard Specification.
- 3) Two working days prior to any excavation, contractor must contact Line Locating Service, 703-1234, for location of existing utilities.
- 4) Prior to construction, the contractor shall excavate and verify the horizontal and vertical locations of all obstructions. Should a conflict exist, the contractor shall notify the engineer or surveyor so that the conflict can be resolved with minimum amount of delay.

THE FOLLOWING NOTES APPLY WHEN CHECKED

- ☐ All utilities and utility service lines shall be installed prior to paving.
- ☒ Backfill compaction shall be according to specified street use. (Residential)
- ☒ Tack coat requirements shall be determined by the City Engineer.
- ☐ Sidewalks and wheelchair ramps within the curb returns shall be constructed wherever a new curb return is constructed.
- ☐ If curb is depressed for a driveway, the driveway shall be constructed prior to acceptance of the curb and gutter.
- ☒ All storm drainage facilities shall be completed prior to final acceptance.

LEGEND

- REMOVE EXISTING CATCH BASIN AND INLET LINE, BUILD SINGLE "D" CATCH BASIN AND 12" D.I.P. INLET PIPE TO INVERTS SHOWN.
- REMOVE EXIST. CURB & GUTTER, BUILD STD. CURB & GUTTER TO GRADES SHOWN.
- REMOVE 3'-FT. WIDE SECTION OF PAVING ALONG NEW CURB, BUILD STD. RESIDENTIAL PAVING TO MATCH NEW CURB GRADES.
- EXISTING CURB & GUTTER
- EXISTING STORM DRAIN MANHOLE
- EXISTING SANITARY SEWER MANHOLE
- REMOVE EXISTING SIDEWALK & DRIVEPAD, BUILD NEW SIDEWALK & DRIVEPAD TO MATCH NEW CURB.

CITY OF ALBUQUERQUE
MUNICIPAL DEVELOPMENT DEPARTMENT
ENGINEERING DIVISIONTITLE THIRD STREET, NW, FROM PHOENIX TO
WOODLAND - STORM DRAIN IMPROVEMENTS

APPROVALS	ENGINEER	DATE	APPROVALS	ENGINEER	DATE
City Engineer	<i>[Signature]</i>	4/1/82	Liquid Waste		
A.C.E. - Design	<i>[Signature]</i>	15 Apr 82	Traffic		
A.C.E. - Hydrology	<i>[Signature]</i>	7/16/82	Water		

DRAWING NO. 1354
MAP NO. H-14
SHEET 1 OF 1