


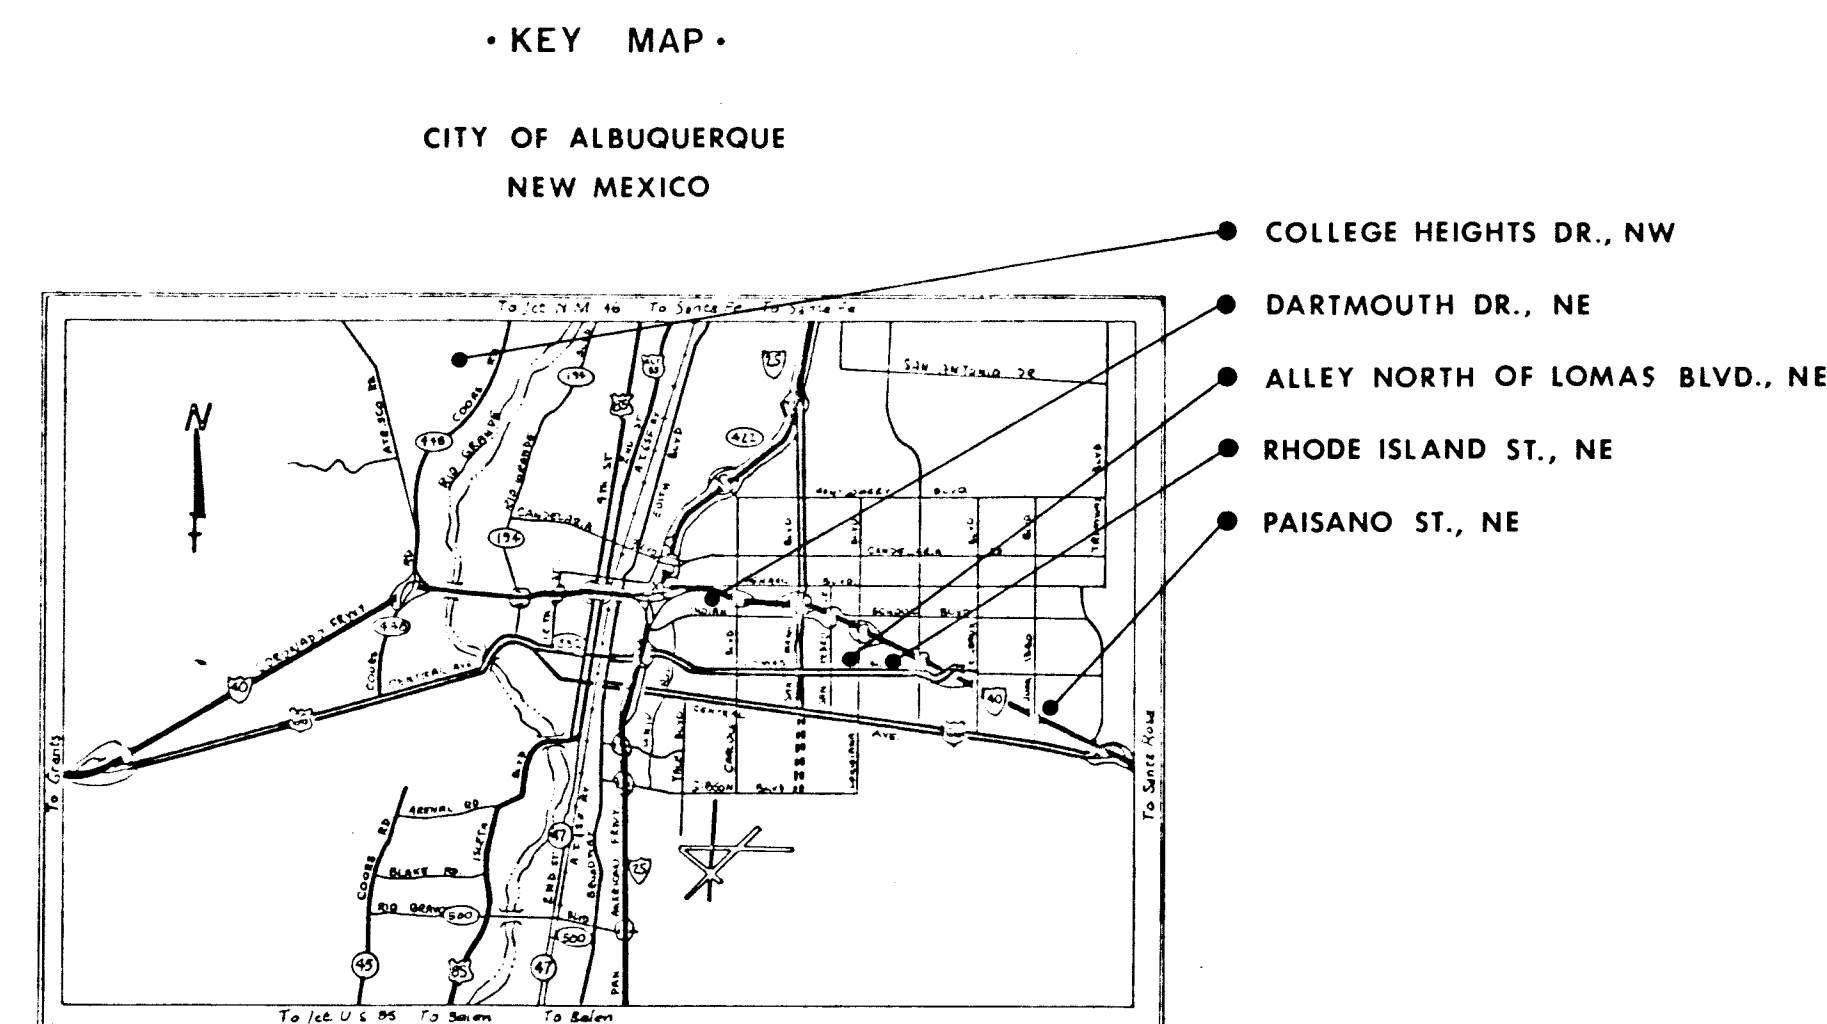

CITY OF ALBUQUERQUE
MUNICIPAL DEVELOPMENT DEPARTMENT

SPECIAL ASSESSMENT
DISTRICT N°200

• NOTICE TO CONTRACTORS •

1. NEW MEXICO STANDARD SPECIFICATIONS FOR PUBLIC WORKS CONSTRUCTION - 1979 EDITION SHALL BE REFERRED TO HEREON AS THE "STANDARD SPECIFICATION".
2. ALL WORK DETAILED ON THESE PLANS TO BE PERFORMED UNDER CONTRACT SHALL, EXCEPT AS OTHERWISE STATED OR PROVIDED FOR HEREON, BE CONSTRUCTED IN ACCORDANCE WITH "CONTRACT DOCUMENTS FOR CITY-WIDE UTILITIES AND CASH PAVING N°30" OR ITS SUBSEQUENT REPLACEMENT AND THE "STANDARD SPECIFICATION". THE STANDARD DETAILS OF THE CONTRACT DOCUMENTS FOR CITY-WIDE UTILITIES AND CASH PAVING N°30 ARE MAINTAINED ON FILE IN THE CITY ENGINEER'S OFFICE AND ARE INCORPORATED INTO THIS PROJECT BY REFERENCE, THE SAME AS IF FULLY DRAWN HEREON.
3. ALL BARRICADING AND SIGNING SHALL BE IN ACCORDANCE WITH THE NEW MEXICO MANUAL AND SPECIFICATIONS FOR A UNIFORM SYSTEM OF TRAFFIC CONTROL DEVICES FOR STREETS AND HIGHWAYS.
4. PRIOR TO CONSTRUCTION, THE CONTRACTOR SHALL EXCAVATE AND VERIFY THE HORIZONTAL AND VERTICAL LOCATIONS OF ALL OBSTRUCTIONS. SHOULD A CONFLICT EXIST, THE CONTRACTOR SHALL NOTIFY THE ENGINEER SO THAT THE CONFLICT CAN BE RESOLVED WITH A MINIMUM OF DELAY.
5. THE CONTRACTOR SHALL BE REQUIRED TO CONFINE HIS WORK WITHIN THE CONSTRUCTION LIMITS AND/OR R.O.W. TO PRESERVE EXISTING VEGETATION AND PRIVATE PROPERTY. OVERNIGHT PARKING OF CONSTRUCTION EQUIPMENT SHALL NOT OBSTRUCT DRIVEWAY OPENINGS OR DESIGNATED TRAFFIC LANES.
6. TWO WORKING DAYS PRIOR TO ANY EXCAVATION, CONTRACTOR SHALL CONTACT LINE AND CABLE LOCATING SERVICE, TELEPHONE N° 765-1234, FOR LOCATIONS OF EXISTING UTILITIES.
7. THE CONTRACTOR SHALL PROTECT AND MAINTAIN IN SERVICE ALL EXISTING UTILITIES.
8. BACKFILL COMPACTION SHALL BE ACCORDING TO SPECIFIED PAVEMENT TYPE.
9. ALL EXCAVATION SHALL BE GOVERNED BY THE CONSTRUCTION SAFETY AND HEALTH STANDARDS (TITLE 29, CODE OF FEDERAL REGULATIONS, PART N°S 1910 AND 1926, PUBLISHED IN THE FEDERAL REGISTER, AND MODIFICATIONS THERE TO).
10. SUBGRADE PREPARATION UNDER CURB & GUTTER, DRIVEPADS AND SIDEWALKS SHALL BE CONSIDERED INCIDENTAL TO THE CONSTRUCTION OF SUCH AND SHALL BE INCLUDED IN THE BID PRICE FOR SUCH ITEMS.
11. A DISPOSAL SITE FOR ALL EXCESS EXCAVATION MATERIAL, ASPHALTIC PAVING, CONCRETE PAVING, CURB & GUTTERS, FOUNDATIONS AND FLOORS, EXISTING DROP INLETS, ETC. SHALL BE OBTAINED BY THE CONTRACTOR, IN COMPLIANCE WITH ALL APPLICABLE ENVIRONMENTAL REGULATIONS. ALL COSTS INCURRED IN OBTAINING A DISPOSAL SITE AND HAULING THERETO SHALL BE CONSIDERED INCIDENTAL TO CONSTRUCTION AND NO DIRECT PAYMENT SHALL BE MADE THEREFORE.
12. ALL FINISH GRADES AND PROFILES SHOWN ARE TOP OF CURB GRADES, UNLESS OTHERWISE NOTED. MATCH FLOW-LINES OF GUTTERS WHEN CONNECTING NEW CURB & GUTTER TO EXISTING.
13. ALL WATER VALVE BOXES AND SEWER MANHOLES IN THE PROJECT AREA ARE TO BE ADJUSTED TO FINISH GRADE UNDER THIS CONTRACT.
14. ALL GAS VALVE BOXES, GAS MANHOLES, ELECTRICAL & TELEPHONE MANHOLES SHALL BE ADJUSTED TO GRADE BY OTHERS.
15. CURB & GUTTER SHOWN AS EXISTING AND NOT TO BE REMOVED UNDER THIS CONTRACT WHICH IS DAMAGED OR REPLACED BY THE CONTRACTOR SHALL BE REMOVED AND REPLACED BY THE CONTRACTOR AT HIS EXPENSE.
16. WHEN REMOVAL OF EXISTING CURB & GUTTER OR SIDEWALK IS REQUIRED, IT SHALL BE REMOVED TO THE NEAREST JOINT.
17. WHEN ABUTTING NEW PAVEMENT TO EXISTING, EXISTING PAVEMENT SHALL BE CUT BACK TO A STRAIGHT LINE AS REQUIRED TO REMOVE ANY BROKEN OR CRACKED PAVEMENT AND MATCH NEW TO EXISTING.
18. WHEELCHAIR RAMPS SHALL BE CONSTRUCTED AT ALL CURB RETURNS CONSTRUCTED ON THIS PROJECT. WHEELCHAIR RAMPS SHALL BE MEASURED AND PAID FOR AS CONCRETE SIDEWALK AND CONCRETE CURB & GUTTER.
19. DRIVEPADS ARE TO BE LOCATED WHERE THERE IS EVIDENCE OF AN EXISTING DRIVE, AS DETERMINED BY THE PROJECT ENGINEER. DRIVEWAY PERMIT MUST BE OBTAINED FROM TRAFFIC ENGINEERING BY THE OWNER.
20. PERMANENT SIGNING AND STRIPING SHALL BE BY CITY FORCES. CONSTRUCTION SIGNING AND STRIPING SHALL BE BY CONTRACTOR. ALL COSTS INCURRED FOR CONSTRUCTION SIGNING AND STRIPING SHALL BE CONSIDERED INCIDENTAL TO CONSTRUCTION AND NO SEPARATE PAYMENT SHALL BE MADE THEREFORE.
21. THE CONTRACTOR SHALL MAINTAIN ACCESS TO ADJACENT PROPERTIES AT ALL TIMES — EXCEPT DURING ACTUAL PAVING OPERATIONS.
22. ALL UTILITIES AND UTILITY SERVICE LINES SHALL BE INSTALLED PRIOR TO PAVING.
23. PRIVATE WALLS, FENCES, LANDSCAPING, ETC. ARE TO BE REMOVED FROM THE LIMITS OF CONSTRUCTION ONLY AFTER THE PROPERTY OWNERS HAVE BEEN NOTIFIED AND HAVE BEEN GIVEN AN OPPORTUNITY, ACCEPTABLE TO THE ENGINEER, TO REMOVE THE AFFECTED ITEMS. ALL SUCH ITEMS SHALL BE INCIDENTAL TO THE WORK OF THE CONTRACT.
24. CENTERLINE OF CONSTRUCTION SHALL NOT BE USED AS CENTERLINE OF R.O.W. (R.O.W. CENTERLINE NOT DETERMINED.)
25. DRIVEPADS FOR PROJECT LOTS SHALL BE LOCATED IN THE FIELD BY THE ENGINEER UNLESS OTHERWISE NOTED ON PLANS.
26. POWER POLES, STREET LIGHTS, TELEPHONE RISERS AND TRAFFIC SIGNS TO BE RELOCATED BY OTHERS.
27. TACK COAT REQUIREMENTS SHALL BE DETERMINED BY THE ENGINEER.

• INDEX TO DRAWINGS •

1. TITLE SHEET
2. LOCATION MAP AND LEGEND
3. COLLEGE HEIGHTS DR. PAVING
4. COLLEGE HEIGHTS DR. PAVING
5. DARTMOUTH DR. PAVING
6. ALLEY NORTH OF LOMAS PAVING
7. RHODE ISLAND ST. PAVING
8. PAISANO ST. PAVING
9. COLLEGE HEIGHTS DR. WATER & SANITARY SEWER
10. COLLEGE HEIGHTS DR. WATER & SANITARY SEWER
11. DARTMOUTH DR. WATER & SANITARY SEWER
12. RHODE ISLAND ST. WATER & SANITARY SEWER
13. MISCELLANEOUS DETAILS

RECORD DRAWINGS

THESE RECORD DRAWINGS HAVE BEEN PREPARED, IN PART, ON THE BASIS OF INFORMATION COMPILED AND FURNISHED BY OTHERS. THE ENGINEER WILL NOT BE RESPONSIBLE FOR ANY ERRORS OR OMISSIONS WHICH HAVE BEEN INCORPORATED INTO THIS DOCUMENT AS A RESULT.

DATE: May 17, 1983

APPROVAL OF AS BUILT DRAWINGS
ASST. CITY ENGINEER - FIELD
<i>W. J. McManura</i>
DATE <u>2-19-85</u>

1 2 3 4 5 6 7 8 9 10 11 12
26 1360 0185

CITY OF ALBUQUERQUE
THIS MICROIMAGE IS THE BEST
POSSIBLE REPRODUCTION DUE
TO THE POOR QUALITY OF THE
ORIGINAL DOCUMENT

Camille Spadaro
CITY CLERK/REGISTRAR

OWNERSHIP OF DOCUMENTS	
This document, and the ideas and designs incorporated herein, as an instrument of professional service, is the property of SULLIVAN DESIGN GROUP, INC. and is not to be used, in whole or in part, for any other project without the written authorization of SULLIVAN DESIGN GROUP, INC.	
EJG Record Dwg. Notes Added	5/7/83
NO. BY	DESCRIPTION
REVISIONS	
APPRVD. DATE	DATE

PREPARED UNDER THE DIRECTION OF
<i>Wilbert J. Hobbs</i>
APPROVED FOR CONSTRUCTION
<i>Richard S. McManura</i> 12/2/81
CITY ENGINEER DATE


DRAWING
NO. 1360

COLLEGE HEIGHTS - UNIT I (12-2-65)(D3-129)
BLOCK B


- NOTES:
1. ALL LOTS ZONED R-1 UNLESS OTHERWISE SHOWN.
2. SUBGRADE TO BE STERILIZED AT LOCATIONS TO BE DESIGNATED BY THE ENGINEER.

RECORD DRAWINGS

THESE RECORD DRAWINGS HAVE BEEN PREPARED, IN PART,
ON THE BASIS OF INFORMATION COMPILED AND FURNISHED
BY OTHERS. THE ENGINEER WILL NOT BE RESPONSIBLE
FOR ANY ERRORS OR OMISSIONS WHICH HAVE BEEN INCORPORATED
INTO THIS DOCUMENT AS A RESULT.
DATE: May 17, 1983

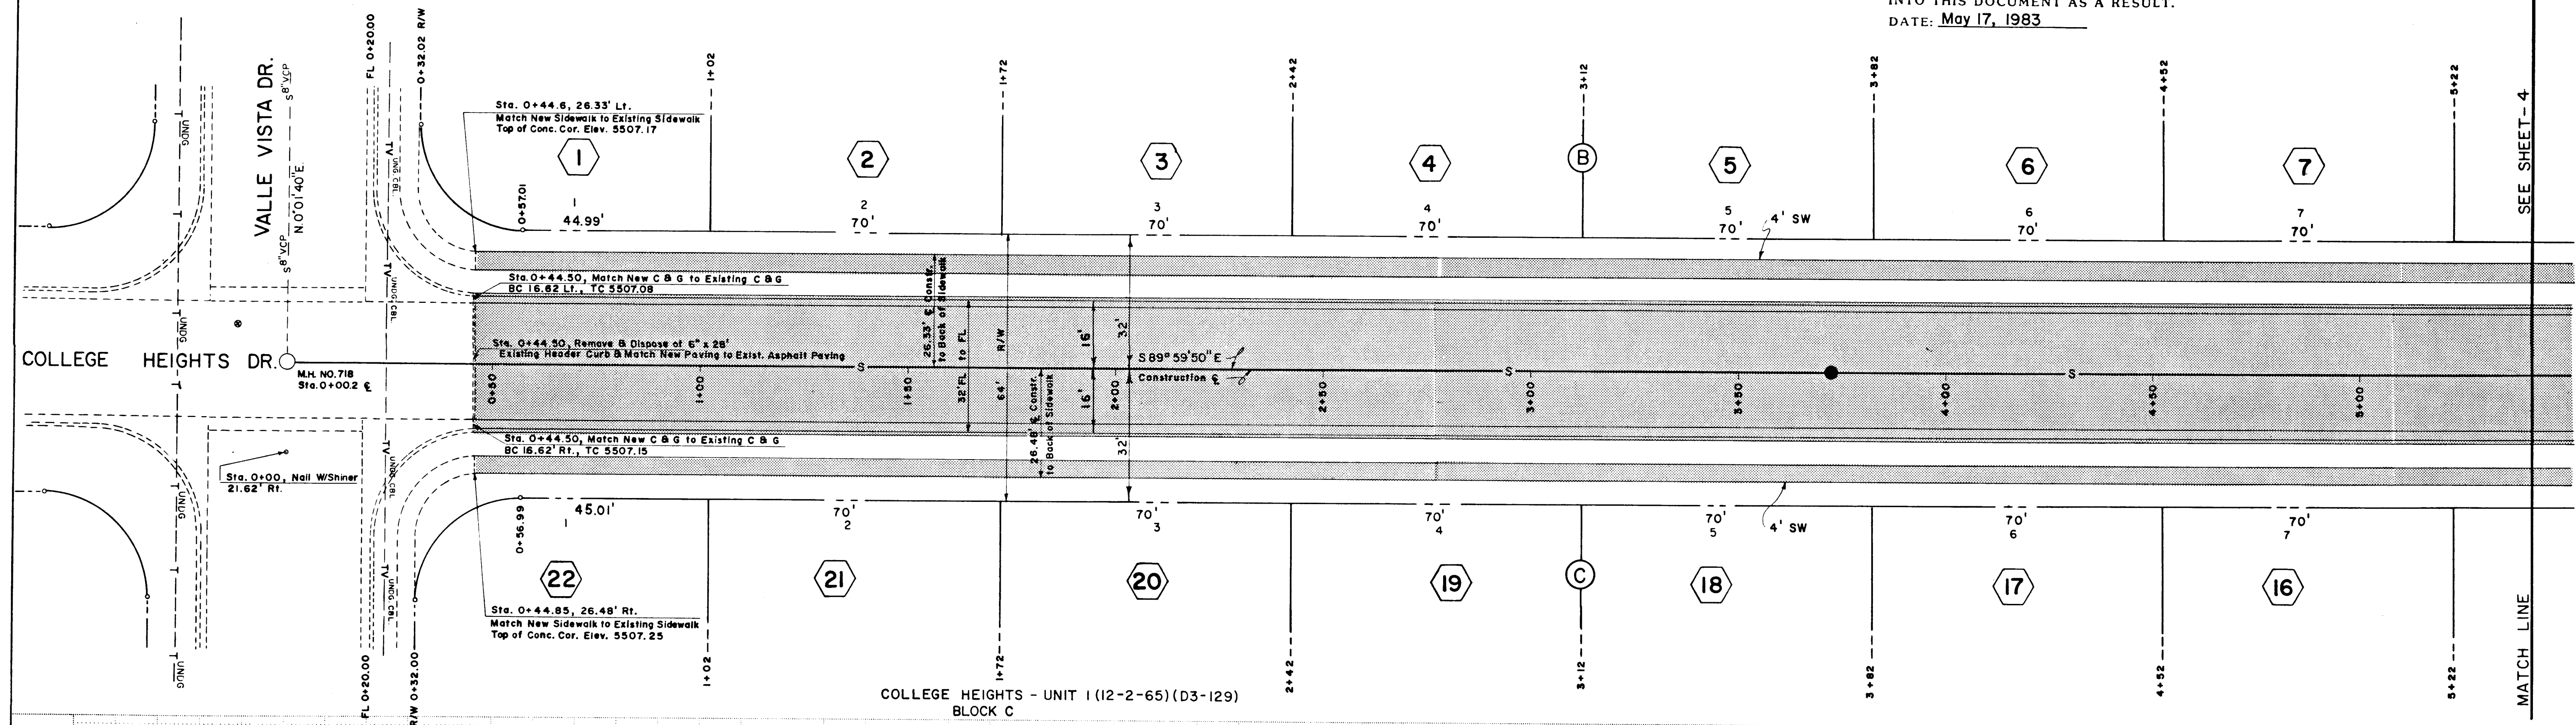

COLLEGE HEIGHTS - UNIT I (12-2-65)(D3-129)
BLOCK C

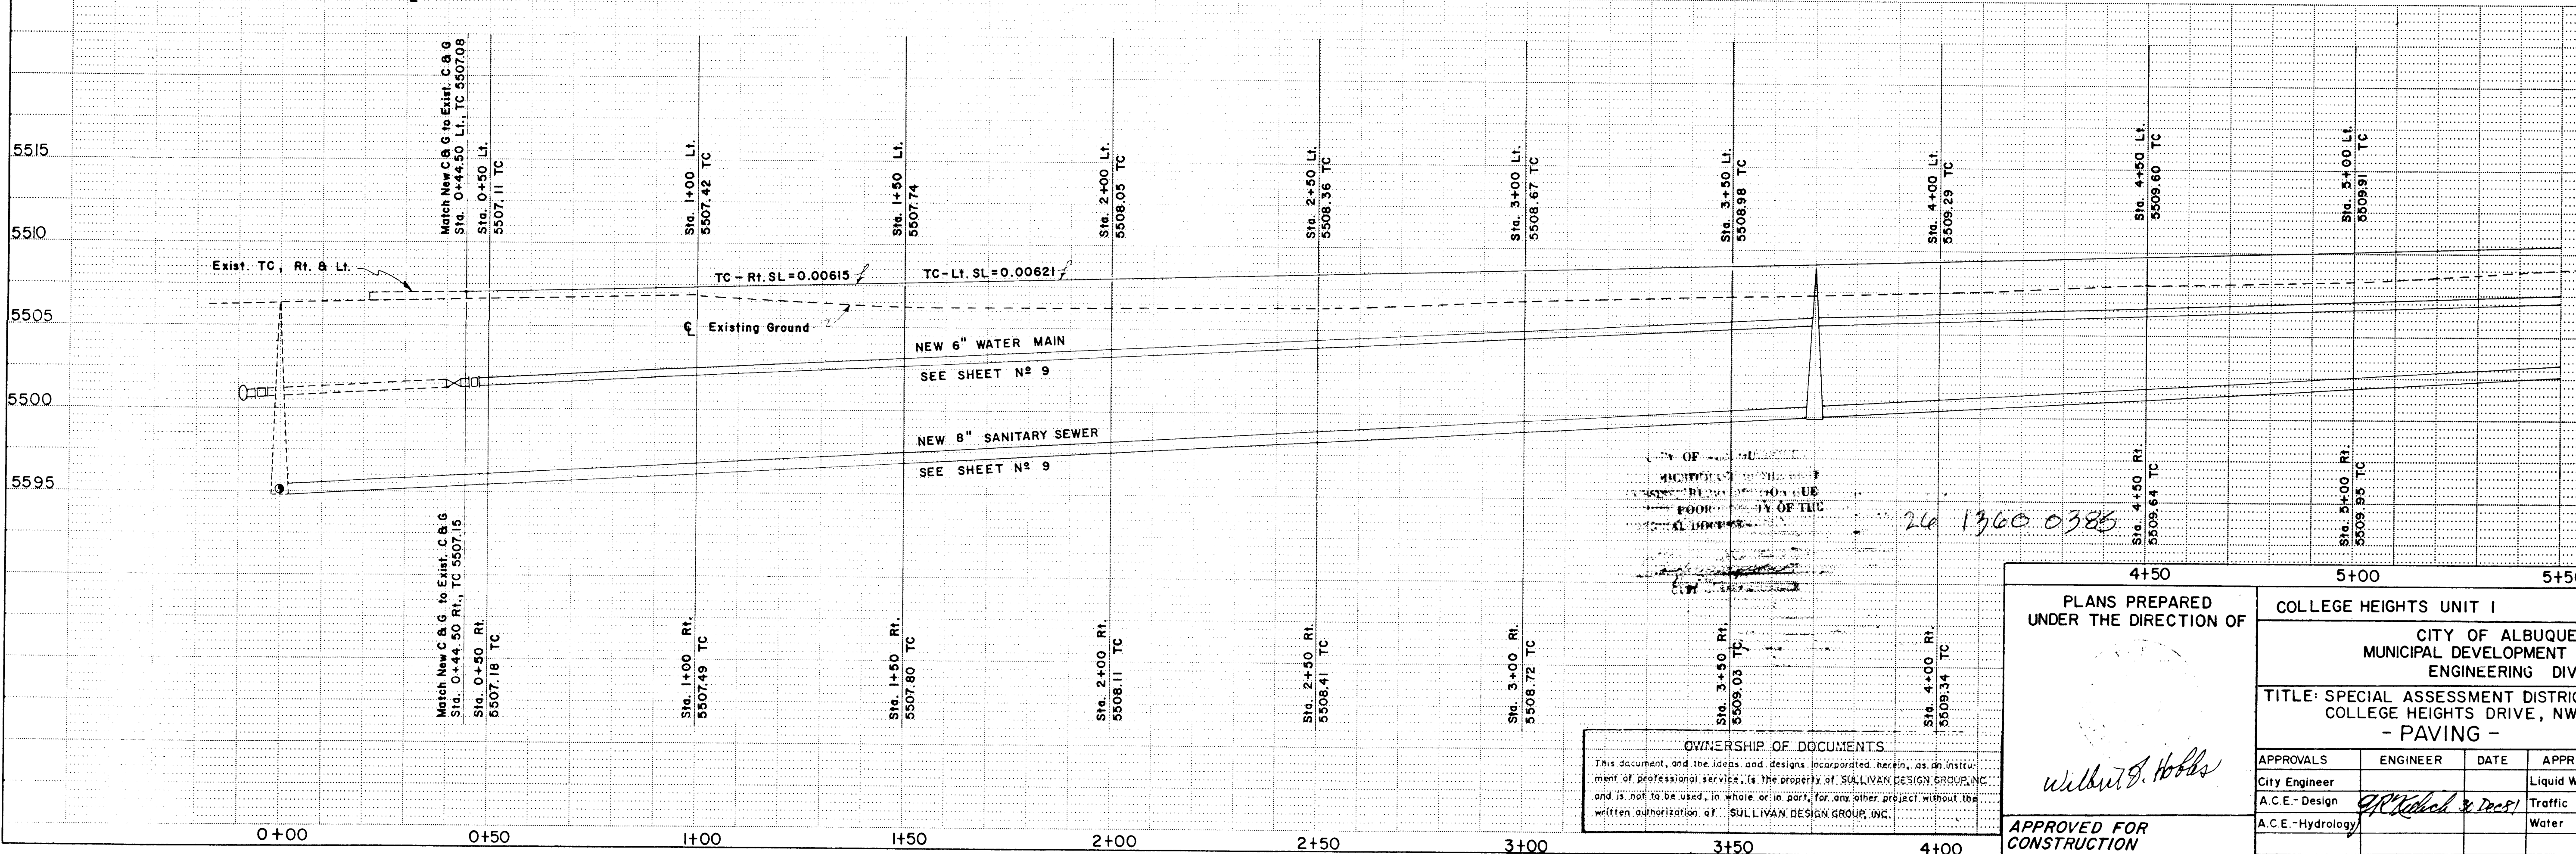


OWNERSHIP OF DOCUMENTS
This document, and the ideas and designs incorporated herein, as an instrument of professional service, is the property of SULLIVAN DESIGN GROUP, INC. and is not to be used, in whole or in part, for any other project without the written authorization of SULLIVAN DESIGN GROUP, INC.

PLANS PREPARED UNDER THE DIRECTION OF			COLLEGE HEIGHTS UNIT I		
CITY OF ALBUQUERQUE MUNICIPAL DEVELOPMENT DEPARTMENT ENGINEERING DIVISION			TITLE: SPECIAL ASSESSMENT DISTRICT N° 200 COLLEGE HEIGHTS DRIVE, NW - PAVING -		
APPROVALS	ENGINEER	DATE	APPROVALS	ENGINEER	DATE
City Engineer			Liquid Waste		
A.C.E. - Design			Traffic		
A.C.E. - Hydrology			Water		
DRAWING NO. 1360			SHEET 3 OF 13		



Sdg sullivan design group, inc.
santa fe albuquerque new mexico

SCALE: HORIZ. 1" = 20'
VERT. 1" = 5'

COLLEGE HEIGHTS DR., NW ITEMS 1-22 (PAVING, SAS & WATER)

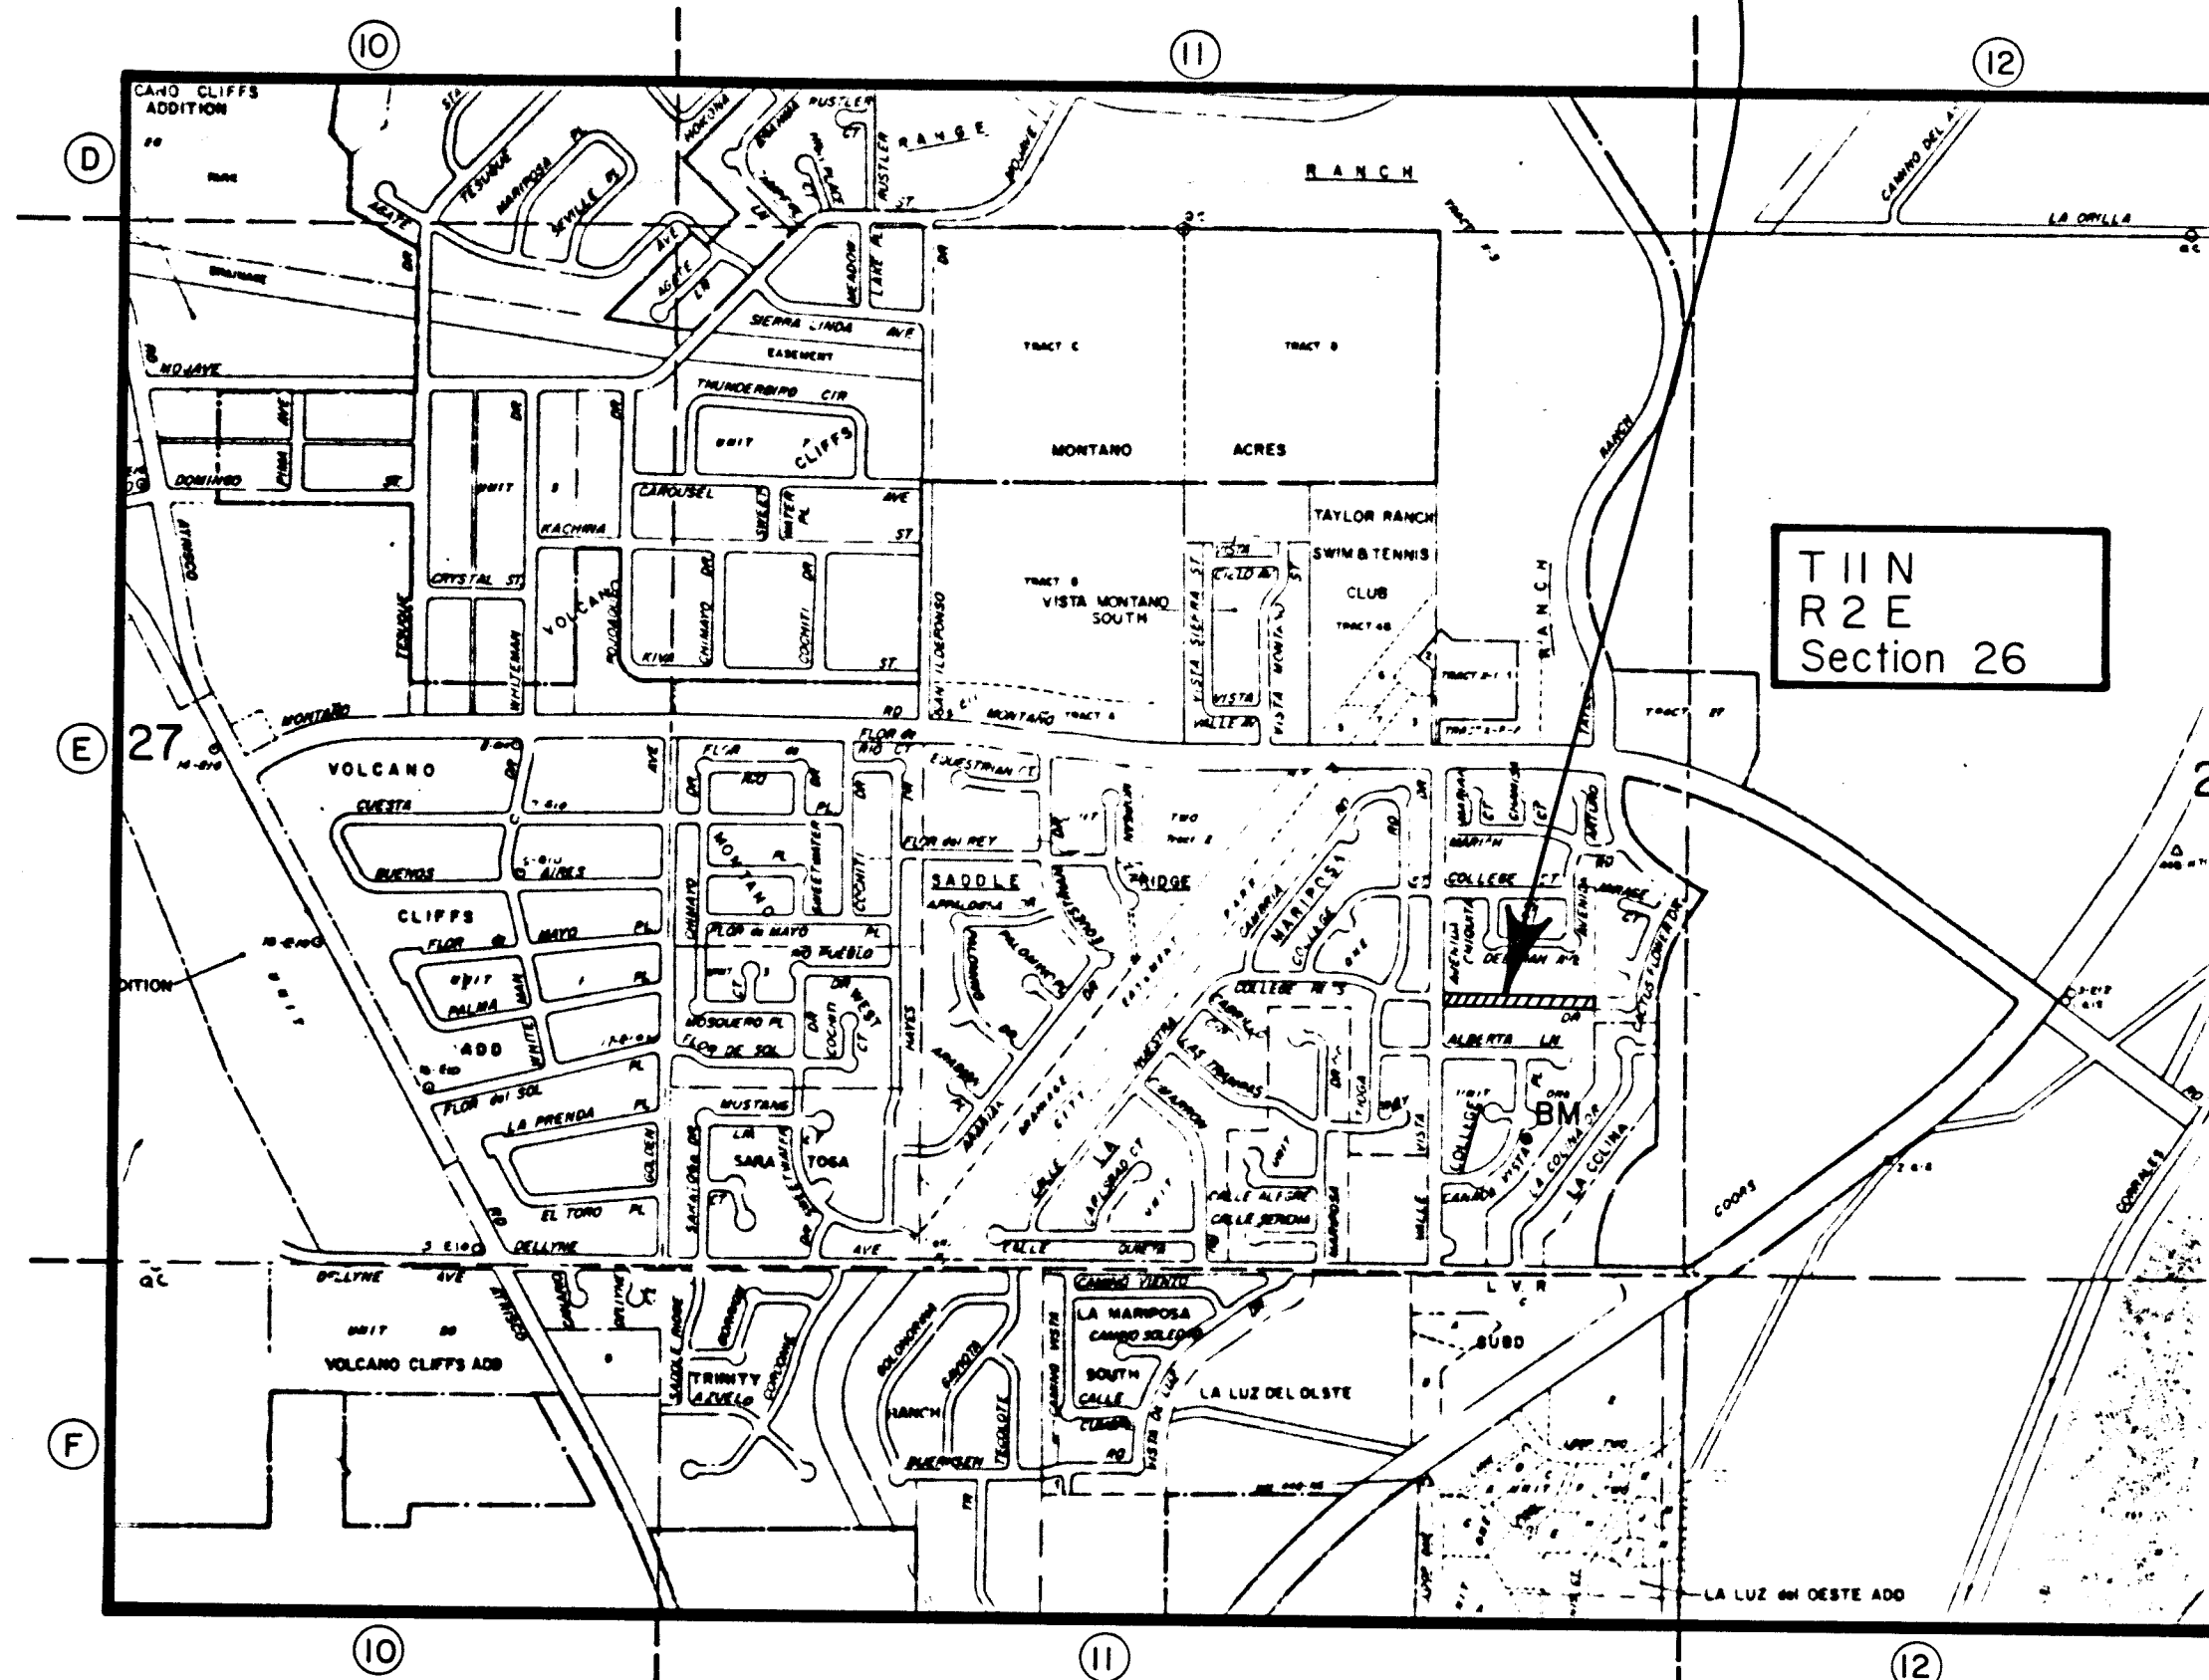


PAISANO ST., NE ITEMS 40-53, 55-57 (PAVING)

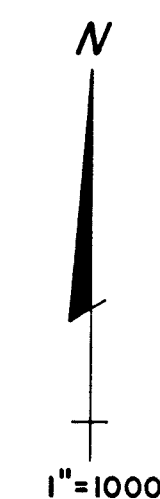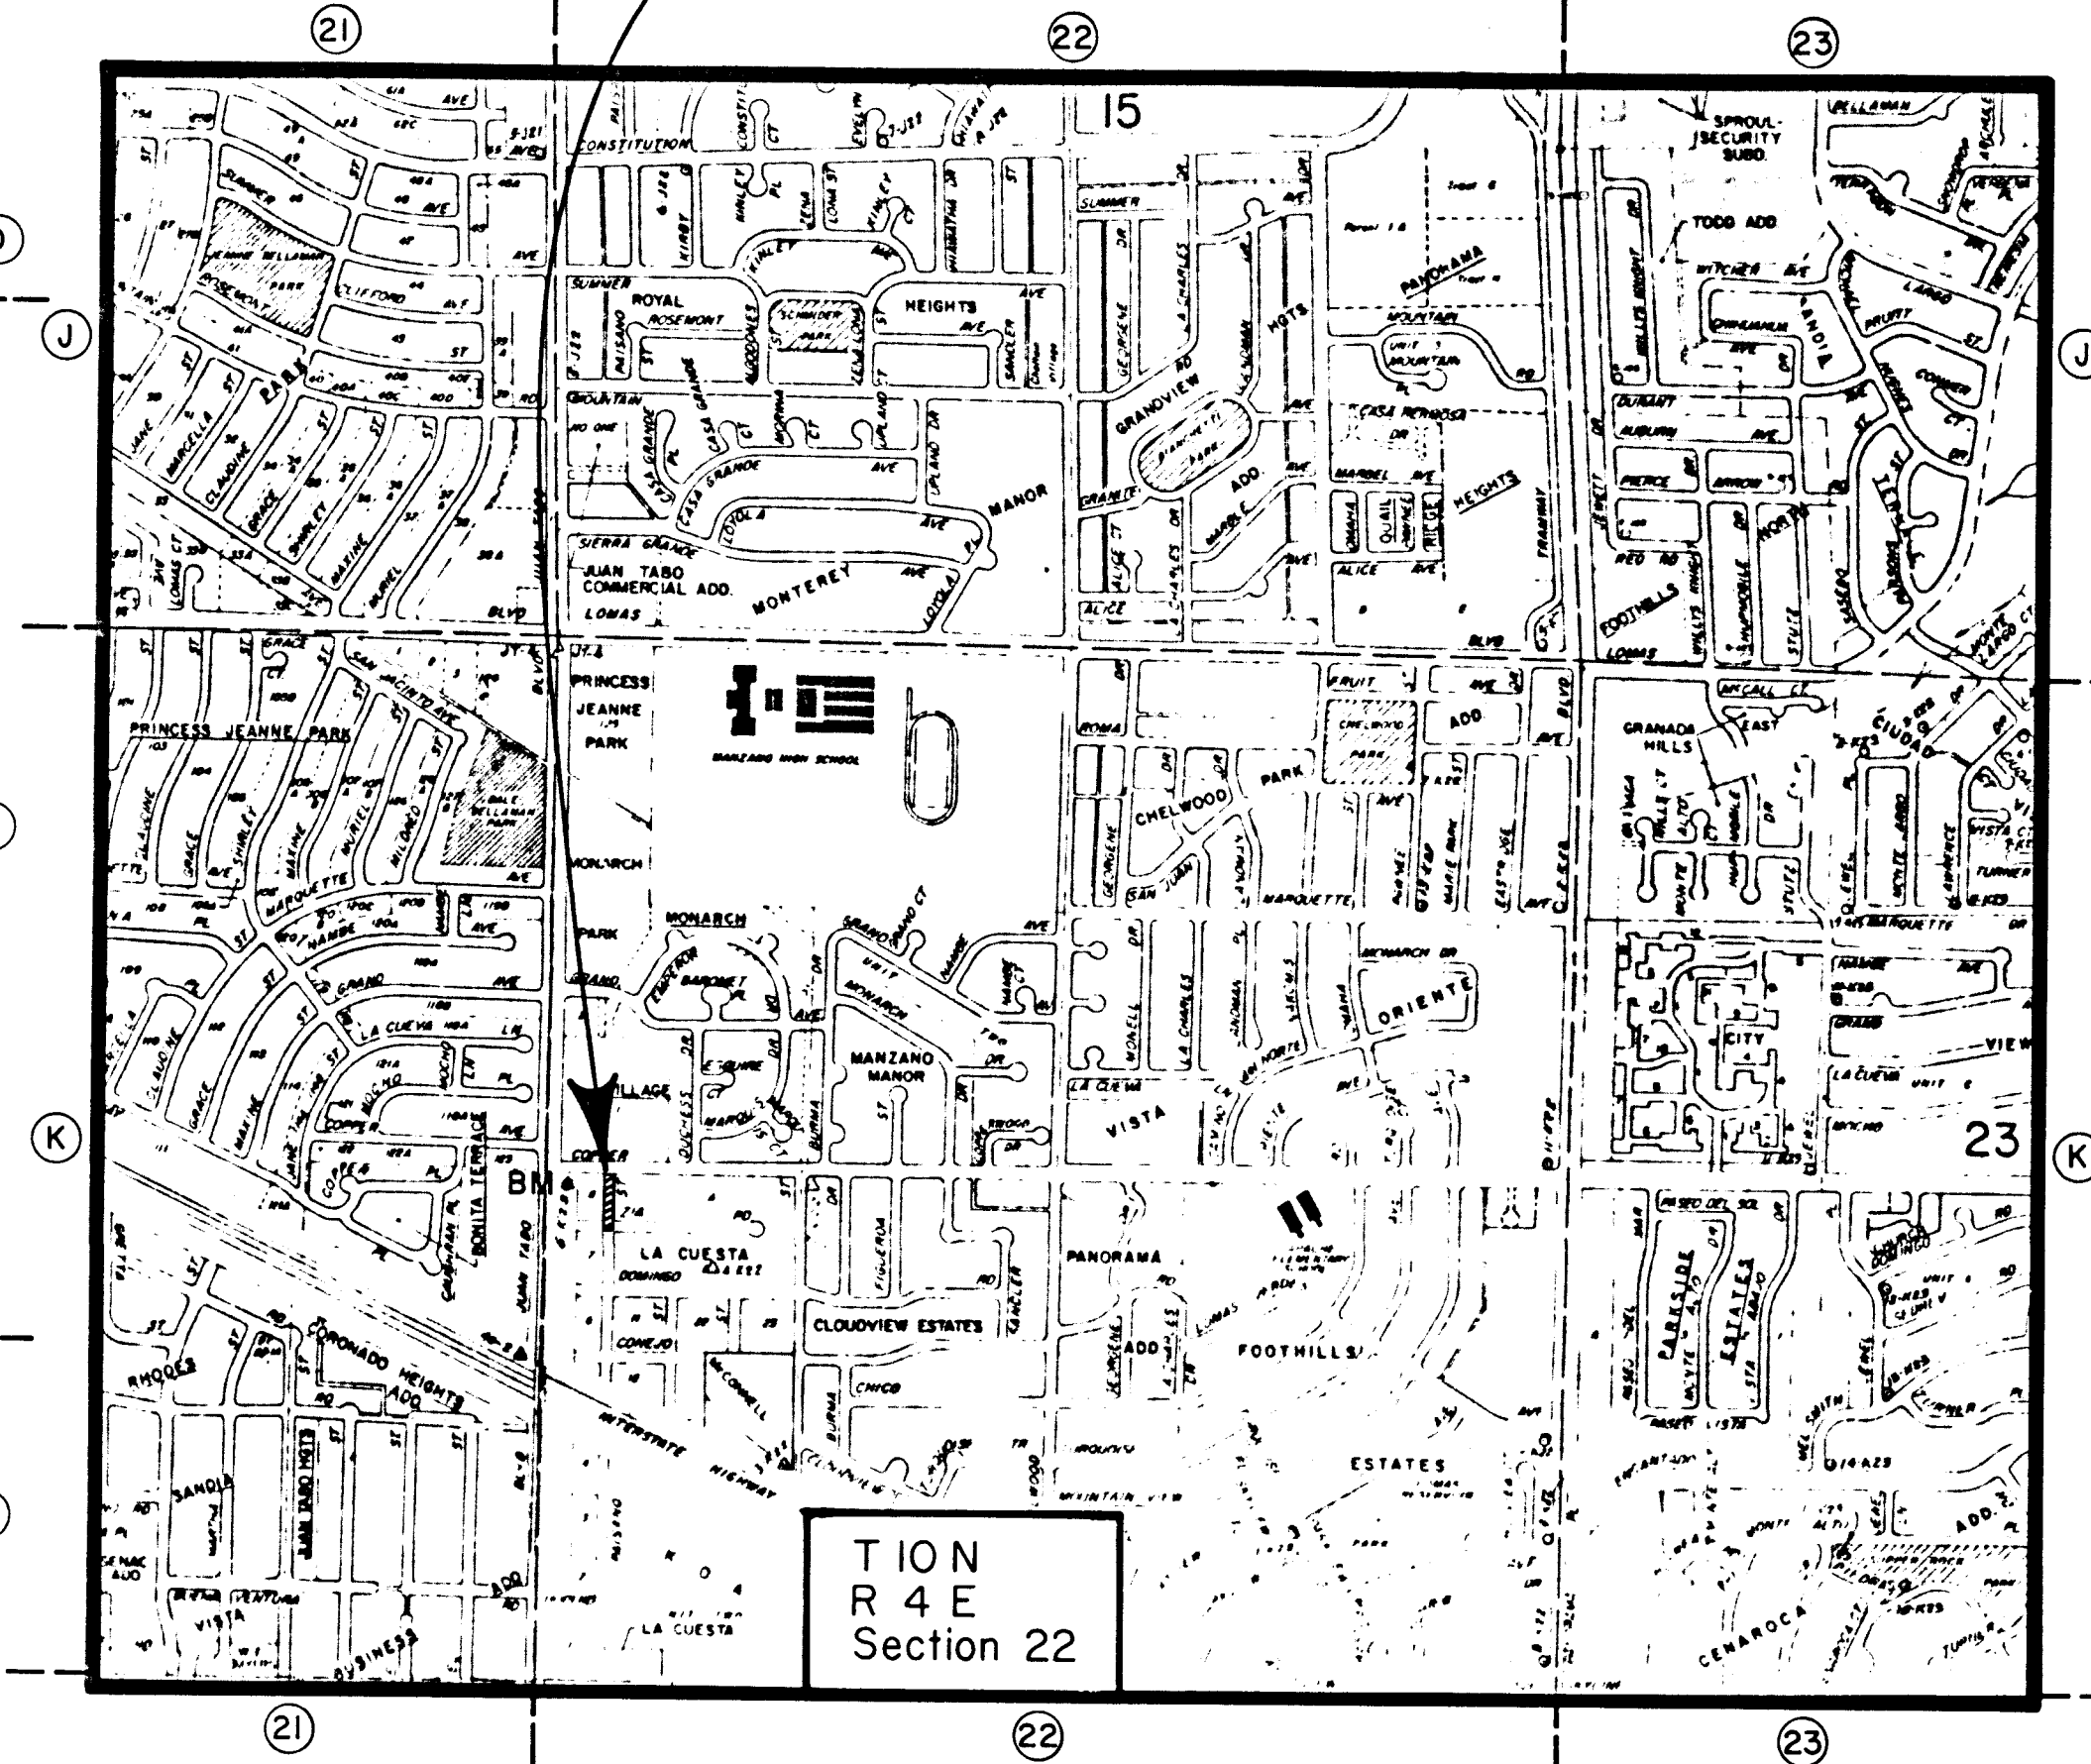


LEGEND

	NEW	EXISTING
CURB & GUTTER		
SIDEWALK		
WHEELCHAIR RAMP		
SANITARY SEWER LINE		
MANHOLE		
SANITARY SEWER		
WATER LINE		
GATE VALVE WITH VALVE BOX		
FIRE HYDRANT		
WATER METER & WATER SERVICE CONNECTION		
DIRECTION OF FLOW		
PROPERTY LINE		
LOT NUMBERS		
BLOCK NUMBERS		
ITEM NUMBERS		
ASPHALT PAVEMENT		

DARTMOUTH DR., NE ITEMS 23-27 (PAVING, SAS & WATER)

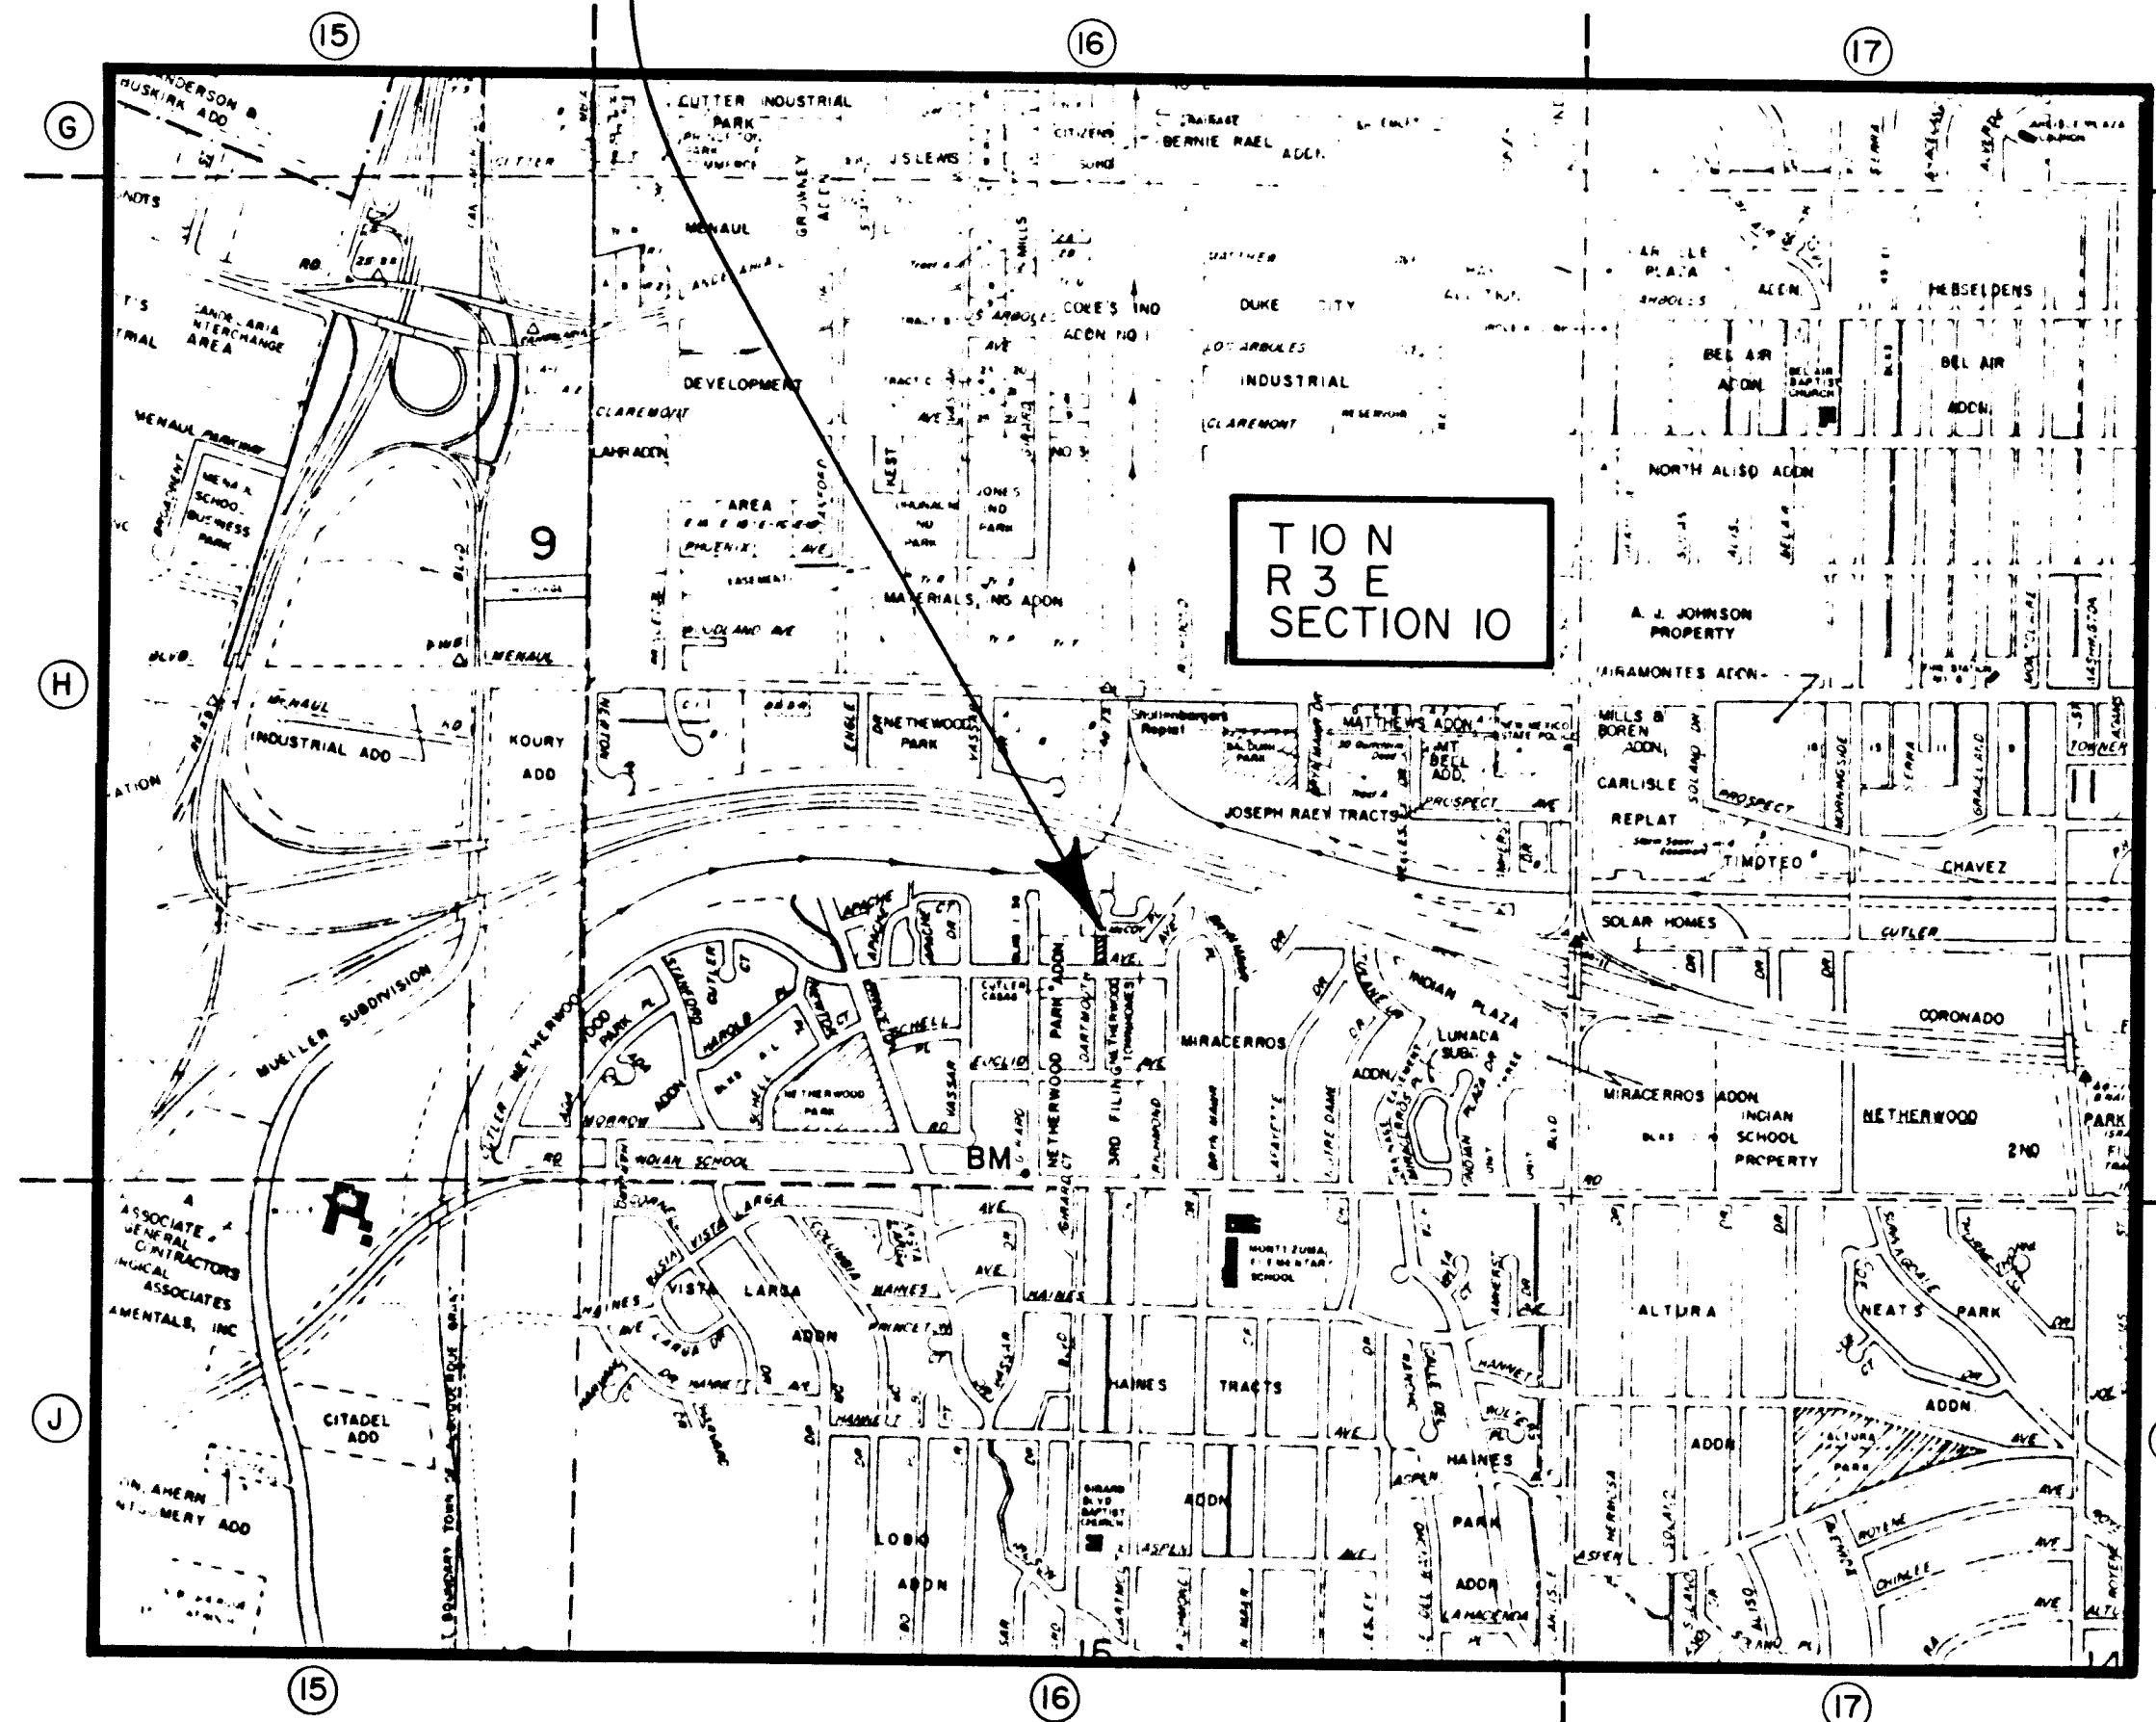

ALLEY NORTH OF LOMAS BLVD., NE ITEMS 73-79 (PAVING)

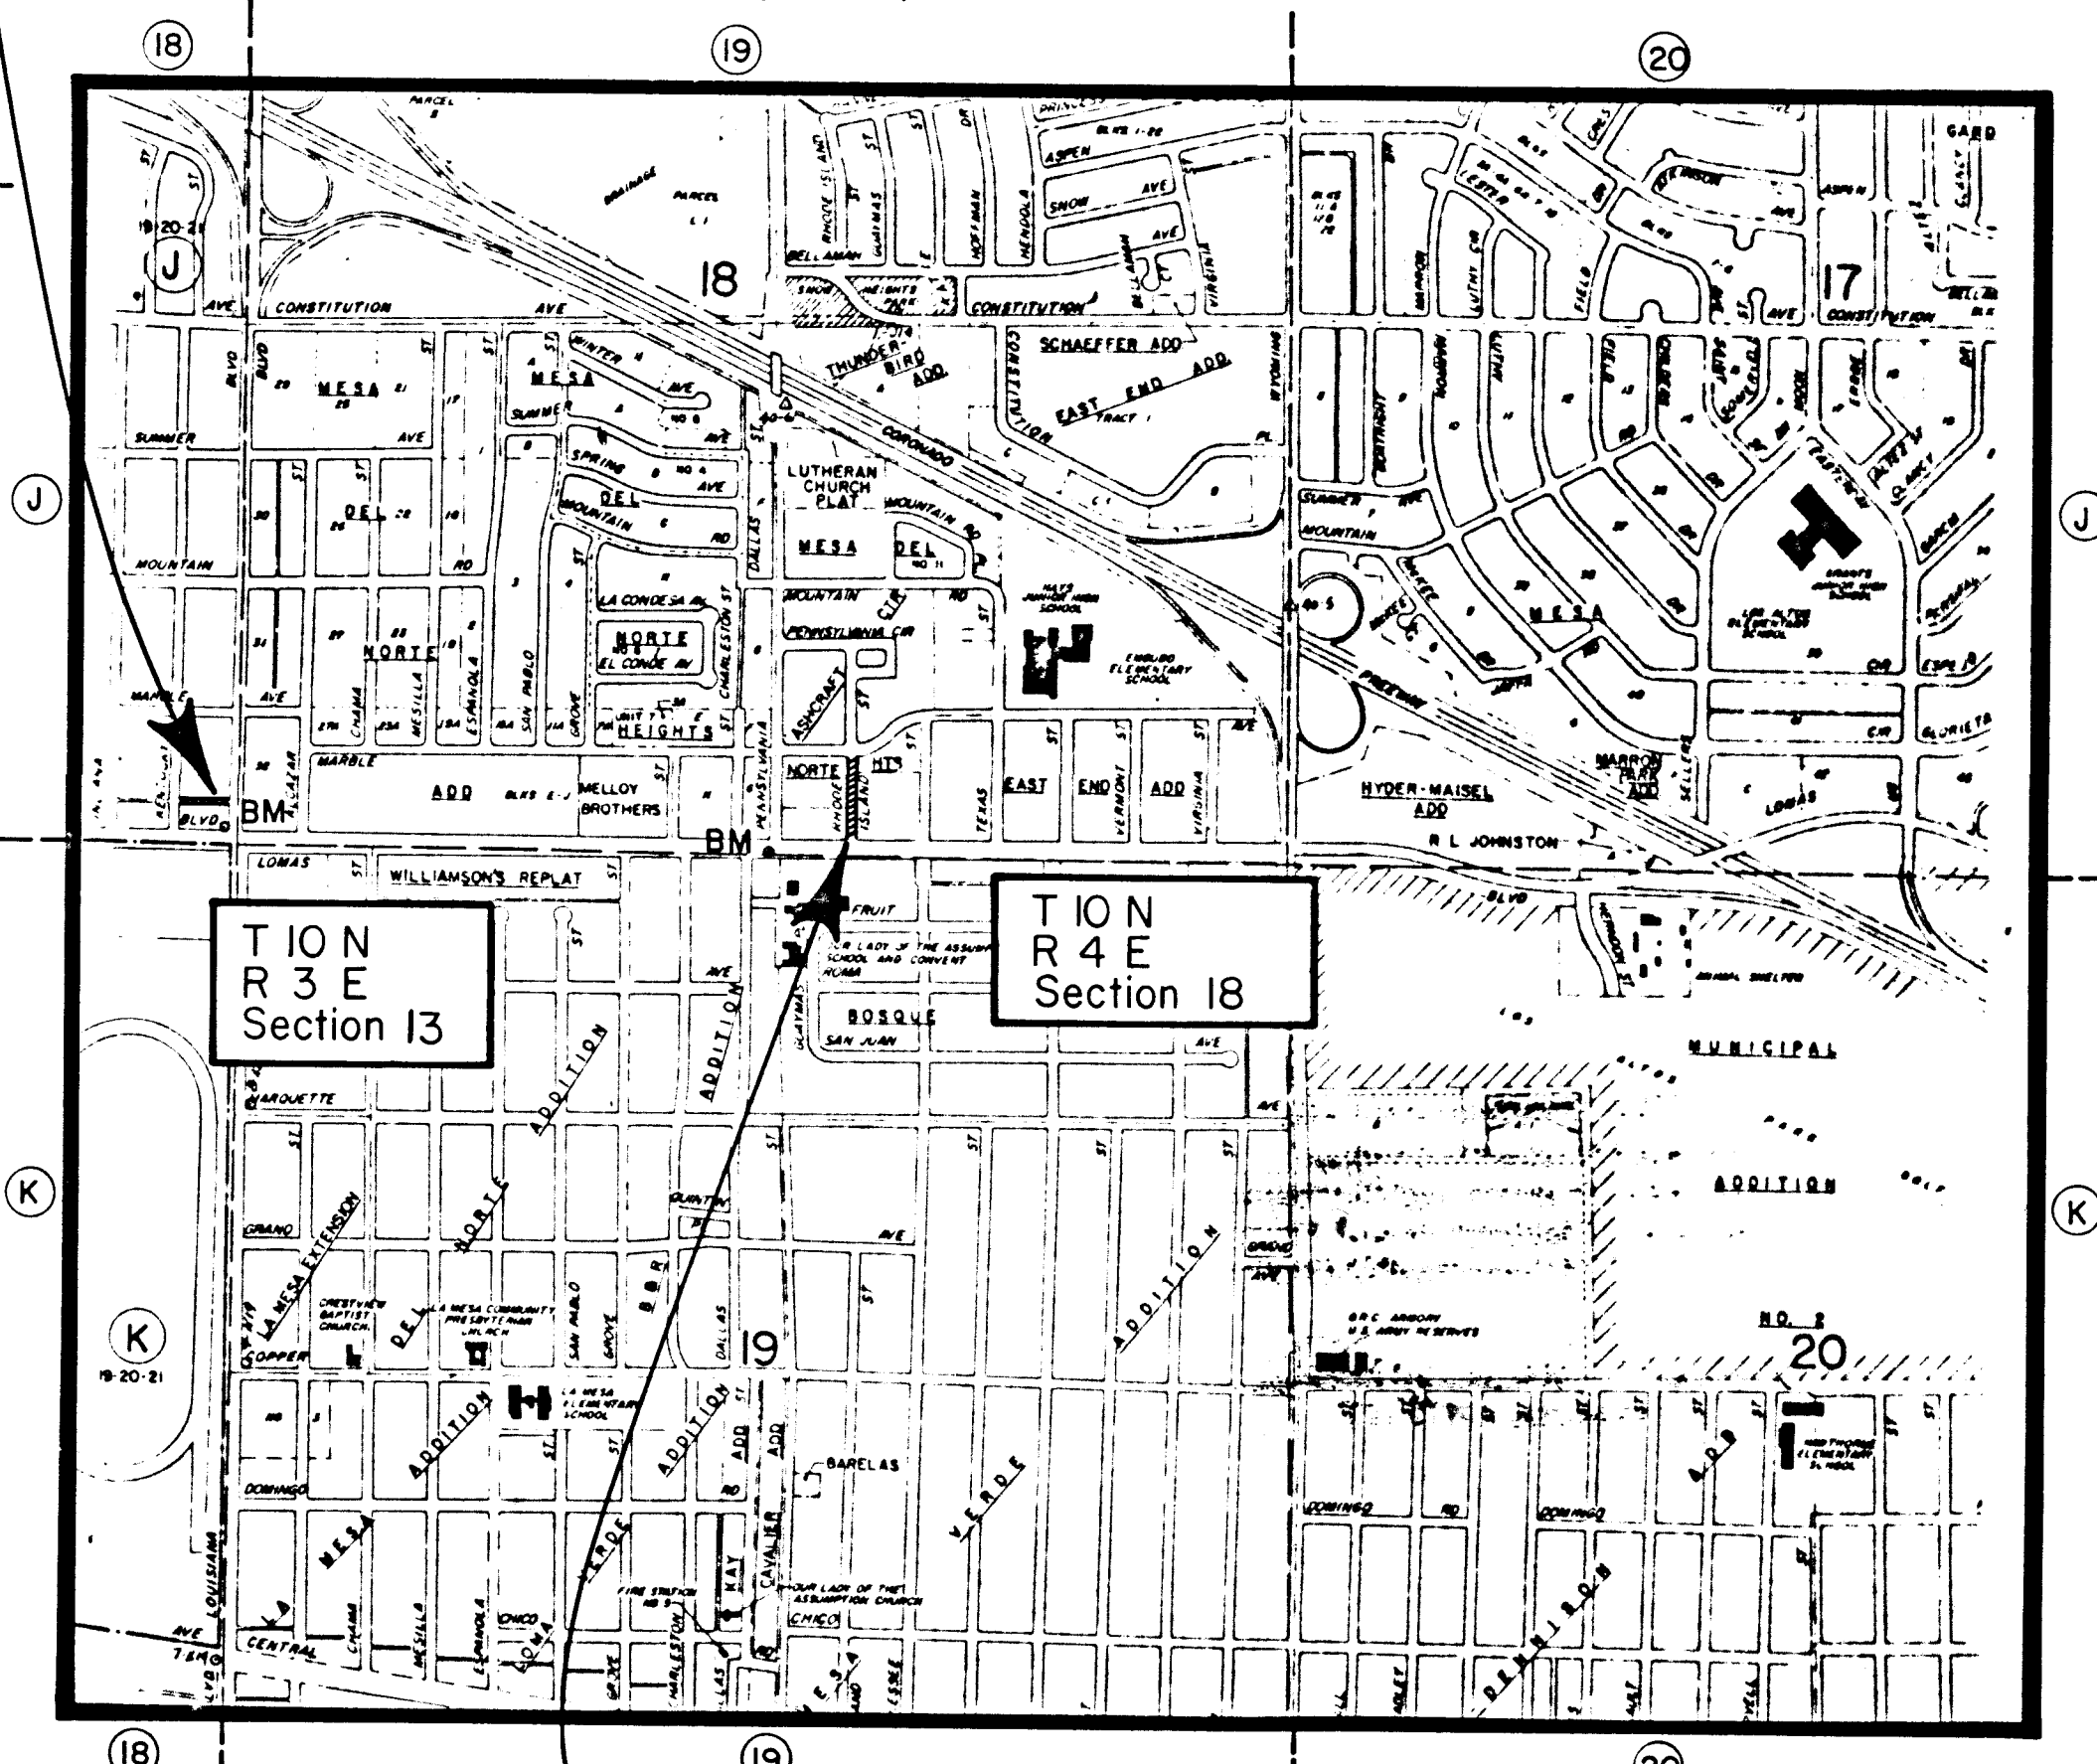

RECORD DRAWINGS

THESE RECORD DRAWINGS HAVE BEEN PREPARED, IN PART, ON THE BASIS OF INFORMATION COMPILED AND FURNISHED BY OTHERS. THE ENGINEER WILL NOT BE RESPONSIBLE FOR ANY ERRORS OR OMISSIONS WHICH HAVE BEEN INCORPORATED INTO THIS DOCUMENT AS A RESULT.
DATE: May 17, 1983

LEGEND

DR-Drive	LN-Lane	RD-Road
BLVD-Boulevard	CT-Cut	ST-Street
CR-Cut	PL-Place	TR-Trail
CT-Cut		
ARROW	PRIVATE STREET OR ROAD	
CITY LIMIT	SUBDIVISION BOUNDARY OR FREEWAY RIGHT OF WAY	
GRANT LINE	TRACT OR BLOCK BOUNDARY	

SCALE IN FEET
0 500 1000 1500 2000

SURVEY MONUMENTS
(Locations Approximate)
○ Horizontal control
○ Vertical control
○ Public lands survey

Sdg sullivan design group, incorporated
albuquerque • santa fe • new mexico

PLANS PREPARED UNDER THE DIRECTION OF


CITY OF ALBUQUERQUE
MUNICIPAL DEVELOPMENT DEPARTMENT
ENGINEERING DIVISION

TITLE: SPECIAL ASSESSMENT DISTRICT No 200
—LOCATION MAP AND LEGEND—

APPROVALS	ENGINEER	DATE	APPROVALS	ENGINEER	DATE
CITY ENGINEER			LIQUID WASTE		
A.C.E.—DESIGN			TRAFFIC		
A.C.E.—HYDROLOGY			WATER		

DRAWING NO. 1360
SHEET 2 OF 13

RHODE ISLAND ST., NE ITEMS 28-39 (PAVING, SAS & WATER)

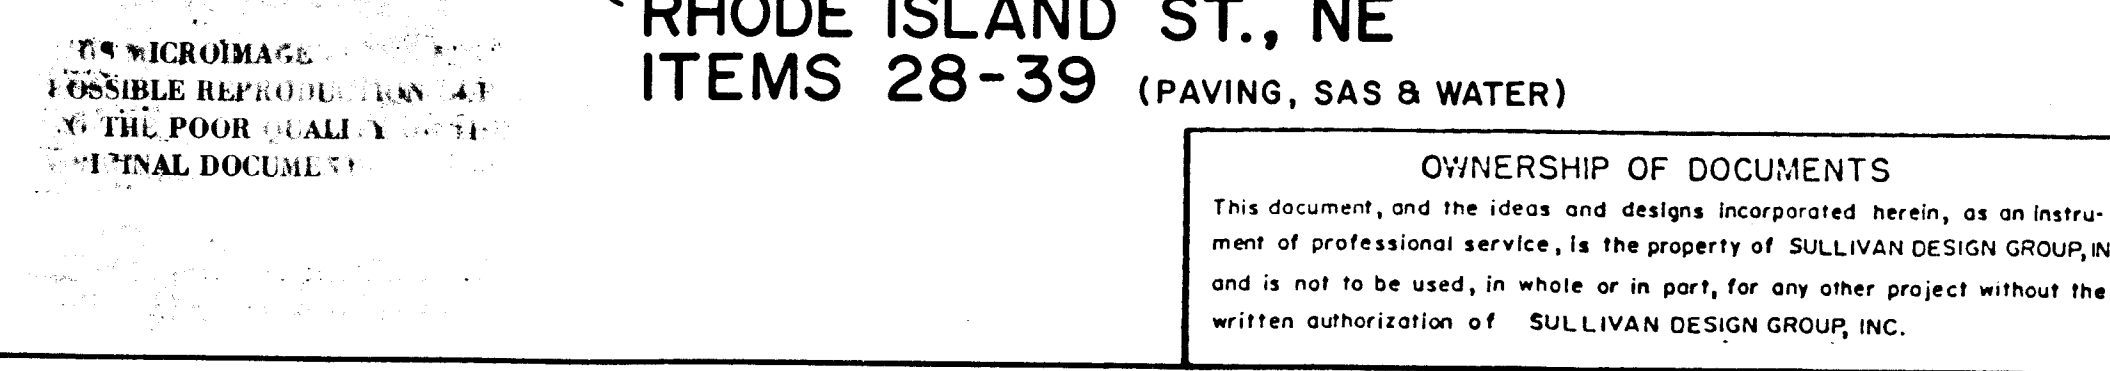

OWNERSHIP OF DOCUMENTS

This document, and the ideas and designs incorporated herein, as an instrument of professional service, is the property of SULLIVAN DESIGN GROUP, INC. and is not to be used, in whole or in part, for any other project without the written authorization of SULLIVAN DESIGN GROUP, INC.

APPROVED FOR CONSTRUCTION


CITY ENGINEER DATE

AP 131670

NOTE: ALL LOTS ZONED R-1 UNLESS OTHERWISE SHOWN.


COLLEGE HEIGHTS UNIT I (12-2-65) (D3-129)
BLOCK B

SAGECREST (D7-134)

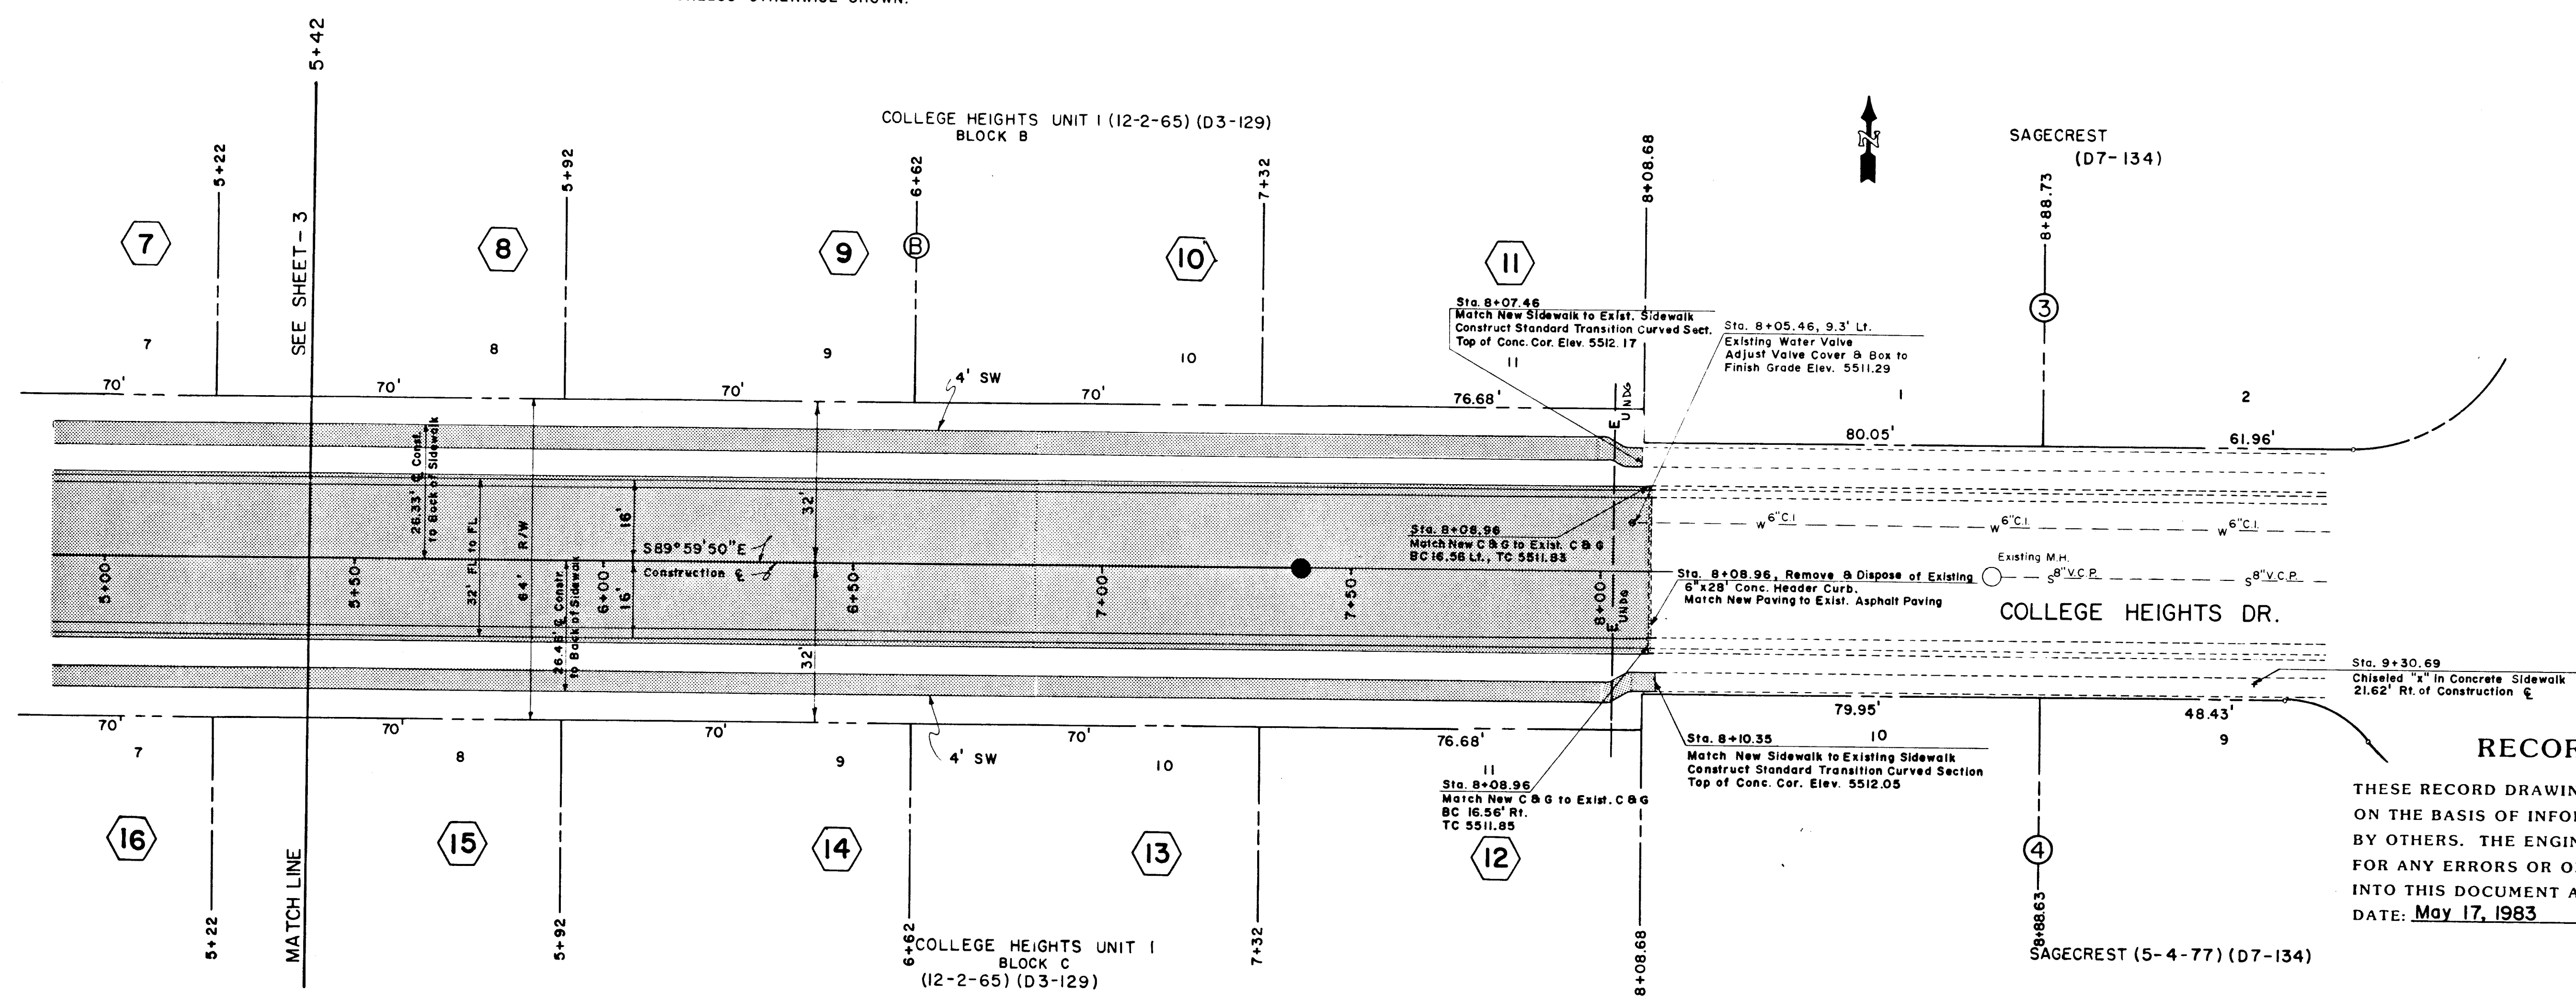

RECORD DRAWINGS

THESE RECORD DRAWINGS HAVE BEEN PREPARED, IN PART, ON THE BASIS OF INFORMATION COMPILED AND FURNISHED BY OTHERS. THE ENGINEER WILL NOT BE RESPONSIBLE FOR ANY ERRORS OR OMISSIONS WHICH HAVE BEEN INCORPORATED INTO THIS DOCUMENT AS A RESULT.
DATE: May 17, 1983

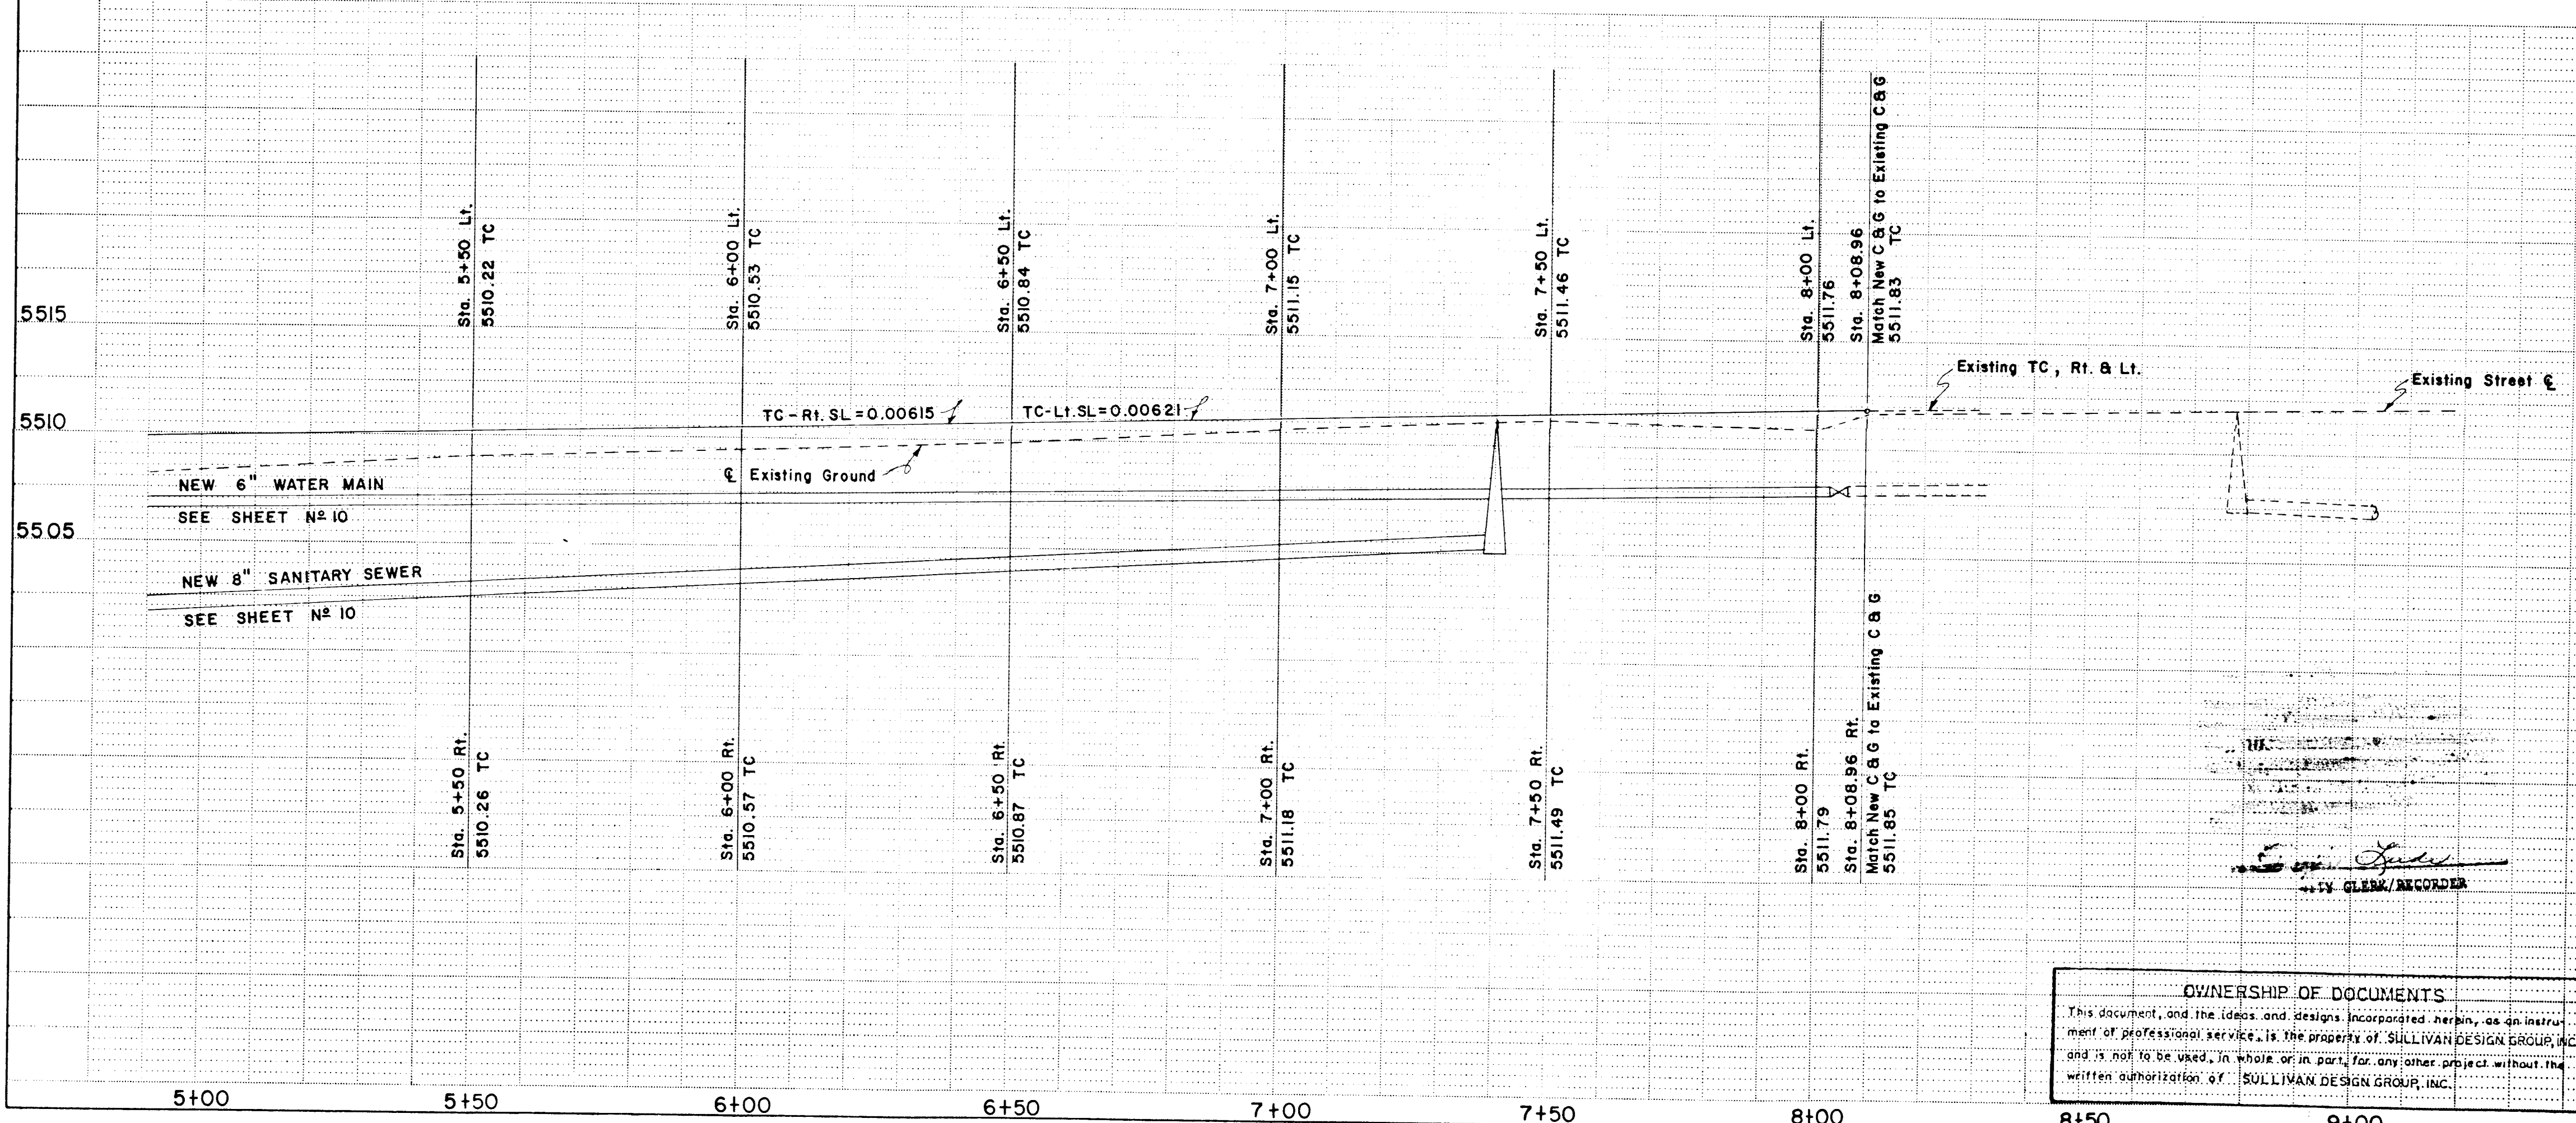


OWNERSHIP OF DOCUMENTS
This document, and the ideas and designs incorporated herein, are an instrument of professional service, and are the property of SULLIVAN DESIGN GROUP, INC. and is not to be used, in whole or in part, for any other project without the written authorization of SULLIVAN DESIGN GROUP, INC.

PLANS PREPARED UNDER THE DIRECTION OF
Walter J. Hobbs
APPROVED FOR CONSTRUCTION
CITY ENGINEER DATE

CITY OF ALBUQUERQUE MUNICIPAL DEVELOPMENT DEPARTMENT ENGINEERING DIVISION			
TITLE: SPECIAL ASSESSMENT DISTRICT N° 200 COLLEGE HEIGHTS DRIVE, NW - PAVING -			
APPROVALS		ENGINEER	DATE
City Engineer		Liquid Waste	12/9/81
A.C.E. - Design		Traffic	11/10/81
A.C.E. - Hydrology		Water	12/14/81
DRAWING NO. 1360		SHEET 4 OF 13	


SURVEY INFORMATION		BENCH MARKS		AS BUILT INFORMATION	
DATE	BY	STANDARD CITY OF ALBUQUERQUE BRASS	CONTRACTOR	WORK	DATE
6-81	WFH - JMK	TABLET STAMPED 1-E11 1969	INSPECTORS	ACCEPTANCE BY	DATE
N/A	N/A	EAST OF EAST CURB & FLUSH WITH TOP OF CURB	VERIFICATION BY	DATE	
		LOCATED ON EAST SIDE OF CANADA VISTA PL.	DRAWINGS BY	DATE	
		NW 300' SOUTH OF ALBERTA LN. NW	MICRO-FILM INFORMATION	RECORDED BY	DATE
				NO.	

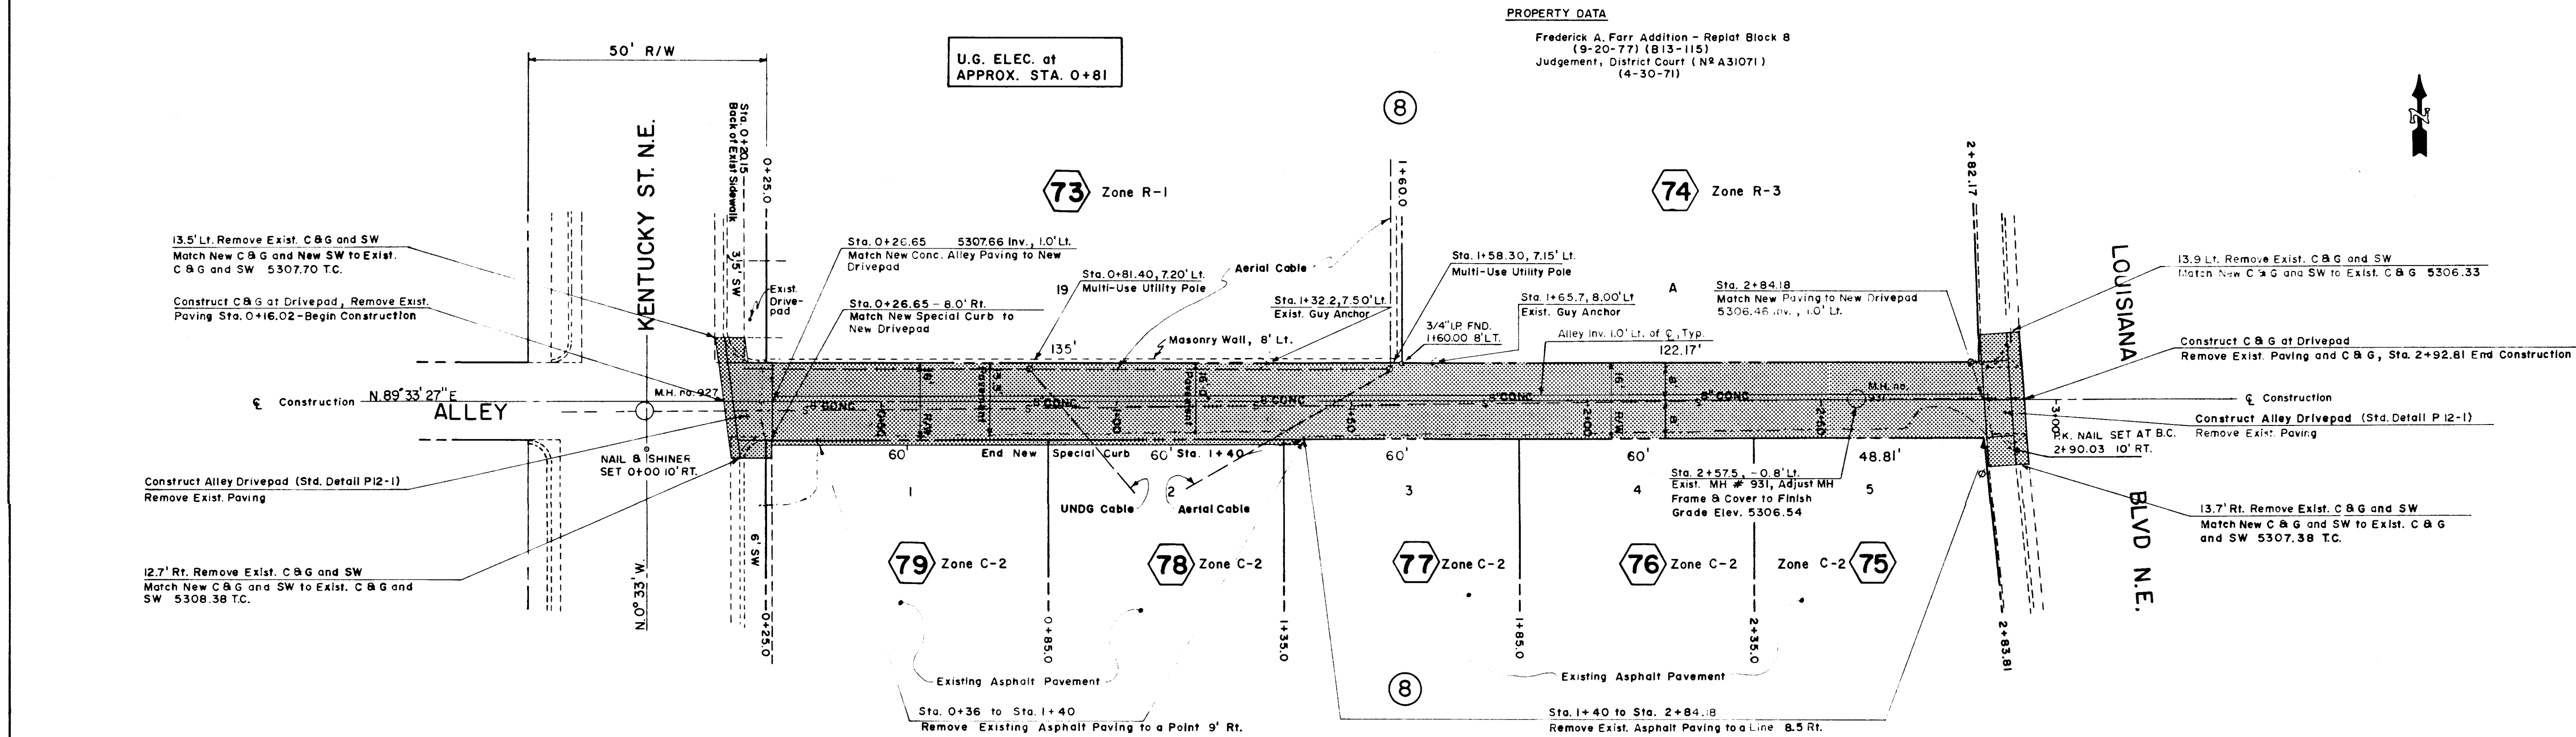

RECORD DRAWINGS

THESE RECORD DRAWINGS HAVE BEEN PREPARED, IN PART, ON THE BASIS OF INFORMATION COMPILED AND FURNISHED BY OTHERS. THE ENGINEER WILL NOT BE RESPONSIBLE FOR ANY ERRORS OR OMISSIONS WHICH HAVE BEEN INCORPORATED INTO THIS DOCUMENT AS A RESULT.

DATE: MAY 17, 1983

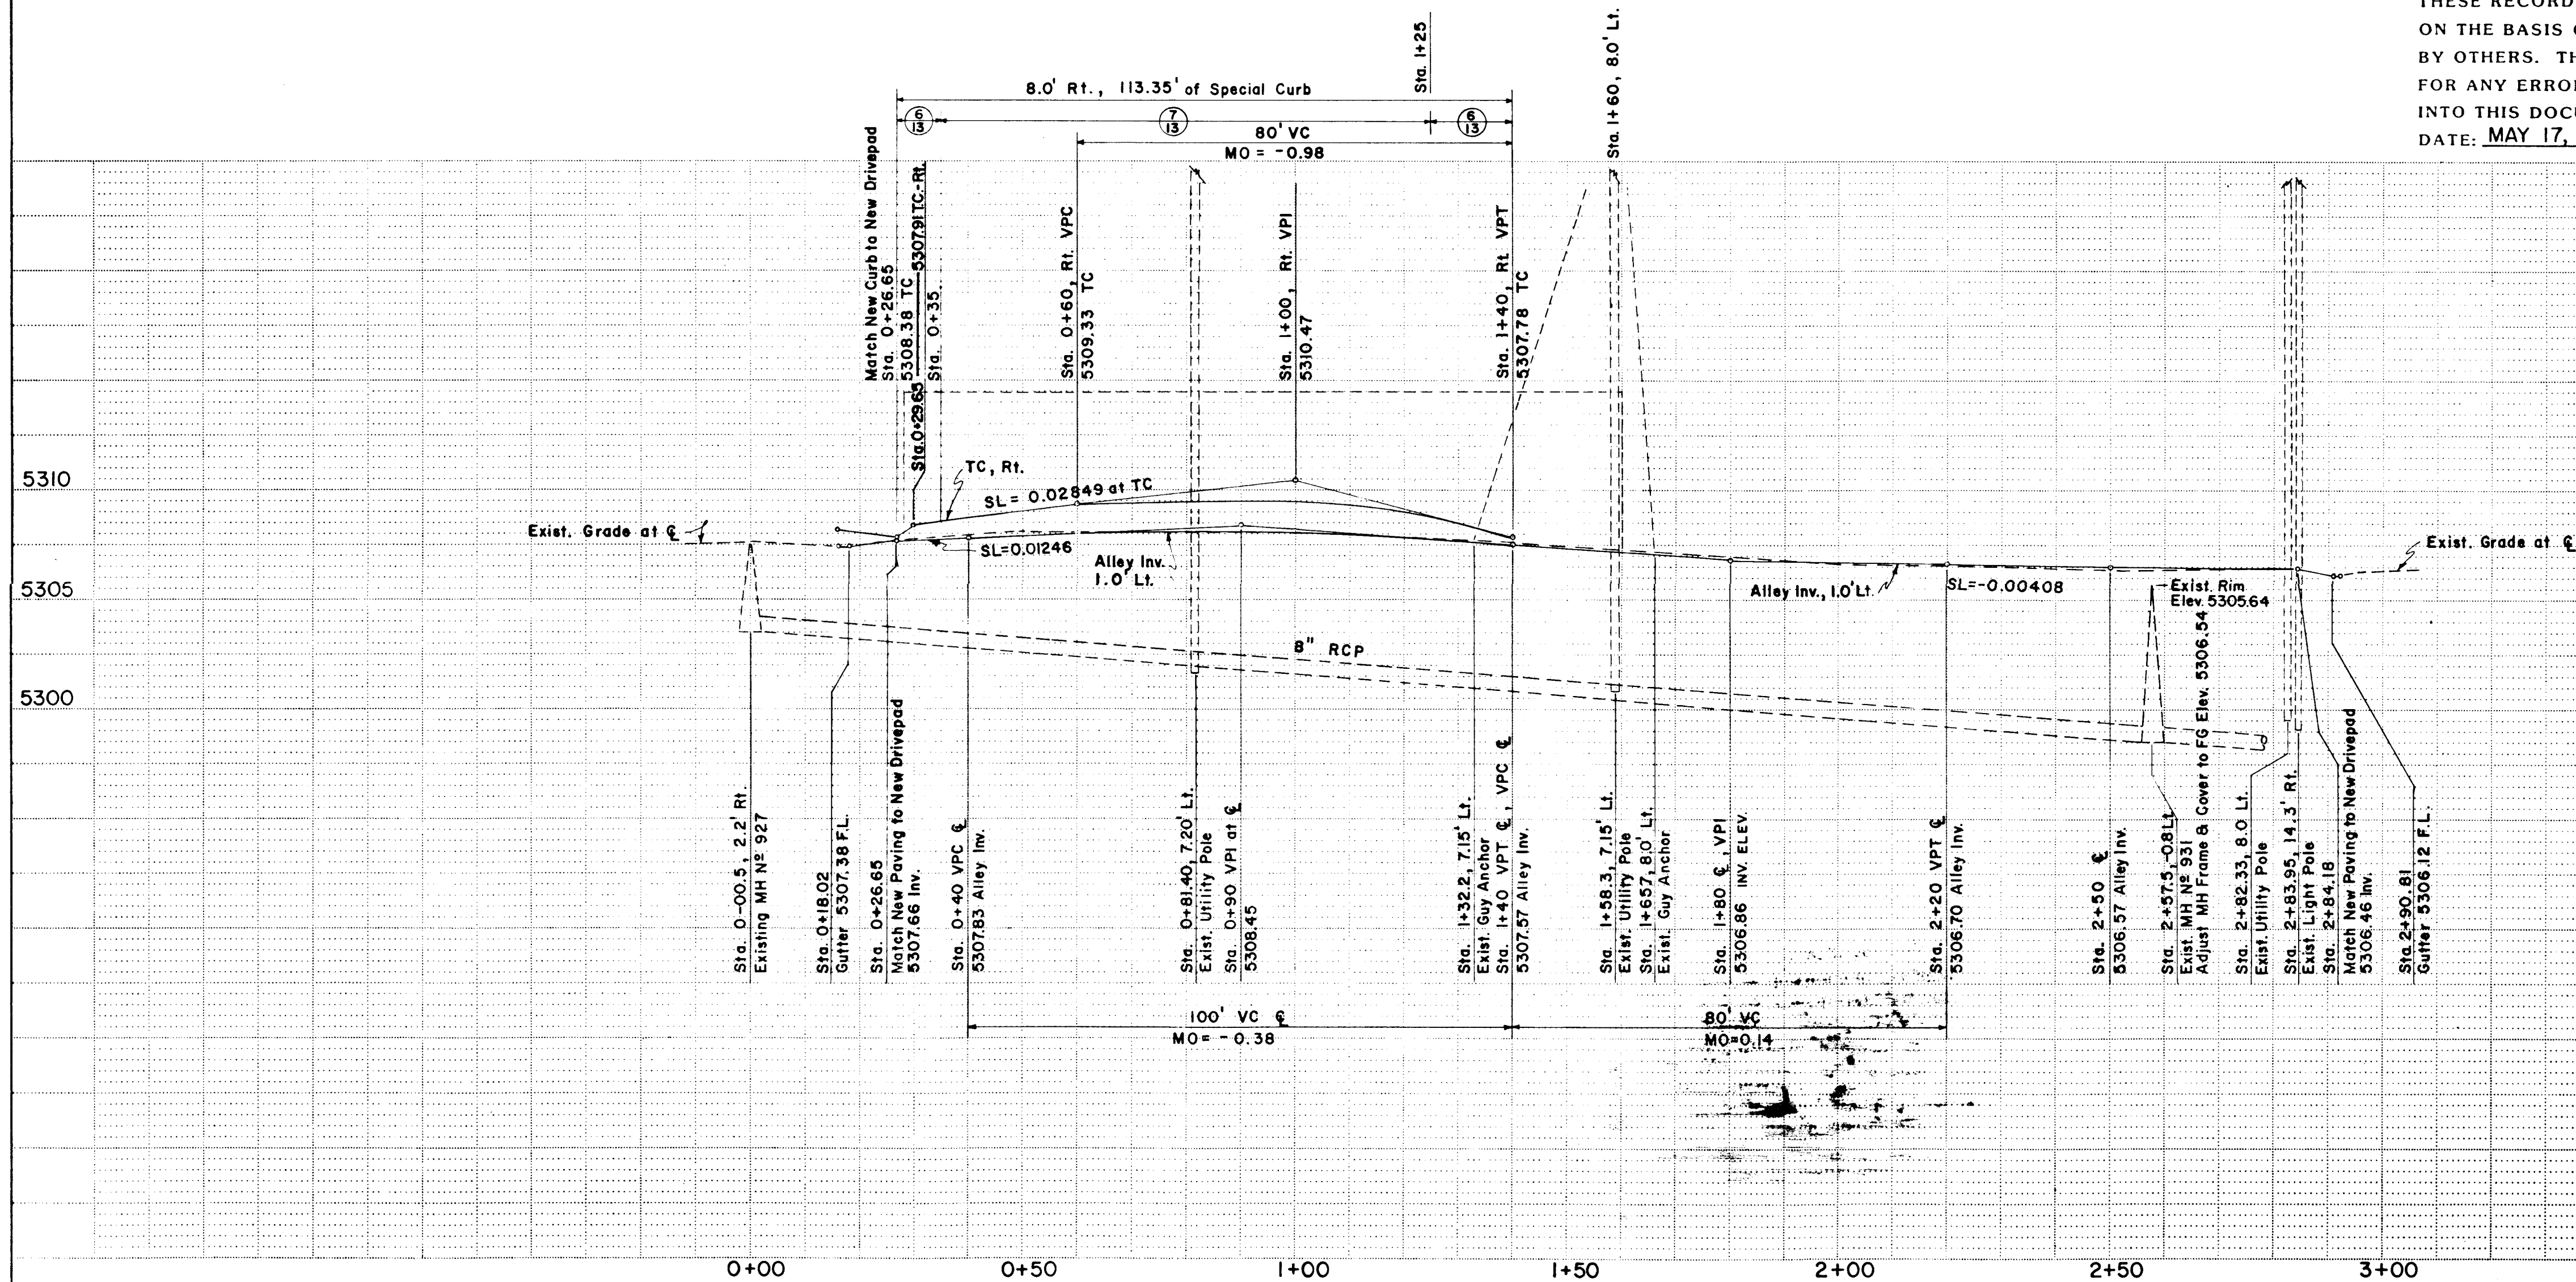

PLANS PREPARED UNDER THE DIRECTION OF:

APPROVED FOR CONSTRUCTION

CITY ENGINEER DATE

OWNERSHIP OF DOCUMENTS
This document and the ideas and designs incorporated herein, as an instrument of professional service, is the property of SULLIVAN DESIGN GROUP, INC. and is not to be used, in whole or in part, for any other project without the written authorization of SULLIVAN DESIGN GROUP, INC.

CITY OF ALBUQUERQUE
MUNICIPAL DEVELOPMENT DEPARTMENT
ENGINEERING DIVISION

TITLE: SPECIAL ASSESSMENT DISTRICT N° 200
ALLEY NORTH OF LOMAS BLVD., NE
- PAVING -


ZONE
MAP
J-18


APPROVALS	ENGINEER	DATE	APPROVALS	ENGINEER	DATE
City Engineer			Liquid Waste		
A.C.E. - Design			Traffic		
A.C.E. - Hydrology			Water		

DRAWING NO. 1360

SHEET 6 OF 13

SURVEY INFORMATION		BENCH MARKS		AS BUILT INFORMATION	
NO.	FIELD NOTES	NO.	DATE	CONTRACTOR	DATE
N/A	WFH - JMK	N/A	7/6/81	INSPECTOR'S	DATE
				FIELD BY	DATE
				VERIFICATION BY	DATE
				CORRECTED BY	DATE
				MICRO-FILM	INFORMATION
				RECORDED BY	DATE
				NO.	

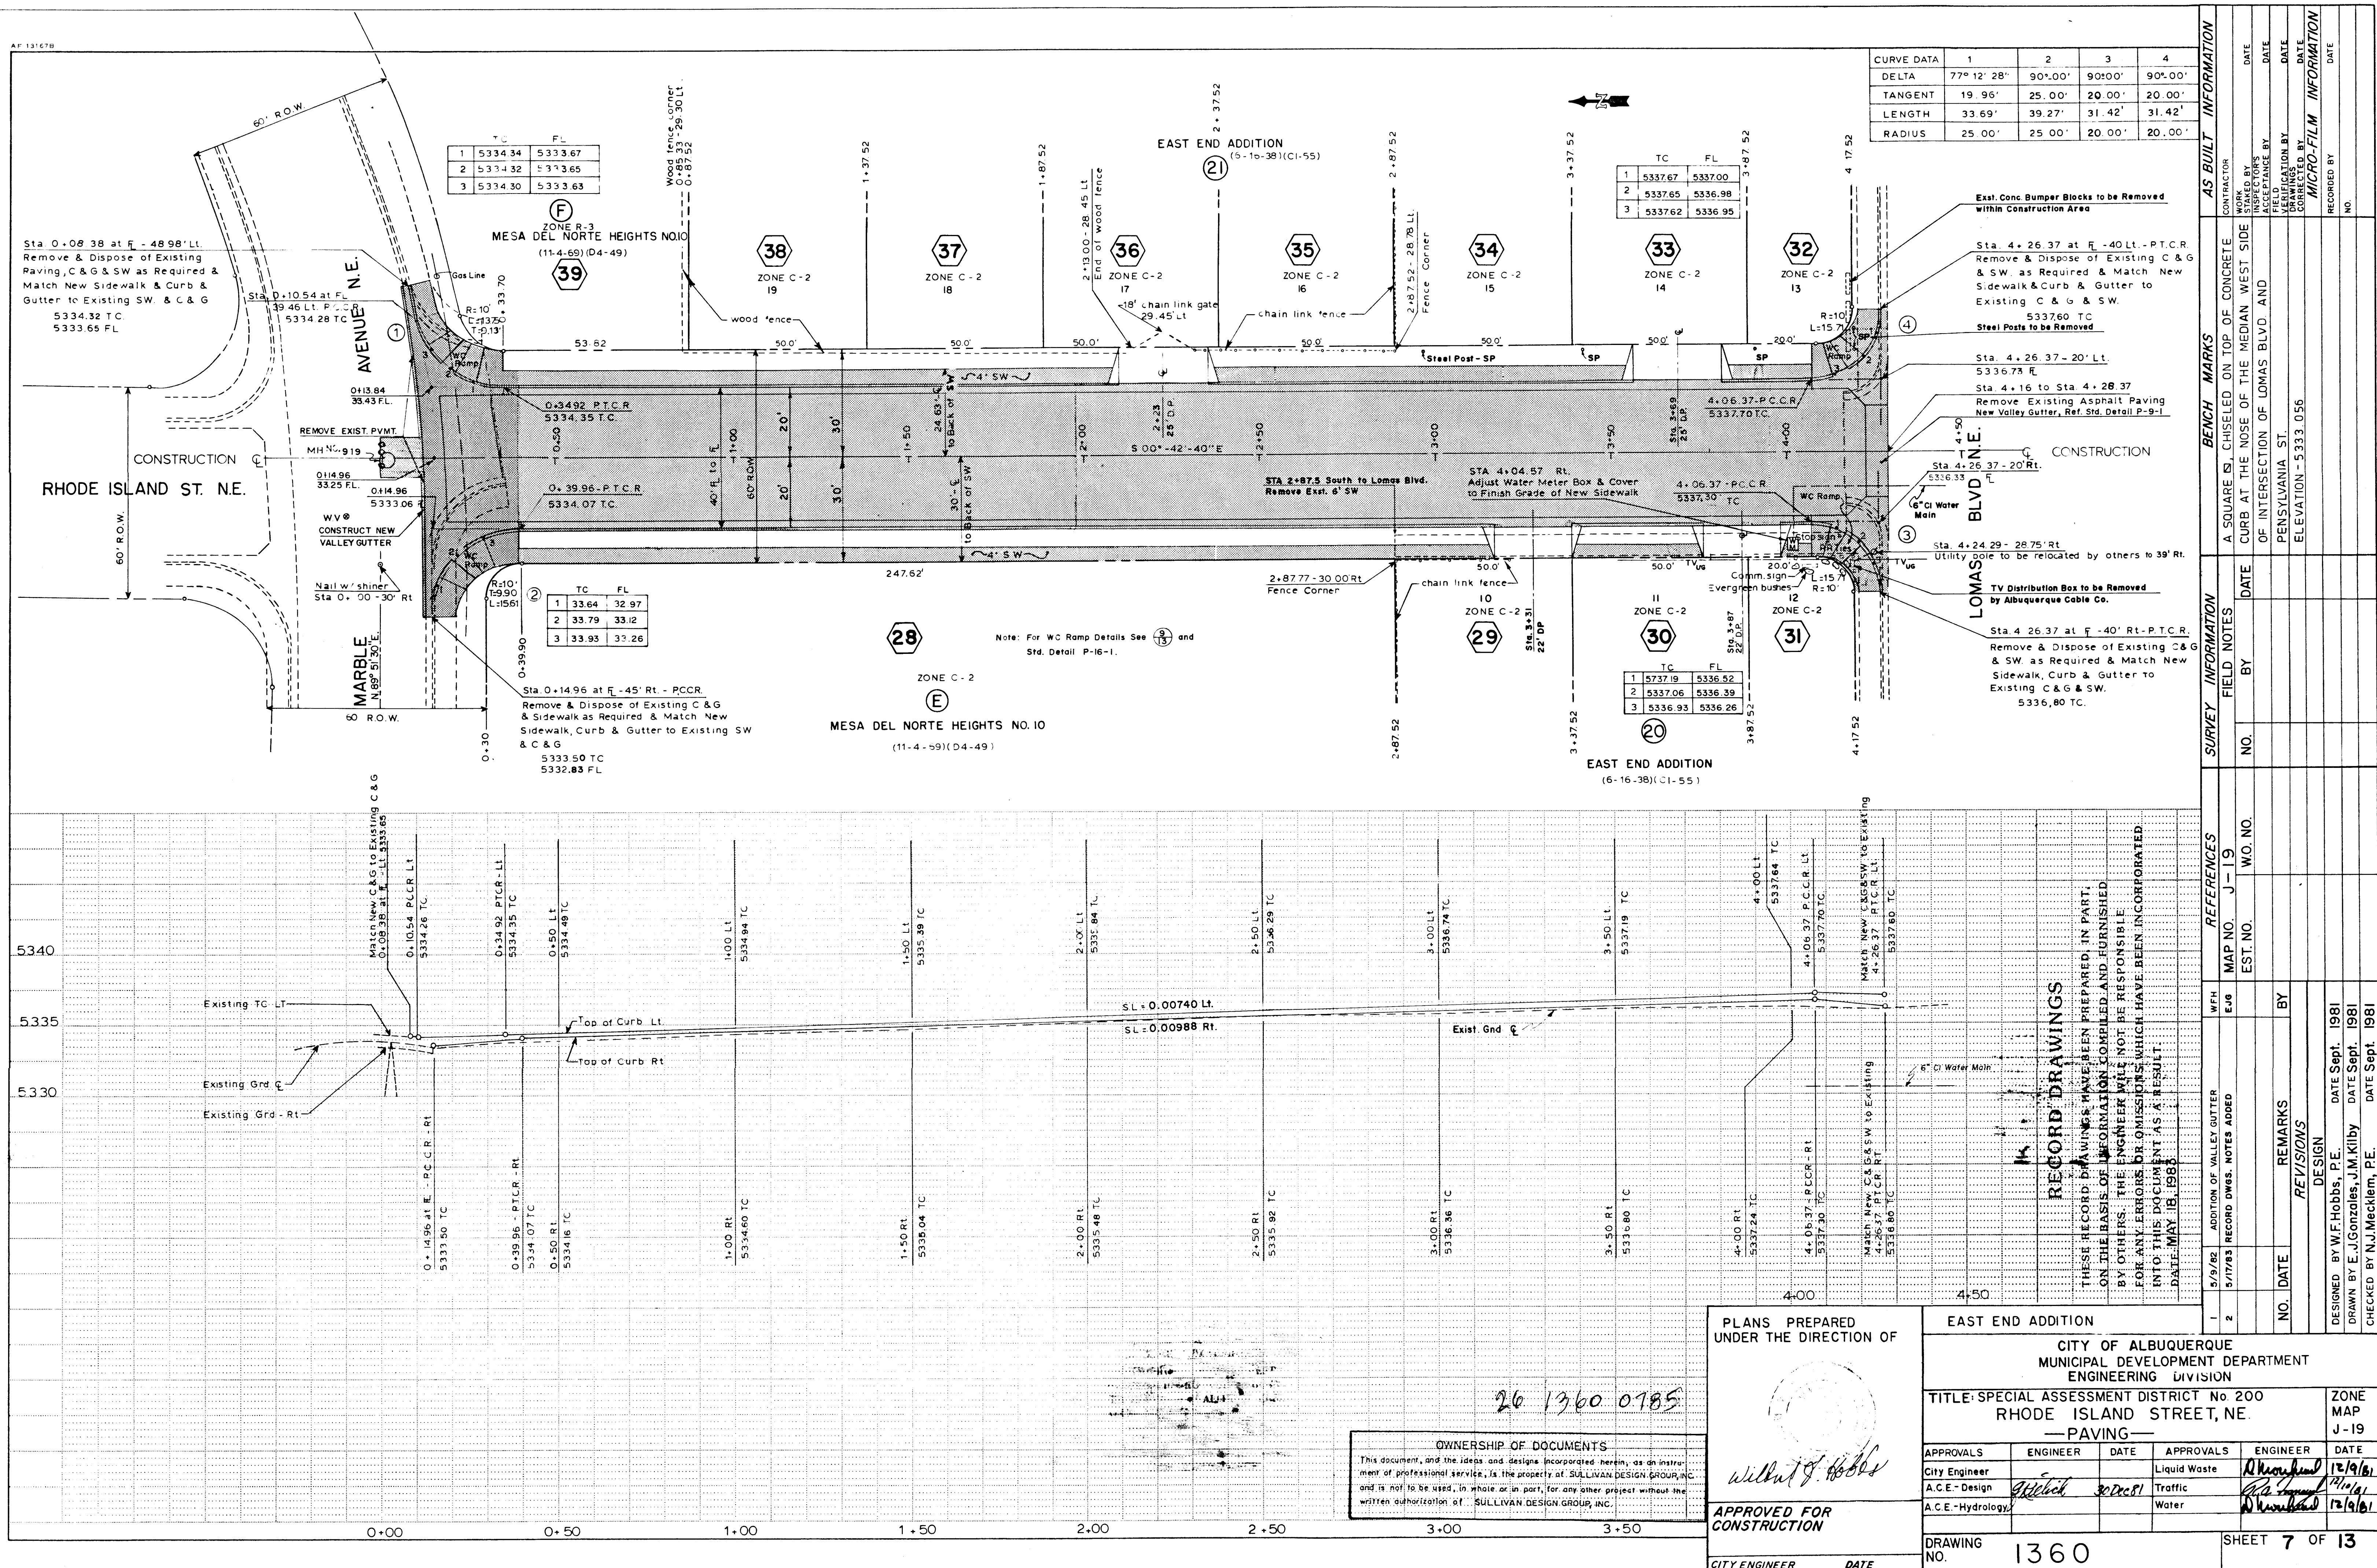

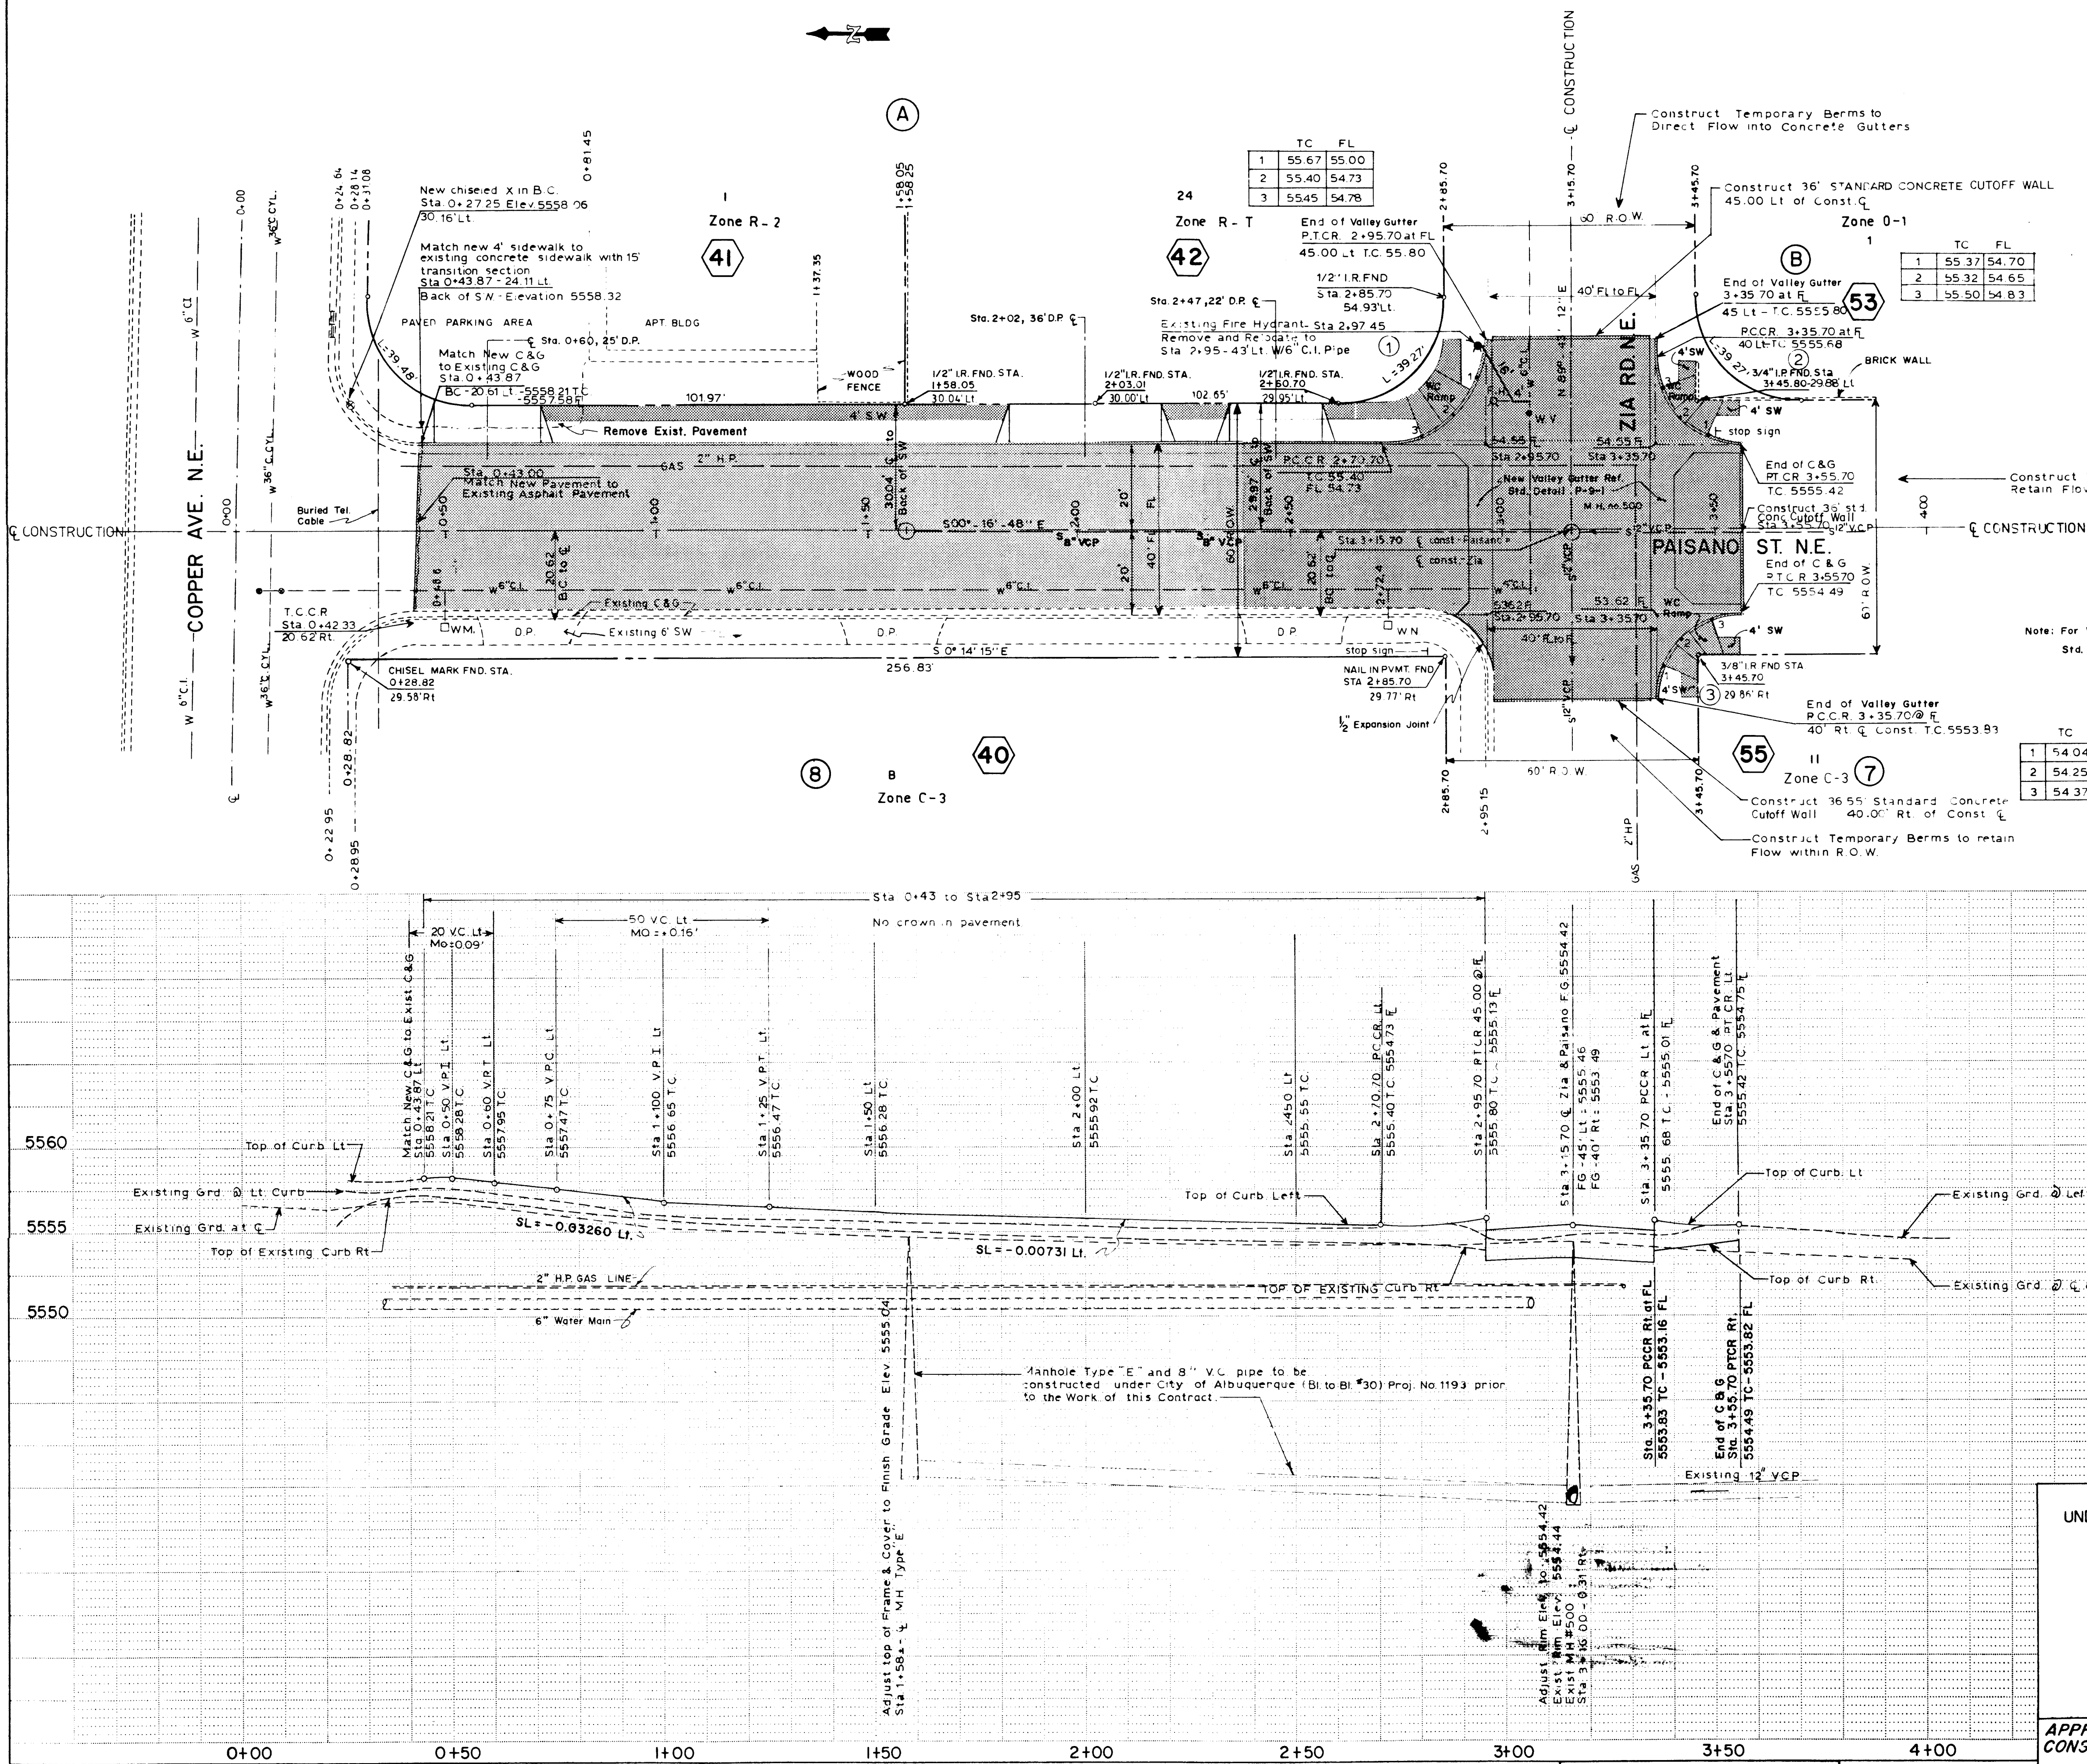

CURVE DATA	1	2	3
DELTA	90°-00'	90°-00'	90°-00'
TANGENT	25.00'	20.00'	20.00'
LENGTH	39.27'	31.42'	31.42'
RADIUS	25.00'	20.00'	20.00'

TC	FL
1	55.37
2	55.32
3	55.50

Note: For WC Ramp Details See 9 13 and
Std. Detail P-16-1

TC	FL
1	54.04
2	54.25
3	54.37

RECORD DRAWINGS

THESE RECORD DRAWINGS HAVE BEEN PREPARED, IN PART, ON THE BASIS OF INFORMATION COMPILED AND FURNISHED BY OTHERS. THE ENGINEER WILL NOT BE RESPONSIBLE FOR ANY ERRORS OR OMISSIONS WHICH HAVE BEEN INCORPORATED INTO THIS DOCUMENT AS A RESULT.
DATE: MAY 19, 1983



AS BUILT INFORMATION			BENCH MARKS			SURVEY INFORMATION			REFERENCES		
CONTRACTOR	STANDARD ACS	TABLET STAMPED '16-K-22	DATE	1974	CEMENTED IN A DRILL HOLE IN TOP OF CONCRETE CURB. ELEV. 5547.648.	NO.	BY	FIELD NOTES	MAP NO.	K-22	E/G
DATE			DATE	6-81		EST. NO.	W.O. NO.				
FIELD			DATE								
ACCEPTANCE BY			DATE								
FIELD			DATE								
INSPECTION BY			DATE								
CORRECTED BY			DATE								
MICRO-FILM			DATE								
INFORMATION			DATE								
RECORDED BY			DATE								
NO.			DATE								

OWNERSHIP OF DOCUMENTS	REVISIONS	REMARKS	NO.	DATE
THIS DOCUMENT, AND THE IDEAS AND DESIGNS INCORPORATED HEREIN, AS AN INSTRUMENT OF PROFESSIONAL SERVICE, IS THE PROPERTY OF SULLIVAN DESIGN GROUP, INC. AND IS NOT TO BE USED, IN WHOLE OR IN PART, FOR ANY OTHER PROJECT WITHOUT THE WRITTEN AUTHORIZATION OF SULLIVAN DESIGN GROUP, INC.	DESIGN			
	BY			
	DESIGNED BY	W.F. Hobbs, P.E.	DATE	Sept. 1981
	DRAWN BY	A. Odell, J.M. Kilby	DATE	Sept. 1981
	CHECKED BY	N.J. Mecklem, P.E.	DATE	Sept. 1981

PLANS PREPARED UNDER THE DIRECTION OF	LA QUESTA SUBDIVISION
APPROVED FOR CONSTRUCTION	CITY OF ALBUQUERQUE MUNICIPAL DEVELOPMENT DEPARTMENT ENGINEERING DIVISION
CITY ENGINEER	DATE
DATE	

APPROVALS	ENGINEER	DATE	APPROVALS	ENGINEER	DATE
City Engineer			Liquid Waste		
A.C.E.-Design			Traffic		
A.C.E.-Hydrology			Water		

DRAWING NO.	1360	SHEET 8 OF 13
-------------	------	---------------

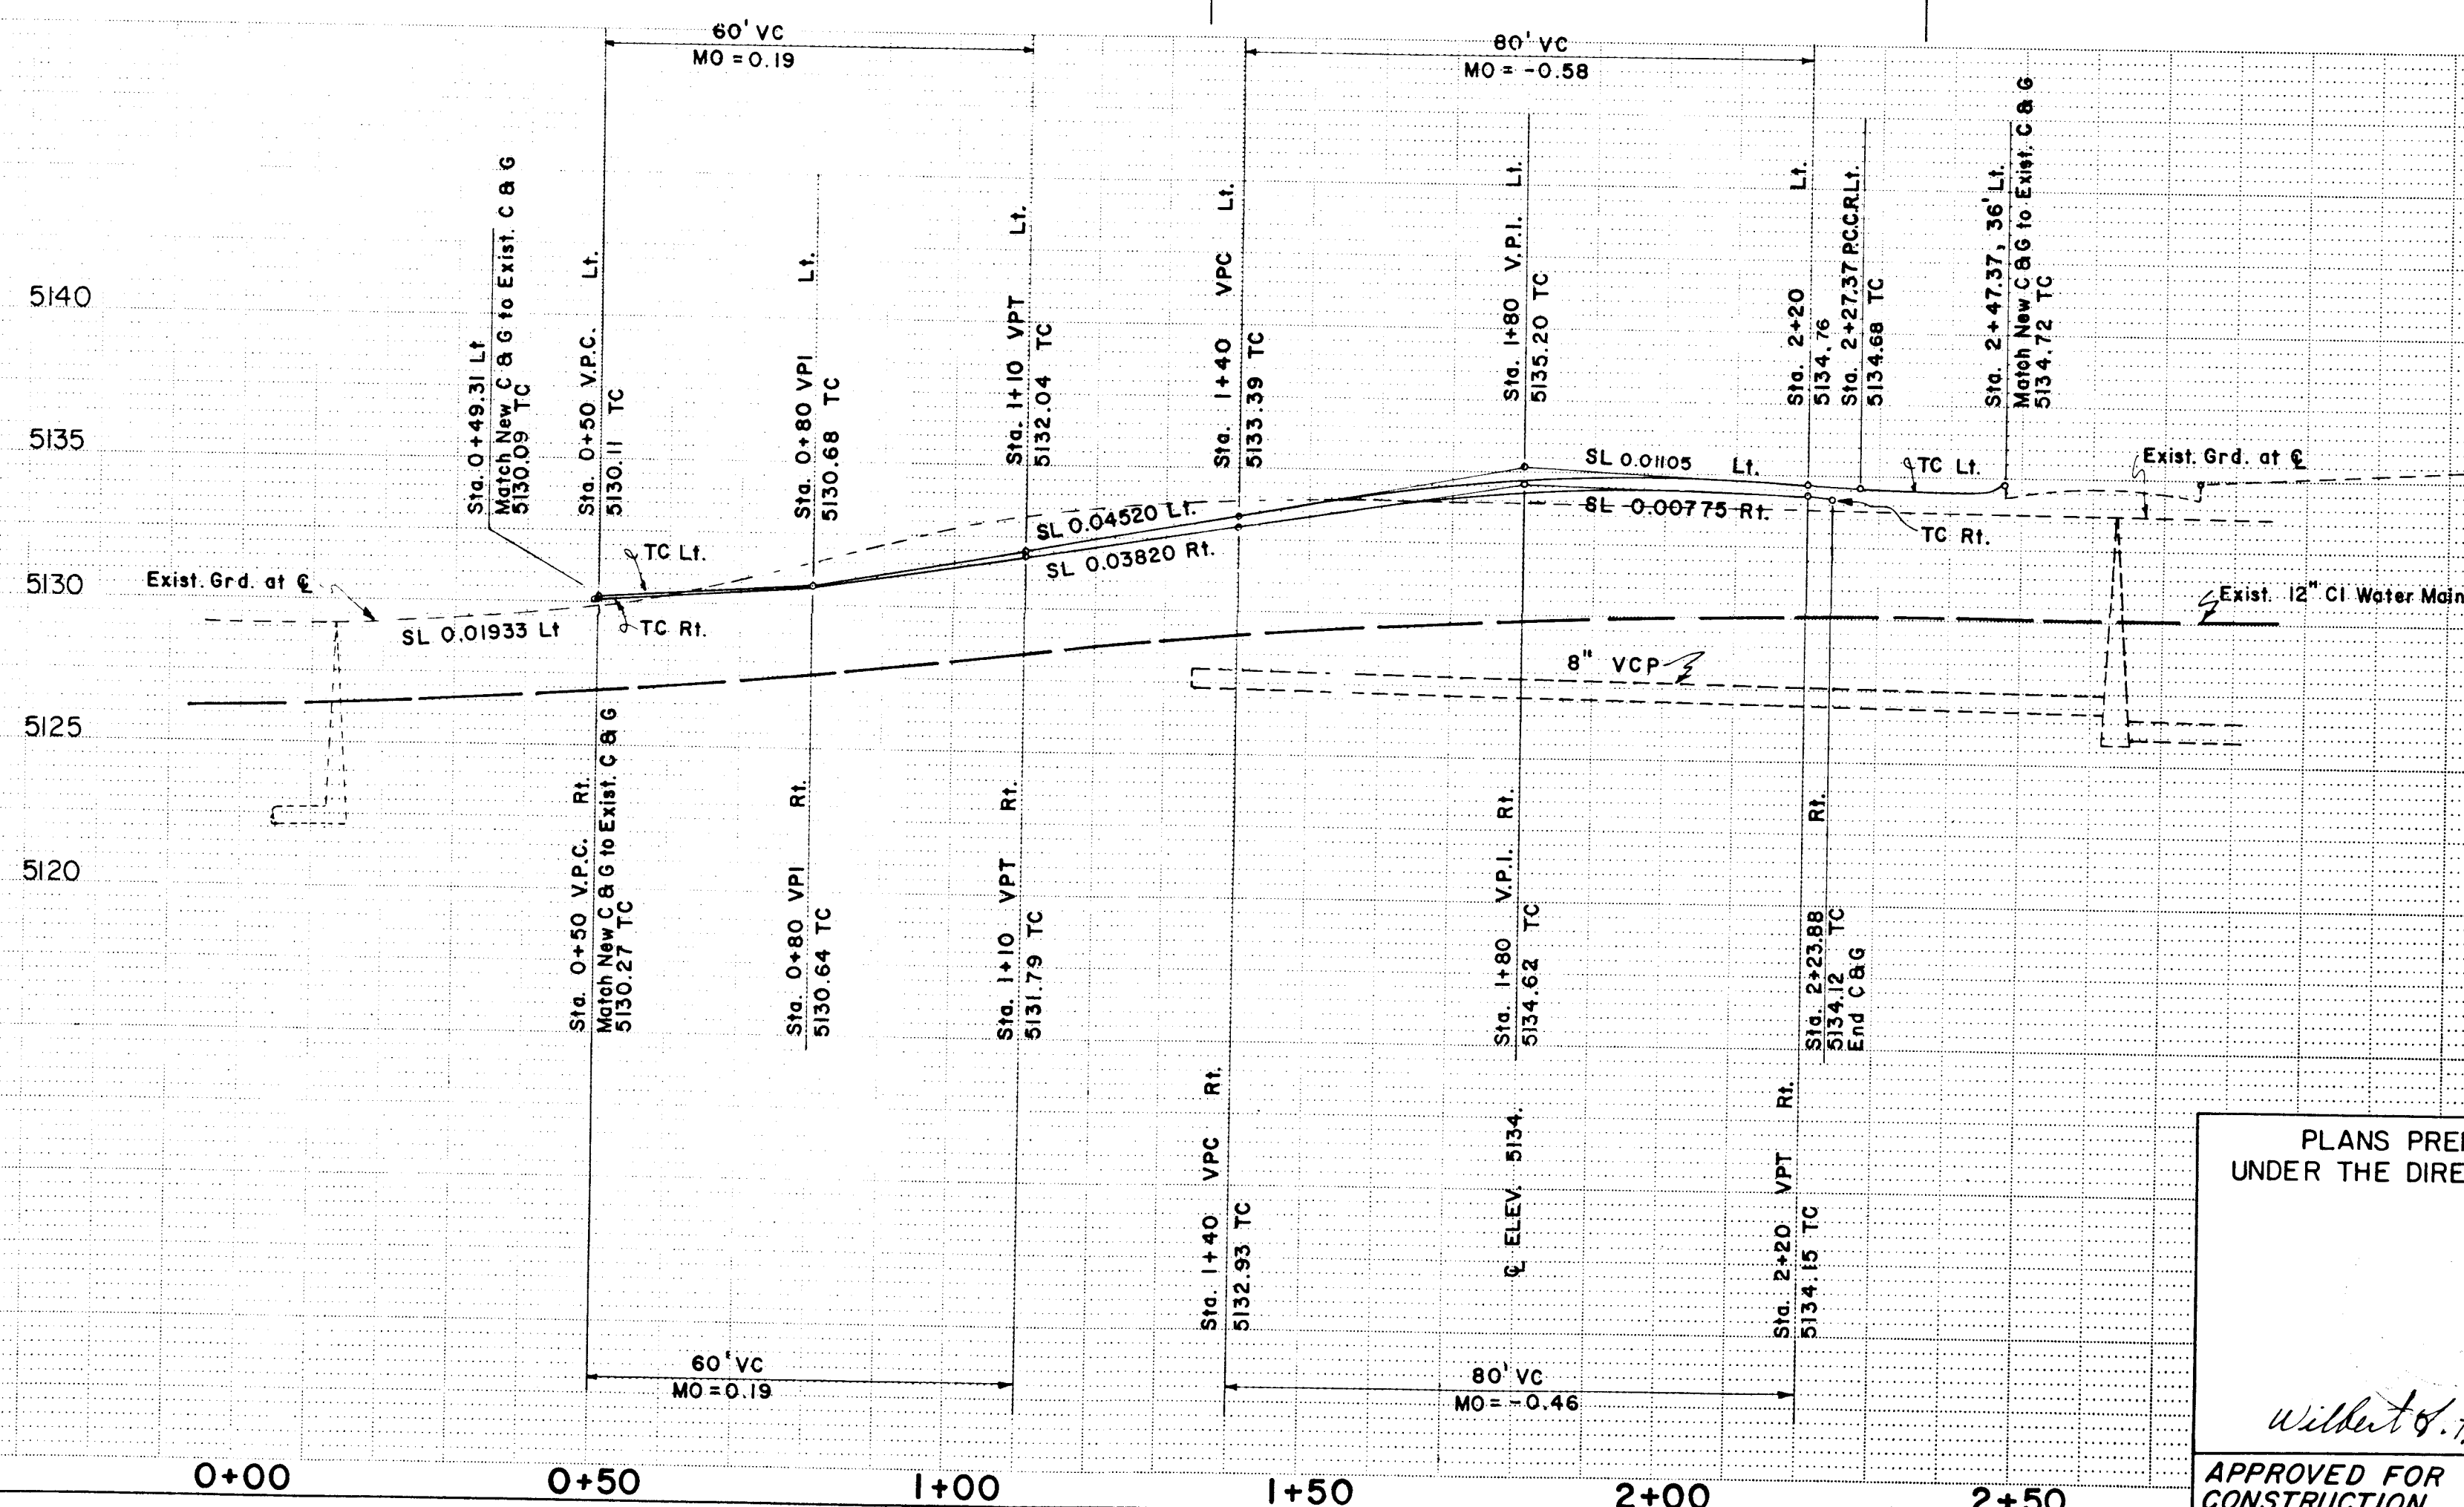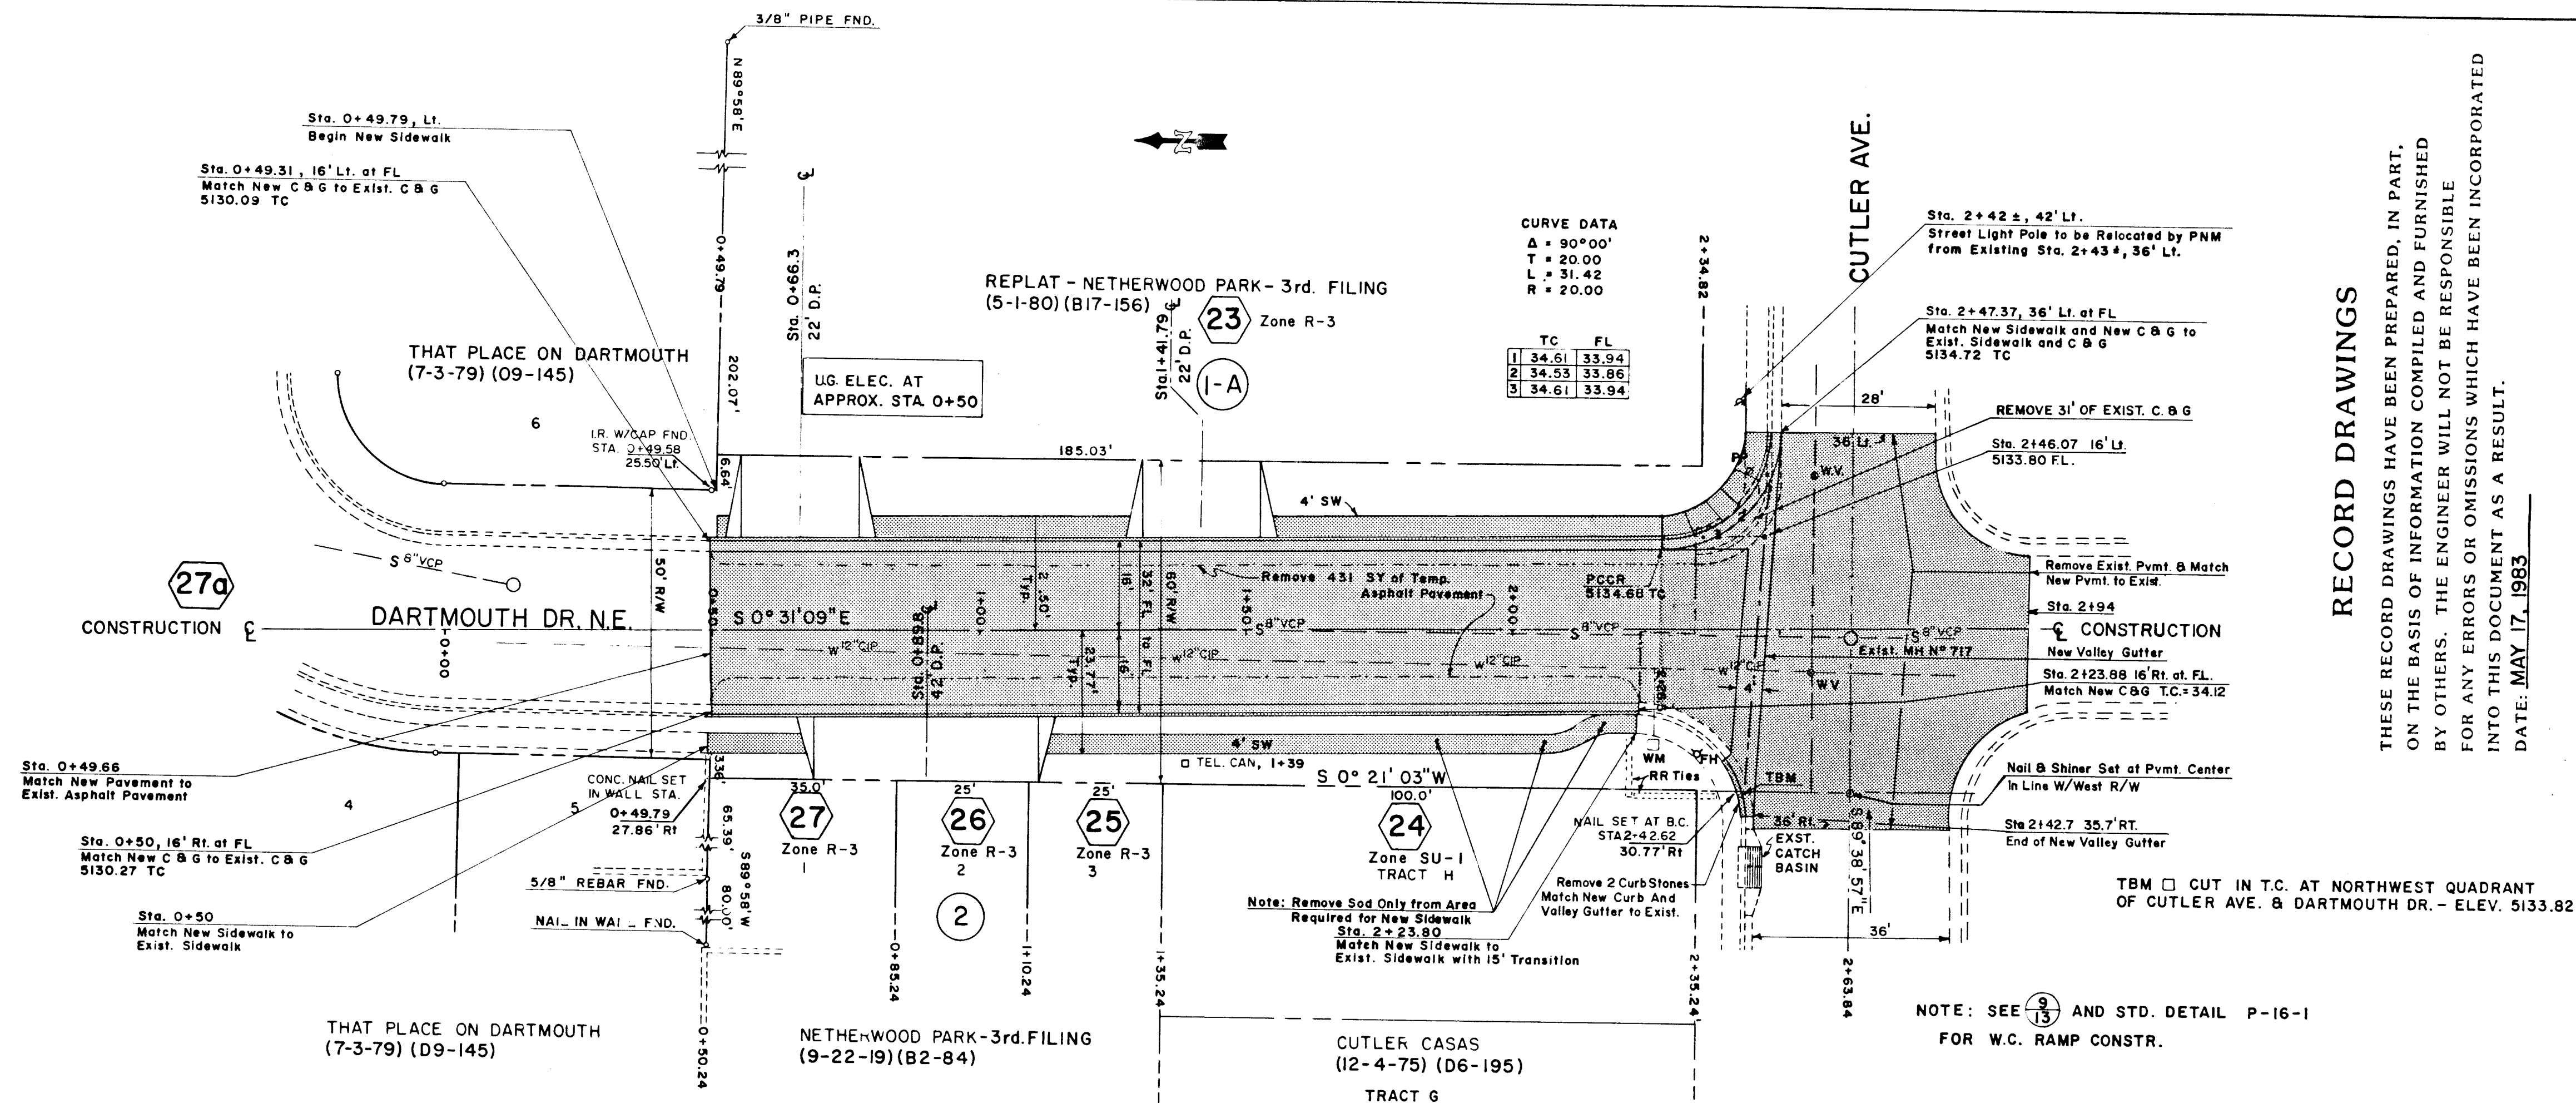

OWNERSHIP OF DOCUMENTS

This document, and the ideas and designs incorporated herein, as an instrument of professional service, is the property of SULLIVAN DESIGN GROUP, INC. and is not to be used, in whole or in part, for any other project without the written authorization of SULLIVAN DESIGN GROUP, INC.


PLANS PREPARED UNDER THE DIRECTION OF		CITY OF ALBUQUERQUE MUNICIPAL DEVELOPMENT DEPARTMENT ENGINEERING DIVISION	
APPROVED FOR CONSTRUCTION		TITLE: SPECIAL ASSESSMENT DISTRICT N°200 DARTMOUTH DRIVE, NE -PAVING-	
CITY ENGINEER	ENGINEER	DATE	APPROVALS
A.C.E.-Design	ENGINEER	DATE	LIQUID WASTE
A.C.E.-Hydrology	ENGINEER	DATE	TRAFFIC
	ENGINEER	DATE	WATER
DRAWING NO. 1360		SHEET 5 OF 13	

SURVEY INFORMATION		BENCH MARKS		AS BUILT INFORMATION	
FIELD NOTES	DATE	SQUARE	CUT	CHISELED AT NORTHWEST QUADRANT OF INTERSECTION OF INDIAN SCHOOL ROAD AND GIRARD AVENUE - LABELED WITH PAINTED "4-H16" - ELEVATION 5117.14	CONTRACTOR
NO.	DATE	NO.	DATE	NO.	CONTRACTOR
WFH - JK	6-81				
REFERENCES		REVISIONS		MICRO-FILM INFORMATION	
MAP NO.	EST. NO.	WFO. NO.	DATE	NO.	DATE
E-11					
REVISIONS		REVISIONS		REVISIONS	
NO.	DATE	NO.	DATE	NO.	DATE
1	5/24/82	1	5/24/82	1	5/24/82
2	5/17/83	2	5/17/83	2	5/17/83
ADDITION OF VALLEY GUTTER		RECORD DWG. NOTES ADDED		DESIGNED BY W.F. Hobbs, P.E.	
				DRAWN BY E. J. Gonzalez, J.M. Kilby	
				CHECKED BY N.J. Mecklem, P.E.	
				DATE Sept. 1981	
				DATE Sept. 1981	

COLLEGE HEIGHTS - UNIT I (12-2-65) (D3-129)
BLOCK B

NOTES:


1. ALL LOTS ZONED R-1 UNLESS OTHERWISE SHOWN.
2. ALL SANITARY SEWER SERVICE LINES SHALL BE 4" D.I., A MIN. OF 4FT. FROM INVERT TO TOP OF CURB AT R/W(P/L) LINE AND AT A MIN. SLOPE OF 2%.
3. FOR ALL PAVEMENT CUTS SEE DETAIL.
4. USE EMD AT END OF LINE.

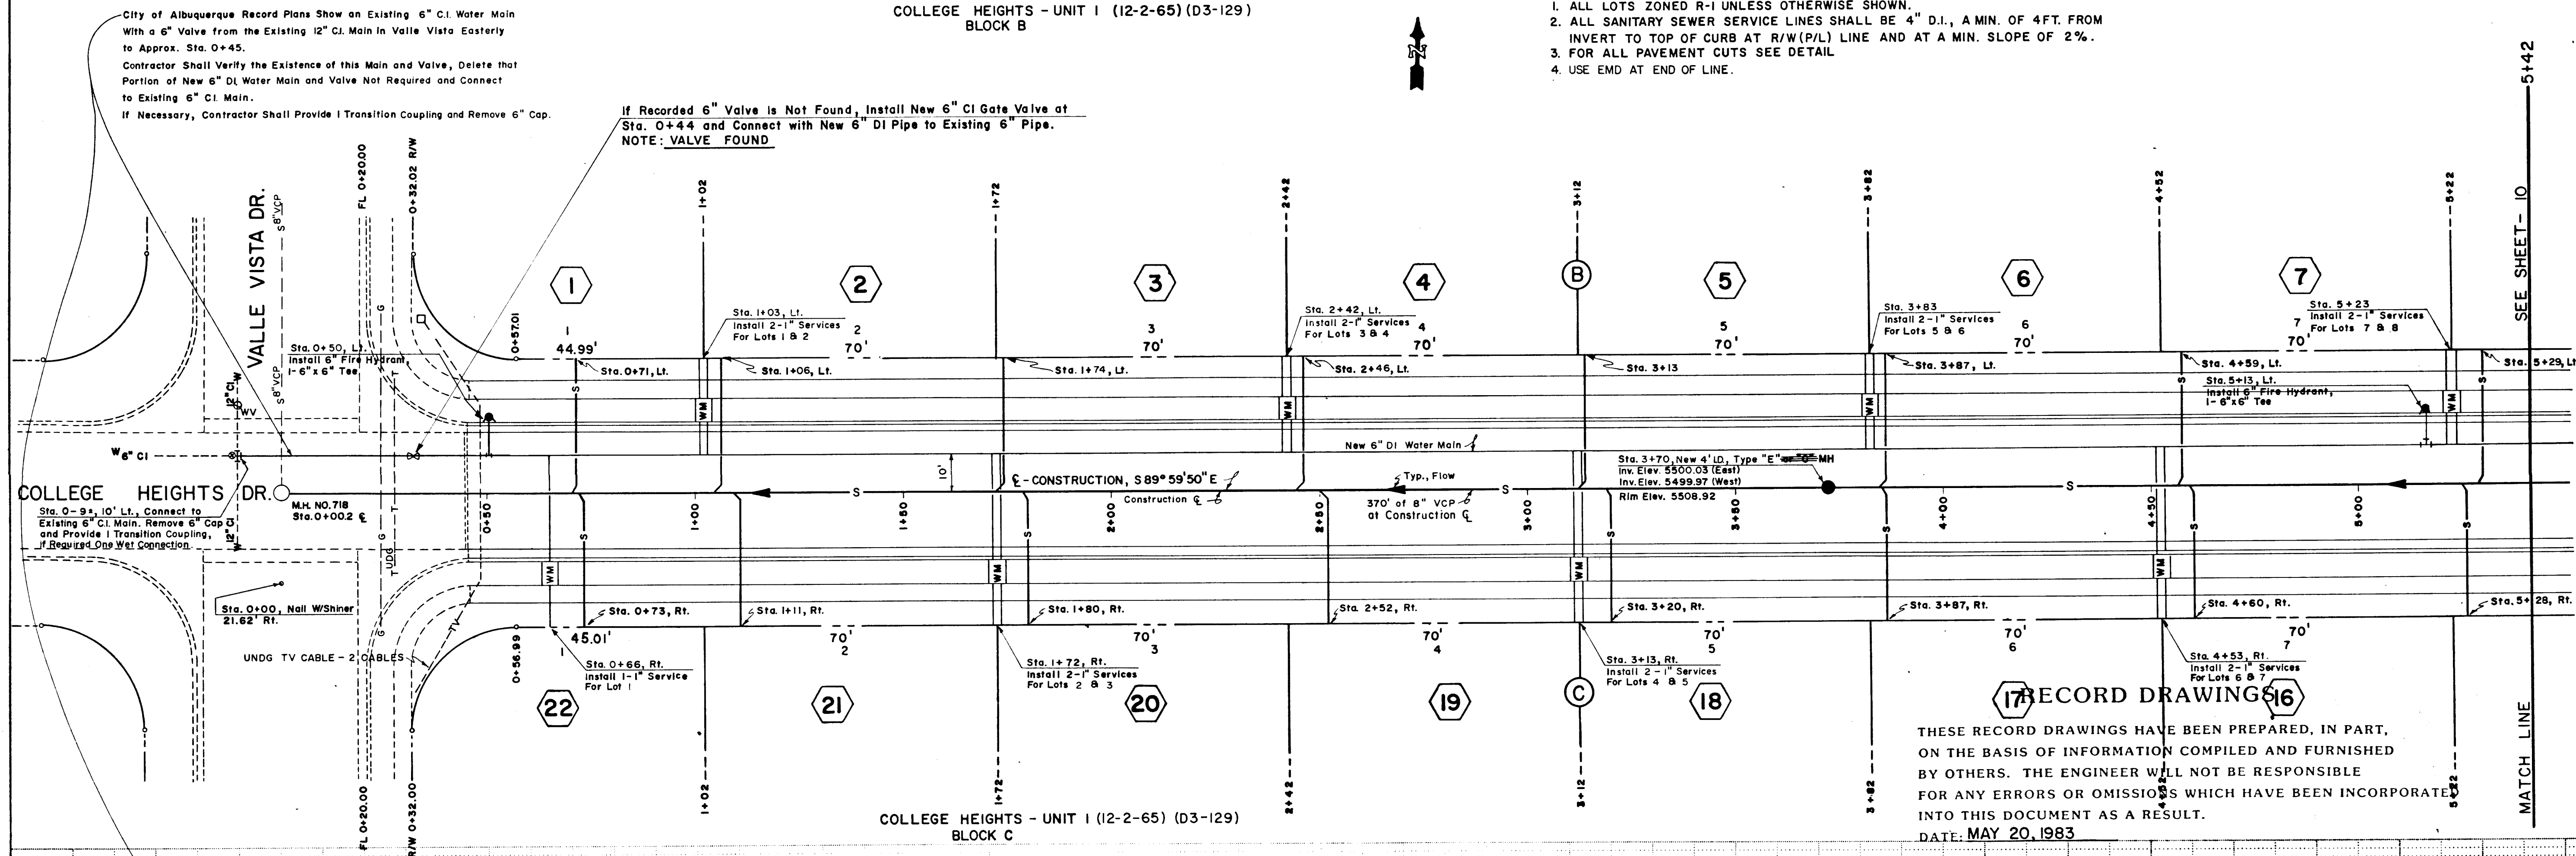

RECORD DRAWINGS

THESE RECORD DRAWINGS HAVE BEEN PREPARED, IN PART, ON THE BASIS OF INFORMATION COMPILED AND FURNISHED BY OTHERS. THE ENGINEER WILL NOT BE RESPONSIBLE FOR ANY ERRORS OR OMISSIONS WHICH HAVE BEEN INCORPORATED INTO THIS DOCUMENT AS A RESULT.

DATE: MAY 20, 1983

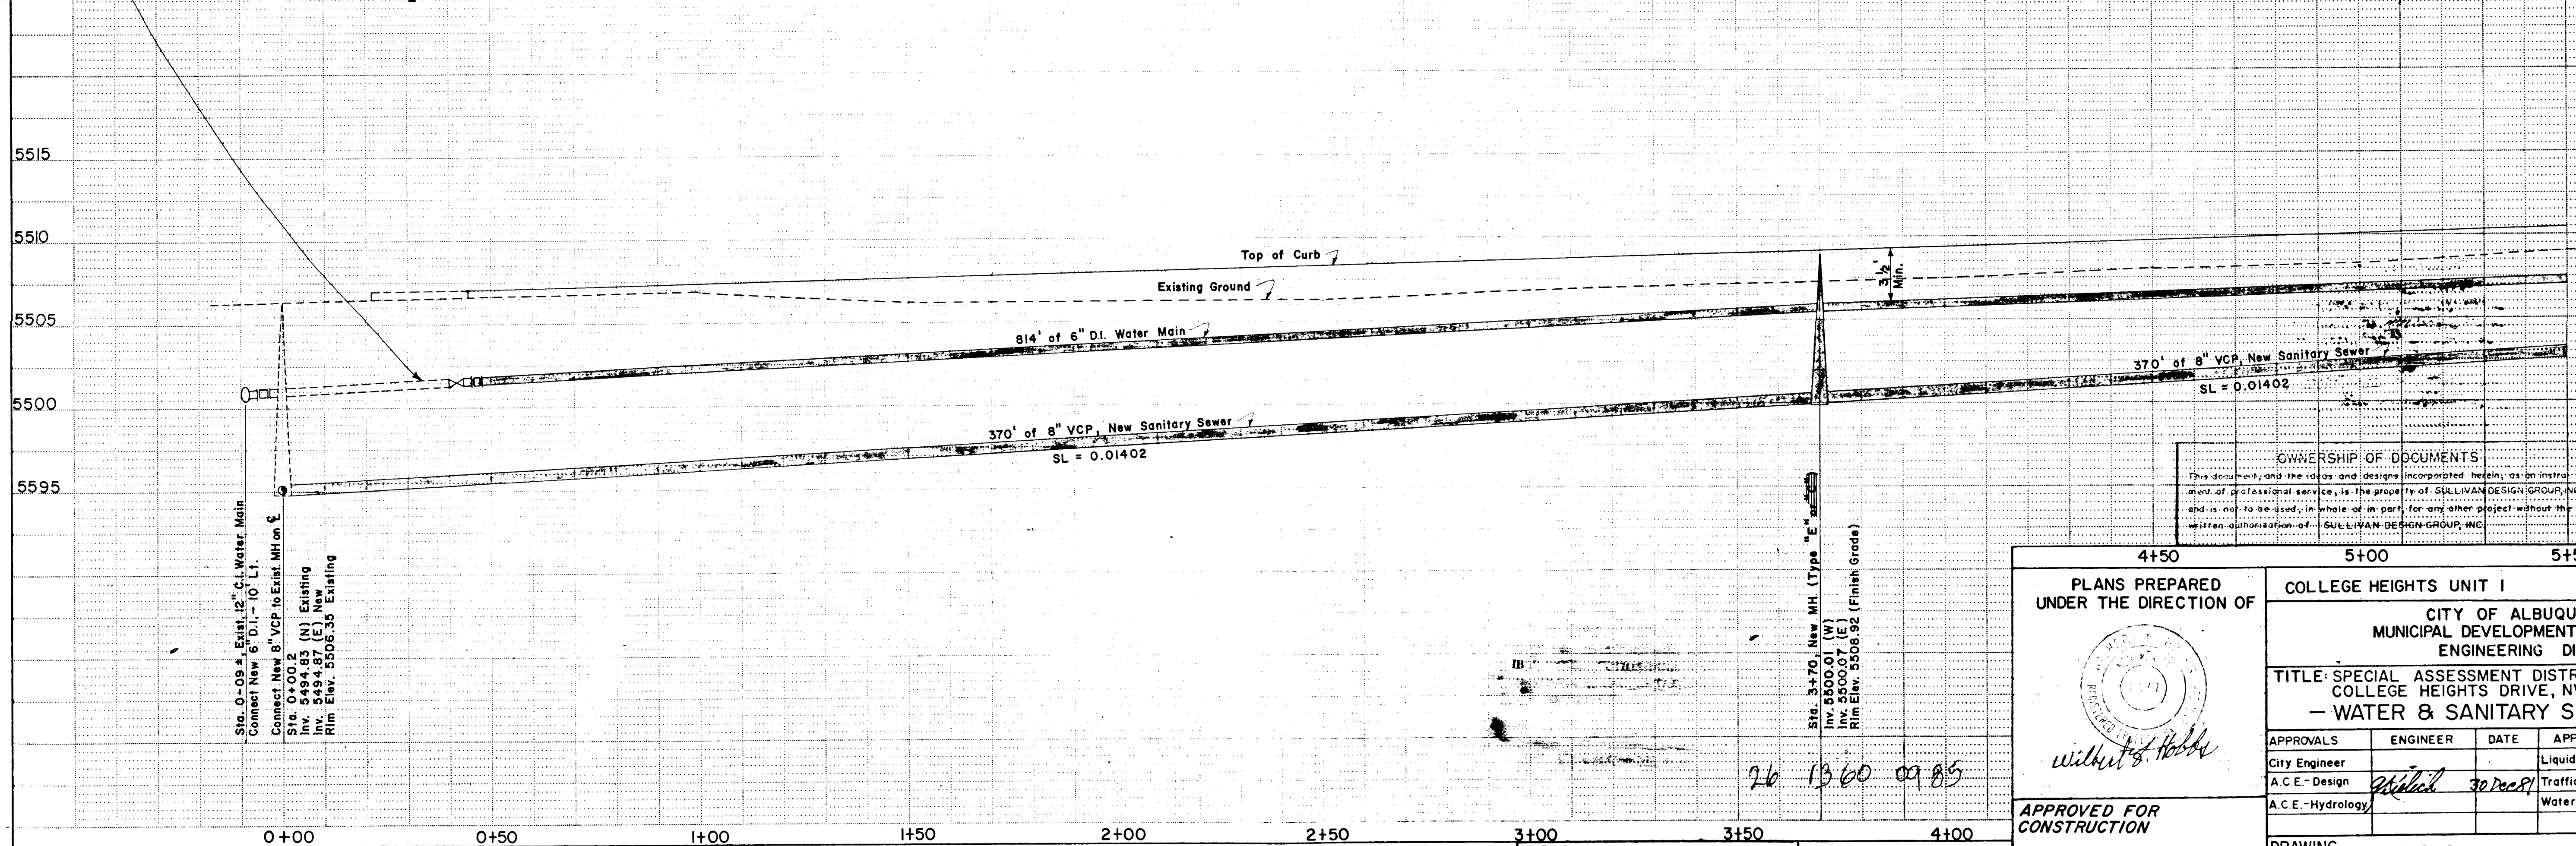

PLANS PREPARED UNDER THE DIRECTION OF			COLLEGE HEIGHTS UNIT I		
			CITY OF ALBUQUERQUE MUNICIPAL DEVELOPMENT DEPARTMENT ENGINEERING DIVISION		
			TITLE: SPECIAL ASSESSMENT DISTRICT N° 200 COLLEGE HEIGHTS DRIVE, NW - WATER & SANITARY SEWER -		
APPROVALS	ENGINEER	DATE	APPROVALS	ENGINEER	DATE
CITY Engineer			Liquid Waste	<i>W. F. Hobbs</i>	12/9/81
A.C.E. - Design	<i>Michael</i>	30 Dec 81	Traffic	<i>M. A. Hobbs</i>	
A.C.E. - Hydrology			Water	<i>W. F. Hobbs</i>	12/9/81
DRAWING NO. 1360			SHEET 9 OF 13		
CITY ENGINEER DATE			DESIGNED BY W. F. Hobbs, DATE Sept. 1981 DRAWN BY E. J. Gonzales, J. M. Kilby, DATE Sept. 1981 CHECKED BY N. J. Mecklem, DATE Sept. 1981		

SURVEY INFORMATION			BENCH MARKS		AS BUILT INFORMATION		
NO.	FIELD NOTES		STANDARD CITY OF ALBUQUERQUE BRASS TABLET STAMPED 1-E-11 1969.	CONTRACTOR	WORK	DATE	
	BY	DATE					
N/A	WFH - JMK	6-81	ELEV. 5113.93 - SET IN TOP OF CONCRETE POST JUST EAST OF EAST CURB AND FLUSH WITH TOP OF CURB.	INSPECTORS	ACCEPTANCE BY	DATE	
			LOCATED ON EAST SIDE OF CANADA VISTA PL., NW, 300 FEET SOUTH OF ALBERTA LN., NW.	VERIFICATION BY	DATE	DATE	
				CORRECTED BY	DATE	DATE	
				MICRO-FILM INFORMATION			
				RECORDED BY	DATE	DATE	
				NO.			


- NOTES:
 1. ALL LOTS ZONED R-1 UNLESS OTHERWISE SHOWN.
 2. ALL SANITARY SEWER SERVICE LINES SHALL BE 4" D.I., A MIN. 4 FT. FROM INVERT TO TOP OF CURB AT R/W (P/L) AND AT A MIN. SLOPE OF 2%.
 3. USE EMD AT END OF LINE.

COLLEGE HEIGHTS UNIT I (12-2-65) (D3-129)
 BLOCK B

SAGECREST (3-4-77) (D7-134)

RECORD DRAWINGS

THESE RECORD DRAWINGS HAVE BEEN PREPARED, IN PART, ON THE BASIS OF INFORMATION COMPILED AND FURNISHED BY OTHERS. THE ENGINEER WILL NOT BE RESPONSIBLE FOR ANY ERRORS OR OMISSIONS WHICH HAVE BEEN INCORPORATED INTO THIS DOCUMENT AS A RESULT.
 DATE: MAY 20, 1983

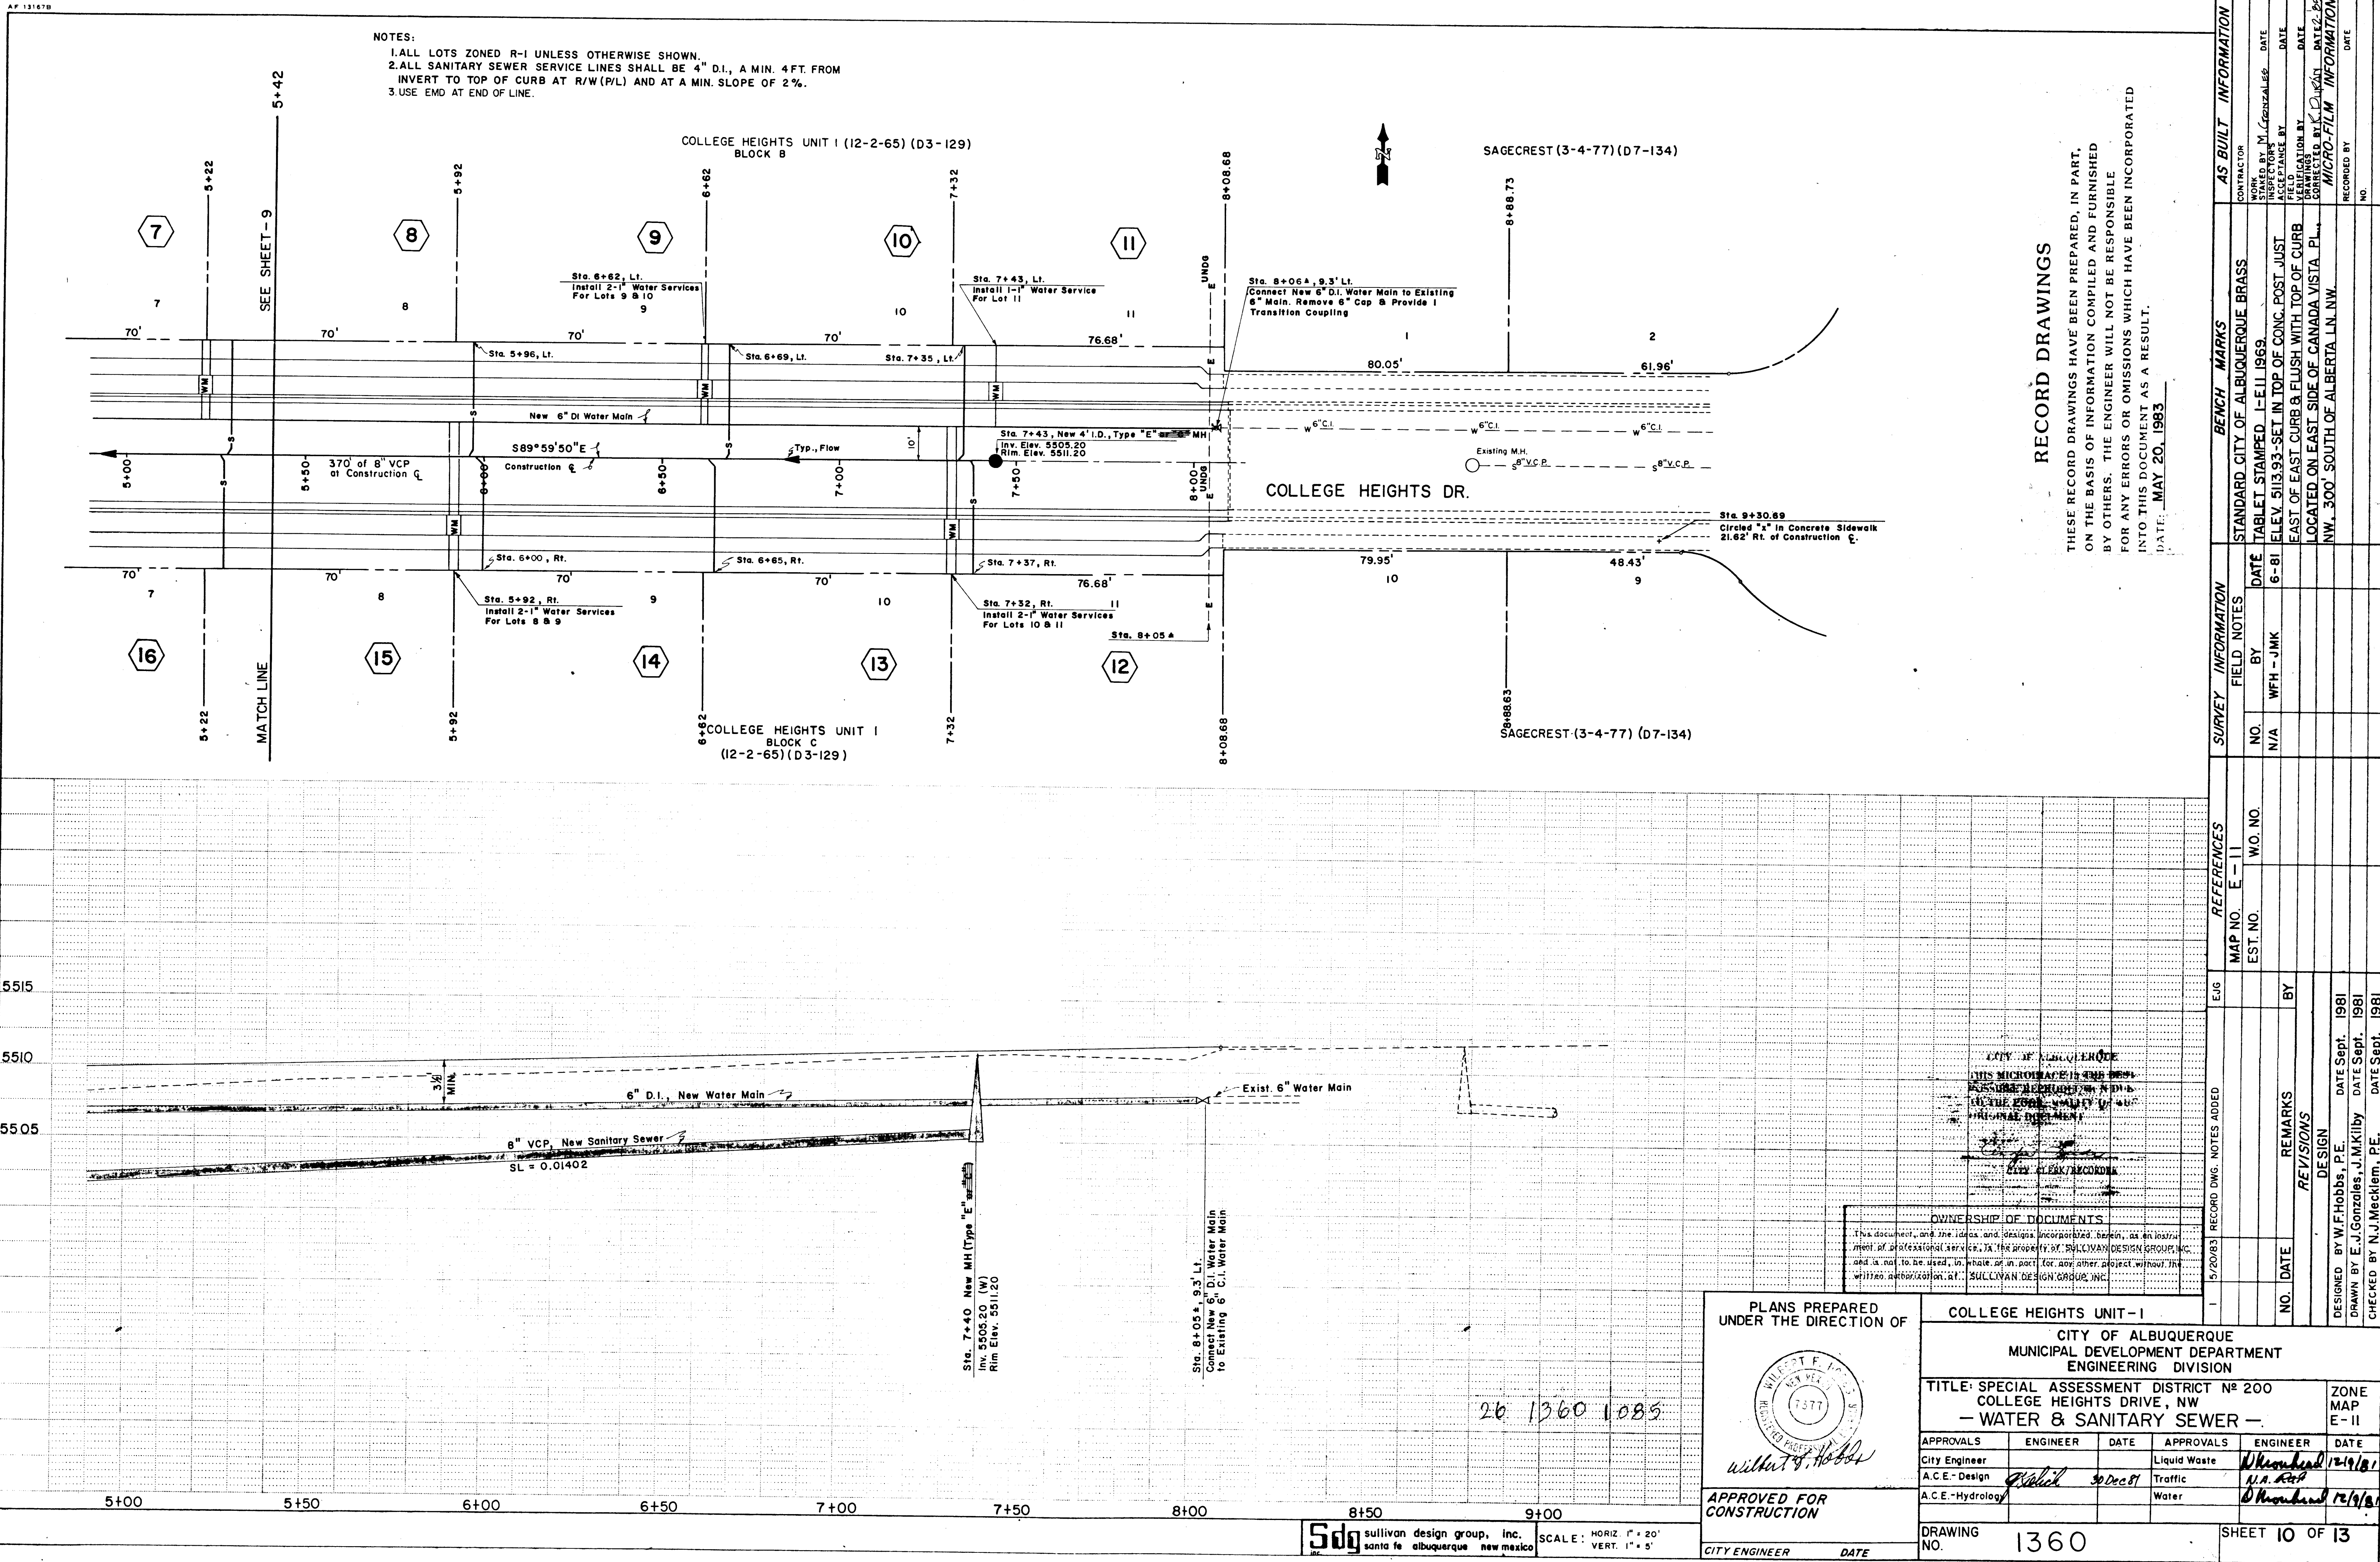

SURVEY INFORMATION			BENCH MARKS			AS BUILT INFORMATION		
NO.	DATE	BY	NO.	DATE	BY	NO.	DATE	BY
1	6-81	WFM - JMK	1	6-81	WFM - JMK	1	6-81	WFM - JMK
2			2			2		
3			3			3		
4			4			4		
5			5			5		
6			6			6		
7			7			7		
8			8			8		
9			9			9		
10			10			10		
11			11			11		
12			12			12		
13			13			13		
14			14			14		
15			15			15		
16			16			16		

PLANS PREPARED UNDER THE DIRECTION OF




APPROVED FOR CONSTRUCTION












CITY ENGINEER DATE

COLLEGE HEIGHTS UNIT-I
 CITY OF ALBUQUERQUE
 MUNICIPAL DEVELOPMENT DEPARTMENT
 ENGINEERING DIVISION

TITLES			ZONES		
NO.	DATE	REVISIONS	NO.	DATE	REVISIONS
1	12/1/81	1	1	12/1/81	1
2	12/1/81	2	2	12/1/81	2
3	12/1/81	3	3	12/1/81	3
4	12/1/81	4	4	12/1/81	4
5	12/1/81	5	5	12/1/81	5
6	12/1/81	6	6	12/1/81	6
7	12/1/81	7	7	12/1/81	7
8	12/1/81	8	8	12/1/81	8
9	12/1/81	9	9	12/1/81	9
10	12/1/81	10	10	12/1/81	10
11	12/1/81	11	11	12/1/81	11
12	12/1/81	12	12	12/1/81	12
13	12/1/81	13	13	12/1/81	13
14	12/1/81	14	14	12/1/81	14
15	12/1/81	15	15	12/1/81	15
16	12/1/81	16	16	12/1/81	16

DRAWING NO. 1360 SHEET 10 OF 13

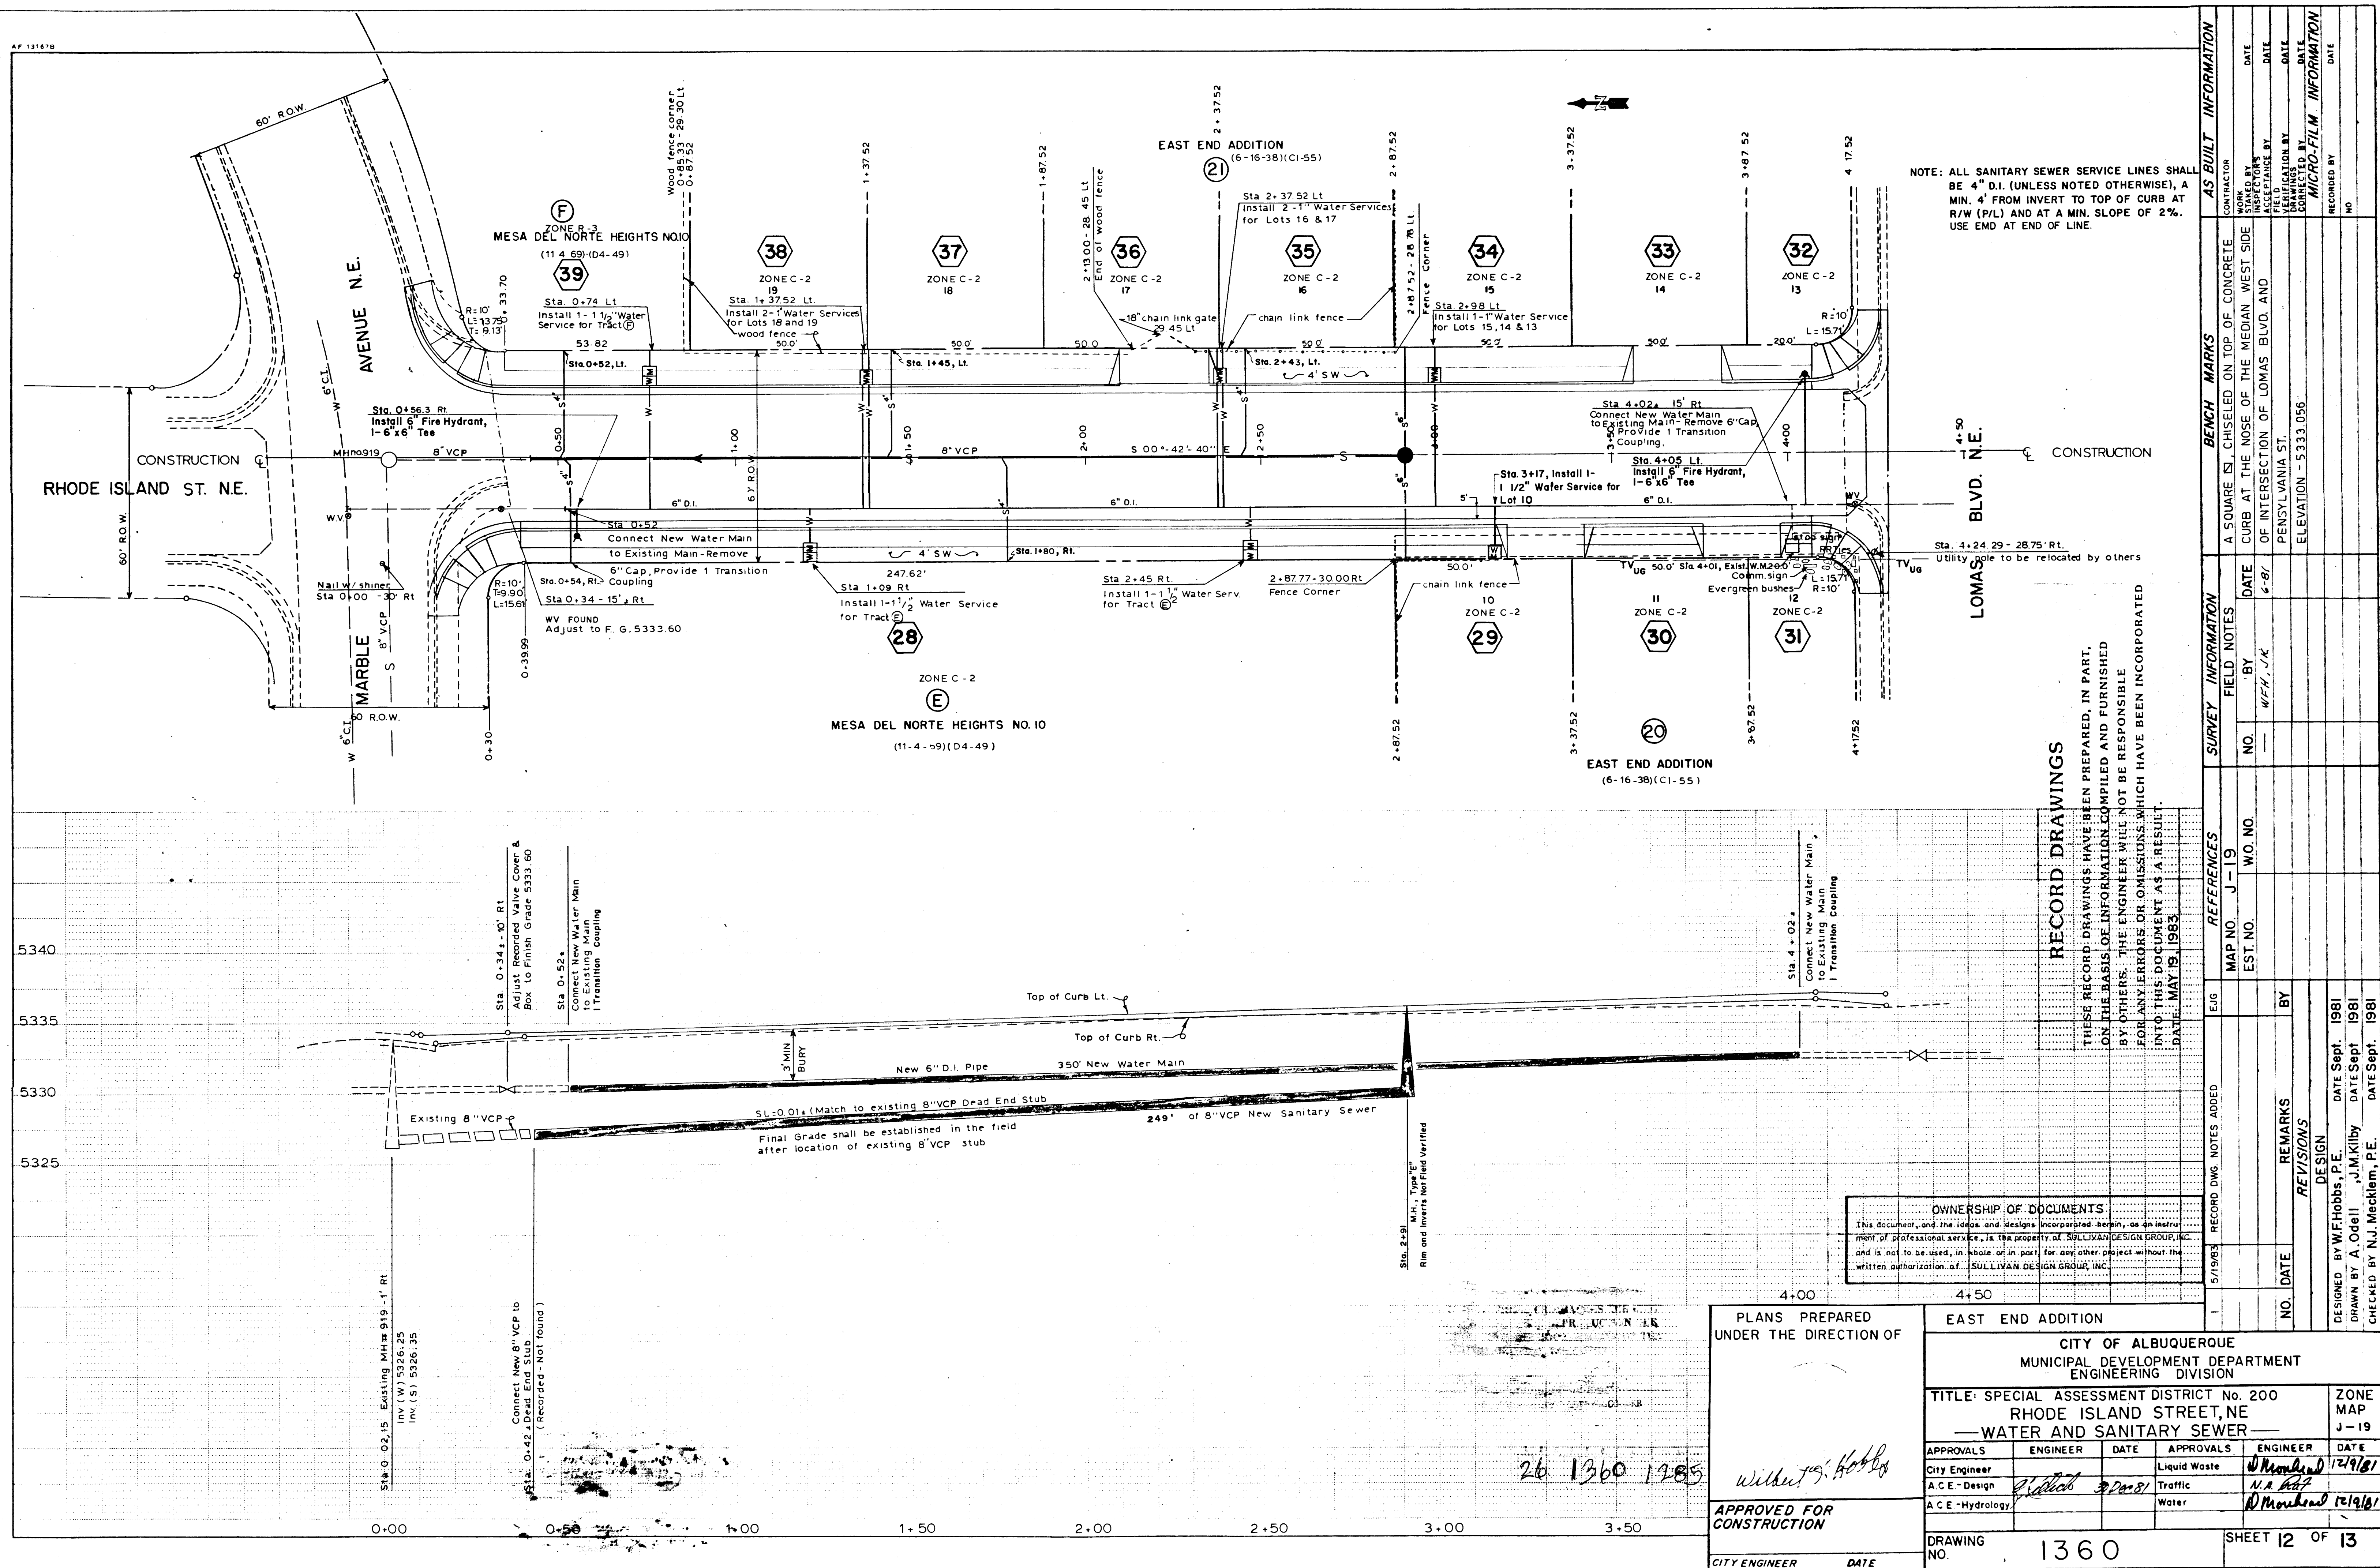

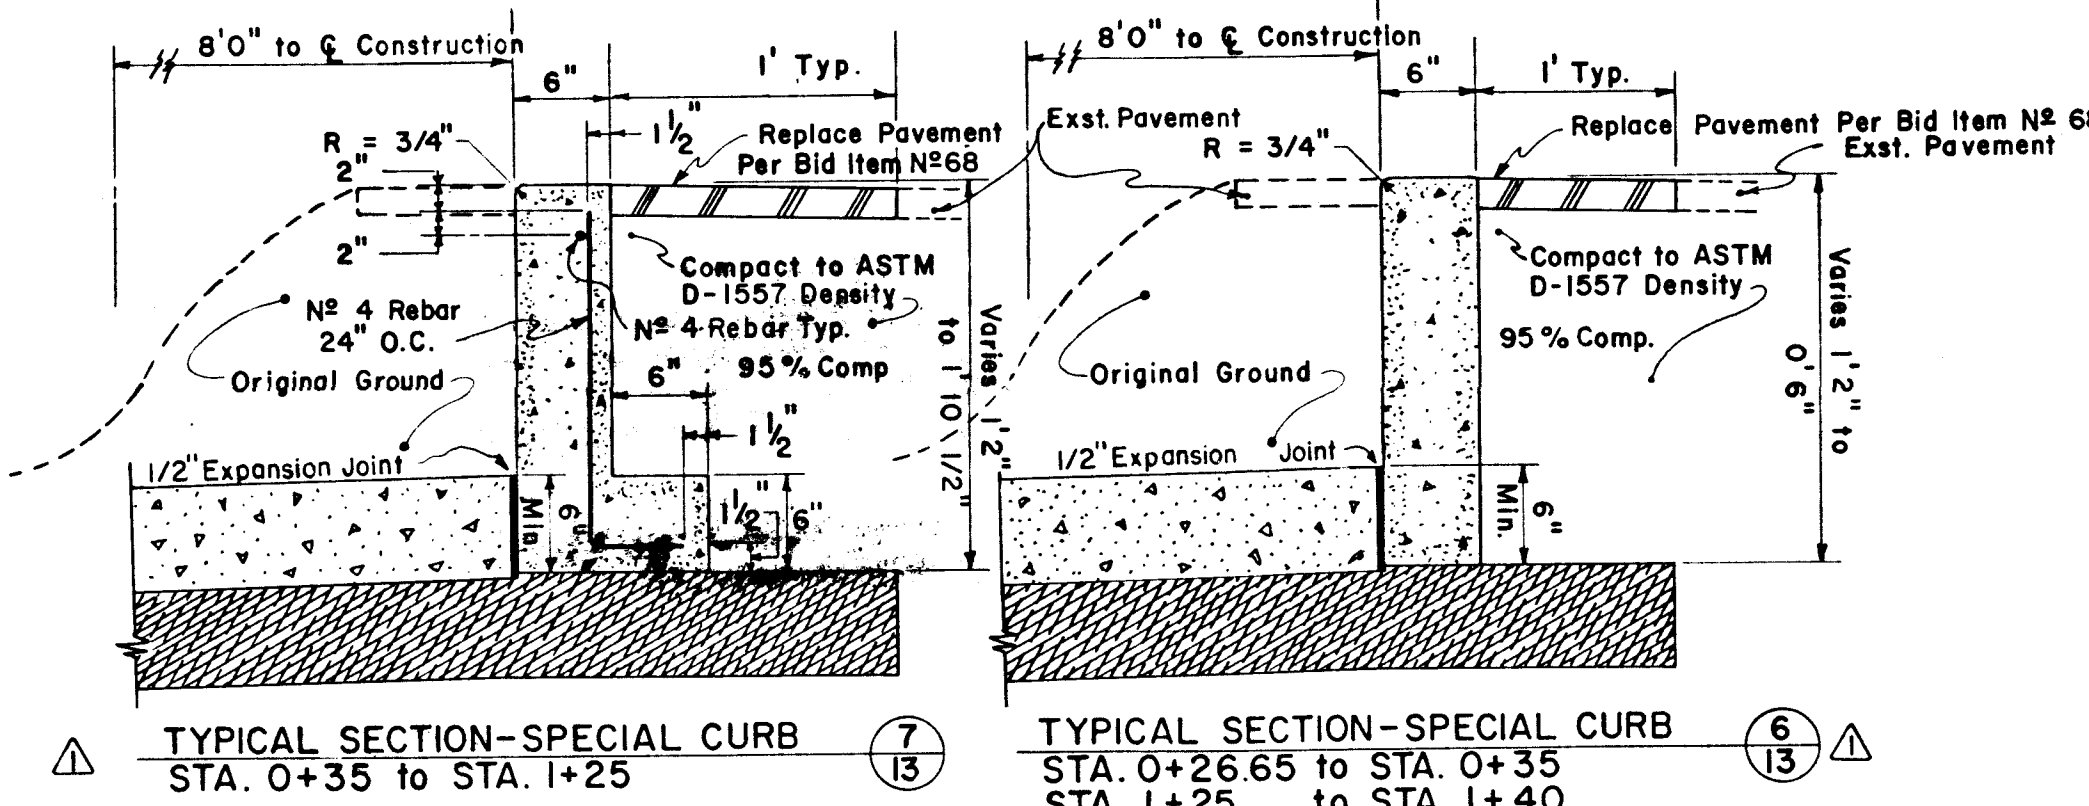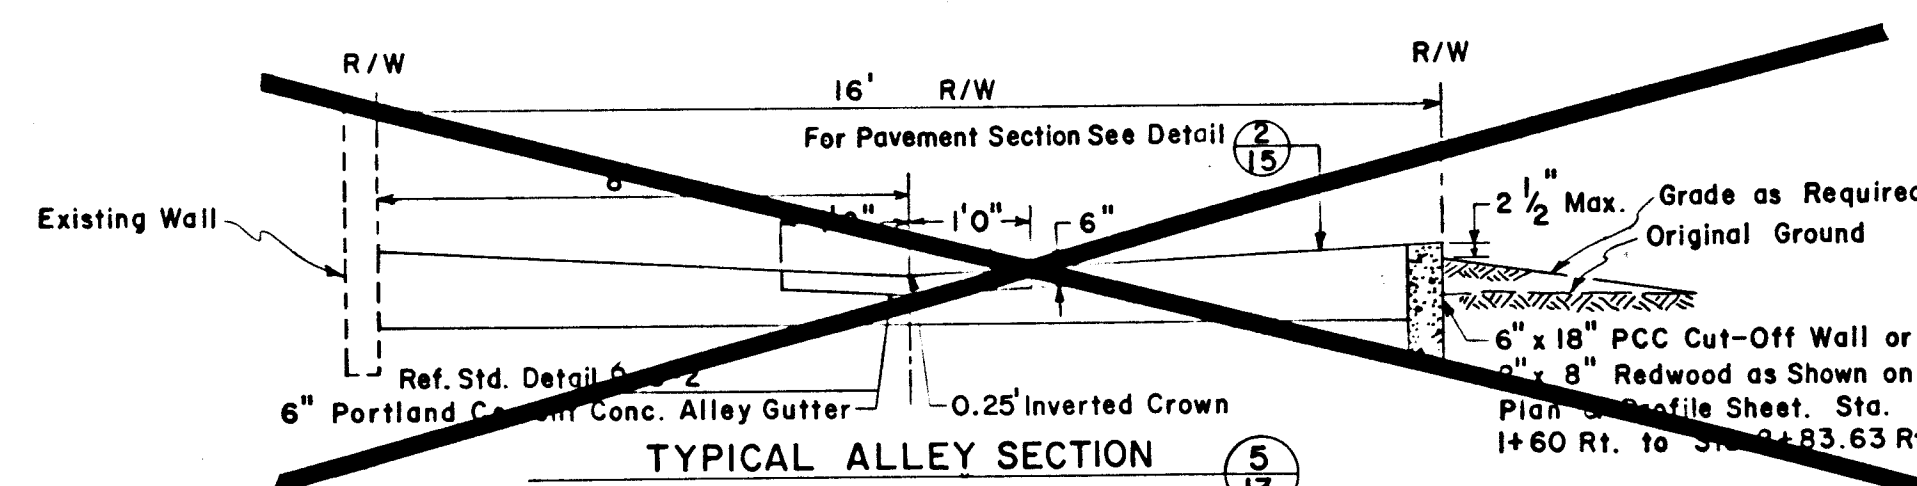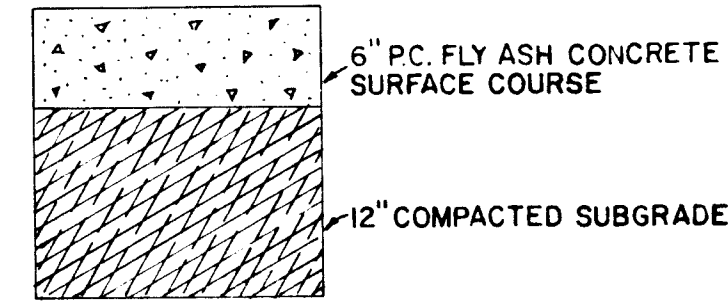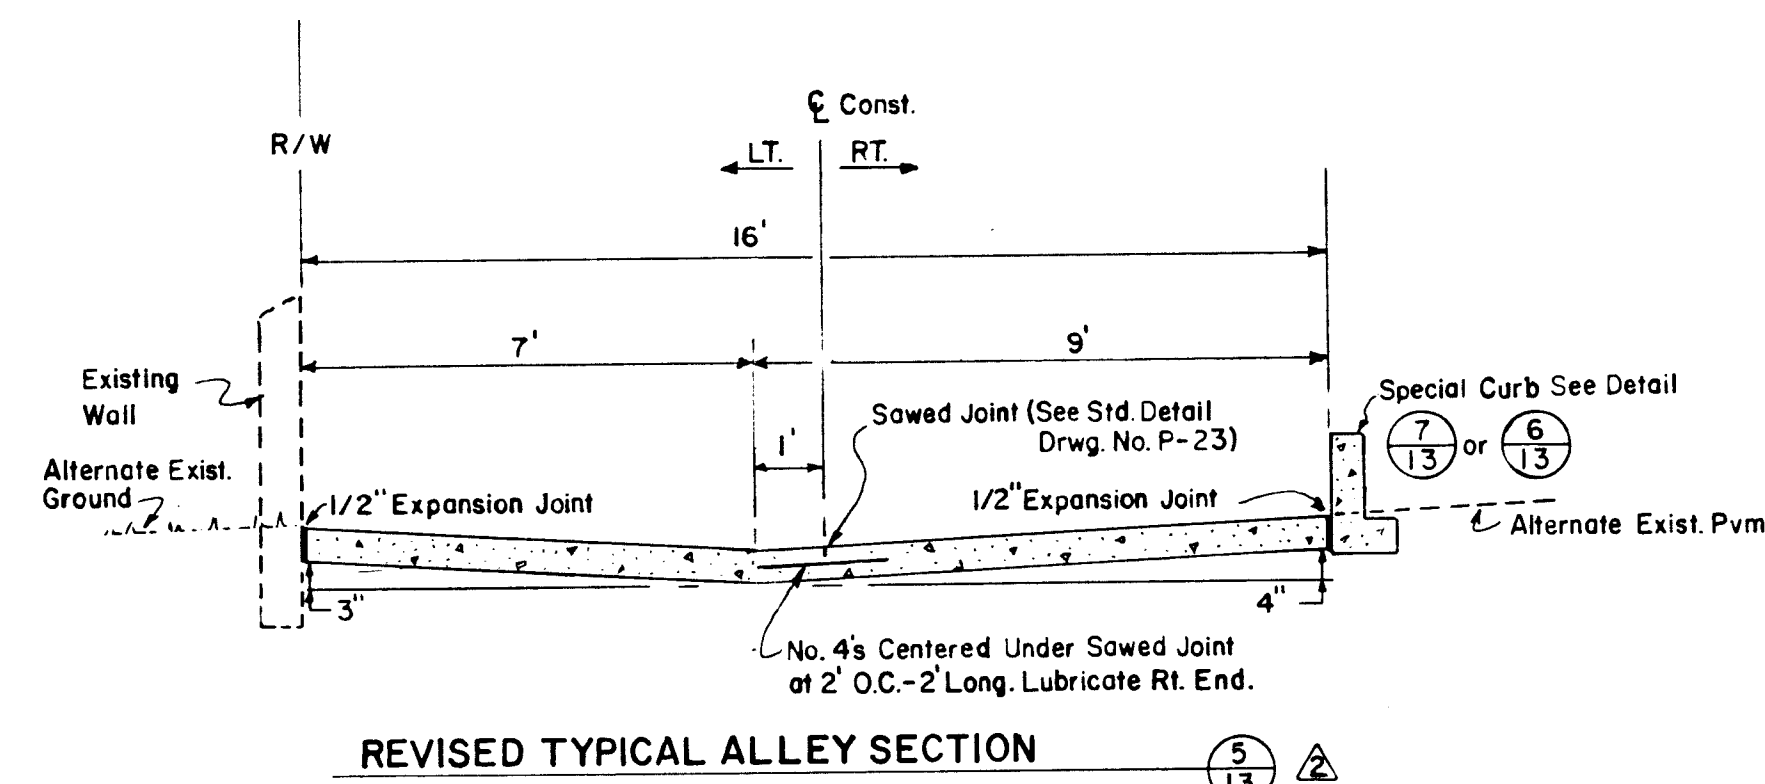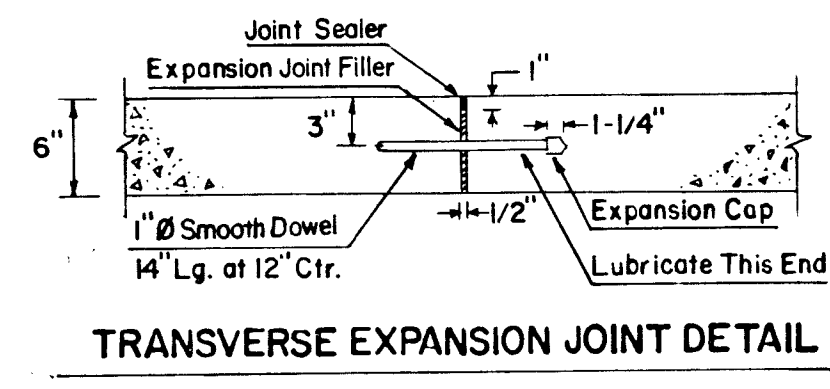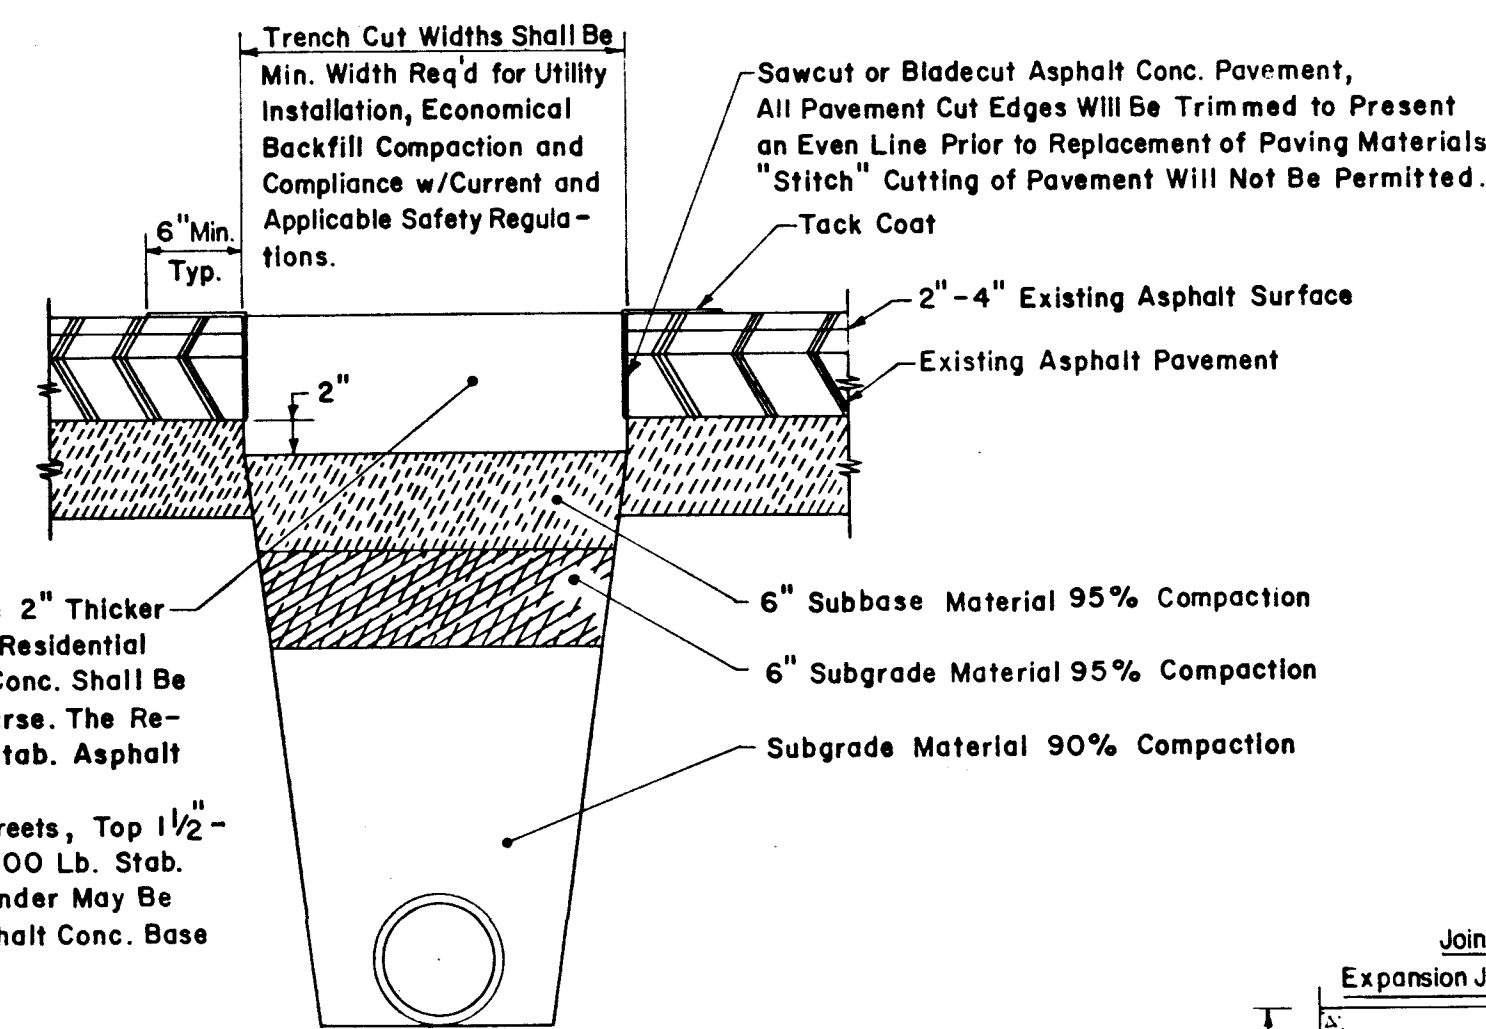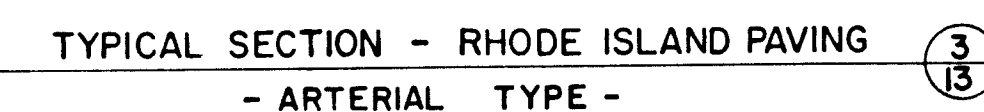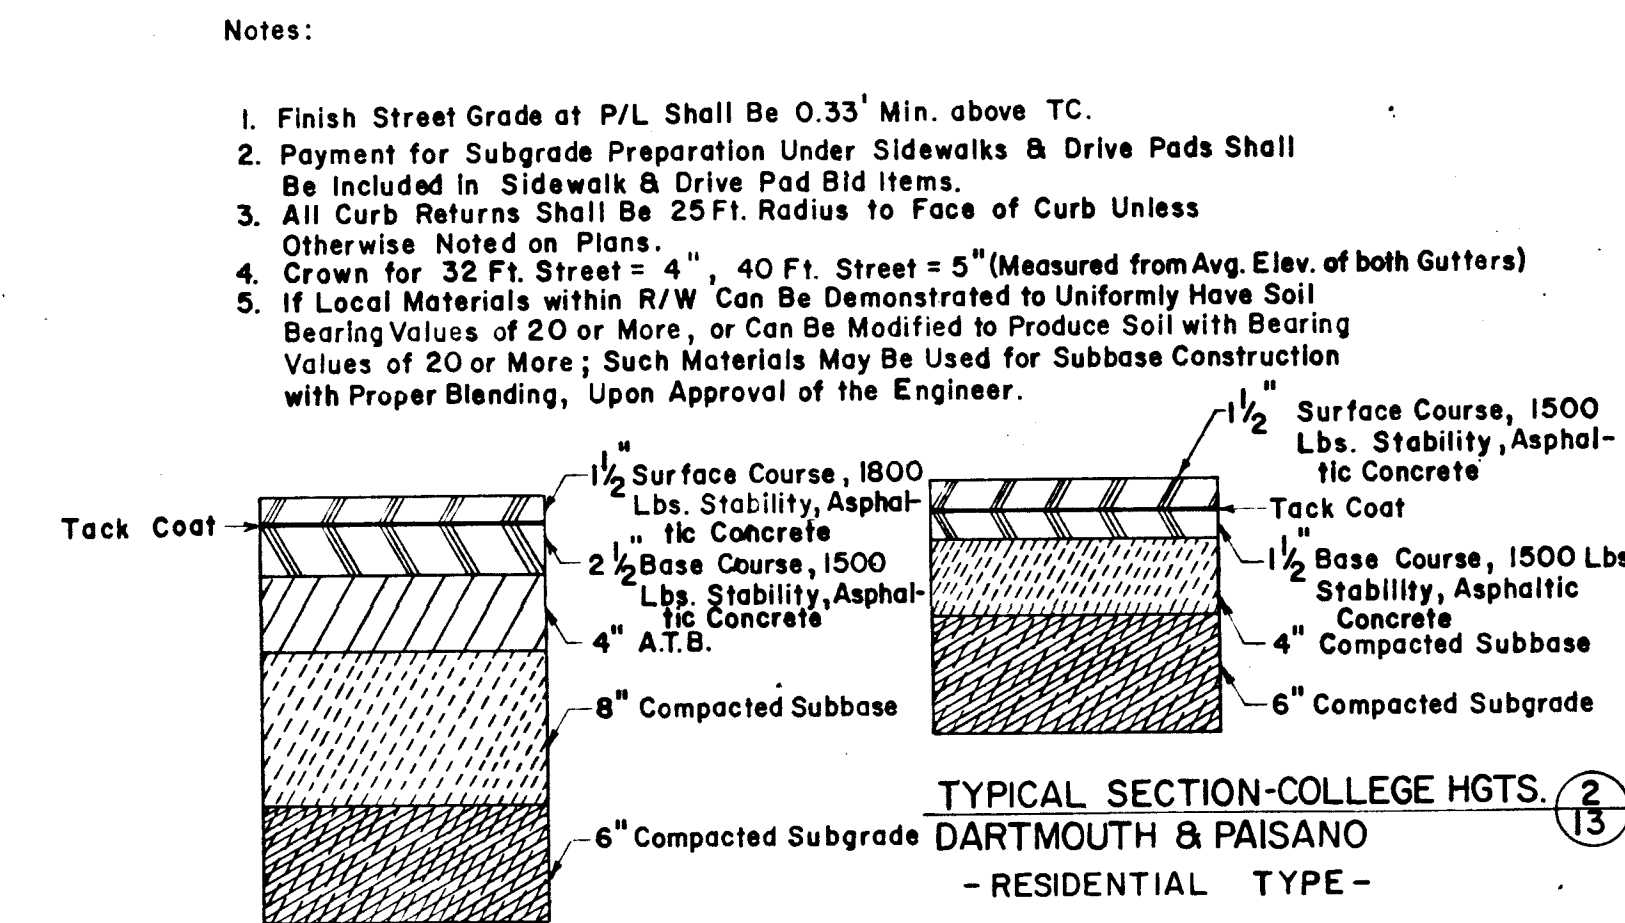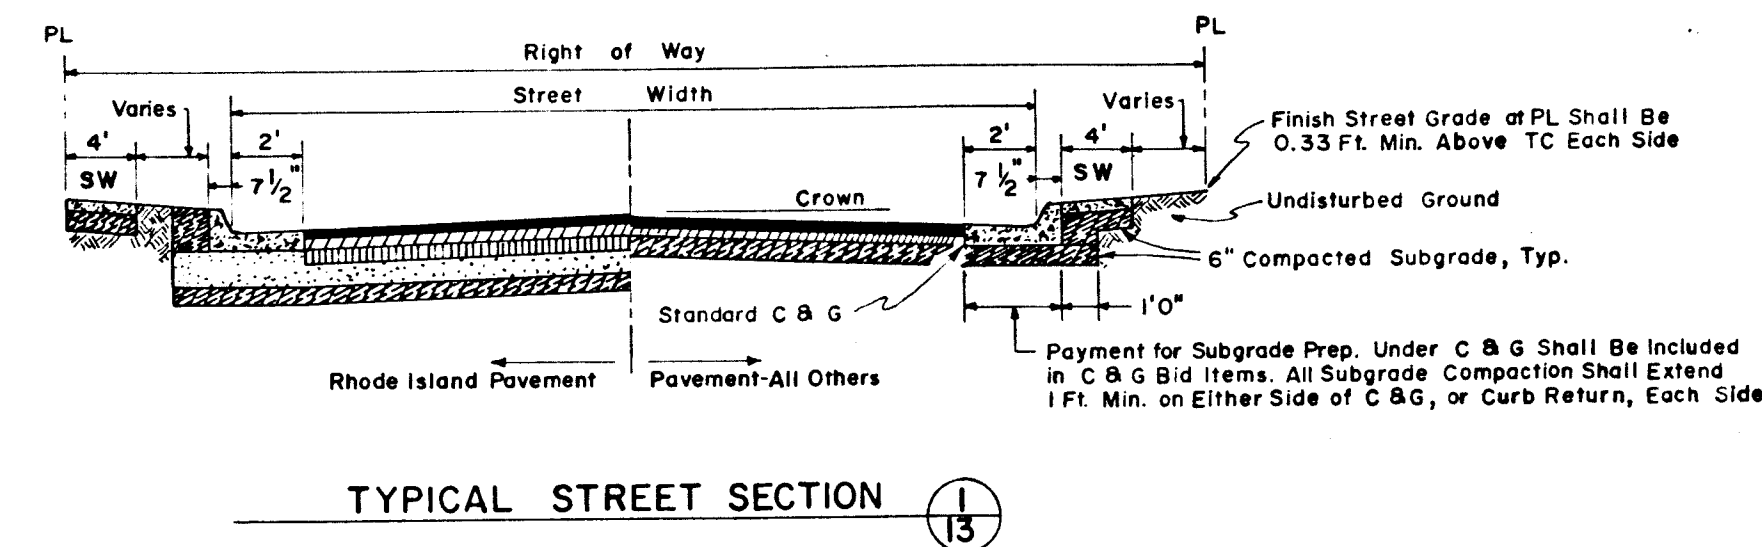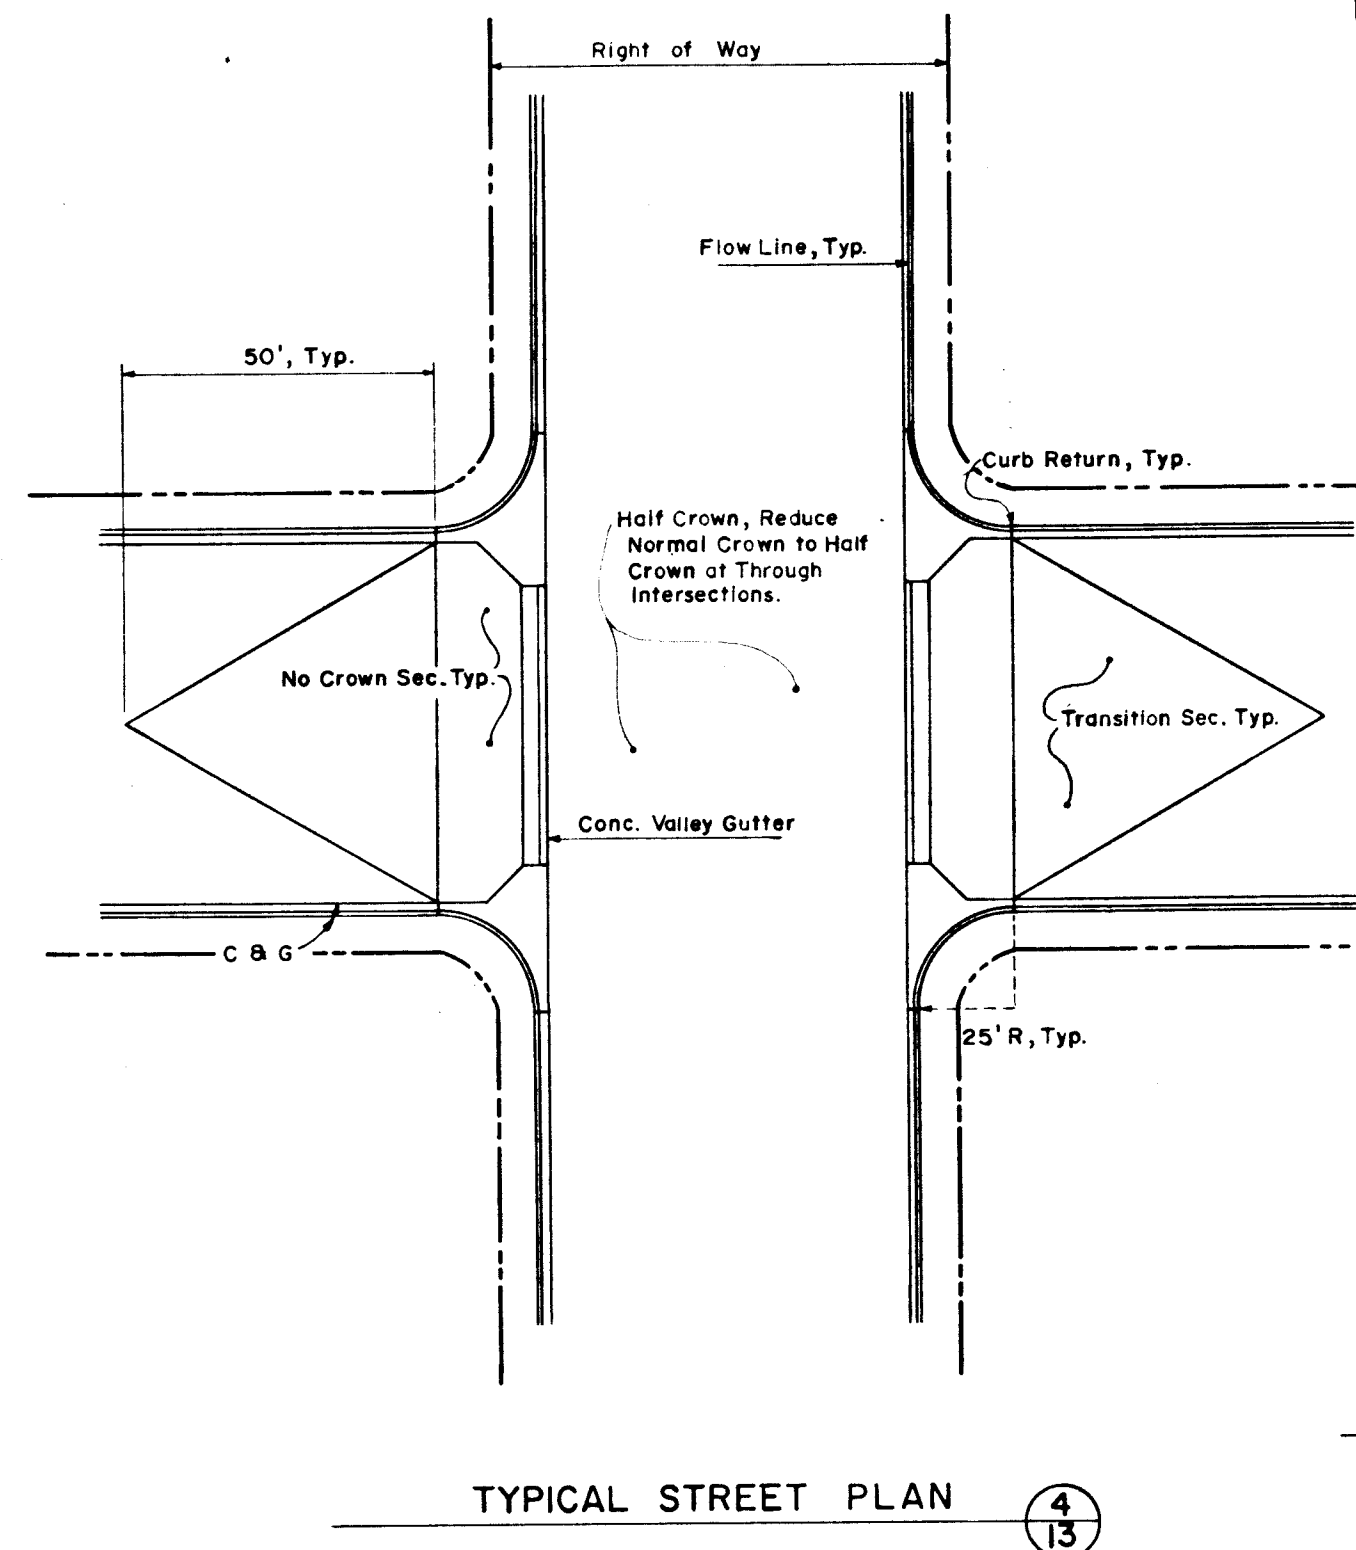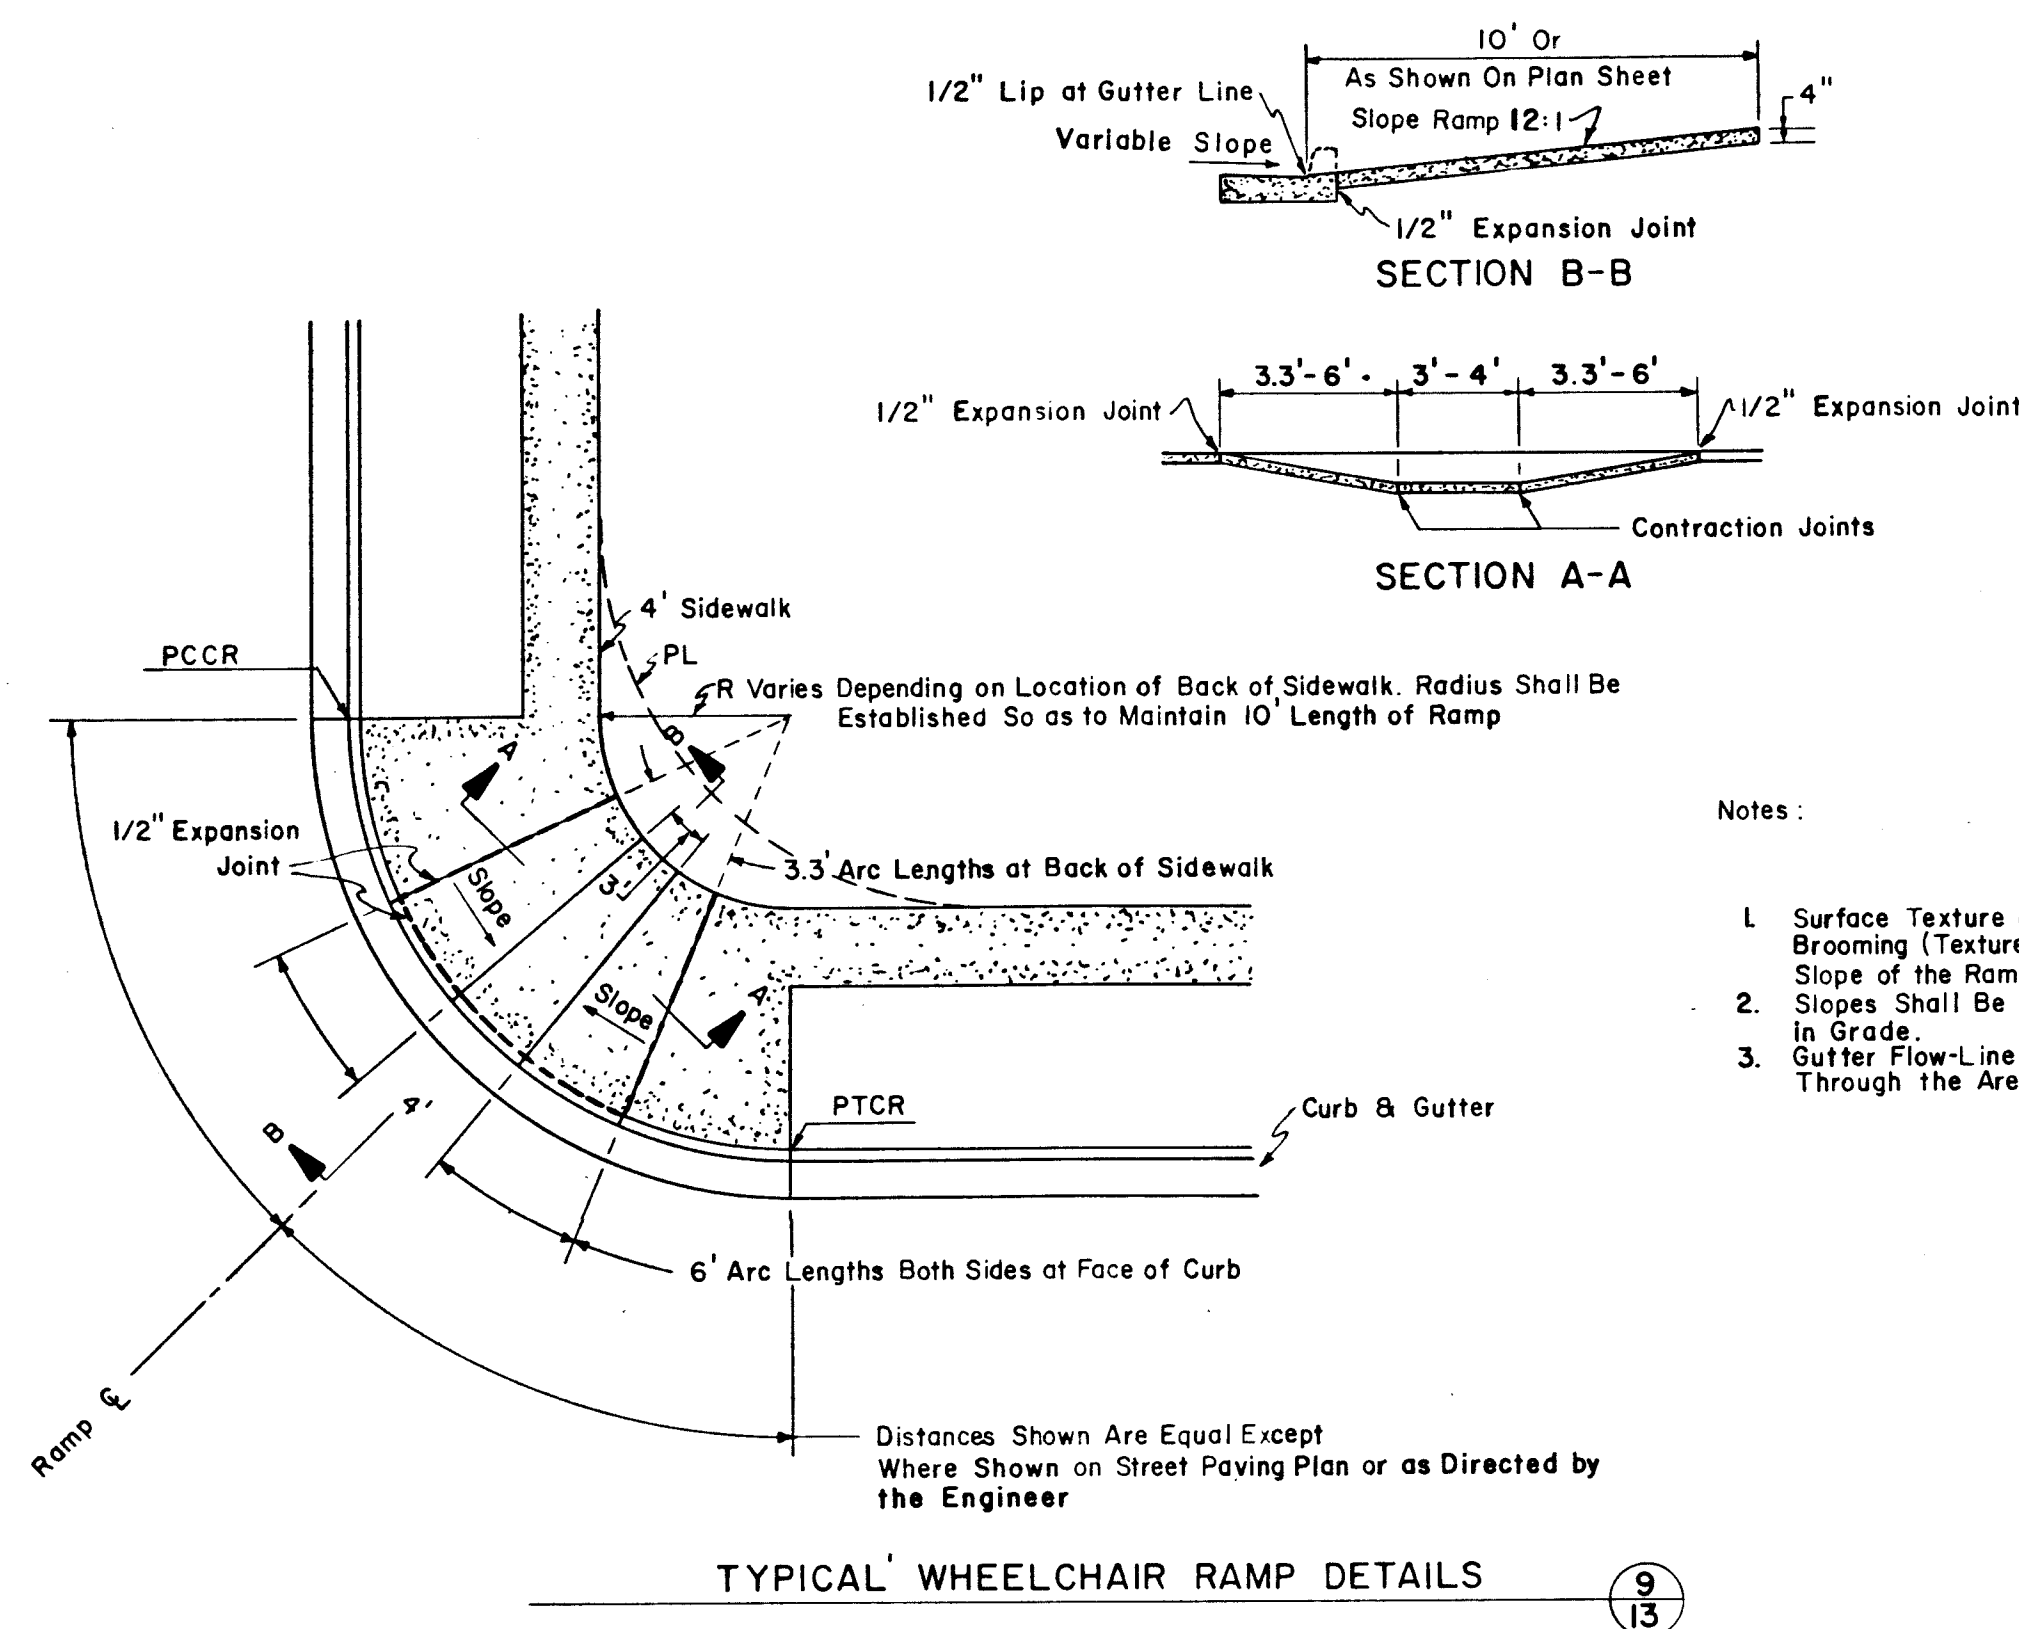


Sdg sullivan design group, incorporated
albuquerque • santa fe • new mexico

PLANS PREPARED UNDER THE DIRECTION OF	<					
--	--	--	--	--	--	--

RECORD DRAWINGS

THESE RECORD DRAWINGS HAVE BEEN PREPARED, IN PART, ON THE BASIS OF INFORMATION COMPILED AND FURNISHED BY OTHERS. THE ENGINEER WILL NOT BE RESPONSIBLE FOR ANY ERRORS OR OMISSIONS WHICH HAVE BEEN INCORPORATED INTO THIS DOCUMENT AS A RESULT.

OWNERSHIP OF DOCUMENTS
This document, and the ideas and designs incorporated herein, as an instrument of professional service, is the property of SULLIVAN DESIGN GROUP, INC. and is not to be used, in whole or in part, for any other project without the written authorization of SULLIVAN DESIGN GROUP, INC.

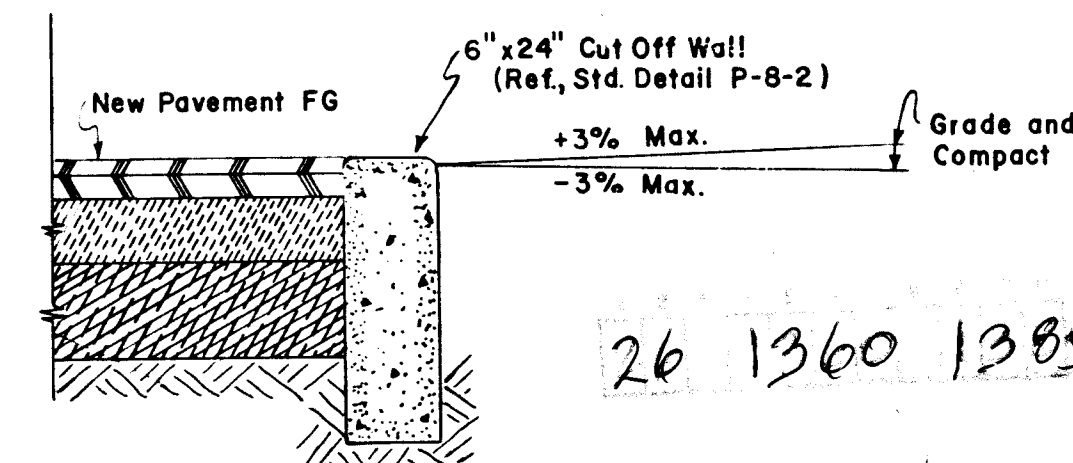

SECTION - PAVED TO UNPAVED TRANSITION
PAISANO ST. - ZIA ROAD INTERSECTION

THIS IS A RECORD DRAWING
IT IS NOT TO BE USED FOR CONSTRUCTION
IT IS NOT TO BE USED FOR CONSTRUCTION

DATE: MAY 20, 1983