
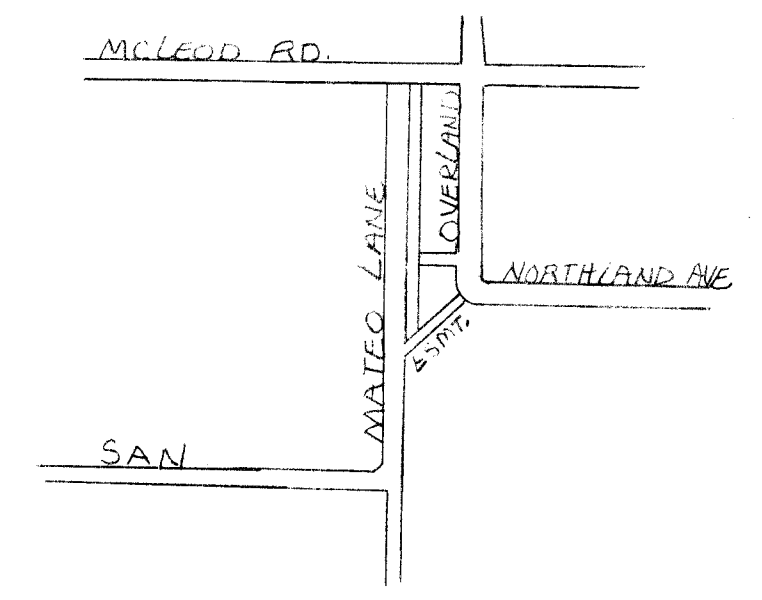
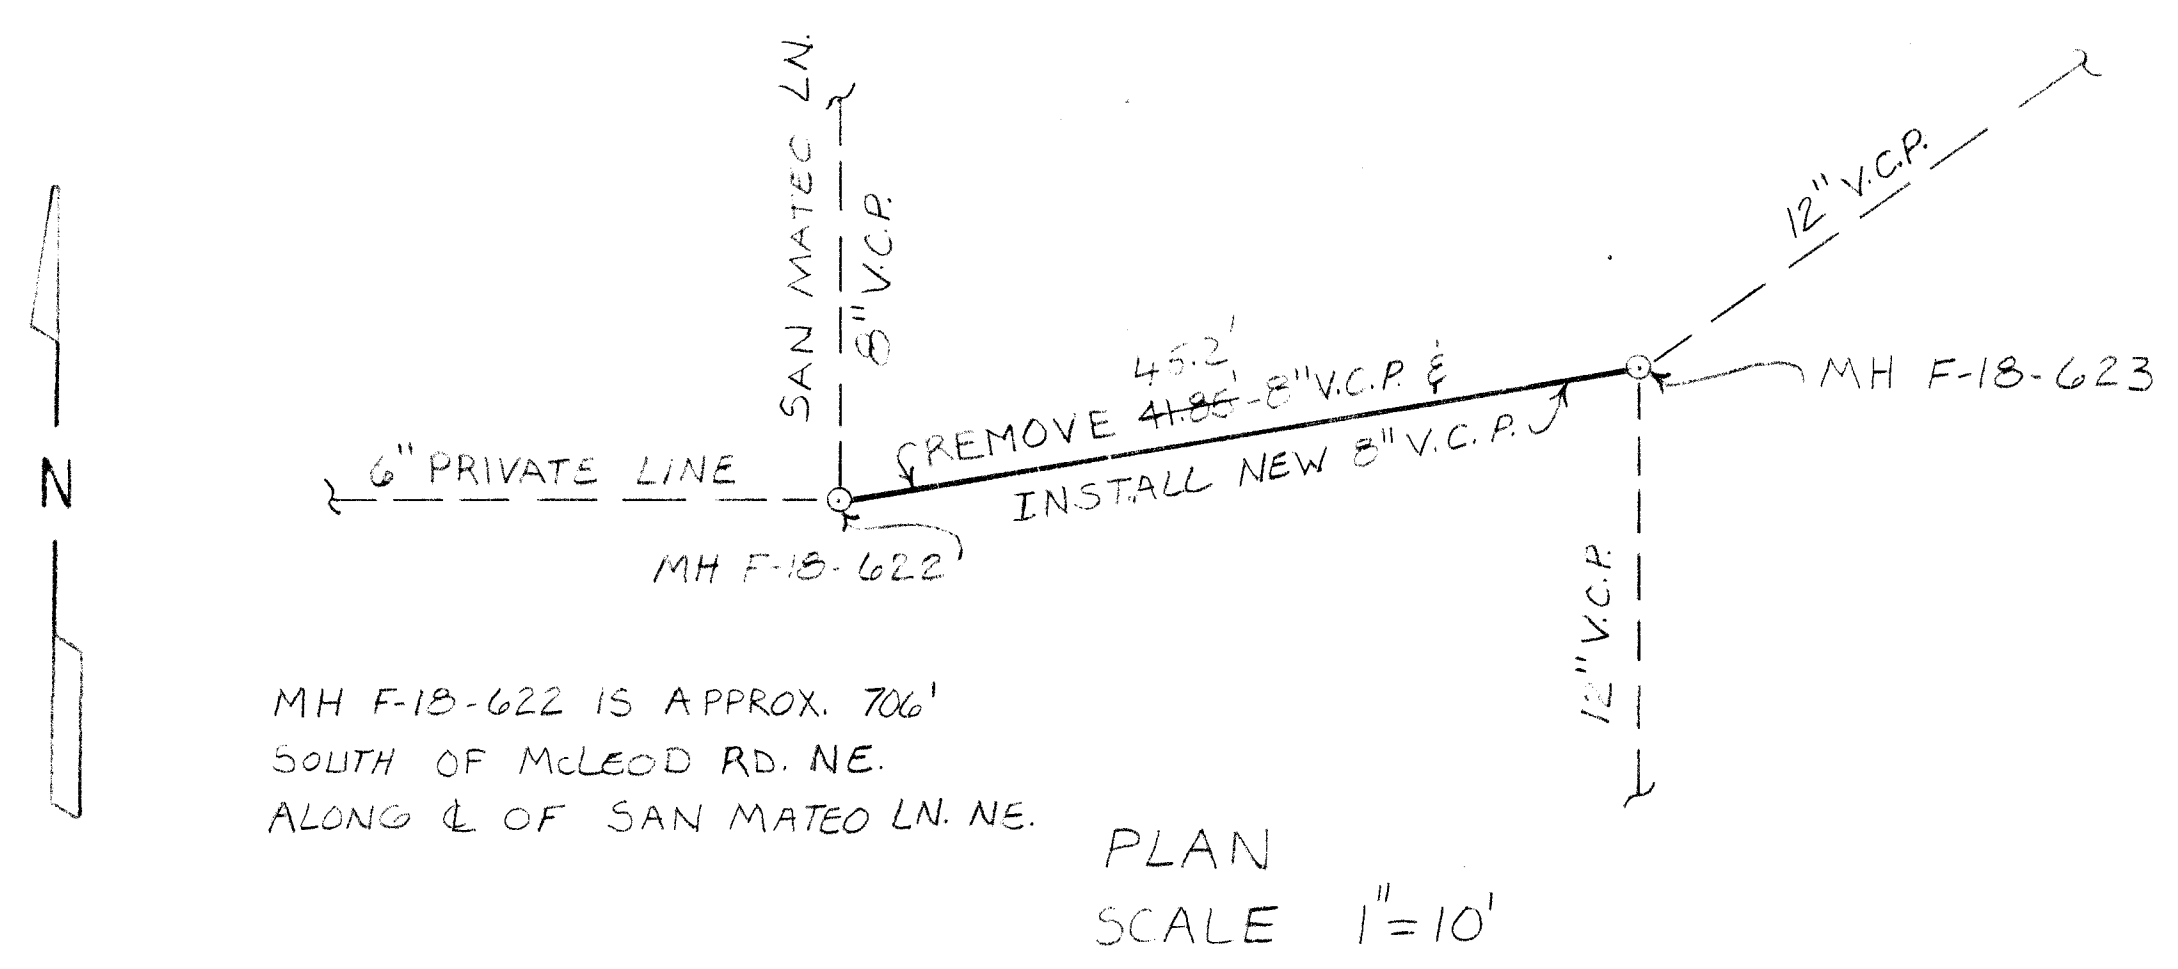


SCALE - 1"=1'

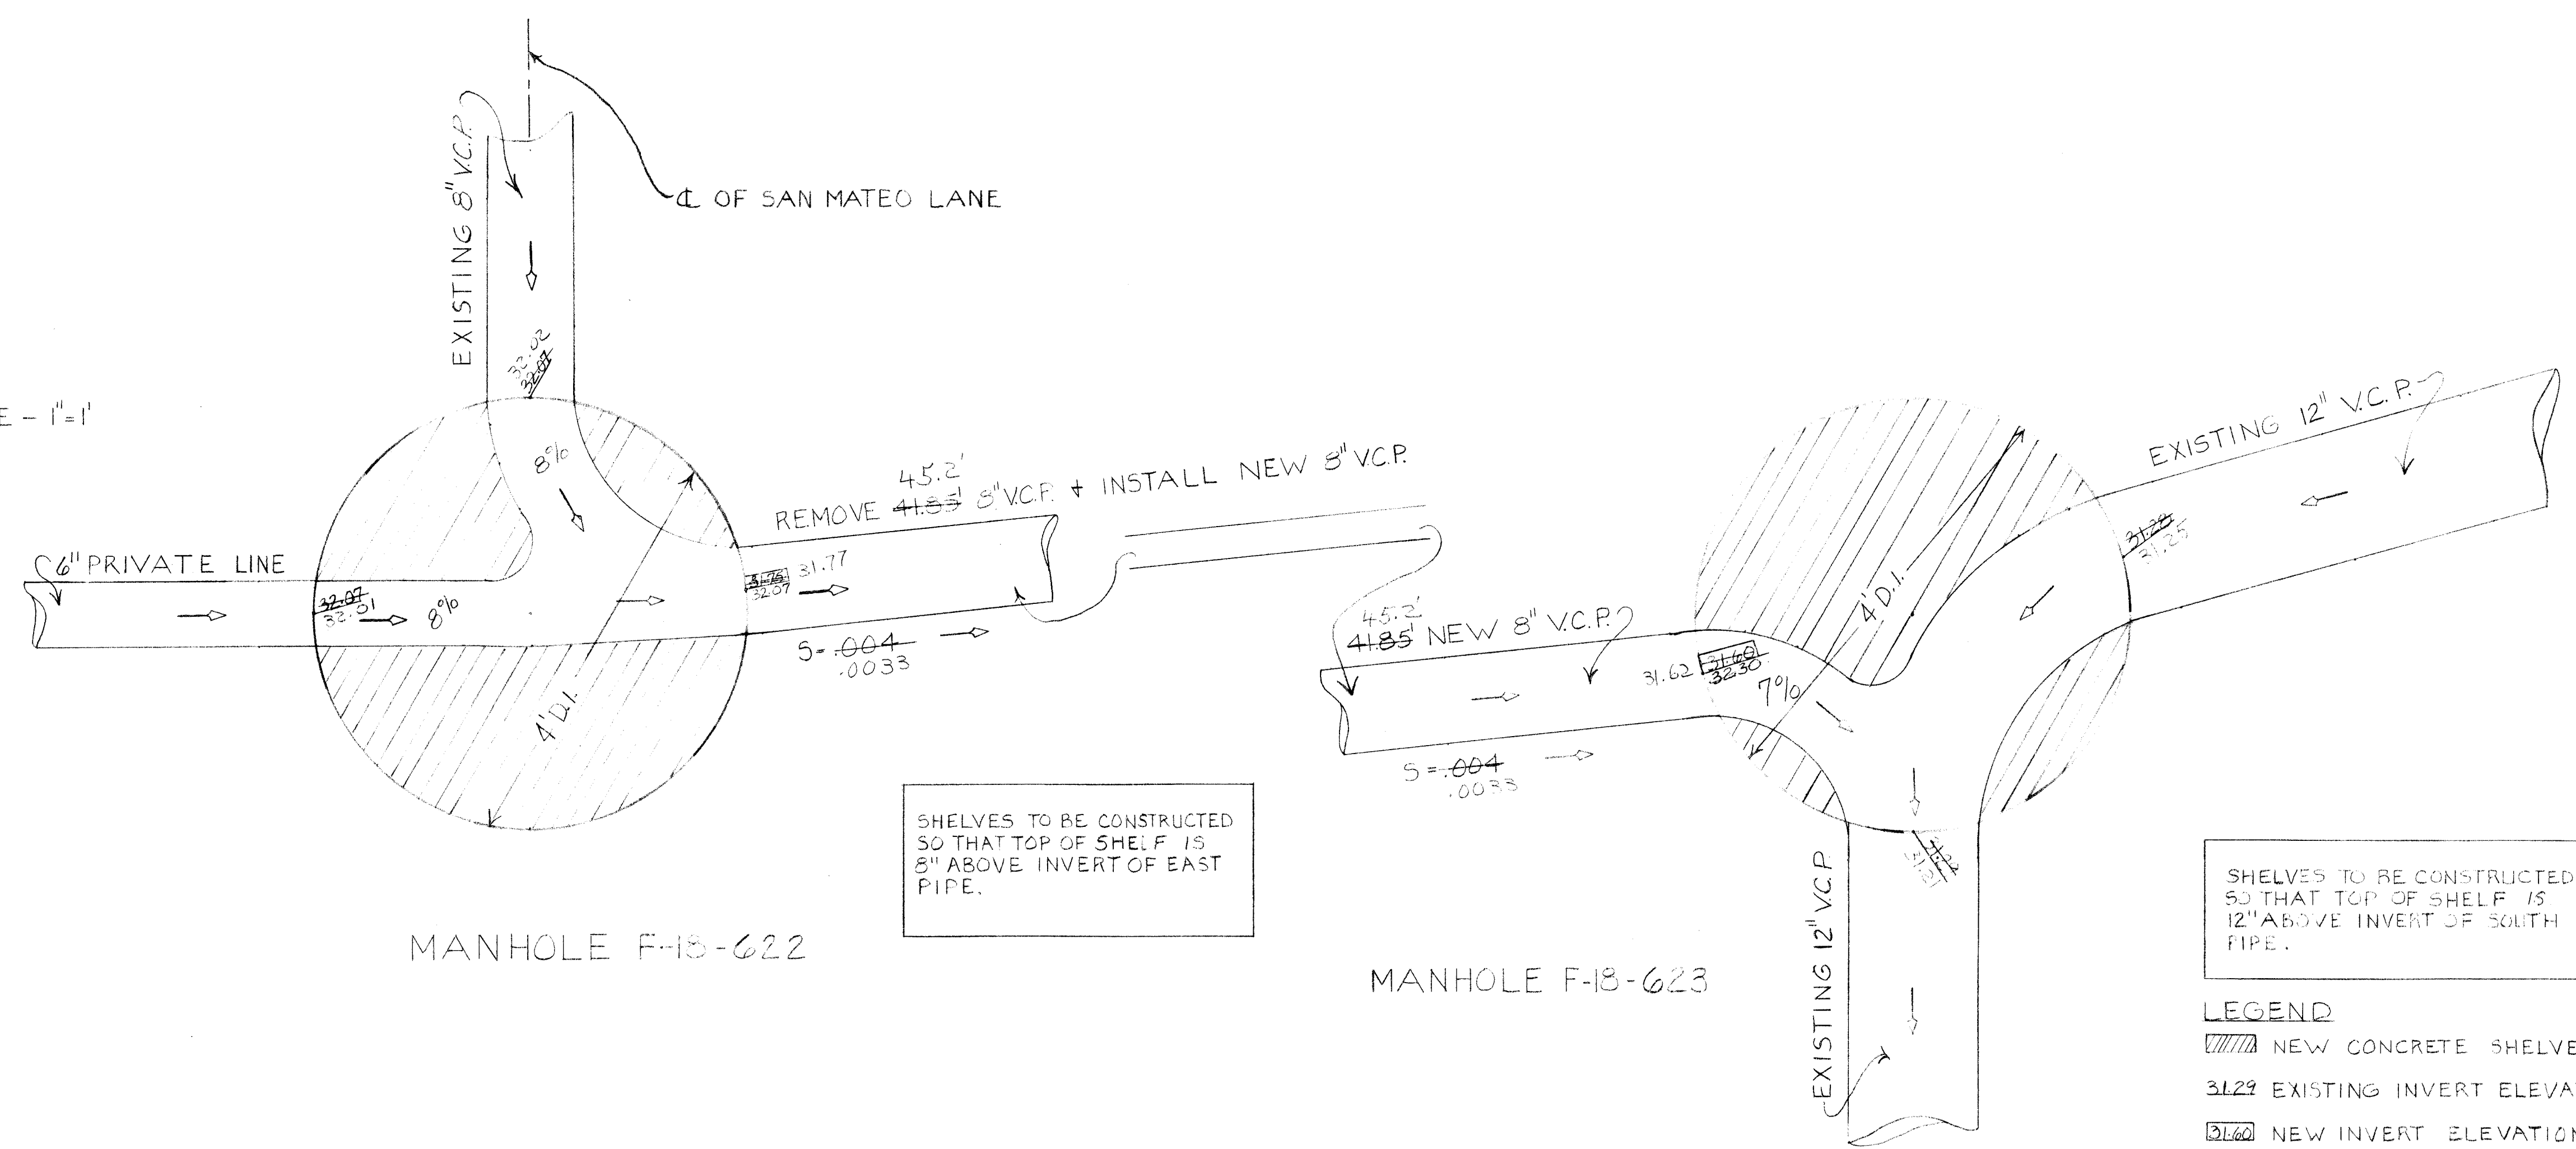

30

(RESIDENTIAL)

1 ARCHITECT

2 ARCHITECT

NM 307 2-A BRIDGE TRUSSET

30316 D215.86 ELEV. ON CL OF

64881 SAN MATEO BLVD. NE, 130'

S. OF MCLEOD RD. NE.

NOTE:

1. USE DWG. NO. 5-1-2 OR 5-2-2 FOR CONSTRUCTION OF SHELVES.

2. THIS DRAWING SUPERCEDES THAT PORTION OF THE SANITARY SEWER LINE FROM STA. 7+05 TO STA. 7+47.67, AS SHOWN ON DRAWING NO. P-103-77.

1369

26 13690182

APPROVED FOR CONSTRUCTION

CITY ENGINEER DATE

SANITARY SEWER LINE REVISION BETWEEN MH F-18-622 & MH F-18-623 ADJACENT TO SAN MATEO LANE N.E.

1/1/62

7/1/62

1/1/62

1369 F-18