


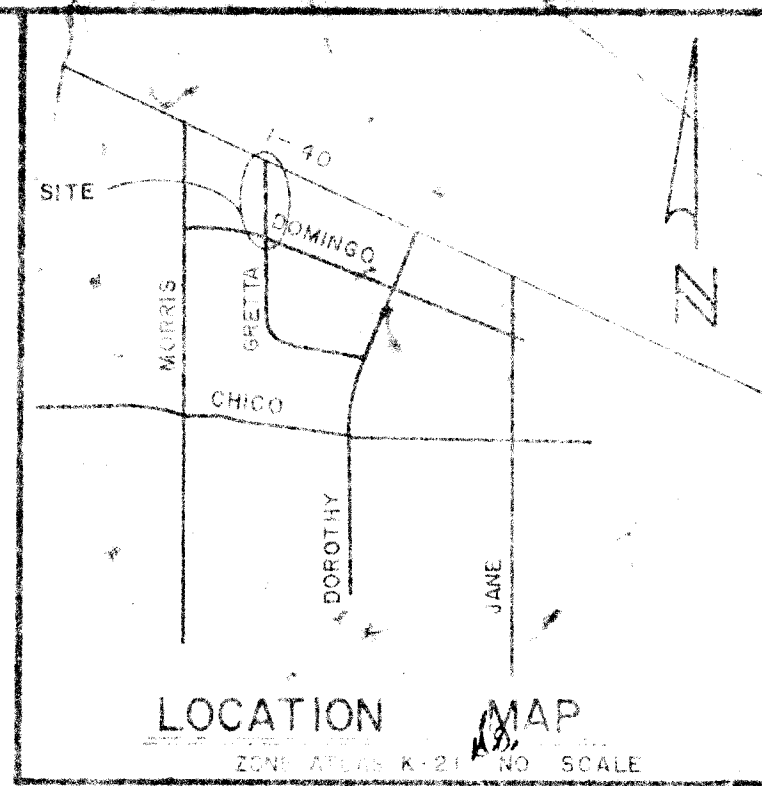

"NOTICE TO CONTRACTORS"

- 1) New Mexico Standard Specifications for Public Works Construction - 1979 Edition will be referred to hereon as the "Standard Specification".
- 2) All work detailed on these plans to be performed under contract shall, except as otherwise stated or provided for herein, be constructed in accordance with "Contract Documents for City-Wide Utilities and Cash Paving No. 32" and the Standard Specification.
- 3) Two working days prior to any excavation, contractor must contact Line Locating Service to determine location of existing utilities.
- 4) Prior to construction, the contractor shall excavate and verify the horizontal and vertical locations of all obstructions. Should a conflict exist, the contractor shall notify the engineer or surveyor so that the conflict can be resolved with minimum amount of delay.

INDEX

SHEET	TITLE
1	TITLE SHEET
2	P & P WATER & SEWER
3	P & P PAVING

GRETTA ST. N.E.
FROM DOMINGO NORTH TO I-40

~~WATER~~ ~~SEWER~~ PAVING

THE FOLLOWING NOTES APPLY WHEN USED


- ✓ All utilities and utility service lines shall be installed prior to paving.
- ✓ No fill compaction shall be according to specified street use.
- ✓ Tack coat requirements shall be as required by the City Engineer.
- ✓ Sidewalks and wheelchair ramps shall be constructed wherever a new curb return is constructed.
- ✓ If curb is depressed for a driveway, the driveway shall be constructed prior to acceptance of the curb and gutter.
- ✓ All storm drainage facilities shall be completed prior to final acceptance.

APPROVAL OF AS BUILT DRAWINGS
ASST. CITY ENGINEER - FIELD
[Signature]
DATE 12/15/82

1 2 3 4 5 6 7 8 9 10 11 12
26 13720182

Reference Drawing No. IIII
For Water & Sewer Installations

APPROVED FOR CONSTRUCTION <i>[Signature]</i> CITY ENGINEER	DRAWING NO. 1372	SHEET 1 OF 3
--	------------------	--------------

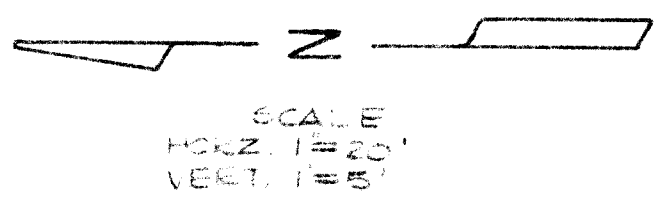

RHODES SANDIA VISTA

GRETTA ST. N.E.

DOMINGO RD.

	HL	TC
1	8720	8751
2	8716	8753
3	8712	8779

	HL	TC
1	8661	8728
2	8637	8704
3	8612	8679

CURVE DATA FOR RETURNS

LE RETURN
 $\Delta = 68^{\circ} 10' 00''$
 $R = 20'$
 $T = 13.03'$
 $L = 23.79'$

NW RETURNS
 $\Delta = 105^{\circ} 00' 00''$
 $R = 20'$
 $T = 26.06'$
 $L = 36.65'$

LEGEND:

- EXIST CURB & GUTTER
- NEW CURB & GUTTER
- NEW SIDEWALK & WHEEL-CHAIR RAMP
- NEW VALLEY GUTTER
- NEW FLOWLINE ELEVATION
- NEW TOP ASPHALT ELEVATION
- EXPANSION JOINT MATERIAL
- NEW WATER SERVICES DOUBLE & SINGLE
- FIRE HYDRANT

NOTE:

LOT 29 AS PER REPLAT OF 3/11/80 RECORDING NO. A7-288 FORMERLY LOT 15.

26 13720382

CITY OF ALBUQUERQUE
MUNICIPAL DEVELOPMENT DEPARTMENT
ENGINEERING DIVISION
TITLE: GRETTA ST. N.E. NORTH OF DOMINGO PAVING

APPROVALS	ENGINEER	DATE	APPROVALS	ENGINEER	DATE
City Engineer	<i>[Signature]</i>	7/1/81	Liquid Waste	<i>[Signature]</i>	6/1/81
City Designer	<i>[Signature]</i>		Traffic	<i>[Signature]</i>	6/1/81
City Hydrologist	<i>[Signature]</i>		Water	<i>[Signature]</i>	6/1/81

DRAWING NO. **1372** MAP NO. **K-21** SHEET **3** OF **3**