


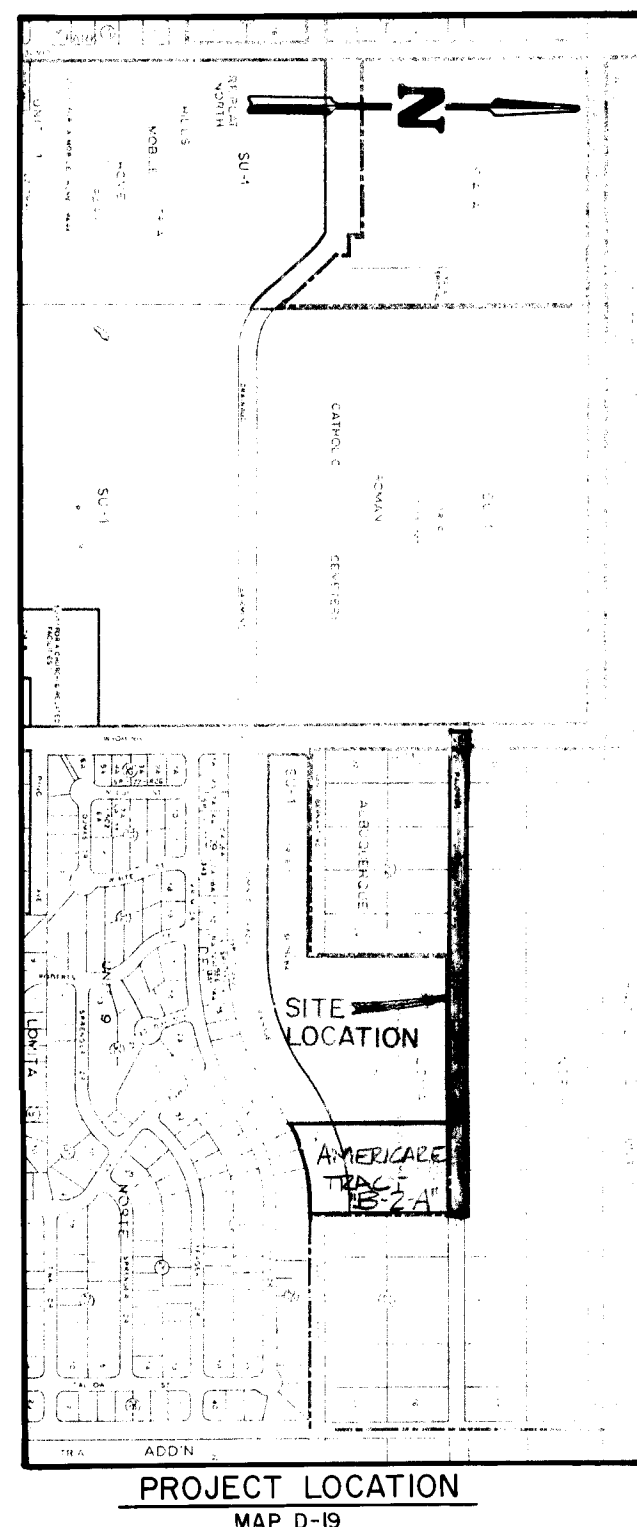

# CONSTRUCTION PLANS FOR

# PALOMAS AVE. WATER-SEWER-PAVING

## INDEX TO DRAWINGS

- 1 TITLE SHEET
- 2 PLAT
- 3-4 STREET PAVING PLAN & PROFILE
- 5-6 WATER AND SEWER PLAN & PROFILE

### NOTICE TO CONTRACTORS

1. New Mexico Standard Specifications for Public Works Construction - 1979 Edition will be referred to hereon as the "Standard Specification".
2. All work detailed on these plans to be performed under contract shall, except as otherwise stated or provided for hereon, be constructed in accordance with "Contract Documents for City-Wide Utilities and Cash Paving No. 30 and the Standard Specification".

### GENERAL NOTES

1. Backfill compaction shall be according to specified street use. (Arterial and Residential)
2. Two working days prior to any excavation, contractor must contact Line Locating Service, 765-1234, for location of existing utilities.
3. Prior to construction, the contractor shall excavate and verify the horizontal and vertical locations of all obstructions. Should a conflict exist, the contractor shall notify the engineer or surveyor so that the conflict can be resolved with a minimum amount of delay.
4. Contractor to coordinate traffic control on Wyoming Blvd. with City Traffic Department prior to beginning construction.
5. All M's shall be Type "E", 4' inside diameter.
6. All utilities and utility service lines shall be installed prior to paving.

PREPARED UNDER THE SUPERVISION OF

*Carl A. Telford*


3/29/02  
DATE



MSM CONSULTANTS, INC.

2601 WYOMING BOULEVARD, N.E. • ALBUQUERQUE, NEW MEXICO 87110

(505) 292-1936 • MEMBER SP GROUP

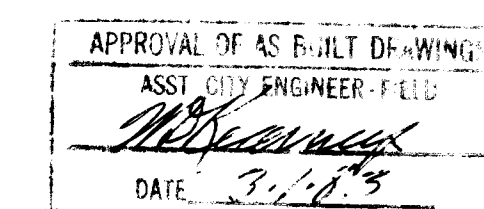


APPROVED FOR CONSTRUCTION

*Richard S. Hill*  
CITY ENGINEER

6/24/82  
DATE

26 13730182

DWG. NO 1373

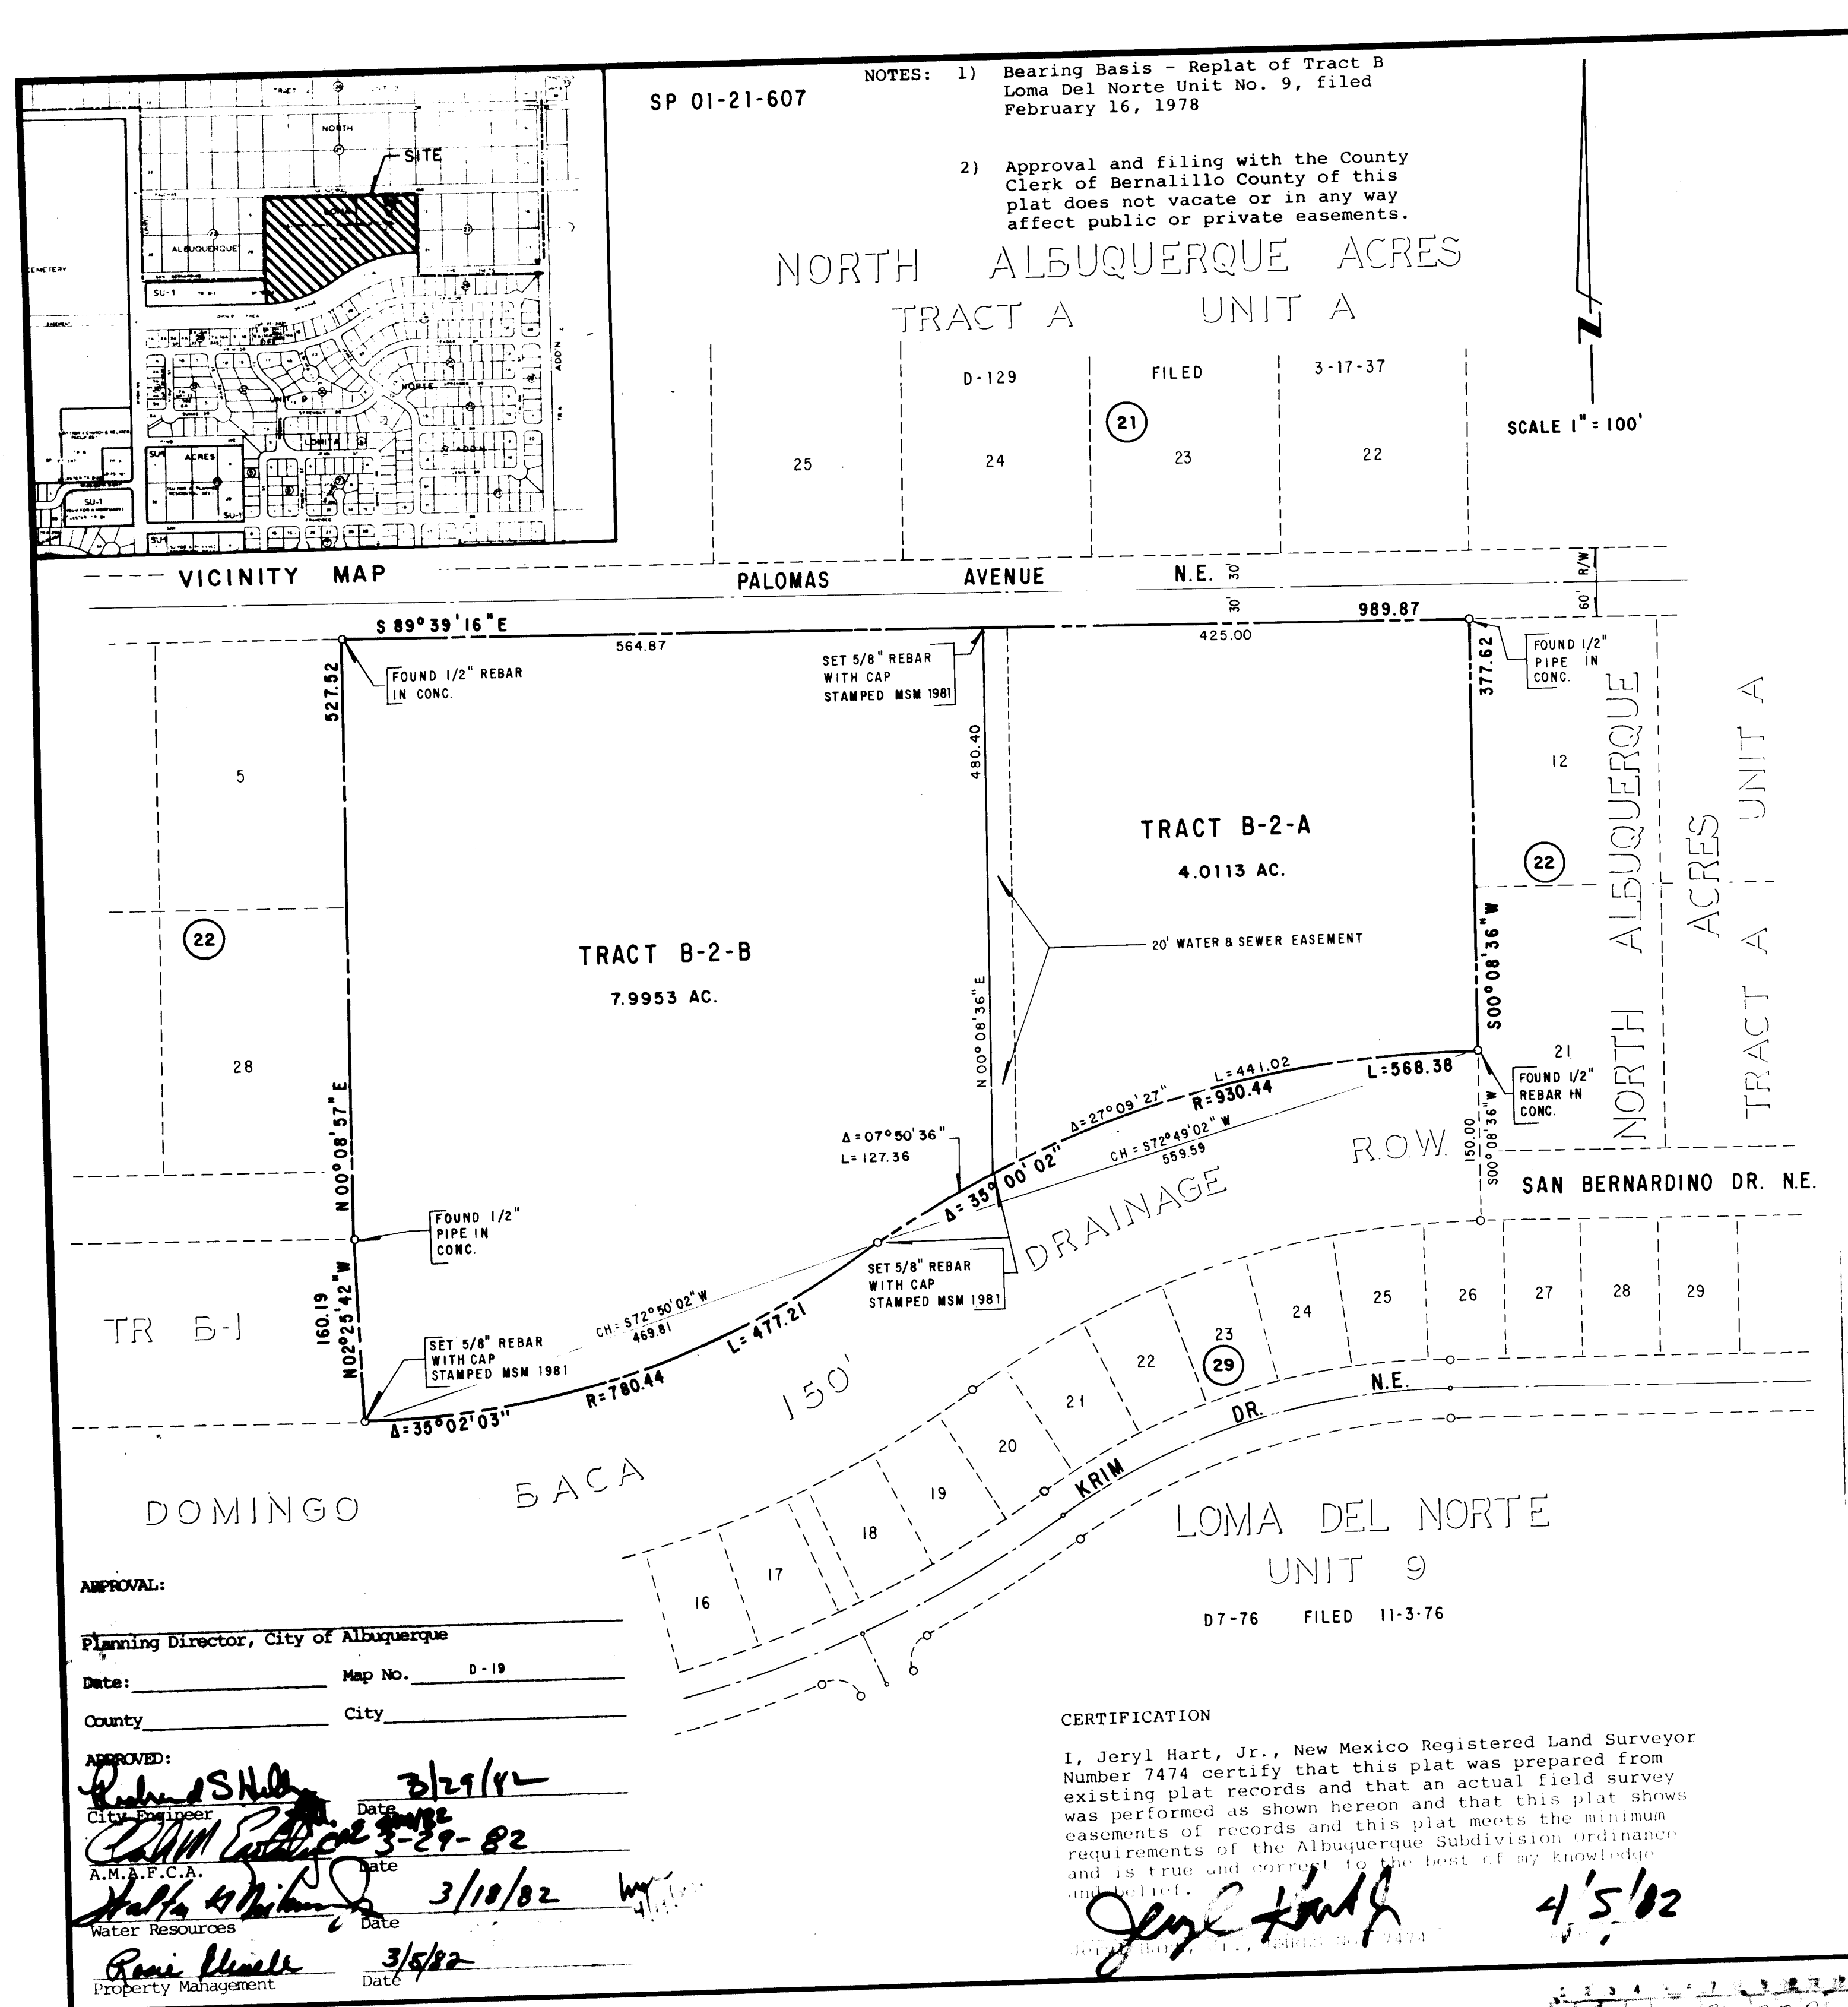

TRACTS B-2-A & B-2-B  
LOMA DEL NORTE  
UNIT 9  
BEING A REPLAT OF  
TRACT "B-2"  
LOMA DEL NORTE  
UNIT 9  
CITY OF ALBUQUERQUE  
BERNALILLO COUNTY, NEW MEXICO  
JANUARY, 1982

The undersigned Owners of the land hereon shown do hereby consent to the Replat shown hereon, TRACTS B-2-A and B-2-B LOMA DEL NORTE UNIT 9, being a Replat of TRACT "B-2" OF LOMA DEL NORTE UNIT NO. 9 an Addition to the City of Albuquerque, New Mexico, filed in the office of the County Clerk of Bernalillo County, New Mexico on February 16, 1978 (Book D-8, Page 83), and is with the free consent of and in accordance with the desires of the undersigned Owners and Proprietors thereof, and said Owners and Proprietors do hereby dedicate the 20' wide water and sewer easement shown hereon including the right of ingress and egress and the right to trim interfering trees.

Americare Corporation, an Ohio Corporation  
(Owner of Tract B-2-A)

Ralph E. Hazelbaker, President Date 4/8/82

STATE OF NEW MEXICO )  
COUNTY OF BERNALILLO )

The foregoing instrument was acknowledged before me this day of APRIL, 1982 by Ralph E. Hazelbaker, President of Americare Corporation, an Ohio Corporation.

Christina M. Henderson  
Notary Public

OFFICIAL SEAL  
CHRISTINA M. HENDERSON  
NOTARY PUBLIC - NEW MEXICO  
My Commission Expires AUGUST 20, 1987

Robert D. Ryan  
(Owner of Tract B-2-B)

Robert D. Ryan Date

STATE OF NEW MEXICO )  
COUNTY OF BERNALILLO )

The foregoing instrument was acknowledged before me this day of \_\_\_\_\_, 1982 by Robert D. Ryan

Notary Public My Commission Expires



MEURER, SERAFINI AND MEURER, INC.  
CONSULTING ENGINEERS • SURVEYORS • PLANNERS  
2601 Wyoming Blvd., N.E. Albuquerque, New Mexico 87112  
(505) 292-1936

TRACTS B-2-A & B-2-B  
LOMA DEL NORTE





MEURER, SERAFINI AND MEURER, INC.  
CONSULTING ENGINEERS • SURVEYORS • PLANNERS  
2601 Wyoming Blvd., N.E. Albuquerque, New Mexico 87112  
(505) 292-1936

|          |             |            |             |          |       |      |           |
|----------|-------------|------------|-------------|----------|-------|------|-----------|
| DRAWN BY | DESIGNED BY | CHECKED BY | APPROVED BY | FILE NO. | SCALE | DATE | SHEET NO. |
|          |             |            |             |          |       |      |           |

DWG NO. 1275



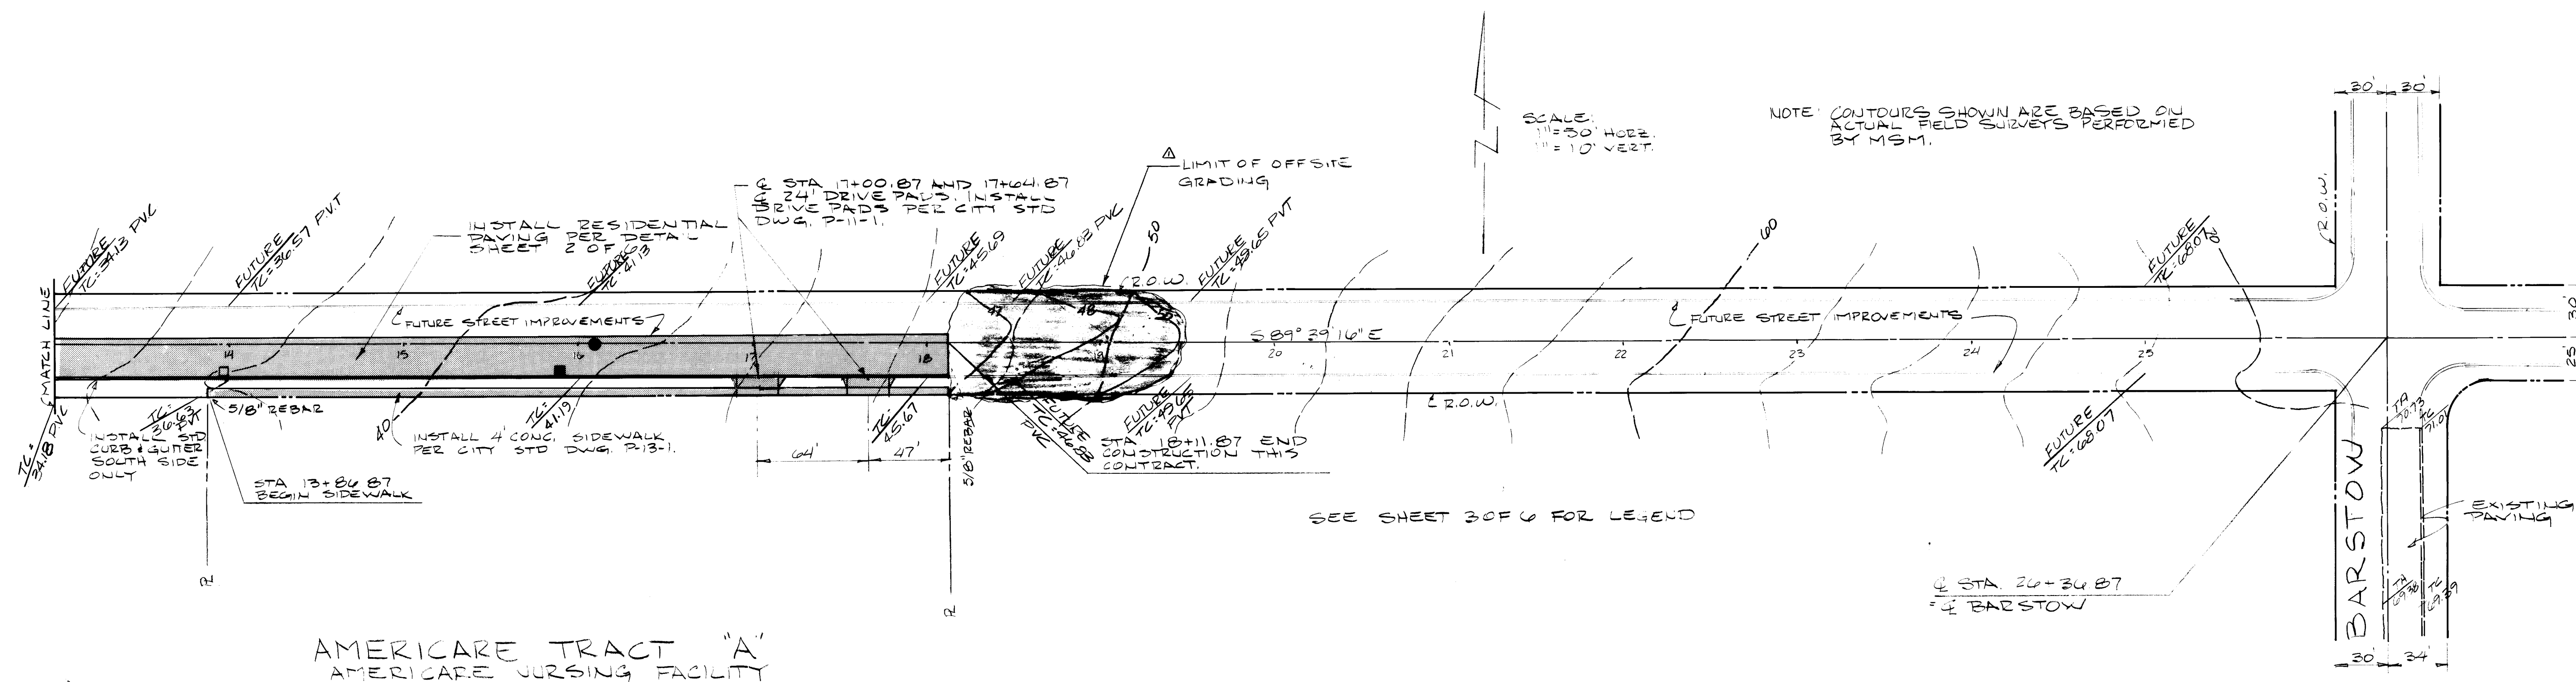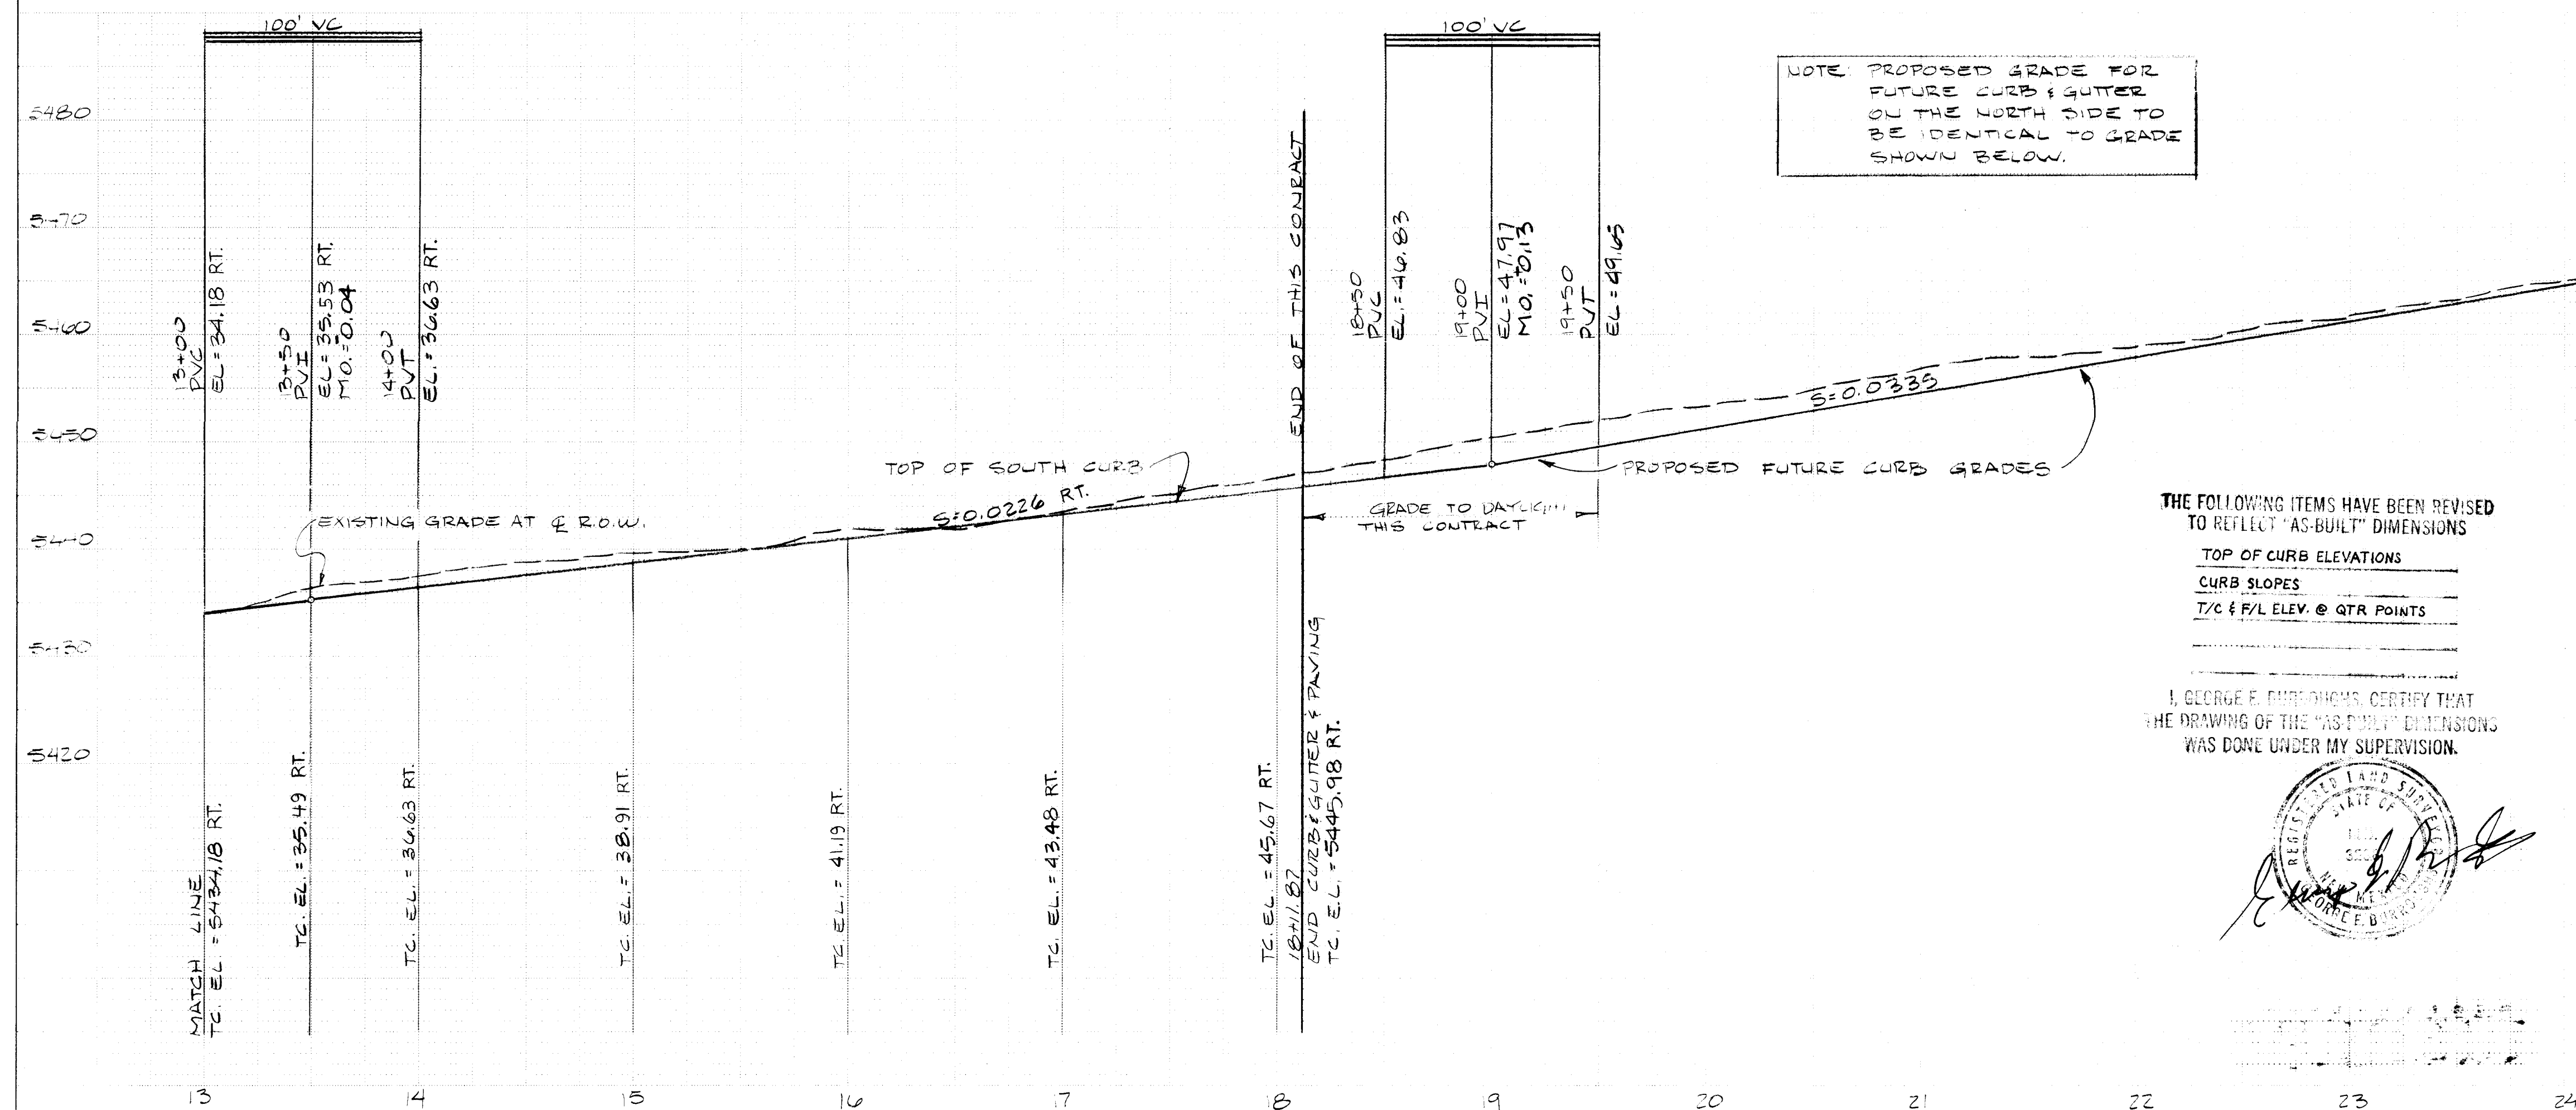

AMERICARE TRACT "A"  
AMERICARE NURSING FACILITY


PALOMAS AVE.



NOTE: PROPOSED GRADE FOR  
FUTURE CURB & GUTTER  
ON THE NORTH SIDE TO  
BE IDENTICAL TO GRADE  
SHOWN BELOW.

THE FOLLOWING ITEMS HAVE BEEN REVISED  
TO REFLECT "AS-BUILT" DIMENSIONS


TOP OF CURB ELEVATIONS  
CURB SLOPES  
T/C & F/L ELEV. @ QTR POINTS

I, GEORGE E. BURROUGHS, CERTIFY THAT  
THE DRAWING OF THE "AS-BUILT" DIMENSIONS  
WAS DONE UNDER MY SUPERVISION.


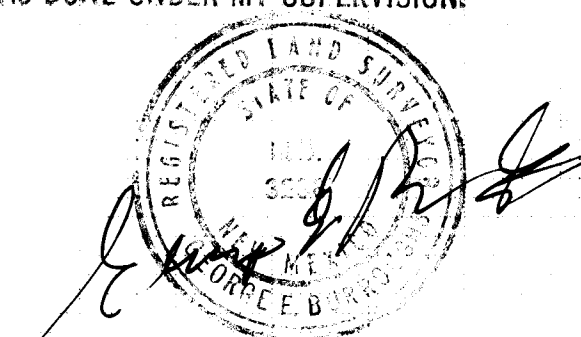

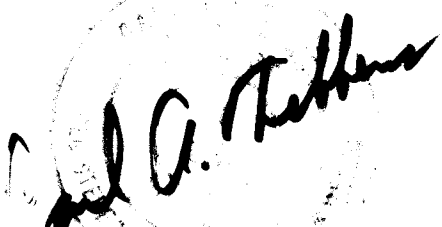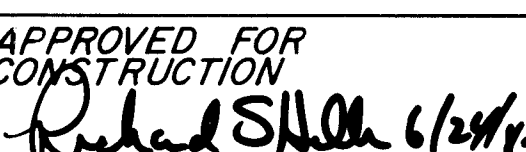
|                                                                                                                                      |  |                                                                                                                                                                                                   |  |                                                                                                           |  |                      |  |                  |  |
|--------------------------------------------------------------------------------------------------------------------------------------|--|---------------------------------------------------------------------------------------------------------------------------------------------------------------------------------------------------|--|-----------------------------------------------------------------------------------------------------------|--|----------------------|--|------------------|--|
| MEURER, SERAFINI AND MEURER, INC.                                                                                                    |  | CONSULTING ENGINEERS - SURVEYORS - PLANNERS                                                                                                                                                       |  | DESIGN                                                                                                    |  | DRAWN                |  | CHECKED          |  |
| 0690109                                                                                                                              |  | 27601 WYOMING, BEVEL, PUE, SUITE 1, ALBUQUERQUE, NEW MEXICO 87110, (505) 262-1349                                                                                                                 |  | A                                                                                                         |  | NO.                  |  |                  |  |
| PLANS PREPARED<br>UNDER THE DIRECTION<br>OF<br> |  | CITY OF ALBUQUERQUE<br>PUBLIC WORKS DEPARTMENT<br>ENGINEERING DIVISION<br><br>TITLE: <u>DIPLOMAS AVE. N.E.</u><br><u>PAVING PLAN AND PROFILE</u>                                                  |  |                                                                                                           |  |                      |  |                  |  |
| APPROVED FOR<br>CONSTRUCTION<br>                |  | APPROVALS<br>CITY ENGINEER <u>Richard S. Allen</u> DATE <u>6/25/82</u><br>A.C.E. - Design <u>P.G. Thibault</u> DATE <u>7/20/82</u><br>A.C.E. - Hydrology <u>P.G. Thibault</u> DATE <u>7/27/82</u> |  | APPROVALS<br>Liquid Waste <u>N/A</u><br>Traffic <u>W.D. Dwyer</u> DATE <u>4/20/82</u><br>Water <u>N/A</u> |  | ENGINEER<br><br><br> |  | DATE<br><br><br> |  |
| CITY ENGINEER DATE                                                                                                                   |  | DRAWING NO. 1373                                                                                                                                                                                  |  | SHEET 4                                                                                                   |  | OF 6                 |  |                  |  |

[illegible]

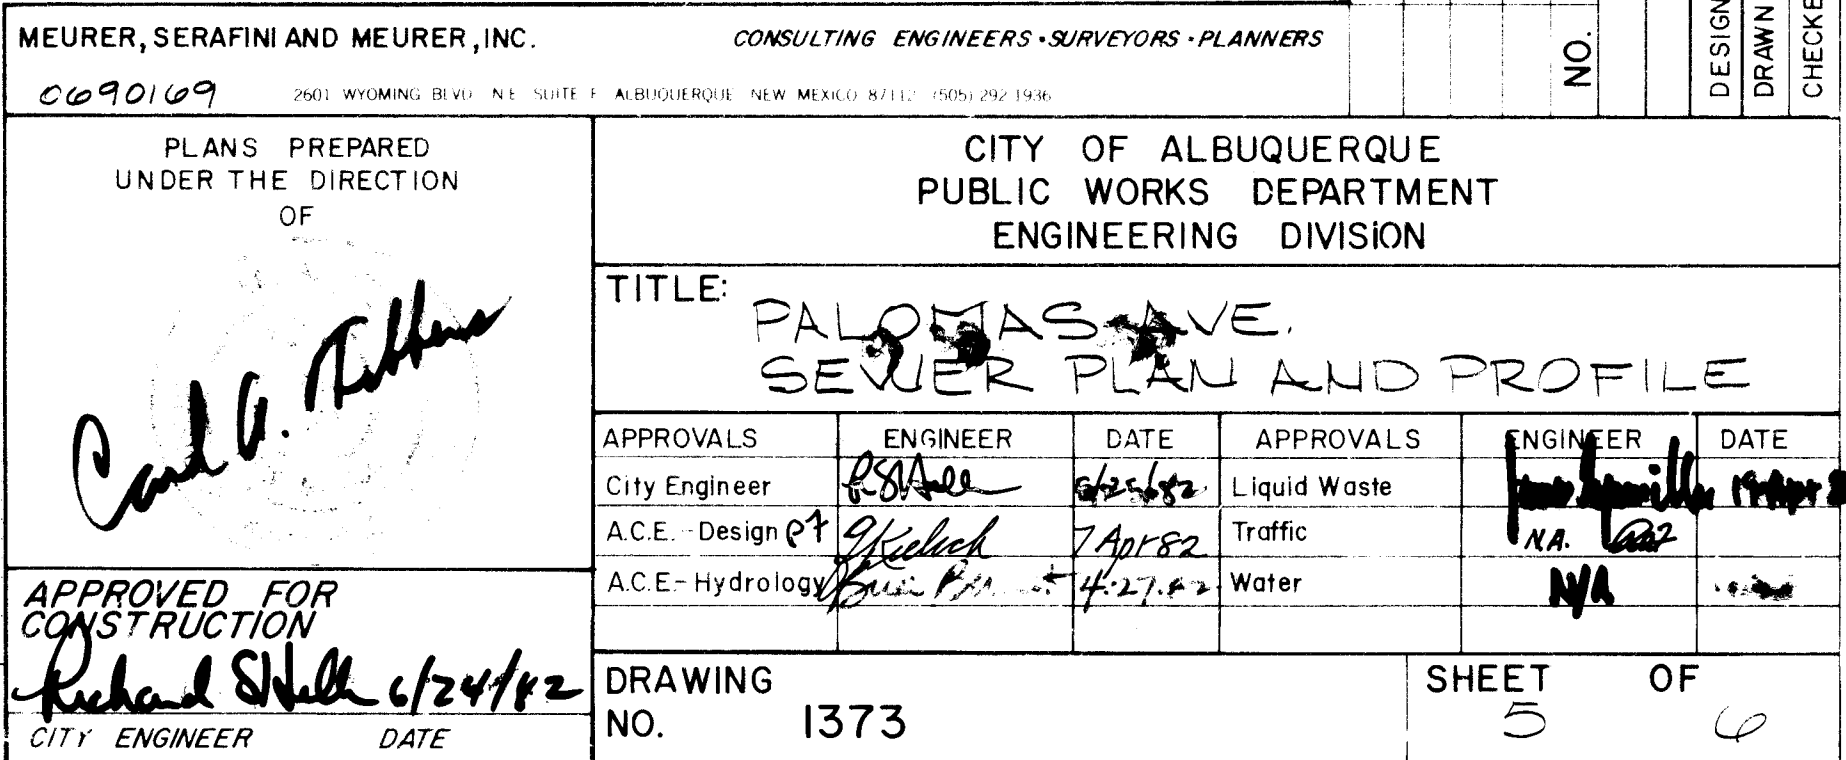

|             |           | REFERENCES    |           | SURVEY INFORMATION |              |             | BENCH MARKS                 |  | AS BUILT INFORMATION   |      |
|-------------|-----------|---------------|-----------|--------------------|--------------|-------------|-----------------------------|--|------------------------|------|
|             |           | MAP NO. 12-19 | W.O. NO.  | NO.                | BY           | FIELD NOTES | CITY OF ALBUQUERQUE STATION |  | CONTRACTOR             |      |
|             |           | EST NO.       |           |                    |              |             | HEAVEN, LOCATED AT THE      |  | WORK                   |      |
|             |           |               |           |                    | TAUBERCH-MEM | 12-81       | EVIDENCE TO THE GATE OF     |  | STAKED BY              | DATE |
|             |           |               |           |                    |              |             | HEAVEN CEMETARY STATION     |  | INSPECTORS             | DATE |
|             |           |               |           |                    |              |             | MARK IS A STD JUSCKG'S      |  | FIELD                  | DATE |
|             |           |               |           |                    |              |             | BRASS TABLET STAMPED        |  | ADJUSTMENT BY          | DATE |
|             |           |               |           |                    |              |             | HEAVEN 1991 SET IN TOP OF   |  | CORRECTED BY           | DATE |
|             |           |               |           |                    |              |             | A CONCRETE POST SET FLUSH   |  | MICRO-FILM INFORMATION |      |
|             |           |               |           |                    |              |             | WITH GROUND ELEV. 5376.79   |  | RECORDED BY            | DATE |
|             |           |               |           |                    |              |             |                             |  | NO.                    |      |
| NO. DATE    | REMARKS   | BY            |           |                    |              |             |                             |  |                        |      |
| DESIGN      |           |               |           |                    |              |             |                             |  |                        |      |
| DESIGNED BY | J. LEYMON | DATE          | DEC. 1981 |                    |              |             |                             |  |                        |      |
| DRAWN BY    | J. LEYMON | DATE          | DEC. 1981 |                    |              |             |                             |  |                        |      |
| CHECKED BY  | MEM       | DATE          | JAN. 1982 |                    |              |             |                             |  |                        |      |

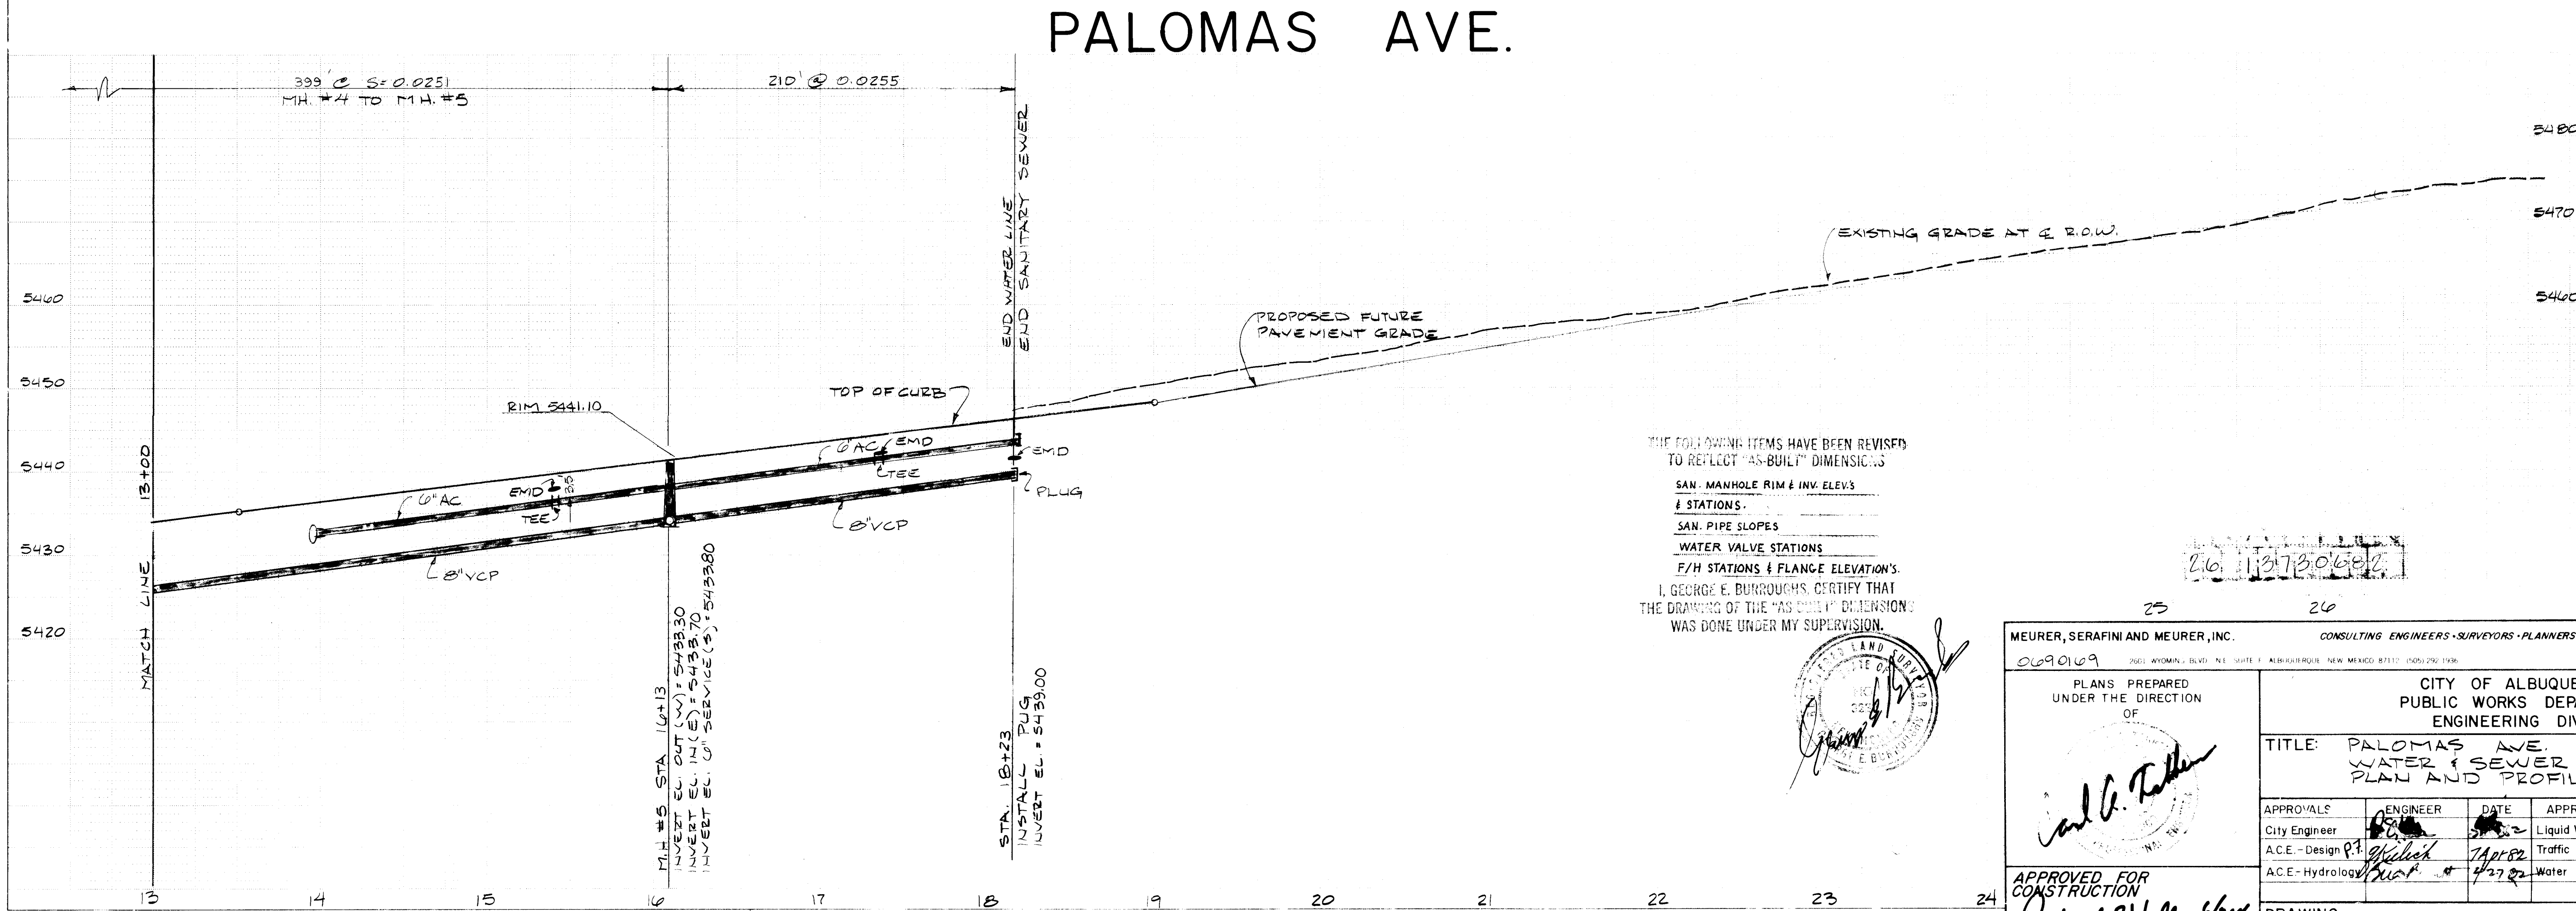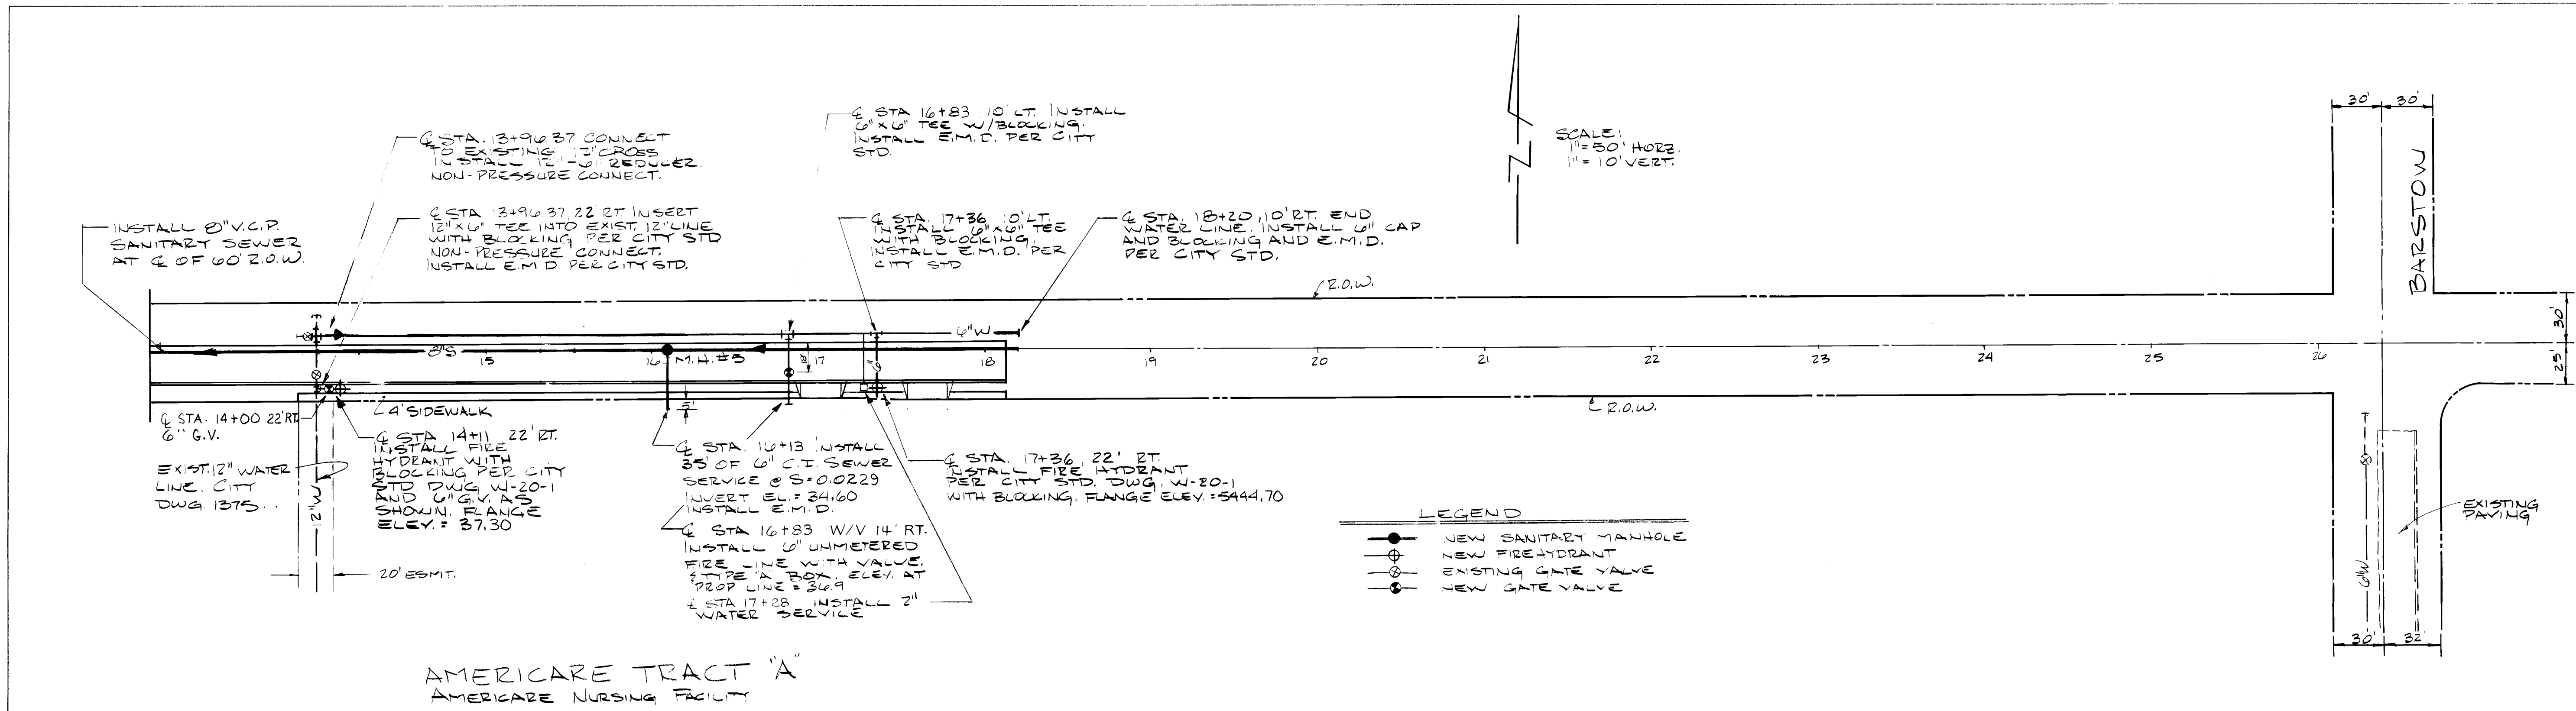

| AS BUILT INFORMATION   |               |      |     | BENCH MARKS                   |         |       |     | SURVEY INFORMATION |             |      |     | REFERENCES |          |         |    | REVISIONS |     |    |      |
|------------------------|---------------|------|-----|-------------------------------|---------|-------|-----|--------------------|-------------|------|-----|------------|----------|---------|----|-----------|-----|----|------|
| CONTRACTOR             | WORK          | DATE | NO. | CITY OF ALBUQUERQUE           | STATION | DATE  | NO. | NO.                | BY          | DATE | NO. | MAP NO.    | EST. NO. | WO. NO. | BY | DATE      | NO. | BY | DATE |
| WORK                   | STAKED BY     | DATE | NO. | "HEAVEN" LOCATED AT THE       |         | 12/81 |     |                    | TAUBERT-MSM |      |     |            |          |         |    |           |     |    |      |
| FIELD                  | ACCEPTANCE BY | DATE | NO. | ENTRANCE WAY TO THE GATE      |         |       |     |                    |             |      |     |            |          |         |    |           |     |    |      |
| DRAWINGS               | BY            | DATE | NO. | OF HEAVEN CEMETERY, STATION   |         |       |     |                    |             |      |     |            |          |         |    |           |     |    |      |
| CORRECTED BY           |               | DATE | NO. | MARK IS A STANDARD U.S. CASE  |         |       |     |                    |             |      |     |            |          |         |    |           |     |    |      |
| MICRO-FILM INFORMATION |               |      |     | BRASS "TABLET STAMPED         |         |       |     |                    |             |      |     |            |          |         |    |           |     |    |      |
|                        |               |      |     | "HEAVEN" PLANT, SET IN TOP OF |         |       |     |                    |             |      |     |            |          |         |    |           |     |    |      |
|                        |               |      |     | A CONCRETE POST FLUSH WITH    |         |       |     |                    |             |      |     |            |          |         |    |           |     |    |      |
|                        |               |      |     | THE GROUND ELEVATION 5318.79  |         |       |     |                    |             |      |     |            |          |         |    |           |     |    |      |

MEURER, SERAFINI AND MEURER, INC. CONSULTING ENGINEERS - SURVEYORS - PLANNERS

0690109 2601 AROMING BLVD. N.E. SUITE 110 ALBUQUERQUE, NEW MEXICO 87110 (505) 261-1300

PLANS PREPARED UNDER THE DIRECTION OF

CITY OF ALBUQUERQUE PUBLIC WORKS DEPARTMENT ENGINEERING DIVISION

TITLE: PALOMAS AVE. N.E. WATER & SEWER PLAN AND PROFILE

| APPROVALS          | ENGINEER           | DATE    | APPROVALS    | ENGINEER           | DATE    |
|--------------------|--------------------|---------|--------------|--------------------|---------|
| City Engineer      | <i>[Signature]</i> | 5/2/82  | Liquid Waste | <i>[Signature]</i> | 4/14/82 |
| A.C.E. - Design    | <i>[Signature]</i> | 7/14/82 | Traffic      | <i>[Signature]</i> | 7/14/82 |
| A.C.E. - Hydrology | <i>[Signature]</i> | 7/27/82 | Water        | <i>[Signature]</i> | 4/14/82 |

APPROVED FOR CONSTRUCTION

Richard S. Felt 4/24/82

CITY ENGINEER DATE

DRAWING NO. 1373

SHEET 6 OF 6