

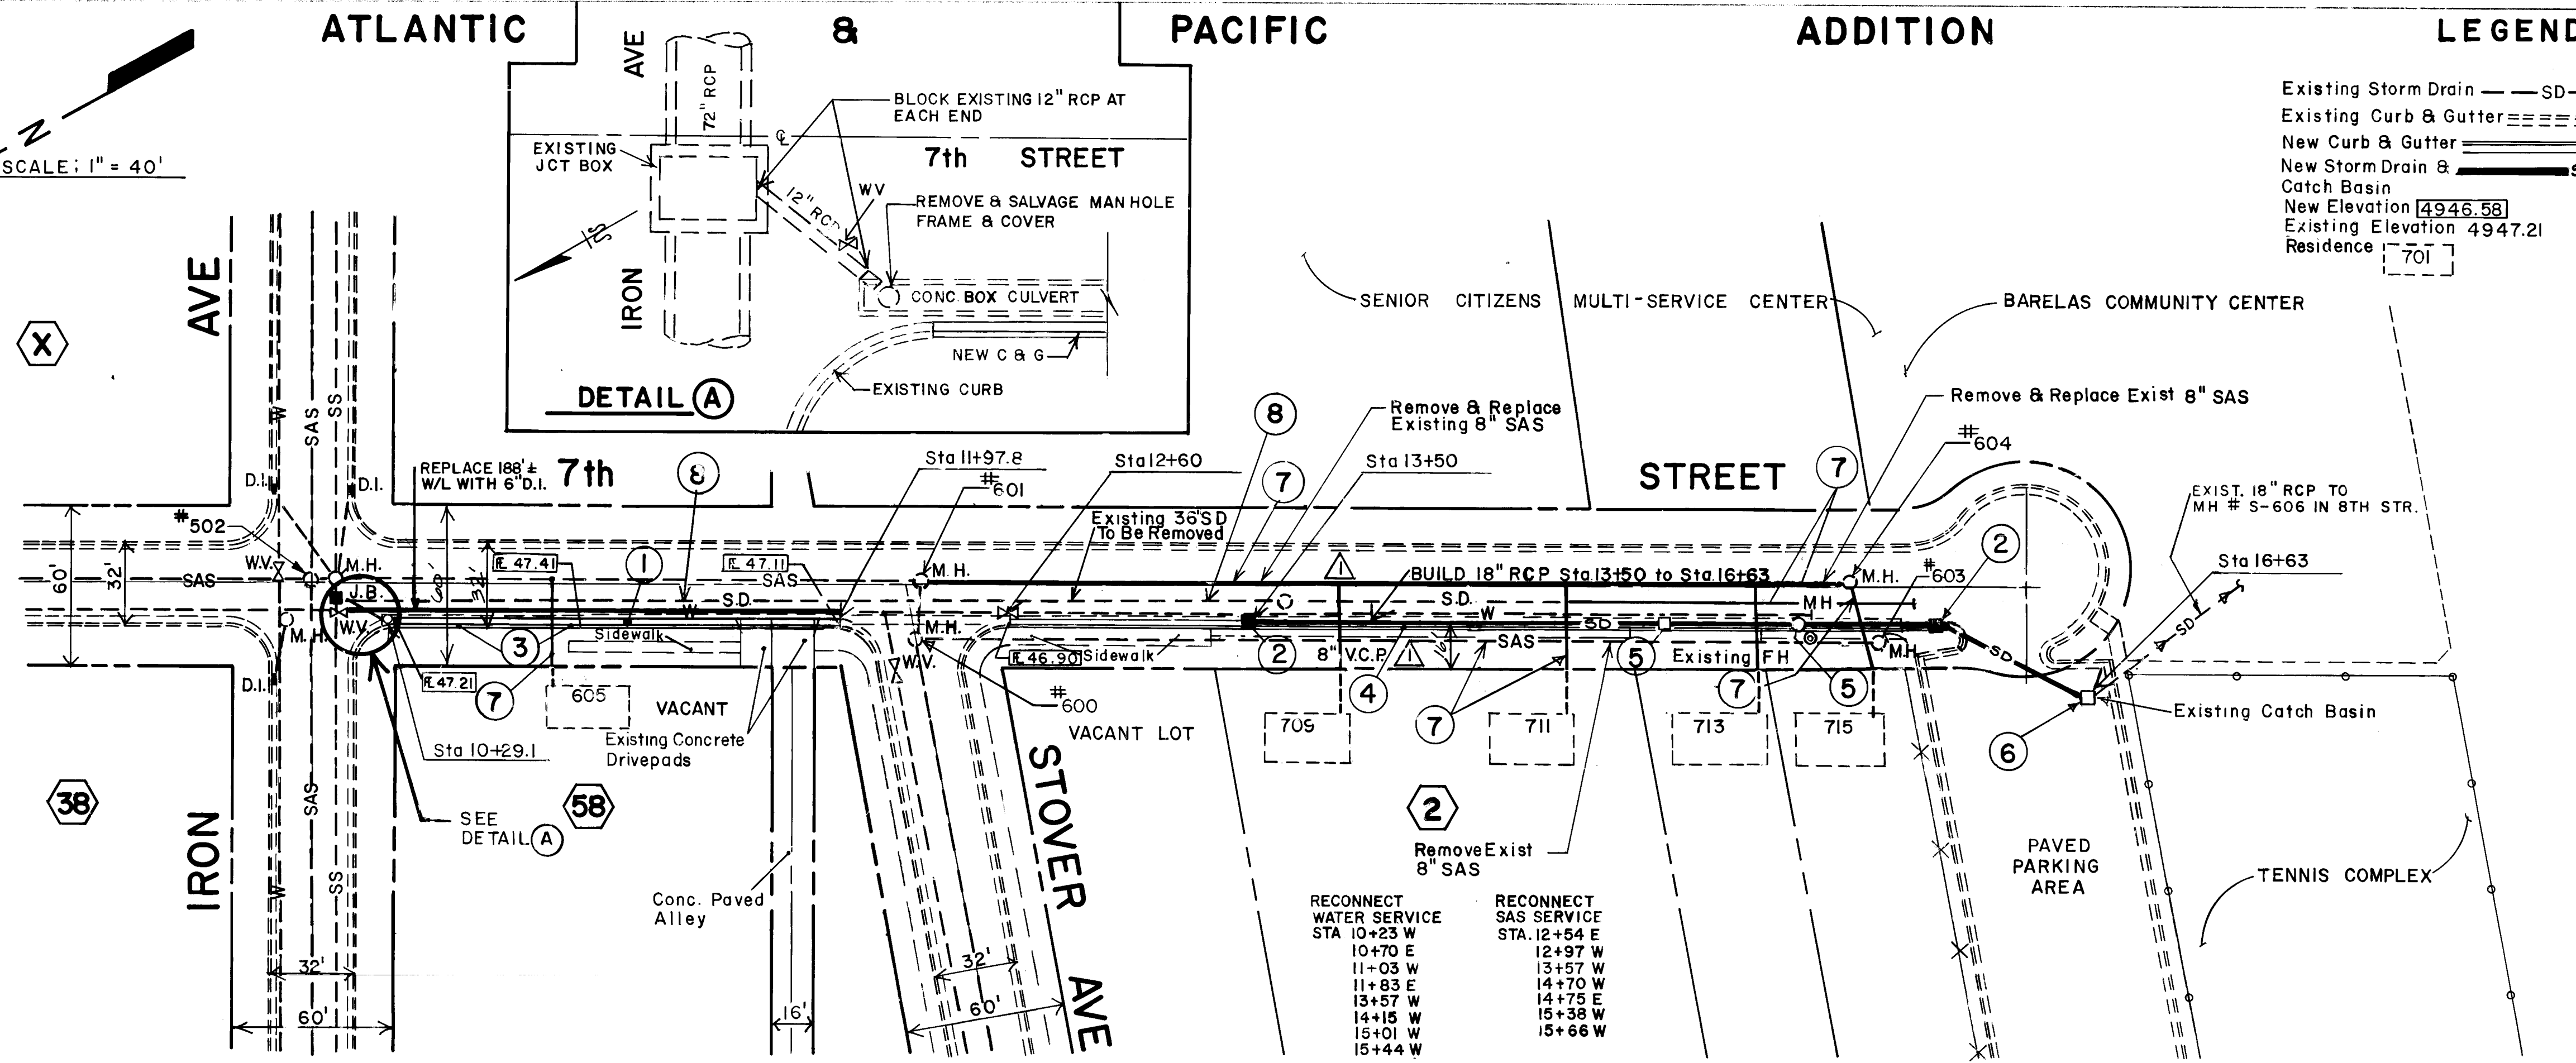


1377

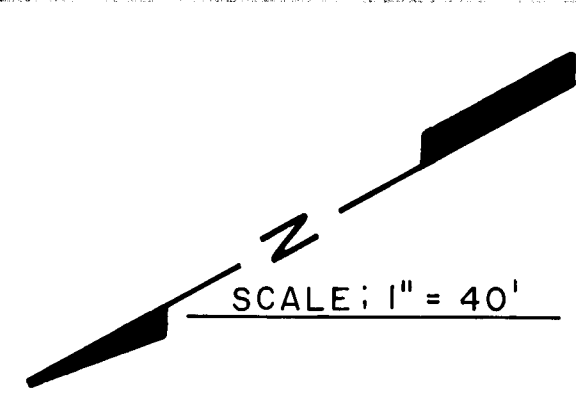

LEGEND

Existing Storm Drain — SD —
Existing Curb & Gutter — CG —
New Curb & Gutter — CG —
New Storm Drain 8" — SD —
Catch Basin
New Elevation 4946.58
Existing Elevation 4947.21
Residence 701

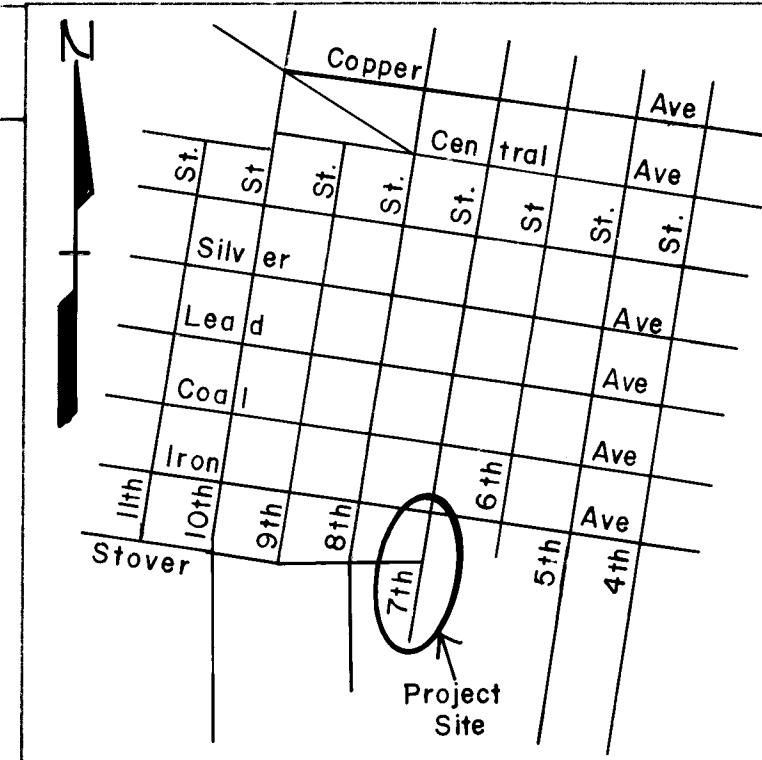

LOCATION MAP K-14

NOTICE TO CONTRACTORS


- All work detailed on these plans to be performed under contract shall, except as otherwise stated or provided for herein, be constructed in accordance with the New Mexico Standard Specifications for Public Works Construction-1979 Edition (referred to herein as the Standard Specifications) and the Contract Documents for City-Wide Utilities and Curb Paving No. 31.
- Two (2) working days prior to any excavation, the contractor must contact Line Locating Service, 765-1234, for location of existing utilities.
- Prior to construction, the contractor shall excavate and verify the horizontal and vertical locations of all obstructions. Should a conflict exist, the contractor shall notify the engineer or surveyor so that the conflict can be resolved with minimum amount of delay.

THE FOLLOWING NOTES ALSO APPLY WHEN CHECKED


- ☒ All utilities and utility service lines shall be installed prior to paving.
- ☒ Backfill compaction shall be according to specified street use.
- ☒ Tack coat requirements shall be determined by the City Engineer.
- ☒ Sidewalks and wheelchair ramps within the curb returns shall be constructed wherever a new curb return is constructed.
- ☐ If curb is depressed for a driveway or a handicap ramp, the driveway or ramp shall be constructed prior to acceptance of the curb and gutter.
- ☒ All storm drainage facilities shall be completed prior to final acceptance.

NOTES:


- Remove existing 3' X 3' Concrete Culvert from Sta. 10+29.1 to Sta. 15+96.8. Also remove curb from Sta. 10+29.1 to Sta. 16+05.
- Build single D Type inlets at Sta. 13+50 and at Sta. 16+05.
- Build new curb and gutter from Sta. 10+29.1 to 11+97.8 according to grades shown. Replace driveways to match new curb grades if necessary.
- Build new curb from Sta. 12+60 to Sta. 16+05 to match existing sidewalk and driveways.
- Remove existing S.D. Man Hole at Sta. 15+53.8 and existing catch basin at Sta. 15+14.6.
- Connect to existing catch basin per STD. DW. K-17 (1-B1).
- Remove and replace 8" SAS at @ with 8" V.C.P. Also remove 8" SAS at West curb and transfer services to new SAS.
- Remove existing 36" SD from Sta. 10+26 to Sta. 16+02.

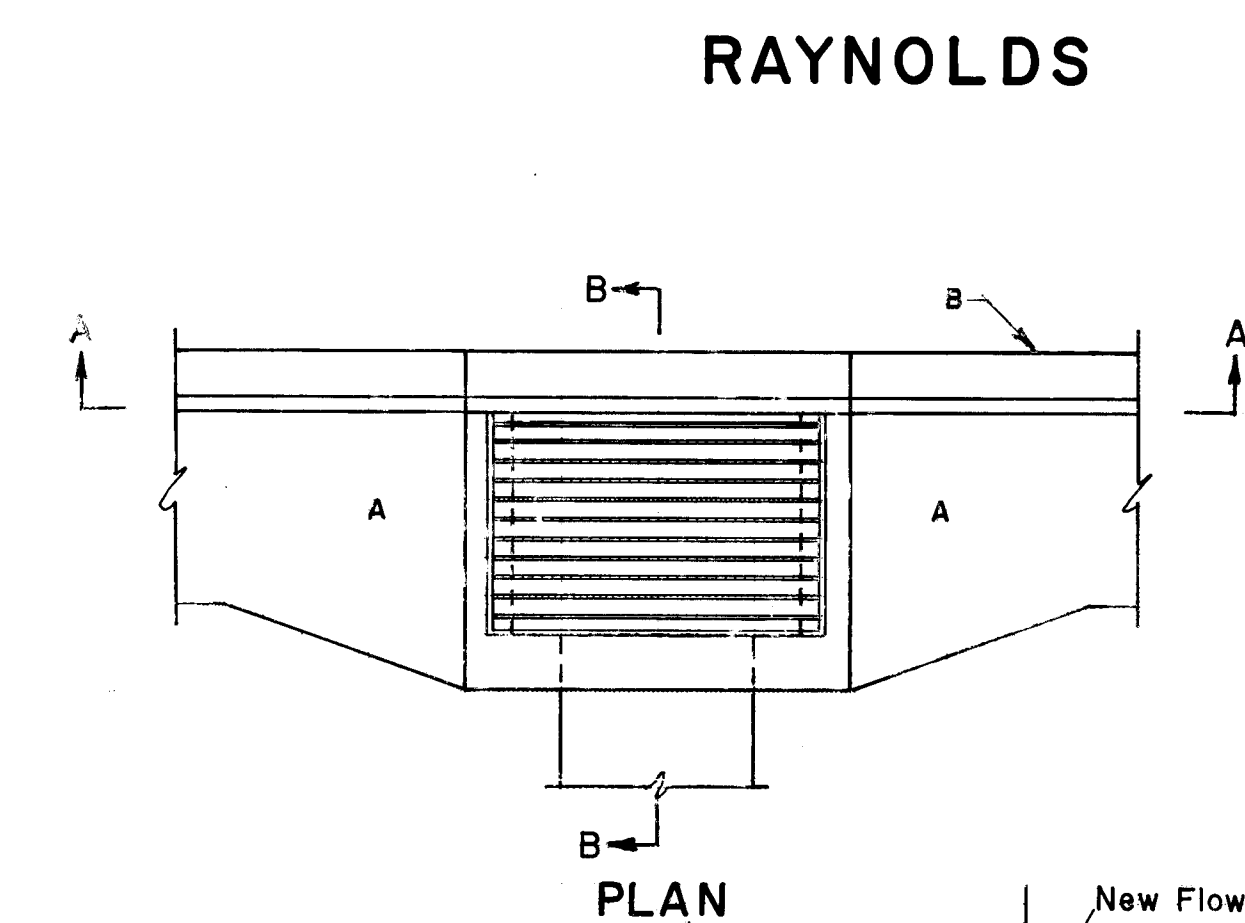

PLAN

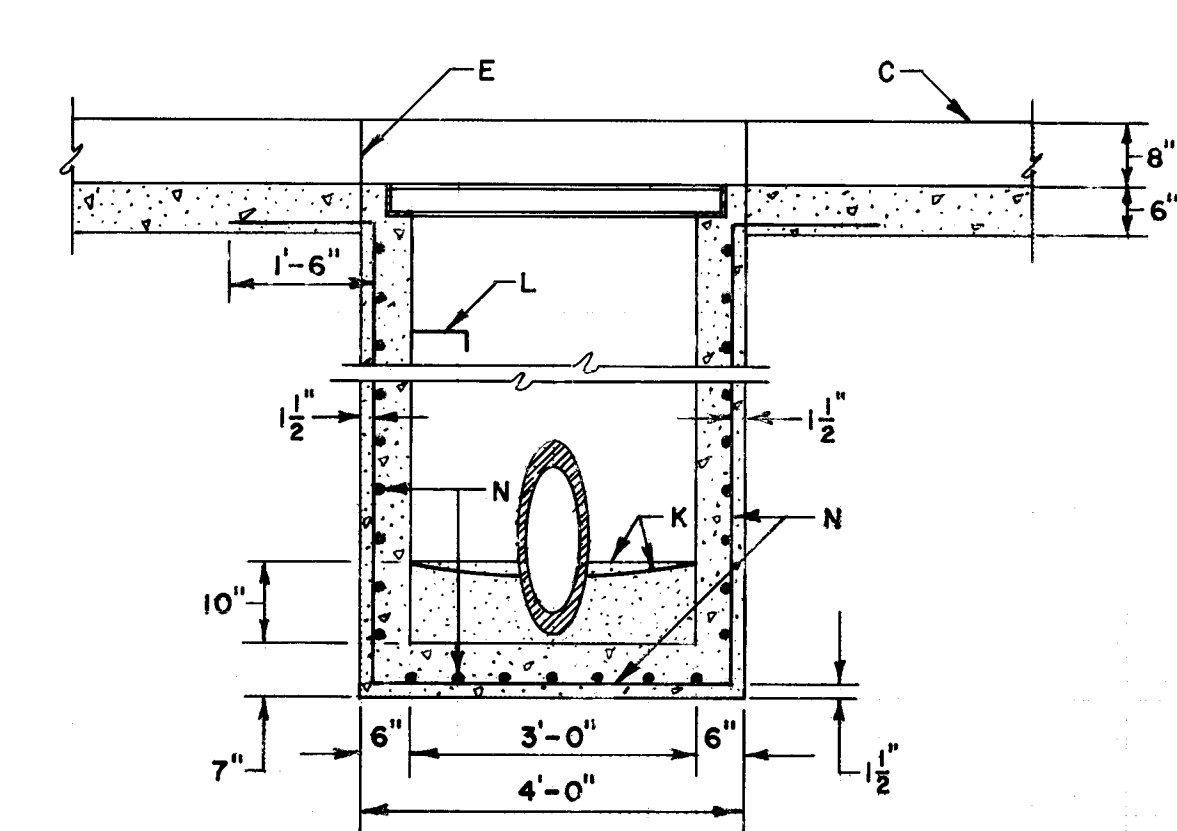


SECTION A-A

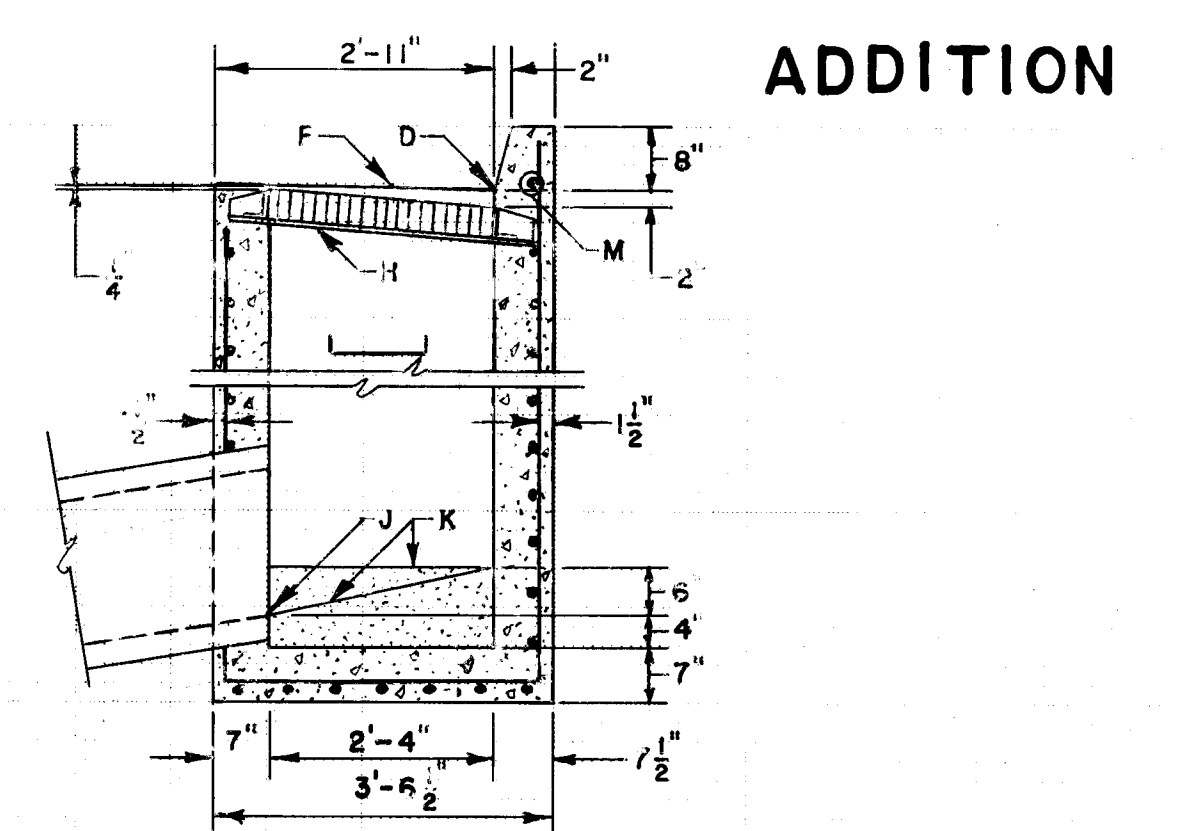

SECTION B-B

SCALE:
HORZ: 1" = 40'
VERT: 1" = 5'

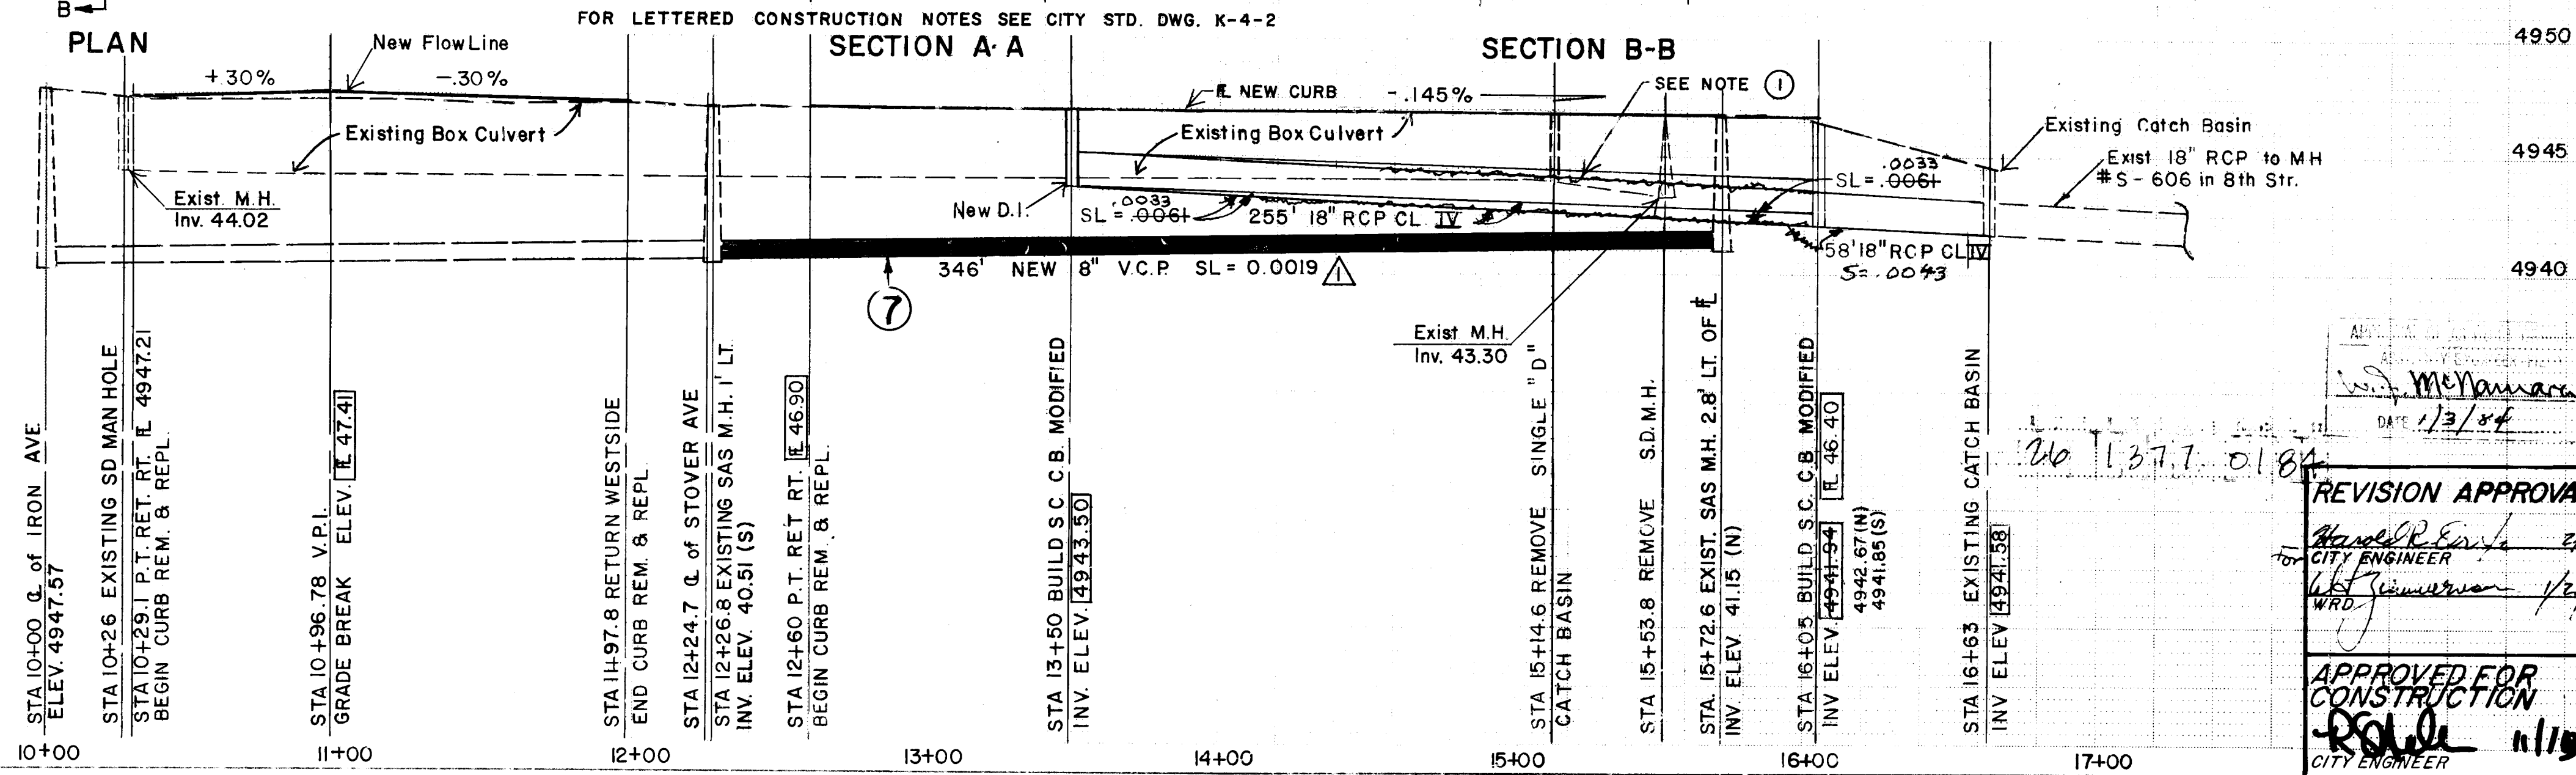

REVISION APPROVAL

APPROVED FOR CONSTRUCTION
CITY ENGINEER
DATE 11/19/82

APPROVED FOR CONSTRUCTION
CITY ENGINEER
DATE 11/19/82

CITY OF ALBUQUERQUE
MUNICIPAL DEVELOPMENT DEPARTMENT
ENGINEERING DIVISION

TITLE:
STORM DRAIN REPLACEMENT FOR 7th ST.
FROM IRON AVE TO CUL-DE-SAC

APPROVALS	ENGINEER	DATE	APPROVALS	ENGINEER	DATE
City Engineer	11/19/82		City Engineer	11/19/82	
A.C.E. Design	11/19/82		A.C.E. Design	11/19/82	
A.C.E. Hydrology	11/19/82		A.C.E. Hydrology	11/19/82	

DRAWING NO. 1377 MAP NO. K-14 SHEET 1 OF 1