



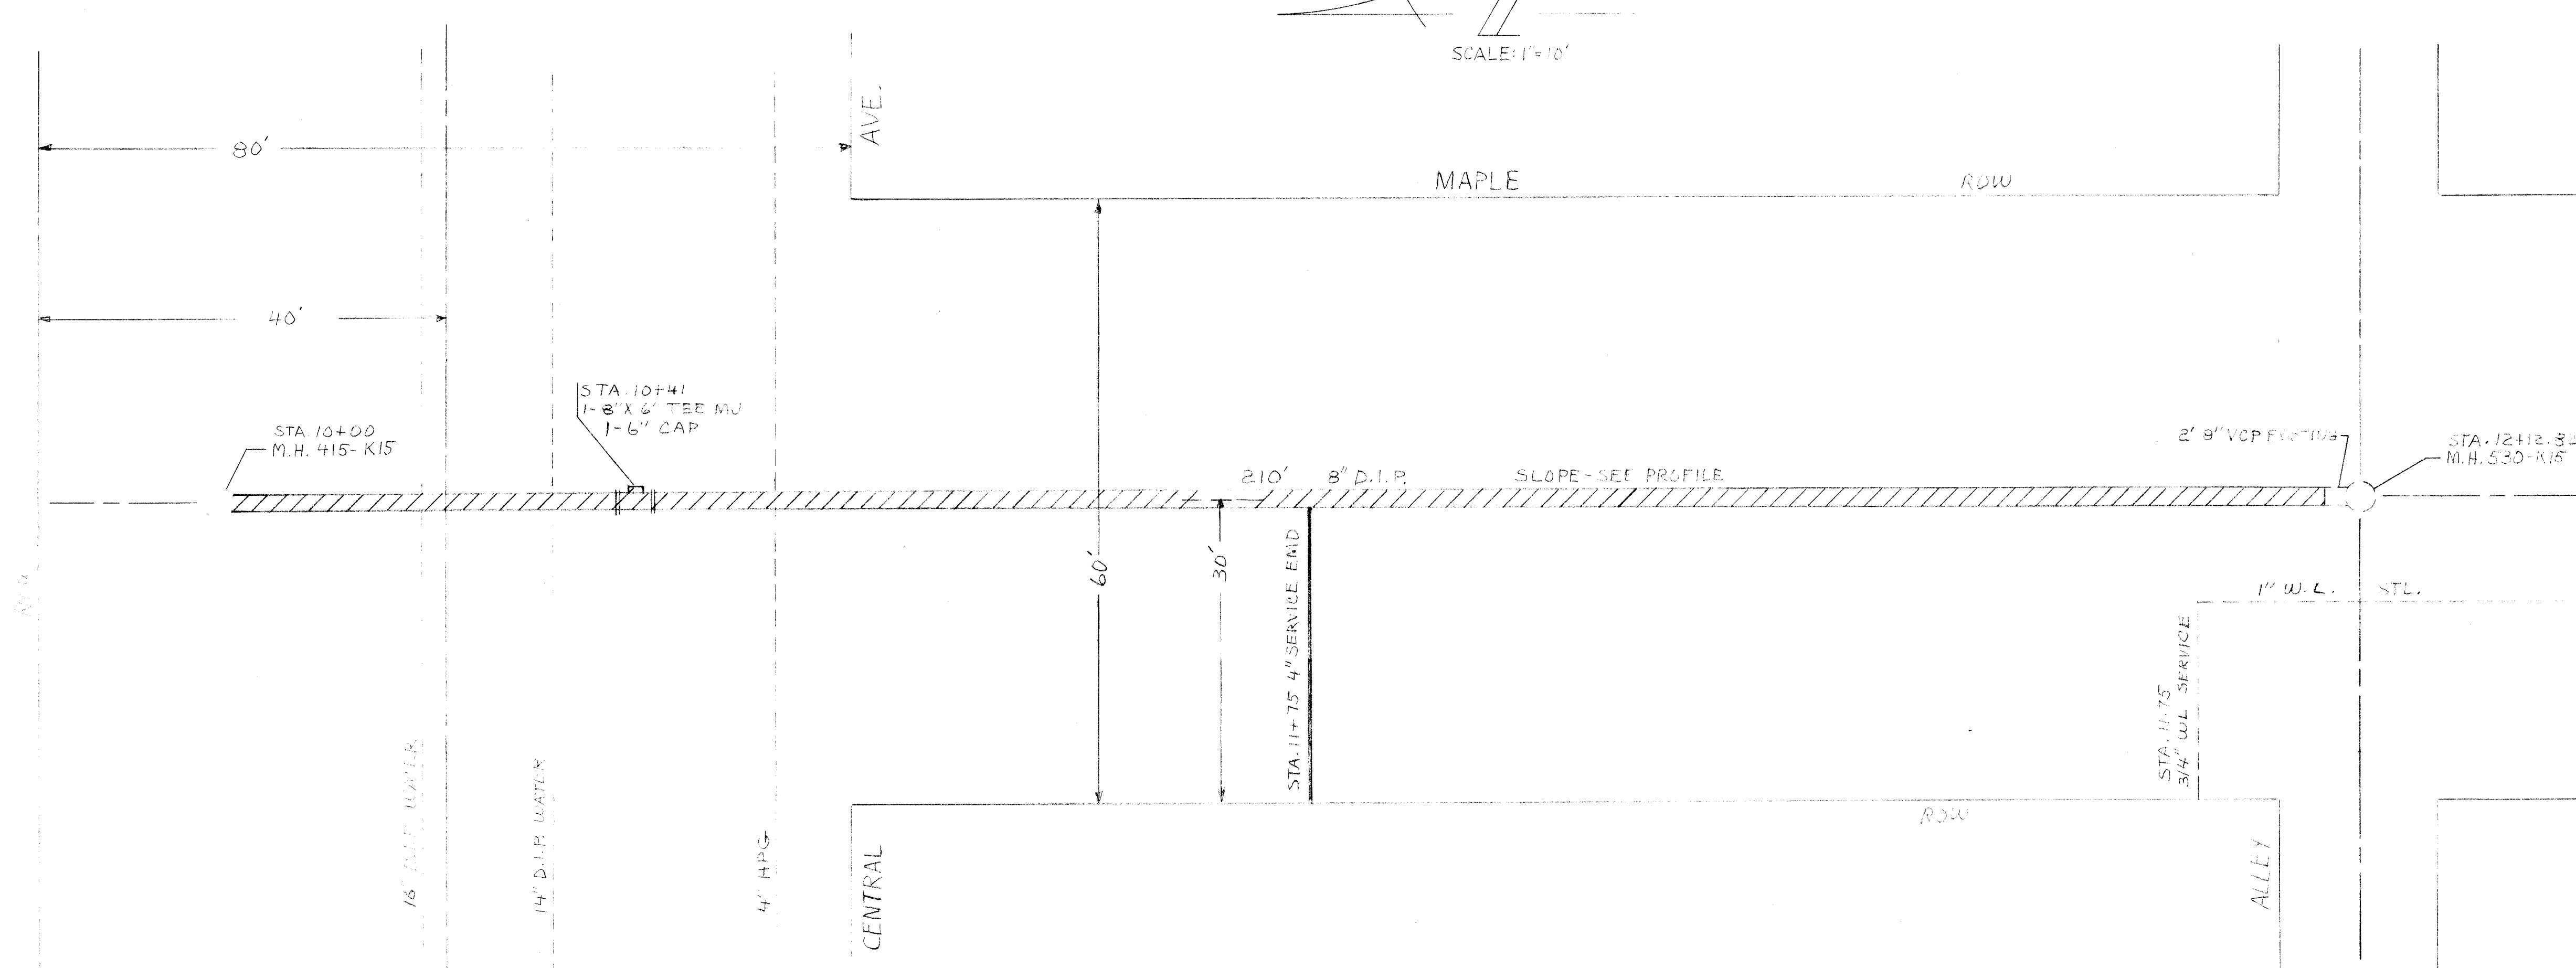

SCALE: 1"=10'

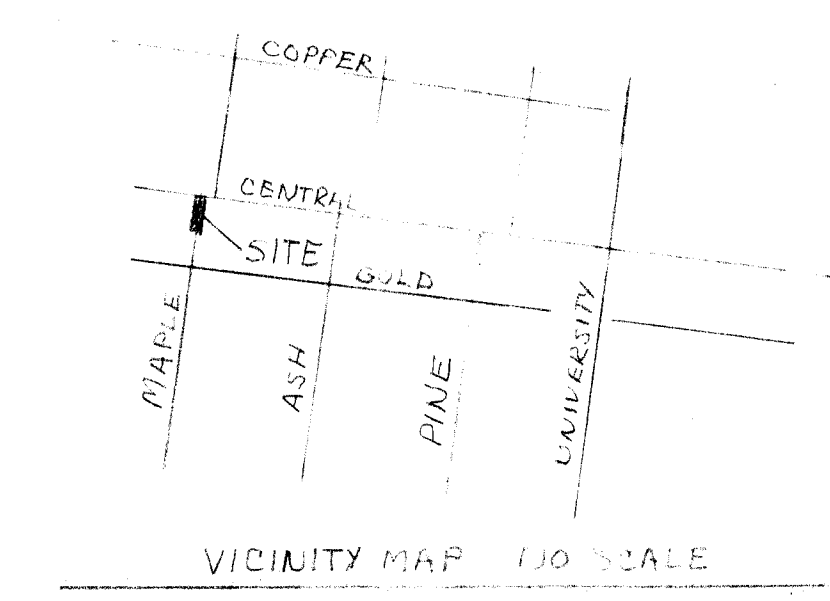

NOTICE TO CONTRACTORS

- 1) New Mexico Standard Specifications for Public Works Construction - 1979 Edition will be referred to hereon as the "Standard Specifications."
- 2) All work detailed on these plans to be performed under contract shall, except as otherwise stated or provided for hereon, be constructed in accordance with Contract Documents for City-Wide Utilities and Cash Paving No. 30 and the Standard Specifications.
- 3) Two working days prior to any excavation, contractor must contact Line Locating Service, 765-1234, for location of existing utilities.
- 4) Prior to construction, the contractor shall excavate and verify the horizontal and vertical locations of all obstructions. Should a conflict exist, the contractor shall notify the engineer or survey so that the conflict can be resolved with minimum of delay.

THE FOLLOWING NOTES APPLY WHEN CHECKED:

- ☒ All utilities and utility service lines shall be installed prior to paving.
- ☒ Backfill compaction shall be according to specified street use.
- ☒ Tack coat requirements shall be determined by the City Engineer.
- ☐ Sidewalks and wheelchair ramps within the curb returns shall be constructed wherever a new curb return is constructed.
- ☐ If curb is depressed for a driveway, the driveway shall be constructed prior to acceptance of the curb and gutter.
- ☐ All storm drain facilities shall be completed prior to final acceptance.

NOTES
1. THIS WAS BUILT COMPILED FROM FIELD NOTES & FIELD ENGINEER INSTRUCTIONS AND IS FOR INFORMATION ONLY.

5105
5100
5095
5090



1	2	3	4	5	6	7	8	9	10	11	12
26	13	83	01	82							

1	2	3	4	5	6	7	8	9	10	11	12
20	1	33	0	82							

APPROVAL OF AS BUILT DRAWINGS
ASST. CITY ENGINEER - FIELD
[Signature]
DATE 6-1-82

SAS REPLACEMENT OF LINES FROM CENTRAL AVE TO PINE ST

1383 K-15

RA Boren 4/82

6/8/82

FATTELSON