


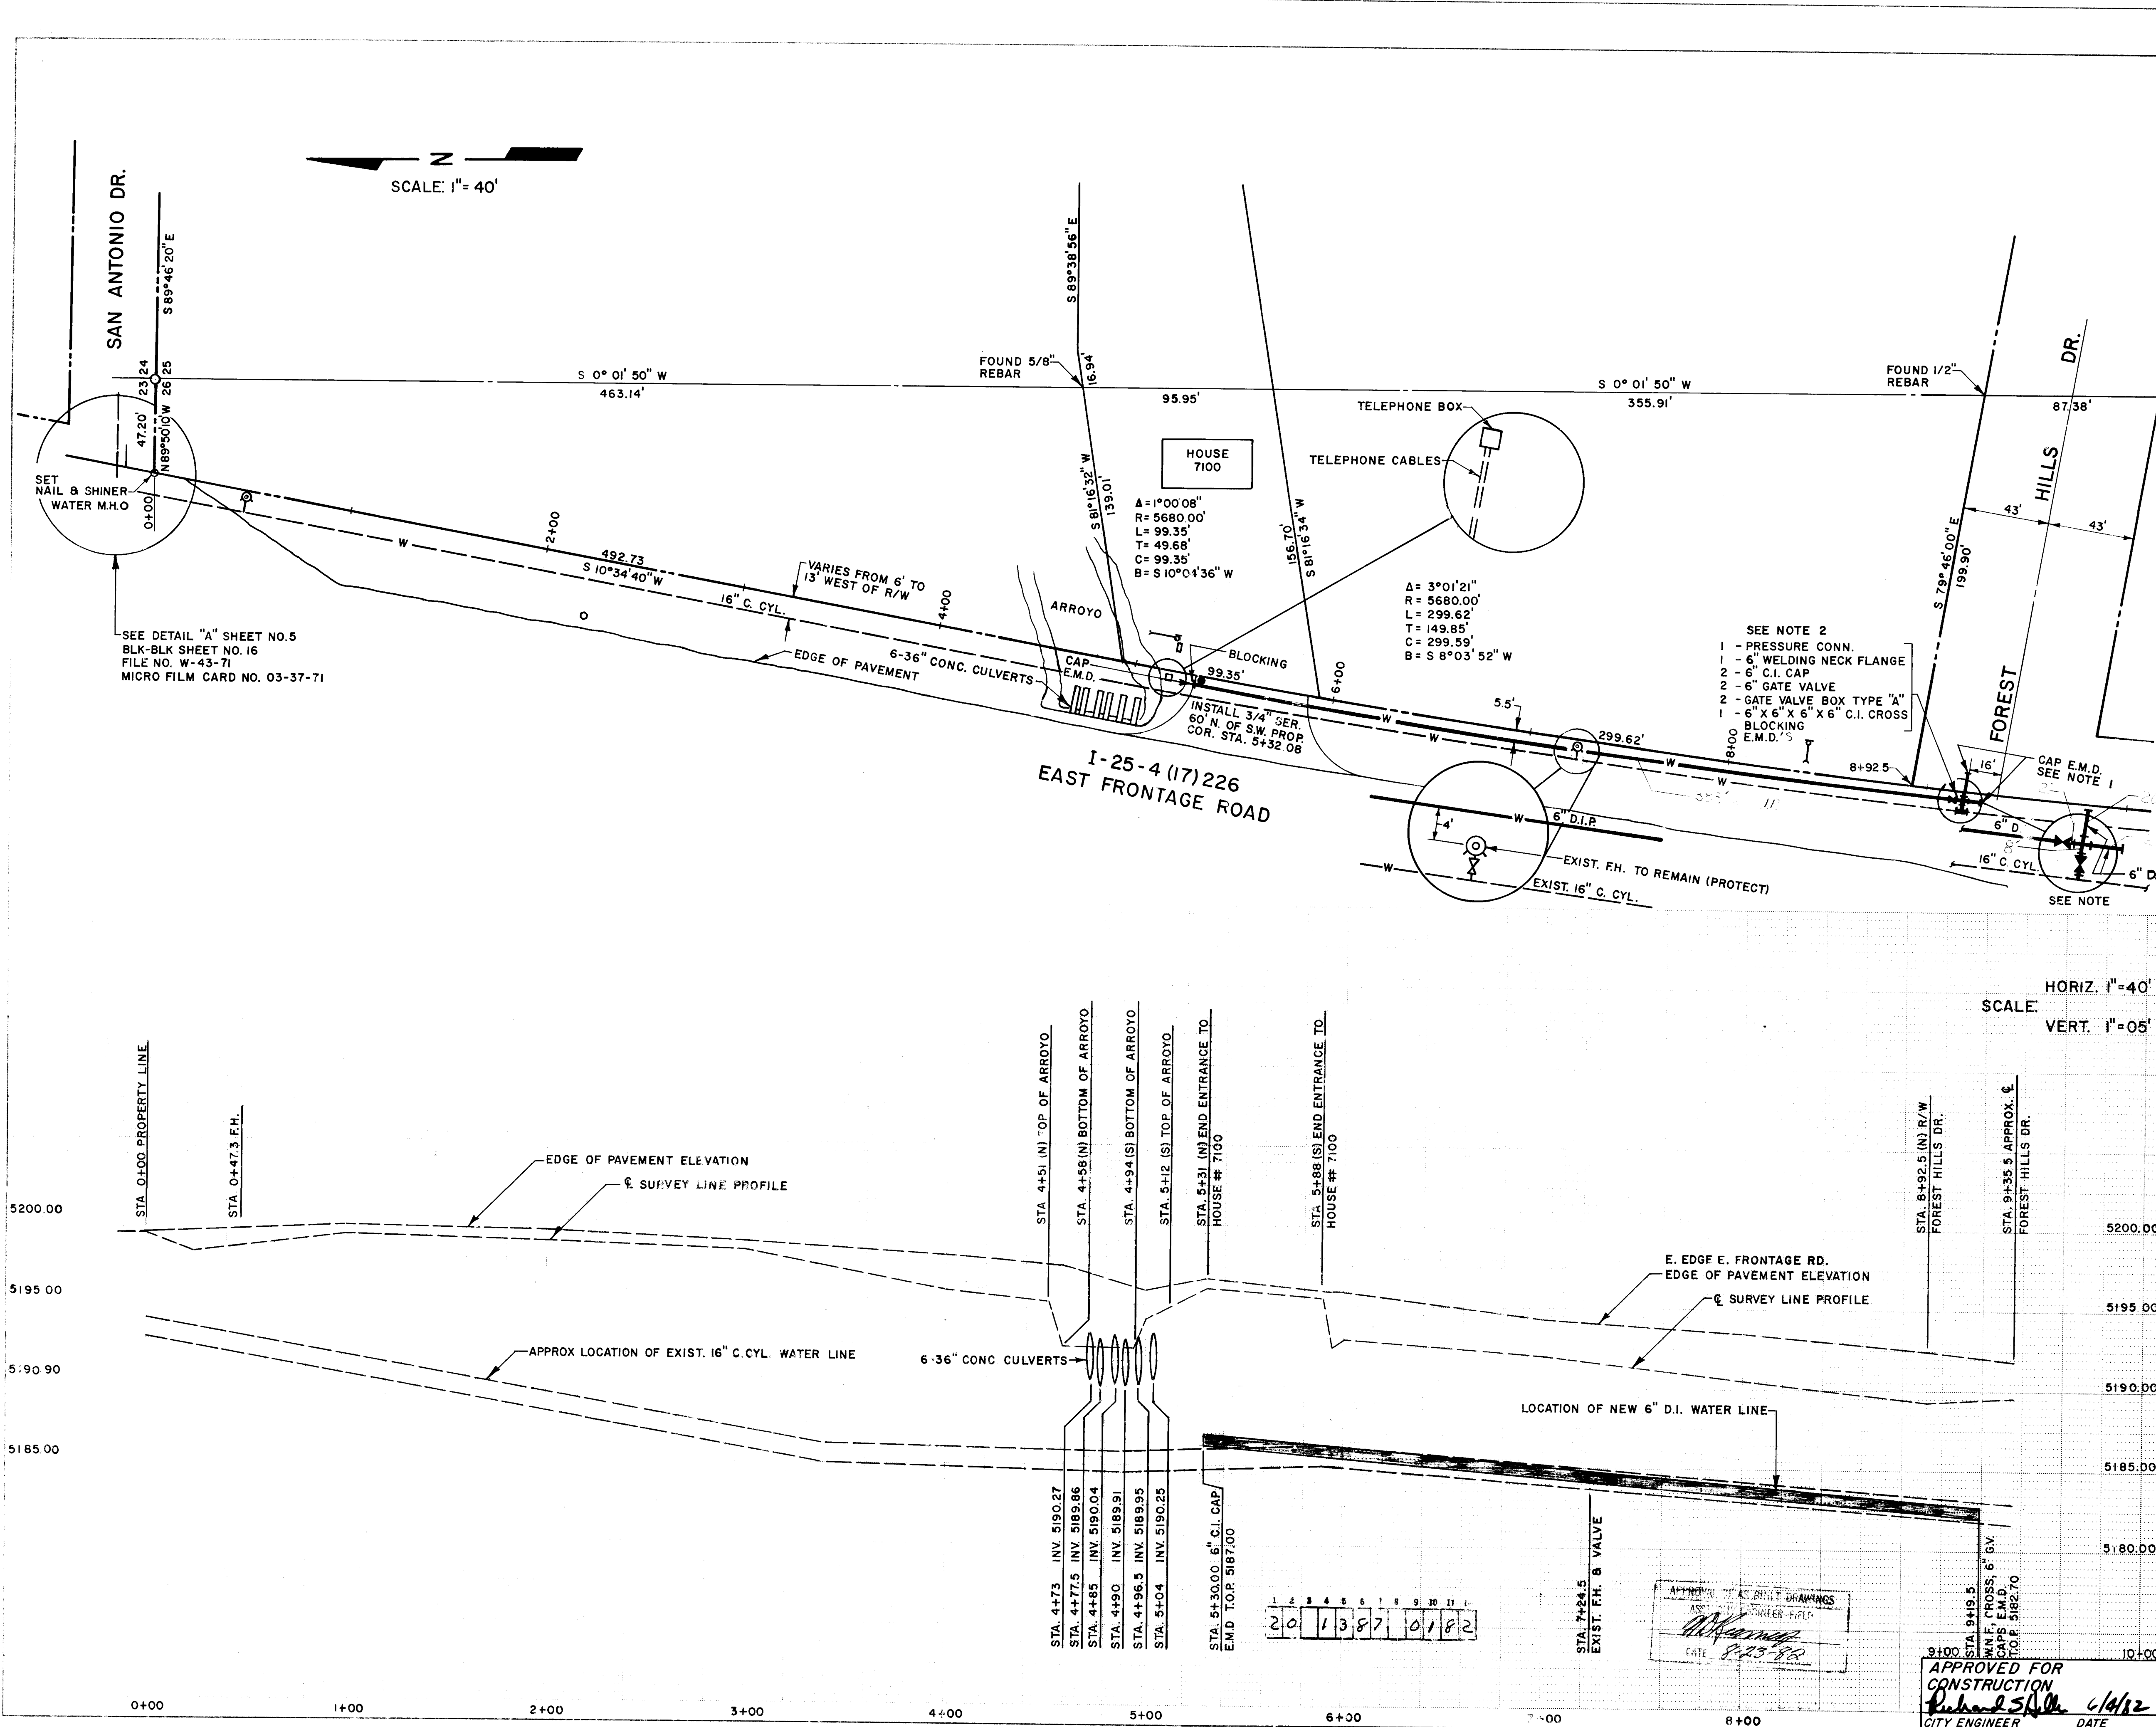

AS BUILT INFORMATION		BENCH MARKS		ENGINEER'S SEAL		REVISIONS	
NO.	DATE	NO.	DATE	NO.	DATE	NO.	DATE
1	3-15-82	1	3-15-82	1	3-15-82	1	3-15-82
2	3-15-82	2	3-15-82	2	3-15-82	2	3-15-82
3	3-15-82	3	3-15-82	3	3-15-82	3	3-15-82
4	3-15-82	4	3-15-82	4	3-15-82	4	3-15-82
5	3-15-82	5	3-15-82	5	3-15-82	5	3-15-82
6	3-15-82	6	3-15-82	6	3-15-82	6	3-15-82
7	3-15-82	7	3-15-82	7	3-15-82	7	3-15-82
8	3-15-82	8	3-15-82	8	3-15-82	8	3-15-82
9	3-15-82	9	3-15-82	9	3-15-82	9	3-15-82
10	3-15-82	10	3-15-82	10	3-15-82	10	3-15-82
11	3-15-82	11	3-15-82	11	3-15-82	11	3-15-82
12	3-15-82	12	3-15-82	12	3-15-82	12	3-15-82

NOTICE TO CONTRACTORS

- New Mexico Standard Specifications for Public Works Construction-1979 Edition will be referred to hereon as the "Standard Specification".
- All work detailed on these plans to be performed under contract shall, except as otherwise stated or provided for hereon, be constructed in accordance with "Contract Documents for City-Wide Utilities and Cash Paving No. 30 and the Standard Specification".
- Two working days prior to any excavation, contractor must contact Line Locating Service, 765-1234, for location of existing utilities.
- Prior to construction, the contractor shall excavate and verify the horizontal and vertical locations of all obstructions. Should a conflict exist, the contractor shall notify the engineer or surveyor so that the conflict can be resolved with minimum amount of delay.

THE FOLLOWING NOTES APPLY WHEN CHECKED

☐ All utilities and utility service lines shall be installed prior to paving.

☒ Backfill compaction shall be according to specified street use (Arterial).

☐ Tack coat requirements shall be determined by the City Engineer.

☐ Sidewalks and wheelchair ramps within the curb returns shall be constructed wherever a new curb return is constructed.

☐ If curb is depressed for a driveway, the driveway shall be constructed prior to acceptance of the curb and gutter.

☐ All storm drainage facilities shall be completed prior to final acceptance.

LEGEND

--- R/W LINE
--- PROPERTY LINE
--- CENTER LINE
○ BUS STOP SIGN
□ TELEPHONE BOX
□ MAIL BOX
Y POWER POLE & GUY LINE
-W- EXIST. WATER LINE & F.H.
-W- EXIST. WATER LINE & VALVE
-W- NEW WATER LINE & VALVE
-W- NEW WATER METER

NOTE:

- STUB OUT TO EAST AND SOUTH ONE PIPE LENGTH.
- CONTRACTOR TO COORDINATE TAP OF 16" CONC. CYL. LINE WITH WATER OPERATIONS. LINE MAINTENANCE. CALL ARCHIE MARTINEZ 766-7100

**CITY OF ALBUQUERQUE
MUNICIPAL DEVELOPMENT DEPARTMENT
ENGINEERING DIVISION**

TITLE:
WATER LINE EXTENSION ALONG EAST I-25 FRONTAGE RD.
NORTH OF FOREST HILLS DRIVE N.E.

APPROVALS	ENGINEER	DATE	APPROVALS	ENGINEER	DATE
City Engineer	Richard S. [Signature]	3/1/82	Liquid Waste	[Signature]	4-22-82
A.C.E. - Design	[Signature]	3/1/82	Traffic	[Signature]	4-22-82
A.C.E. - Hydrology	[Signature]	3/1/82	Water	[Signature]	4-22-82

APPROVED FOR CONSTRUCTION
CITY ENGINEER
DATE 4/1/82

APPROVED FOR CONSTRUCTION
CITY ENGINEER
DATE 4/1/82

DRAWING NO. 1387
MAP NO. E-17
SHEET 1 OF 1