


WATER

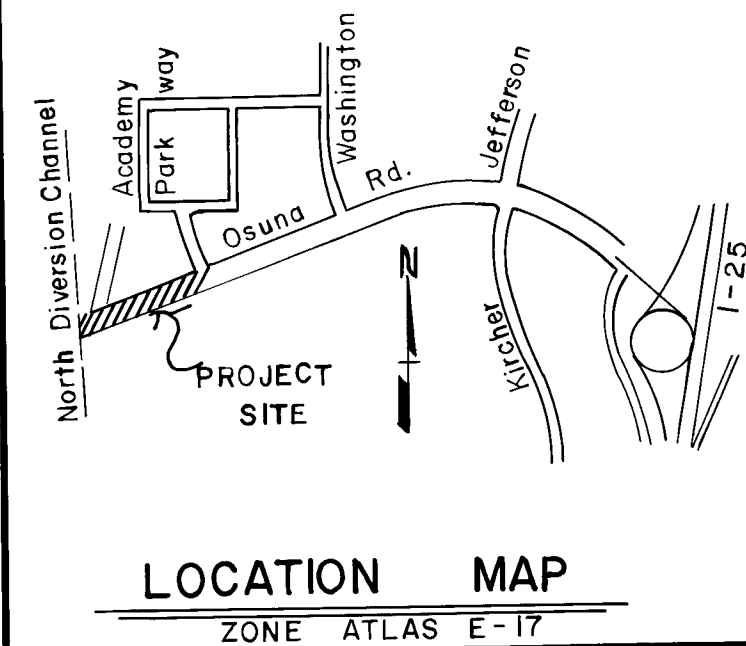

OSUNA ROAD N.E.
BETWEEN
NORTH DIVERSION CHANNEL & ACADEMY

DESCRIPTION

12" WATER LINE & 8" FIRE LINE TO SERVE
LOTS 1A & 1B BLOCK A of
THE INTERSTATE INDUSTRIAL PARK
UNIT 2

INDEX

Sheet	Description
1 of 2	TITLE SHEET
2 of 2	PLAN & PROFILE

"NOTICE TO CONTRACTORS"

- 1) New Mexico Standard Specification for Public Works Construction - 1979 Edition will be referred to herein as the "Standard Specification."
- 2) All work detailed on these plans to be performed under contract shall, except as otherwise stated or provided for herein, be constructed in accordance with "Contract Documents for City-Wide Utilities and Cash Paving No. 30" and the Standard Specification."
- 3) Two working days prior to any excavation, contractor must contact Line Locating Service, 763-1234, for location of existing utilities.
- 4) Prior to construction, the contractor shall excavate and verify the horizontal and vertical locations of all obstructions. Should a conflict exist, the contractor shall notify the engineer or surveyor so that the conflict can be resolved with minimum amount of delay.

THE FOLLOWING NOTES APPLY WHEN CHECKED.

- ☒ All utilities and utility service lines shall be installed prior to paving.
- ☒ Backfill compaction shall be according to specified street use. (ARTERIAL)
- ☒ Tack coat requirements shall be determined by the City Engineer.
- ☐ Sidewalks and wheelchair ramps within the curb returns shall be constructed whenever a new curb return is constructed.
- ☐ If curb is depressed for a driveway, the driveway shall be constructed prior to acceptance of the curb and gutter.
- ☐ All storm drainage facilities shall be completed prior to final acceptance.

TRAFFIC HANDLING NOTES

1. CONTRACTOR MUST SUBMIT A CONSTRUCTION SIGNING AND BARRICADING PLAN TO TRAFFIC ENGINEERING DIVISION AND RECEIVE A BARRICADING PERMIT PRIOR TO CONSTRUCTION.
2. ALL CONSTRUCTION SIGNING AND BARRICADING TO COMPLY WITH MANUAL ON UNIFORM TRAFFIC CONTROL DEVICES, 1978 EDITION.
3. CONTRACTOR'S OPERATION, BARRICADING AND SIGNING SHALL NOT AFFECT THRU LANES OF OSUNA BLVD. BETWEEN 7 A.M. AND 9 A.M. OR 4 P.M. AND 6 P.M.
4. EAST BOUND LANES ON OSUNA CANNOT BE CLOSED EXCEPT BY PERMISSION OF CITY TRAFFIC ENGINEER.



APPROVED FOR
CONSTRUCTION
1/9/83

16 14070180

APPROVED FOR
CONSTRUCTION
ENGINEER
1/9/83
DATE

DRAWING
NO. 1407

SHEET OF
1 2

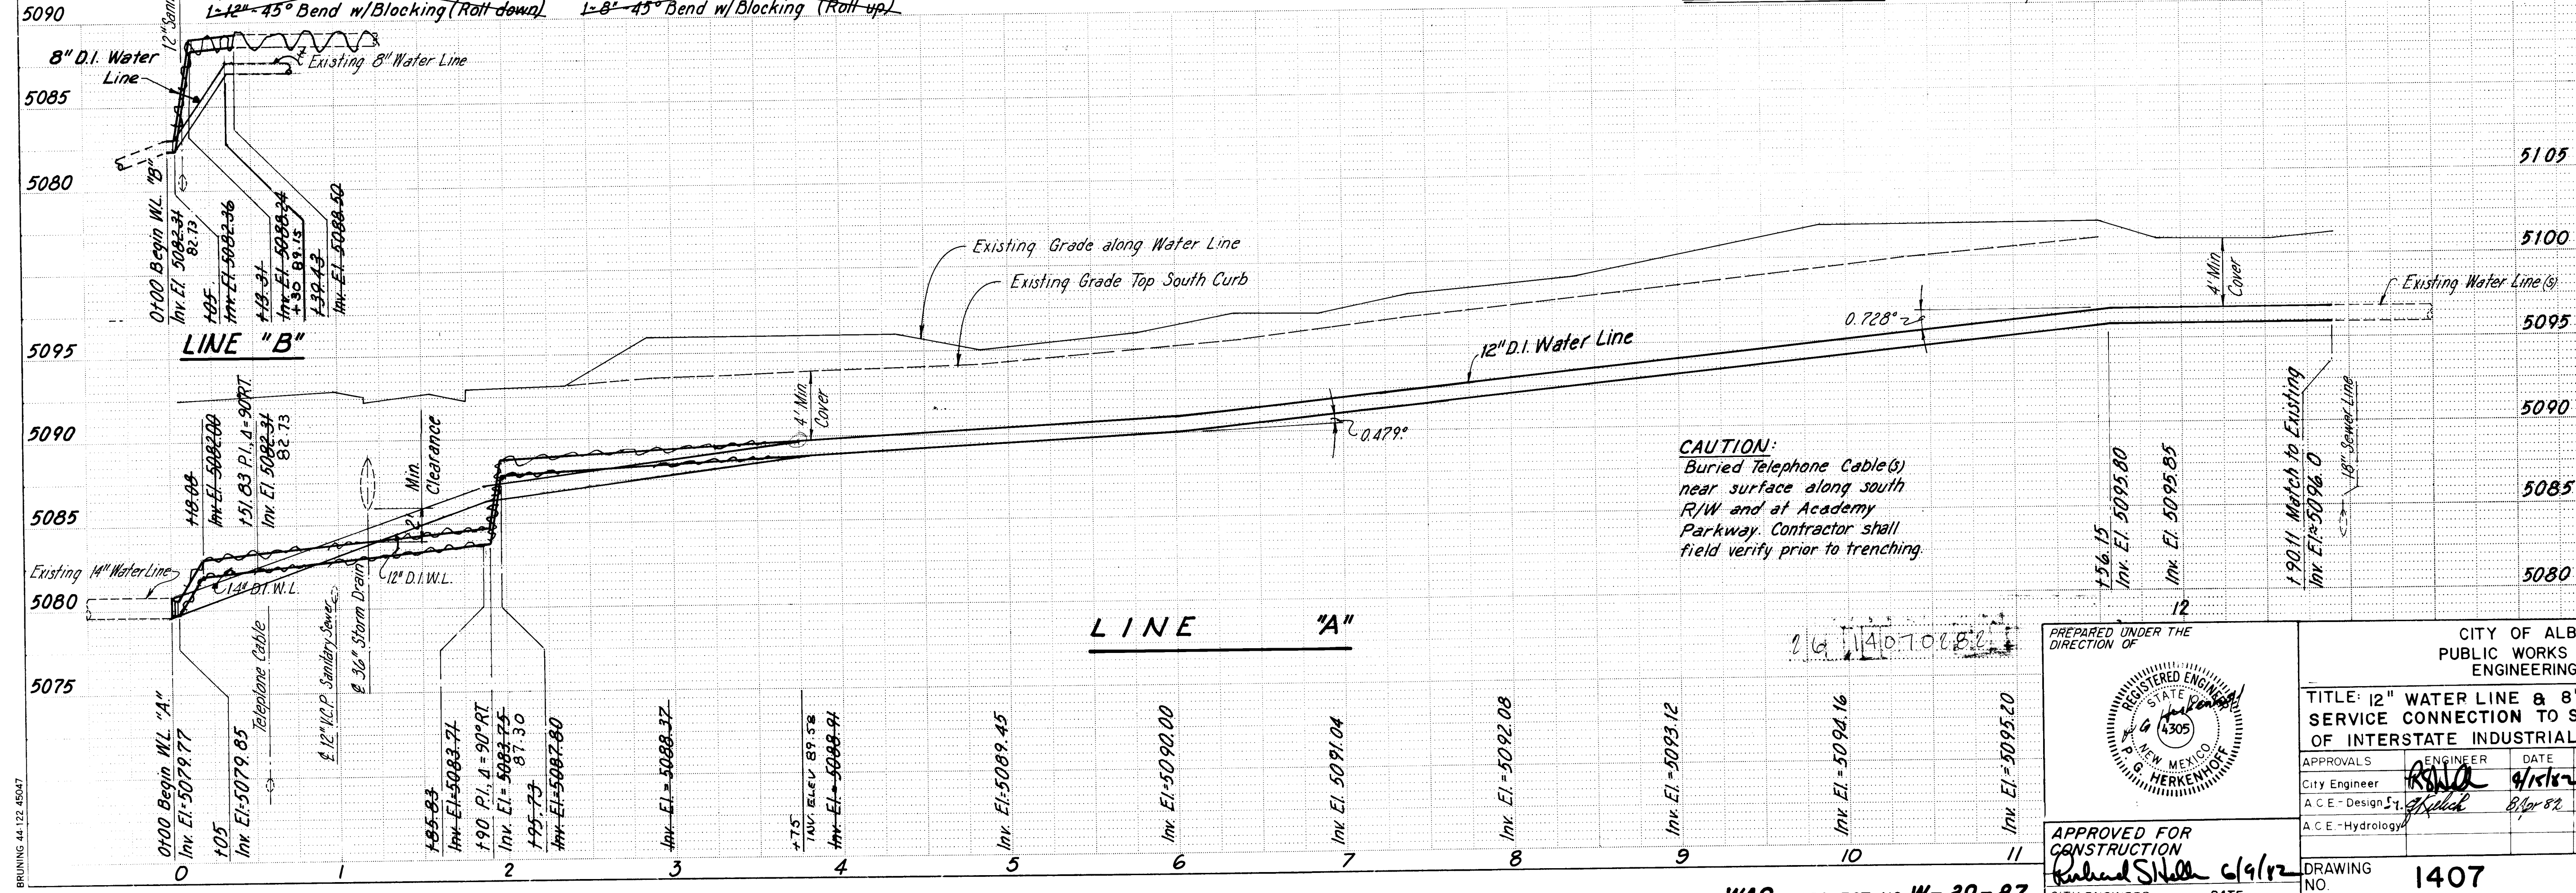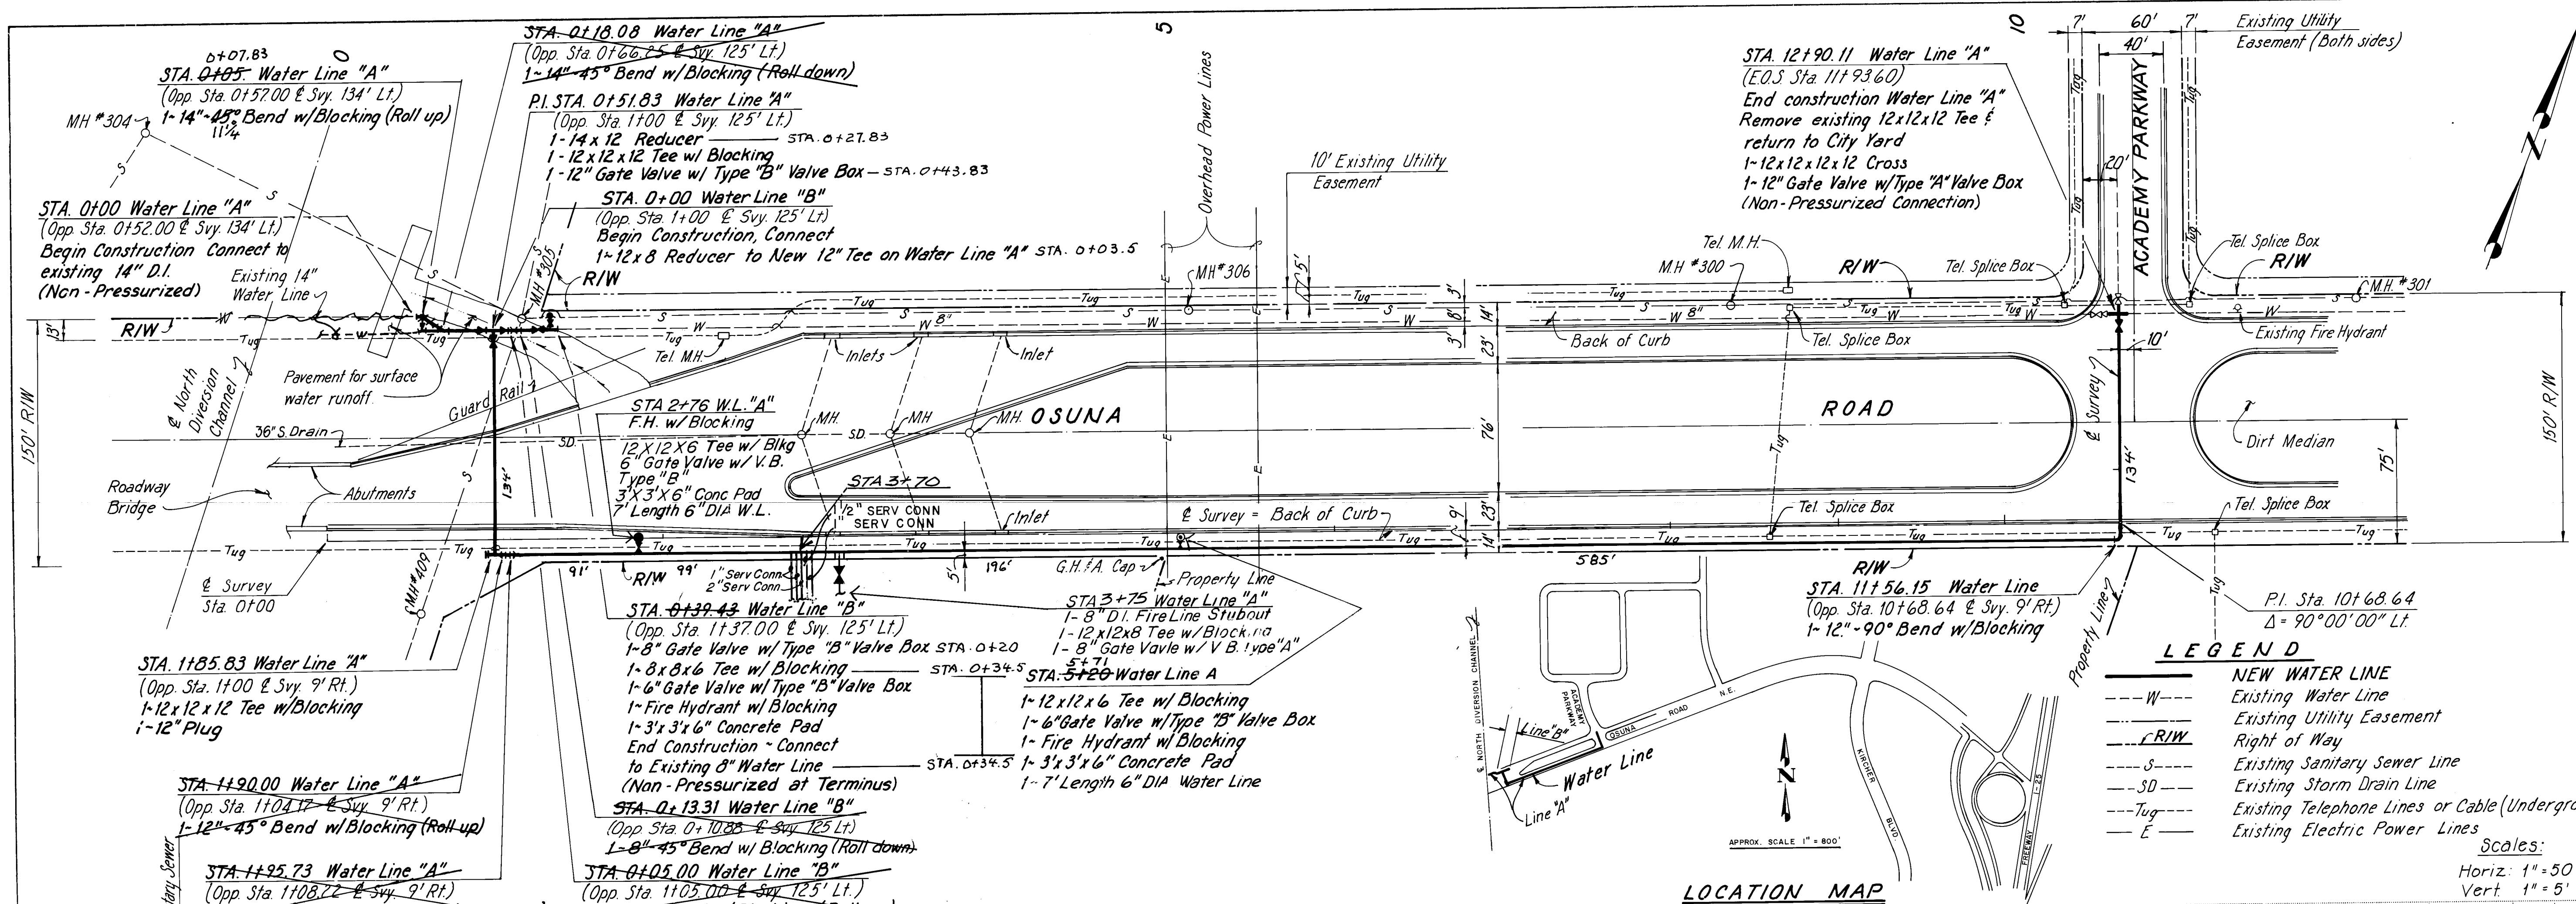

CITY OF ALBUQUERQUE PUBLIC WORKS DEPARTMENT ENGINEERING DIVISION		
TITLE: 12" WATER LINE & 8" FIRE LINE W/ METERED SERVICE CONNECTION TO SERVE LOTS 1A & 1B BLK A OF INTERSTATE INDUSTRIAL PARK UNIT 2.		
APPROVALS	ENGINEER	DATE
City Engineer	<i>[Signature]</i>	9/15/12
A.C.E. - Design	<i>[Signature]</i>	8/1/12
A.C.E. - Hydrology		
DRAWING NO. 1407		SHEET 2 OF 2

APPROVED FOR CONSTRUCTION
[Signature] 6/9/12
CITY ENGINEER DATE

AS BUILT INFORMATION		BENCH MARKS		SURVEY INFORMATION		REFERENCES		REVISIONS	
CONTRACT NO.	DATE	5E-17	S. side of Osuna, chiseled square in curb, 990' East of North Division Channel Crossing. ELEV = 5099.057	FIELD NOTES	DATE	MAP NO. E-17	EST. NO.	NO.	DATE
STATIONED BY	DATE			BY				BY	DATE
ACCEPTANCE BY	DATE			NO.				REMARKS	DATE
FIELD OBSERVATION BY	DATE			W.O. NO.				DESIGN	DATE
DRAWINGS	DATE							CHECKED BY	DATE
CORRECTED BY	DATE								
MICRO-FILM INFORMATION	DATE								
RECORDED BY	DATE								
NO.									