
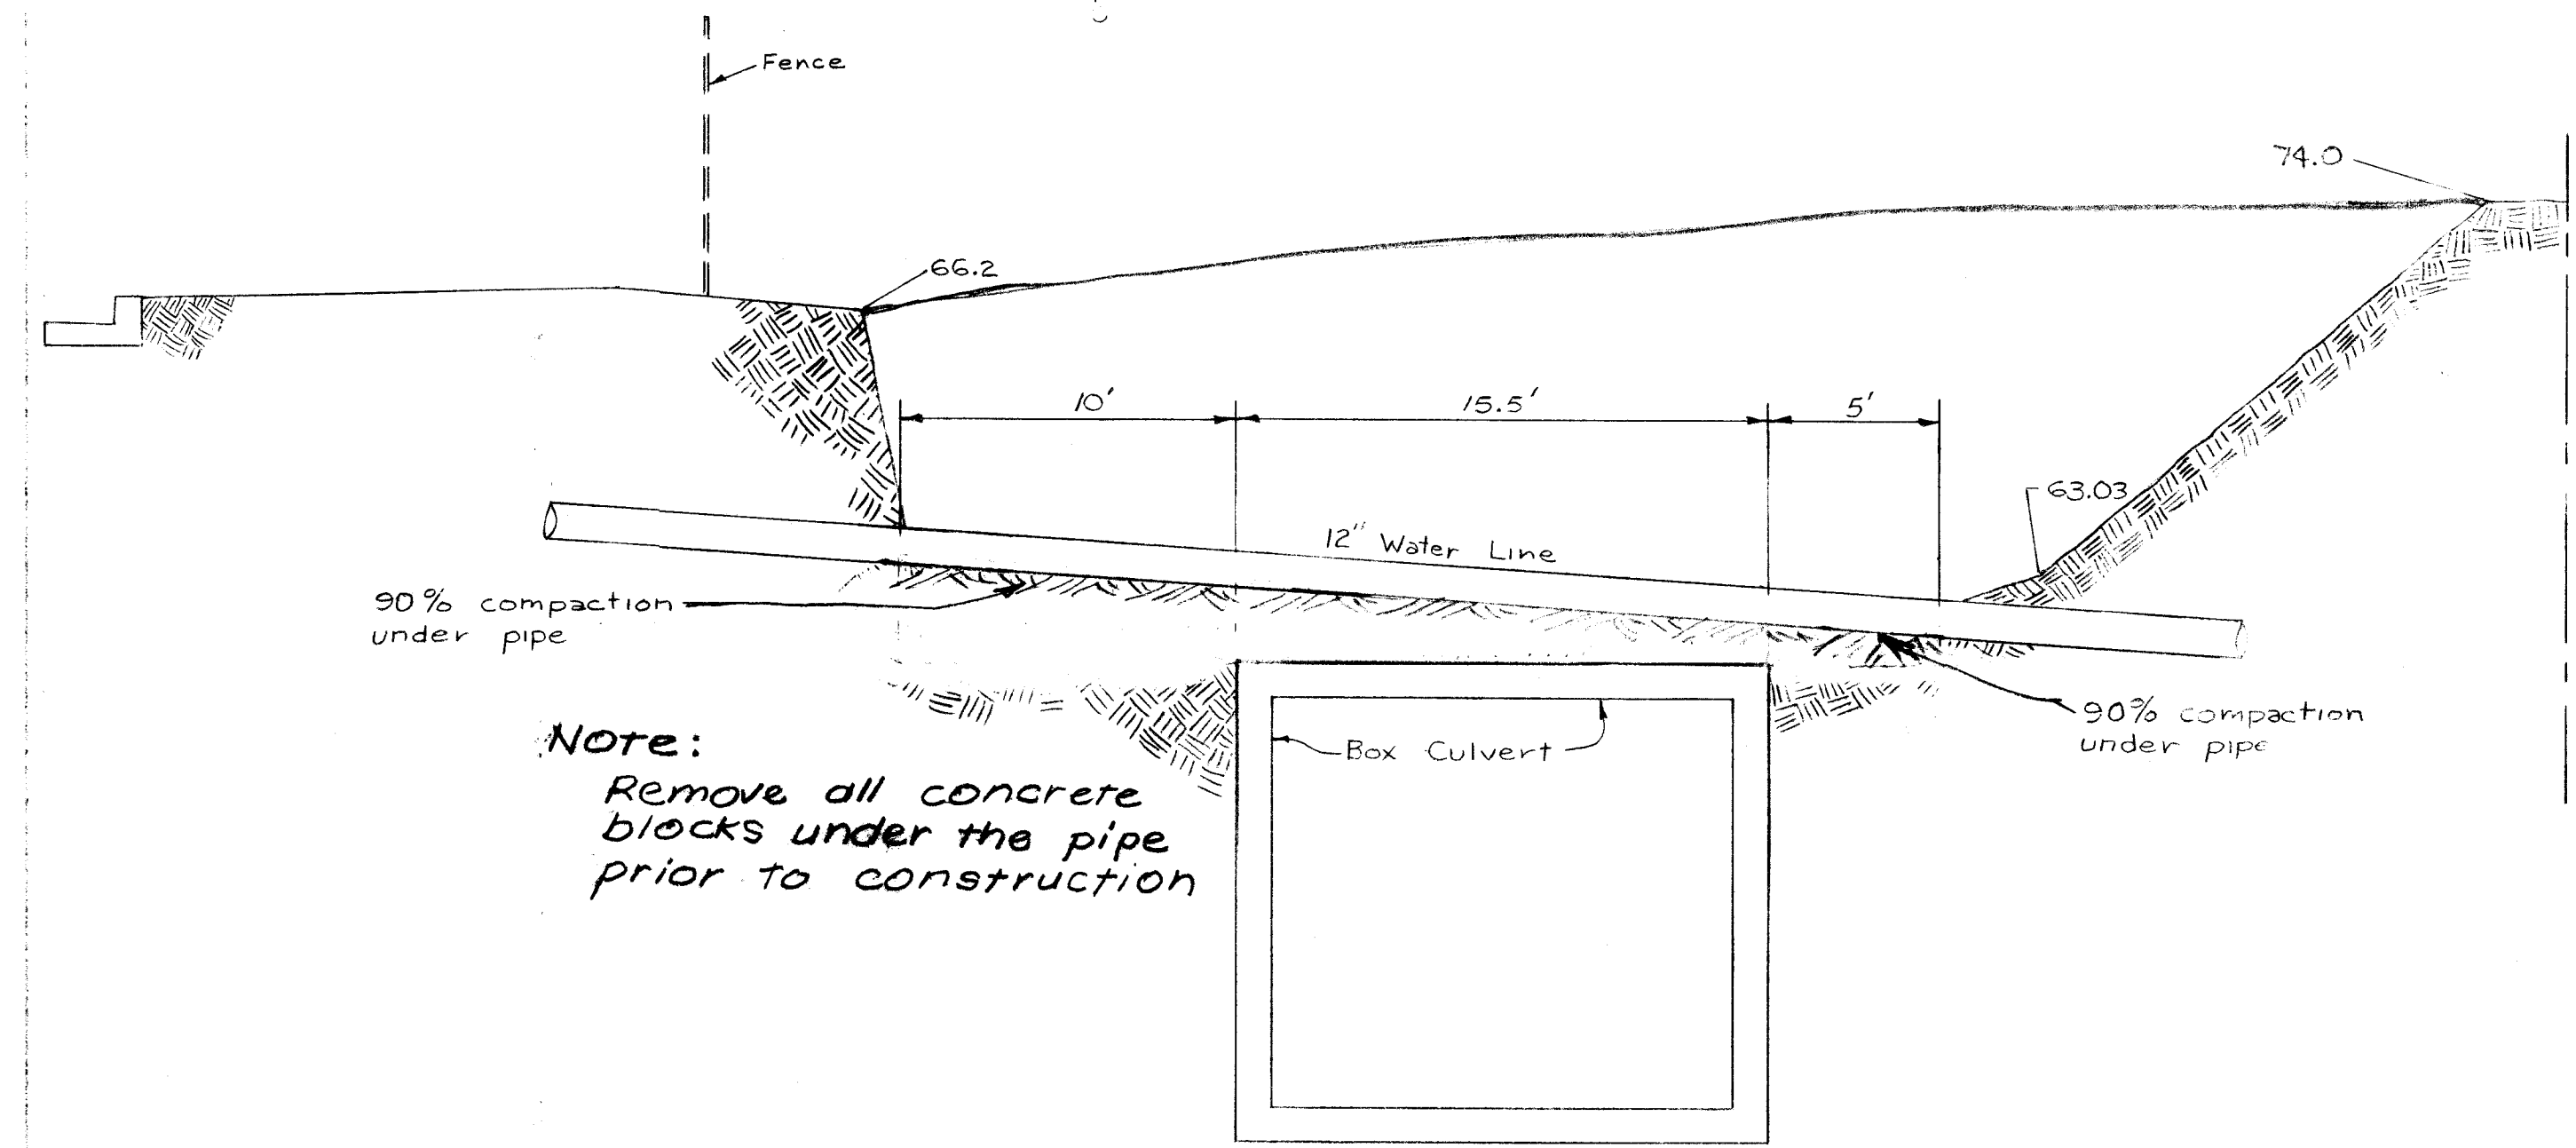
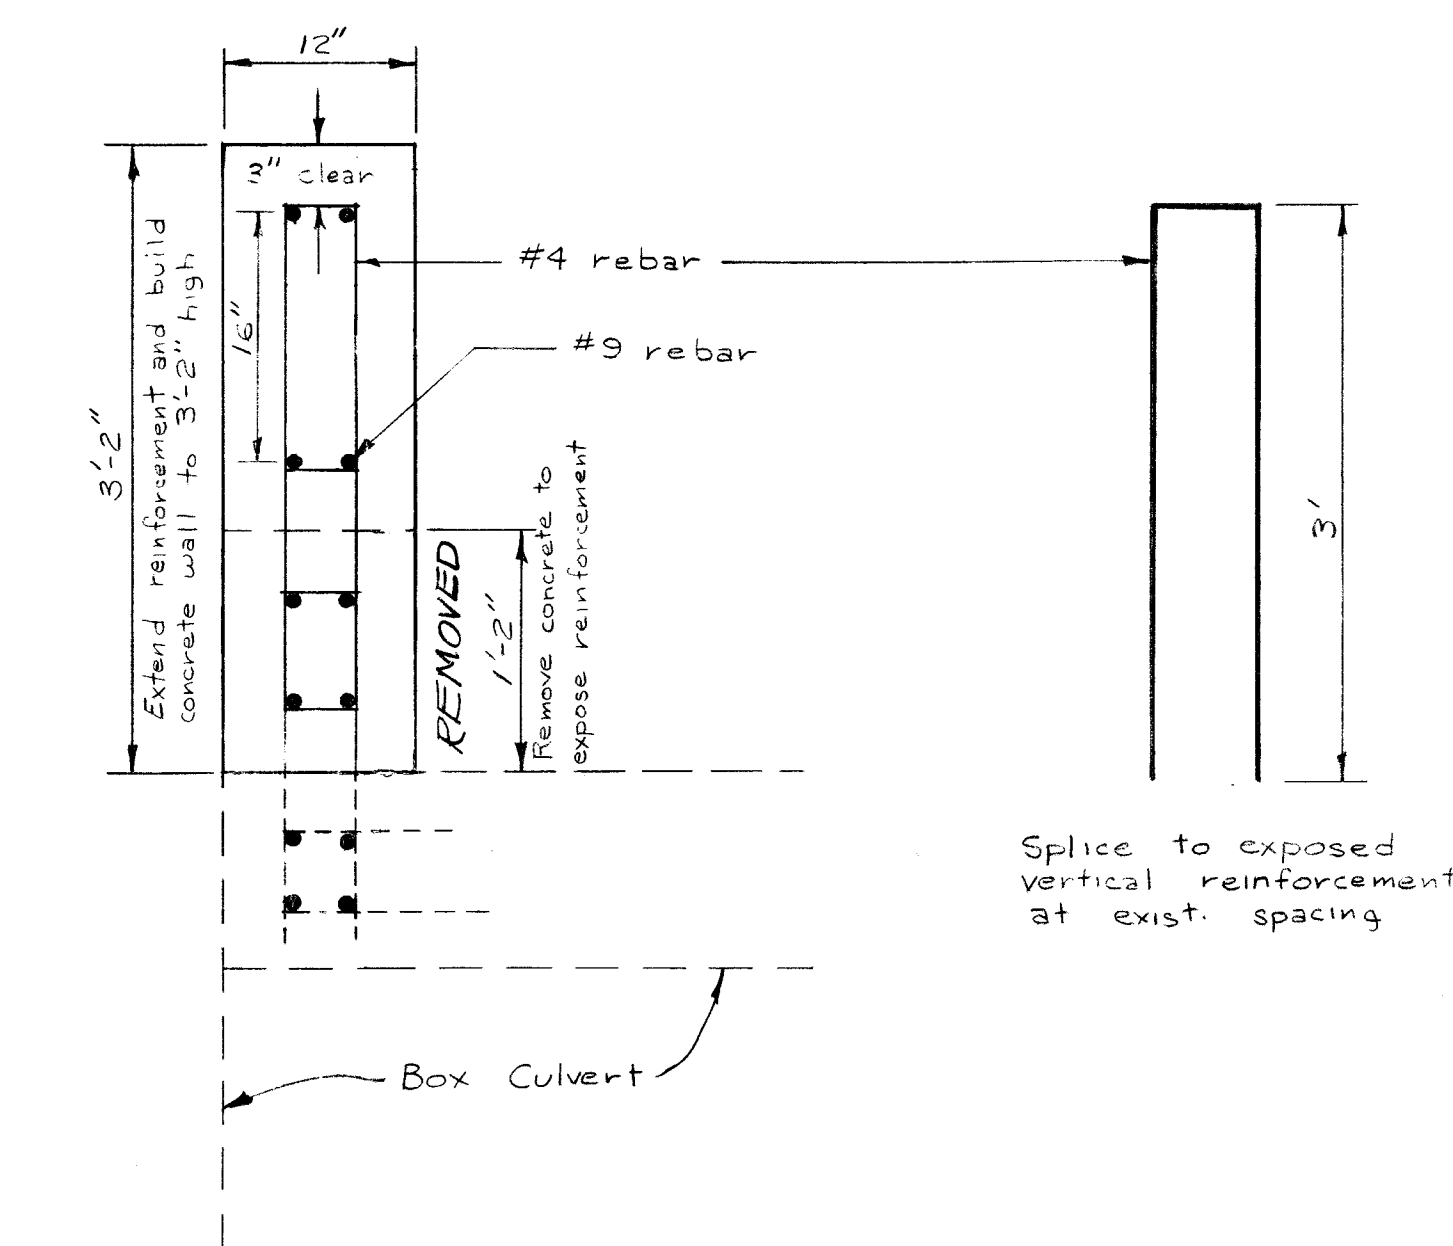
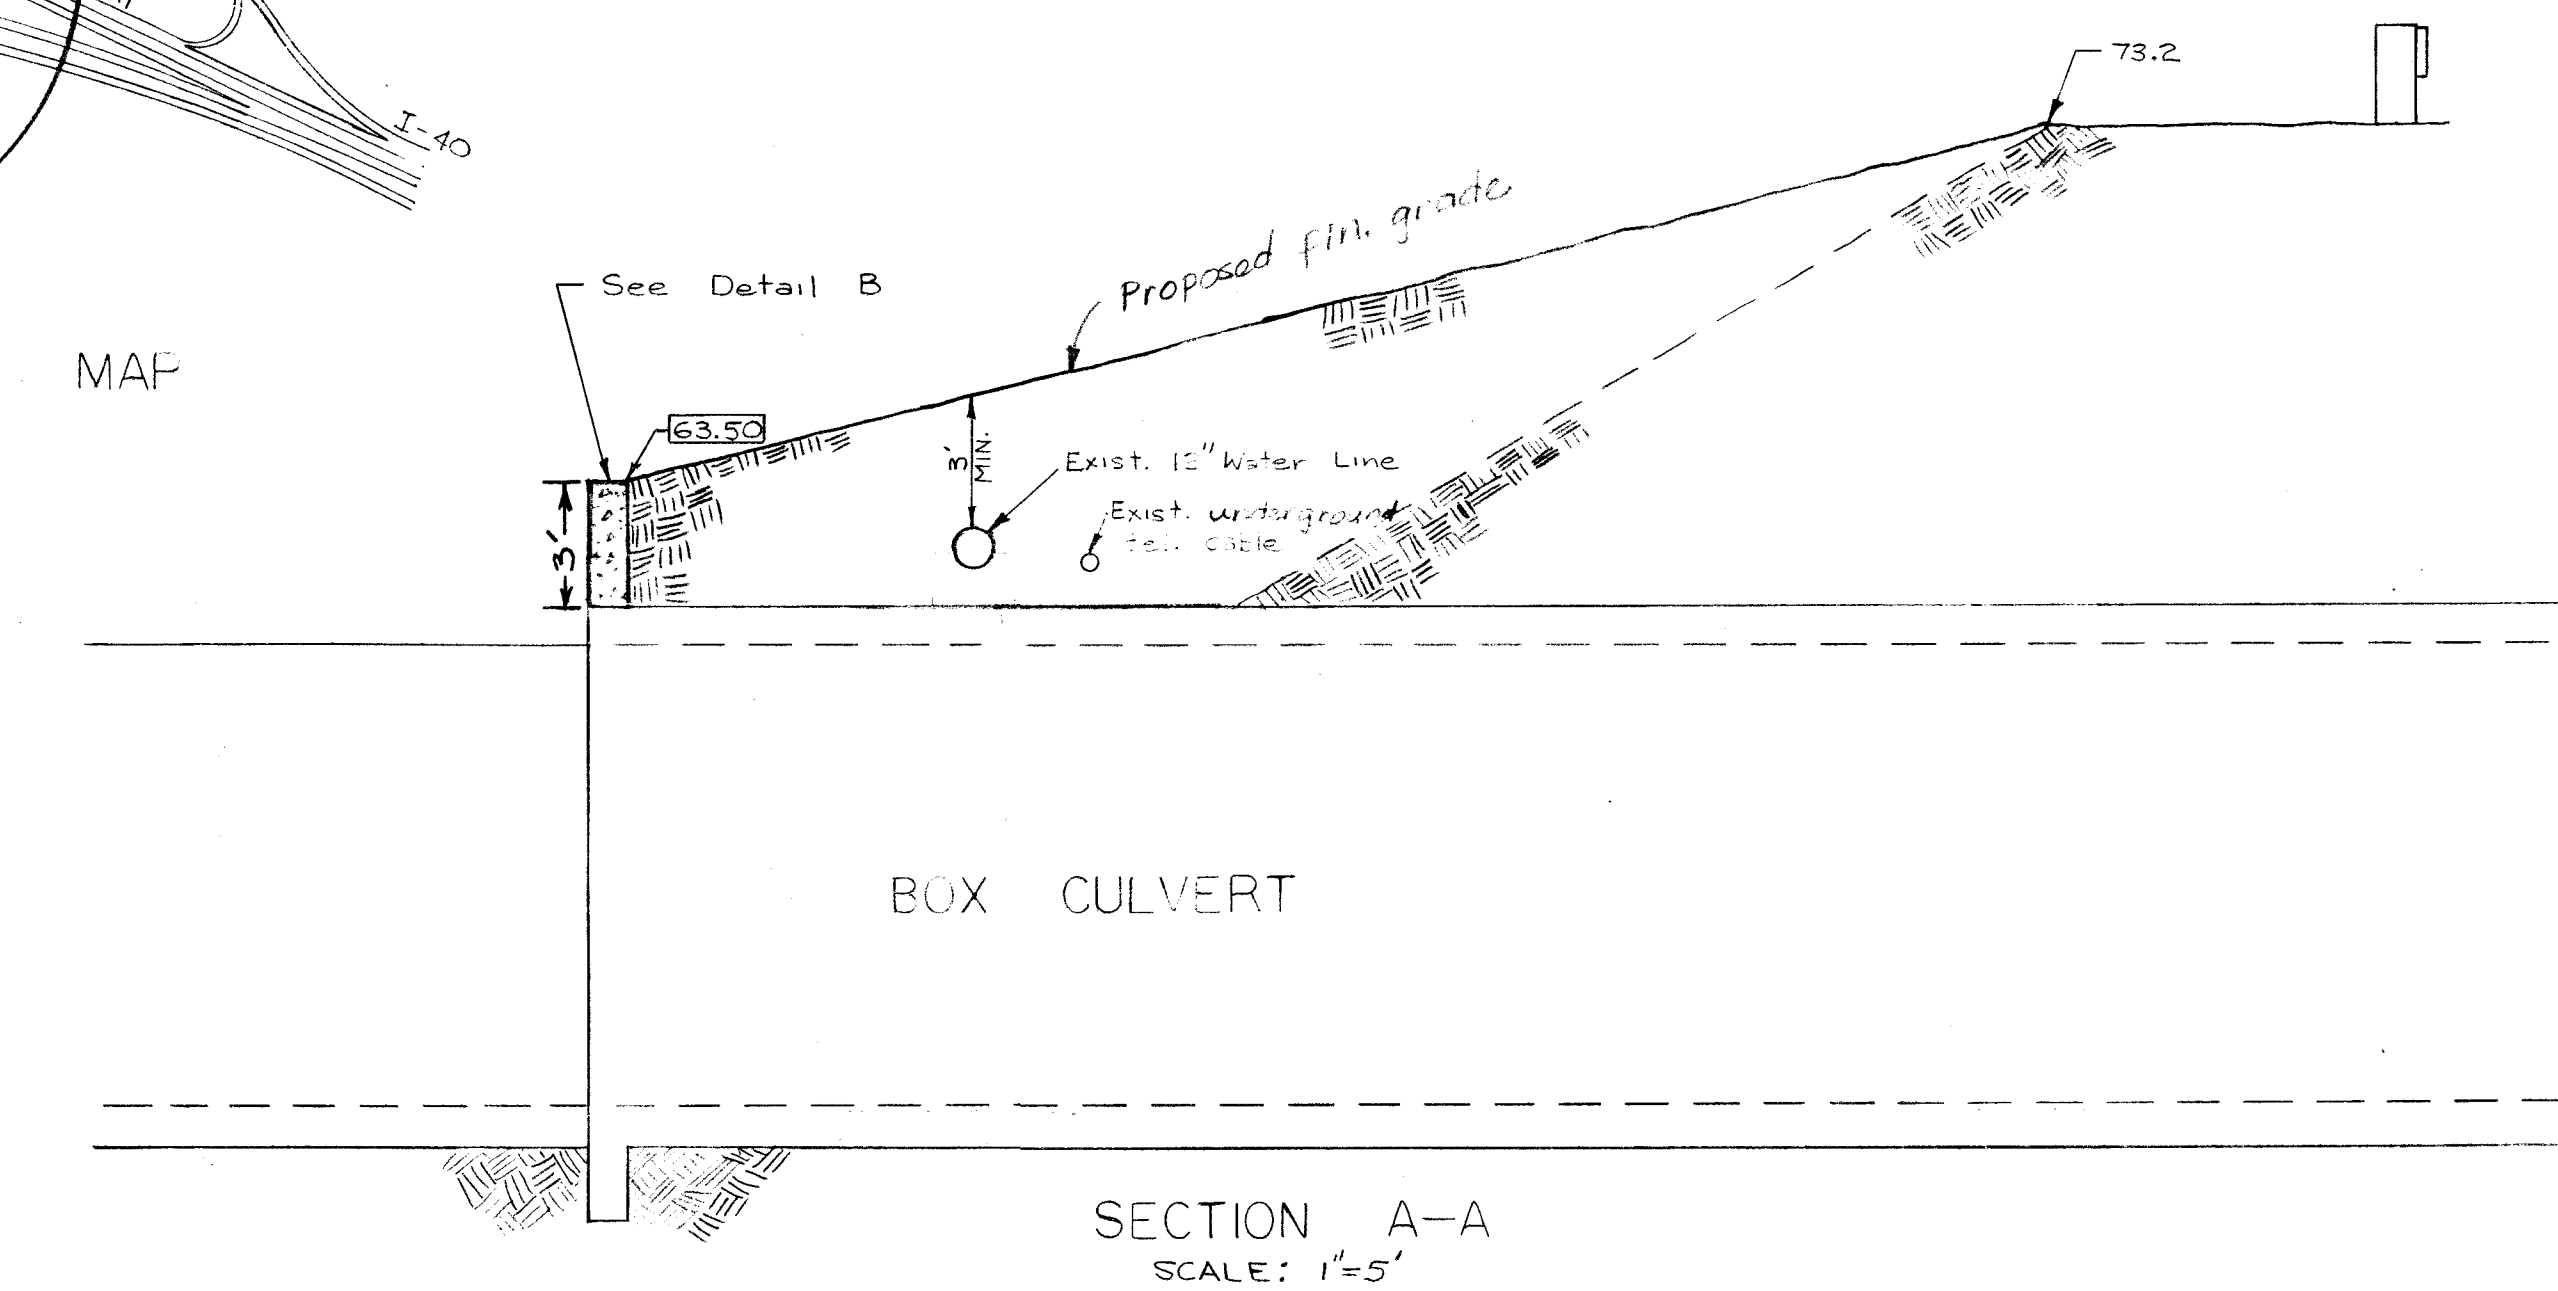
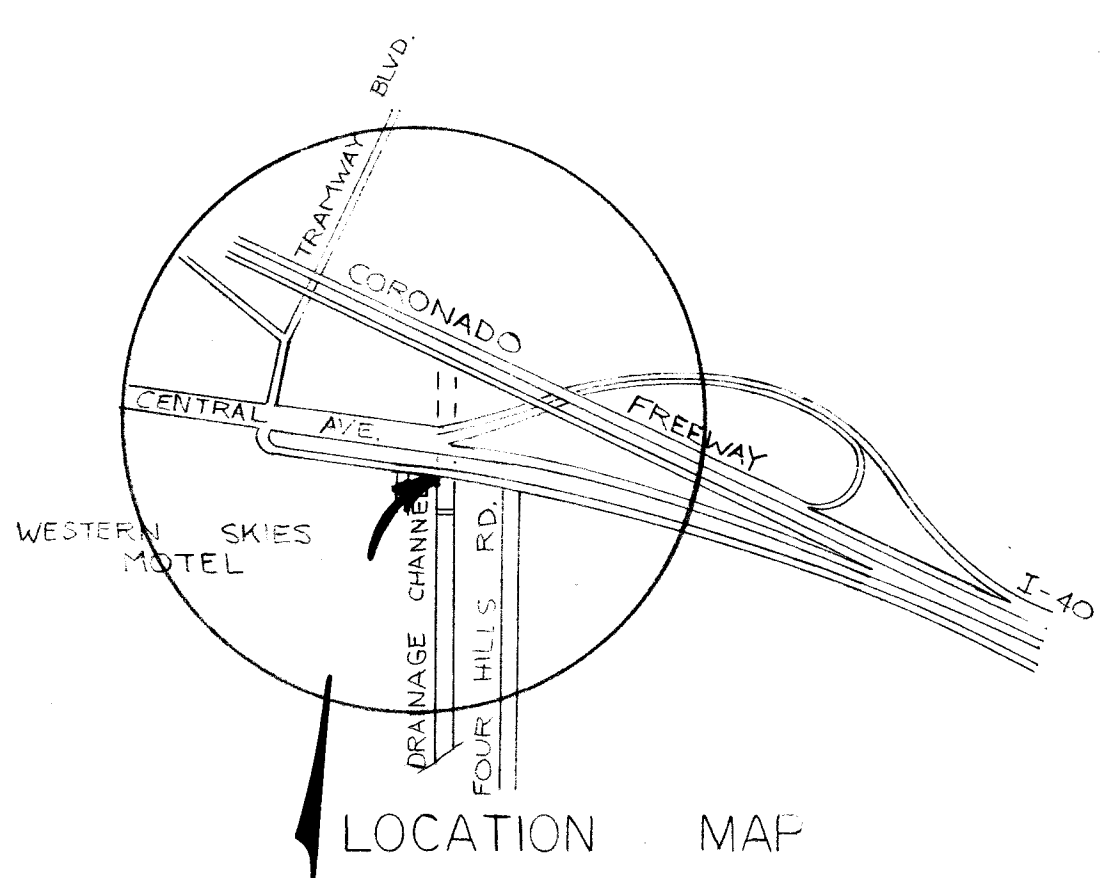


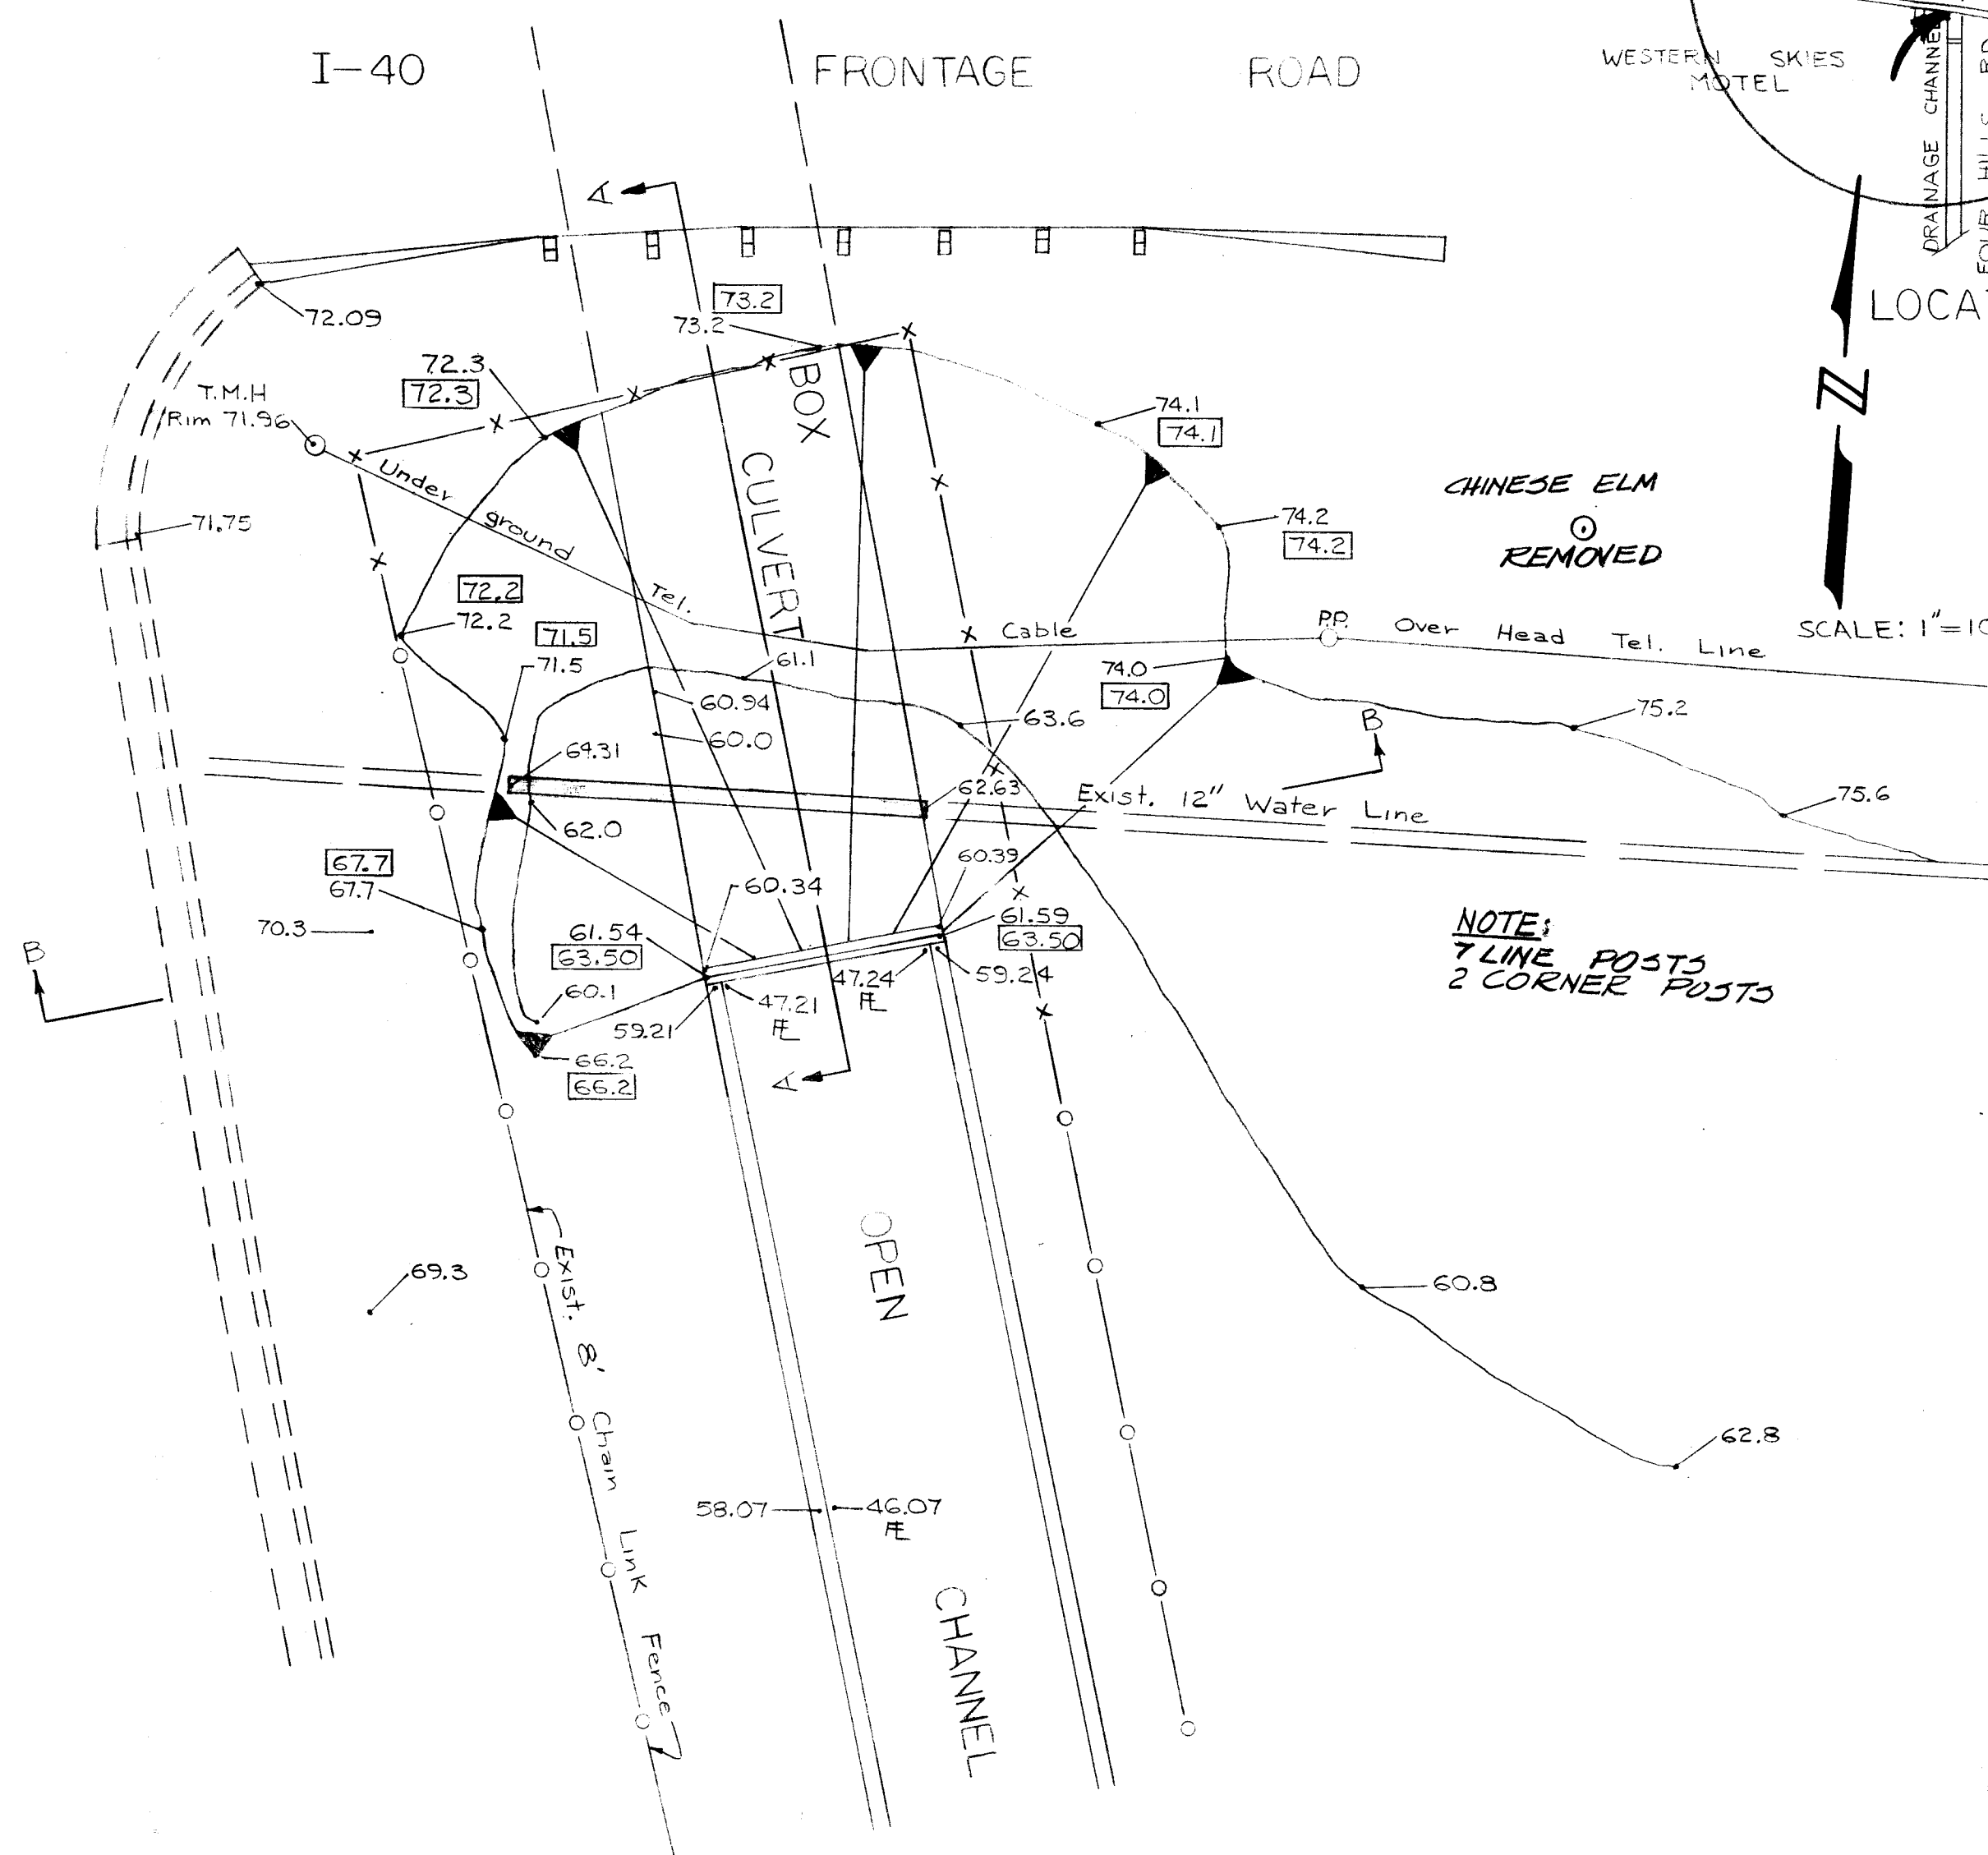

- LEGEND:
- 61.54 Exist ground elevations
 - 63.50 Proposed ground elevations
 - Limit of fill area
 - Exist. chain Link fence
 - Proposed chain Link fence
 - Prop. Conc. Retaining Wall

Note:
Remove all concrete blocks under the pipe prior to construction

SCANNED BY
BY LASON

23 141 0178

APPROVAL OF AS BUILT DRAWINGS
ASST. CITY ENGINEER - FIELD
DATE 6-17-80

APPROVED FOR CONSTRUCTION
CITY ENGINEER
DATE 10/9/78

CITY OF ALBUQUERQUE PUBLIC WORKS DEPARTMENT ENGINEERING DIVISION				
TITLE: REPAIR OF DAMAGE CAUSED BY WATER MAIN BREAK ALONG I-40 FRONTAGE ROAD EAST OF THE WESTERN SKIES MOTEL.				
APPROVALS	ENGINEER	DATE	APPROVALS	ENGINEER
City Engineer	<i>W. J. ...</i>	9/27/78	Liquid Waste	
A.C.E. - Design	<i>W. J. ...</i>	8 Sep 78	Traffic	
A.C.E. - Hydrology			Water	<i>Charles G. ...</i>
DRAWING NO. W-141-78			SHEET 1 OF 1	

SURVEY INFORMATION		BENCH MARKS		AS BUILT INFORMATION	
MAP NO.	W-141-78	4-L23	#5670.674	CONTRACT NO.	CO 604
EST. NO.	W-141-78	DATE	9/15/78	FIELD NO.	W-141-78
BY	W. J. ...	NO.	28-74	DATE	9/15/78
REMARKS		BY		DATE	
DESIGNED BY	C. TOMLINSON	DATE	9/15/78	DATE	
DRAWN BY	E. CASAS	DATE		DATE	
CHECKED BY		DATE		DATE	