


SAS ON HANOVER AND 68 TH. ST, N.W.
(SEE PROJECT 1591 FOR PAVING)

INDEX

- SHEET 1- PROJECT TITLE
- SHEET 2- PLAN & PROFILE, REV. 1
- SHEET 3- CROSS SECTIONS 68 TH. ST.

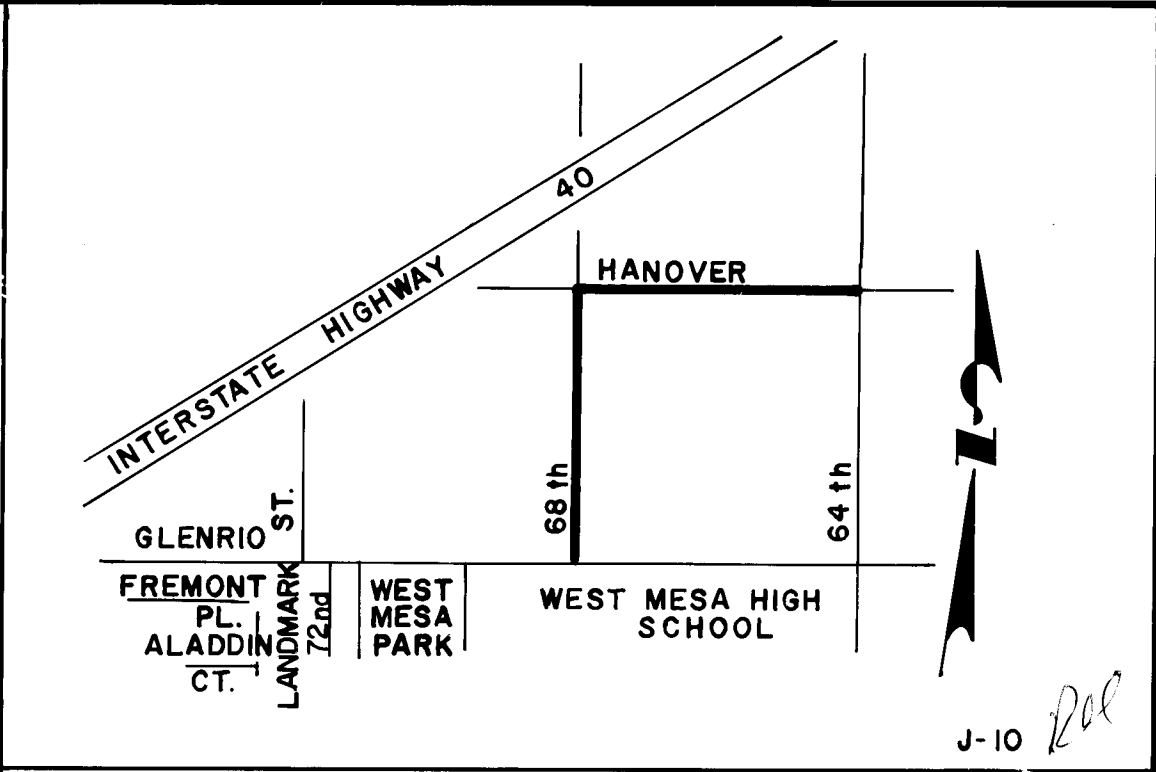

LOCATION MAP

"NOTICE TO CONTRACTOR"

- All work detailed on these plans to be performed under contract shall, except as otherwise stated or provided for hereon, be constructed in accordance with the New Mexico Standard Specifications for Public Works Construction 1979 Edition (referred to herein as the Standard Specifications) and the Contract Documents for City-Wide Utilities and Cash Paving No. 31.
- Two (2) working days prior to any excavation, contractor must contact Line Locating Service, 765-1234, for location of existing utilities.
- Prior to construction, the contractor shall excavate and verify the horizontal and vertical locations of all obstructions. Should a conflict exist, the contractor shall notify the engineer or surveyor so that the conflict can be resolved with minimum amount of delay.

THE FOLLOWING NOTES APPLY WHEN CHECKED

- ☒ All utilities and utility service lines shall be installed prior to paving.
- ☒ Backfill compaction shall be according to specified street use.
- ☒ Tack coat requirements shall be determined by the City Engineer.
- ☐ Sidewalks and wheelchair ramps within the curb returns shall be constructed wherever a new curb return is constructed.
- ☒ If curb is depressed for a driveway or a handicap ramp, the driveway or ramp shall be constructed prior to acceptance of the curb and gutter.
- ☐ All storm drainage facilities shall be completed prior to final acceptance.

26 1424 0183





APPROVAL OF A CITY ENGINEER
DATE 8/27/83

REV.	SHEETS	CITY ENGR.	DATE	USER DEPT.	DATE	USER DEPT.	DATE
2	2						
1	2						

APPROVAL OF REVISIONS

CITY OF ALBUQUERQUE	APPROVED FOR CONSTRUCTION
	CITY ENGR.
1424	SHEET 1 OF 3

4541

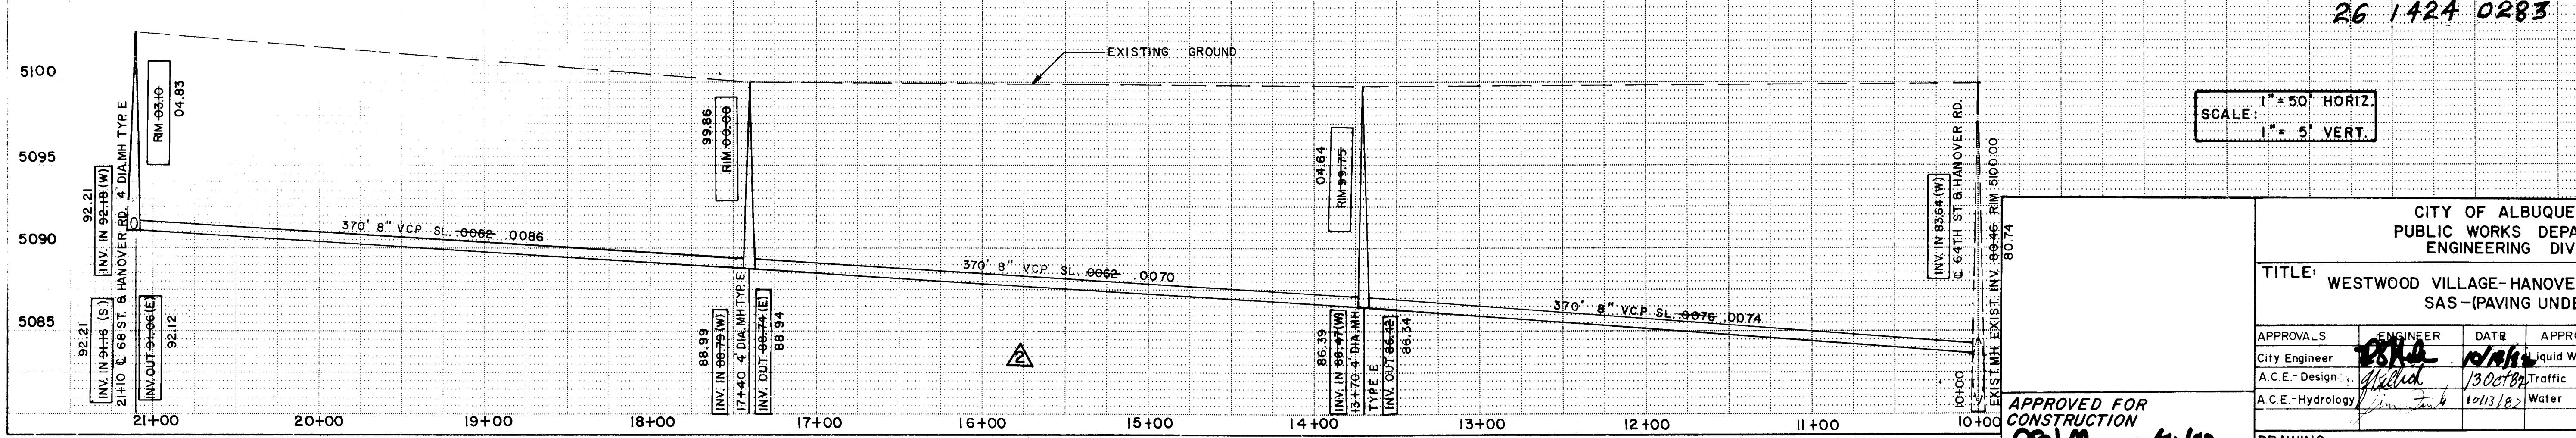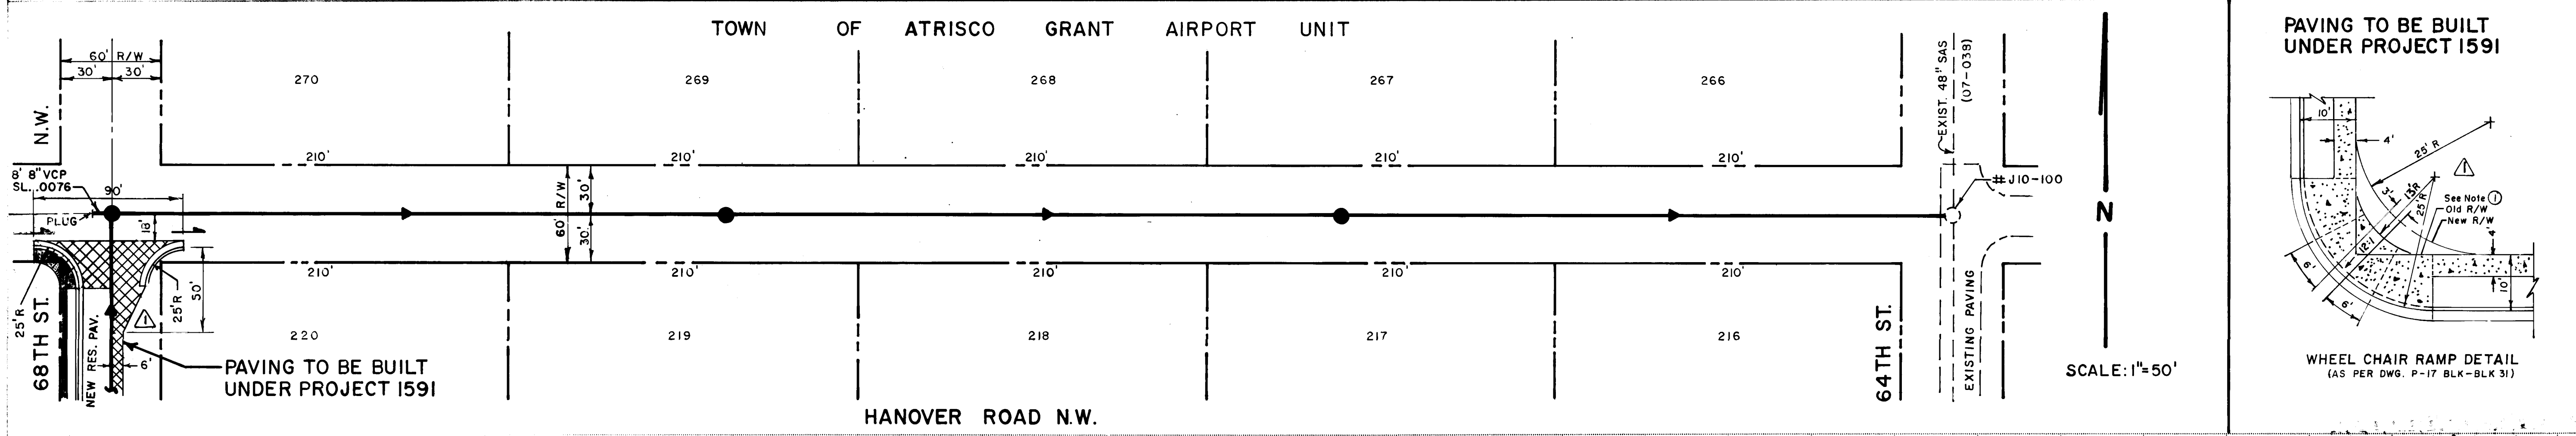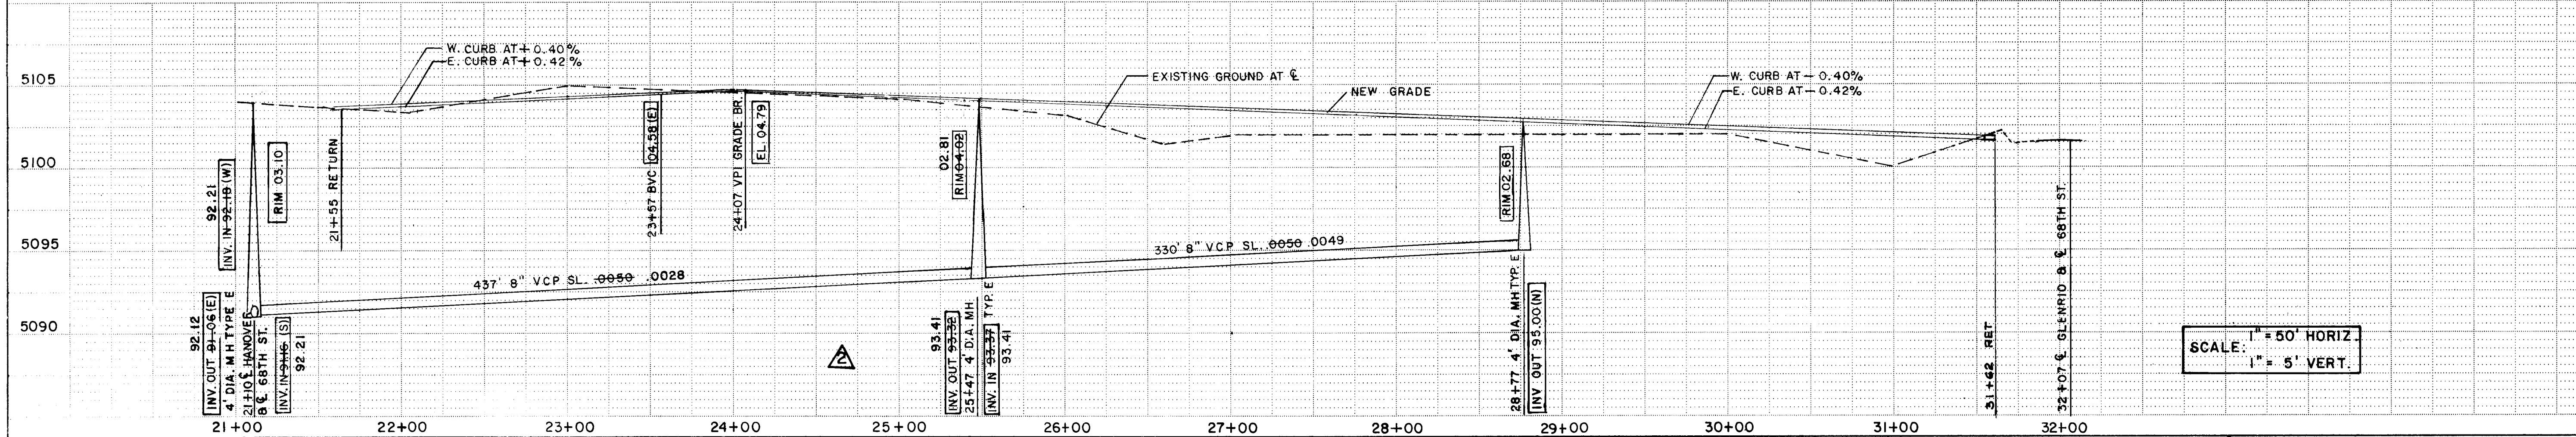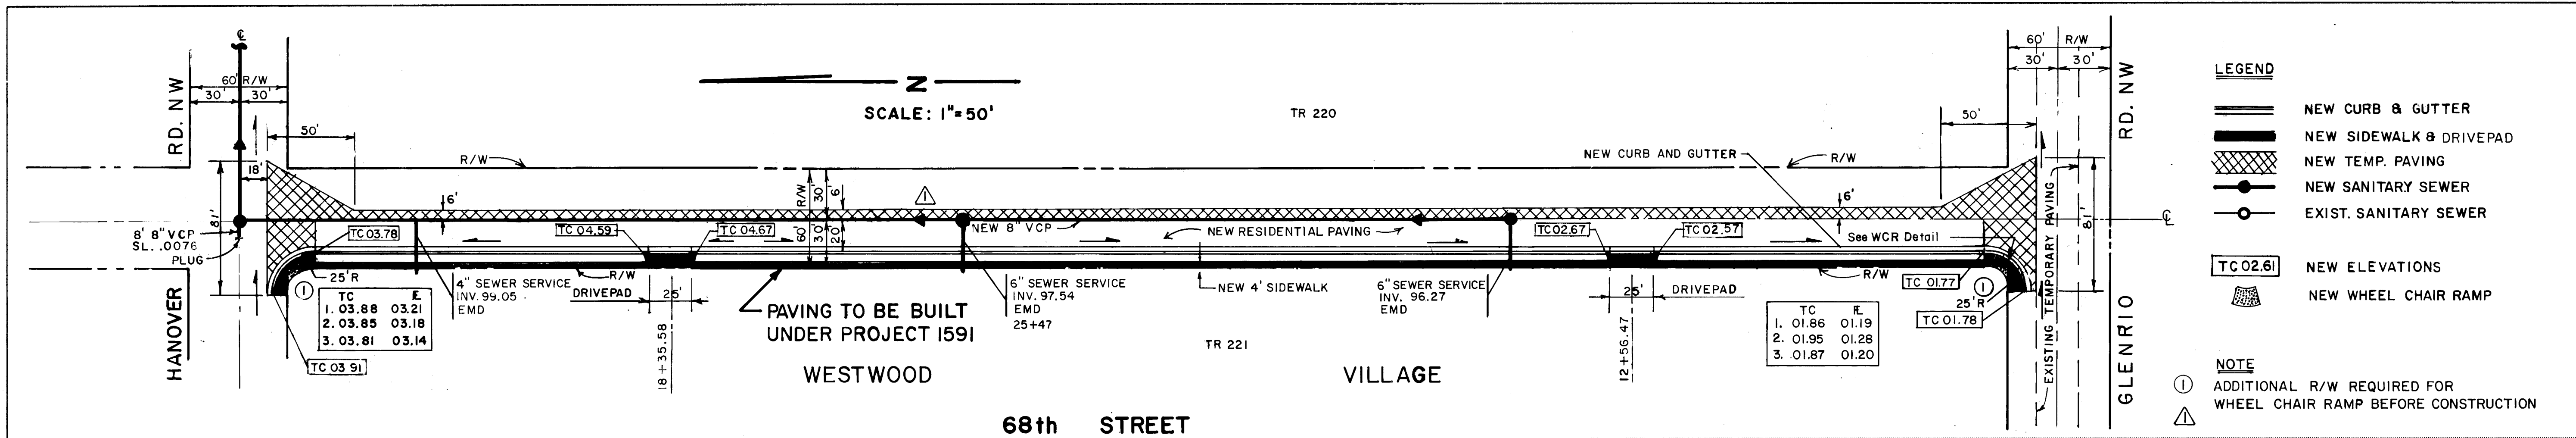

APPROVED FOR
CONSTRUCTION
CITY ENGINEER
DATE

CITY OF ALBUQUERQUE PUBLIC WORKS DEPARTMENT ENGINEERING DIVISION				
TITLE: WESTWOOD VILLAGE- HANOVER RD. & 68TH ST. SAS-(PAVING UNDER PROJECT 1591)				
APPROVALS	ENGINEER	DATE	APPROVALS	ENGINEER
City Engineer	<i>[Signature]</i>	1/30/82	liquid Waste	<i>[Signature]</i>
A.C.E.-Design	<i>[Signature]</i>	1/30/82	Traffic	<i>[Signature]</i>
A.C.E.-Hydrology	<i>[Signature]</i>	10/13/82	Water	<i>[Signature]</i>
DESIGNED BY	SERGIO MIRANDA	DATE	DESIGNED BY	DATE
DRAWN BY	TONY SANCHEZ	DATE	DRAWN BY	DATE
CHECKED BY		DATE	CHECKED BY	DATE

AS BUILT INFORMATION		BENCH MARKS		SURVEY INFORMATION		REFERENCES	
CONTRACTOR		FIELD NOTES		MAP NO.		EST. NO.	
STATED BY		BY		NO.		WO. NO.	
ACCEPTANCE BY		DATE					
FIELD LOCATION BY							
DRAWINGS							
CORRECTED BY							
MICRO-FILM INFORMATION							
RECORDED BY							
NO.							

1-JIO NAIL IN P.P.S.W. CORNER - 64TH ST. & HANOVER.	DATE	1/26/81
ELEV. 5101.14		
CBM NAIL AT BASE OF P.P.S.W. COR. 64TH & GLENRIO.		
ELEV. 5099.42		

