


CITY OF ALBUQUERQUE
DEPARTMENT OF TRANSPORTATION

INDIAN SCHOOL ROAD
MEDIAN RECONSTRUCTION

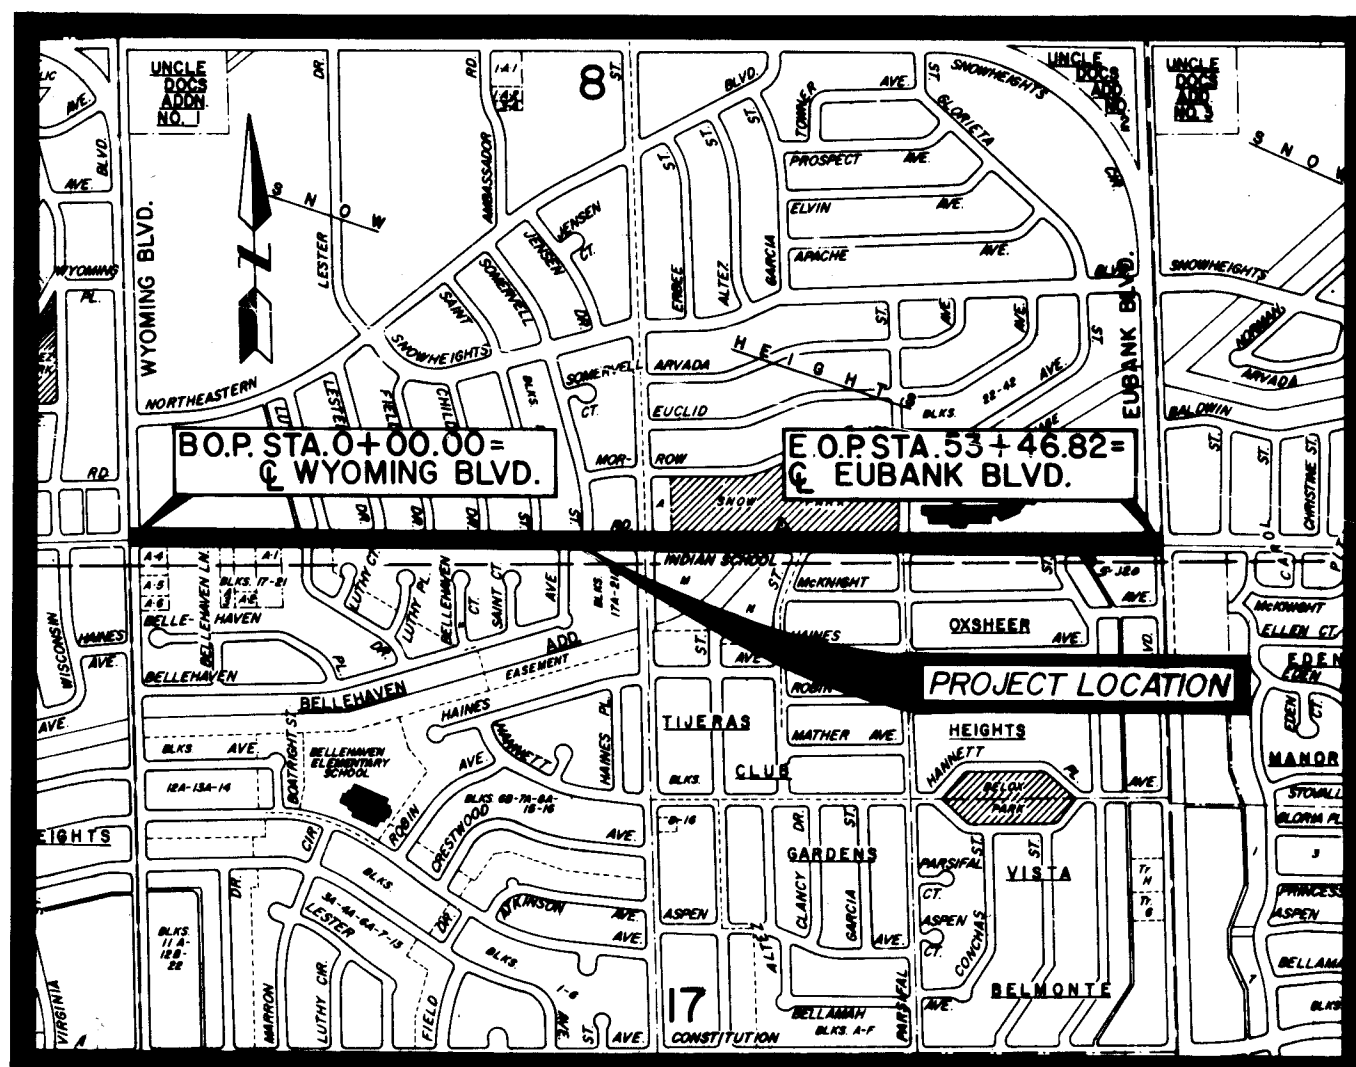


PROJECT LOCATION MAP H 46 4 19 8 20

WYOMING BLVD.
TO
EUBANK BLVD.

SEPTEMBER 1981

SHEET NO.	INDEX	DESCRIPTION
1		COVER SHEET, VICINITY MAP & INDEX OF SHEETS
2		GENERAL NOTES & LEGEND
3		SUMMARY OF QUANTITIES & SITE PREPARATION
4		TYPICAL SECTIONS
5-13		PLAN & PROFILE SHEETS
14		CONSTRUCTION SIGNING & MEDIAN GEOMETRY

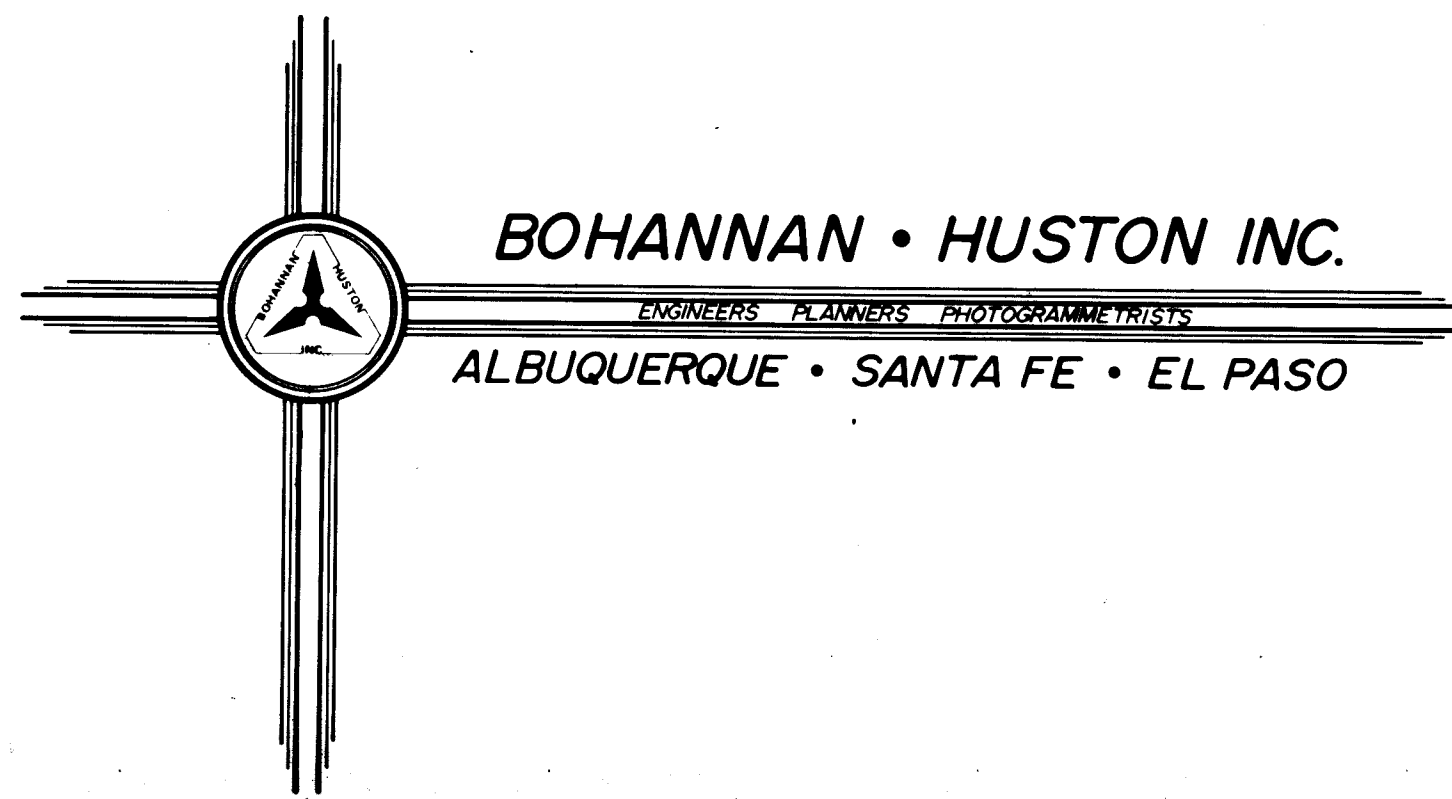

APPROVAL OF AS BUILT DRAWINGS
ASST. CITY ENGINEER - FIELD
Richard D. Hill
DATE 4-1-82
CITY ENGINEER DATE

Marlin D. Larson
MARLIN D. LARSON
N.M.P.E. NO. 7398
3-29-82
DATE

Project Reviewed and Approved for Construction

Joseph A. Martin
JOSEPH A. MARTIN
ACTING DIRECTOR
DEPT. OF TRANSPORTATION
4-14-82
DATE

Marlin D. Larson
2-22-82

3 2 3 4 5 6 7 8 9 10 11 12
114320182

NOTICE TO CONTRACTORS

- New Mexico Standard Specifications for Public Works Construction 1978 Edition will be referred to hereon as the "Standard Specification."
 - All work detailed on these plans to be performed under contract shall, except as otherwise stated or provided for hereon, be constructed in accordance with "Contract Documents for City-Wide Utilities and Cash Paving No. _____ and the Standard Specification."
 - Two working days prior to any excavation, contractor must contact Line Locating Service, 785-1234, for location of existing utilities.
 - Prior to construction, the contractor shall excavate and verify the horizontal and vertical locations of all obstructions. Should a conflict exist, the contractor shall notify the engineer or surveyor so that the conflict can be resolved with a minimum amount of delay.
- THE FOLLOWING NOTES ALSO APPLY WHEN CHECKED
- ☐ All utilities and utility service lines shall be installed prior to paving.
 - ☐ Backfill compaction shall be according to specified street use.
 - ☐ Tack coat requirements shall be determined by the City Engineer.
 - ☐ Sidewalks and wheelchair ramps within the curb returns shall be constructed wherever a new curb return is constructed.
 - ☐ If curb is depressed for a driveway, the driveway shall be constructed prior to acceptance of curb and gutter.
 - ☐ All storm drainage facilities shall be completed prior to final acceptance.
 - ☐ The requestor or developer shall be responsible for repair or replacement of all curbs and gutters or sidewalk damaged after approval by the City Engineer of work completed by the Contractor.

APPROVED FOR RECORD DRAWINGS	APPROVED FOR CONSTRUCTION
ASST. CITY ENGINEER, FIELD	DATE
CITY ENGINEER	DATE
CITY OF ALBUQUERQUE	
APPROVALS	ENGINEER DATE
ACE DESIGN	
WATER RESOURCES	
CITY ENGINEER	

GENERAL NOTES

1. ALL RADII OF CURB RETURNS ARE SHOWN TO FLOWLINE OF CURB.

2. ALL DIMENSIONS ARE TO FLOWLINE OF CURB.

3. ALL FINISH GRADES AND PROFILES SHOWN ARE TOP OF CURB GRADES UNLESS OTHERWISE NOTED. MATCH FLOWLINES OF GUTTERS WHEN CONNECTING NEW CURB AND GUTTER TO EXISTING.

4. CURB AND GUTTER SHOWN AS EXISTING AND NOT TO BE REMOVED UNDER THIS CONTRACT WHICH IS DAMAGED OR DISPLACED BY THE CONTRACTOR SHALL BE REMOVED AND REPLACED BY THE CONTRACTOR AT HIS EXPENSE.

5. WHEN ABUTTING NEW PAVEMENT TO EXISTING, CUT BACK EXISTING PAVEMENT TO A STRAIGHT LINE AND AT RIGHT ANGLES TO REMOVE ANY BROKEN OR CRACKED PAVEMENT. NO SEPARATE PAYMENT SHALL BE MADE BUT SHALL BE CONSIDERED INCIDENTAL TO THE PROJECT.

6. ALL GAS VALVE BOXES, GAS MANHOLES, ELECTRICAL MANHOLES, TELEPHONE MANHOLES, AND UTILITY POLES WILL BE ADJUSTED TO GRADE OR RELOCATED BY OTHERS.

7. WHEN REMOVAL OF EXISTING CURB AND GUTTER OR SIDEWALK IS REQUIRED, REMOVE BACK TO NEAREST JOINT.

8. THE CONTRACTOR SHALL NOTIFY THE UTILITY COMPANIES BY CALLING 765-1234 BEFORE COMMENCING WORK IN AREAS NEAR UNDERGROUND UTILITY LINES.

9. IT WILL BE THE CONTRACTOR'S RESPONSIBILITY TO PROTECT AND MAINTAIN IN SERVICE ALL EXISTING UTILITIES.

10. EXACT RELOCATION OF TRAFFIC SIGNAL FOUNDATIONS SHALL BE DETERMINED BY TRAFFIC ENGINEERING DEPARTMENT.

11. THE SPECIFICATIONS USED FOR THIS CONTRACT - NEW MEXICO STANDARD SPECIFICATION FOR PUBLIC WORKS CONSTRUCTION 1979 EDITION, AND CITY OF ALBUQUERQUE STANDARDS UNLESS OTHERWISE NOTED ON PLANS AND/OR SPECIFICATIONS.

12. ALL WATER VALVE BOXES AND SEWER MANHOLES IN THE CONSTRUCTION AREA ARE TO BE ADJUSTED TO FINISH GRADE UNDER THIS CONTRACT.

13. EXISTING MATERIALS TO BE REMOVED UNDER SITE PREPARATION ARE LISTED FOR CONTRACTOR'S INFORMATION ONLY.

14. EXISTING PROFILES AND GRADES SHOWN MAY VARY DUE TO RECENT AND CURRENT WORK DONE BY OTHERS IN THE CONSTRUCTION AREA.

15. ALL UTILITY LINES ABANDONED UNDER THIS CONTRACT SHALL BE PLUGGED WITH CONCRETE AT EACH END OF THE PORTION TO BE ABANDONED. PAYMENT FOR SUCH WORKS WILL BE CONSIDERED INCIDENTAL TO SITE PREPARATION.

16. ALL EARTHWORK SHALL BE CONSIDERED INCIDENTAL TO STREET GRADING, EXCAVATION AND SUBGRADE PREPARATION.
17. SUBGRADE PREPARATION UNDER "STANDARD" AND "MEDIAN" CURB AND GUTTER (INCLUDING ONE FOOT BEHIND BACK OF CURB), DRIVEPADS AND SIDEWALKS SHALL BE CONSIDERED INCIDENTAL TO THE CONSTRUCTION OF SUCH AND SHALL BE INCLUDED IN THE BID PRICE FOR SUCH ITEMS.

18. A DISPOSAL SITE FOR ALL EXCESS EXCAVATION MATERIAL, ASPHALTIC PAVING, CONCRETE PAVING ETC., SHALL BE OBTAINED BY THE CONTRACTOR IN COMPLIANCE WITH APPLICABLE ENVIRONMENTAL REGULATIONS. ALL COSTS INCURRED IN OBTAINING A DISPOSAL SITE AND HAUL THERETO SHALL BE CONSIDERED INCIDENTAL TO SITE PREPARATION, AND NO SEPARATE PAYMENT WILL BE MADE.

19. ALL CLEARING AND GRUBBING NECESSARY SHALL BE CONSIDERED INCIDENTAL TO SITE PREPARATION, AND NO SEPARATE PAYMENT WILL BE MADE.

20. THE CONTRACTOR SHALL MAINTAIN ACCESS TO ADJACENT PROPERTIES DURING CONSTRUCTION EXCEPT DURING ACTUAL PAVING OPERATIONS.

21. THE CONTRACTOR WILL BE REQUIRED TO CONFINE HIS WORK WITHIN THE CONSTRUCTION LIMITS AND/OR ROW TO PRESERVE EXISTING VEGETATION AND PRIVATE PROPERTY. OVERNITE PARKING OF CONSTRUCTION EQUIPMENT SHALL NOT OBSTRUCT DRIVEWAY OPENINGS OR DESIGNATED TRAFFIC LANES. OVERNITE PARKING OF EQUIPMENT WITHIN THE ROADWAY OR MEDIAN WILL NOT BE PERMITTED UNLESS THE AREA IS COMPLETELY BARRICADED OFF DUE TO CONSTRUCTION OPERATIONS.

22. FIFTY (50) TON ROLLER OPERATION SHALL NOT BE USED IN THIS PROJECT WHERE UNDERGROUND UTILITIES ARE PRESENT. THE REQUIRED COMPACTION AT THESE LOCATIONS SHALL BE EFFECTED BY MEANS OF OTHER TYPES OF ROLLING AVAILABLE.

23. ALL EXCAVATION FOR STORM DRAINS, AND OTHER EXCAVATIONS AS NECESSARY SHALL BE GOVERNED BY FEDERAL, STATE, AND LOCAL LAWS, RULES AND REGULATIONS CONCERNING CONSTRUCTION SAFETY AND HEALTH.

24. THE CITY OF ALBUQUERQUE TRAFFIC ENGINEERING DIVISION SHALL REMOVE ALL EXISTING TRAFFIC SIGNAL EQUIPMENT DEEMED SALVAGEABLE BY THE CITY. ALL REMOVAL OF TRAFFIC CONTROL EQUIPMENT SHALL BE COORDINATED BETWEEN THE CITY TRAFFIC ENGINEERING DIVISION AND THE CONTRACTOR SO AS TO MINIMIZE DISRUPTION OF TRAFFIC. ALL SIGNS AND CODING WILL BE IN ACCORDANCE WITH THE "MANUAL OF UNIFORM TRAFFIC CONTROL DEVICES FOR STREETS AND HIGHWAYS," CURRENT EDITION, PUBLISHED BY THE U.S. DEPARTMENT OF TRANSPORTATION.

25. PROVIDE GROUND ROD ON PEDESTALS USED AT SPLICE CABINET BASES AND CONTROL BASES.

26. PAVEMENT REMOVAL, TRENCHING AND BACKFILLING, SUBGRADE PREPARATION, FULL DEPTH ASPHALTIC CONCRETE REPLACEMENT, CONCRETE CURB AND GUTTER, SIDEWALK, AND OTHER RELATED WORK SHALL BE CONSIDERED INCIDENTAL TO ALL UTILITY WORK DONE BY THE CONTRACTOR, EXCEPT IN AREAS OF MEDIAN REMOVAL.

27. ASPHALTIC CONCRETE LEVELING COURSE SHALL BE PLACED IN AREAS DESIGNATED BY THE PROJECT ENGINEER, COMPLETE, IN PLACE, AND SHALL BE MEASURED AND PAID BY THE SQ. YD.

28. ADJUSTMENT OF MANHOLE RIMS SHALL INCLUDE ADJUSTMENT OF BARREL AND CONE WHERE NECESSARY.


29. LOCATION SHOWN FOR 1-1/2" PVC CONDUIT IS APPROXIMATE AND WILL BE VARIFIED BY THE CITY PARKS AND RECREATION DEPARTMENT DURING CONSTRUCTION.

LEGEND

	SURVEY
	BACK OF EXISTING CURB
	BACK OF PROPOSED CURB
	CONDUIT (EXISTING)
	WATER LINE
	GAS LINE
	TELEPHONE CABLE (U.G.)
	STORM DRAIN
	SANITARY SEWER
	PULL BOX (PROPOSED)
	PULL BOX (EXISTING)
	CATCH BASIN
	LIMITS OF PAVEMENT REMOVAL
	LANDSCAPE WATER TAP (MEDIAN PROPOSED)
	WATER VALVE
	MANHOLE (PROPOSED)
	MANHOLE (EXISTING)
	SIGNAL CONTROLLER (EXISTING)
	STREET LIGHT
	UTILITY POLE
	FIRE HYDRANT
	PANEL LOCATION
	CONTROL POINT
	WATER METER (EXISTING)
	STREET SIGN
	PEDESTAL FOUNDATION (PROPOSED)
	2" CONDUIT (PROPOSED)
	1 1/2" CONDUIT (PROPOSED)
	EXISTING MEDIAN TO BE REMOVED
	MILLED PAVEMENT

1 2 3 4 5 6 7 8 9 10 11 12
26 114320282

PREPARED UNDER THE
DIRECTION OF

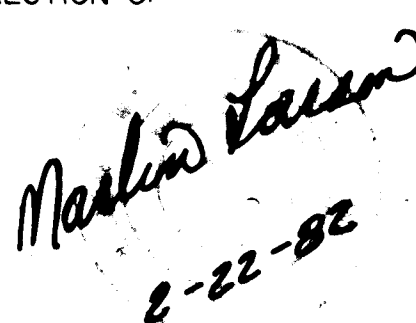
2-22-82

CITY OF ALBUQUERQUE

TITLE:
INDIAN SCHOOL RD.
GENERAL NOTES AND LEGEND

APPROVALS	ENGINEER	DATE	APPROVALS	ENGINEER	DATE

PROJECT NUMBER

DRAWING NO. 1432

SHEET 2 OF 14

SUMMARY OF QUANTITIES

Item No.	Item	Quantity	Unit
1.	Site Preparation Including Pavement Removal and Disposal	1	L.S.
2.	Arterial Pavement Including Subgrade Preparation, Subbase, Base Course, and Surface Course	5,072	S.Y.
3.	Asphalt Concrete Surface Course, 1½" Thick, 1,800 lb. Stability, Over Milled Pavement	1,088	S.Y.
4.	Emulsified Asphalt Tack Coat, Over Milled Pavement	1,088	S.Y.
5.	Portland Cement Concrete Median Curb and Gutter, Complete in Place, with Subbase and Subgrade Preparation	6,909	L.F.
6.	Portland Cement Concrete Standard Curb and Gutter, Complete in Place, with Subbase and Subgrade Preparation	34	L.F.
7.	Portland Cement Concrete Pinned Curb, Type I, Complete in Place	174	L.F.
8.	Portland Cement Concrete Pavement, 4" Thick, Complete in Place	527	S.Y.
9.	Portland Cement Concrete Drive Pad, 6" Thick	23.3	S.Y.
10.	Adjust Manhole Frames to Grade	11	Ea.
11.	Adjust Water Valve Boxes to Grade	1	Ea.
12.	¾" Single Service Connection, Complete in Place, Including Labor and Materials	11	Ea.
13.	Traffic Pedestal Foundation, Type II for Splice Cabinet, Complete in Place	2	Ea.
14.	Traffic Signal Pull Box, Complete in Place	28	Ea.
15.	Interconnect Manhole	4	Ea.
16.	Traffic Signal Electrical Conduit, 2" Rigid, Complete in Place	5,440	L.F.
17.	Electrical Conduit, 1½" PVC/P, Complete in Place	845	L.F.
18.	Signs for Detours	308	S.F.
19.	Square Tube Steel Posts for Detours	~ 598	L.F.
20.	Flashers for Signs and Barricades	42	Ea.
21.	Barricades, Type II or Barrels	24	Ea.
22.	Asphalt Leveling Course	500	S.Y.
23.	Milling Existing Pavement — 1½"	1,088	S.Y.
24.	Portland Cement Concrete Sidewalk, 4" Thick, Complete in Place	136	S.F.
25.	Traffic Signal Foundation Controller Pad, Type I, Complete in Place	1	Ea.

SITE PREPARATION

Location – Sta. to Sta.	Item	Comment
1+59 to 3+05 – Lt. & Rt.	Remove Concrete Median Curb	215 L.F.
3+65 to 5+16 – Lt. & Rt.	Remove Asphalt Curb	328 L.F.
4+25 – 4' Rt.	Adjust Manhole	Lower 0.50'
5+05 to 5+39 – Lt.	Remove Laydown Curb	34 L.F.
5+05 to 5+39 – Lt.	Remove Drive Pad	22.6 S.Y.
5+44.38 to 5+82.38 – Lt.	Remove Sidewalk	152 S.F.
5+97 to 7+48 – Lt. & Rt.	Remove Asphalt Curb	328 L.F.
8+24 to 8+88 – Lt. & Rt.	Remove Asphalt Curb	158 L.F.
9+43 to 9+84 – Lt. & Rt.	Remove Asphalt Curb	108 L.F.
10+45 to 12+62 – Lt. & Rt.	Remove Asphalt Curb	355 L.F.
12+30 – 10' Rt.	Adjust Manhole	Lower 0.55'
13+22 to 15+32 – Lt. & Rt.	Remove Asphalt Curb	448 L.F.
15+92 to 18+06 – Lt. & Rt.	Remove Asphalt Curb	448 L.F.
16+27 – 10' Rt.	Adjust Manhole	Lower 0.57'
18+62 to 20+73 – Lt. & Rt.	Remove Asphalt Curb	448 L.F.
19+72 – 10' Rt.	Adjust Manhole	Lower 0.60'
21+32 to 22+18 – Lt. & Rt.	Remove Asphalt Curb	208 L.F.
22+82 to 23+46 – Lt. & Rt.	Remove Asphalt Curb	158 L.F.
23+15 – 10' Rt.	Adjust Manhole	Lower 0.70'
24+02 to 24+23 – Lt. & Rt.	Remove Asphalt Curb	198 L.F.
28+60 to 29+06 – Lt. & Rt.	Remove Asphalt Curb	128 L.F.
30+25 to 32+08 – Lt. & Rt.	Remove Asphalt Curb	388 L.F.
33+71 to 34+50 – Lt. & Rt.	Remove Asphalt Curb	193 L.F.
35+22 to 39+81 – Lt. & Rt.	Remove Asphalt Curb	948 L.F.
36+70 – C	Adjust Manhole	Lower 0.81'
37+60 – 11' Lt.	Adjust Valve Box	Lower 0.60'
39+00 – C	Adjust Manhole	Lower 0.35'
40+42 to 46+47 – Lt. & Rt.	Remove Asphalt Curb	1248 L.F.
40+65 – C	Adjust Manhole	Lower 0.92'
47+44 to 47+90	Remove Asphalt Curb	128 L.F.
48+54 to 49+29	Remove Asphalt Curb	175 L.F.
49+10 – C	Adjust Manhole	Lower 0.30'
49+89 to 51+35 – Lt. & Rt.	Remove Concrete Median Curb & Gutter	164 L.F.
Throughout project (see Plan Sheets)	Remove Existing Asphalt Surfacing	2951.6 S.Y.
Throughout project (see Plan Sheets)	Remove Existing Surfacing for Conduit Placement	405 S.Y.

Note: This listing of removals is for information purposes only and is not intended to be all-inclusive

		REFERENCES		SURVEY INFORMATION		BENCH MARKS		AS-BUILT INFORMATION	
NO.	DATE	REMARKS	BY	EST. NO.	W.O. NO.	NO.	BY	DATE	
1	5/14/83	Revisions to quantities	SAH	MAP NO. H-8-1	13-2-20-04				
REVISIONS									
DESIGN									
DESIGNED BY	MDL	DATE	12-81						
DRAWN BY	SAH	DATE	12-81						
CHECKED BY	MDL	DATE	12-81						
MICRO-FILM INFORMATION									
RECORDED BY				DATE					
NO.									

1	2	3	4	5	6	7	8	9	10	11	12	SIA#		DATE		DESIGNED BY	DRAWN BY	CHECKED BY
26	14	32	03	62								/			NO.			

PREPARED UNDER THE
DIRECTION OF

Marked Laramie

2-22-62

CITY OF ALBUQUERQUE

TITLE: INDIAN SCHOOL RD.
SUMMARY OF QUANTITIES
AND SITE PREPARATION


APPROVALS	ENGINEER	DATE	APPROVALS	ENGINEER	DATE

PROJECT NUMBER


DRAWING NO.

1432


SHEET 3 OF 14

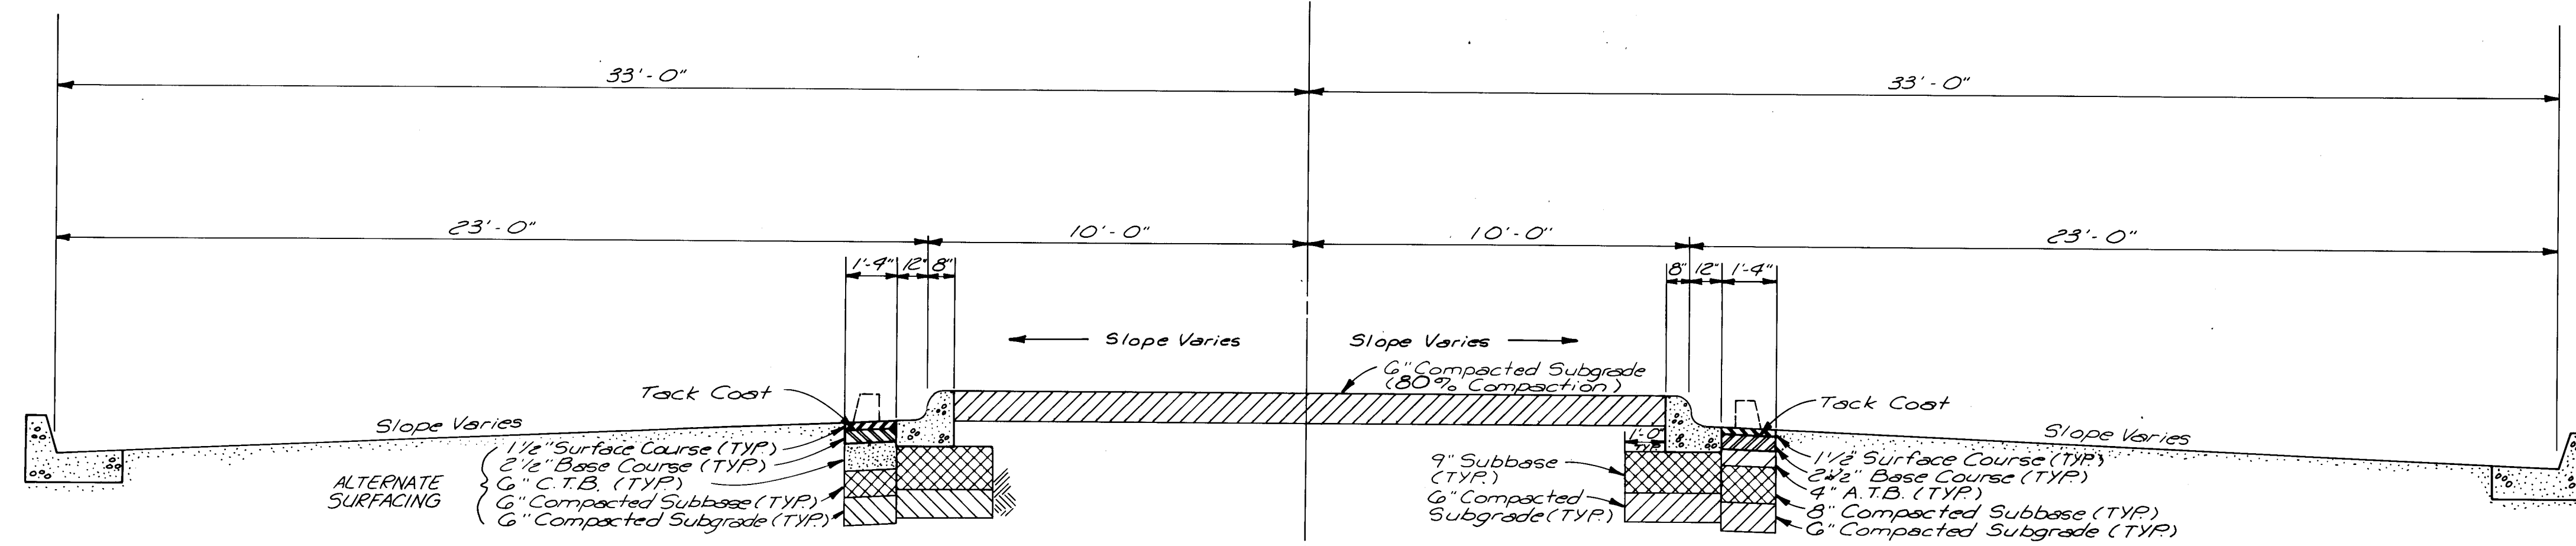


**TYPICAL SECTION
(20' MEDIAN)**
NO SCALE

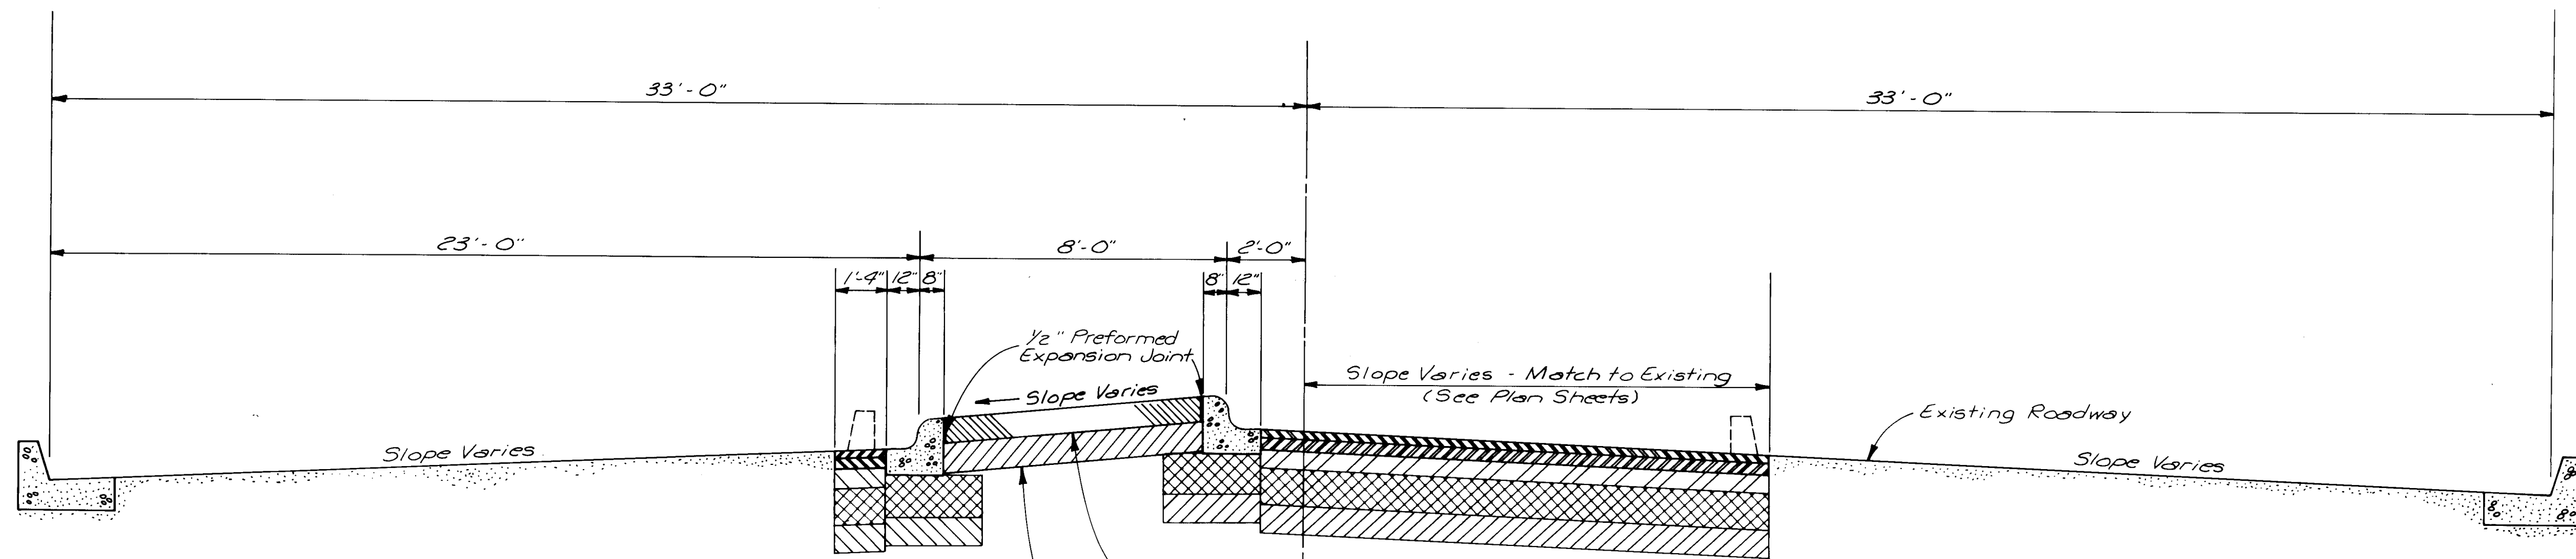

**TYPICAL SECTION
(AT TURNBAYS)**
NO SCALE

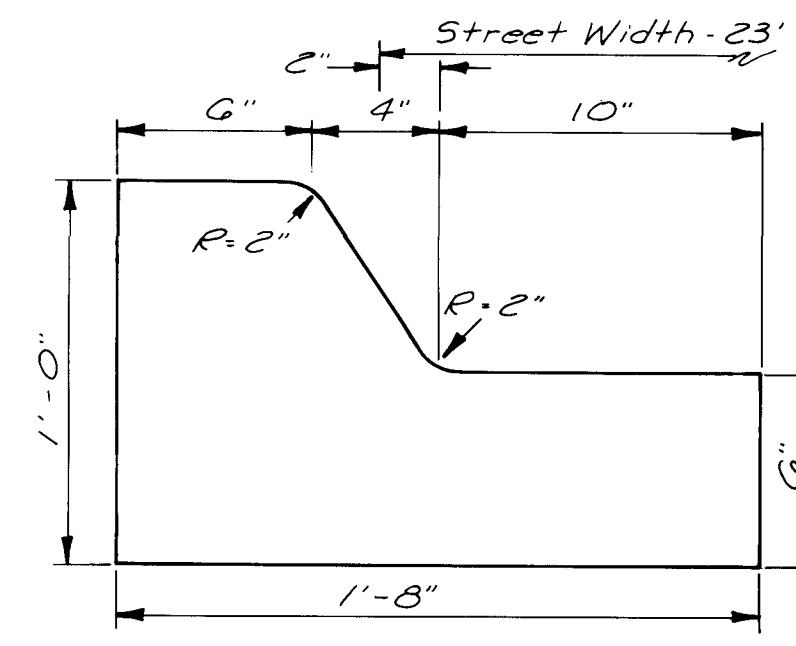

MEDIAN CURB & GUTTER

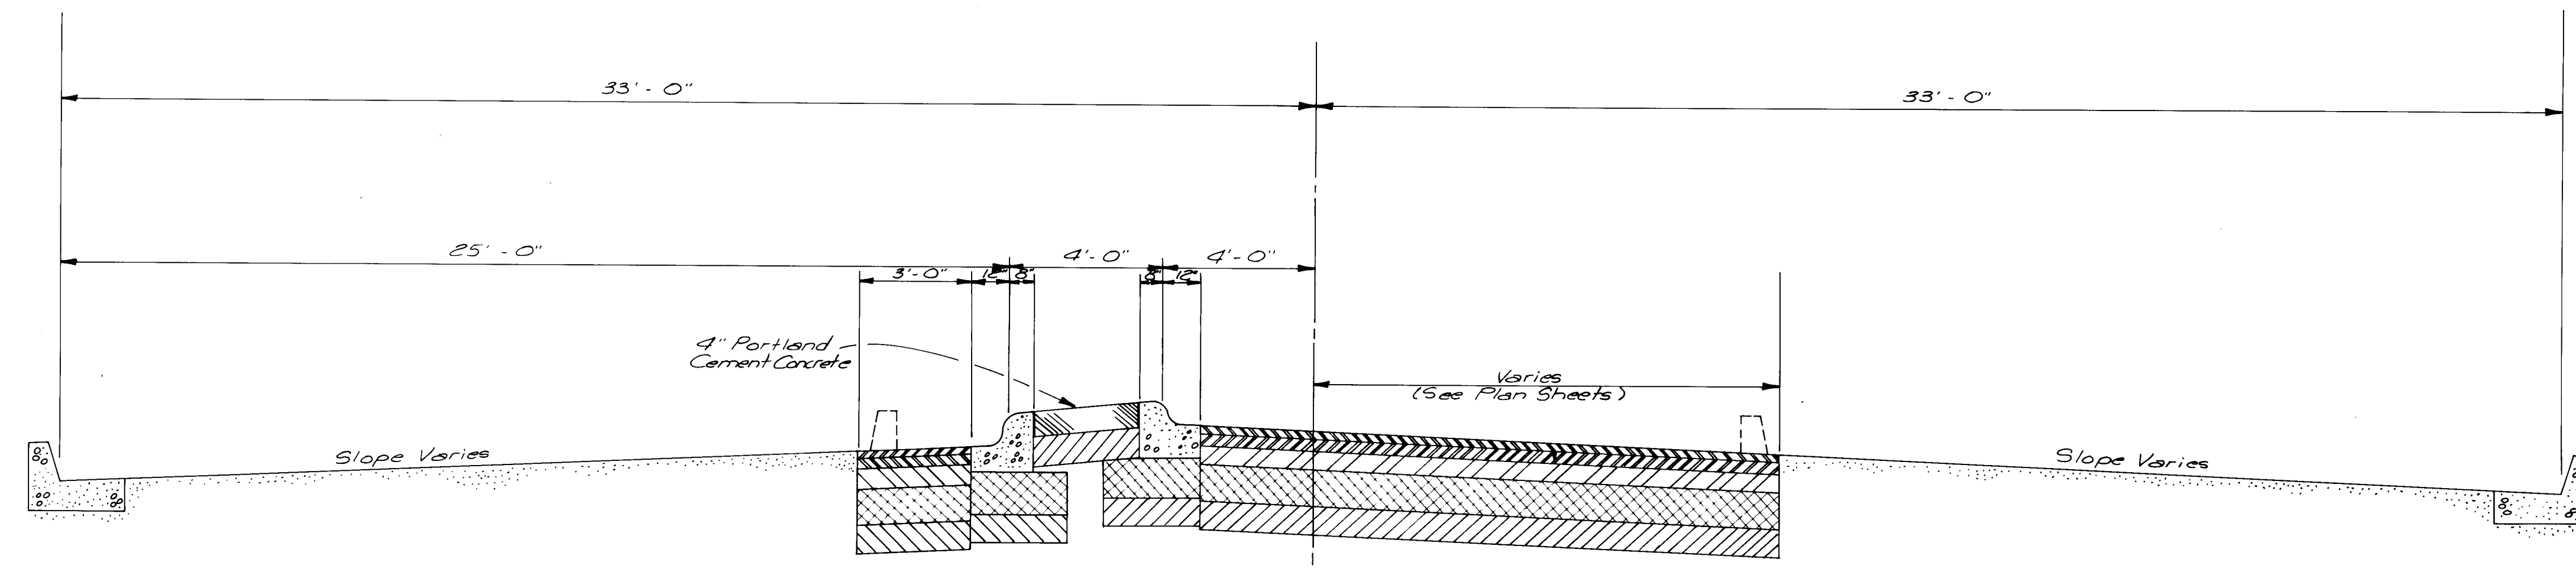

**TYPICAL SECTION
(STA. 1+61.26 to STA. 3+03.20 & STA. 50+18.04 to STA. 51+34.73)**
NO SCALE

SCALE: NO SCALE

AS-BUILT INFORMATION										BENCH MARKS				SURVEY INFORMATION				REFERENCES				DESIGN													
CONTRACTOR				WORK STARTED BY				DATE				NO.				BY				DATE				NO.				DATE							
FIELD ACCEPTANCE BY				DATE				NO.				BY				DATE				NO.				DATE				NO.				DATE			
DRAWINGS CORRECTED BY				DATE				NO.				BY				DATE				NO.				DATE				NO.				DATE			
MICRO-FILM INFORMATION				NO.				BY				DATE				NO.				DATE				NO.				DATE							

PREPARED UNDER THE DIRECTION OF		CITY OF ALBUQUERQUE	
 2-22-81		INDIAN SCHOOL RD. TYPICAL SECTIONS	
APPROVALS	ENGINEER	DATE	APPROVALS
PROJECT NUMBER		DRAWING NO. 1432	
SHEET 4 OF 14			

PROFILE	SURVEYED	BY	DATE
NOTE BOOK	PLOTTED		
NO.	BY		
	STRUCTURE NOTATIONS CHND		

PLAN	SURVEYED	BY	DATE
NOTE BOOK	PLOTTED		
NO.	BY		
	STRUCTURE NOTATIONS CHND		

*

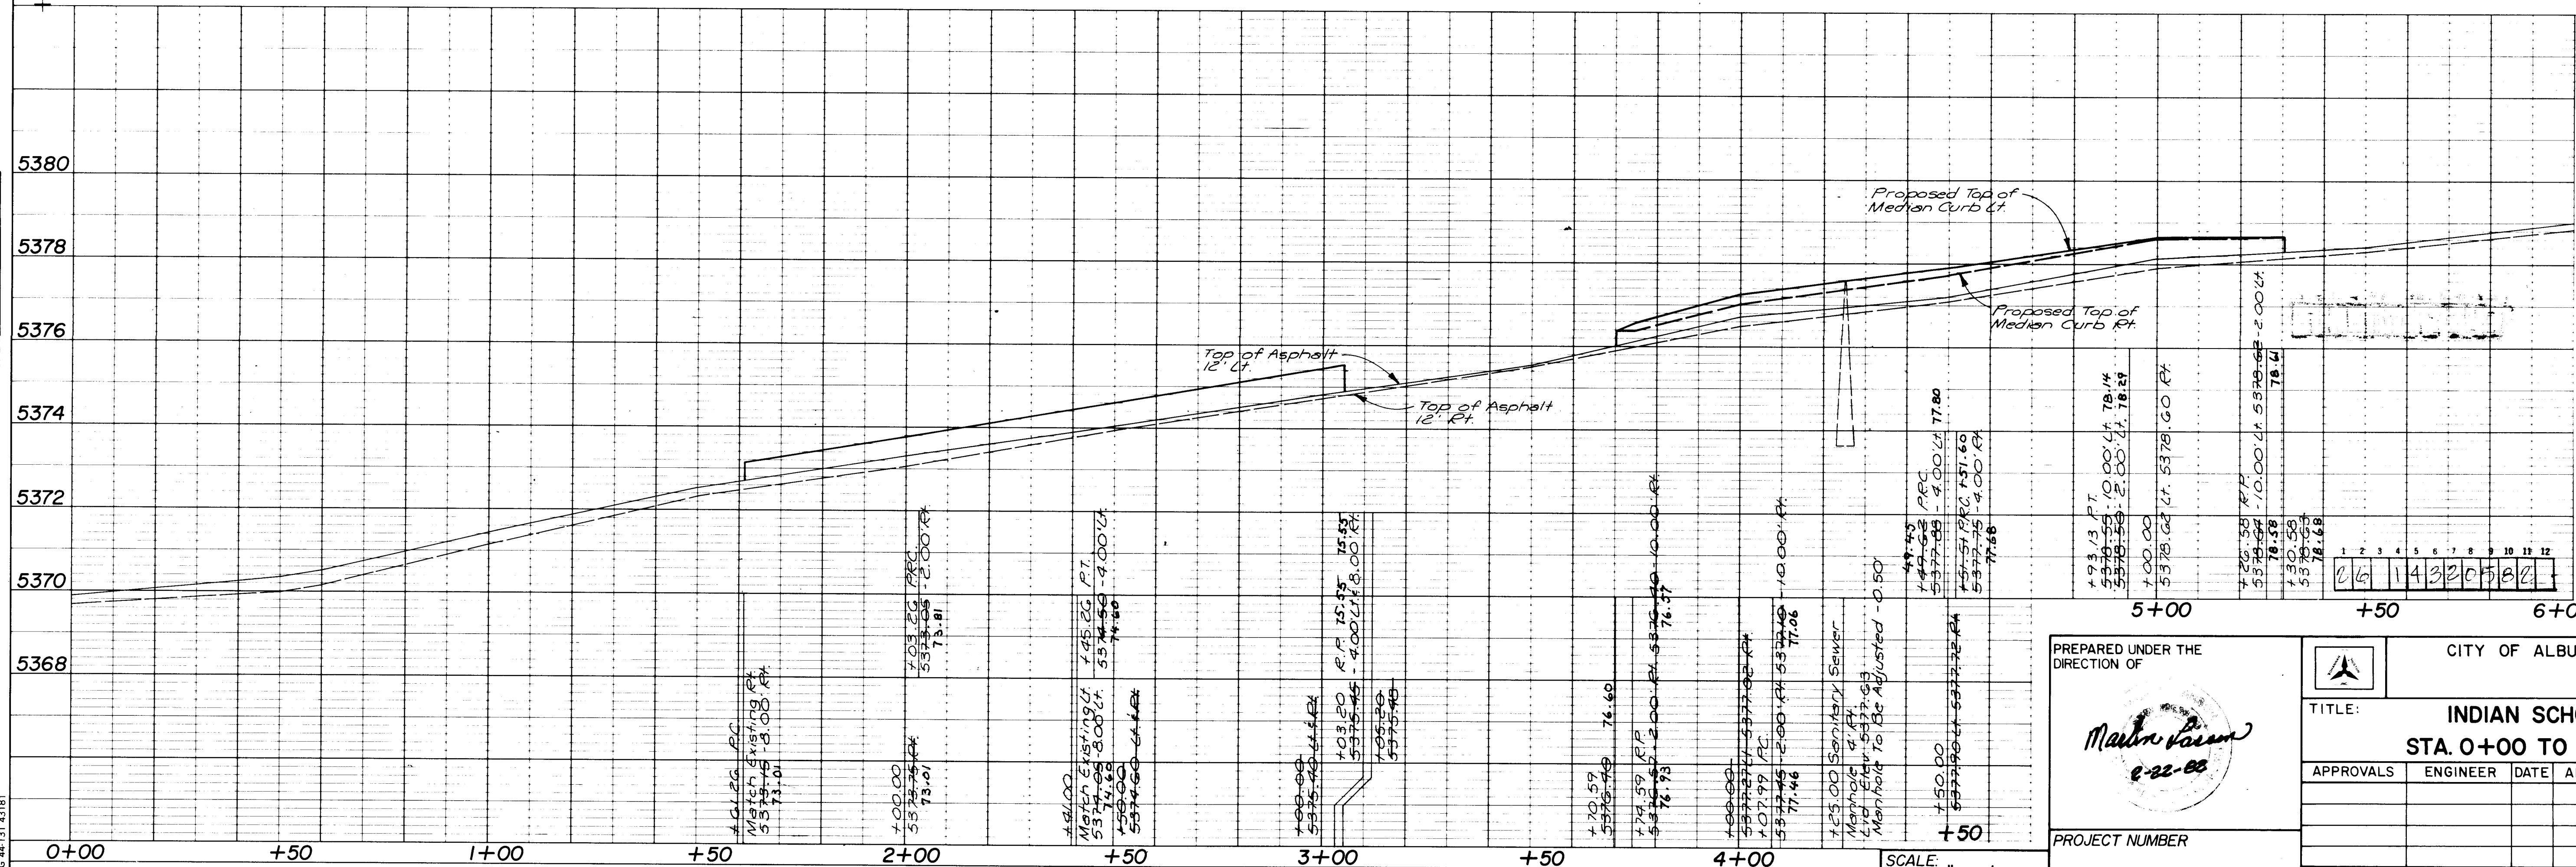


PLATE 1 SINGLE PLAN - PROFILE
CHARLES BRUNING CO.
MADE IN U.S.A.

SCALE: 1" = 20' HORIZ.
1" = 2' VERT.


PREPARED UNDER THE
DIRECTION OF
Martin Korman
2-22-00

CITY OF ALBUQUERQUE					
TITLE: INDIAN SCHOOL RD. STA. 0+00 TO STA. 6+00					
APPROVALS	ENGINEER	DATE	APPROVALS	ENGINEER	DATE
DRAWING NO. 1432			SHEET 5 OF 14		

F.H.W.A. Region No.	NEW MEXICO
SHEET NO.	TOTAL SHEETS

AS-BUILT INFORMATION			
CONTRACTOR	WORK STAKED BY	DATE	
Located at the intersection of Indian School Rd. N.E. and Childers Dr. N.E., in the NW quadrant of the intersection.	DATE		
A square, ☒ chiseled on top of the concrete curb of the NNW return. Elev. 5402.04	DATE		
MICRO-FILM INFORMATION			
RECORDED BY	NO.	DATE	

SURVEY INFORMATION			
MAP NO.	EST. NO.	W.O. NO.	NO.
1	544	11	11
REFERENCES			
5442	Sta. 5+05 to 5+12	33	
Left - Revised Build			
Removal Area			
REVISIONS			
NO.	DATE	REMARKS	BY
DESIGN			
DESIGNED BY	MDL	DATE	12-81
DRAWN BY	SAH	DATE	12-81
CHECKED BY	MDL	DATE	12-81

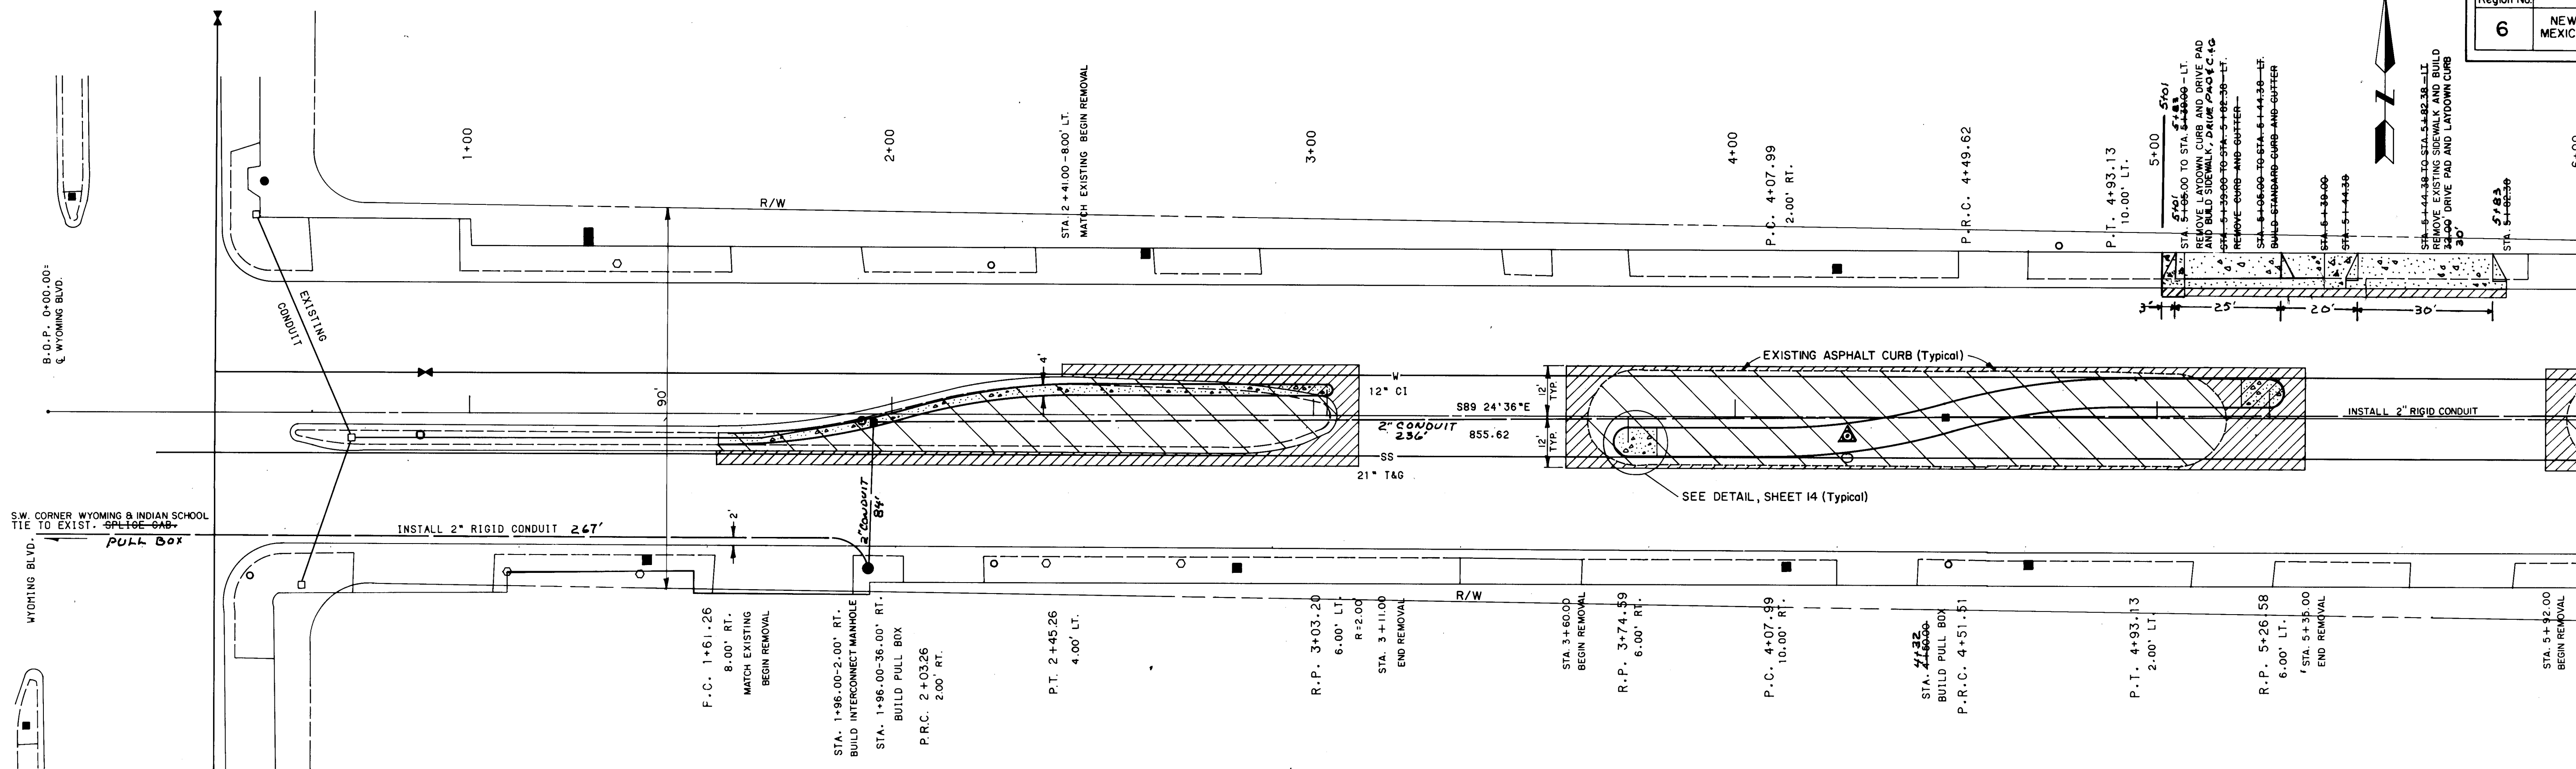

WYOMING BLVD.
B.O.P. 0+00.00
E. WYOMING BLVD.
S.W. CORNER WYOMING & INDIAN SCHOOL
TIE TO EXIST. SPLICE 0+00.00
PULL BOX
INSTALL 2" RIGID CONDUIT 2.67'

EXISTING ASPHALT CURB (Typical)
SEE DETAIL, SHEET 14 (Typical)
INSTALL 2" RIGID CONDUIT

STA. 1+61.26
8.00' RT.
MATCH EXISTING
BEGIN REMOVAL

STA. 1+96.00-2.00' RT.
BUILD INTERCONNECT MANHOLE
STA. 1+96.00-36.00' RT.
BUILD PULL BOX
P.R.C. 2+03.26
2.00' RT.

P.T. 2+45.26
4.00' LT.

R.P. 3+03.20
6.00' LT.
R=2.00'
STA. 3+11.00
END REMOVAL

STA. 3+60.00
BEGIN REMOVAL

R.P. 3+74.39
6.00' RT.

P.C. 4+07.99
10.00' RT.

STA. 4+32.00
P.R.C. 4+51.51

P.T. 4+93.13
2.00' LT.

R.P. 5+26.58
6.00' LT.
1 STA. 5+36.00
END REMOVAL

STA. 5+42.00
BEGIN REMOVAL

6+00.

PROFILE	SURVEYED	BY	DATE
NOTE BOOK	GRADES CHECKED		
NO.	STRUCTURE NOTATION'S CHKO		

PLAN	SURVEYED	BY	DATE
NOTE BOOK	ALIGNMENT CHECKED		
NO.	R/W OF WAY CHECKED		


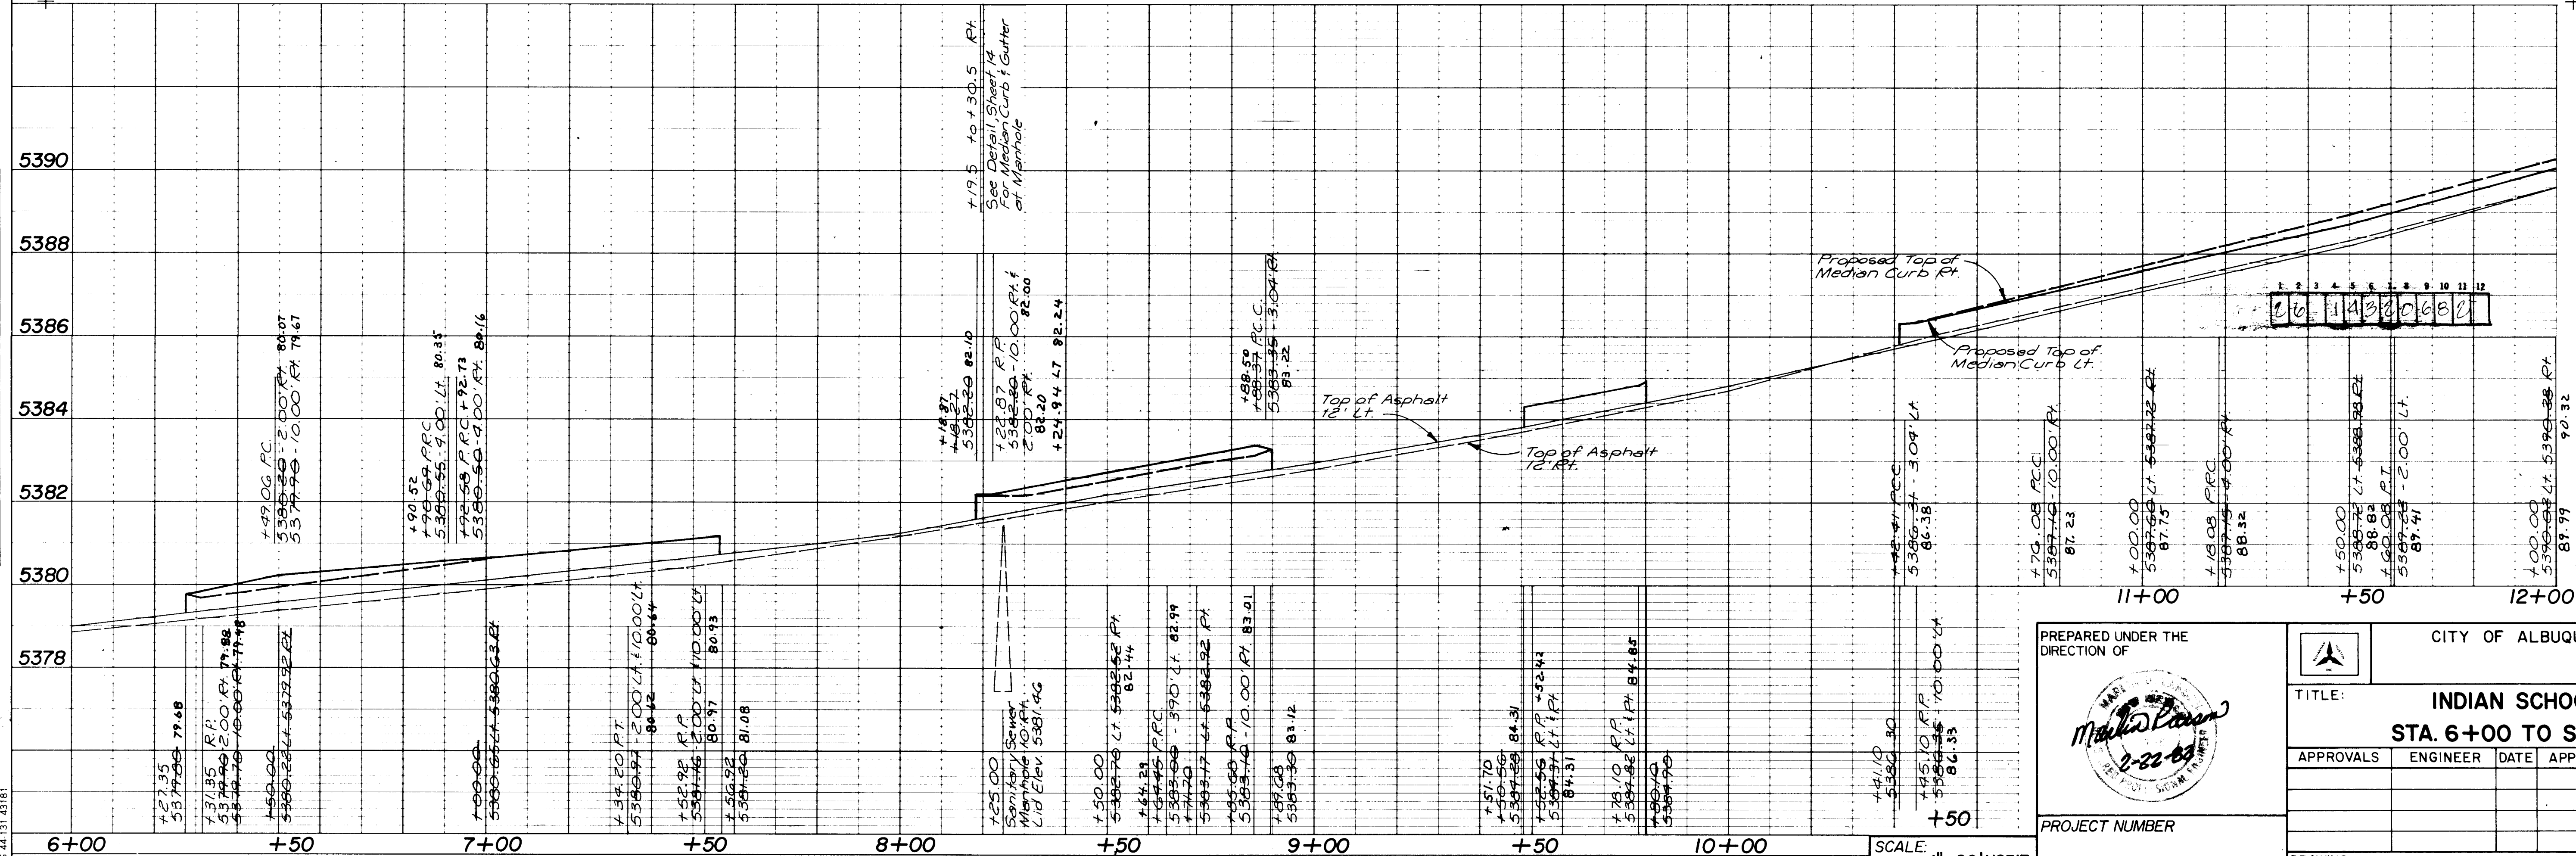


PLATE 1 SINGLE PLAN - PROFILE
CHARLES BRUNING CO.
MADE IN U.S.A.

SCALE:
1" = 20' HORIZ.
1" = 2' VERT.

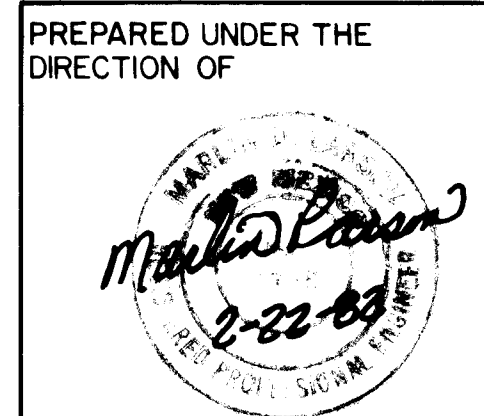

CITY OF ALBUQUERQUE	
TITLE: INDIAN SCHOOL RD. STA. 6+00 TO STA. 12+00	
APPROVALS	ENGINEER
DATE	DATE
PROJECT NUMBER	
DRAWING NO. 1432	
SHEET 6 OF 14	

F.H.W.A.	Region No.	SHEET NO.	TOTAL SHEETS
6	NEW MEXICO		

AS-BUILT INFORMATION	
CONTRACTOR	WORK
STATIONED BY	DATE
ACCEPTANCE BY	DATE
FIELD	DATE
CORRECTED BY	DATE
MICRO-FILM INFORMATION	
RECORDED BY	DATE
NO.	


SURVEY INFORMATION	
EST. NO.	NO.
BY	DATE
BENCH MARKS	
Located at the intersection of Indian School Rd. N.E. and Childrens Dr. N.E., in the NW quadrant of the intersection. A square, 12", chiseled on top of the concrete curb at the NNW return. Elev. 5402.04	

REFERENCES	
MAP NO. 1432	1942.04
EST. NO.	NO.
BY	DATE
DESIGN	
DESIGNED BY	MDL
DRAWN BY	SAH
CHECKED BY	MDL
DATE	DATE

PLAN		BY	DATE
NO.	BOOK		
SURVEYED			
PLOTTED			
ALIGNMENT CHECKED			
RT. OF WAY CHECKED			

PROFILE		BY	DATE
NO.	BOOK		
SURVEYED			
PLOTTED			
STRUCTURE NOTATIONS CHKD			

*

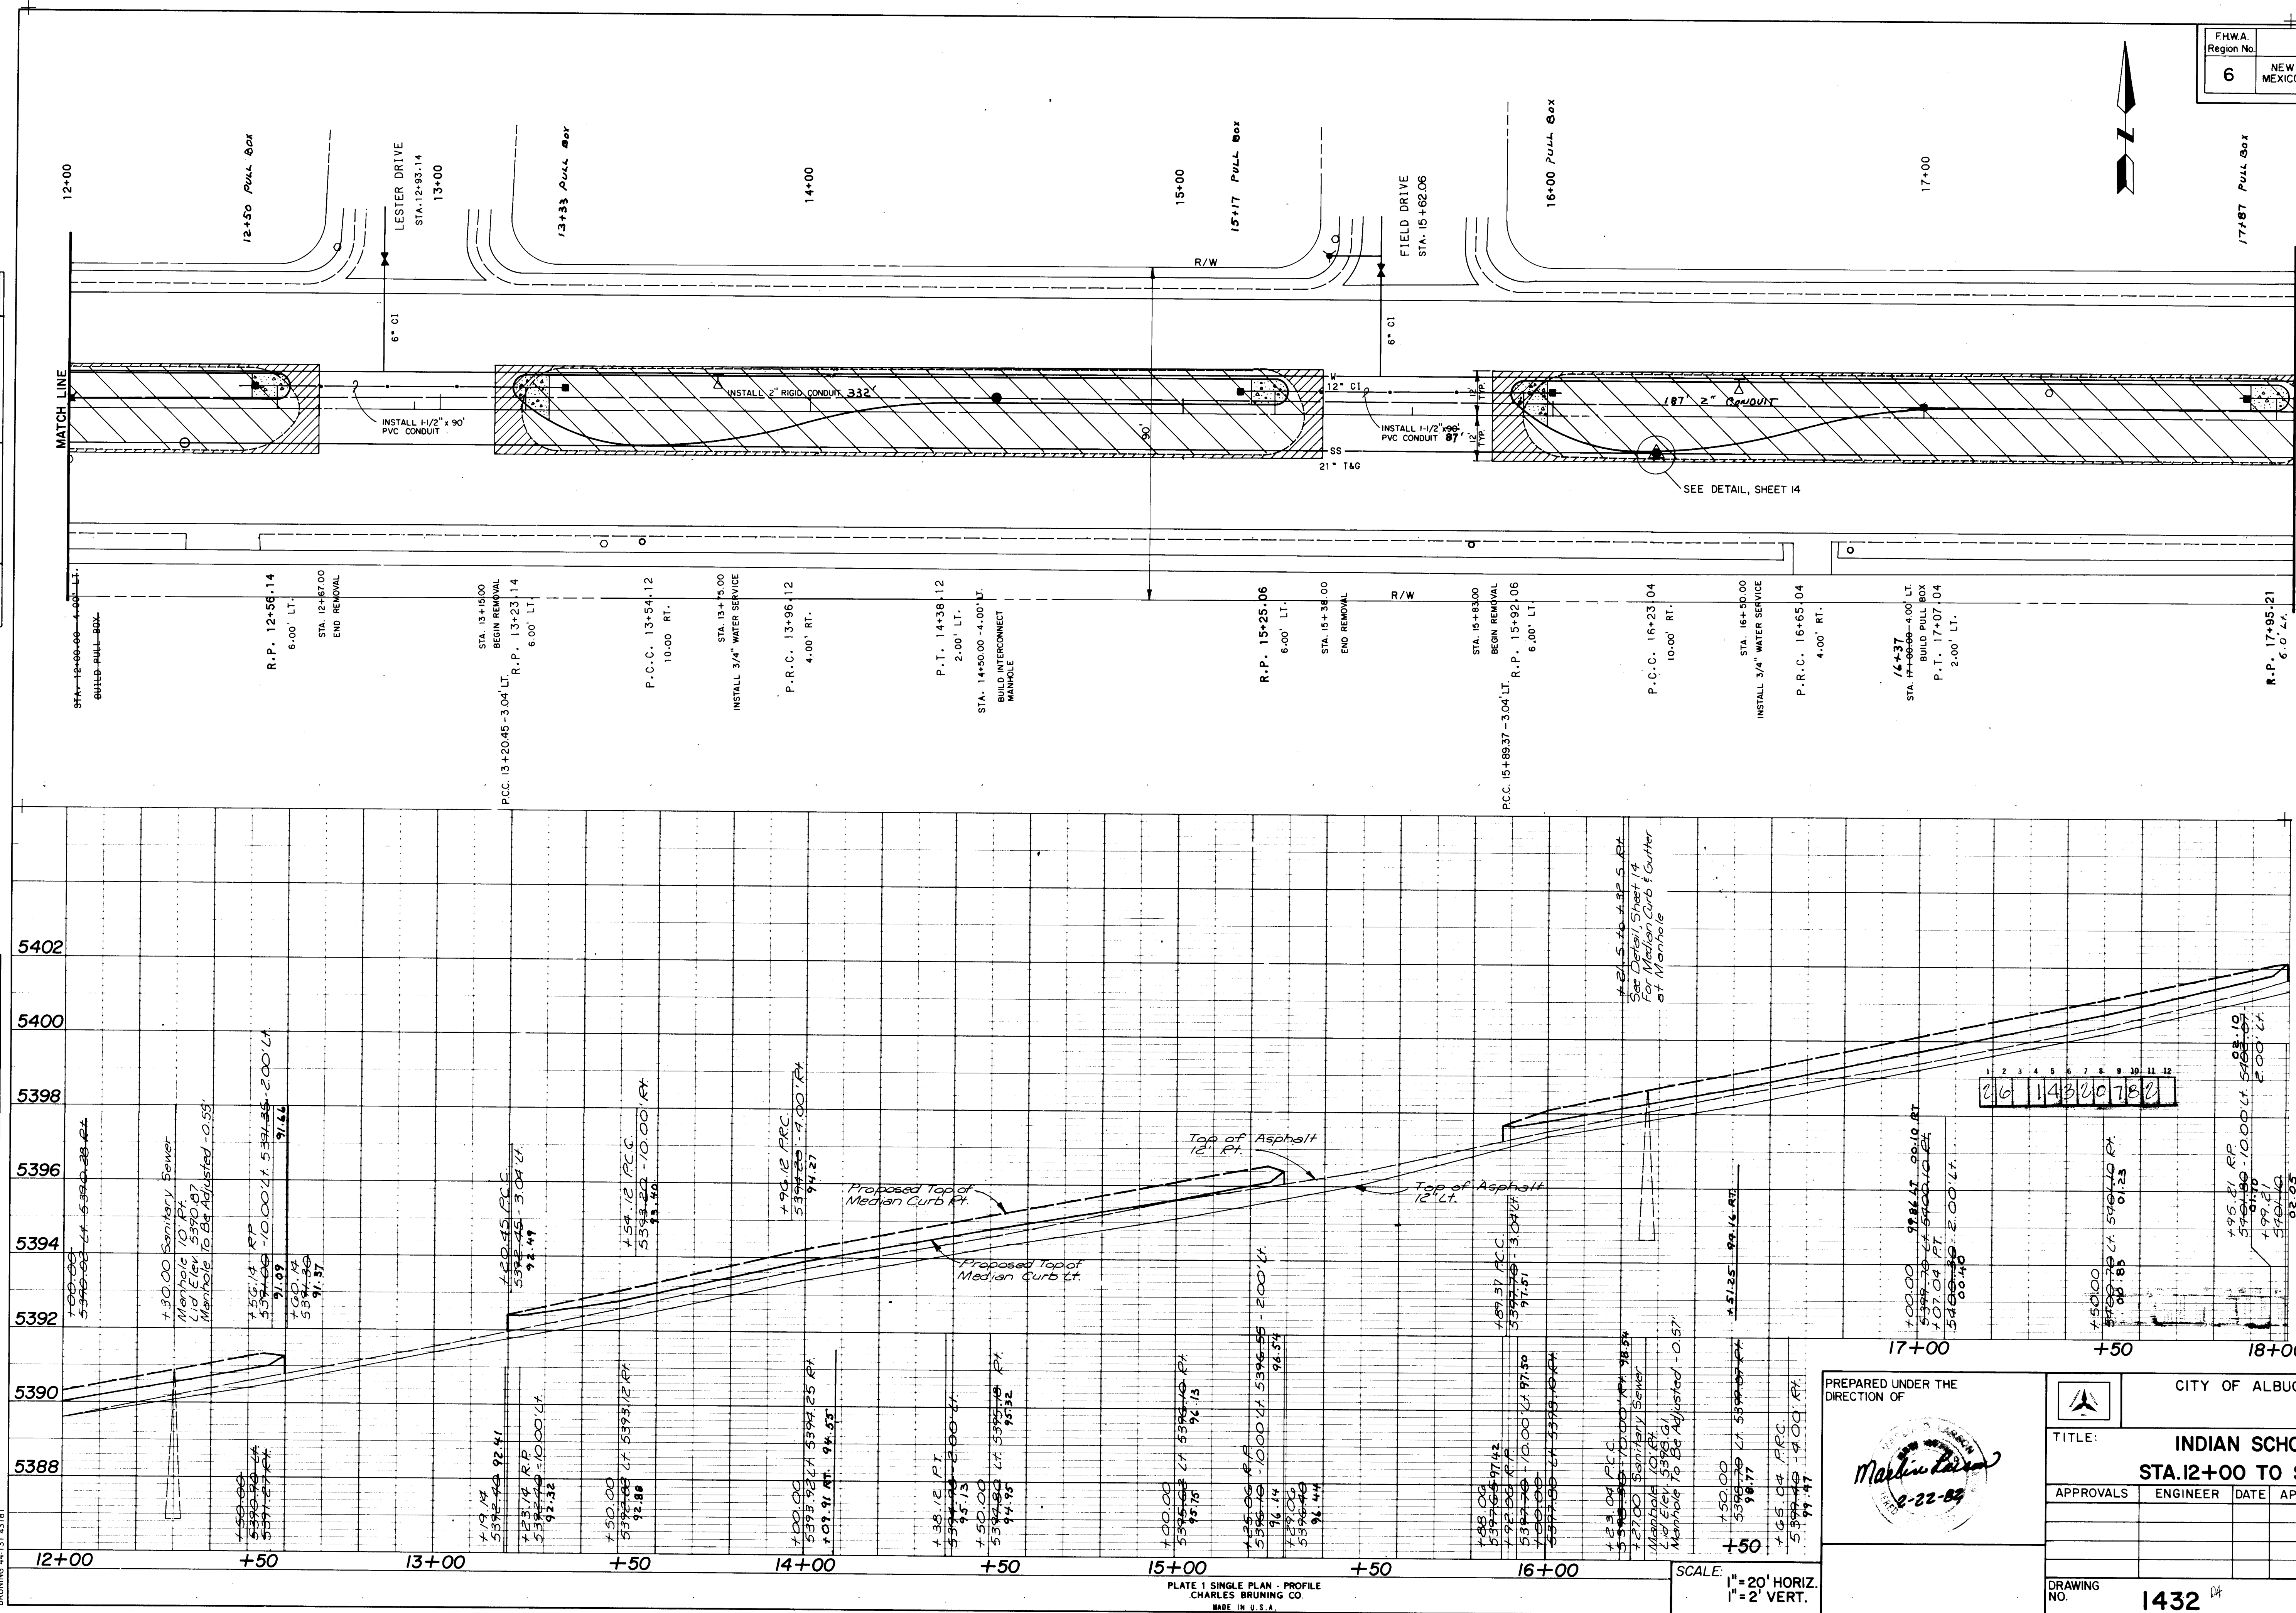

FHWA Region No.	NEW MEXICO	SHEET NO.	TOTAL SHEETS
-----------------	------------	-----------	--------------

AS-BUILT INFORMATION	
CONTRACTOR	
WORK STARTED BY	
INSPECTOR'S DATE	
FIELD CHANGE BY	
VERIFICATION BY	
CORRECTED BY	
MICRO-FILM INFORMATION	
RECORDED BY	
NO.	

BENCH MARKS	
Located at the intersection of Indian School Rd. N.E. and Childers Dr. N.E., in the NW quadrant of the intersection. A square, 12" x 12", chiseled on top of the concrete curb at the N.W. return. Elev. 5402.04	

SURVEY INFORMATION	
DATE	
BY	
NO.	



REFERENCES	
MAP NO. H & J 17 & 20	
EST. NO.	
W.O. NO.	


REVISIONS	
NO.	DATE
1	5/10/88 Revised Curb & Gutter at Manhole.

DESIGNED BY	MDL	DATE	12-81
DRAWN BY	SAH	DATE	12-81
CHECKED BY	MDL	DATE	12-81

CITY OF ALBUQUERQUE	
TITLE: INDIAN SCHOOL RD. STA. 12+00 TO STA. 18+00	
APPROVALS	ENGINEER
DATE	DATE
APPROVALS	ENGINEER
DATE	DATE

PREPARED UNDER THE DIRECTION OF	
SCALE: 1" = 20' HORIZ. 1" = 2' VERT.	

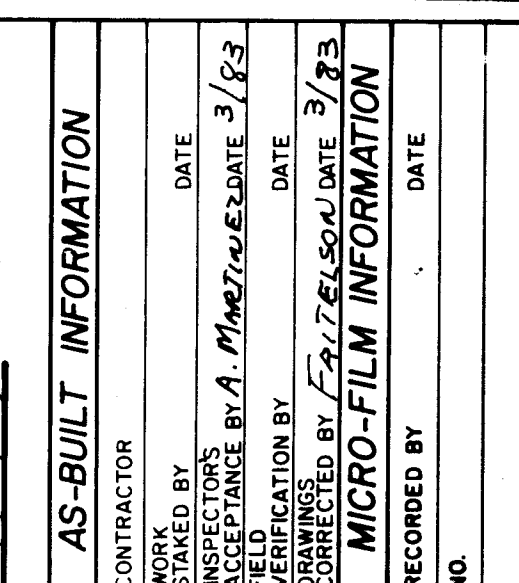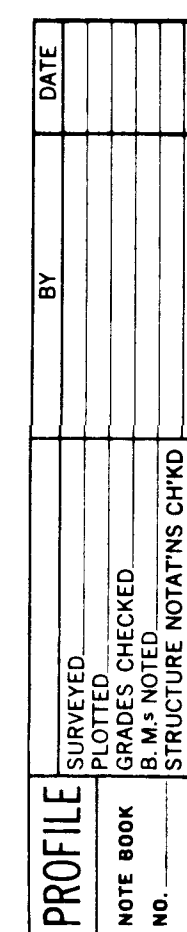

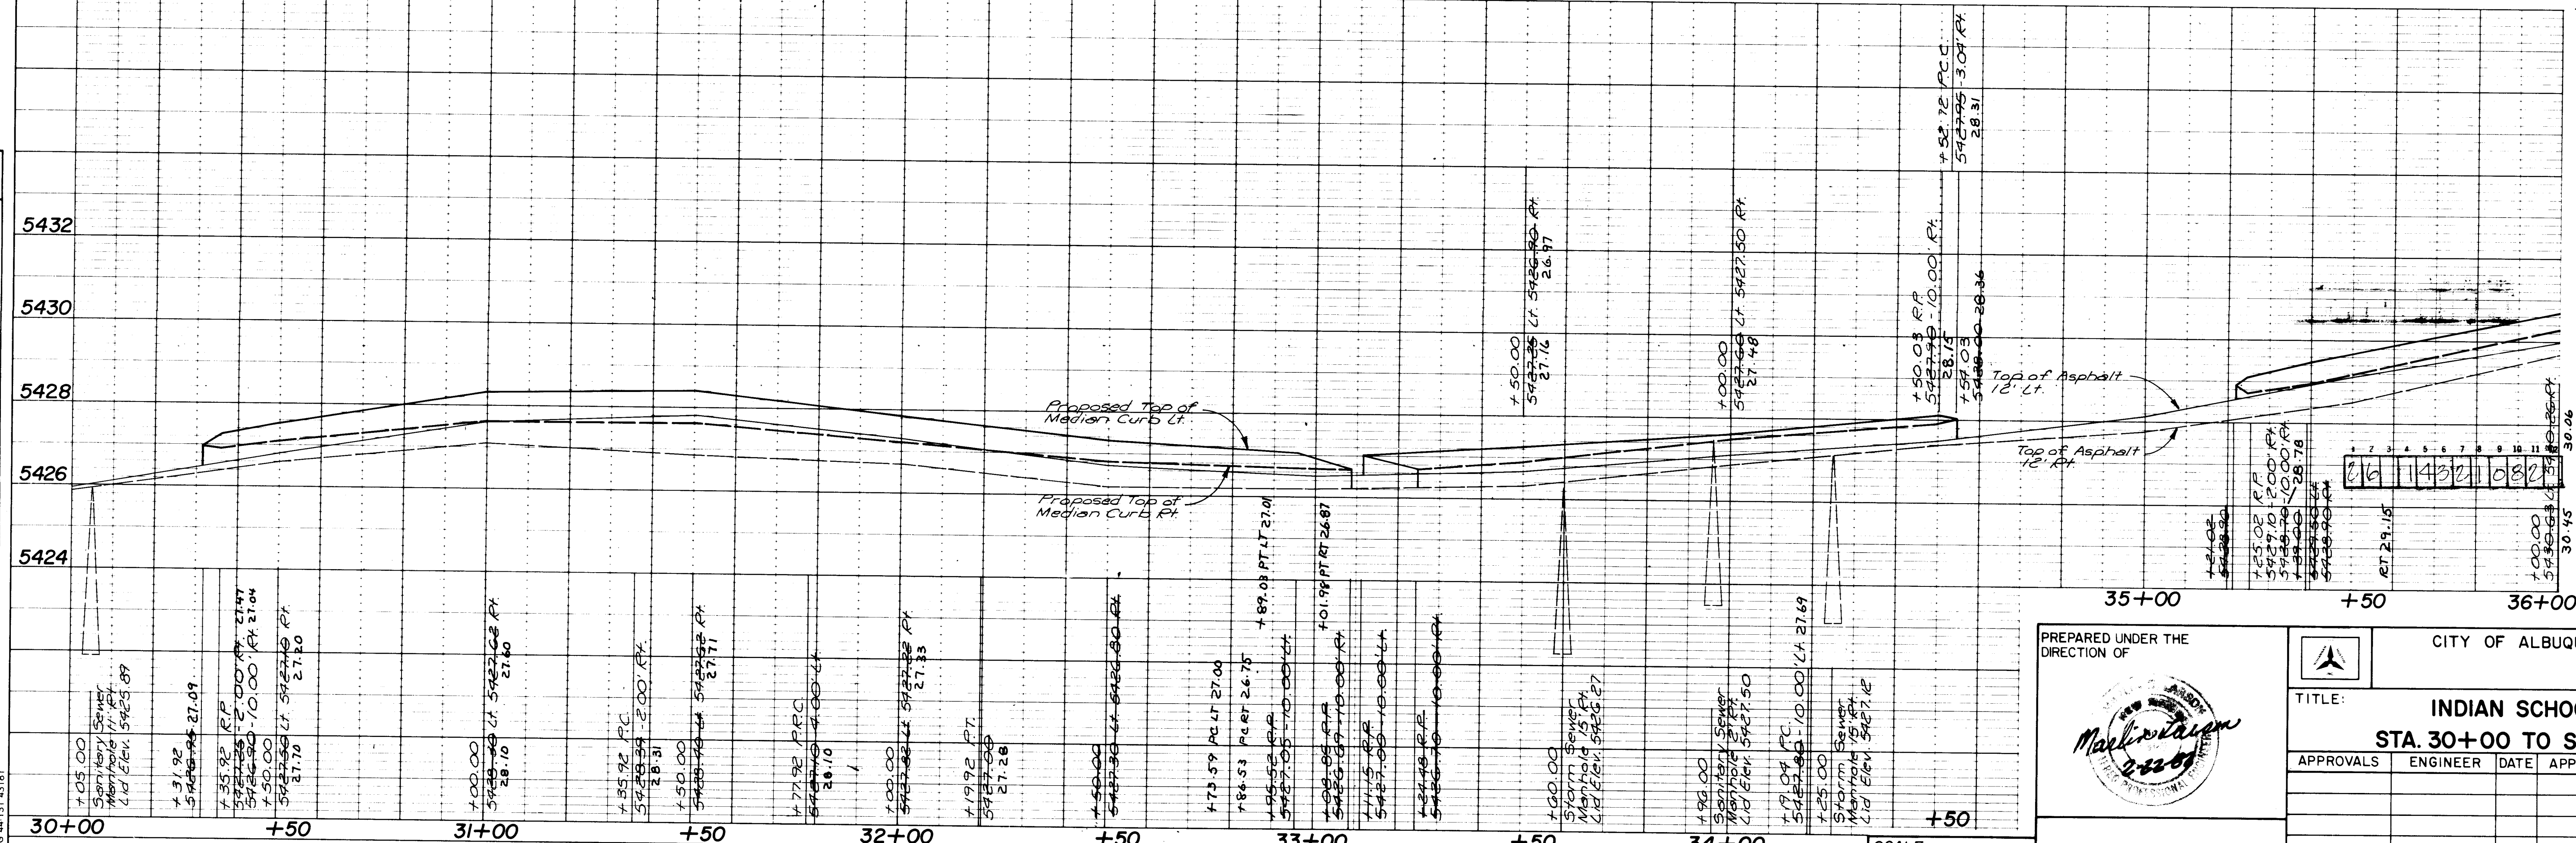

SCALE: 1" = 20' HORIZ.
1" = 2' VERT.

TITLE:

INDIAN SCHOOL RD.
STA. 30+00 TO STA. 36+00

APPROVALS	ENGINEER	DATE	APPROVALS	ENGINEER	DATE
-----------	----------	------	-----------	----------	------

--	--	--	--	--	--

DRAWING
NO.

1432

SHEET 10 OF 14


				BENCH MARKS		WATER LINE	
REFERENCES		SURVEY INFORMATION		AS-BUILT INFORMATION			
SAH	MAP NO. 11-1	W.O. NO.	DATE	CONTRACTOR			
1	5448E Revised Conduits & Pull Boxes			STAMPED BY			
				INSPECTOR'S ACCEPTANCE BY A. Martinez DATE 3/93			
NO.	DATE	REMARKS	BY	VERIFICATION BY			
		REVISIONS		DRAWINGS COURTESY OF DATE 3/93			
				MICRO-FILM INFORMATION			
DESIGNED BY	MDL	DATE	12-81	RECORDED BY			
DRAWN BY	SAH	DATE	12-81	DATE			
CHECKED BY	MDL	DATE	12-81	NO.			

F.H.W.A. Region No.			SHEET NO.	TOTAL SHEET
6	NEW MEXICO			



PLAN	DATE	BY
SURVEYED		
PLOTTED		
NOTED		
NO.		

PROFILE	DATE	BY
SURVEYED		
PLOTTED		
NOTED		
NO.		

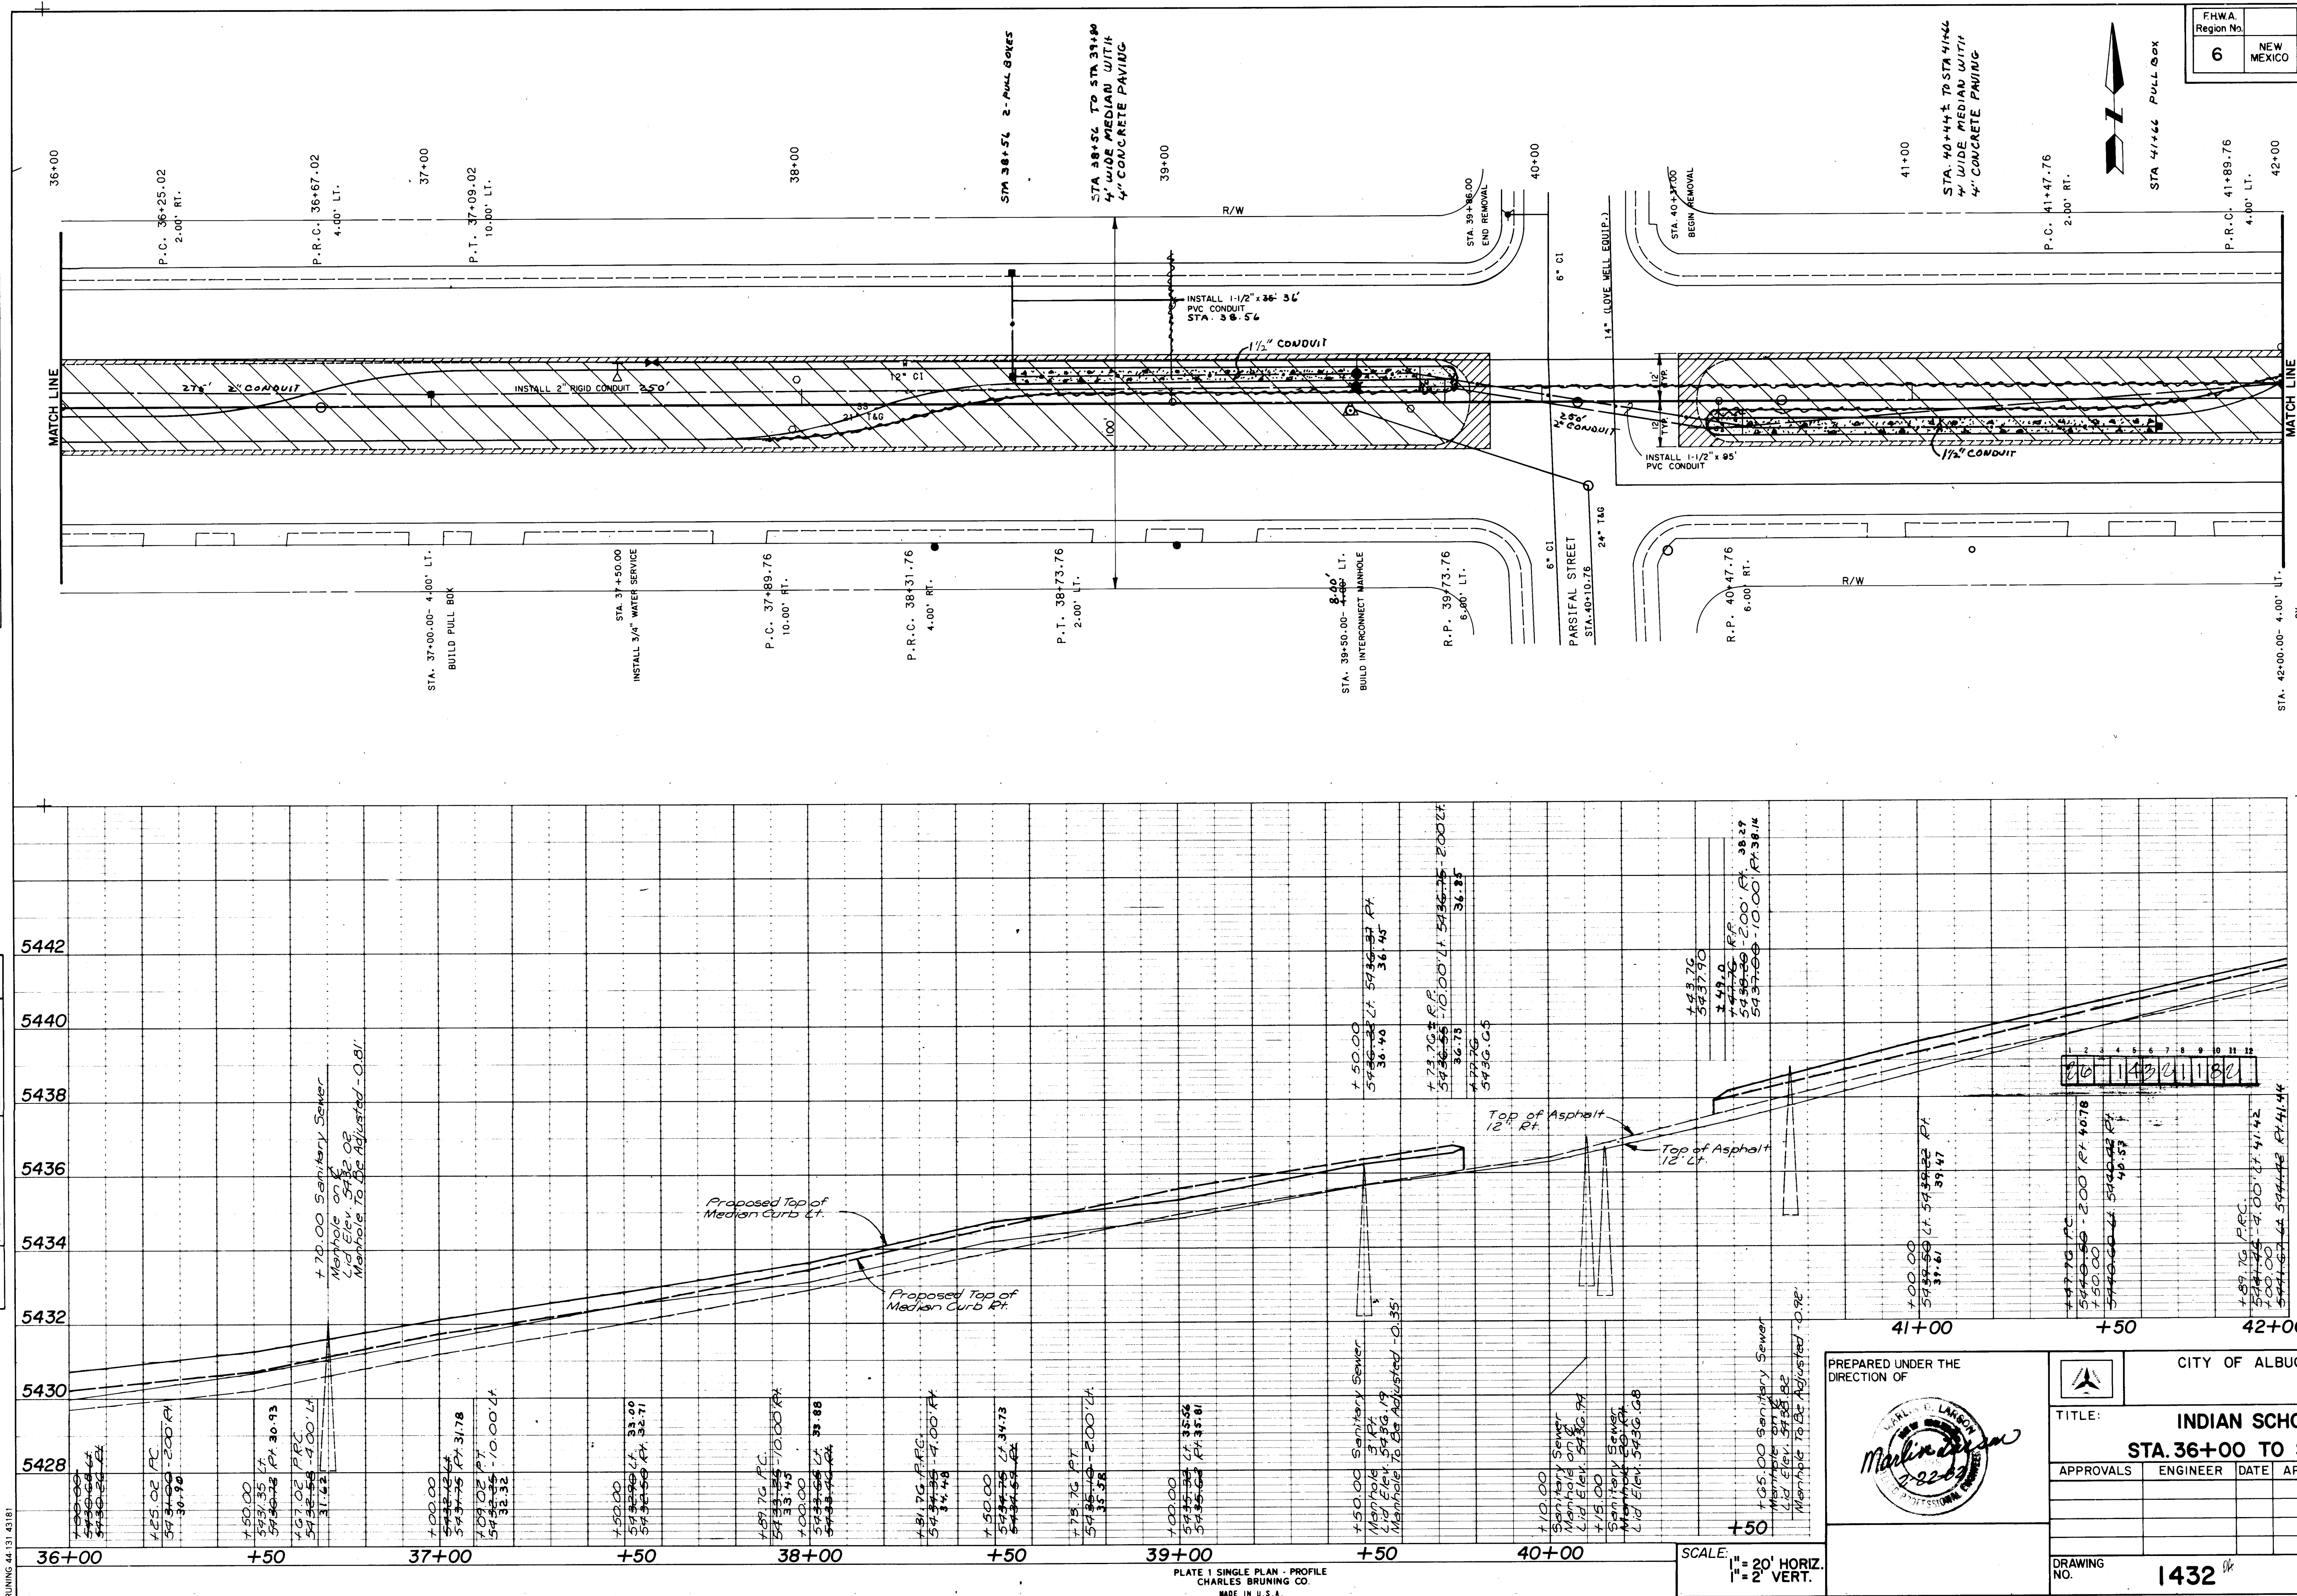

F.H.W.A. Region No.	NEW MEXICO
SHEET NO.	11
TOTAL SHEETS	14

AS-BUILT INFORMATION			
CONTRACTOR	DATE	BY	NO.
INSPECTOR	DATE	BY	NO.
ACCEPTANCE BY	DATE	BY	NO.
VERIFICATION BY	DATE	BY	NO.
MICRO-FILM INFORMATION			
RECORDED BY	DATE	BY	NO.

SURVEY INFORMATION			
MAP NO.	DATE	BY	NO.
EST. NO.	DATE	BY	NO.
NO.	DATE	BY	NO.

REFERENCES			
MAP NO.	DATE	BY	NO.
EST. NO.	DATE	BY	NO.
NO.	DATE	BY	NO.

BENCH MARKS			
CONTRACTOR	DATE	BY	NO.
INSPECTOR	DATE	BY	NO.
ACCEPTANCE BY	DATE	BY	NO.
VERIFICATION BY	DATE	BY	NO.


REVISIONS			
NO.	DATE	REMARKS	BY
1			
2			
3			
4			
5			
6			
7			
8			
9			
10			
11			
12			

DESIGN			
DESIGNED BY	DATE	BY	NO.
DRAWN BY	DATE	BY	NO.
CHECKED BY	DATE	BY	NO.

CITY OF ALBUQUERQUE					
INDIAN SCHOOL RD.					
STA. 36+00 TO STA. 42+00					
APPROVALS	ENGINEER	DATE	APPROVALS	ENGINEER	DATE
DRAWING NO. 1432			SHEET 11 OF 14		

PROFILE
SURVEYED
PLOTTED
CHECKED
DATE
BY
NOTE BOOK
NO.

PLAN
SURVEYED
PLOTTED
CHECKED
DATE
BY
NOTE BOOK
NO.

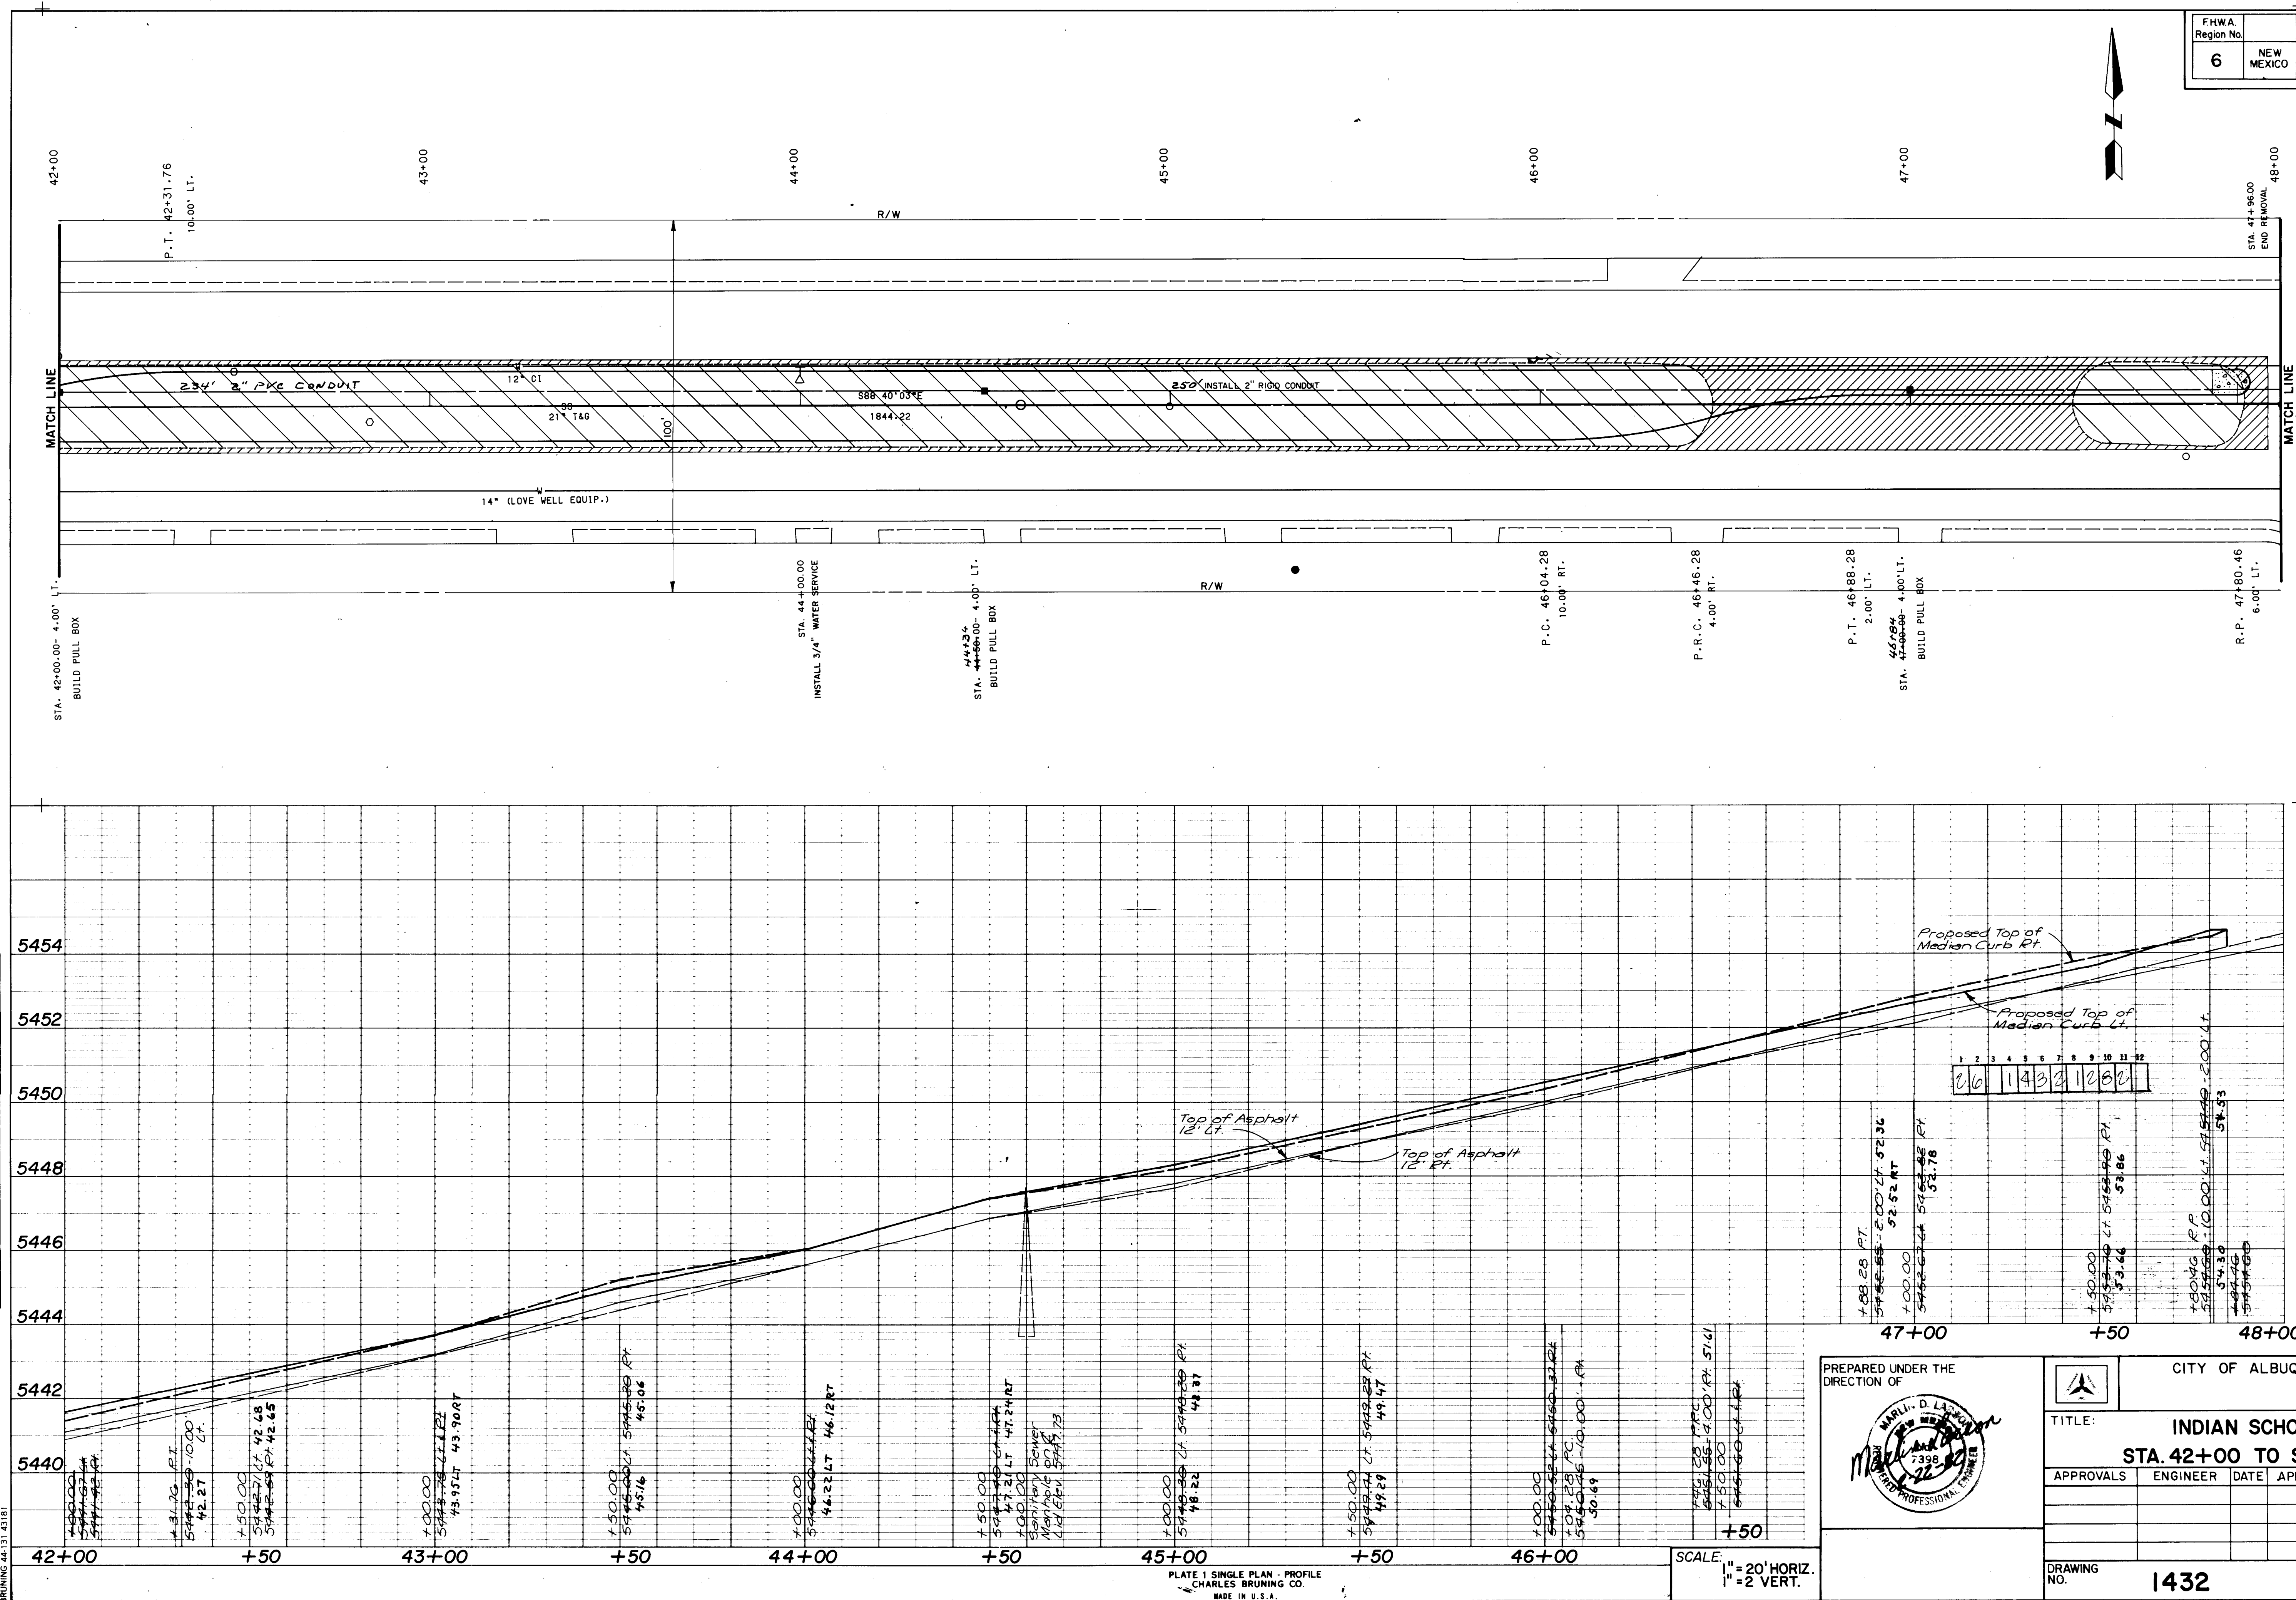


FHWA
Region No.
6
NEW
MEXICO

SHEET
NO.
12
TOTAL
SHEETS
14

AS-BUILT INFORMATION			
CONTRACTOR	DATE	WORKED BY	DATE
INSPECTORS	DATE	ACCEPTANCE BY	DATE
VERIFICATION BY	DATE	DRAWING NO.	DATE
MICRO-FILM INFORMATION			
RECORDED BY	DATE	NO.	

SURVEY INFORMATION			
MAP NO.	EST. NO.	W.O. NO.	DATE
REFERENCES			
NO.	DATE	REMARKS	BY

DESIGN			
DESIGNED BY	MDL	DATE	12-81
DRAWN BY	SAH	DATE	12-81
CHECKED BY	MDL	DATE	12-81

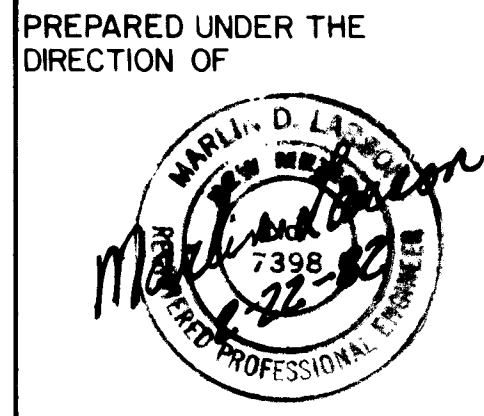

PREPARED UNDER THE
DIRECTION OF

CITY OF ALBUQUERQUE

TITLE:
INDIAN SCHOOL RD.
STA. 42+00 TO STA. 48+00

APPROVALS	ENGINEER	DATE	APPROVALS	ENGINEER	DATE

DRAWING NO. 1432 SHEET 12 OF 14

PLAN	SURVEYED	BY	DATE
NO.	PLOTTED		
	CHECKED		
	RT. OF WAY CHECKED		

PROFILE	SURVEYED	BY	DATE
NO.	PLOTTED		
	CHECKED		
	STRUCTURE NOTATIONS CHMD		


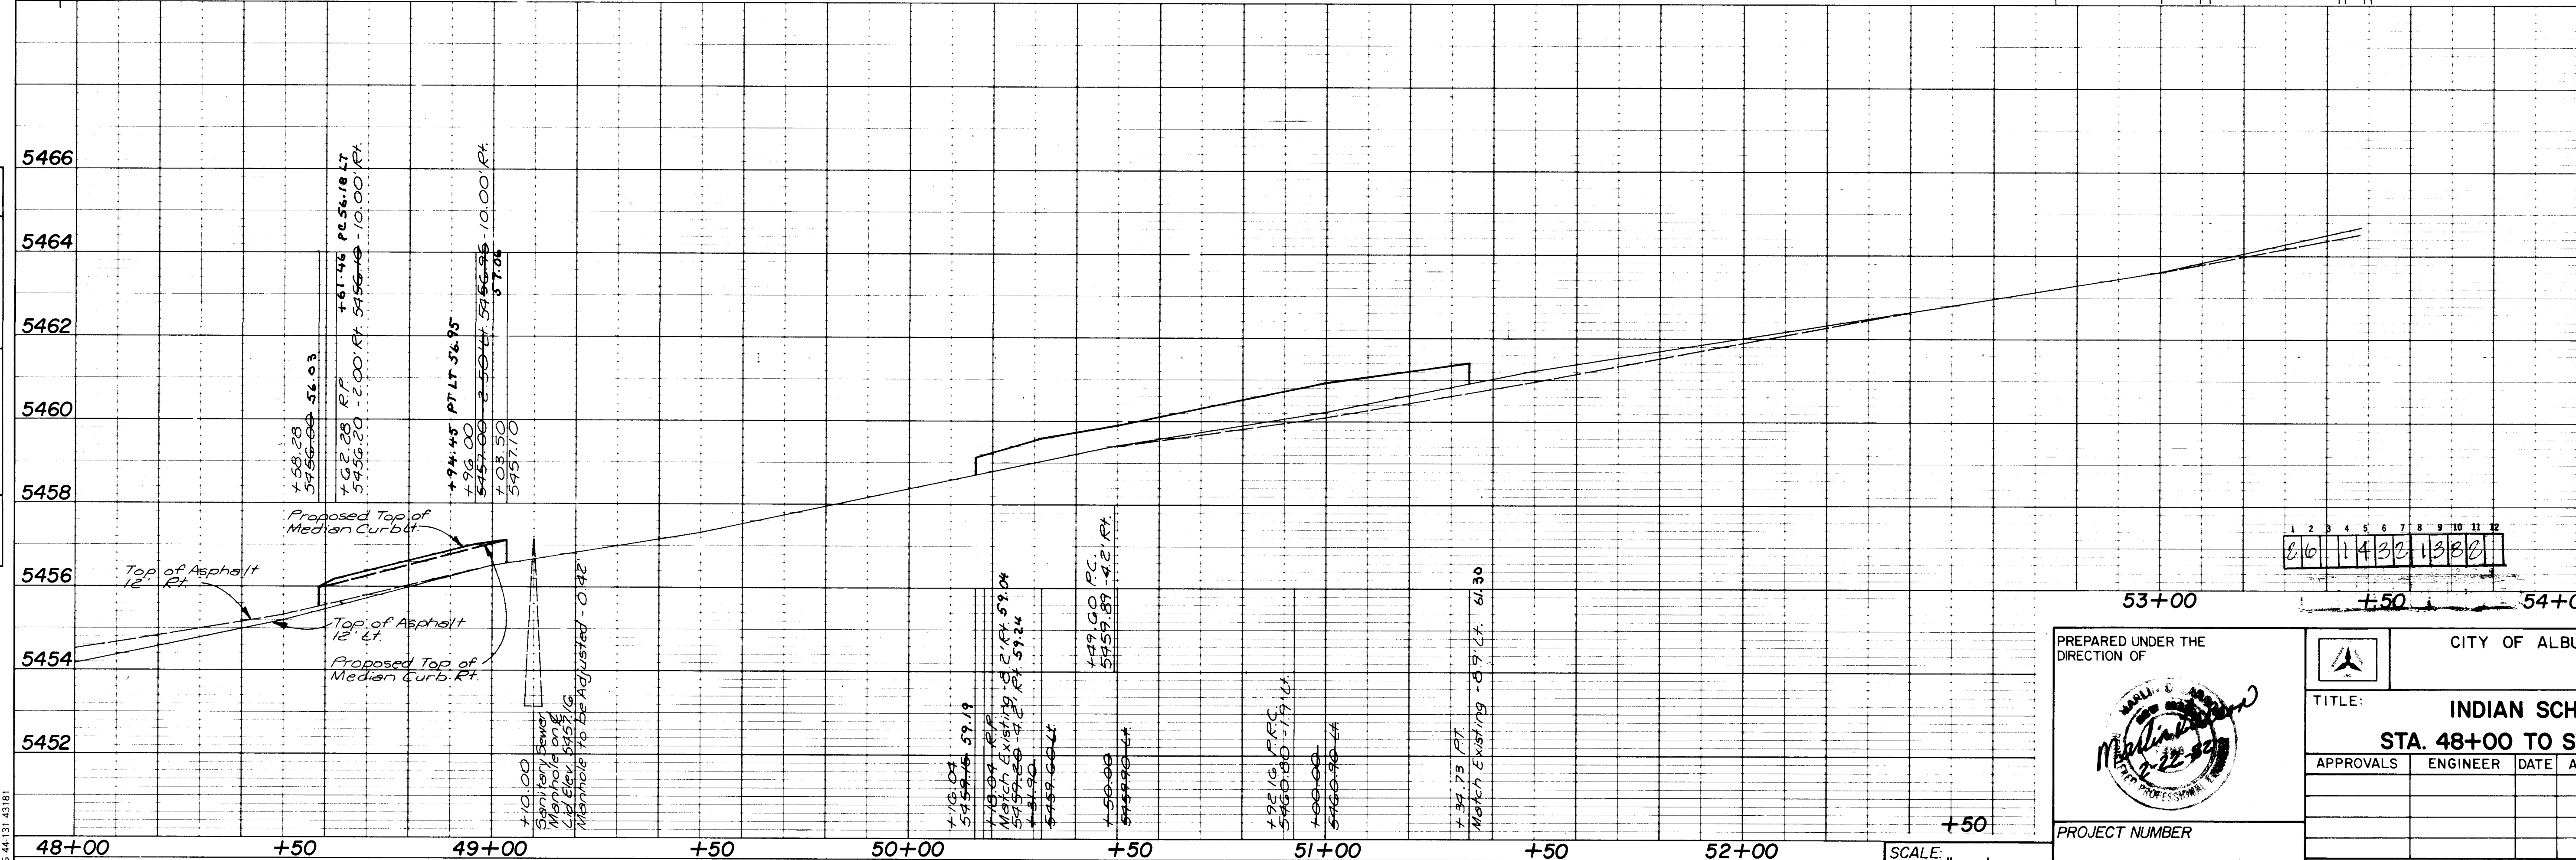


PLATE 1 SINGLE PLAN - PROFILE
CHARLES BRUNING CO.
MADE IN U.S.A.

SCALE:
1"=20' HORIZ.
1"=2' VERT.

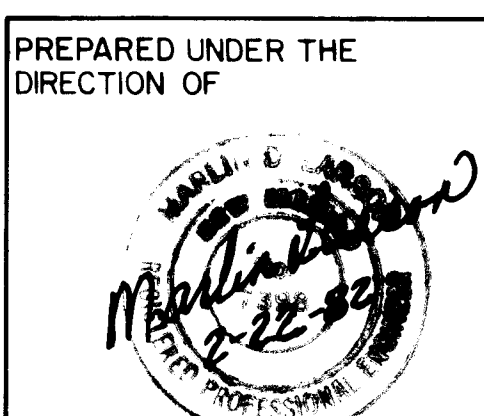


CITY OF ALBUQUERQUE					
TITLE: INDIAN SCHOOL RD. STA. 48+00 TO STA. 53+46.82					
APPROVALS	ENGINEER	DATE	APPROVALS	ENGINEER	DATE
DRAWING NO. 1432			SHEET 13 OF 14		

FHWA Region No.	NEW MEXICO	SHEET NO.	TOTAL SHEETS
6			


REFERENCES		SURVEY INFORMATION		BENCH MARKS		AS-BUILT INFORMATION	
MAP NO.	EST. NO.	BY	DATE	CONTRACTOR	WORKS BY	DATE	DATE
H 3 d	19 5 10				ACCEPTED BY	DATE	DATE
					VERIFICATION BY	DATE	DATE
					DRAWINGS BY	DATE	DATE
					CONTRACTOR	DATE	DATE
					RECORDED BY	DATE	DATE
					NO.		

Located on the south side of Indian School Road, in front of the "Circle K Store" in the 9900 block, approximately 150 ft. east of Glorieta Dr., N.E. A 60-penny nail in a power pole. Elev. 5456.21


- GENERAL NOTES:
- All traffic control devices shall comply with Chapter VI of the 1978 edition "Manual For Uniform Traffic Control Devices".
 - The Contractor shall prepare and submit to the Project Engineer a detailed detour plan, which must be approved by the City Traffic Engineer 3 working days in advance of any required lane closures other than those shown on these plans.
 - All signs must be installed before construction begins as directed by the Engineer. Sign heights shall be 7 feet above the sidewalk level.
 - All signs, barricades and/or drums will be reflectorized. All drums may have sand or water ballast limited to 100 lbs.
 - All sign locations will be selected in the field and approved by the Project Engineer. Distances may be adjusted for local conditions.
 - All signs will be ground mounted on single or double posts. Existing posts may be used at some locations, with the approval of the Project Engineer. Portable sign supports will be acceptable as an alternate.
 - All applicable signs will be moved forward as the construction progresses.
 - The Contractor shall maintain access to businesses and residences adjacent to the construction area.
 - When barriers are required after dark, all advance warning signs and all barricades shall be equipped with flashing warning lights (Type A), except that all channelizing barricades shall have steady burning warning lights (Type C).
 - All existing regulatory signs that need to be removed, relocated or reinstalled shall be done by the City of Albuquerque Traffic Engineering Division. The Contractor shall notify the Traffic Engineering Division 3 working days in advance of any required work.
 - The Contractor shall provide and maintain a safe and adequate means of channeling pedestrian traffic around all work areas throughout the period of construction. All such channelization shall be arranged to prevent pedestrians from having to enter the roadway in order to pass around the work areas.
 - All construction signing shall be black on a reflectorized orange field unless otherwise specified. All construction barricades and channelization devices shall be orange on white, reflectorized, unless otherwise specified.
 - All advance warning signs not directly applicable shall be removed, covered, or turned away from oncoming traffic.
 - Barricades and barrels shall not be intermixed in the same series of channelization.

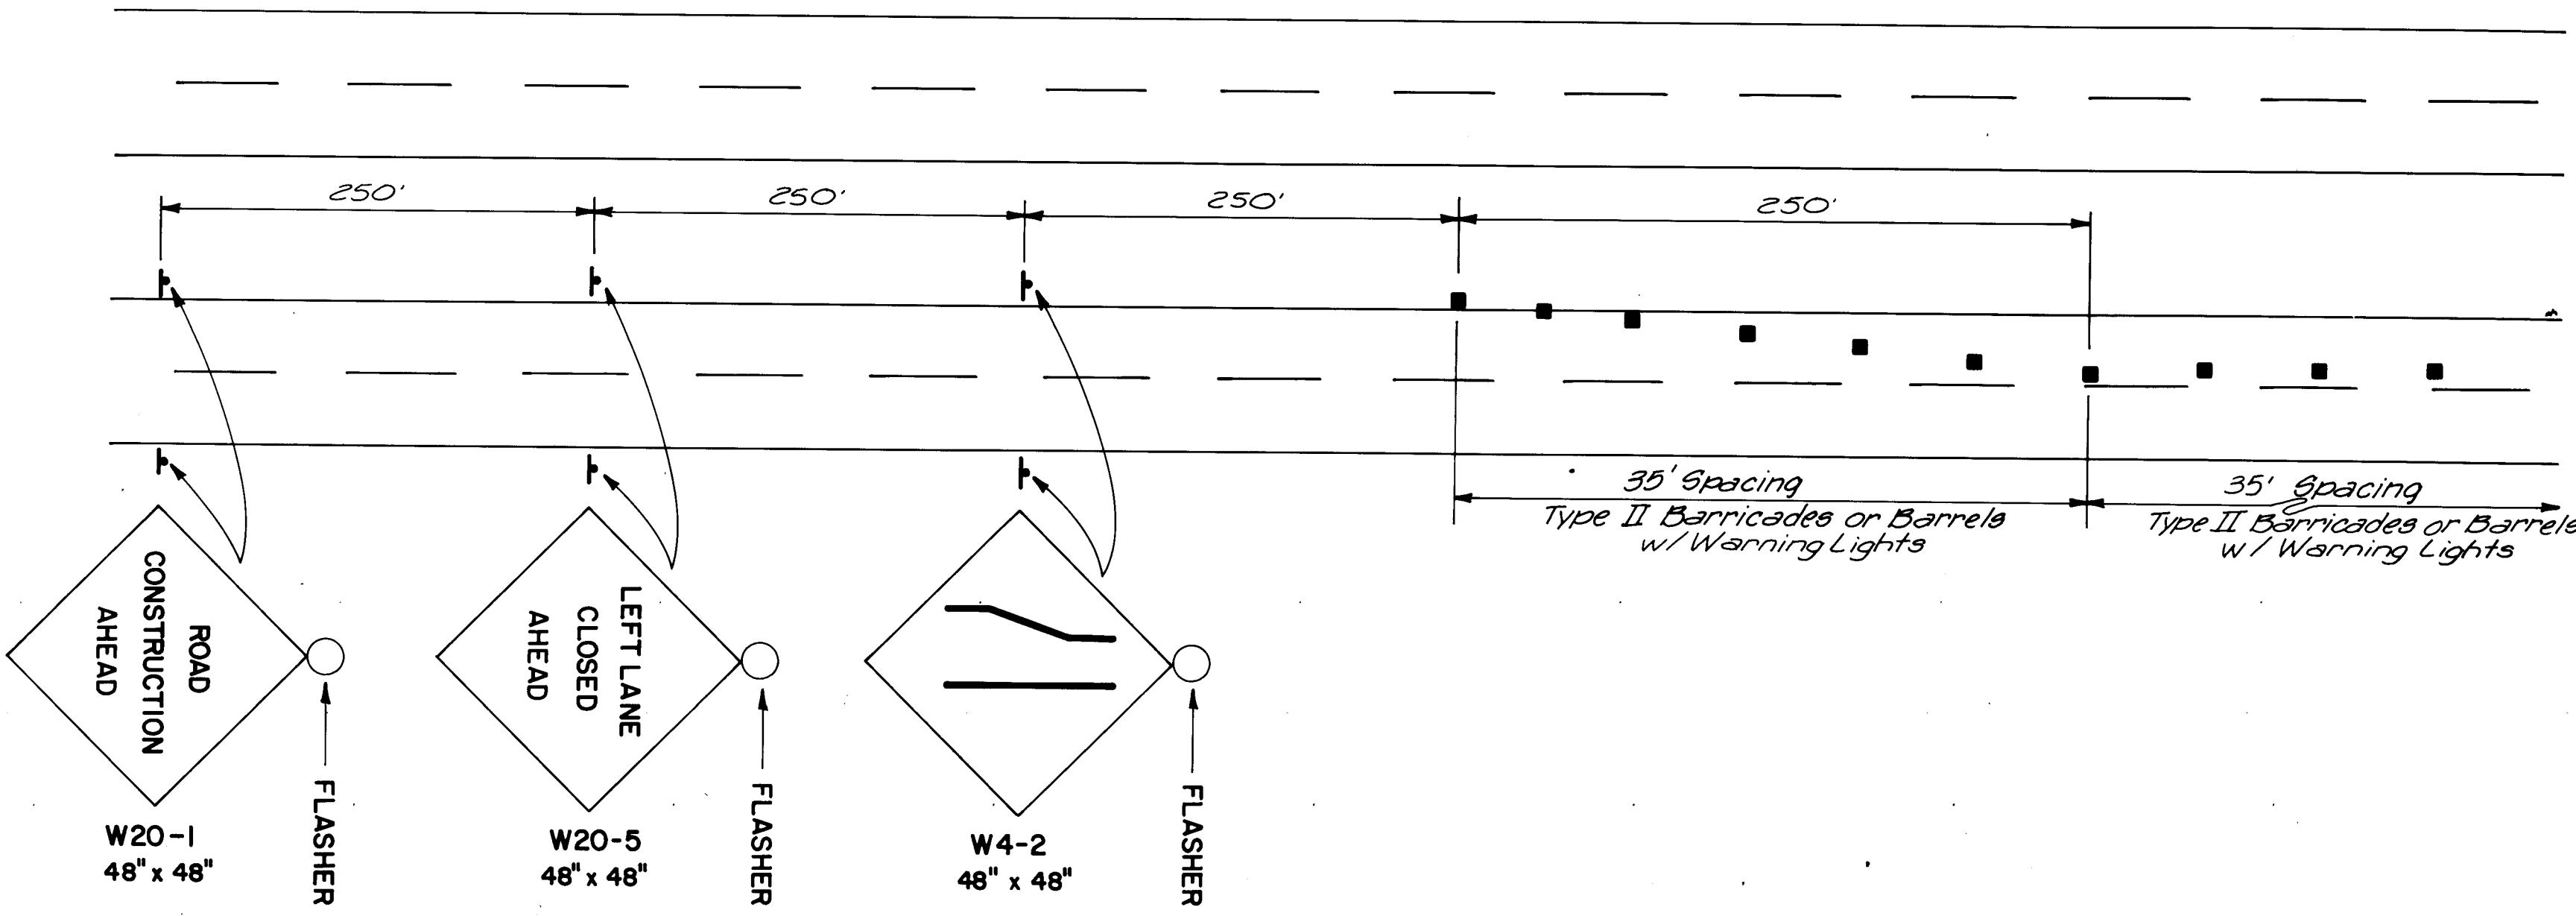


TYPICAL LEFT LANE CLOSURE
NO SCALE

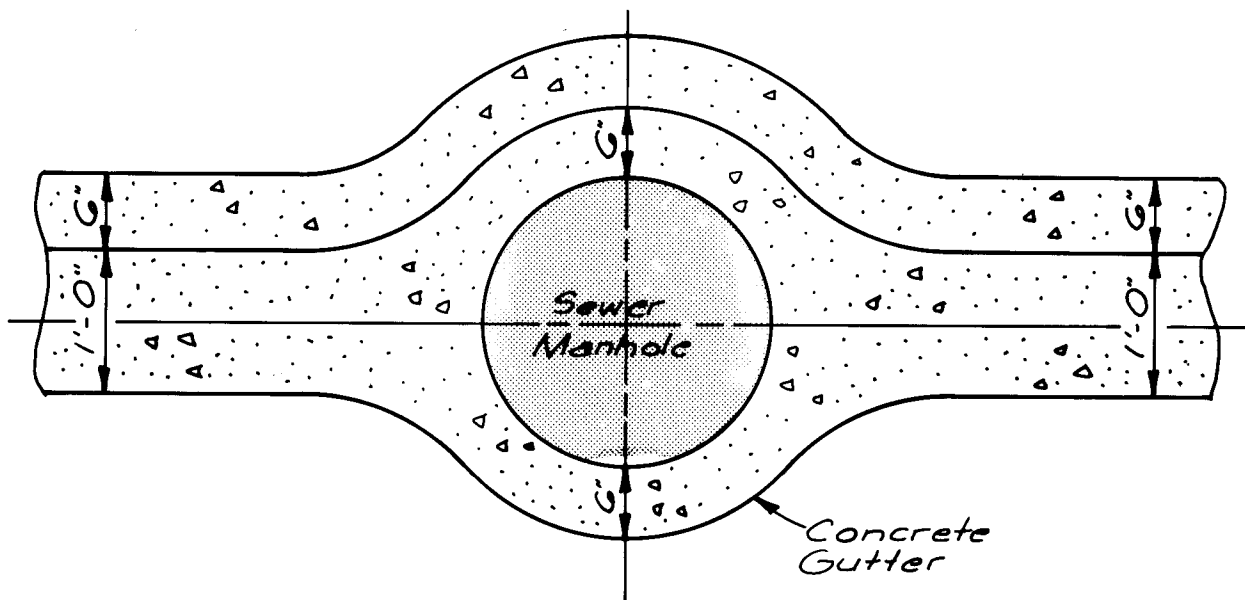


MEDIAN CURB & GUTTER AT MANHOLE

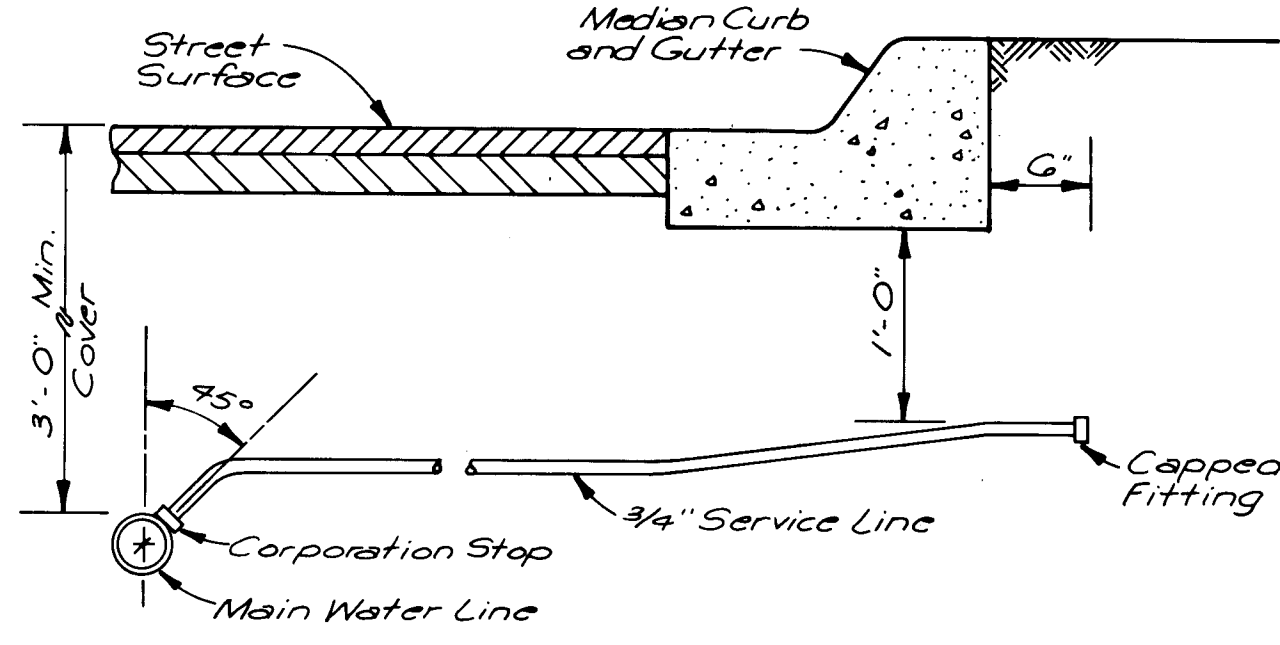

WATER SERVICE

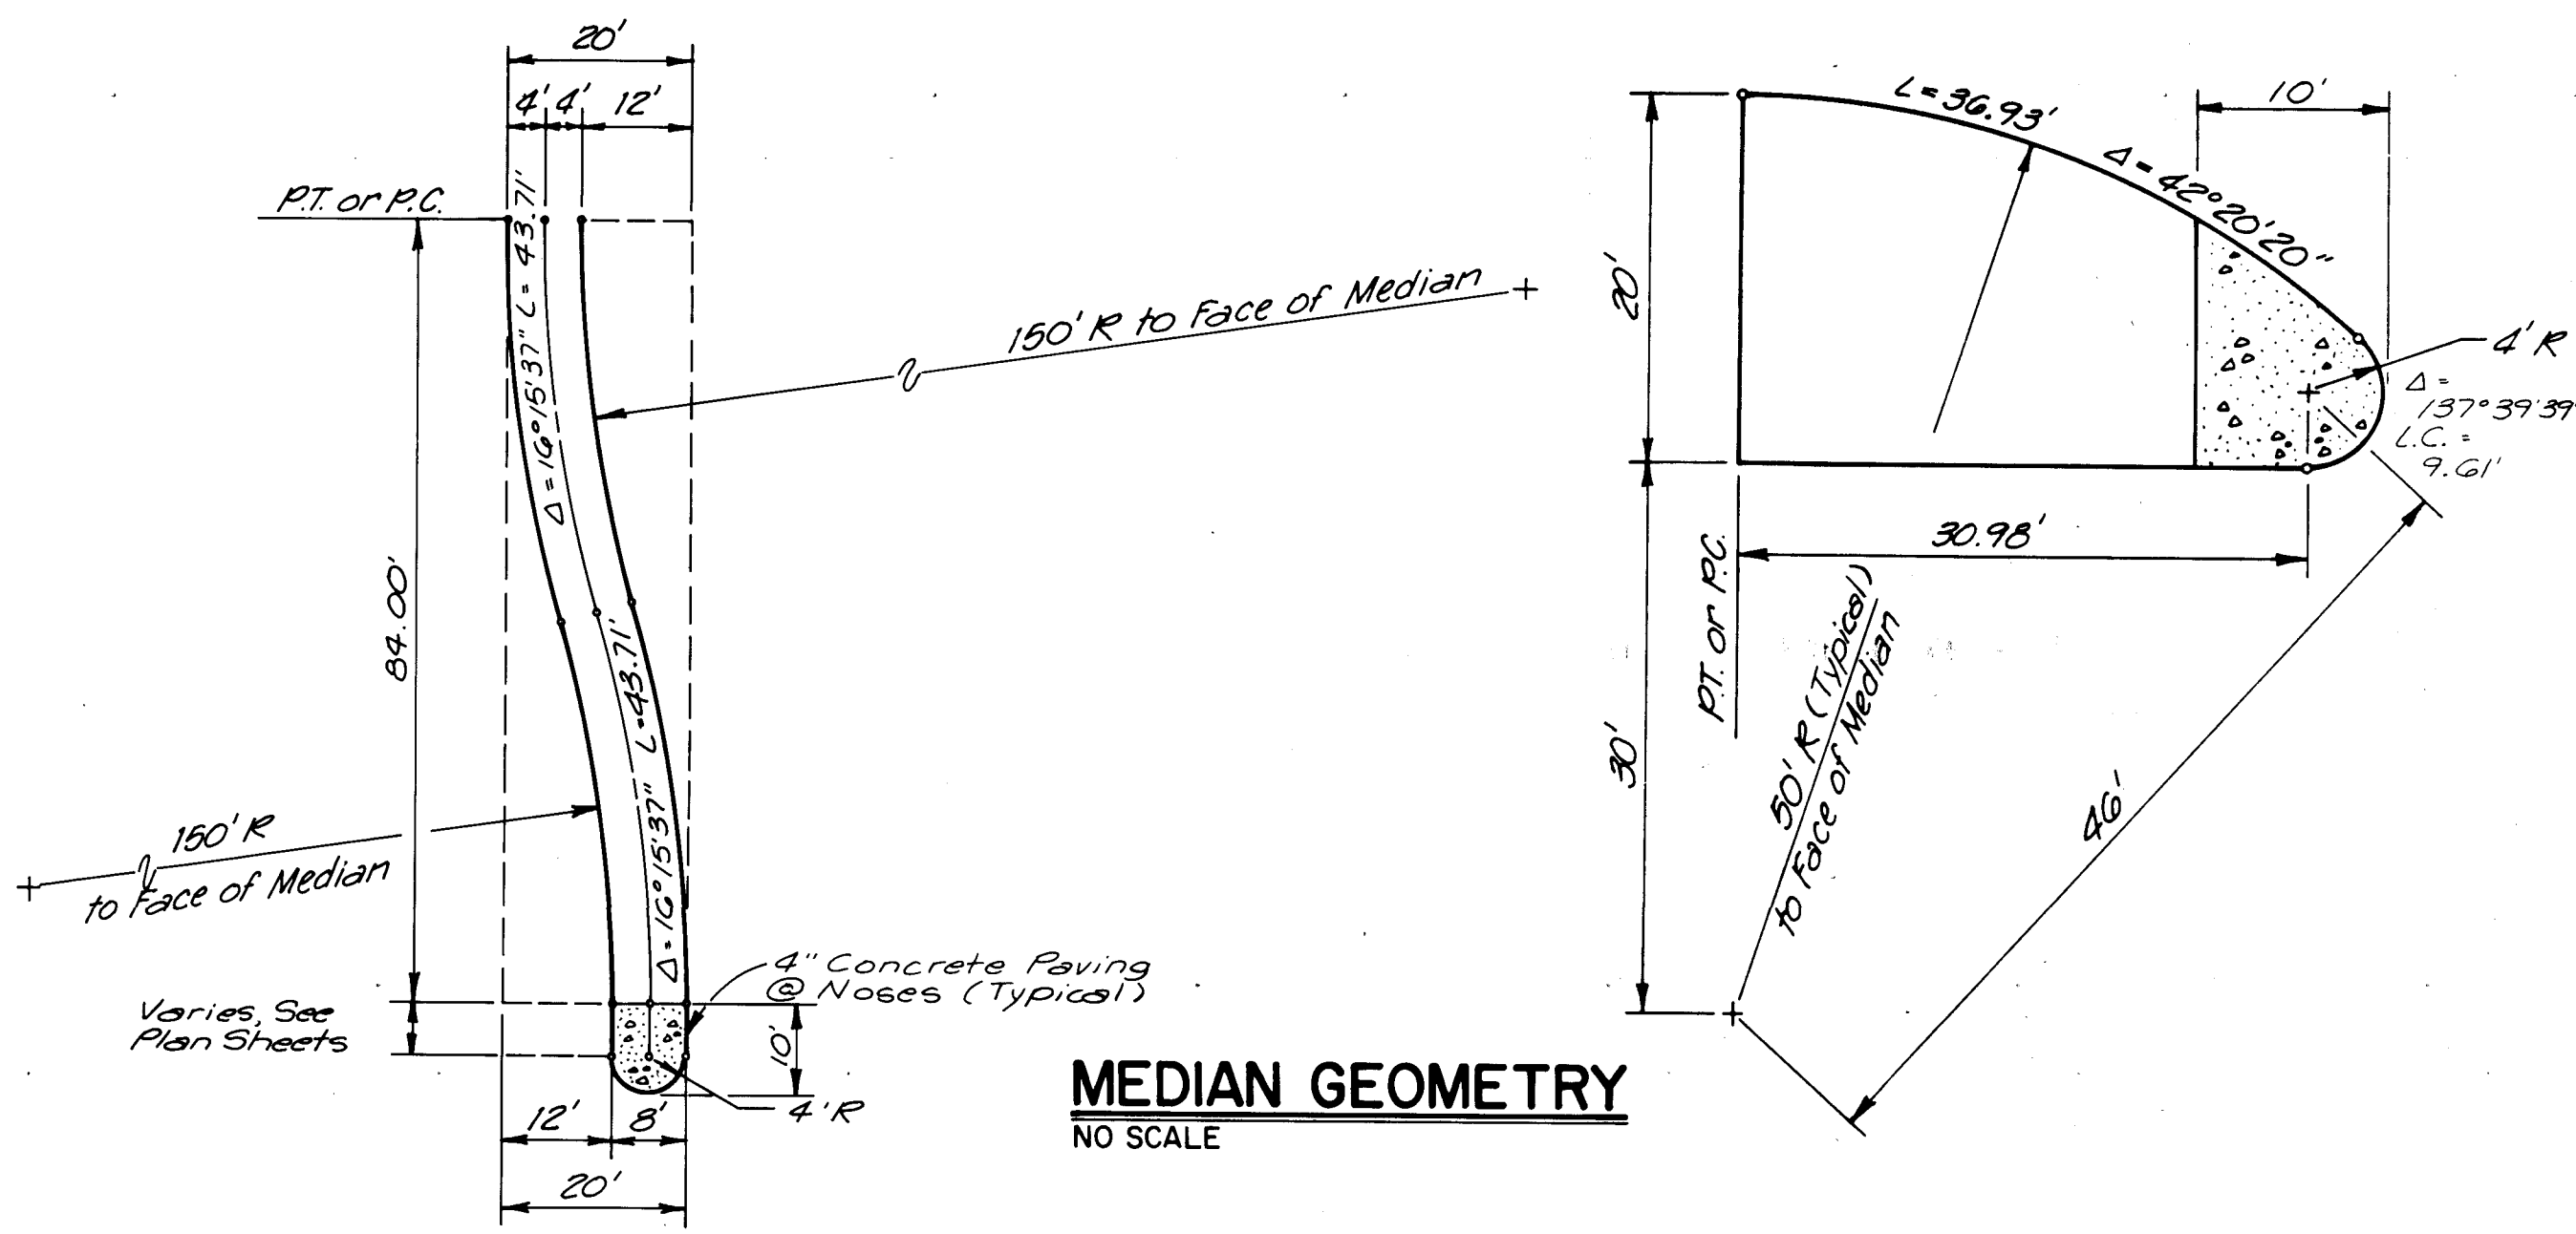

MEDIAN GEOMETRY
NO SCALE

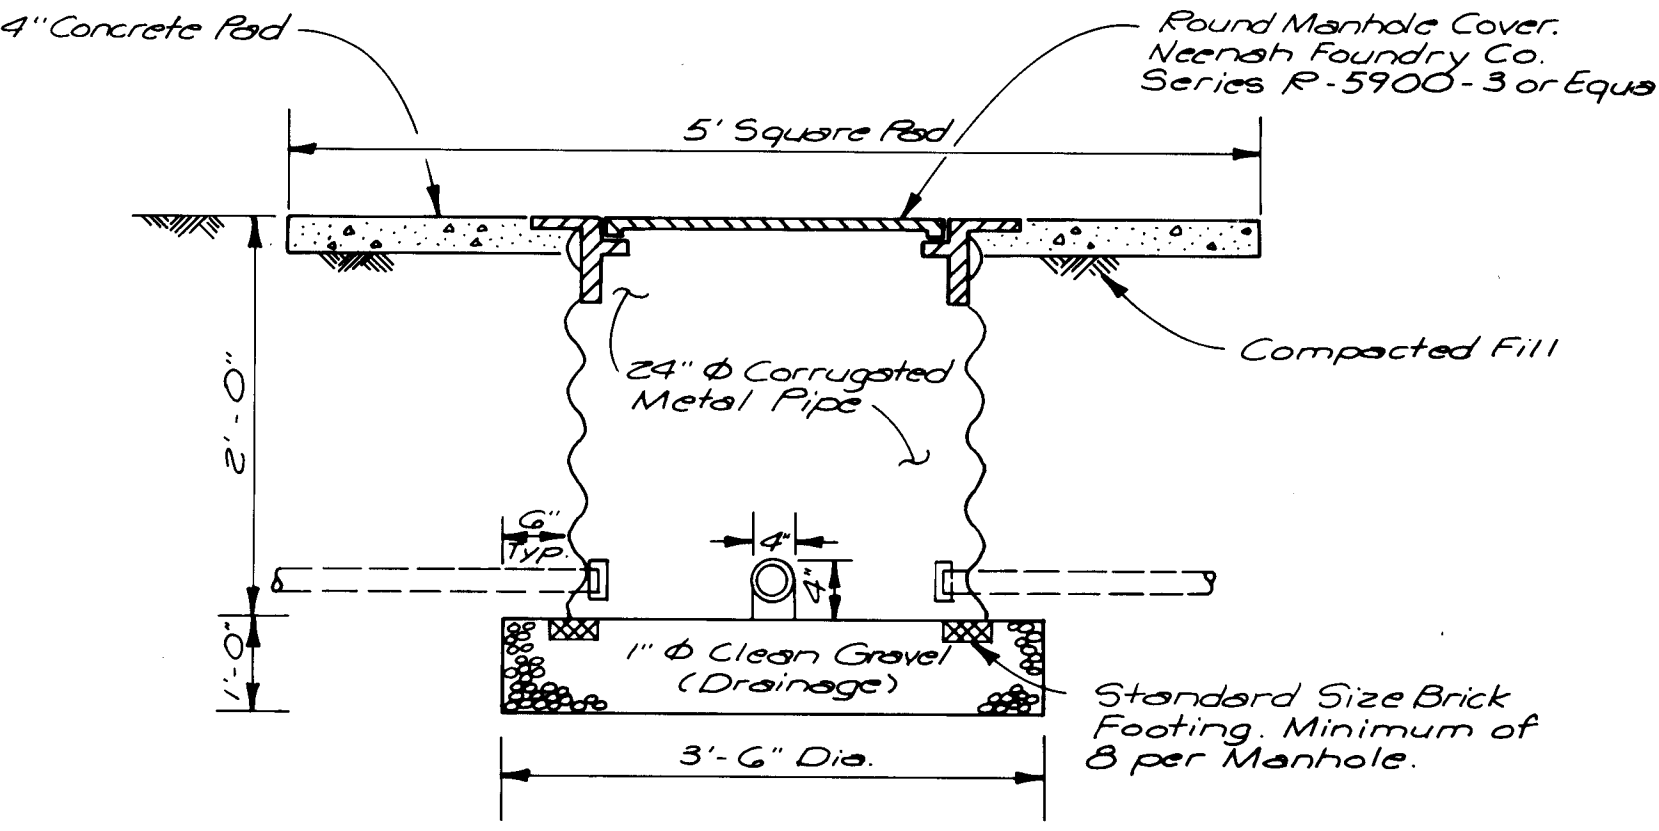

INTERCONNECT MANHOLE

SPECIAL TRAFFIC PROVISIONS:

ONE LANE IN EACH DIRECTION, EAST AND WEST, SHALL REMAIN OPEN AT ALL TIMES.

TWO LANES SHALL REMAIN OPEN FOR WEST BOUND TRAFFIC BETWEEN 7 A.M. - 9 A.M., MONDAY THRU FRIDAY.

TWO LANES SHALL REMAIN OPEN FOR EAST BOUND TRAFFIC BETWEEN 4 P.M. - 6 P.M., MONDAY THRU FRIDAY.

TRAFFIC CONTROL PLANS FOR ANY LANE CLOSURE CONDITIONS OTHER THAN SHOWN ON THESE PLANS MUST BE SUBMITTED BY THE CONTRACTOR TO THE PROJECT ENGINEER FOR APPROVAL BY THE CITY TRAFFIC ENGINEER PRIOR TO THE COMMENCEMENT OF WORK.

THE CONTRACTOR SHALL NOT INITIATE ANY OPERATIONS WITHIN THE PROJECT LIMITS WITHOUT AN APPROVED TRAFFIC CONTROL PLAN FOR EACH PHASE OF CONSTRUCTION.

SCALE: NO SCALE

PREPARED UNDER THE DIRECTION OF

CITY OF ALBUQUERQUE

INDIAN SCHOOL RD. CONSTRUCTION SIGNING AND MEDIAN GEOMETRY

APPROVALS ENGINEER DATE APPROVALS ENGINEER DATE

DESIGNED BY MDL DATE 9-81
DRAWN BY SAH, JR DATE 9-81
CHECKED BY MDL DATE 9-81

DRAWING NO. 1432 SHEET 14 OF 14