


TERRACE ADDITION

SCALE = 1" = 50'

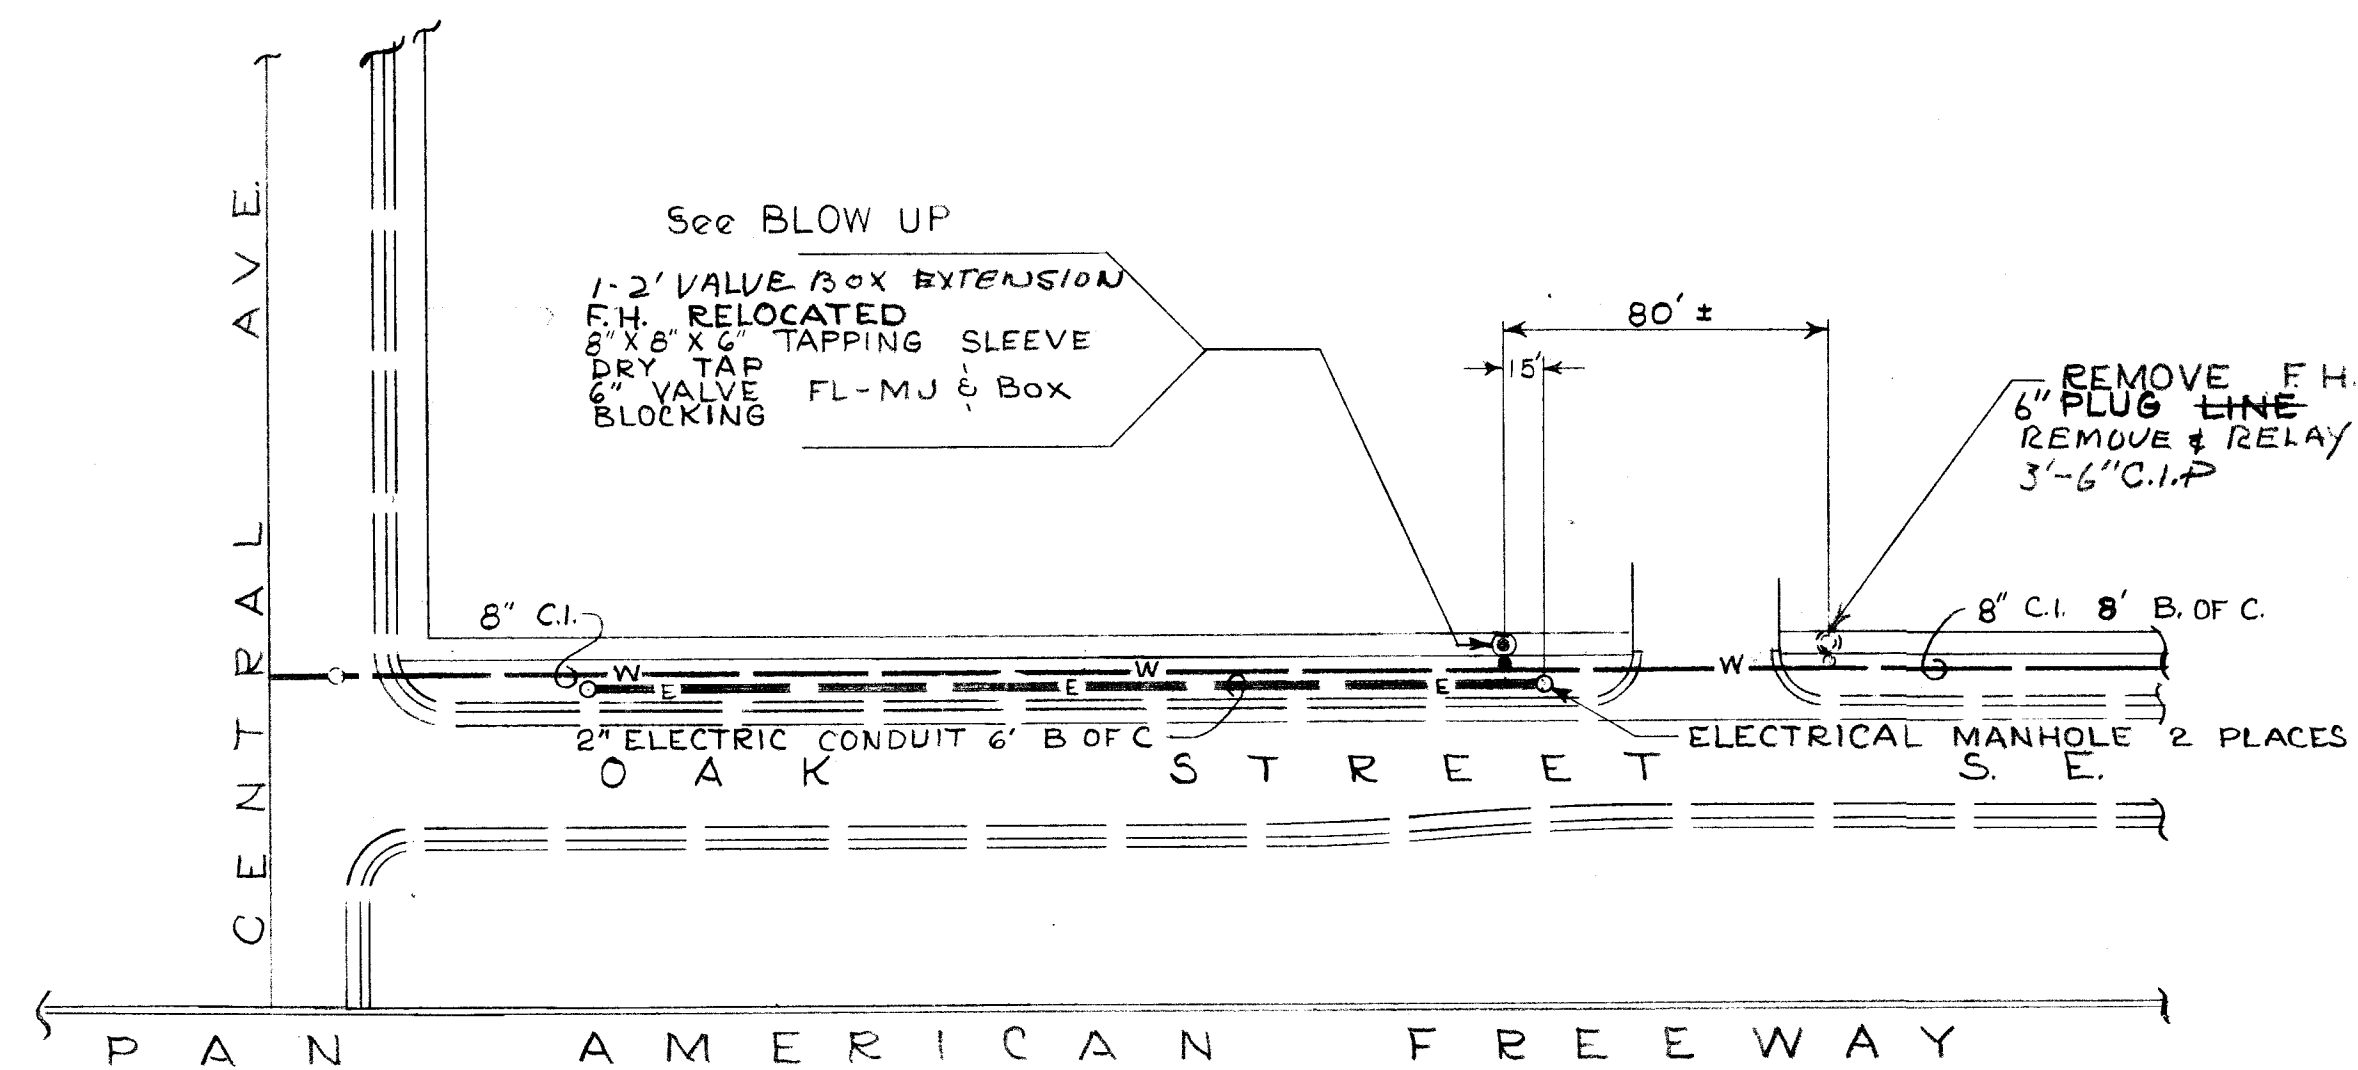


LEGEND
 --- EXISTING
 _____ PROPOSED

NOTES:
1) SEE FOR CONSTRUCTION, INSPECTION
STD. DWG. NO. W-20

2) FIRE HYDRANT TO BE MOVED 80'±
NORTH FROM ORIGINAL LOCATION

48 HOURS PRIOR TO ANY
EXCAVATION, CONTRACTOR
MUST CONTACT THE
CITY OF LOS ANGELES
705-EDU, TO LOCATE
OF EXISTING UTILITIES.

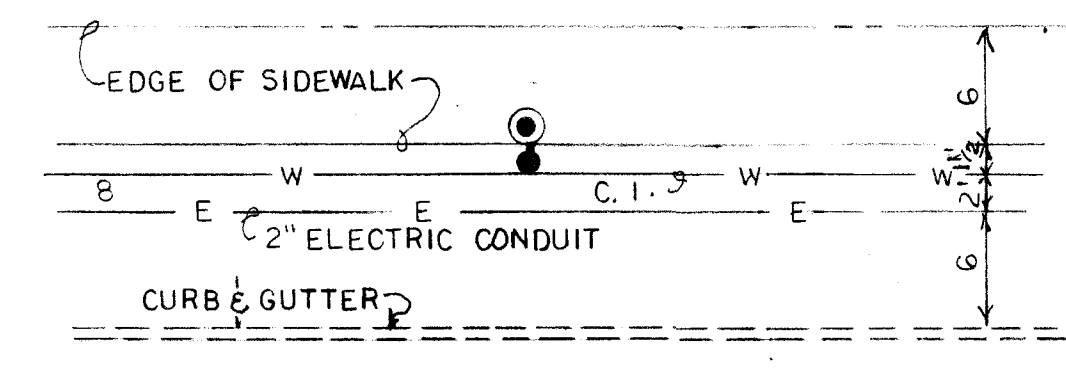

SCANNED BY
BY LASON

1	2	3	4	5	6	7	8	9	10	11	12
23		143					0177				

APPROVAL OF AS-BUILT DRAWING
ASST. CITY ENGINEER - FIELD
[Signature]
DATE 10-22-83

CITY OF ALBUQUERQUE
PUBLIC WORKS DEPARTMENT
ENGINEERING DIVISION

TITLE: RELOCATION OF FIRE HYDRANT ON
OAK ST. S.E. BETWEEN CENTRAL AVE
AND SILVER AVE. S.E.

APPROVALS	ENGINEER	DATE	APPROVALS	ENGINEER	DATE
City Engineer	<i>[Signature]</i>	12-21-77	Liquid Waste		
A.C.E. Design	<i>[Signature]</i>	1/16/77	Traffic		
City Hydrology			Water	<i>[Signature]</i>	1/16/77

APPROVED FOR
CONSTRUCTION
C. M. Shepard 9/24/81
C.E. ENGINEER DATE

DRAWING
NO. W-143-77

[illegible]

SURVEY INFORMATION	
NO.	FIELD NOTES
BY	

REFERENCES

MAP NO.	K-15 *
EST NO.	W-143-77
WO NO.	

NO DATE	RECEIVED	DATE 12-7-77
	DESIGN	CALL 12-7-77
	DESIGNED BY QUINTANA, D.	
	DRAWN BY ORTEGA, P.	
	SCALE 1/8"	

QUE
 TMENT
 SIGN
 HYDRANT ON
 CENTRAL AVE
 VALS ENGINEER DATE
 to
 St Monahan 12/1/99
 SHEET 1 OF 1