

LA VISTA GRANDE UNIT IB

ALBUQUERQUE, N. M.

INDEX

SHEET	TITLE
1.	TITLE SHEET
2.	PLAT & COMPUTATIONS
3.	PROPOSED SEWER DESIGN
4.	PROPOSED WATER DESIGN
5.	PROPOSED PAVING DESIGN
6.	SPAIN ROAD (NOT INCLUDED IN WORK ORDER FOR PROJECT 1440)
7.	VISTA DEL CERRO
8.	CAMINO SANDIA
9.	CAMINO SANDIA, ARROYO DE VISTA
10.	VISTA SANDIA
11.	DRAINAGE IMPROVEMENTS
12.	OUTLET STRUCTURE
13.	CURB INLET & STORM SEWER MANHOLE

NOTICE TO CONTRACTORS

- New Mexico Standard Specifications for Public Works Construction-1979 Edition will be referred to hereon as the "Standard Specification."
- All work detailed on these plans to be performed under contract shall, except as otherwise stated or provided for hereon, be constructed in accordance with "Contract Documents for City-Wide Utilities and Cash Paving No. 21" and the Standard Specification."
- Two working days prior to any excavation, contractor must contact Line Locating Service, 765-1234, for location of existing utilities.
- Prior to construction, the contractor shall excavate and verify the horizontal and vertical locations of all obstructions. Should a conflict exist, the contractor shall notify the engineer or surveyor so that the conflict can be resolved with a minimum amount of delay.

THE FOLLOWING NOTES ALSO APPLY WHEN CHECKED

- ☒ All utilities and utility service lines shall be installed prior to paving.
- ☒ Backfill compaction shall be according to specified street use.
- ☒ Tack coat requirements shall be determined by the City Engineer.
- ☒ Sidewalks and wheelchair ramps within the curb returns shall be constructed wherever a new curb return is constructed.
- ☒ If curb is depressed for a driveway, the driveway shall be constructed prior to acceptance of curb and gutter or the depression filled with an asphalt curb.
- ☒ All storm drainage facilities shall be completed prior to final acceptance.
- ☐ The requestor or developer shall be responsible for repair or replacement of all curb and gutter or sidewalk damaged after approval by the City Engineer of work completed by the Contractor.

APPROVED FOR RECORD DRAWINGS	APPROVED FOR CONSTRUCTION
ASST. CITY ENGINEER, FIELD	CITY ENGINEER
DATE	DATE
CITY OF ALBUQUERQUE	
APPROVALS	ENGINEER
DATE	TITLE
A.C.E. DESIGN	DATE
WATER RESOURCES	PROJECT
CITY ENGINEER	MAP NO.
	SHEET / OF 3



VICINITY MAP F 22 DA
NO SCALE


NOTE:

THESE SHEETS WERE ORIGINALLY APPROVED AS C-29-33. THIS PLAN SET IS TO PROVIDE A NEW CITY PROJECT NUMBER AND ALLOW FOR EASE OF BIDDING, CONSTRUCTION, AS CONSTRUCTED DRAWING AND RECORDS IN THE CITY.

APPROVAL OF AS BUILT DRAWINGS
ASST. CITY ENGINEER - FIELD
DATE 4-11-84

1 2 3 4 5 6 7 8 9 10 11 12
24 1440 0184

1440

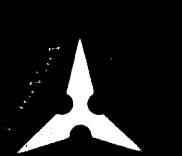

State of New Mexico
County of Santa Fe
This instrument was lawfully recorded on
this 14th day of May, 1964.
UNPLATTED
(RUTLEDGE TRACT)
Attest: _____ D9
Notary Public for New Mexico
James C. Cole 203

RIGHT-OF-WAY DEDICATED BY QUITCLAIM -
DEED FILED: APRIL 3, 1980
(BOOK DIII7A, PAGE 826)

RIGHT-OF-WAY DEDICATED BY QUITCLAIM
DEED FILED: APRIL 3, 1980
(BOOK DIII7A, PAGE 823)

ACADEMY PLACE SUBDIVISION NO. 5
(FILED OCT. 17, 1974)
(BOOK 66, PAGE 91)

LANDS OF ANKHOME IV
(FILED MAY 30, 1978)
(BOOK DB, PAGE 137)

RIGHT-OF-WAY DEDICATED BY QUITCLAIM
DEED FILED: APRIL 3 1980
(BOOK D1117A, PAGE 824-825)

ROAD

TRACT B
65.0195 ACRES

OPEN SPACE
UNIT 1
GLENWOOD HILLS NORTH
(FILED JULY 18, 1979)
(BOOK D8, PAGE 166)

OVERLOOK
 (FILED: FEB. 21, 1960)
 (BOOK DB: PAGE 196)

OPEN SPACE
4,800 ACRES

VISTA DEL SANDIA
(FILED: JANUARY 3, 1979
(BOOK D9, PAGE 49

CITY OF ALBUQUERQUE
DEDICATED FLOODWAY

VICINITY MAP
NO SCALE

DESCRIPTION

A certain tract of land situated in the ELENA GALLEGOS GRANT, and within Section 34 (as projected T11N, R4E, N.M.P.M., Bernalillo County, New Mexico, being TRACT 1 of AICO - WOOD PARCEL, SECTION 34, T11N, R4E, N.M.P.M., as the same is shown and designated on the plat filed in the office of the County Clerk of Bernalillo County, New Mexico on June 15, 1978, and being more particularly described by New Mexico State Plane Grid Bearings (Central Zone) and ground distances as follows:

BEGINNING AT A POINT ON THE SOUTHERLY BOUNDARY OF SAID TRACT
 AC100 - WOOD PARCEL, whence the A.C.S. Monument "Harry"
 having New Mexico State Plane Coordinates (Cental Zone)
 N 89° 40' 02" E, 117.12 feet along the southerly boundary
 and running from said A12 beginning point thence,
 N 89° 40' 02" E, 117.12 feet along the southerly boundary of said
 N17° 53' 31" W, 1324.85 feet along the westerly boundary of
 said N17° 53' 31" W, 1324.85 feet along the westerly boundary of said TRACT III
 to the northwest corner, said corner being the southwest corner
 of the lot of 1/4 Section 27 and 34 (as projected)
 of Bernillo County, New Mexico on March 31, 1978, thence,
 N17° 53' 31" W, 1324.85 feet along the westerly boundary of
 said TRACT III to the northwest corner, said corner being the southwest corner
 of the lot of 1/4 Section 27 and 34 (as projected)
 designated on the plat filed in the office of the County Clerk of
 Bernillo County, New Mexico on May 30, 1978 and also being
 the southwest corner of the lot of 1/4 Section 27 and 34 (as
 projected) of Bernillo County, New Mexico on May 30, 1978 and also being
 N17° 09' 27" E, 1649.04 feet along the northerly boundary of said
 TRACT I to the northeast corner, said corner being the northeast
 corner of the lot of 1/4 Section 27 and 34 (as projected)
 T11N, R4E, N.M.P.M. said corner being the southeast corner of
 said TRACT I, thence,
 S 89° 36' 51" E, 2547.58 feet along the section line common to
 said Section 27 and 34 of TRACT I to the northeast corner, a point on the westerly
 right of way of Trimmey Boulevard, thence,
 N 89° 36' 51" W, 117.12 feet along the westerly boundary of said
 TRACT 1 and along the said westerly right of way to the south
 east corner, thence leaving said right of way and continuing along
 the said westerly boundary of said TRACT 1,
 S 87° 01' 37" W, 637.60 feet to a point, thence,
 S 87° 01' 37" W, 156.68 feet to the northeast corner of
 N56° 28' 56" W, 682.54 feet to a point, thence,
 N50° 33' 04" W, 198.38 feet to a point, thence,
 S 87° 01' 37" W, 156.68 feet to the northeast corner of a place of beginning

Tract contains 130.0416 acres, more or less.

The subdivision of the land herein described is with free consent and accordance with the desires of the undersigned owner and proprietor thereof, and said owner desires hereby to dedicate the public use of any or any show, together with all easements shown in this plat. Power and communication easements are reserved where shown by dashed lines, as noted, including the right of ingress and egress and the right to install interfering. Any drainage right of ways shown herein are also right of ways for underground sewer and water lines.

THE AICO WOOD JOINT VENTURE

BY *J. D. Fulmer*
J. D. FULMER
VICE PRESIDENT
ASSOCIATED INVESTMENT
COMPANY

BY *Donald D. Martin*
DONALD D. MARTIN
SENIOR VICE PRESIDENT
WOOD BROS. HOMES, INC.

STATE OF NEW MEXICO)
COUNTY OF BERNALILLO) ss

The foregoing instrument was acknowledged before me this 2 day of 19, by J.D. FULMER of ASSOCIATED INVESTMENT COMPANY & DONALD D. MARTIN of WOOD BROTHERS HOMES, INC. on behalf said corporations.

My commission expires:

My Commission Expires _____

NOTARY BOND FILED WITH SECRETARY OF STATE
My Commission Expires _____

Notary Public

I, under the laws of New Mexico, certify that I am a Registered Land Surveyor and that this plat was prepared by me or under my supervision and meets the minimum requirements for monumentation and surveys of the Albuquerque Subdivision Ordinance and shows all easements of record and is true and accurate to the best of my knowledge and belief.

A. Dwain Weaver
A. Dwain Weaver, NMPLS No. 8544

NOTES:

1. Bearings are N-M. StatePlane Grid Bearings.
2. Distances are ground distances.
3. Elevations are field elevations.
4. Number 7 rebar with plastic cap marked PE & LS No. 2455 were set on corners designated by a small solid circle.
5. Number of lots: 188 lots.
6. Zone Atlas No. F-22
7. Number of miles of streets within subdivision:
Full Width 1.67 miles
Half Width 0.78 miles

S-78-37

APPROVALS

Eugene Velez
Planning Director, City of Albuquerque, NM
Richard E Leonard

AMAFCA
Robert S. Hill
City Engineer, City of Albuquerque, NM

Robert Thompson 8736
Traffic Engineer, City of Albuquerque, NM

Patricia Walker
Director of Parks & Recreation, City of Albuquerque, NM

William C. Boudreau
Chief Supervisor, City of Albuquerque, NM

Wesley C. Casper, Jr.
Mountain States Telephone & Telegraph Co.

John A. Hume
Public Works, City of New Mexico


James J. ...
City Manager, City of New Mexico

James J. ... Paul ...
Public Works Management

William J. ...
Water Resources, City of Albuquerque

9-12-80
 Date
 REC 9 20 '80
 Date
 9/12/80
 Date
 10/15/79
 Date
 U.S. NM
 9/10/79
 Date
 9/10/80
 Date
 9-11-79
 Date
 9-11-79
 Date
 8-15-79
 Date
 8/11/79
 Date
 10/11/79
 Date

1440

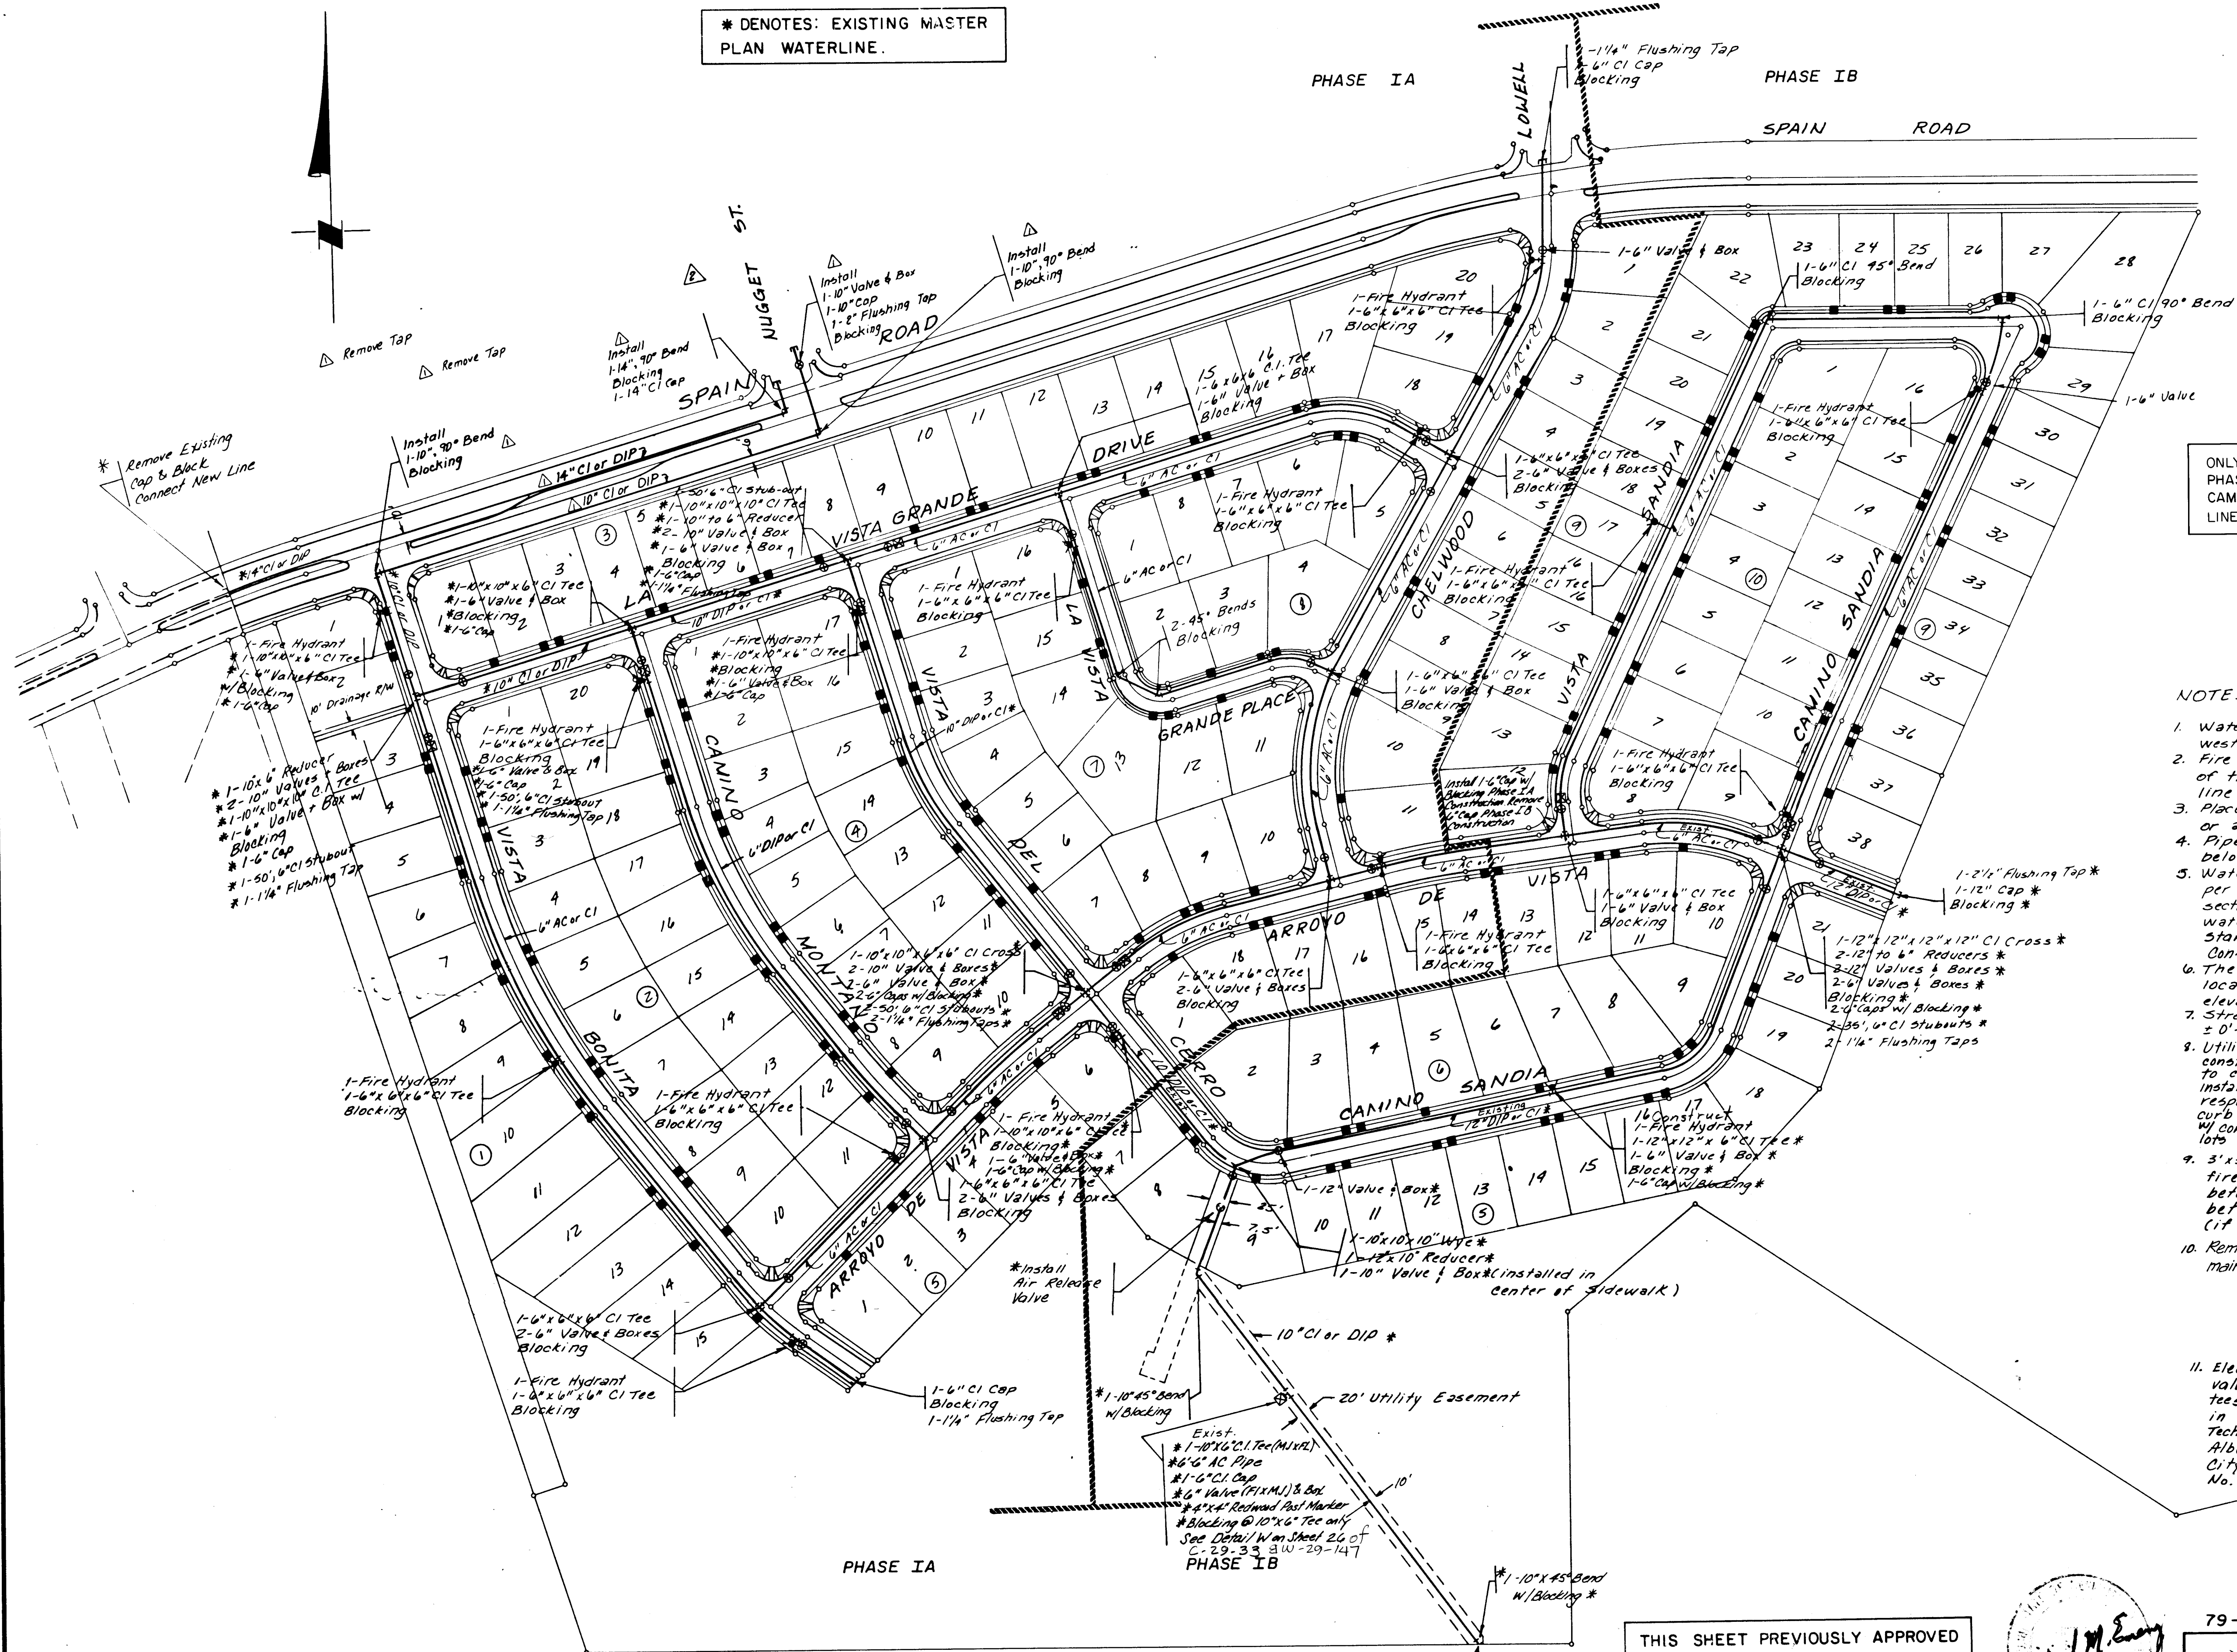


ONLY WATERLINE CONSTRUCTION FOR PHASE IB INCLUDES LINES IN VISTA SANDIA, CAMINO SANDIA AND WATER SERVICE LINES THROUGHOUT PHASE IB.

- NOTES:
- Waterlines are to be located 10' north or west of E. unless otherwise shown.
 - Fire hydrants are to be located at the P.C. of the property return or at the property line between lots.
 - Place valves at the P.C. of curb returns or at the property line between lots.
 - Pipe crown shall be a minimum of 3'-8" below the top of curb.
 - Water and sewer lines shall be installed per supplemental general conditions section 18.1 policy on the proximity of water and sewer lines, New Mexico Standard Specifications for Public Works Construction 1979 Edition.
 - The flange of fire hydrants shall be located 5" (±3) above the top of curb elevation.
 - Streets shall be graded to Finished Grade ±0'-6" prior to installation of Utilities.
 - Utility Contractor shall be responsible for constructing water services from watermain to curb stop, including curb box along with installation of mains. Utility Contractor shall be responsible for installing water service from curb stop to property line (including meter box w/ concrete pad) at time service to individual lots is requested.
 - 3'x3'x4' Concrete Pad required around all fire hydrants. Install 1/2" Expansion Joint between concrete pad and curb and between concrete pad and sidewalk (if applicable).
 - Remove CI cap and connect to existing water main at locations indicated by X.
 - Electronic Marker Disks shall be installed at all valves, bends (22 1/2" and larger), capped ends, tees, and service connections as specified in section 13.1 of the Supplemental Technical Specifications to the City of Albuquerque Contract Documents for City-wide Utilities and Curb Paving No. 31.

THIS SHEET PREVIOUSLY APPROVED AS C-29-33.

Michael M. Ewing
4-28-81

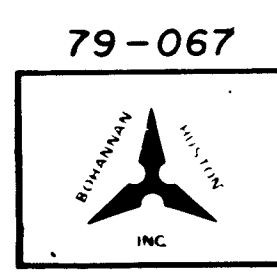


APPROVED FOR CONSTRUCTION
CITY ENGINEER
DATE 12/3/80

SCALE: 1" = 100'

CITY OF ALBUQUERQUE PUBLIC WORKS DEPARTMENT ENGINEERING DIVISION					
TITLE: LA VISTA GRANDE, UNIT IB PROPOSED WATER DESIGN					
APPROVALS	ENGINEER	DATE	APPROVALS	ENGINEER	DATE
City Engineer	[Signature]	12/3/80	City Engineer	[Signature]	12/3/80
A.C.E. Design	[Signature]	12/3/80	A.C.E. Design	[Signature]	12/3/80
A.C.E. Hydrology	[Signature]	12/3/80	A.C.E. Hydrology	[Signature]	12/3/80
DRAWING NO. 1440			SHEET 4 OF 13		



PROFILE NOTE BOOK NO. —	SURVEYED PLOTTED GRADES CHECKED B.M.'S NOTED STRUCTURE NOTATIONS CHMD	BY _____	DATE _____

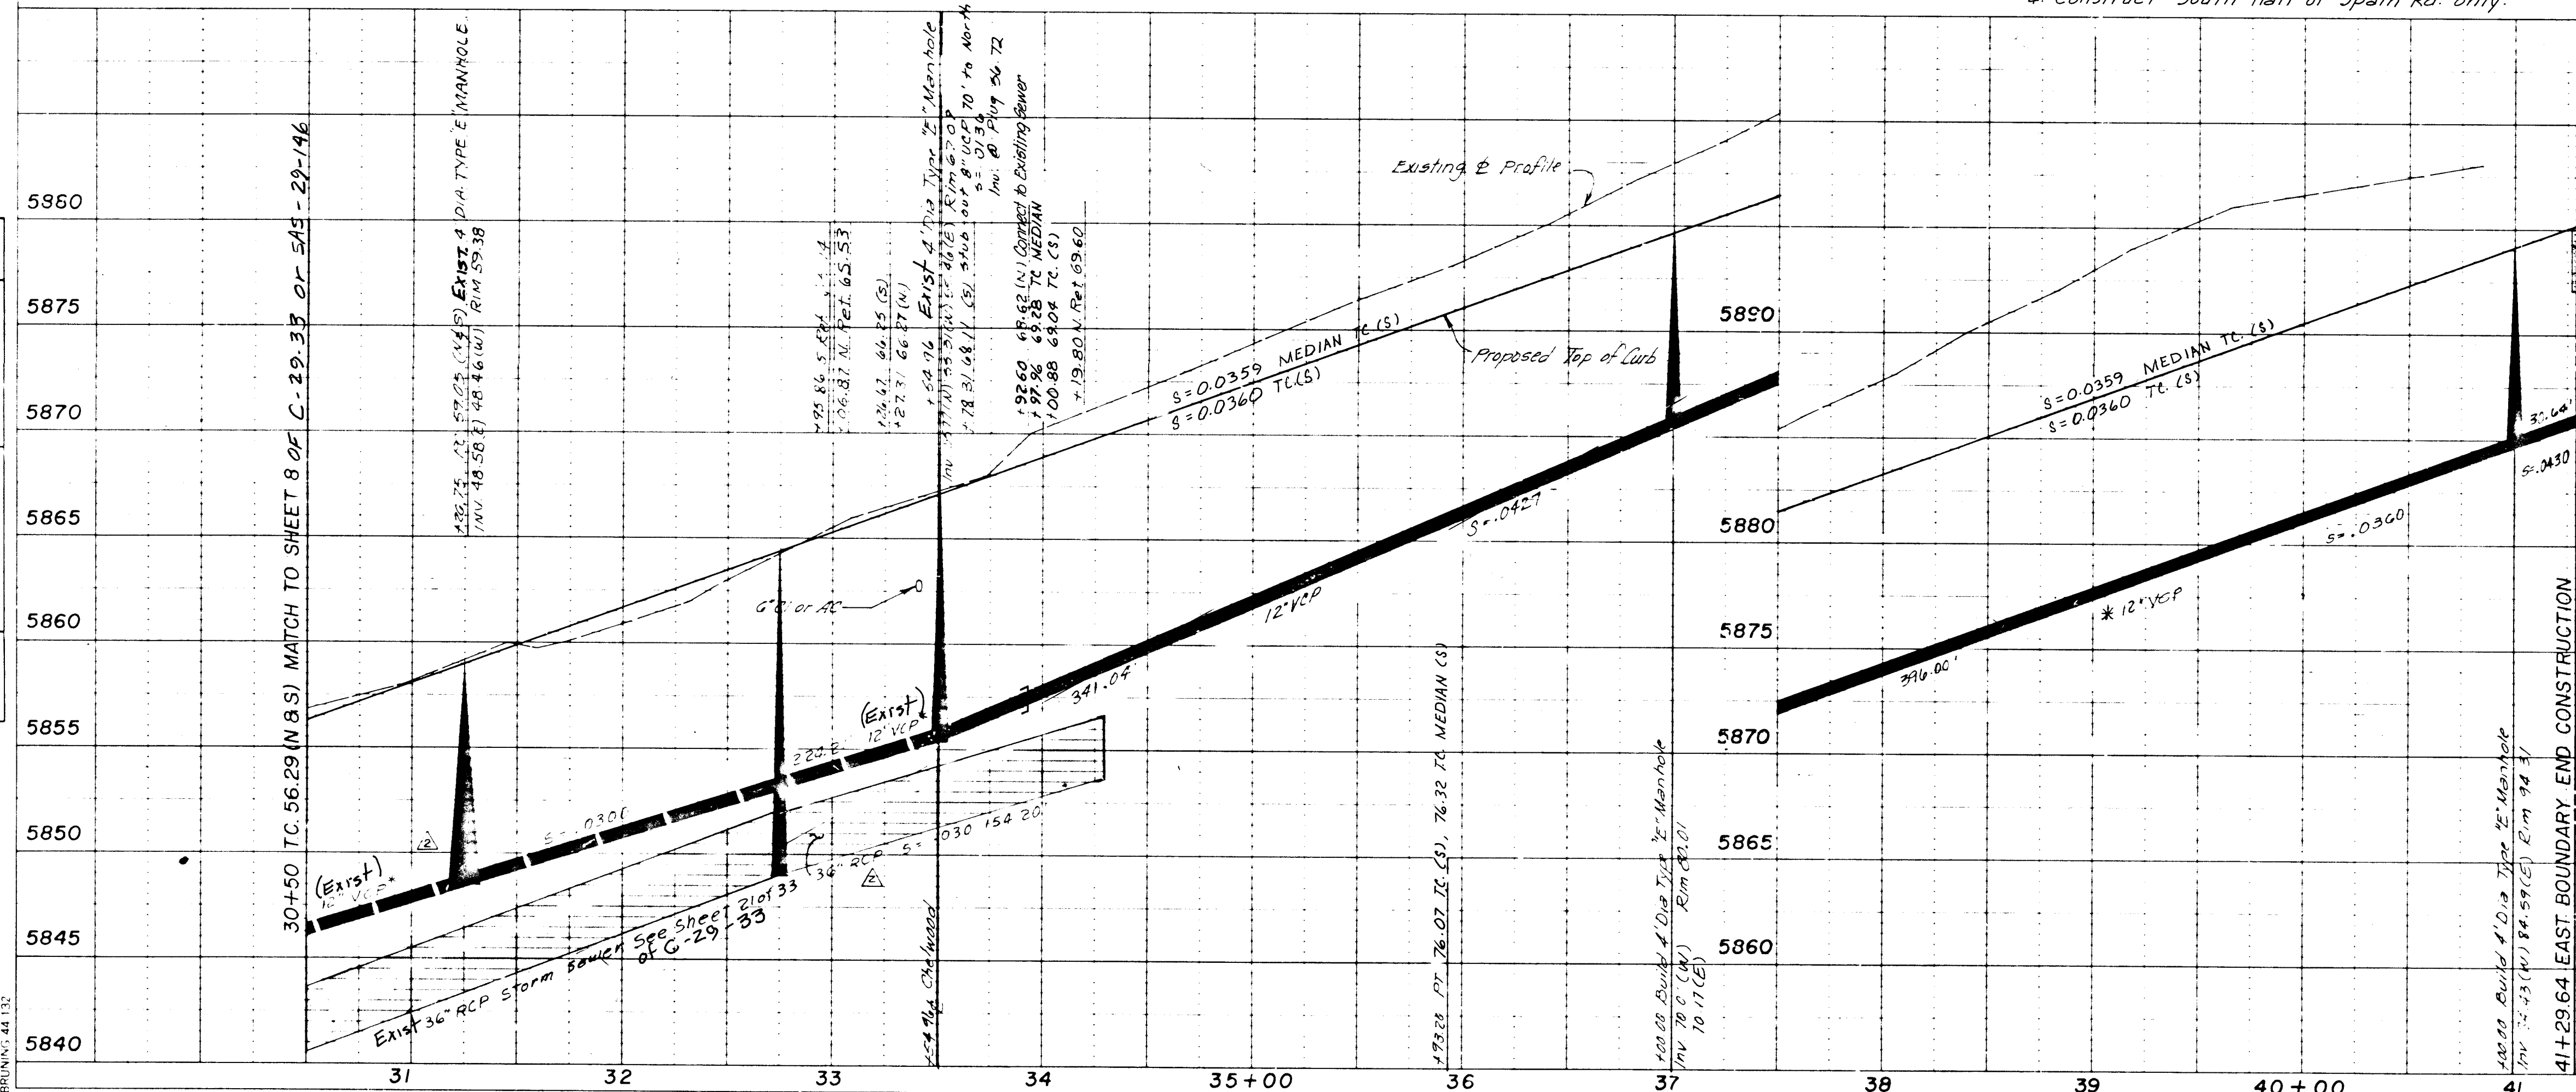

SCALE:
1"=5' VERT. 1"=50' HORIZ.

CITY OF ALBUQUERQUE					
PUBLIC WORKS DEPARTMENT					
ENGINEERING DIVISION					
TITLE: LA VISTA GRANDE, UNIT 1B					
SPAIN ROAD					
APPROVALS	ENGINEER	DATE	APPROVALS	ENGINEER	DATE
City Engineer			Liquid Waste		
A C E - Design			Traffic		
A C E - Hydrology			Water		
DRAWING NO. 1440			SHEET 6 OF 13		

REFERENCES		SURVEY INFORMATION		BENCH MARKS		AS-BUILT INFORMATION	
MAP NO. F-22-34		FIELD NOTES		STATION IS LOCATED 475' EAST FROM		CONTRACTOR KNC, INC.	
EST NO.		NO.		EXT. OF CENTERLINE ON NOREEN DR. AND 26' SO. FROM CENTERLINE ON		WORK ACCEPTED BY	
W O NO.		DATE		SPAIN RD. STATION IS A STANDARD A.C.S.		DRAWING	
				BRASS CAP SET IN CONCRETE, FLUSH WITH GROUND, AND STAMPED "BD=3"		CHECKED BY M. DOHL	
				ELEVATION = 5722.27		DATE 4-9-84	
4-9-84		REVISED TO SHOW AS-BUILTS		7/17/79			
3/82		Create Phase II Construction Plan Set		DMYM			
11/80		Revised Storm Sewer		J.R.J.			
7/80		Added Electronic Marker Marks		DM			
NO.		DATE		REMARKS		BY	
REVISIONS							
DESIGN							
DESIGNED BY DMYM				DATE 6/79			
DRAWN BY J.R.J.				DATE 7/79			
CHECKED BY DMYM				DATE 7/79			

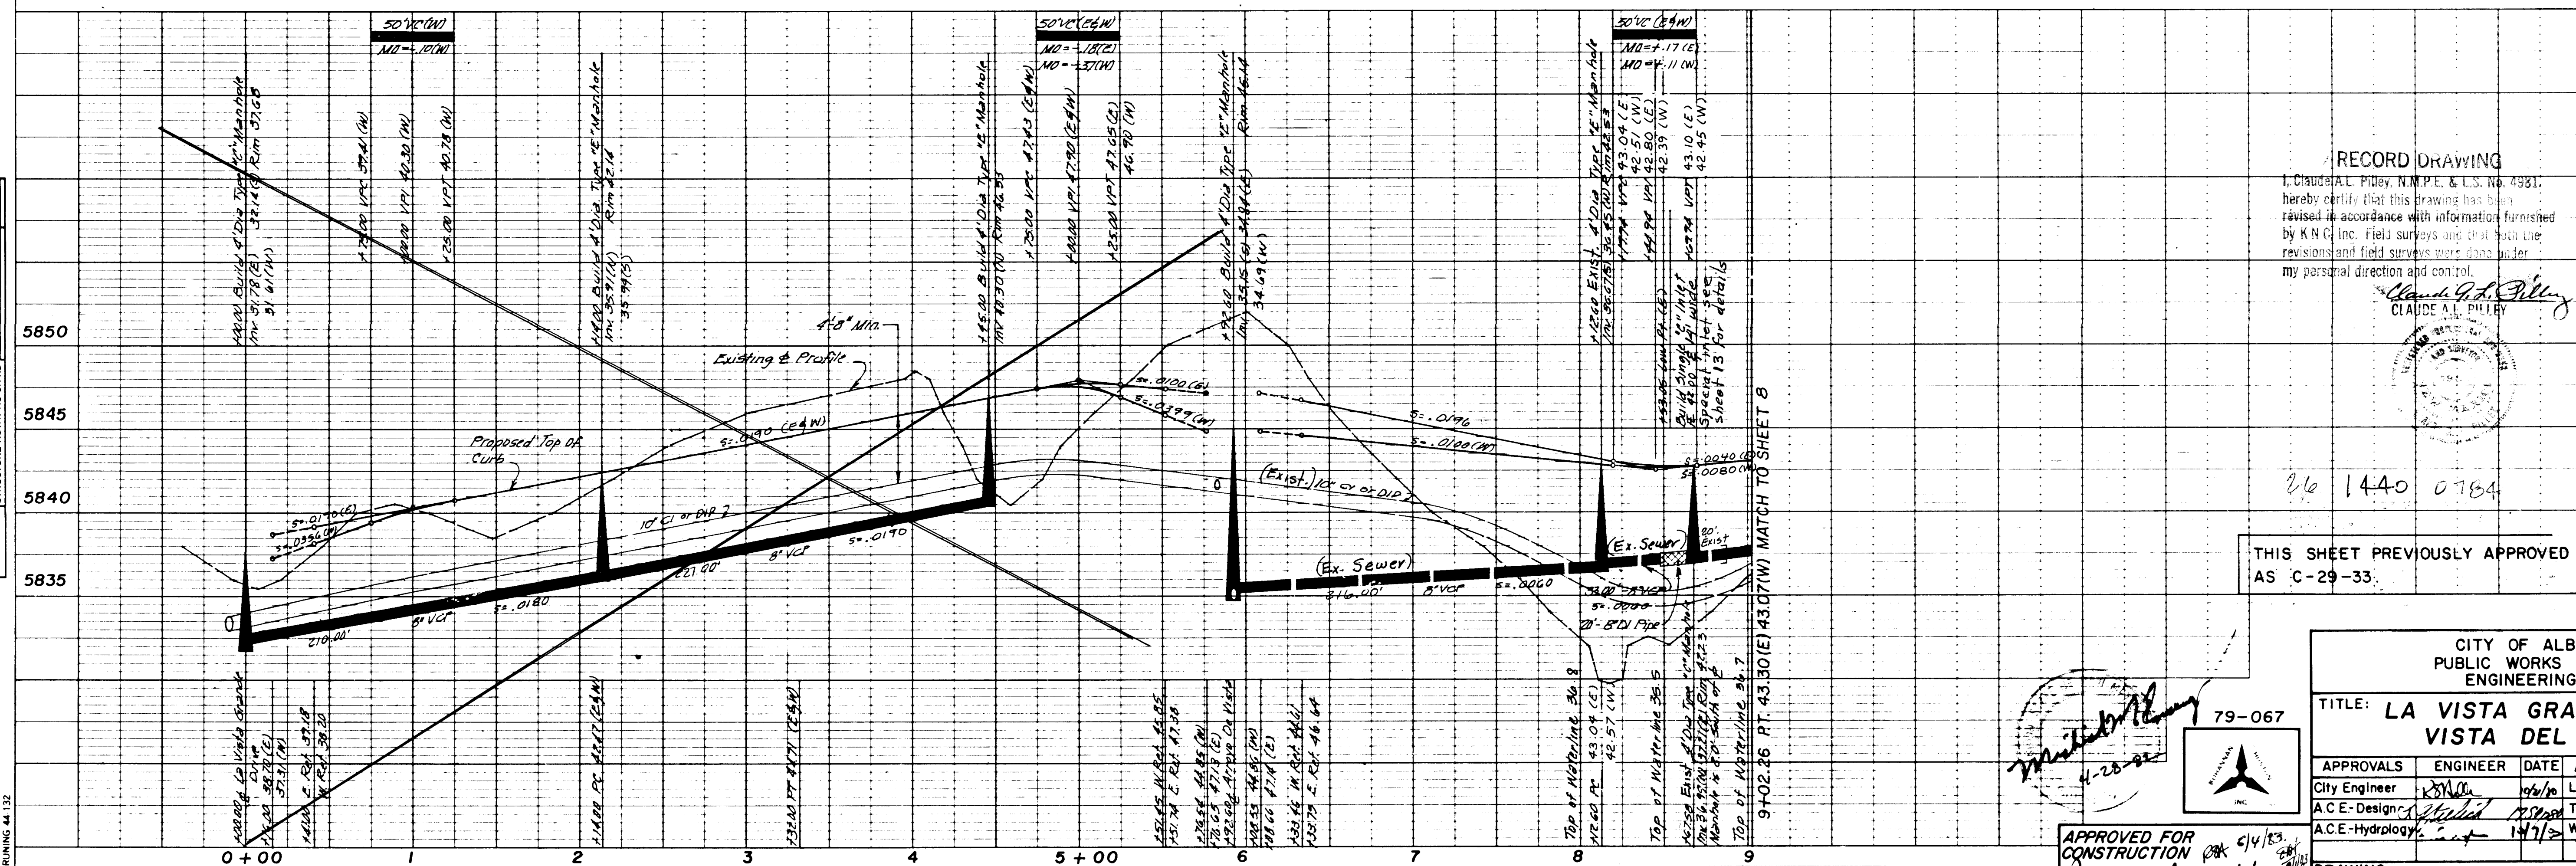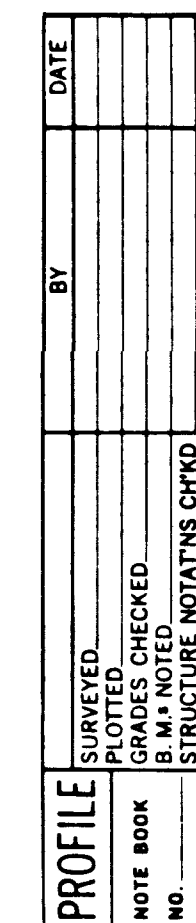

* DENOTES: EXISTING MASTER
PLAN WATERLINE. W-29-147



Note: Electronic Marker Disks shall be installed as specified in Section 131 of the Supplemental Specifications to the City of Albuquerque Contract Documents for City-wide Utilities and Cosh Paving No. 31.

RECORD DRAWING
I, Claude A.L. Pilley, N.M.P.E. & L.S. No. 4981,
hereby certify that this drawing has been
revised in accordance with information furnished
by K.N.C. Inc. Field surveys and that both the
revisions and field surveys were done under
my personal direction and control.

THIS SHEET PREVIOUSLY APPROVED
AS C-29-33.

CITY OF ALBUQUERQUE PUBLIC WORKS DEPARTMENT ENGINEERING DIVISION					
TITLE: LA VISTA GRANDE, UNIT 1B VISTA DEL CERRO					
APPROVALS	ENGINEER	DATE	APPROVALS	ENGINEER	DATE
City Engineer	<i>[Signature]</i>	9/21/90	Liquid Waste	<i>[Signature]</i>	9/21/90
A.C.E.-Design	<i>[Signature]</i>	9/21/90	Traffic	<i>[Signature]</i>	9/21/90
A.C.E.-Hydrology	<i>[Signature]</i>	10/7/90	Water	<i>[Signature]</i>	10/7/90
DRAWING NO. 1440			SHEET 7 OF 13		

REVISED TO SHOW AS-BUILTS			REFERENCES			SURVEY INFORMATION			BENCH MARKS		AS-BUILT INFORMATION	
NO.	DATE	REMARKS	BY	EST. NO.	W. O. NO.	FIELD NOTES			STATION IS LOCATED 475' EAST FROM EXT. OF CENTERLINE ON NOREEN DR. AND 26' SO. FROM CENTERLINE ON SPAIN RD. STATION IS A STANDARD A.C.S. BRASS CAP SET IN CONCRETE, FLUSH WITH GROUND, AND MARKED "BD = 3". ELEVATION = 572.2, 27	WORK ACCEPTED BY DRAWING CHECKED BY M. POHL DATE 3-8-84	DATE	
3	3-8-84	Revised To Show AS-BUILTS	MP			NO.	BY	DATE				
4	3/8/82	Circle Phase 1B Construction Plan Set	DMM									
1	2/80	Added Electronic Marker Dials	PM									
REVISIONS									MICRO-FILM INFORMATION			
DESIGN									RECORDED BY NO DATE			
DESIGNED BY DMM			DATE 6/77									
DRAWN BY J.R.J.			DATE 7/77									
CHECKED BY DMM			DATE 7/77									

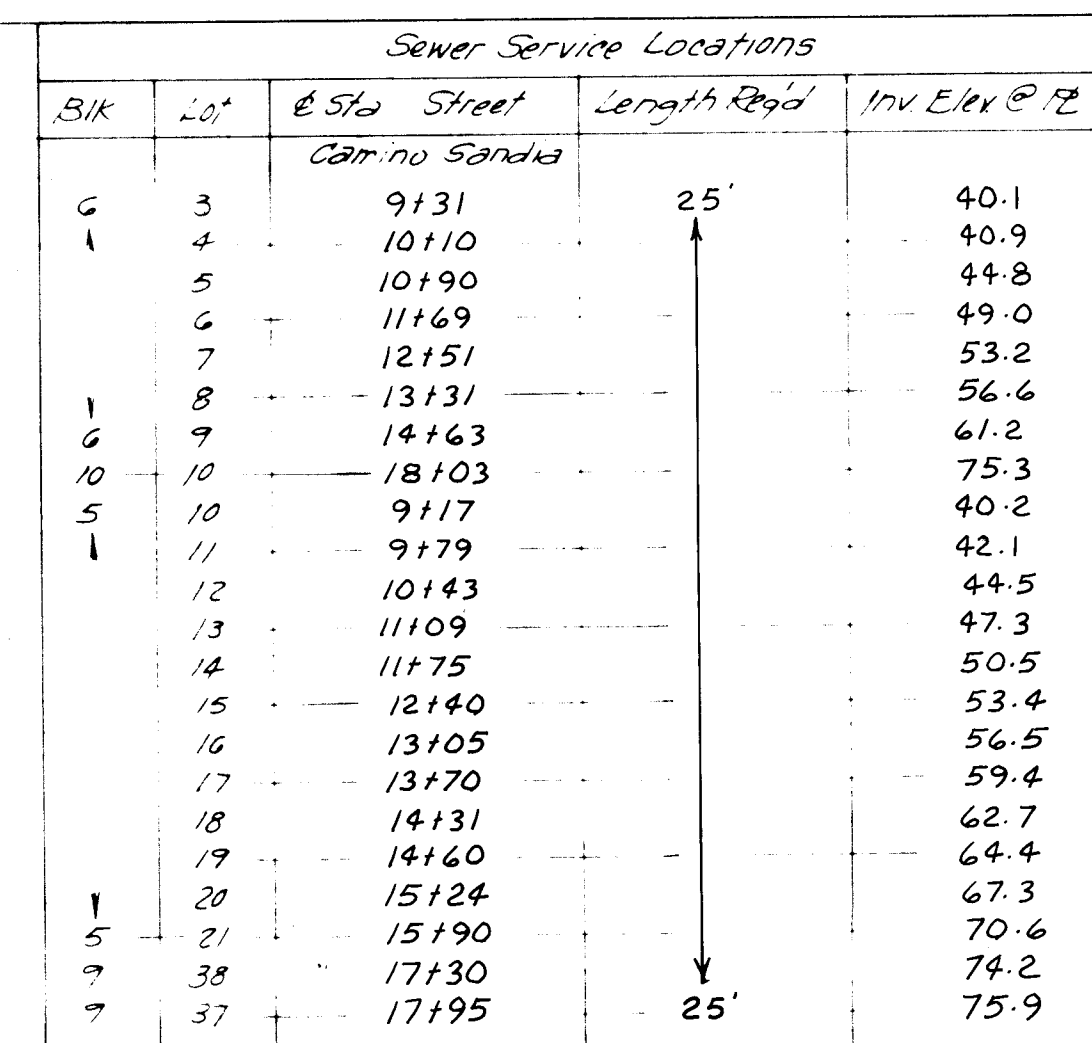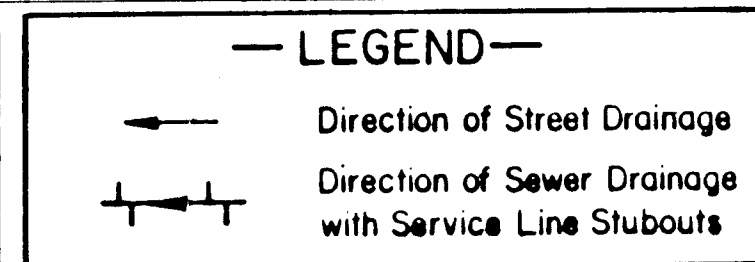

AS-BUILT INFORMATION	DATE
CONTRACTOR KNC Inc.	DATE 3-8-84
WORK RECORDED BY DRAWING CONNECTED BY Mr. POHL	
MICRO-FILM INFORMATION	DATE
RECORDED BY	
NG	




BENCH MARKS

STATION IS LOCATED 475' EAST FROM EXT. OF CENTERLINE ON NOREEN DR. AND 26' SO. FROM CENTERLINE ON SPAIN RD. STATION IS A STANDARD A.C.S. BRASS CAP SET IN CONCRETE, FLUSH WITH GROUND, AND STAMPED "BD-3", ELEVATION -5722.27

[illegible][illegible]

5	3-8-84	REVISED TO SHOW AS-BUILTS	MPM
4	3/82	Indicate Mountable Curb Bolt-Type	QMM
3	3/82	Create Phase 1A Construction Plan Set	MMM
1	2/80	Added Electronic Marker Disk's	PH
NO.	DATE	REMARKS	BY
REVISIONS			
DESIGN			
DESIGNED BY		QMM	
DRAWN BY		JRJ	
		DATE	6/77
		DATE	7/77

JQUERQUE		
DEPARTMENT		
DIVISION		
NDE, UNIT 1B		
NDIA		
APPROVALS	ENGINEER	DATE
Liquid Waste	<i>[Signature]</i>	<i>[Date]</i>
Traffic	<i>[Signature]</i>	<i>[Date]</i>
Water	<i>[Signature]</i>	<i>[Date]</i>
SHEET 8 OF 13		

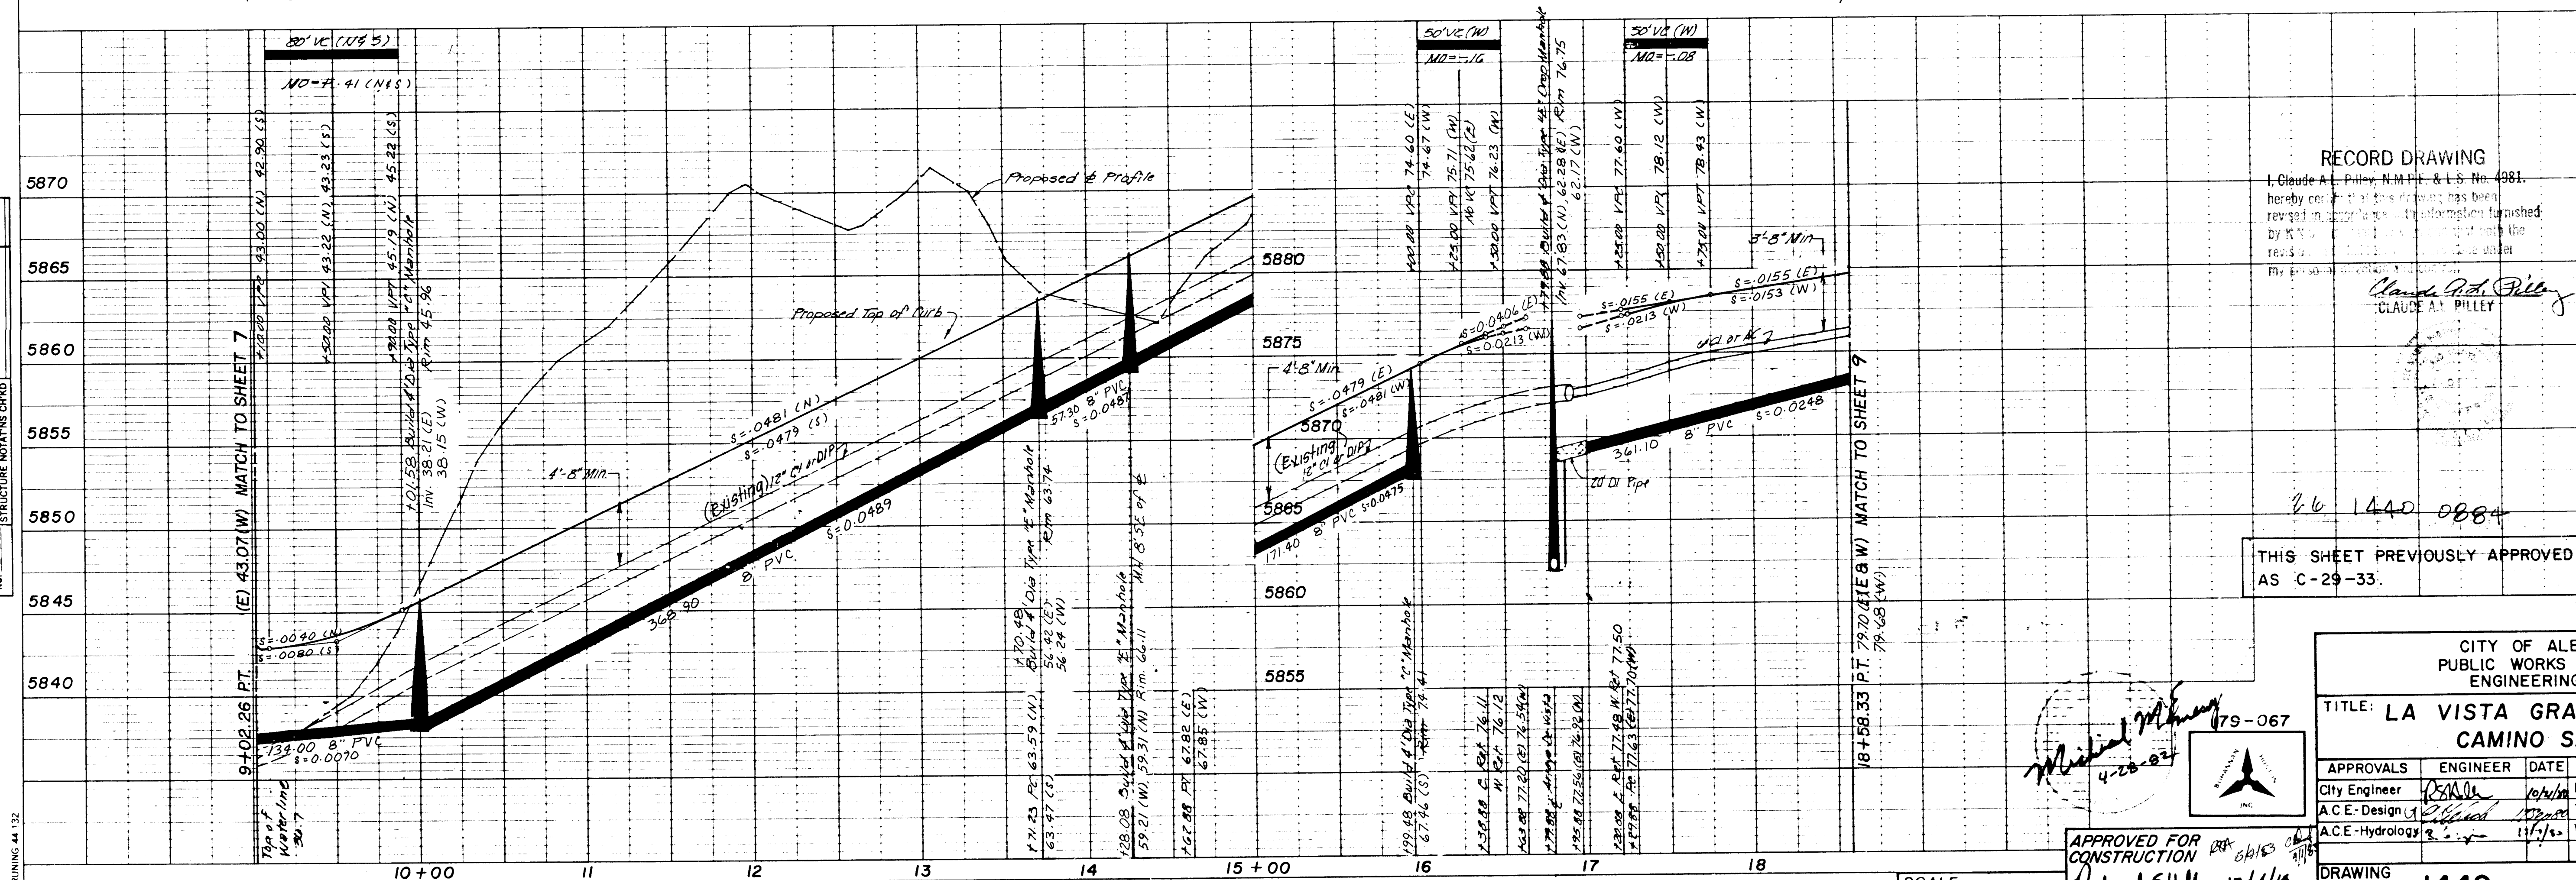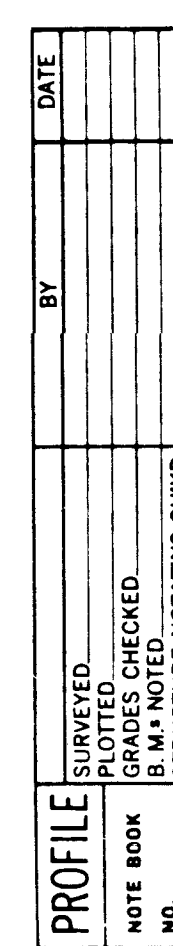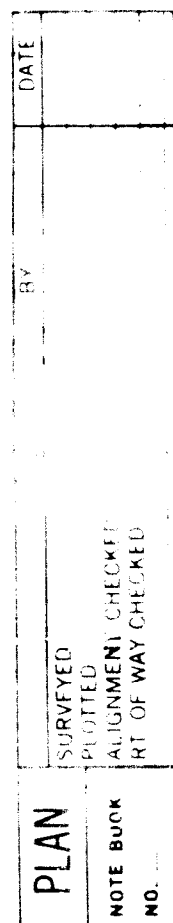

THIS SHEET PREVIOUSLY APPROVED
AS C-29-33.

CITY OF ALBUQUERQUE PUBLIC WORKS DEPARTMENT ENGINEERING DIVISION	
TITLE:	LA VISTA GRANDE, UNIT 1B CAMINO SANDIA

APPROVALS	ENGINEER	DATE	APPROVALS	ENGINEER	DATE
City Engineer	<i>[Signature]</i>	10/24/10	Liquid Waste	<i>[Signature]</i>	10/24/10
A.C.E.-Design	<i>[Signature]</i>	10/24/10	Traffic	<i>[Signature]</i>	10/24/10
A.C.E.-Hydrology	<i>[Signature]</i>	10/24/10	Water	<i>[Signature]</i>	10/24/10


DRAWING NO.		1440	SHEET 8 OF 13	
-------------	--	------	---------------	--

SCALE:
1"=5' Vert. 1"=50' Hor.



APPROVED FOR CONSTRUCTION *RA* 6/1/80
Richard S. Hille 12/4/80
CITY ENGINEER DATE

DRAWING NO.	1440	SHEET 8 OF 13
-------------	------	---------------

PROFILE		BY	DATE
NOTE BOOK	SURVEYED.....		
	PLOTTED.....		
	GRADES CHECKED.....		
	B. M.'s NOTED.....		
	STRUCTURE MOVING PLUMB.....		
NO.			

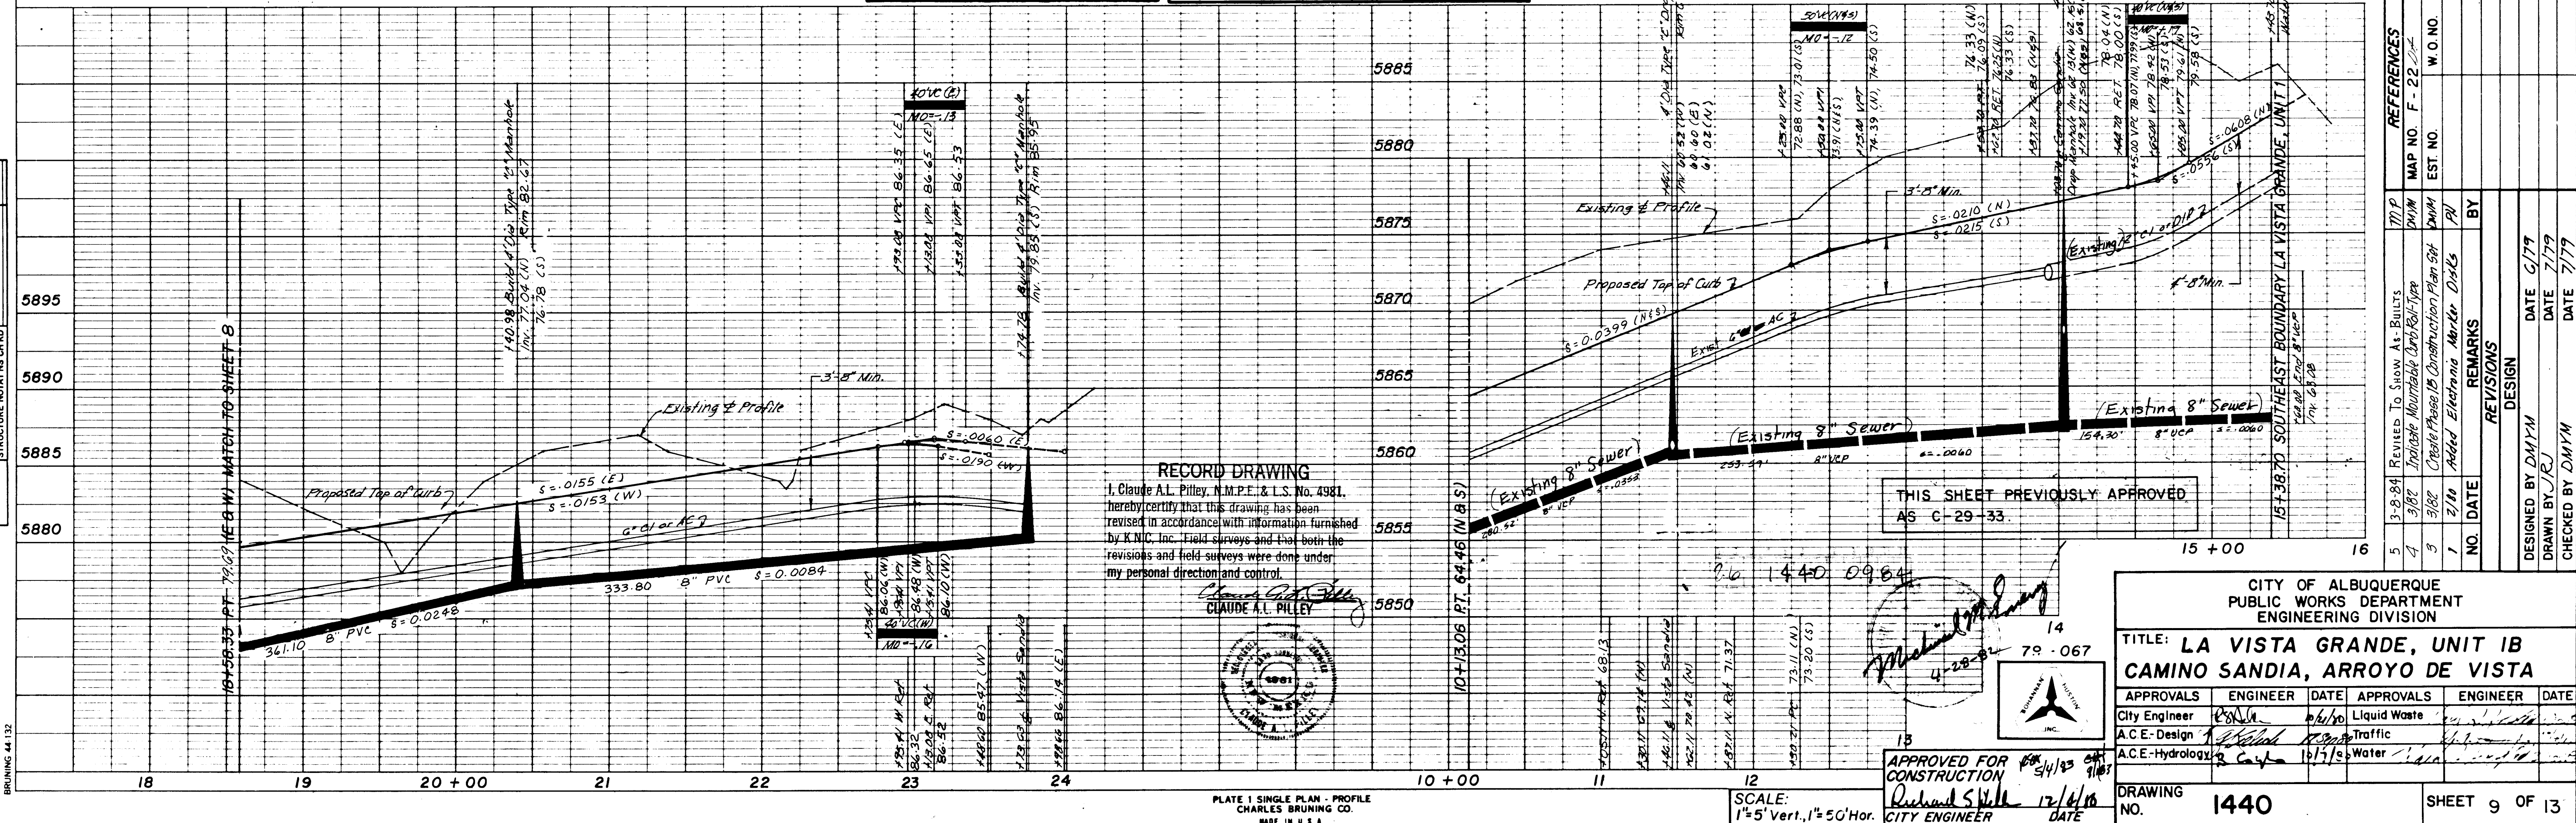


QUERQUE DEPARTMENT DIVISION										UNDE, UNIT 1B BOYO DE VISTA									
APPROVALS					ENGINEER					DATE									
Chief of Party					10/1/79					10/1/79									
Project Engineer					10/1/79					10/1/79									
Inspector					10/1/79					10/1/79									
Surveyor					10/1/79					10/1/79									
Recorder					10/1/79					10/1/79									
Checker					10/1/79					10/1/79									
Planner					10/1/79					10/1/79									
Locator					10/1/79					10/1/79									
Recorder					10/1/79					10/1/79									
Checker					10/1/79					10/1/79									
Planner					10/1/79					10/1/79									
Locator					10/1/79					10/1/79									
Recorder																			

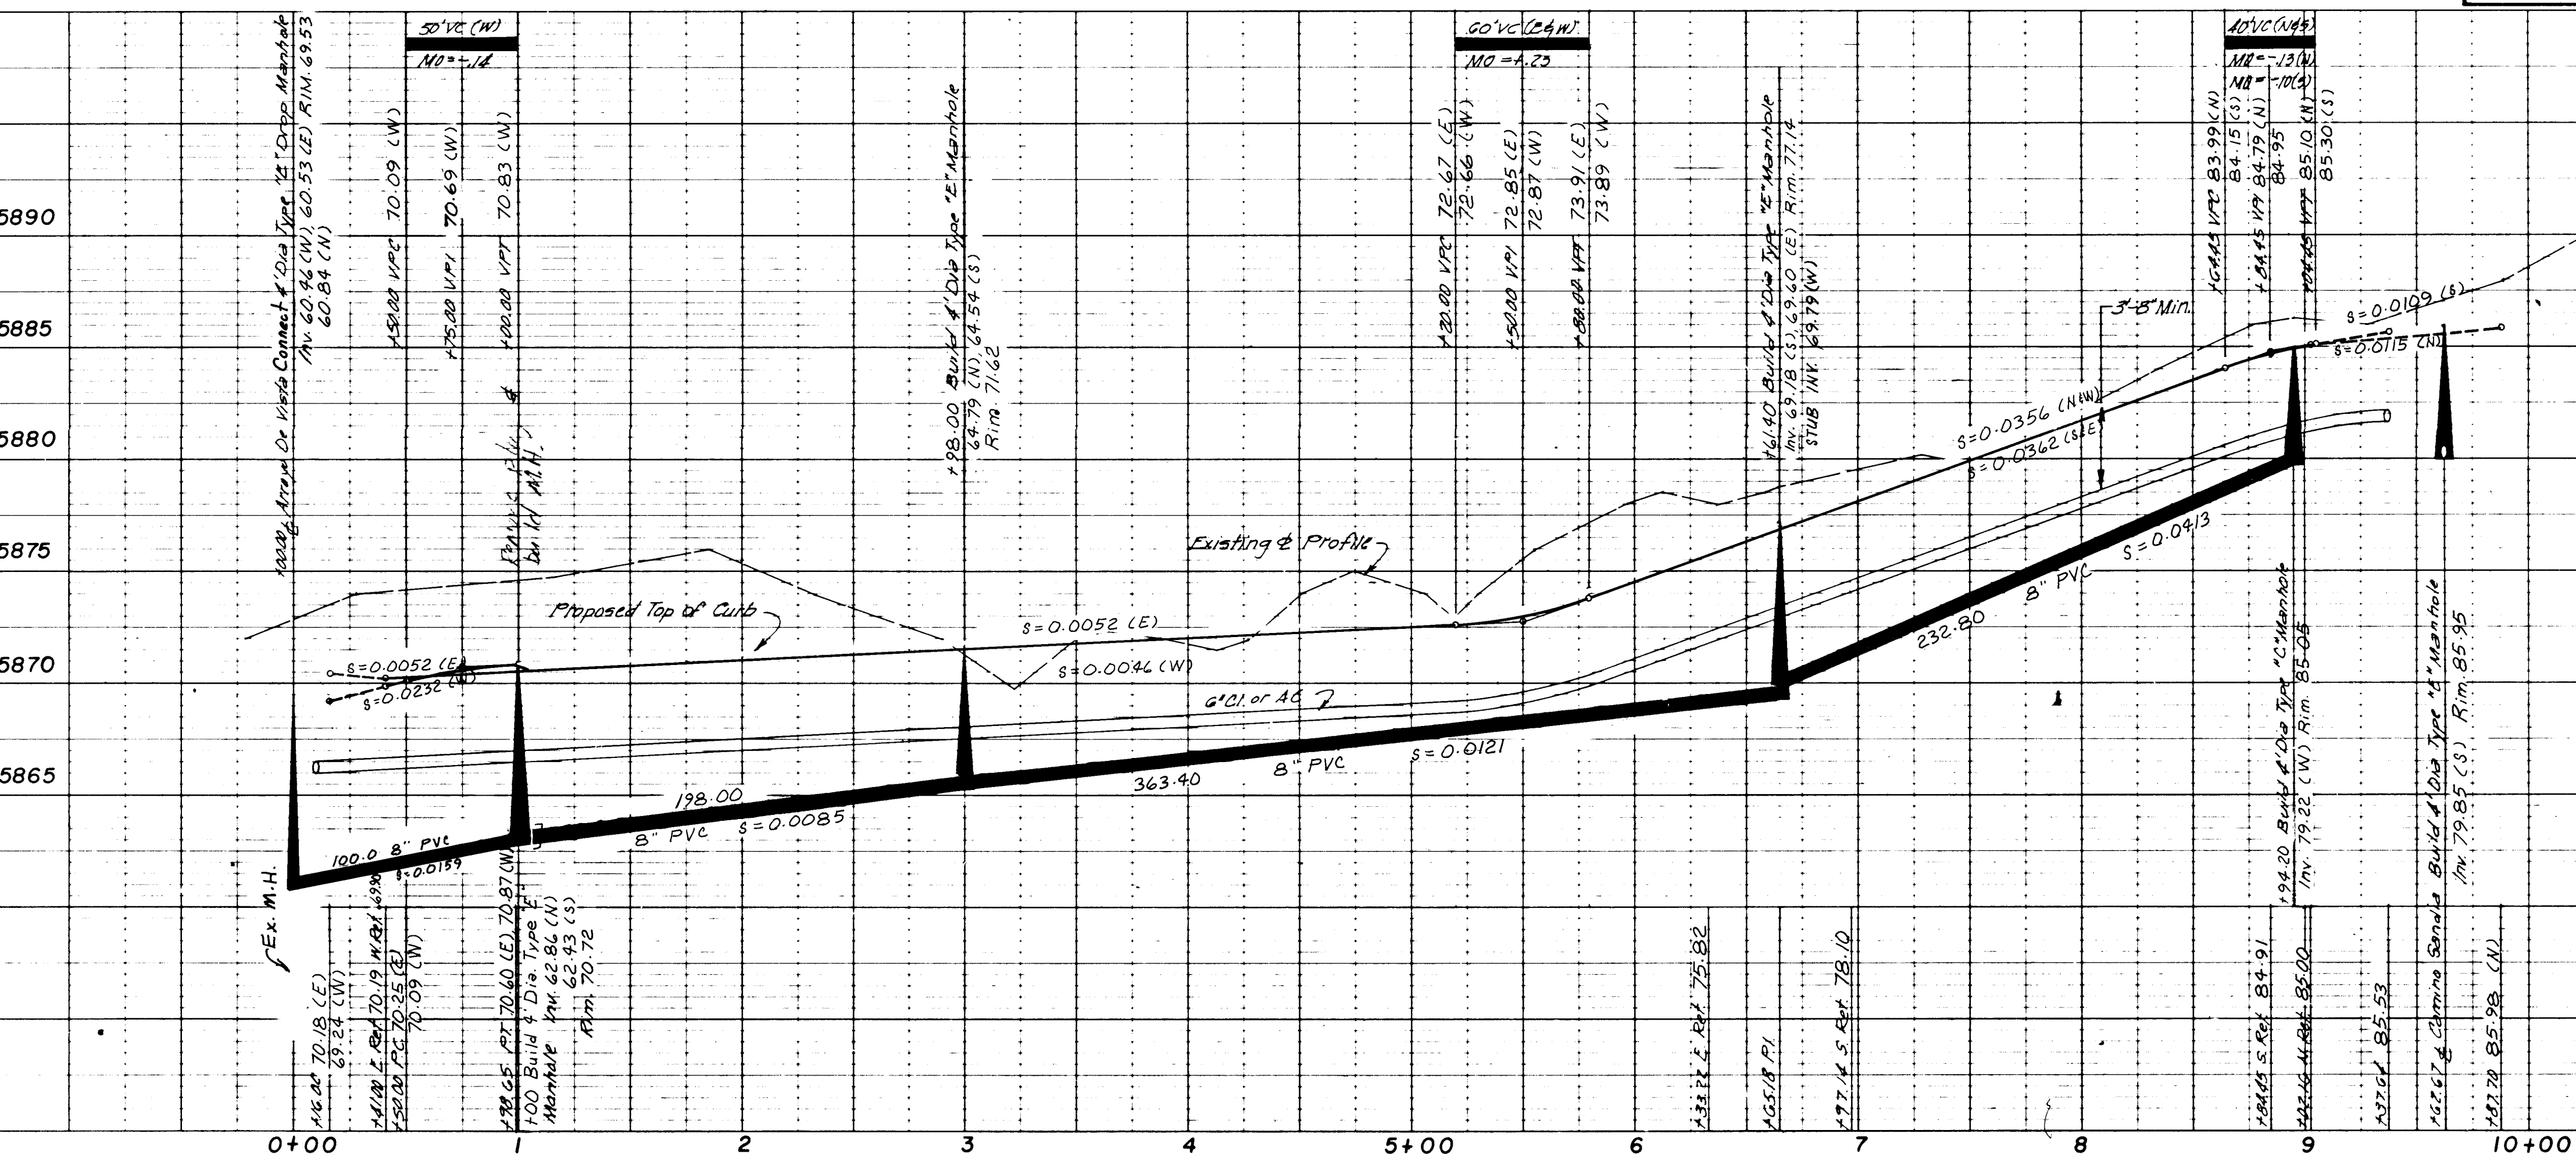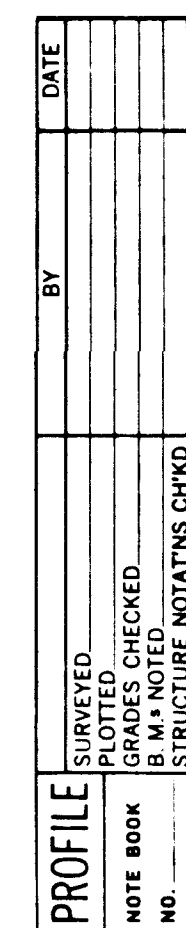

Notes: Electronic Marker Disks shall be installed as specified in section 131 of the supplemental specifications to the City of Albuquerque Contract Documents for City-wide utilities and Gas Having No 31

• Bend

④ Transition from Standard Curb & Gutter to Mountable Curb Roll Type per City Std. Cwg. 10-18-1

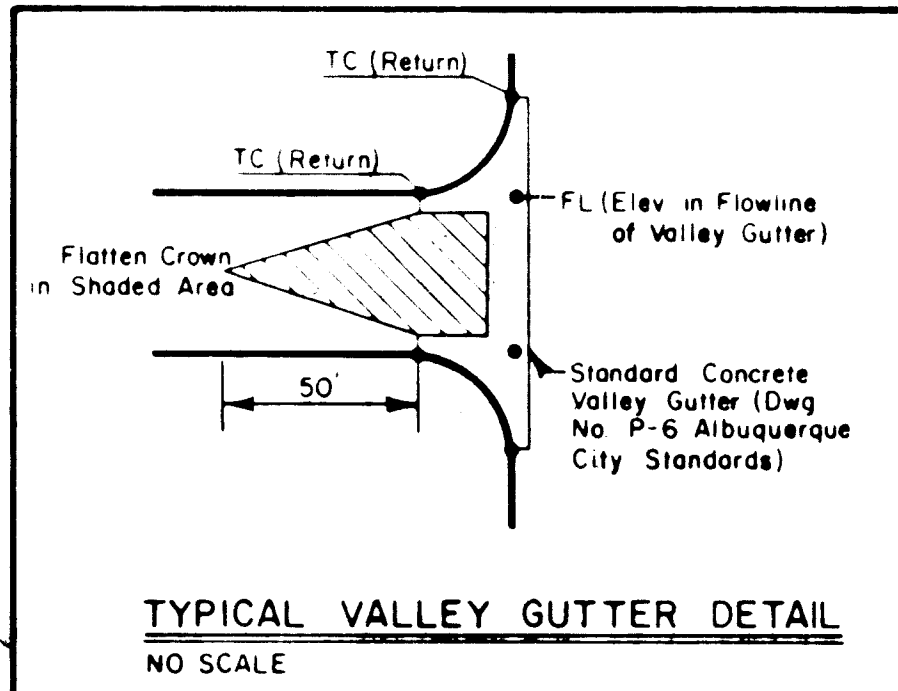

— LEGEND —

	Direction of Street Drainage
	Direction of Sewer Drainage with Service Line Stubouts

RECORD DRAWING

I, Claude A.L. Pilley, N.M.P.E. & L.S. No. 4981,
hereby certify that this drawing has been
revised in accordance with information furnished
by KNC Inc. Field surveys and that both the
revisions and field surveys were done under
my personal direction and control

Claude A.L. Pilley
CLAUDE A.L. PILLEY


APPROVED FOR RECORD
DATE 10/1/84 BY 104

36 1440 1084

THIS SHEET PREVIOUSLY APPROVED
AS C-29-33.

BENCH MARKS						AS-BUILT INFORMATION	
SURVEY INFORMATION				CONTRACTOR KNC INC.			
REFERENCES		FIELD NOTES		WORK PREPARED BY DATE			
MAP NO.	F - 22	W O NO.	NO.	BY	DRAWING CORRECTED BY M. POHL DATE 8-8-84		
5	3-8-84	REVISED TO SHOW AS-BUILTS					
4	3/8/82	UNSATISFACTORY BUILD-TYPE CURB	DMM				
3	5/8/82	CREATE PHASE I/B CONSTRUCTION PLANS SET	DMM				
1	2/1/80	ADDED ELECTRONIC MARKER DISKS	PJH				
NO.	DATE	REMARKS	BY				
REVISIONS							
DESIGN							
DESIGNED BY DMM		DATE 6/79					
DRAWN BY JRJ		DATE 7/79					
CHECKED BY DMM		DATE 7/79					
BENCH MARKS				STATION IS LOCATED 475' EAST FROM EXT. OF CENTERLINE ON NOREEN DR. AND 26' SO. FROM CENTERLINE ON SPAIN RD. STATION IS A STANDARD A.C.S. BRASS CAP SET IN CONCRETE, FLUSH WITH GROUND, AND STAMPED "BD = 3". ELEVATION = 5722.27			
MICRO-FILM INFORMATION				RECORDED BY NO DATE			

SHEET 10 OF 13

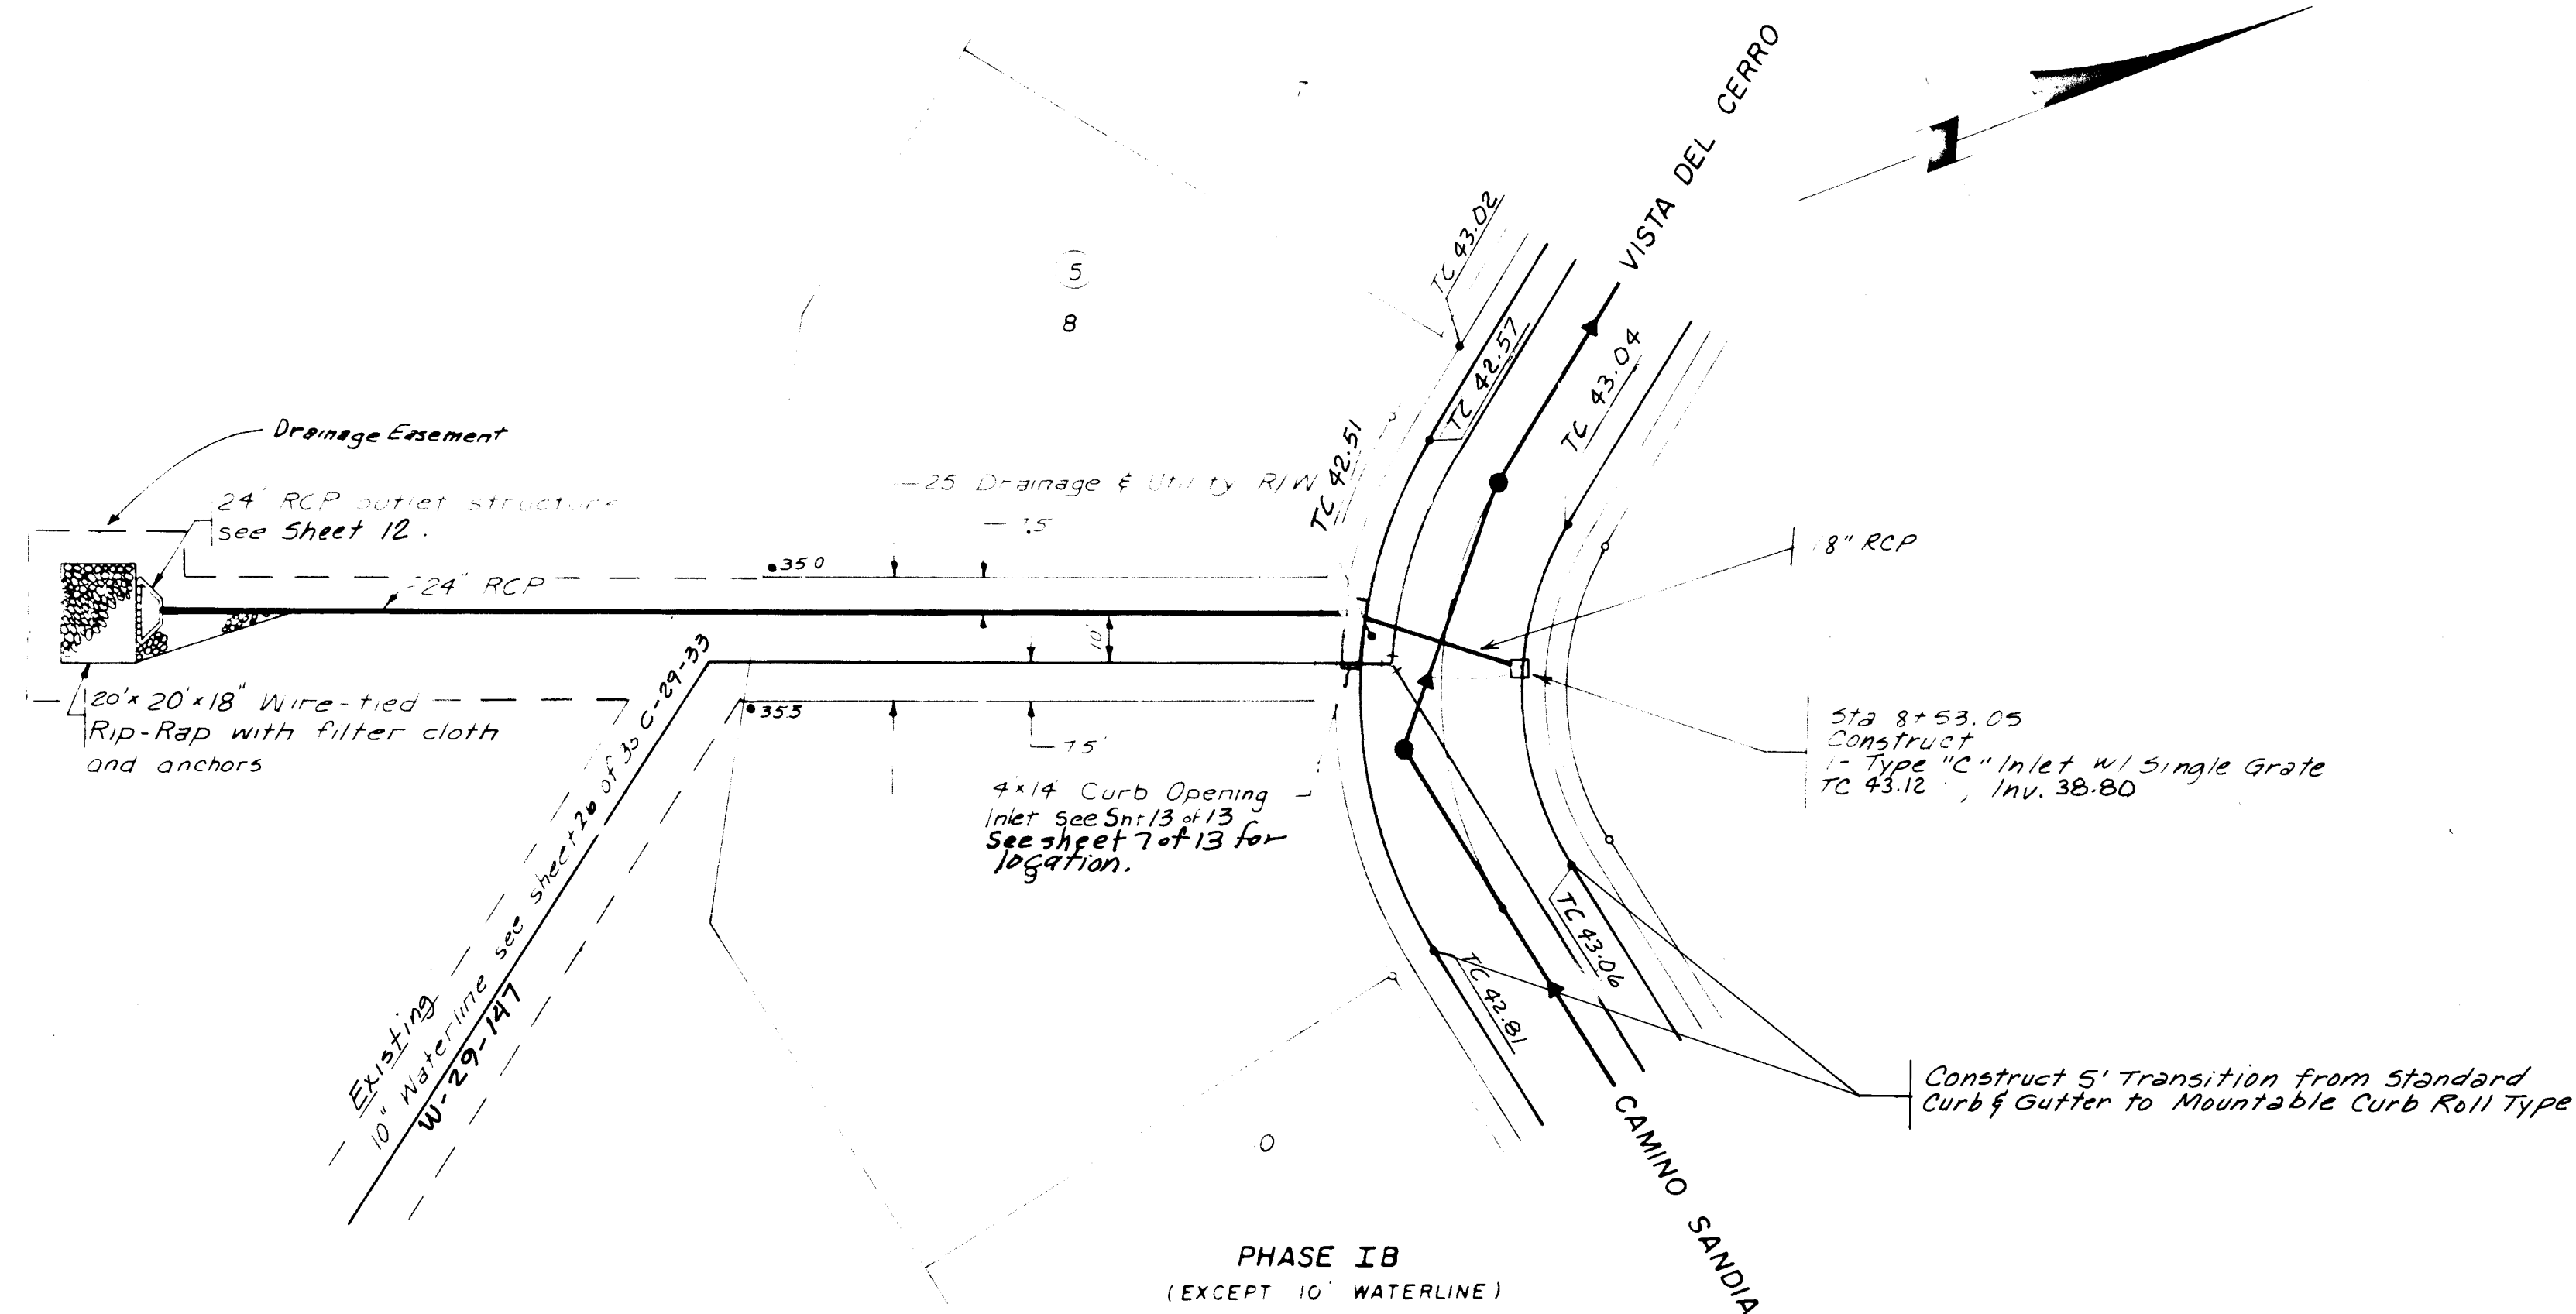

0+00 1 2

5835 5830 5825 5815 5810 5805

5815 5820 5815 5810

0+00 1 2

1+74.42 End 18" RCP
Build Type "A" Inlet w/ Single Grate

1+39.15 End 24" RCP Build 41" x 15" Sub
Curb Inlet see sheet 31 of 35 Inv 38.09 (W)

1+00.00 Begin 24" RCP Inv 36.09

1+55.00 Begin 24" Outlet structure see detail "D" sheet 29 of 35

1+20.50 Begin Wire-tied Rip-Rap

1+99.50 End 36" RCP
Build 41" x 28" Curb Inlet 14.67' x 5.5' 24" Eurb Inlet
see sheet 31 of 35 Inv 38.75

1+20.42 End 36" RCP
Begin 36" RCP Inv 32.34

1+20.00 Begin Sliding Grate

1+20.00 Begin Sliding Basin "B" Inv 30.10

1+05.00 & Channel "A" View 36.34

Existing & Profile

Proposed Grade at &

127.09' 36" RCP 5" 0.0497

11'-0" Min Cover

24" RCP 240-35

Proposed Grade at &

Existing & Profile

8" 0.0555

30.80 18" RCP

8" 0.0841

Wire-tied Rip Rap w/ Filter Cloth on upstream side of Outlet Structure 50' long, width shall vary from 15' at Outlet end to 3' at North end. This Rip Rap shall be tied to 20' x 10' x 18" Wire-tied Rip Rap or Outlet.

I, Claude A.L. Pilley, N.M.P.E. & U.S. No. 4981,
hereby certify that this drawing has been
revised in accordance with information furnished
by K.N.C. Inc. field surveys and that both the
revisions and field surveys were done under
my personal direction and control.

Claude A. L. Pilley
CLAUDE A. L. PILLEY

THIS SHEET PREVIOUSLY APPROVED
AS C-29-33.

CITY OF ALBUQUERQUE
PUBLIC WORKS DEPARTMENT
ENGINEERING DIVISION

TITLE: LA VISTA GRANDE, UNIT 1B
DRAINAGE IMPROVEMENTS

APPROVALS	ENGINEER	DATE	APPROVALS	ENGINEER	DATE
City Engineer			Liquid Waste		
A.C.E.-Design	<i>[Signature]</i>	12-5-00	Traffic	<i>[Signature]</i>	
A.C.E.-Hydrology			Water		

DRAWING NO.	1440	SHEET 11 OF 13
-------------	------	----------------

AS-BUILT INFORMATION	
CONTRACTOR	KNC Inc.
WORK ACCEPTED BY DRAWING CORRECTED BY	DATE DATE 3-8-84 M. Poul


BENCH MARKS

STATION IS LOCATED 475' EAST FROM
EXT. OF CENTERLINE ON NOREEN DR.
AND 26' SO. FROM CENTERLINE ON
ESPAIN RD. STATION IS A STANDARD A.C.
BRASS CAP SET IN CONCRETE, FLUSH
WITH GROUND, AND MARKED "BD = 3"
ELEVATION = 5722.27


[illegible][illegible]

4	3-B-84	REVISED TO SHOW AS-BUILT	MP
3	3/82	CREATE PHASE B CONSTRUCTION PLANSET	DMM
2	11/80	LOWER CHANNEL & STILLING BASIN	MLI
NO.	REVISIONS		BY
DESIGN			
DESIGNED BY DMM		DATE	7/79
DRAWN BY JBR		DATE	7/79


DESIGN	
DESIGNED BY <i>DMYM</i>	DATE <i>7/79</i>
DRAWN BY <i>JBR</i>	DATE <i>7/79</i>

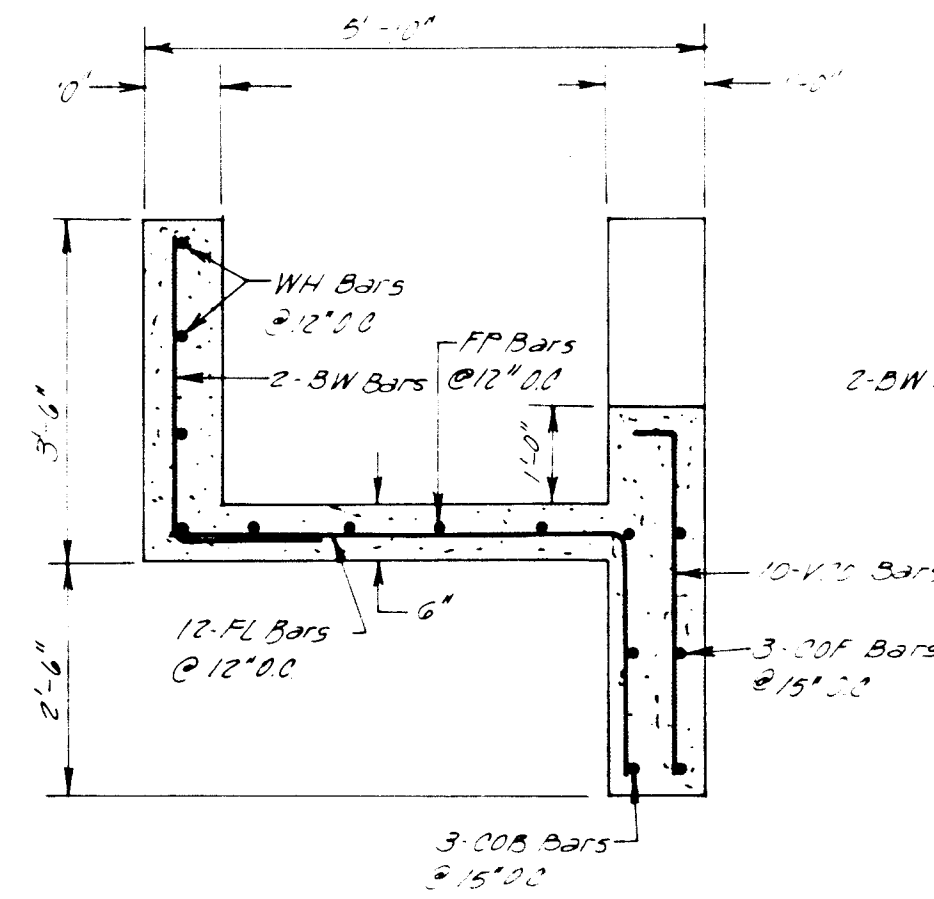


SECTION K-K

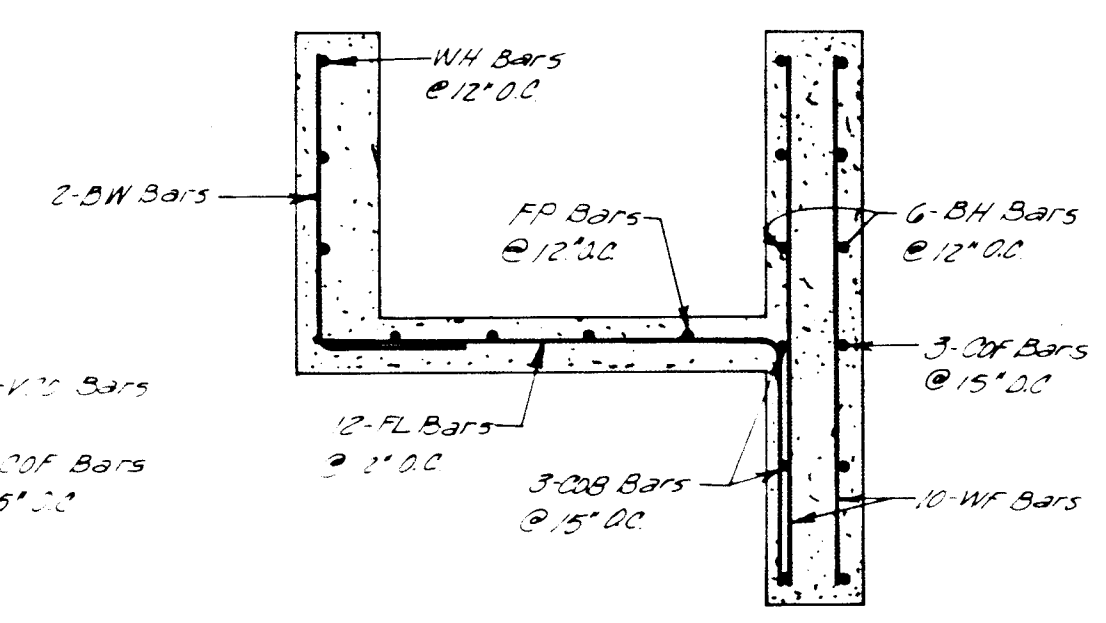











SECTION F-F

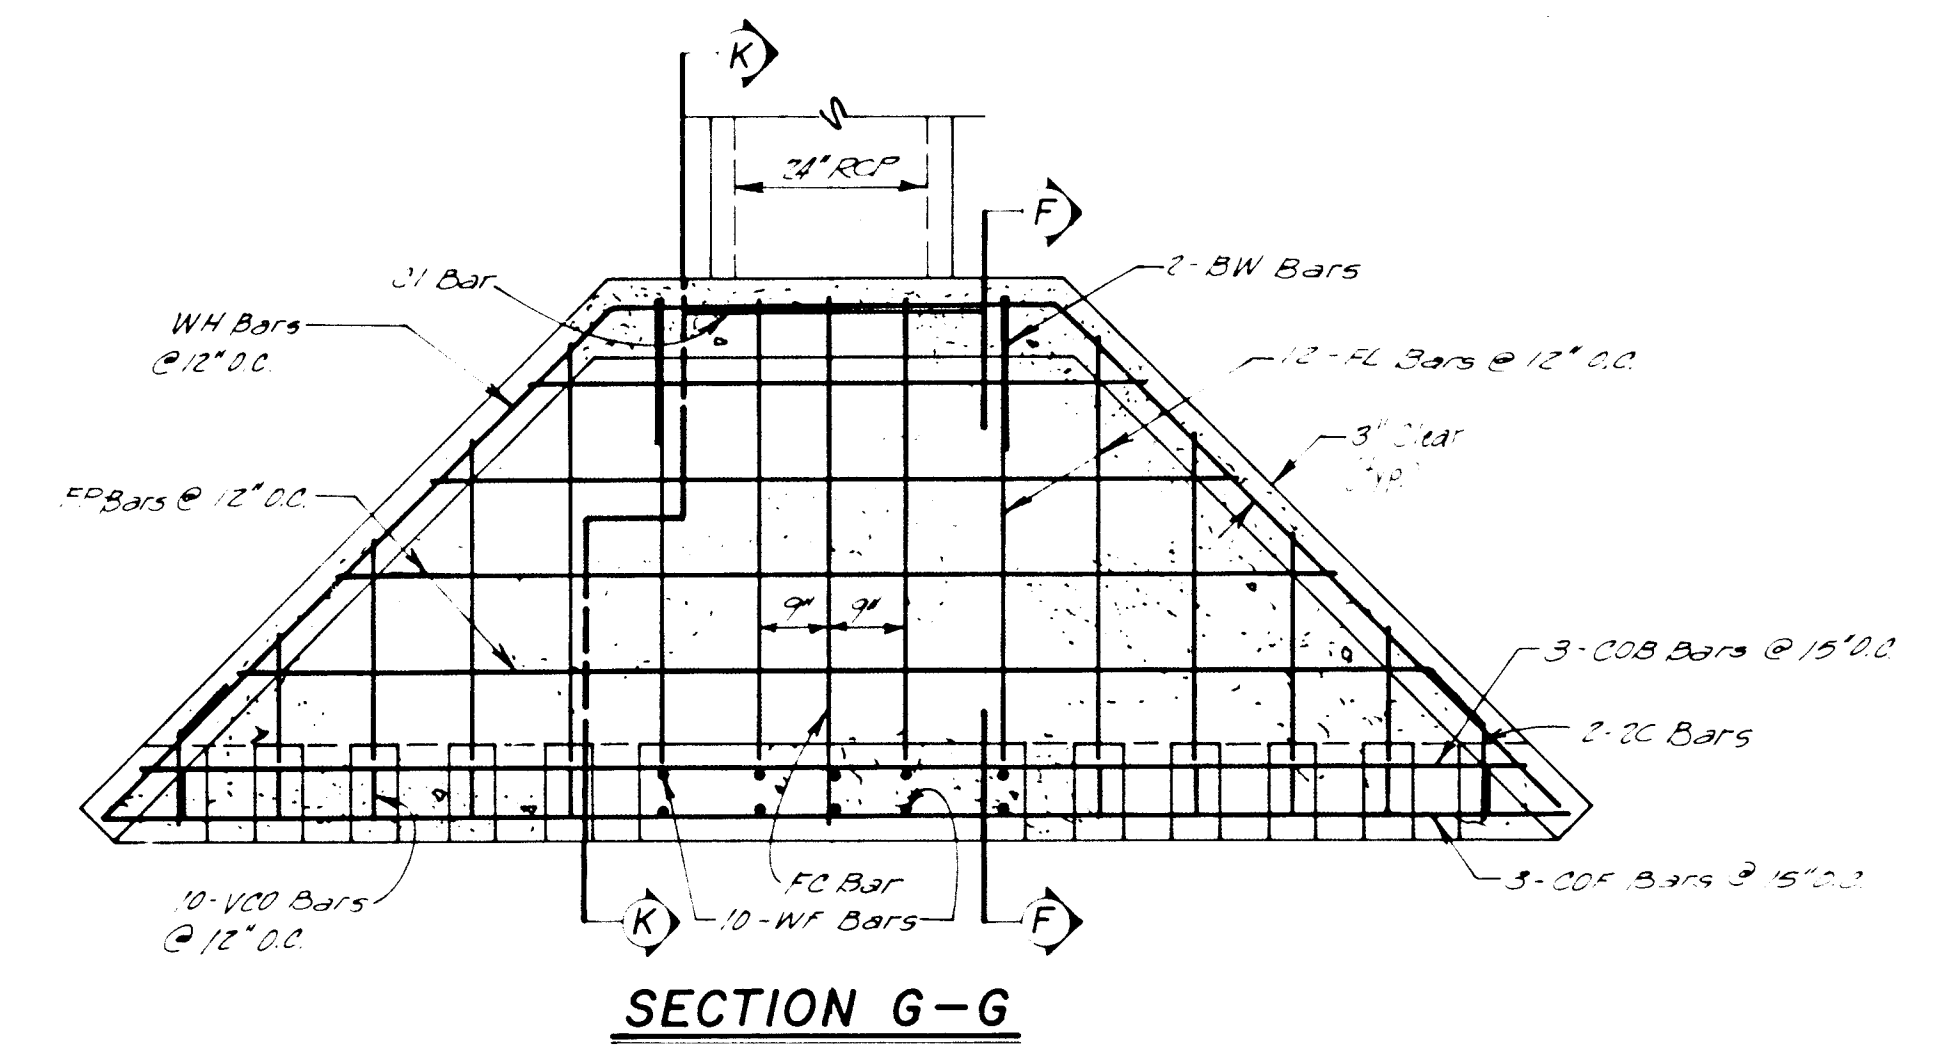

SECTION G-G

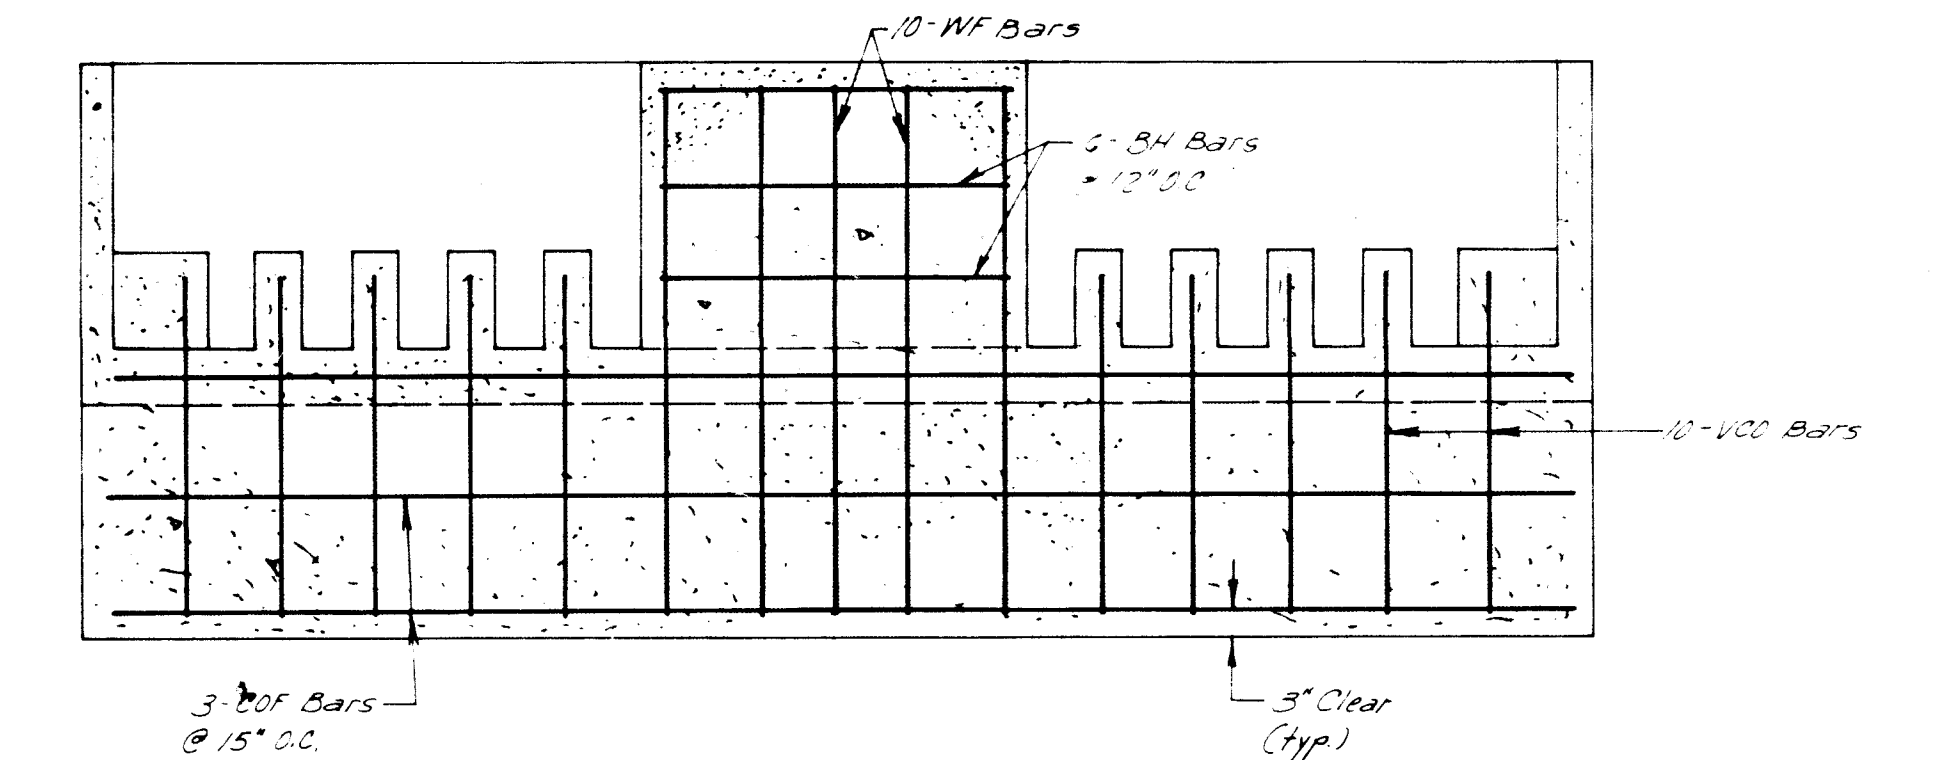


SECTION H-H

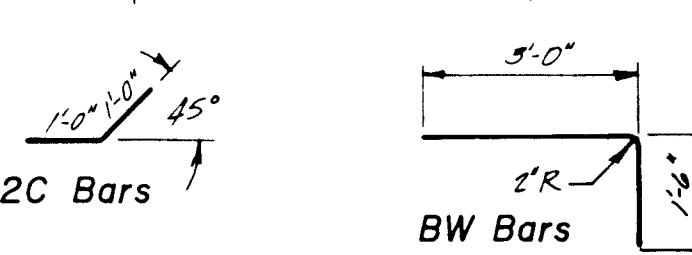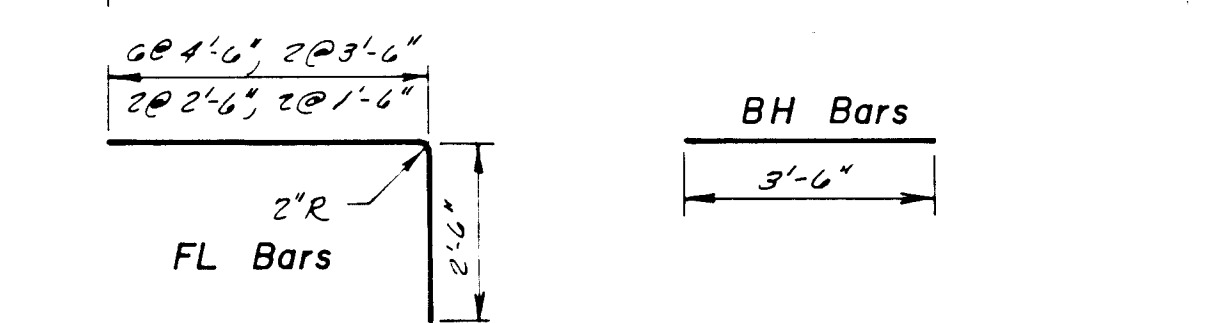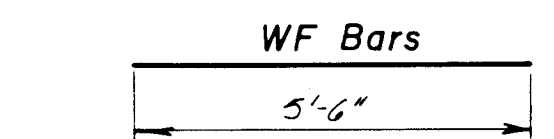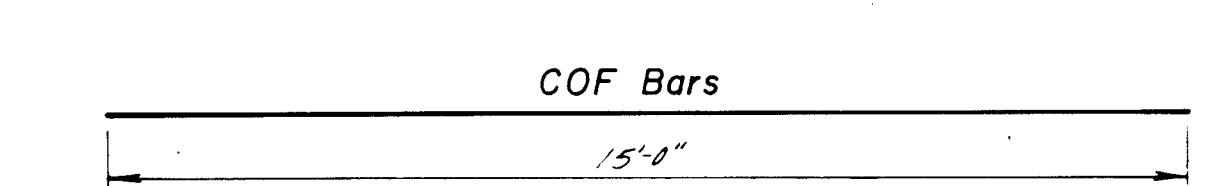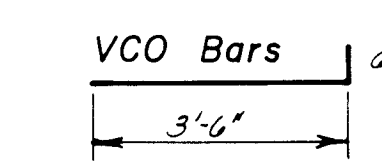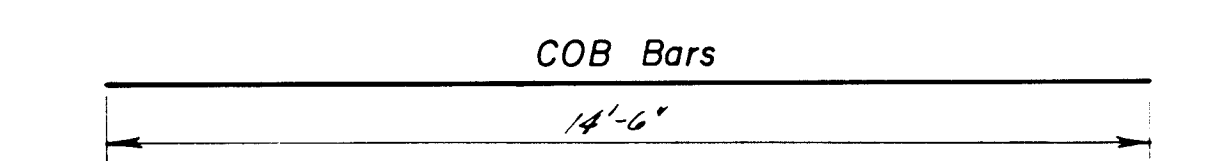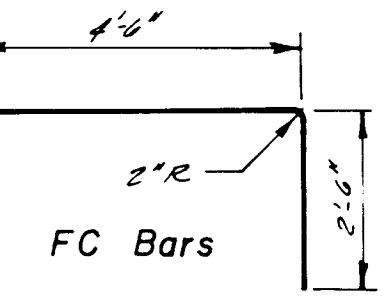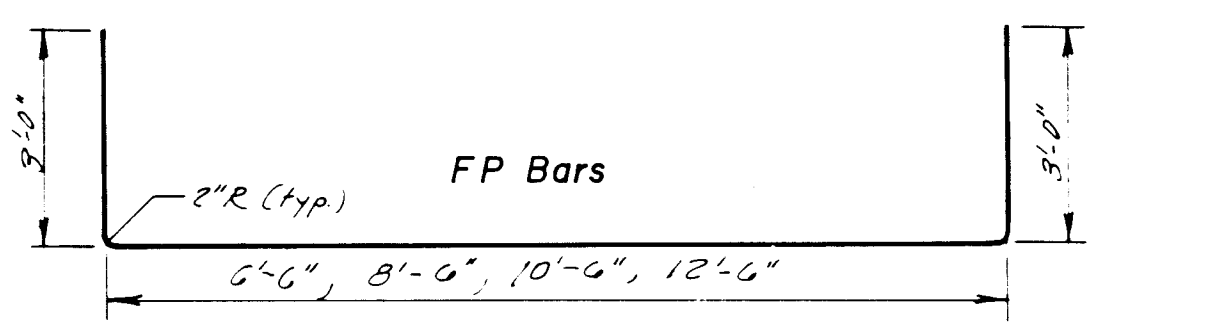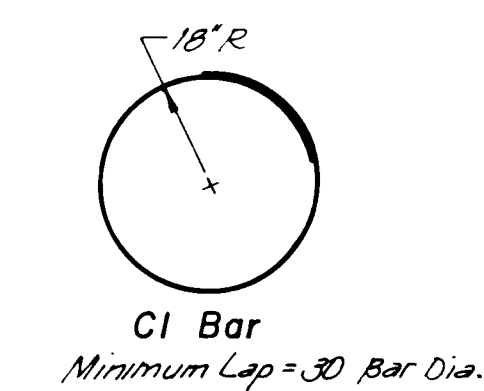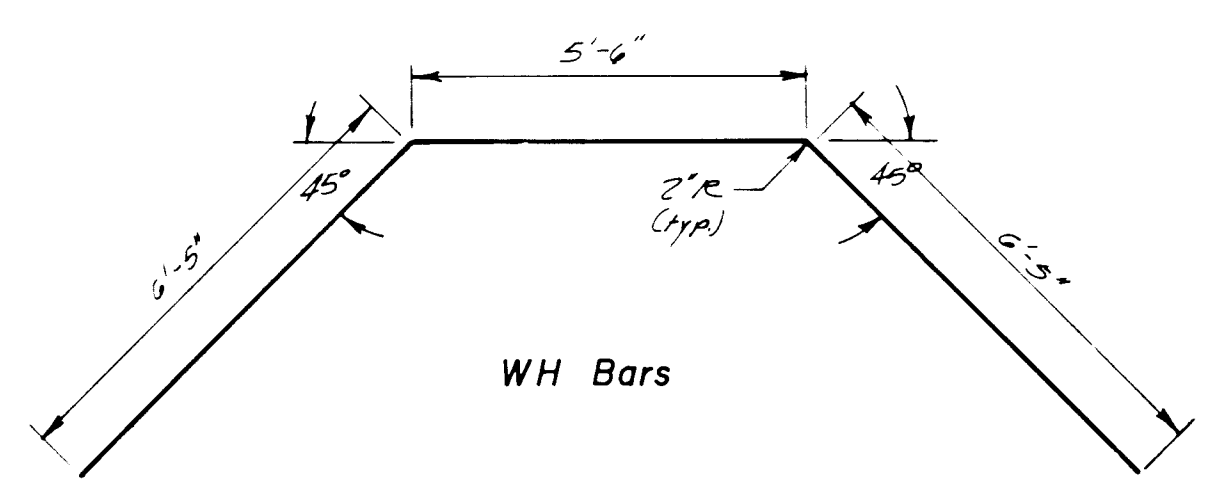


BAR DETAILS-24\"/>

Note: All rebar shall be #4 rebar.

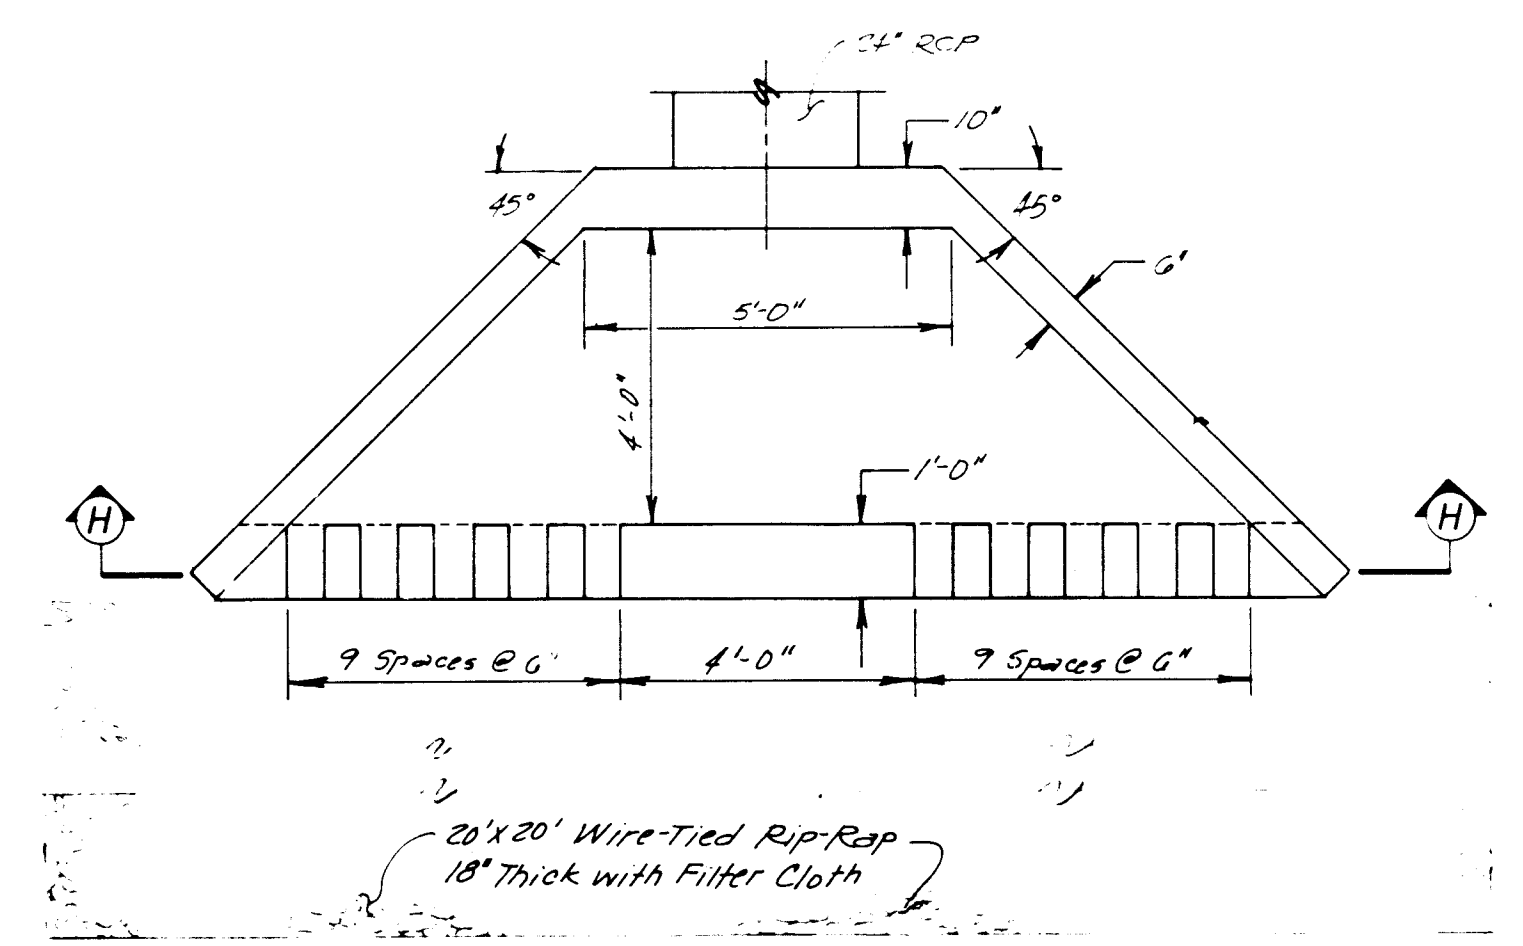

PLAN VIEW

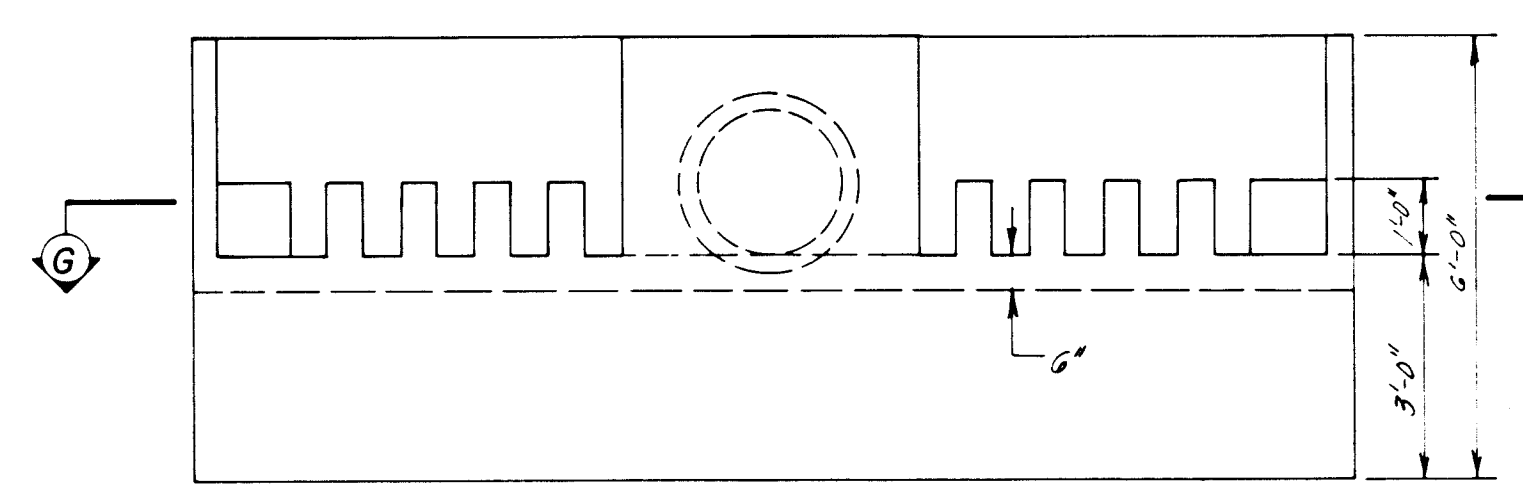

FRONT VIEW


24\"/>

Note: Wire tied rip rap shall be anchored in place by 3\"/>

THIS SHEET PREVIOUSLY APPROVED AS C-29-33.

26 1440 1284

Michael M. Long
4-23-87

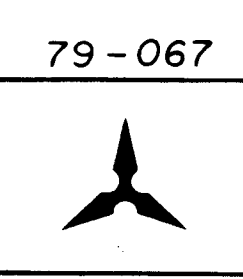

CITY OF ALBUQUERQUE PUBLIC WORKS DEPARTMENT ENGINEERING DIVISION					
TITLE: LA VISTA GRANDE, UNIT 1B OUTLET STRUCTURE					
APPROVALS	ENGINEER	DATE	APPROVALS	ENGINEER	DATE
City Engineer	<i>Michael M. Long</i>	10/1/87	Liquid Waste		
ACE-Design	<i>Michael M. Long</i>	11/1/87	Traffic	<i>N. A.</i>	
ACE-Hydrology	<i>Michael M. Long</i>	11/1/87	Water	<i>N. A.</i>	

SCALE
NO SCALE

APPROVED FOR
CONSTRUCTION
Richard S. Smith
CITY ENGINEER DATE 1/1/88

DRAWING
NO. 1440

SHEET 12 OF 13

AS BUILT INFORMATION			MICRO FILM INFORMATION		
DATE	DATE	DATE	DATE	DATE	DATE
BENCH MARKS STATION IS LOCATED 475' EAST FROM EXT. OF CENTERLINE ON MOREEN DR. AND 26' SO. FROM CENTERLINE ON SPAN RD. STATION IS A STANDARD A.C.S. BRASS CAP SET IN CONCRETE FLUSH WITH GROUND AND STAMPED "BD-3" ELEVATION = 5722.27					
SURVEY INFORMATION			REFERENCES		
NO.	NO.	NO.	MAP NO.	EST. NO.	W/O NO.
			F-22		
REVISIONS			REMARKS		
NO.	DATE	BY			
1	9/88	DMYM	Create Phase 1B Construction Plan Set		
2	11/88	DMYM	Removed Inlet Structure Details		
DESIGNED BY DMYM			DATE 8/79		
DRAWN BY JRJ			DATE 8/79		
CHECKED BY DMYM			DATE 8/79		



All Concrete shall be Class 5.5 C 3000.
Curvature of the Lip and Sidelights at Gutter Opening shall be formed by Curved Forms and shall be by casting.
Floor of Basin shall be given a steel-travelled Finish and shall slope from all directions to the Outlet. Slope of Floor Parallel with Curb shall be 1 in 12.
Manhole shall be Placed Along Back Wall Near Outlet.
Outlet Pipe shall be Trimmied to the Final Shape and Length Before Concrete is Poured.
supports 1" Plain Round Galvanized steel supports shall be Placed 7 ft Apart.











NOTES:

1. A Plain Round Steel Protection Bar 1" in Dia. shall be Installed. Bar shall be Embedded 5" at Each End.
2. A Stirrup shall be Welded to Each Bolt.
3. Protection Bar shall be Located 5" Behind Curb Face and 4" Above Gutter Flow Line.

	W	H	T	D	Downs	Archers	Max. 1	Max. 2
					Supports	Archers	Supports	Archers
Inlets on Vista del Cerro	14"	6'-0"	8"	24"	4	5	1	1500

Top Steel shall be #3 Rebar Grade 40 Clearance shall be 1" from Bottom of Slab.
 Wall and Floor Steel shall be #4 Rebar Grade 40 Clearance shall be 3" from outside of structure.
 All Splices shall be 30 Bar Diameters Minimum.

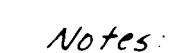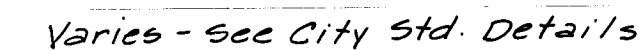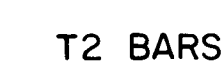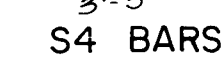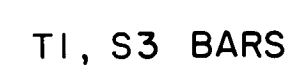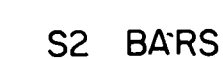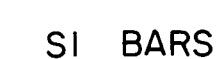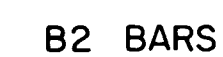

1. For manhole rim and invert elevations refer to sheet 11
2. For Concrete MH Cover Details see City Std. Drawing 5-3.
3. See City Std. Drawing 5-5 for MH Ring and Cover.
4. Concrete shall be class 5.5 C 3000.
5. See City Std. Drawing 5-6 for MH Brick Detail.
6. Grout Invert of Manhole to Crown of pipe as shown.
7. First two steps to protrude 4" into MH, all others 5". Steps to be set in epoxy cement (Hunt Process HEB-230 or approved equal) at 16" O.C. See City Std. Drawing 5-9 for Step Detail.
8. Plaster Inside and Outside of Manhole with 1/2" mortar.
9. Concrete Pipe Supports shall extend to bell of first joint and shall cradle pipe to spring line.

26 1440 1384

THIS SHEET PREVIOUSLY APPROVED
AS C-29-33.

Michael M. Emery
9-14-82

APPROVED FOR CONSTRUCTION *OK* 9/1/83
Richard S. Hall 5/4/83
 CITY ENGINEER DATE

SCALE:
NO SCALE

JOB NO. 00071

CITY OF ALBUQUERQUE
MUNICIPAL DEVELOPMENT DEPARTMENT
ENGINEERING DIVISION

TITLE: **LA VISTA GRANDE, UNIT 1B**

APPROVALS	ENGINEER	DATE	APPROVALS	ENGINEER	DATE
City Engineer	<i>R. S. Smith</i>	5/4/83	Liquid Waste	<i>James J. Jernigan</i>	5-3-83
A.C.E.-Design	<i>R. S. Smith</i>	5/4/83	Traffic		
A.C.E.-Hydrology			Water	<i>James J. Jernigan</i>	5-3-83

3	DRAWING NO.	1440
---	----------------	------

SHEET 13 OF 13