


SCALE: N 1" = 20'

CURVE DATA			
R	Δ	T	L
150'	16° 15' 37"	21.43'	42.57'
10'	180°	—	31.42'
2'	180°	—	6.28'

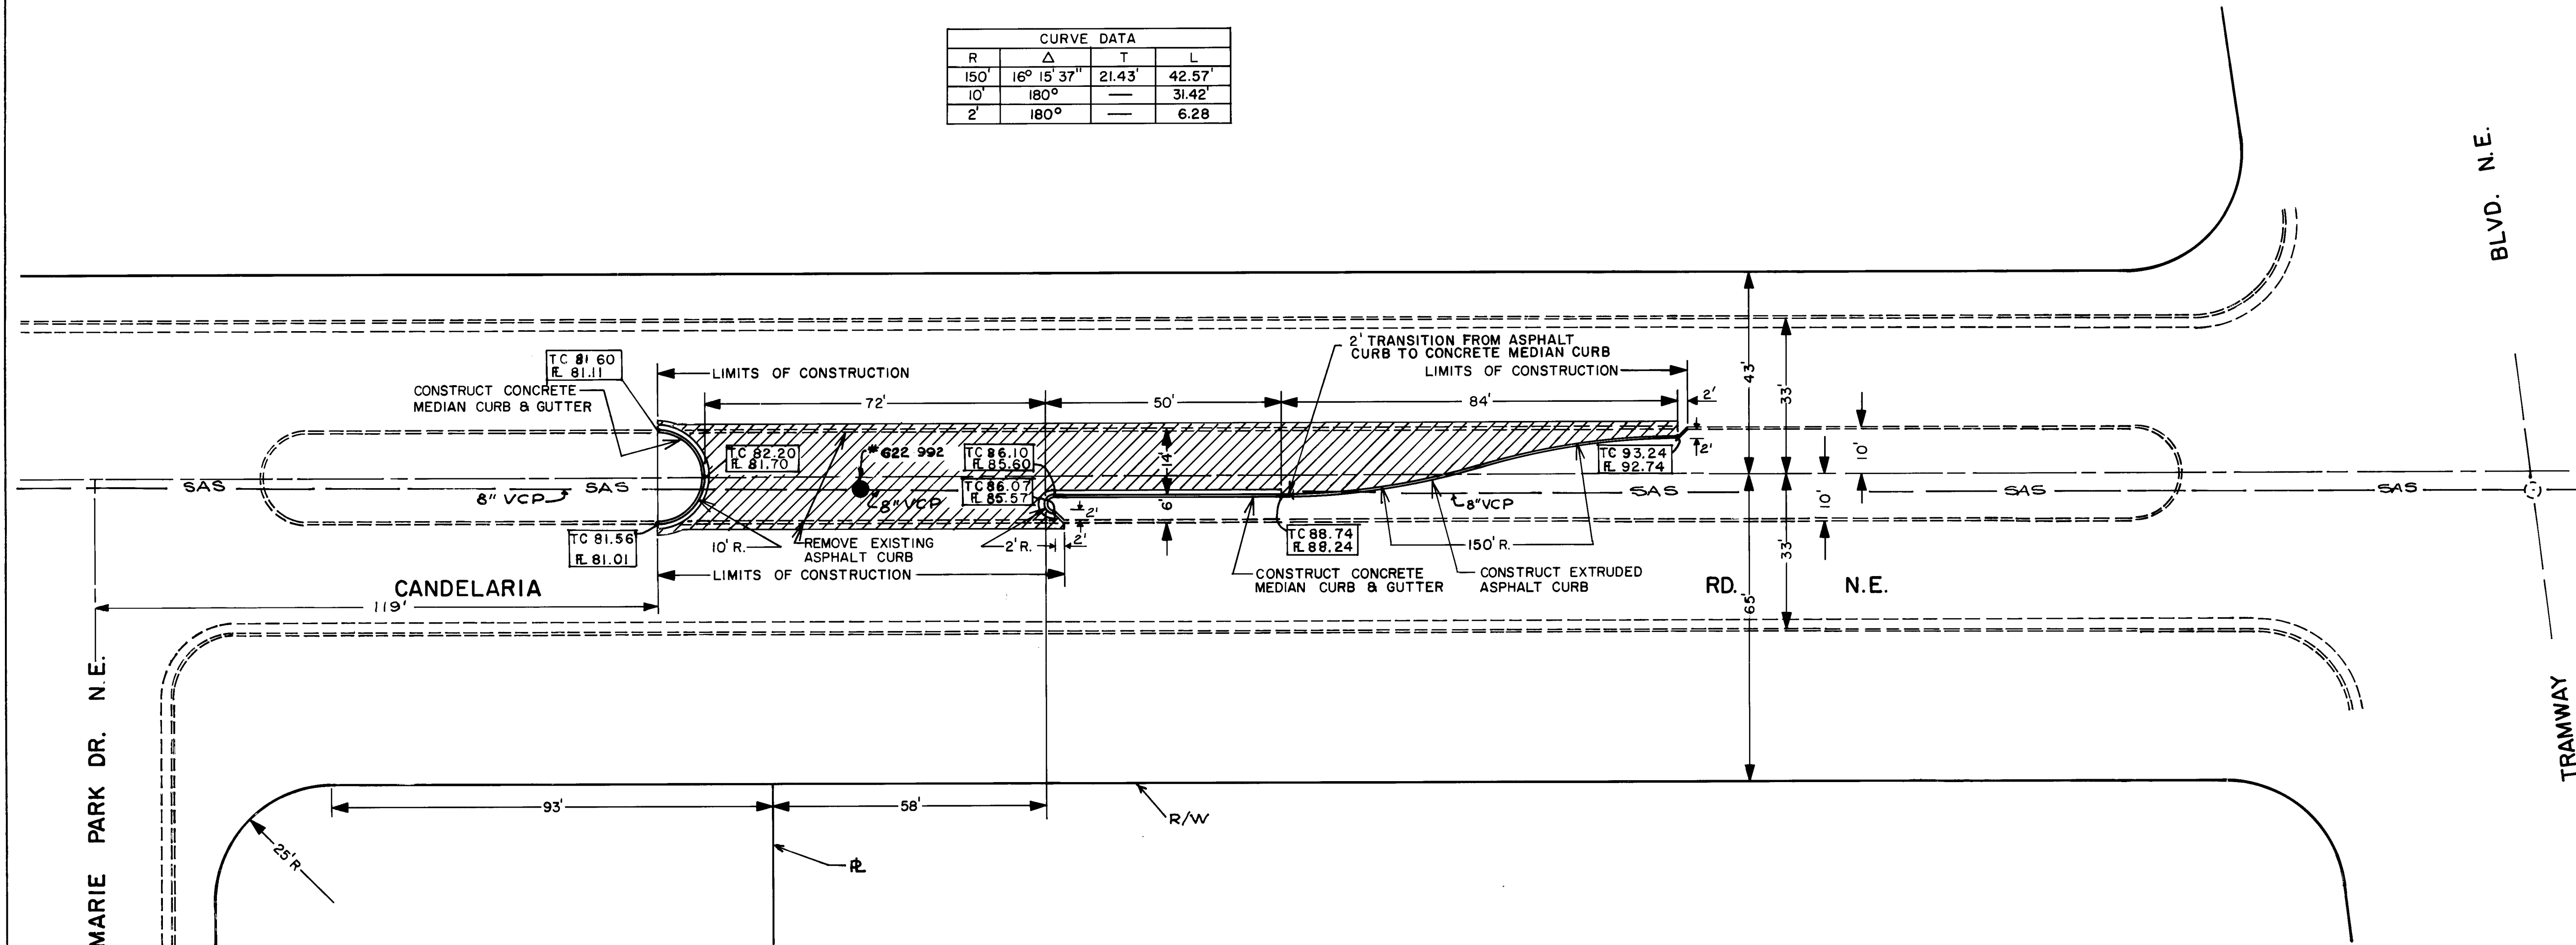

TRAFFIC HANDLING NOTES

1. CONTRACTOR MUST SUBMIT A CONSTRUCTION SIGNING AND BARRICADING PLAN TO TRAFFIC ENGINEERING DIVISION AND RECEIVE A BARRICADING PERMIT PRIOR TO CONSTRUCTION.
2. ALL CONSTRUCTION SIGNING AND BARRICADING TO COMPLY WITH MANUAL ON UNIFORM TRAFFIC CONTROL DEVICES, 1978 EDITION.
3. CONTRACTOR'S OPERATION, BARRICADING AND SIGNING SHALL NOT AFFECT THRU LANES OF CANDELARIA BETWEEN 7 AM AND 9 AM OR 4 PM AND 6 PM.

Legend

- CONCRETE MEDIAN NOSE, SIDEWALK STANDARD
- NEW ARTERIAL PAVING
- EXISTING ASPHALT MEDIAN CURB
- NEW CONCRETE MEDIAN CURB
- NEW EXTRUDED ASPHALT CURB
- NEW CURB ELEVATIONS
- ADJUST MANHOLE TO NEW GRADE



"NOTICE TO CONTRACTORS"

- 1) New Mexico Standard Specification for Public Works Construction - 1979 Edition will be referred to herein as the "Standard Specification."
- 2) All work detailed on these plans to be performed under contract shall, except as otherwise stated or provided for herein, be constructed in accordance with "Contract Documents for City-Wide Utilities and Cash Paving No. 30" and the "Standard Specification."
- 3) Two working days prior to any excavation, contractor must contact Line Locating Service, 765-1234, for location of existing utilities.
- 4) Prior to construction, the contractor shall excavate and verify the horizontal and vertical locations of all obstructions. Should a conflict exist, the contractor shall notify the engineer or surveyor so that the conflict can be resolved with minimum amount of delay.

THE FOLLOWING NOTES APPLY WHEN CHECKED

- ☐ All utilities and utility service lines shall be installed prior to paving.
- ☒ Backfill compaction shall be according to specified street use. (Arterial)
- ☒ Tack coat requirements shall be determined by the City Engineer.
- ☐ Sidewalks and wheelchair ramps within the curb returns shall be constructed wherever a new curb return is constructed.
- ☐ If curb is depressed for a driveway, the driveway shall be constructed prior to acceptance of the curb and gutter.
- ☐ All storm drainage facilities shall be completed prior to final acceptance.

APPROVAL OF AS BUILT DRAWINGS
ASST. CITY ENGINEER - FIELD
[Signature]
DATE 11/1/82

APPROVED FOR CONSTRUCTION
[Signature]
CITY ENGINEER DATE 11/1/82

CITY OF ALBUQUERQUE MUNICIPAL DEVELOPMENT DEPARTMENT ENGINEERING DIVISION					
MR 82-2					
TITLE: MEDIAN REVISION ON CANDELARIA RD. N.E. BETWEEN MARIE PARK DR. AND TRAMWAY BLVD. N.E.					
APPROVALS	ENGINEER	DATE	APPROVALS	ENGINEER	DATE
City Engineer	<i>[Signature]</i>	7/1/82	Liquid Waste		
A.C.E. - Design	<i>[Signature]</i>	7/1/82	Traffic	<i>[Signature]</i>	7/1/82
A.C.E. - Hydrology	<i>[Signature]</i>	7/1/82	Water		
DRAWING NO. 1446			MAP NO. M.B. H-22 SHEET 1 OF 1		