
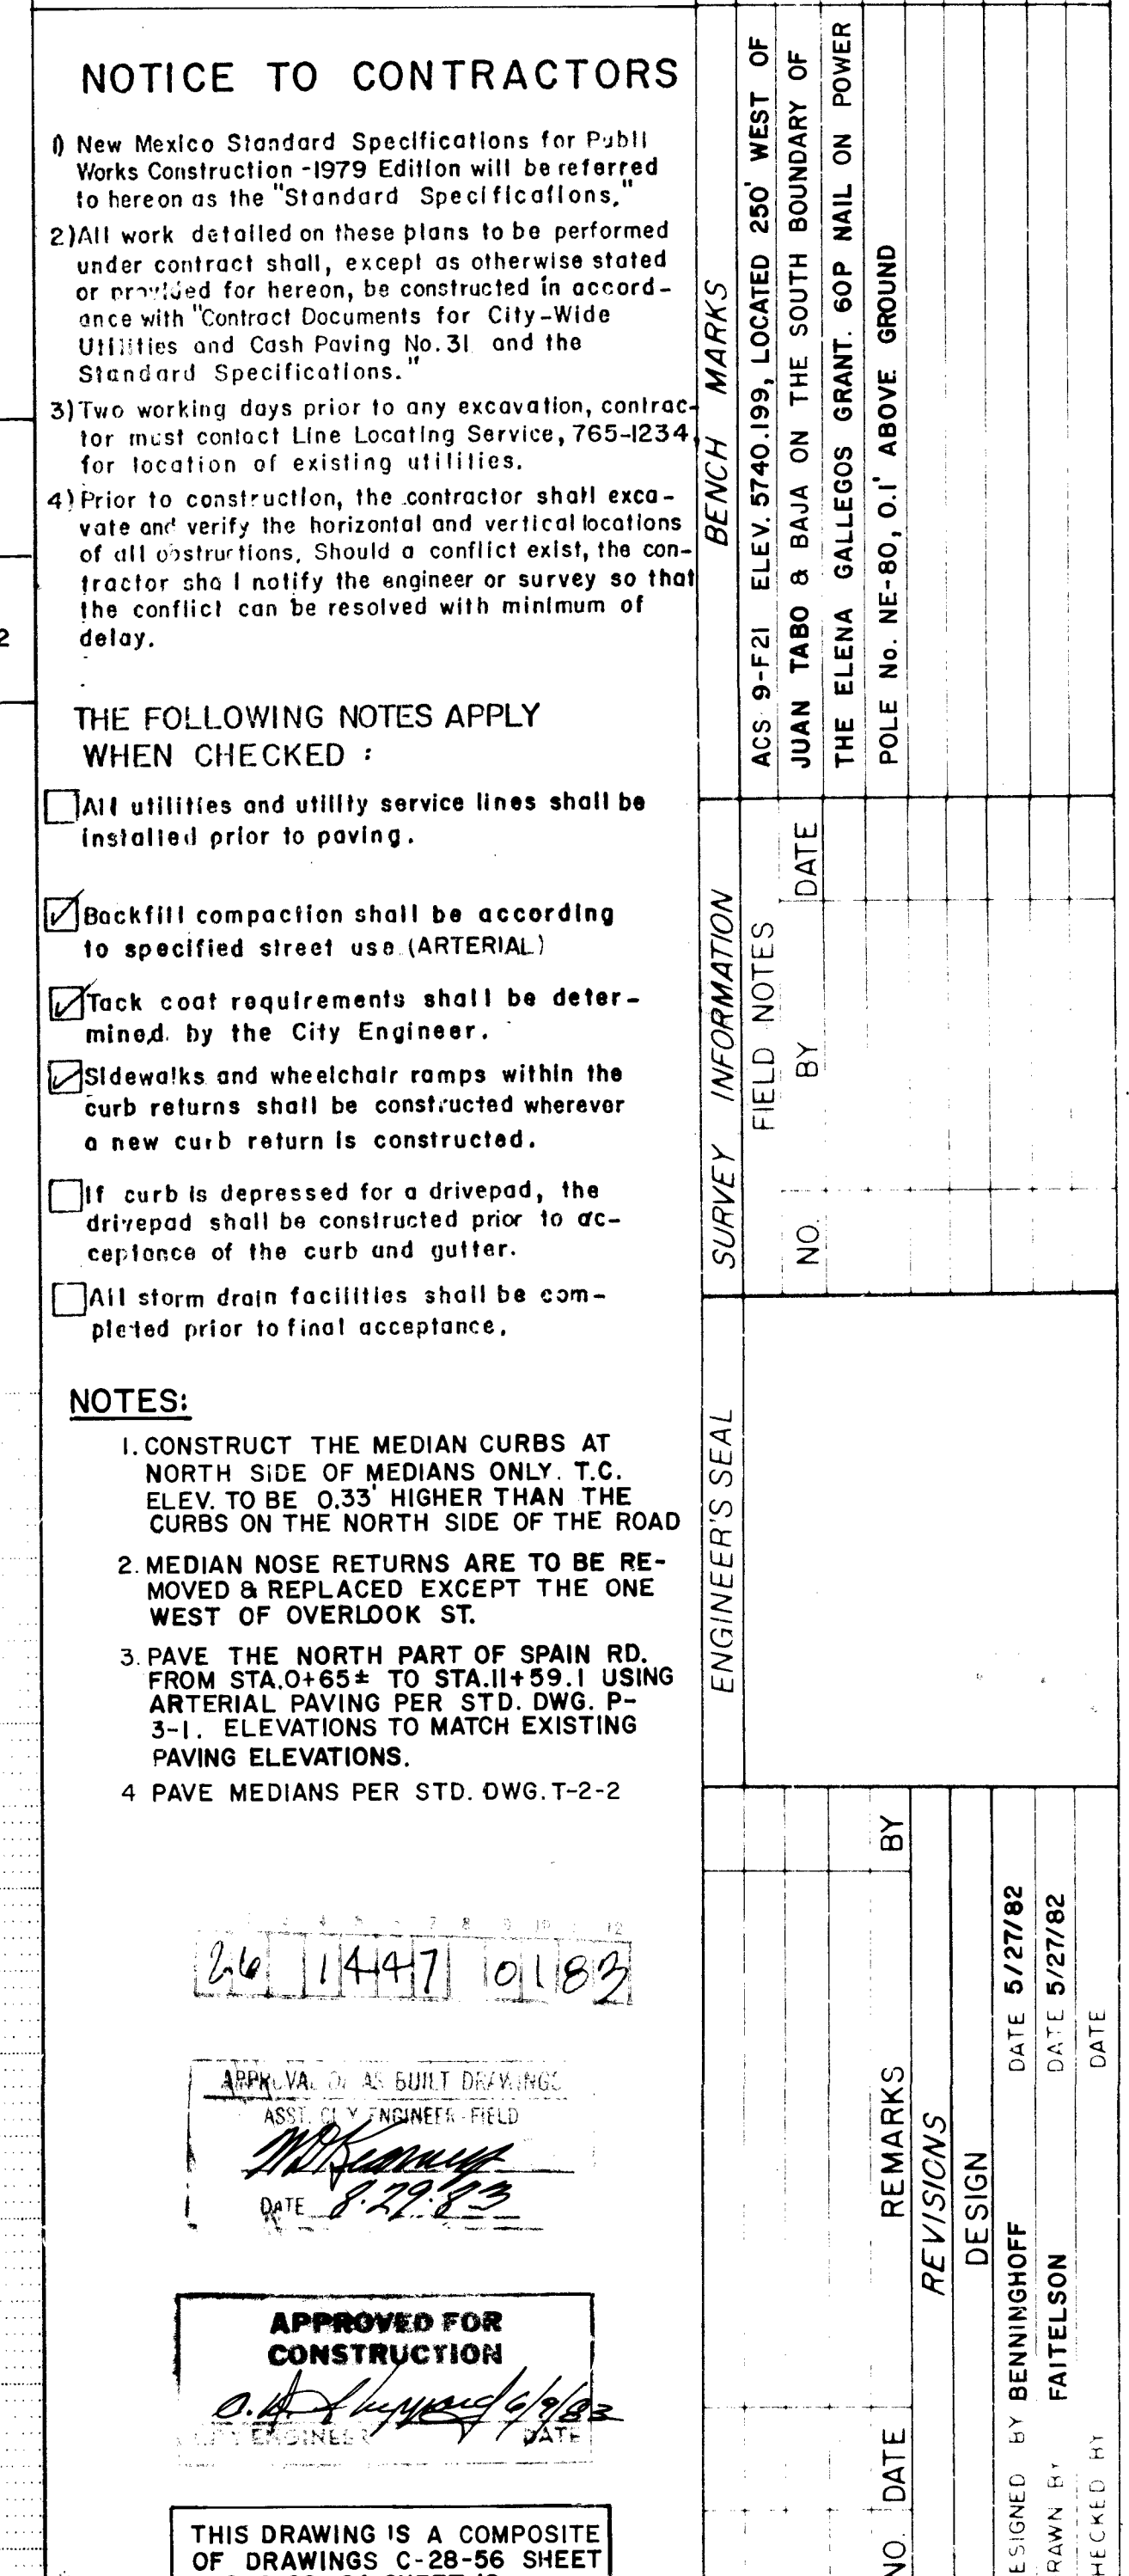


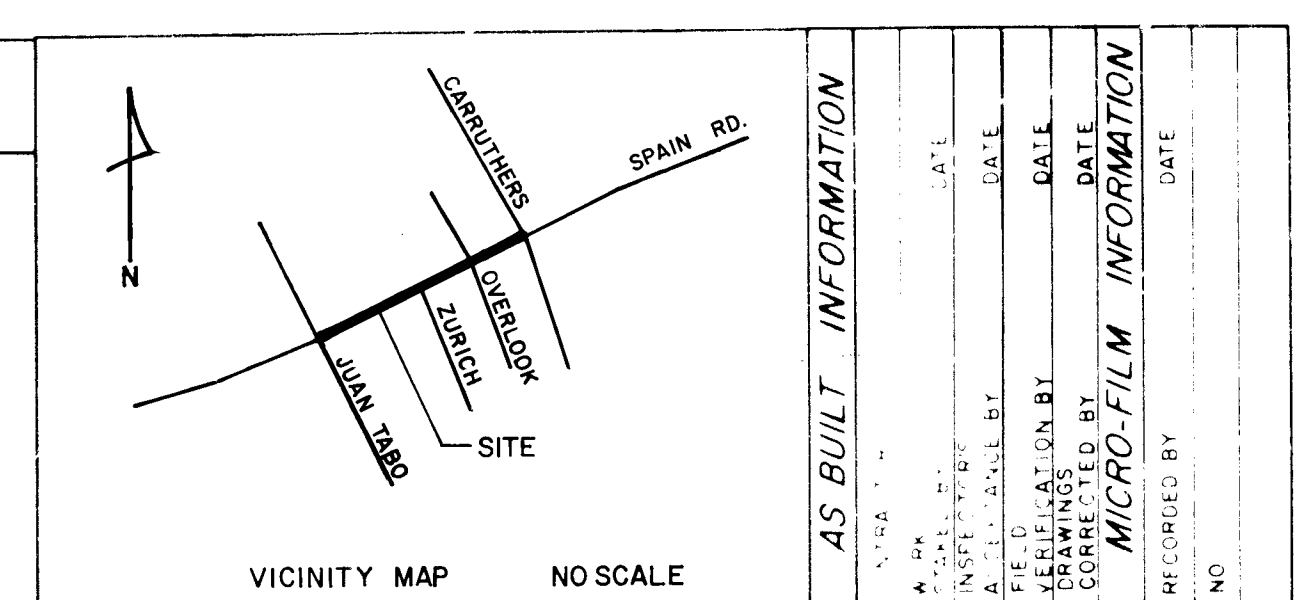

1-4 2-8 3-8 C-29-24 SHEET 10					
CITY OF ALBUQUERQUE MUNICIPAL DEVELOPMENT DEPARTMENT ENGINEERING DIVISION					
TITLE: PAVING ON SPAIN ROAD FROM JUAN TABO TO CARRUTHERS					
APPROVALS	ENGINEER	DATE	APPROVALS	ENGINEER	DATE
City Engineer	<i>R. Smith</i>	8/14/72	Liquid Waste	<i>NA W/3</i>	6-3-73
A C E - Design	<i>G. Kish</i>	11/14/72	Traffic	<i>R. K. Smith</i>	6/1/73
A C E - Hydrology	<i>Jim Fink</i>	10-23-72	Water	<i>NA W/3</i>	6-3-73
DRAWING		1447	MAP NO.	1447 SHEET	OF
		F-22 23			