
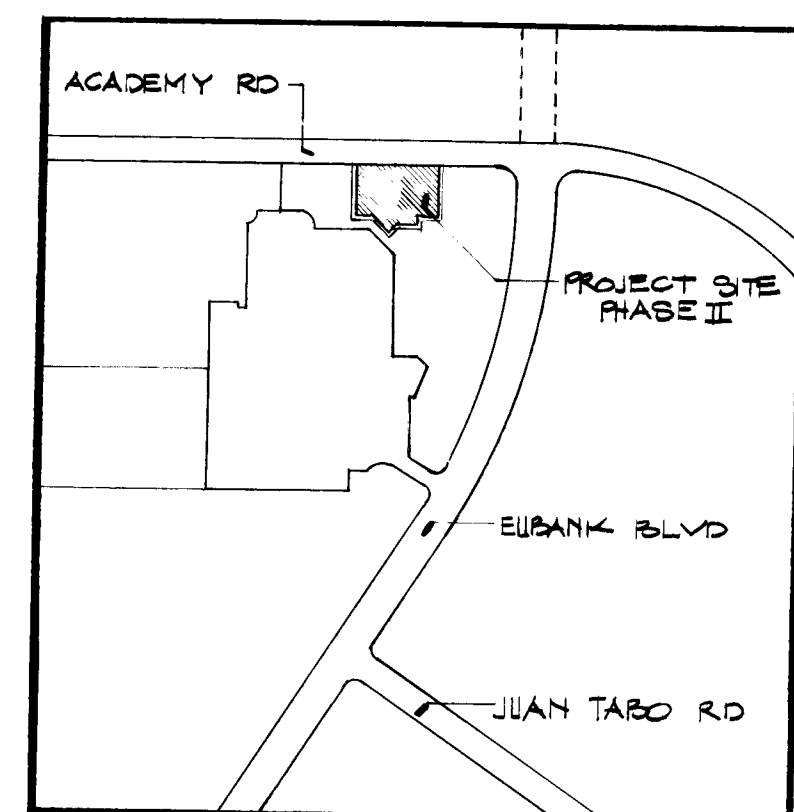


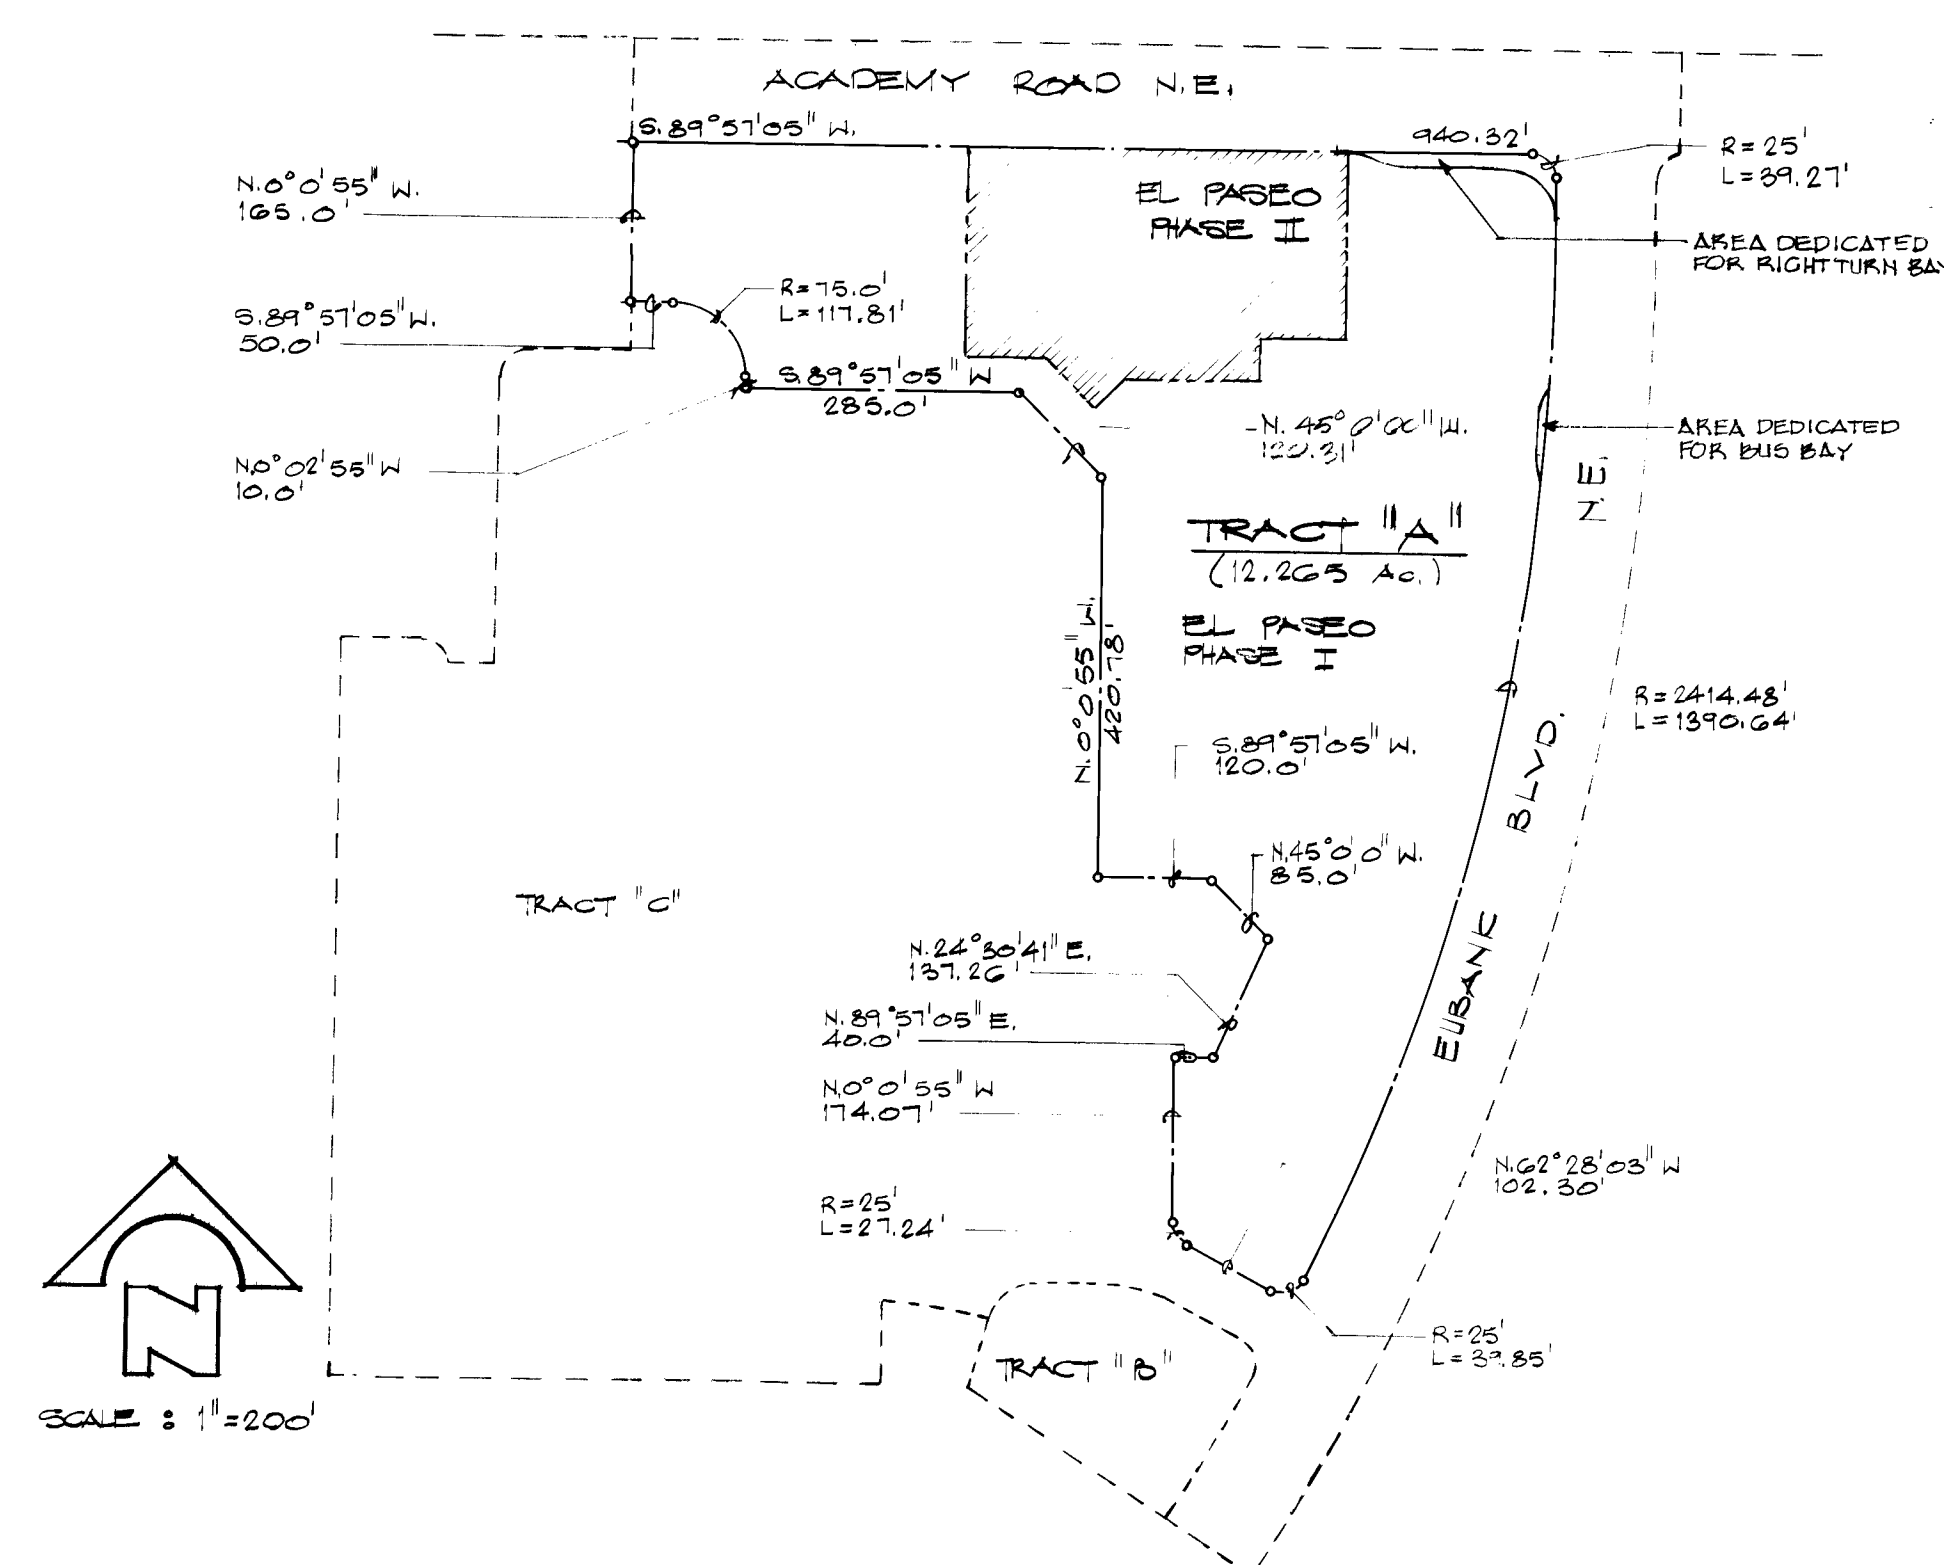

VICINITY MAP

EL PASEO PHASE II

PROJECT SITE
ACADEMY HILLS SUBDIVISION
UNIT NO. 5

INDEX TO DRAWINGS

DESCRIPTION	SHEET NO.
TITLE SHEET	1
PLAN OF GEOMETRY	2-6
SITE/GRADING/DRAINAGE PLAN	7
SITE UTILITY PLAN	8
EASEMENT LINES/A & B UTILITY PLAN AND PROFILE	9
LAS CASITAS COURT/B UTILITY PLAN AND PROFILE	10
RETAINING WALLS AND DRAINAGE DETAILS	11
DRAINAGE DETAILS	12


NOTICE TO CONTRACTORS

- NEW MEXICO STANDARD SPECIFICATIONS FOR HIGHWAYS SHALL BE USED FOR ALL CONSTRUCTION. THE STANDARD SPECIFICATIONS SHALL BE REFERRED TO HEREON AS THE "STANDARD SPECIFICATIONS".
- ALL WORK DETAILED ON THESE PLANS TO BE PREPARED UNDER CONTRACT SHALL BE DONE AS SHOWN, UNLESS OTHERWISE SPECIFIED. THE CONTRACTOR SHALL BE RESPONSIBLE FOR OBTAINING ALL NECESSARY PERMITS AND FOR THE LOCATION OF ALL UTILITIES PRIOR TO CONSTRUCTION.
- THE WORKING DAYS PRIOR TO ANY EXCAVATION OR GRADING, THE CONTRACTOR SHALL LOCATE ALL UTILITIES AND SHALL BE RESPONSIBLE FOR THE LOCATION OF ALL UTILITIES PRIOR TO CONSTRUCTION.
- PRIOR TO CONSTRUCTION, THE CONTRACTOR SHALL LOCATE ALL UTILITIES AND SHALL BE RESPONSIBLE FOR THE LOCATION OF ALL UTILITIES PRIOR TO CONSTRUCTION.

THE FOLLOWING NOTES APPLY WHEN CHECKED

- ☐ ALL UTILITIES AND UTILITY SERVICE LINES SHALL BE LOCATED PRIOR TO CONSTRUCTION.
- ☐ EACH FULL CONSTRUCTION SHALL BE ACCORDING TO SPECIFIED STREET USE (RESIDENTIAL & ARTERIAL).
- ☐ PACE COAT REQUIREMENTS SHALL BE DETERMINED BY THE CITY ENGINEER.
- ☐ SIDEWALKS AND UNDERPASS RAMP WITHIN THE CURB RIGHT-OF-WAY SHALL BE CONSTRUCTED PRIOR TO CONSTRUCTION OF THE CURB AND GUTTER.
- ☐ IF CURB IS CONSTRUCTED FOR A DRIVEWAY, THE DRIVEWAY SHALL BE CONSTRUCTED PRIOR TO ACCEPTANCE OF THE CURB AND GUTTER.
- ☐ ALL STORM DRAINAGE FACILITIES SHALL BE COMPLETED PRIOR TO FINAL ACCEPTANCE.
- ☐ PAINT ALL NEW WATER VALVE BOX COVERS TOPS WITH BLUE PAINT OR BLUE STENCIL PAINT. THE COLOR BLUE SHALL BE EQUIVALENT TO "SAFETY BLUE".

NOTE: CITY PROJECT NO. 1451 INCLUDES WATER & SEWER WORK, WATER AND SEWER SERVICE LINE EXTENSIONS AND ASSOCIATED SUB-OUTS (SEE ESTIMATE QUANTITIES FOR BID ITEMS).


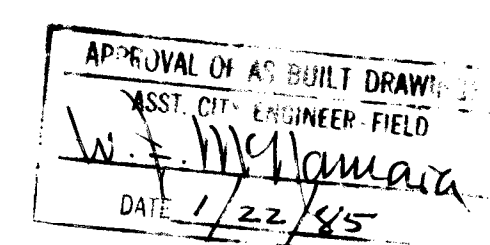


The undersigned does hereby certify that this drawing was revised in accordance with information furnished by J.R. Hale Contracting Company, Inc. (Contractor) and MSM/SP Group (Surveyor) to reflect the reported location of the work as actually accomplished.

Prepared under the supervision of:

Carol Hale
MSM/SP Group

10/11/83
Date

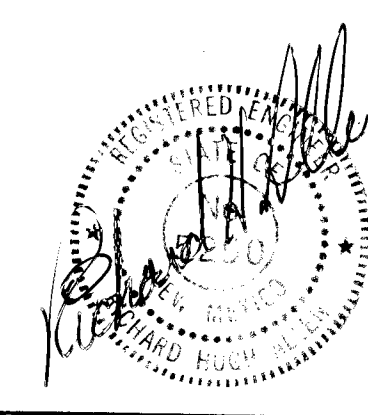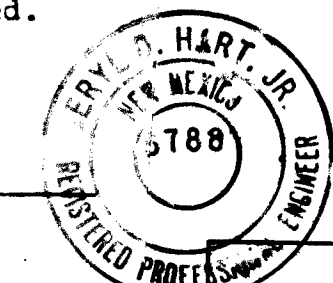

RECORD DRAWINGS

24.151 0185

APPROVED FOR
CONSTRUCTION*Robert J. Hale*
CITY ENGINEER
DATE 4/25/83

CITY OF ALBUQUERQUE MUNICIPAL DEVELOPMENT DEPARTMENT ENGINEERING DIVISION					
TITLE: EL PASEO (PHASE II)					
APPROVALS	ENGINEER	DATE	APPROVALS	ENGINEER	DATE
City Engineer	<i>Robert J. Hale</i>	11/13/82	Liquid Waste	<i>William J. H. A.</i>	10/7/82
ACE - Design	<i>Robert J. Hale</i>	12/14/82	Traffic	<i>William J. H. A.</i>	11/30/82
ACE - Hydrology	<i>Robert J. Hale</i>	10/14/82	Water	<i>William J. H. A.</i>	10/7/82
DRAWING NO. 1451			SHEET 1 OF 12		

SP-05-81-0847

83 4787i

1043

A

UNPLATTED


ACADEMY

RD.

NE.

N89°57'05"E

940.32'

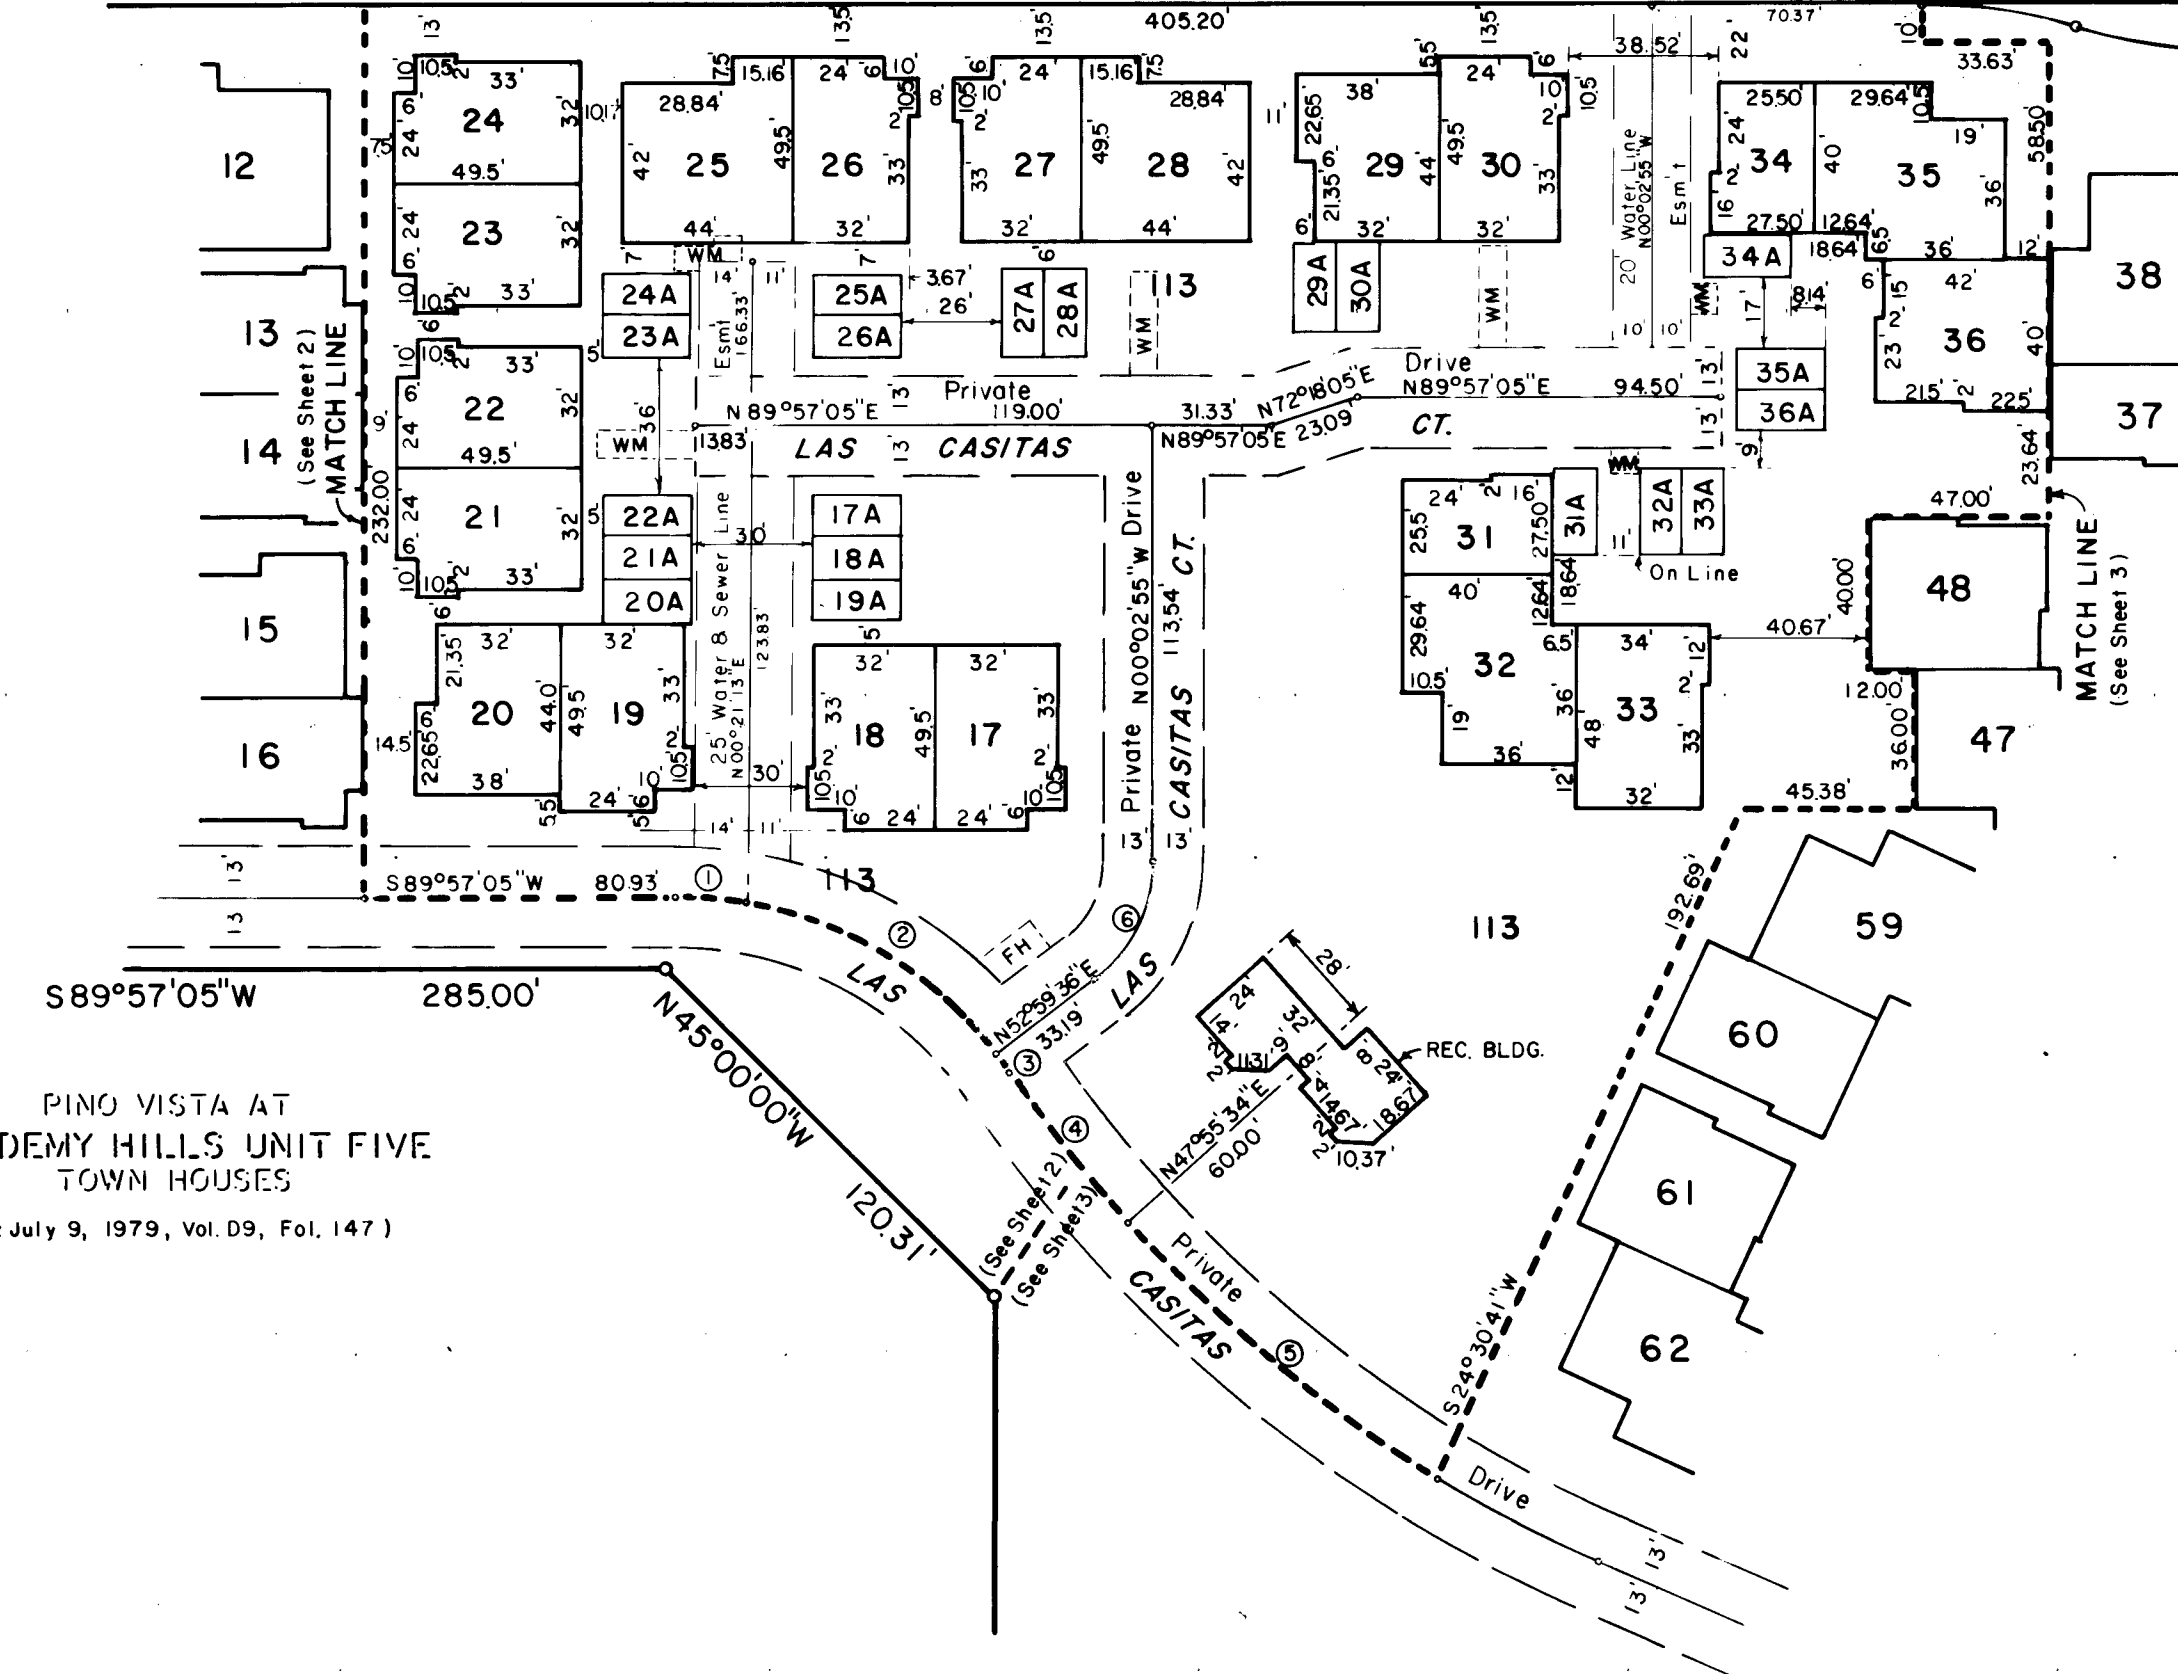

PINO VISTA AT
ACADEMY HILLS UNIT FIVE
TOWN HOUSES
(Filed: July 9, 1979, Vol. 09, Fol. 147)

CURVE DATA

	RADIUS	DELTA	ARC L.	CHORD BEARING	CHORD L.
1.	105.00'	10 deg. 43' 20"	19.65'	N. 84 deg. 41' 15" W.	19.62'
2.	105.00'	42 deg. 19' 11"	77.56'	N. 58 deg. 10' 00" W.	75.80'
3.	105.00'	02 deg. 57' 29"	5.42'	N. 35 deg. 31' 40" W.	5.42'
4.	355.00'	08 deg. 01' 31"	49.72'	N. 38 deg. 03' 41" W.	49.68'
5.	355.00'	16 deg. 46' 11"	103.91'	N. 50 deg. 27' 32" W.	103.53'
6.	38.00'	53 deg. 02' 31"	35.18'	N. 26 deg. 28' 21" E.	33.94'

Revised
Plat of
EL PASEO
Albuquerque, New Mexico
Sheet 5 of 5
HALL SURVEYING CO.
2625 Pennsylvania Ave. N.E., Suite 350
Albuquerque, New Mexico 87110
Phones: (505) 884-6200 & 884-6444


26 1451 0685

RECORD DRAWINGS

CITY OF ALBUQUERQUE
MUNICIPAL DEVELOPMENT DEPARTMENT
ENGINEERING DIVISION


TITLE:
EL PASEO - PHASE II
PLAT

DRAWING NO. 1451 MAP NO. E-21-N SHEET 6 OF 12

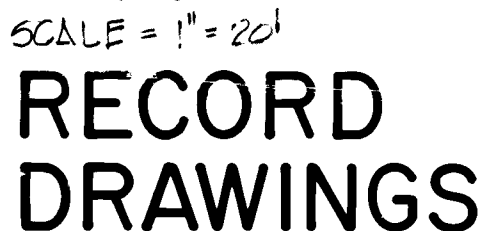

APPROVALS	ENGINEER	DATE	APPRO
City Engineer	<i>[Signature]</i>	1/12/82	Liquid Wa
A.C.E - Design	<i>[Signature]</i>	1/20/82	Traffic
A.C.E - Hydrology	<i>[Signature]</i>	1/20/82	Water
QA	<i>[Signature]</i>	4-25-83	
DRAWING NO.	1451	MAP NO. E 214	

ENGINEER'S SEAL	SURVEY INFORMATION			BENCH MARKS	AS BUILT INFORMATION
	NO.	BY	DATE		
	FIELD NOTES			B.M. LOCATED AT THE INTERSECTION OF P.W. LINES OF ACADEMY RD. (NORTH) AND CONCORDIA RD. (EAST). TOP OF BRASS CAP ELEV. = 55'4.50"	CONTRACTOR: J.R. HALF STARTED BY M.S./S.P. DATE 5/83 INSPECTORS FIELD BY M.S./S.P. DATE 5/83 CORRECTED BY M.S./S.P. DATE 7/83 VERIFICATION BY M.S./S.P. DATE 10/83
	NO.	DATE	BY		
REVISIONS			MICRO-FILM INFORMATION		
NO.	DATE	REMARKS	RECORDED BY DATE		
DESIGN			NO.		
DESIGNED BY DESIGN PROFESSIONALS INC. DATE MARCH 10, 1982			B.M. LOCATED 49'30" SOUTH OF THE SE CORNER LOT 28, UNIT 4, ACADEMY HILLS SUBD. TOP OF BRASS CAP ELEV. = 53'00.42.		
DRAWN BY J. S. DATE					
CHECKED BY B. A. DATE					
RECORDED BY DATE					
NO.					

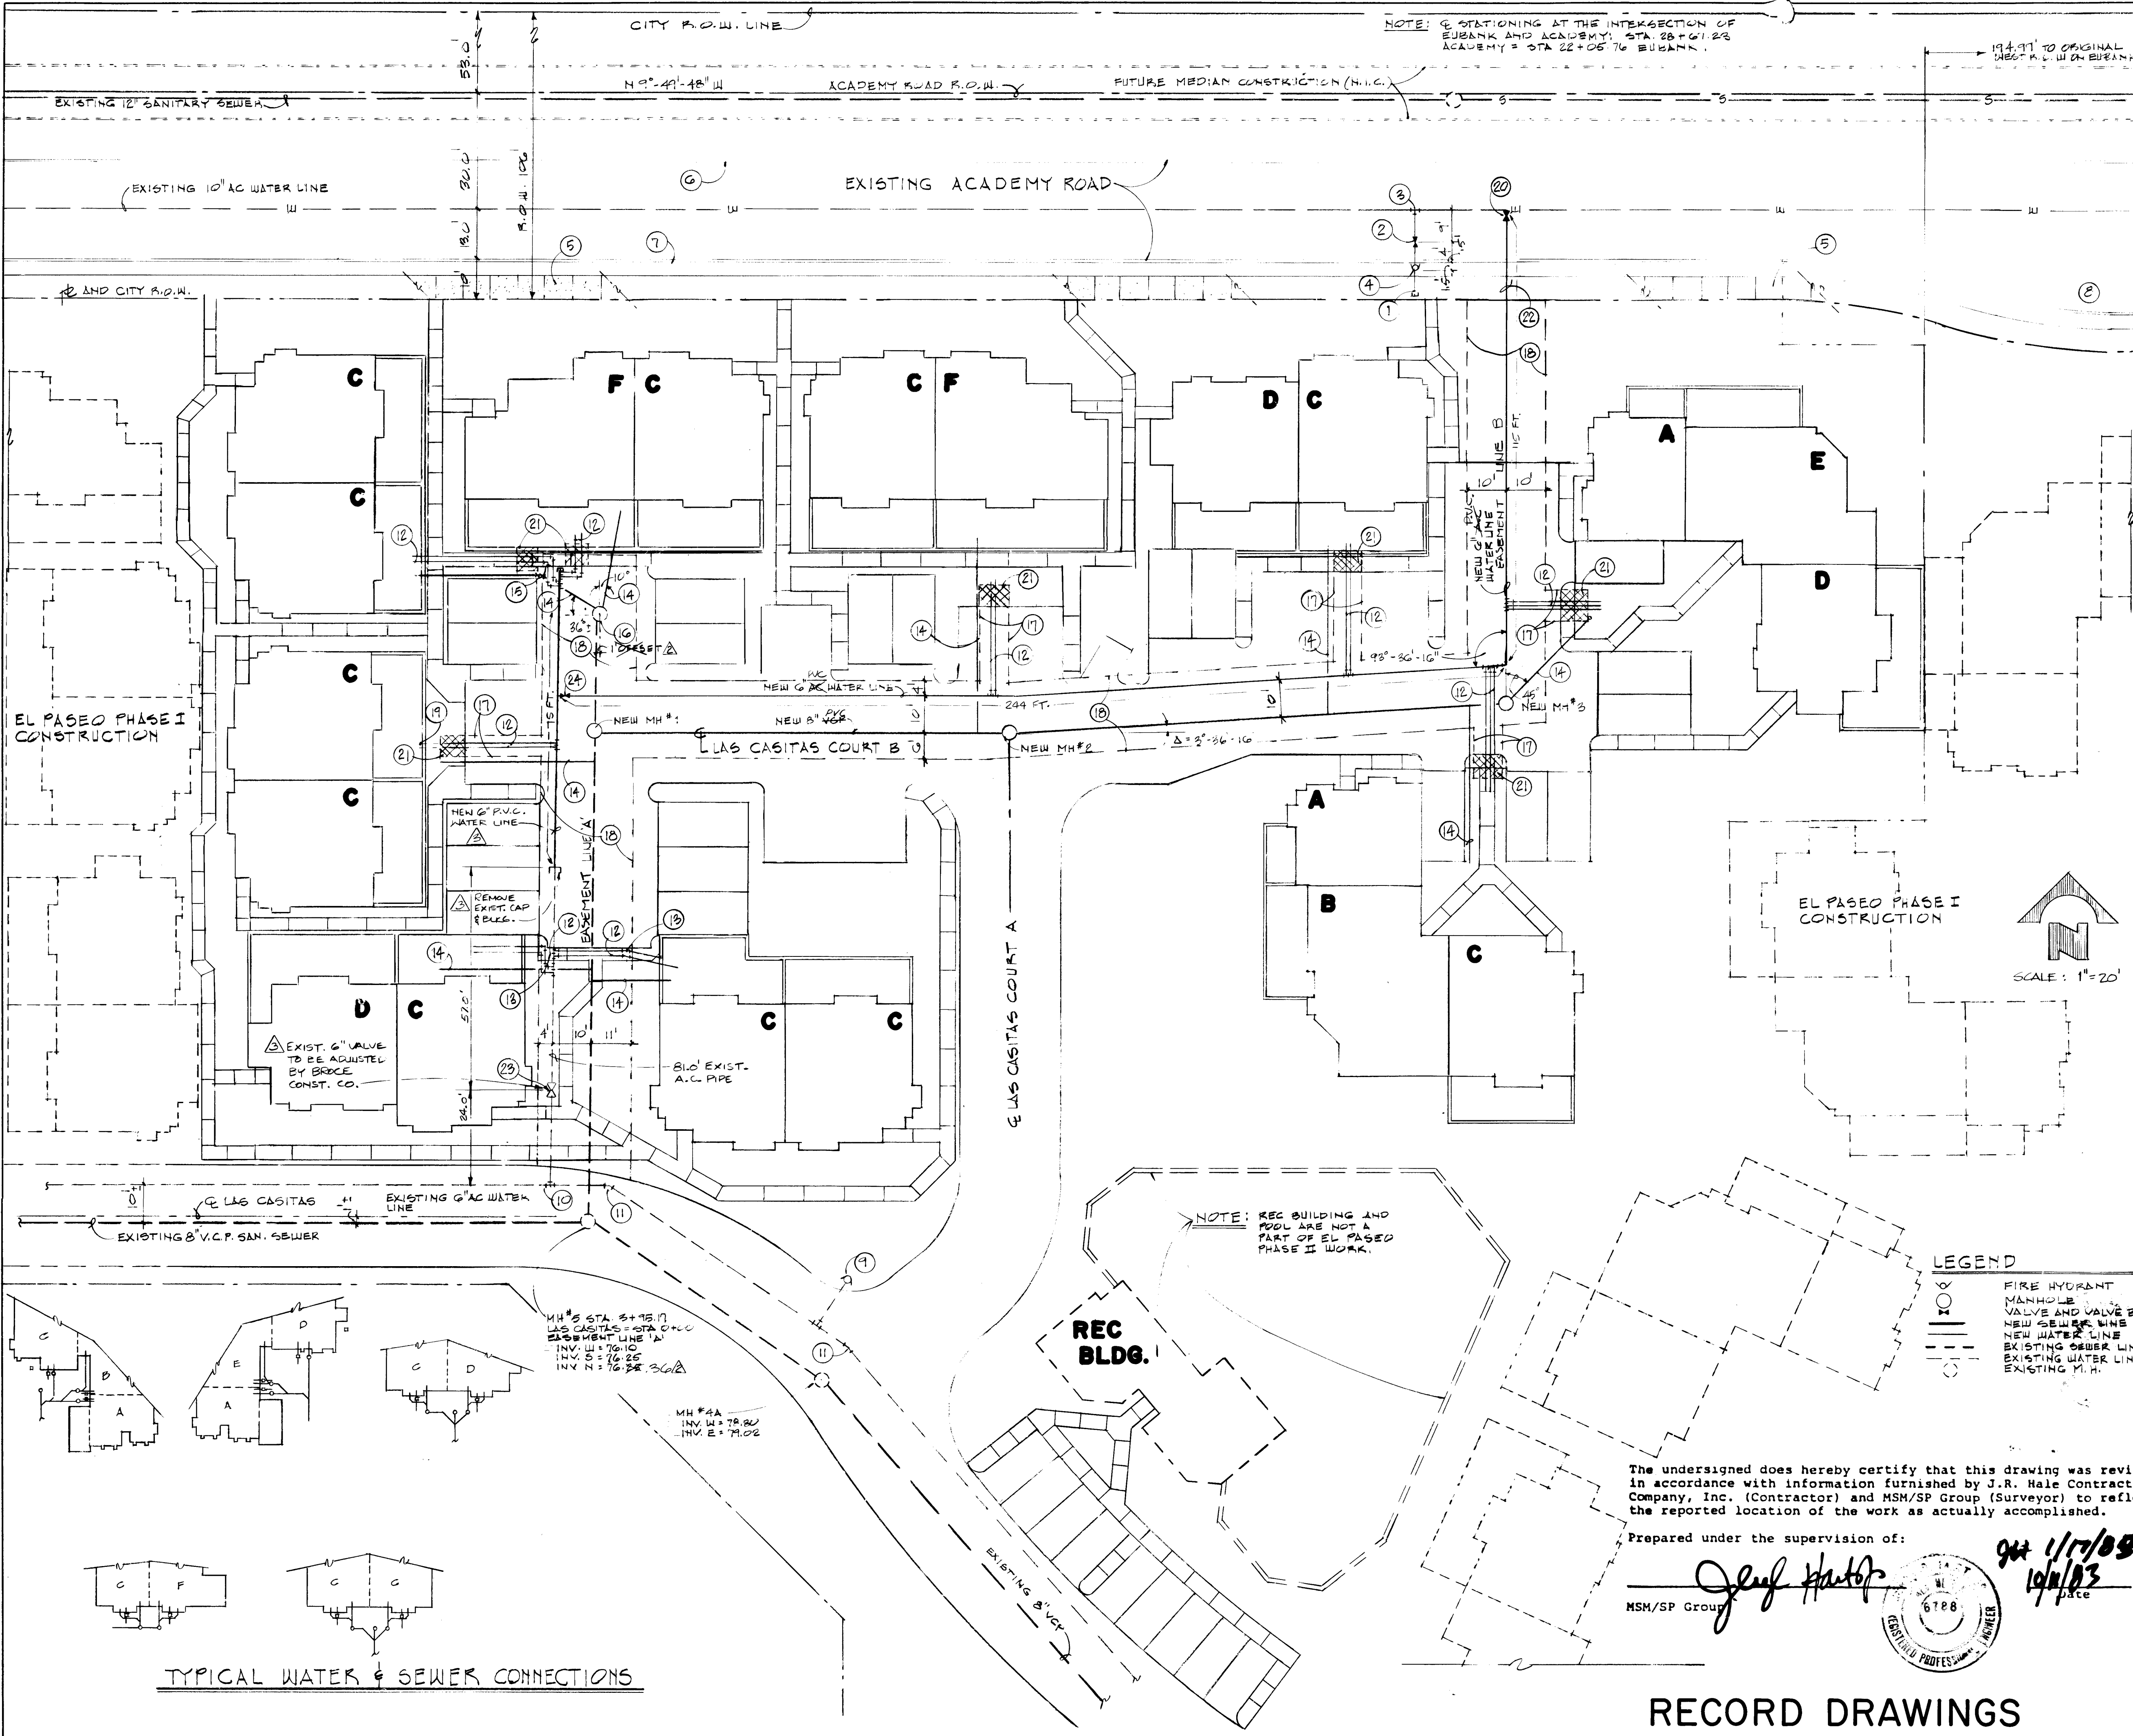

KEYED NOTES

- REMOVE EXISTING CAP AND EXCESS 8" WATER LINE. INSTALL NEW 8" x 6" REDUCER FOR NEW FIRE HYDRANT.
- EXISTING 8" VALVE AND TYPE "A" VALVE BOX.
- STA. 24+65.33 ACADEMY - EXISTING 10" x 8" TEE AND 8" D.I. STUB CUT.
- STA. 24+65.33 ACADEMY - FURNISH AND INSTALL NEW FIRE HYDRANT AND BLOCKING PER CITY STD. DETAILS. FLANGE ELEV. = 5702.6.
- EXISTING 6" WIDE CONCRETE SIDEWALK.
- EXISTING ASPHALT CURB.
- EXISTING CONCRETE CURB & GUTTER.
- EXISTING RIGHT HAND TURN LANE.
- EXISTING FIRE HYDRANT, STA. 5+01 LAS CASITAS.
- EXISTING 6" x 6" G TEE, STA. 5+71.6 LAS CASITAS.
- EXISTING BEND.
- NEW 3/4" WATER STUBS. SEE PLAN AND PROFILE SHEETS FOR LOCATION AND LENGTH. (POLYETHYLENE CLASS 100).
- SET WATER METERS IN SIDEWALK WITHIN LIMITS OF BASEMENT. TOTAL OF 2 METERS REQUIRED AT THIS LOCATION.
- 4" C.I. SEWER LINE. SEE PLAN AND PROFILE SHEETS FOR LOCATION, LENGTH AND INVERT ELEVATION.
- FURNISH AND INSTALL CLEANOUT AT BEND.
- EXISTING MH NO. 17, STA. 1+52.9 INV. 5 = 5631.10. RAISE MH TO MATCH NEW TOP OF PAVEMENT ELEV. 5110.2.
- WATER BASEMENT FOR CITY OF ALBUQUERQUE. SEE PLAN FOR DESCRIPTION. 24" WIDE CITY OF ALBUQUERQUE UTILITY BASEMENT.
- VERTICAL DROP IN WATER SERVICE LINE ON BUILDING SIDE OF WATER METER. PRESSURE CONNECTION WITH WRAPPING SLEEVE, VALVE AND TYPE "A" VALVE BOX.
- WATER METER BASEMENT. SEE SHEET "D" FOR DIMENSIONS.
- NEW 6" A.C. WATER LINE (CLASS 200) OF BASEMENT LINE "B". (CLASS 200) 22'.
- EXISTING VALVE, STA. 0+28.42 BASEMENT LINE "A".
- FURNISH & INSTALL 6" x 6" G TEE W/ TYPE "A" VALVE. VALVE BOX & STANDARD BLOCKING, STA. 1+32 BASEMENT LINE "A".

NOTES:

- ANODES WERE INSTALLED AT ALL WATER LINE FITTINGS.
- ALL 6" A.C. WATER LINE JOINTS ARE STANDARD SLIP-ON CONNECTIONS 4' 13' LENGTHS.

GENERAL NOTES:

- ALL WORK SHALL BE IN ACCORDANCE WITH THE NEW MEXICO STANDARD SPECIFICATIONS FOR PUBLIC WORKS CONSTRUCTION 1979 EDITION AND SHALL MEET ALL STANDARDS FOR WATER AND SEWER SYSTEM CONSTRUCTION OF THE CITY OF ALBUQUERQUE. SEE ALSO CONTRACT SPECIFICATIONS FOR CITY-WIDE UTILITIES AND CASHING. NOT TO CURRENT EDITION.
- CONTRACTOR FOR THIS WORK SHALL BE LICENSED AND QUALIFIED TO INSTALL WATER AND SEWER SYSTEMS FOR THE CITY OF ALBUQUERQUE. ALL UTILITIES SHALL BE OWNED AND MAINTAINED BY THE CITY OF ALBUQUERQUE. AS-BUILTS SHALL BE MAINTAINED AND TURNED TO THE CITY FOR APPROVAL PRIOR TO FINAL INSPECTION AND ACCEPTANCE BY THE CITY. A RECORD PLAT OF ALL EXHAUSTS WILL BE FILED BY THE OWNER AFTER AS-BUILDS OF ALL UTILITIES ARE COMPLETED.
- CONTRACTOR SHALL PROVIDE ALL MATERIALS AND INSTALLATION FOR THE WATER AND SEWER SYSTEM COMPONENTS: 6" CONNECTIONS, VALVES, THURST BLOCKS, MANHOLES, FIRE HYDRANTS ETC. IN ACCORDANCE WITH STANDARD CITY OF ALBUQUERQUE DRAWINGS AND CRITERIA. UNLESS A SPECIFIC DETAIL IS SHOWN.

NOTE: CITY PROJECT NO. 1451 INCLUDES WATER & SEWER WORK, WATER & SEWER SERVICE LINE EXTENSION & ASSOCIATED STUB OUTS. (SEE ESTIMATE QUANTITIES FOR BID ITEMS).

24 1451 0885

CITY OF ALBUQUERQUE
MUNICIPAL DEVELOPMENT DEPARTMENT
ENGINEERING DIVISION

TITLE: EL PASEO - PHASE II
COMPOSITE UTILITY PLAN

APPROVALS	ENGINEER	DATE	APPROVALS	ENGINEER	DATE
City Engineer	RSMA	12/11/03	Liquid Waste	N.A. JAMES	10/7/02
A.C.E. Design	NA BSB	12/11/03	Traffic	N.A. JAMES	10/7/02
A.C.E. - Hydrology	NA BSB	12/11/03	Water	N.A. JAMES	10/7/02
QA	AROLAN	4-25-03			

DRAWING NO.	MAP NO.	SHEET	OF
1451	E 21N	8	12

The undersigned does hereby certify that this drawing was revised in accordance with information furnished by J.R. Hale Contracting Company, Inc. (Contractor) and MSM/SP Group (Surveyor) to reflect the reported location of the work as actually accomplished.

Prepared under the supervision of:

Jeff Hator
MSM/SP Group


94 1/7/05
10/1/03

6788
REGISTERED PROFESSIONAL ENGINEER

RECORD DRAWINGS

RETAINING WALL ARE NOTED
THUS: ~~SEE ELEVATIONS~~
SEE SITE PLAN FOR TOP OF
WALL (T.W.) AND BOTTOM
OF WALL ELEVATIONS

SEE SITE UTILITY PLAN & PLAT
FOR EASEMENT LIMITS
BEYOND FACE OF CURB

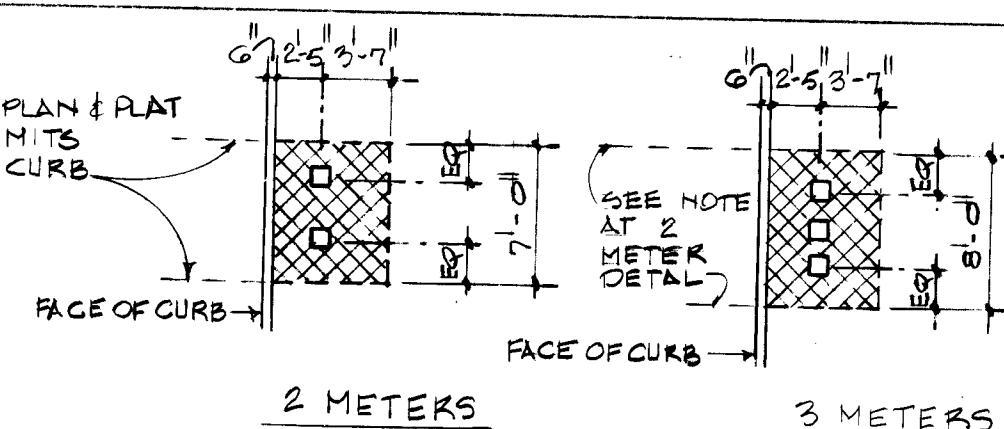

WATER METER BOX EASEMENTS

STATIONING AT THE
INTERSECTION OF ELIBANK &
ACADEMY: STA 28+67.23
ACADEMY = STA 22+05.76
ELIBANK.

GENERAL NOTES

1. TYPE 'E' MANHOLE MAY BE SUBSTITUTED FOR TYPE 'C' MANHOLE WHERE DEPTH IS GREATER THAN 10'. ALL MANHOLES SHALL BE 24 INCH DIAMETER (PRECAST).
2. ALL TEES, BENDS, CAPS ETC. SHALL BE BLOCKED IN ACCORDANCE WITH CITY OF ALBUQUERQUE STANDARD DETAILS.
3.  DENOTES WATER METER FLAG - SEE DETAILS ON THIS SHEET FOR DIMENSIONS, WATER METERS, BOXES, SERVICES, ETC. SHALL BE INSTALLED PER CITY STANDARD DETAILS.
4. WATER METER BOXES SHALL BE INSTALLED BEHIND CURBS FOR ALL SERVICE LINES.

NOTE: CITY PROJECT NO. 451 INCLUDES WATER & SEWER WORK, WATER & SEWER SERVICE LINE EXTENSIONS & ASSOCIATED STUB OUTS. (SEE ESTIMATE QUANTITIES FOR BID ITEMS)

2. ALL SANITARY SEWER SERVICES ARE CAST IRON PIPE

AS BUILT	INFORMATION
NRA IN JK HALE	
DATE BY MSM/SF	CIRCUIT DATE 5/83
DATE BY MSM/SF	CORRECTION DATE 6/83
DATE BY MSM/SF	DATE 7/83
DATE BY MSM/SF	DATE 10/83
MICRO-FILM	INFORMATION
CORPED BY	DATE

BENCH	MARKS	REMARKS
B-1	BM: LOCATED AT THE INTERSECTION OF R/W LINES OF ACADEMY RD (NORTH) AND CONCORDIA RD (EAST). TOP OF BRASS CAP ELEV. = 6578.55.	REMARKS
B-2	BM: LOCATED 471.3' SOUTH OF THE SE CORNER, LOT 2A, UNIT 4, ACADEMY HILLS SUBDIV. TOP OF BRASS CAP ELEV. = 6560.42.	REMARKS

[illegible][illegible]

Professional Engineer Seal for the State of New York, No. 5290, signed by William J. O'Connell.

[illegible]

KM	16.1.	R.H.A	BY
30, 1982			

APRIL
E
E

COMMENTS	DATE
MARKS	DATE
WS	DATE
AGE IN DATE	DATE
DATE	DATE
DATE	DATE

LTS
LTS
VIEW C
REM
E VISION
DE SIGN
O F E S I O N

AS EUI
AS BUI
CITY RE
R
SIGN PR
H. A. JEN

1-9-85	DATE
10-3-83	
6-18-82	

DESIGN	NO.	1	2	3
DRAWN				
CHECKED				

DE
ARTMENT
ON

PLAN AND PROFILE

S	ENGINEER	DATE
	James E. Miller	10/7/82
	N. A. [Signature]	

James Topmiller	10/7/82
SHEET	OF

9	12
---	----

The undersigned does hereby certify that this drawing was revised in accordance with information furnished by J.R. Hale Contracting Company, Inc. (Contractor) and MSM/SP Group (Surveyor) to reflect the reported location of the work as actually accomplished.

Prepared under the supervision of:

MSM/SP Group

1/17/05
10/1/03
late

RECORD DRAWINGS

TITLE: EL PASEO - PHASE II
EASEMENT LINE & UTILITY PLAN AND PROFILE


APPROVALS	ENGINEER	DATE	APPROVALS	ENGINEER	DATE
-----------	----------	------	-----------	----------	------

City Engineer	<i>Kelch</i>	<i>11/11/82</i>	Liquid Waste	<i>James J. Miller</i>	<i>10/7/82</i>
A C E - Design Co.	<i>Kelch</i>	<i>12 Nov 82</i>	Traffic	<i>N. A. B. 82</i>	

ACE - Hydrology	NA B05	10/6/82	Water	James Spiller	10/7/82
QA	ARO/Kan	4-25-83			
















DRAWING NO.	1451	MAP NO. E 21 N	SHEET 9	OF 12
----------------	------	-------------------	------------	----------

[illegible]

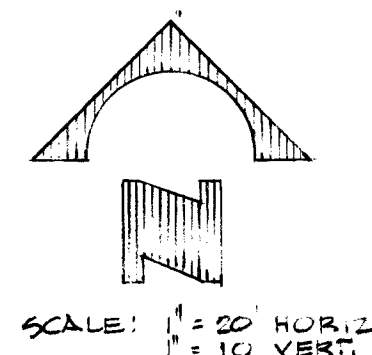

1/17/85 gm
10/11/83
Date

GENERAL NOTES		AS BUILT INFORMATION		BENCH MARKS		SURVEY INFORMATION		ENGINEER'S SEAL		REVISIONS		DESIGN	
1. TYPE 'E' MANHOLE MAY BE SUBSTITUTED FOR TYPE 'C' MANHOLE WHERE DEPTH IS GREATER THAN 10'. ALL MANHOLES SHALL BE 4' INSIDE DIAMETER (PRECAST). 2. ALL TEES, BENDS, CAPS ETC. SHALL BE BLOCKED IN ACCORDANCE WITH CITY OF ALBUQUERQUE STANDARD DETAILS. 3. PENOTES WATER METER EASEMENT. SEE DETAILS ON SHEET 9 FOR DIMENSIONS. WATER METERS, BOXES, SERVICES ETC. SHALL BE INSTALLED PER CITY STANDARD DETAILS. 4. WATER METER BOXES SHALL BE INSTALLED BEHIND CURBS FOR ALL SERVICE LINES. 5. Δ = DEFLECTION ANGLE FOR SEWER LINES AT M.N.		1. 1/4" = 1' HORIZONTAL 2. 1/4" = 1' VERTICAL 3. 1/4" = 1' HORIZONTAL 4. 1/4" = 1' VERTICAL 5. 1/4" = 1' HORIZONTAL 6. 1/4" = 1' VERTICAL 7. 1/4" = 1' HORIZONTAL 8. 1/4" = 1' VERTICAL 9. 1/4" = 1' HORIZONTAL 10. 1/4" = 1' VERTICAL 11. 1/4" = 1' HORIZONTAL 12. 1/4" = 1' VERTICAL 13. 1/4" = 1' HORIZONTAL 14. 1/4" = 1' VERTICAL 15. 1/4" = 1' HORIZONTAL 16. 1/4" = 1' VERTICAL 17. 1/4" = 1' HORIZONTAL 18. 1/4" = 1' VERTICAL 19. 1/4" = 1' HORIZONTAL 20. 1/4" = 1' VERTICAL 21. 1/4" = 1' HORIZONTAL 22. 1/4" = 1' VERTICAL 23. 1/4" = 1' HORIZONTAL 24. 1/4" = 1' VERTICAL 25. 1/4" = 1' HORIZONTAL 26. 1/4" = 1' VERTICAL 27. 1/4" = 1' HORIZONTAL 28. 1/4" = 1' VERTICAL 29. 1/4" = 1' HORIZONTAL 30. 1/4" = 1' VERTICAL 31. 1/4" = 1' HORIZONTAL 32. 1/4" = 1' VERTICAL 33. 1/4" = 1' HORIZONTAL 34. 1/4" = 1' VERTICAL 35. 1/4" = 1' HORIZONTAL 36. 1/4" = 1' VERTICAL 37. 1/4" = 1' HORIZONTAL 38. 1/4" = 1' VERTICAL 39. 1/4" = 1' HORIZONTAL 40. = 1' HORIZONTAL 172. 1/4" = 1' VERTICAL 173. 1/4" = 1' HORIZONTAL 174. 1/4" = 1' VERTICAL 175. 1/4" = 1' HORIZONTAL 176. 1/4" = 1' VERTICAL 177. 1/4" = 1' HORIZONTAL 178. 1/4" = 1' VERTICAL 179. 1/4" = 1' HORIZONTAL 180. 1/4" = 1' VERTICAL 181. 1/4" = 1' HORIZONTAL 182. 1/4" = 1' VERTICAL 183. 1/4" = 1' HORIZONTAL 184. 1/4" = 1' VERTICAL 185. 1/4" = 1' HORIZONTAL 186. 1/4" = 1' VERTICAL 187. 1/4" = 1' HORIZONTAL 188. 1/4" = 1' VERTICAL 189. 1/4" = 1											

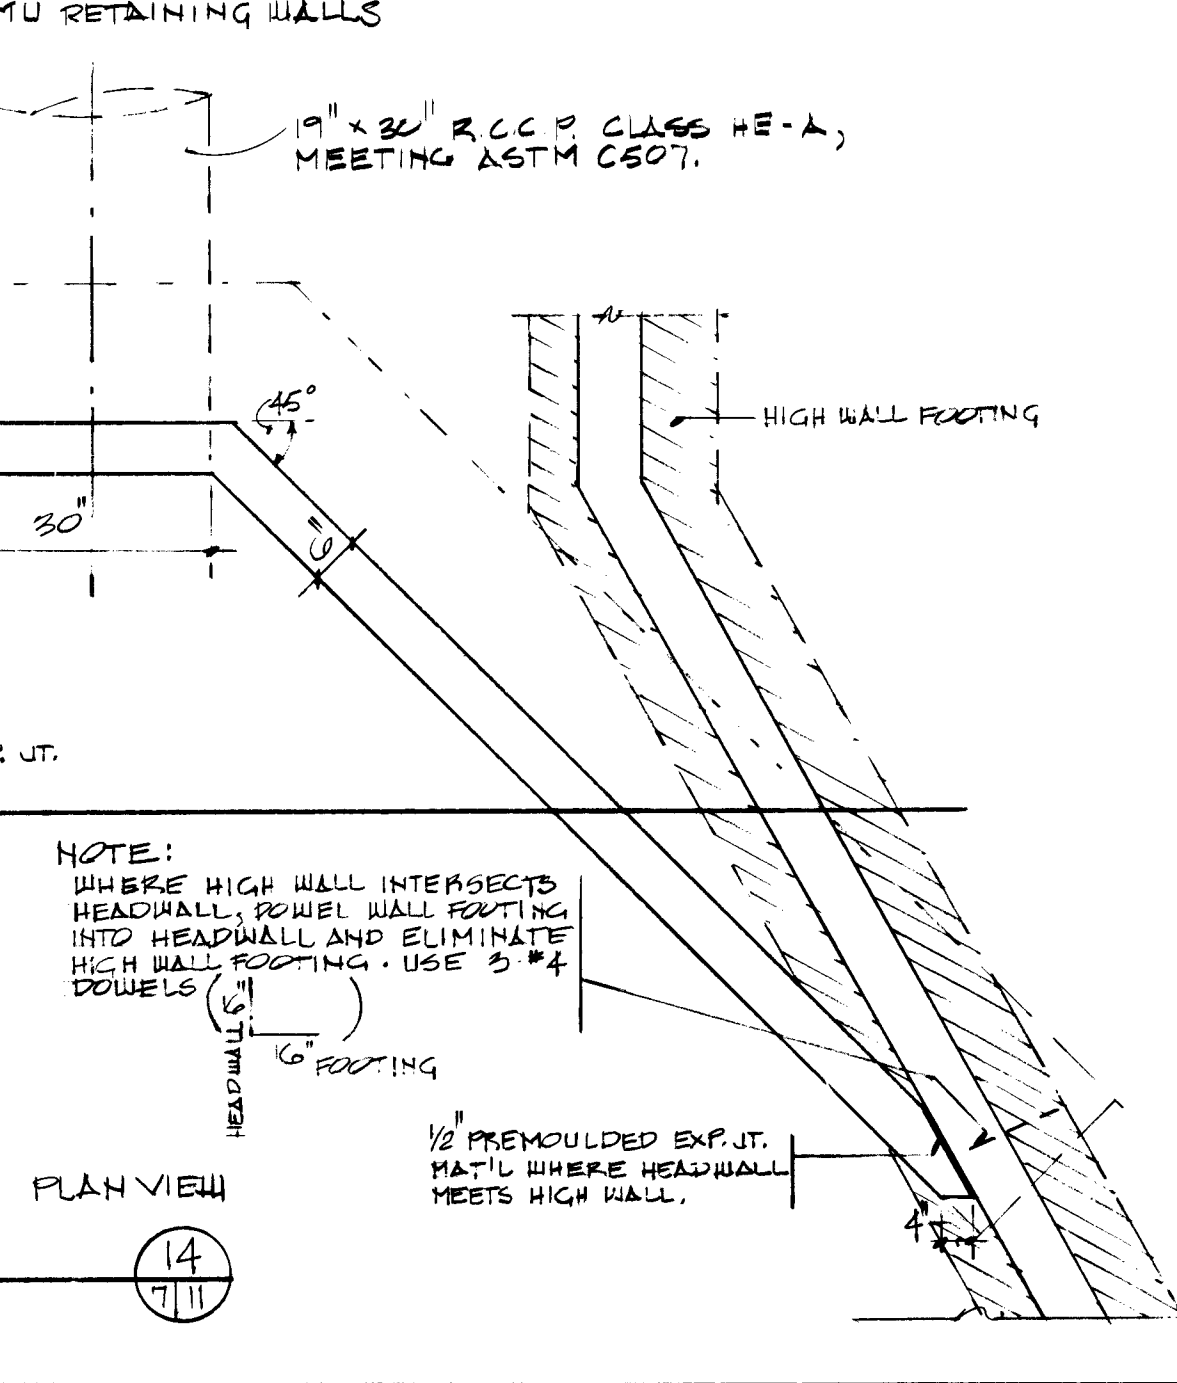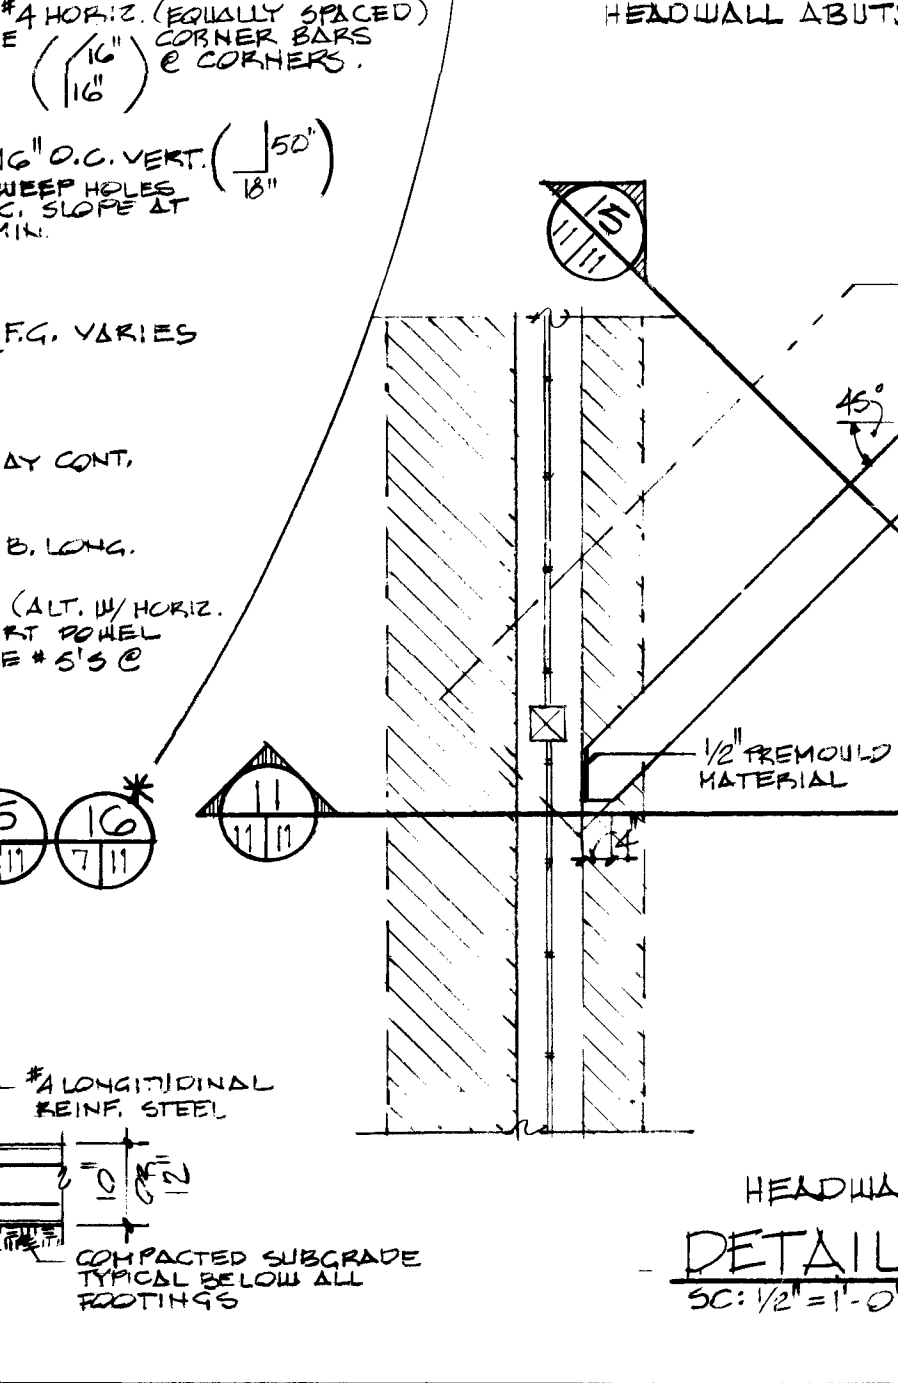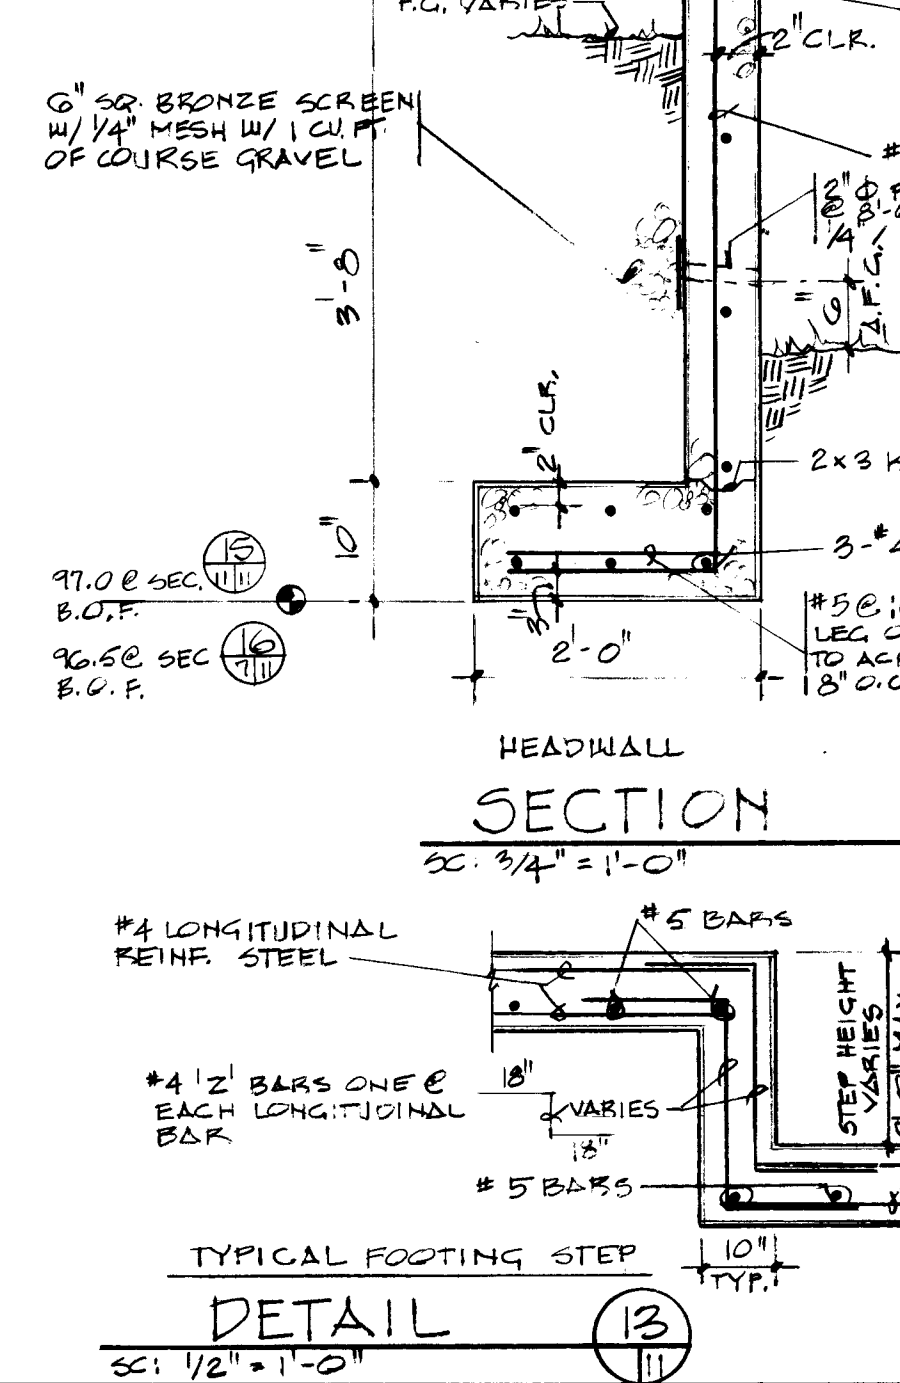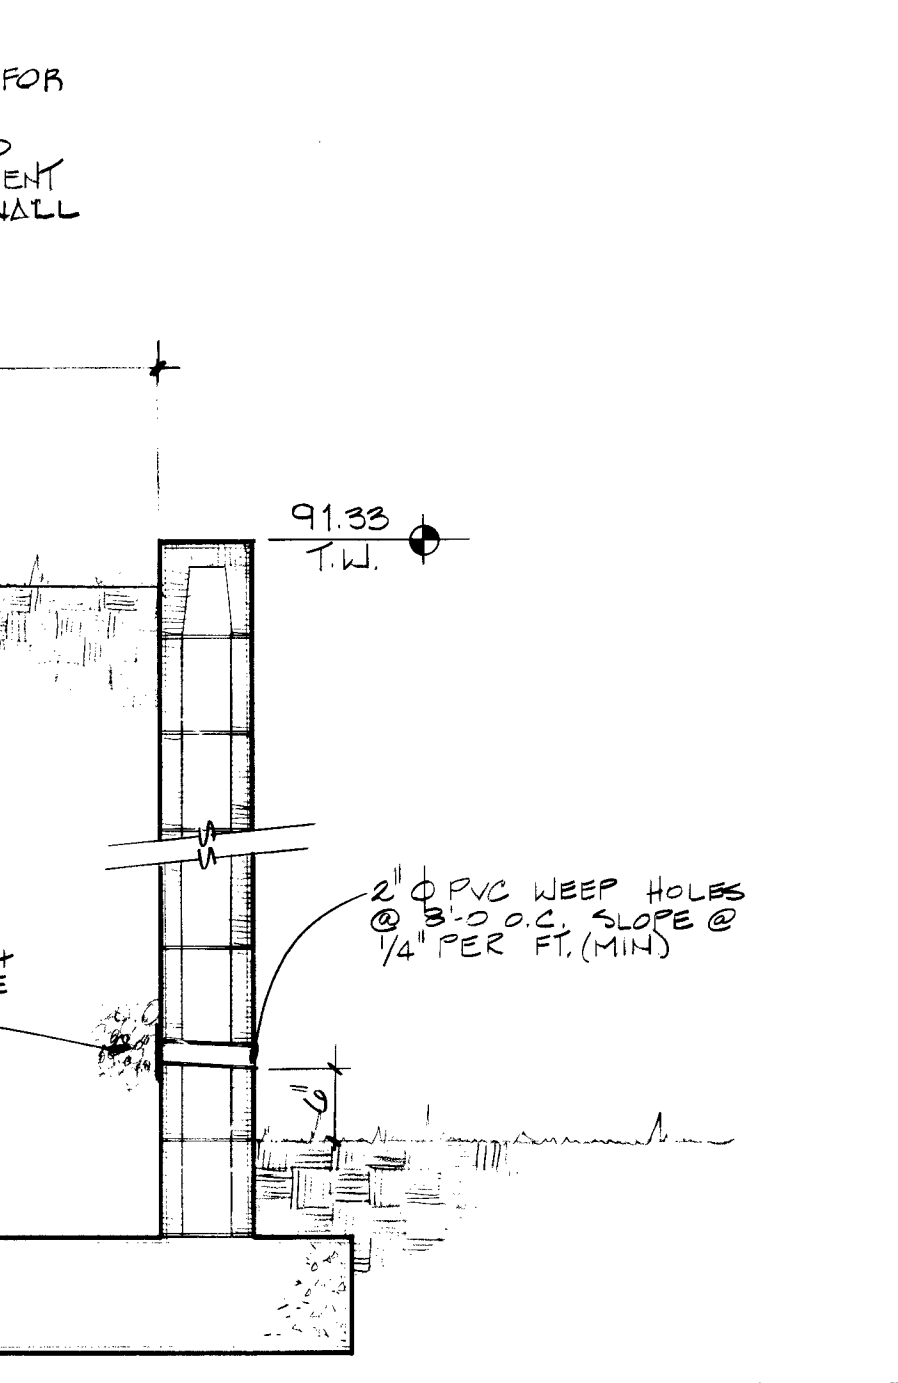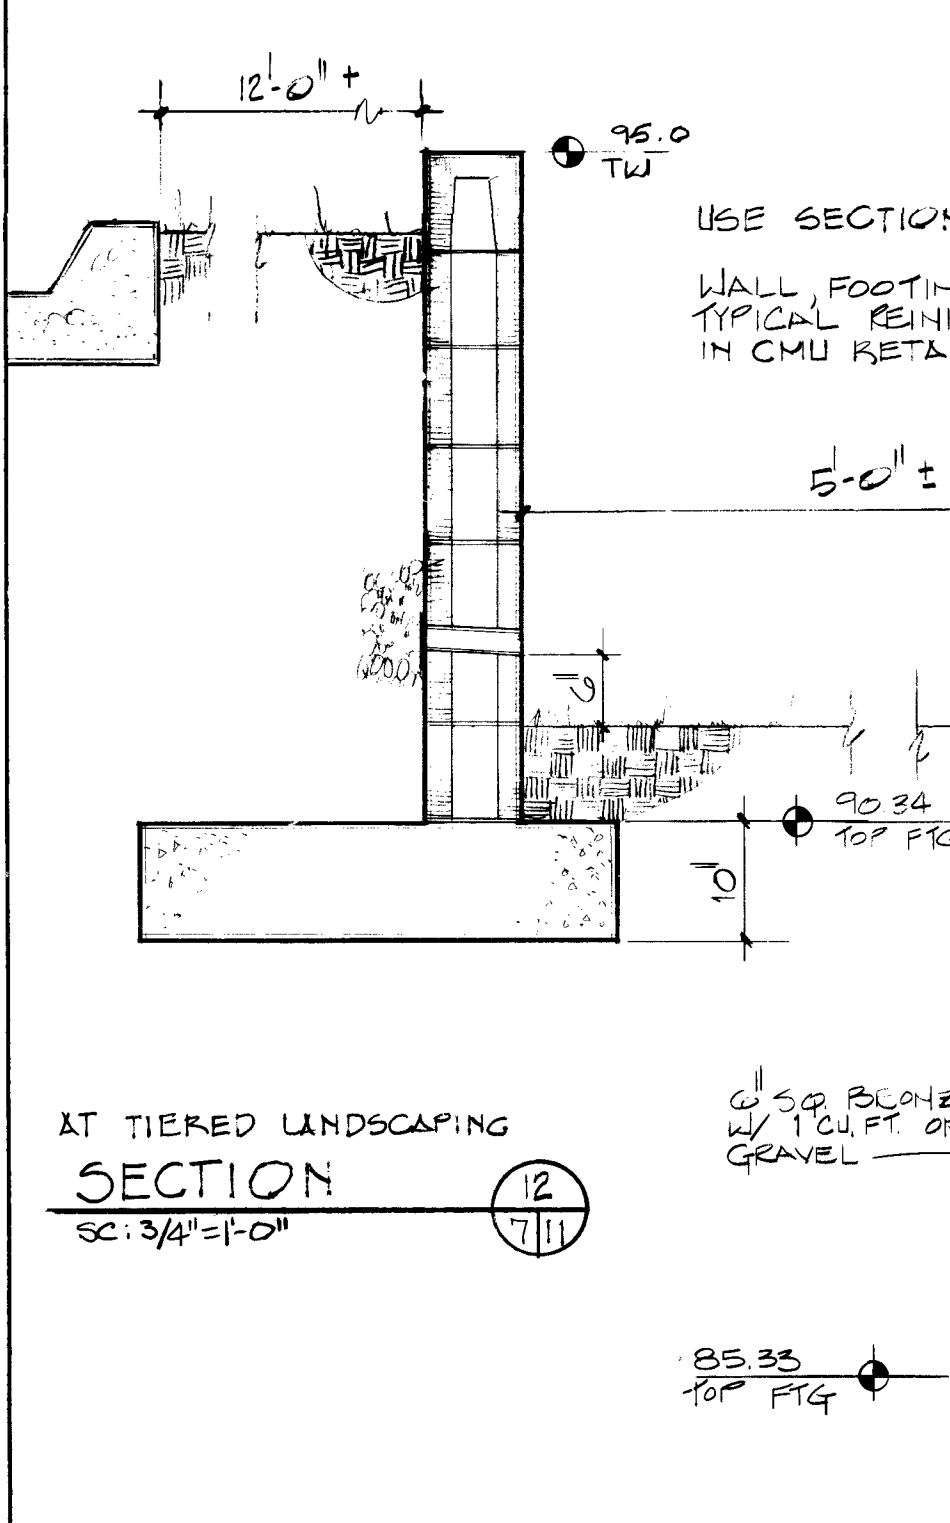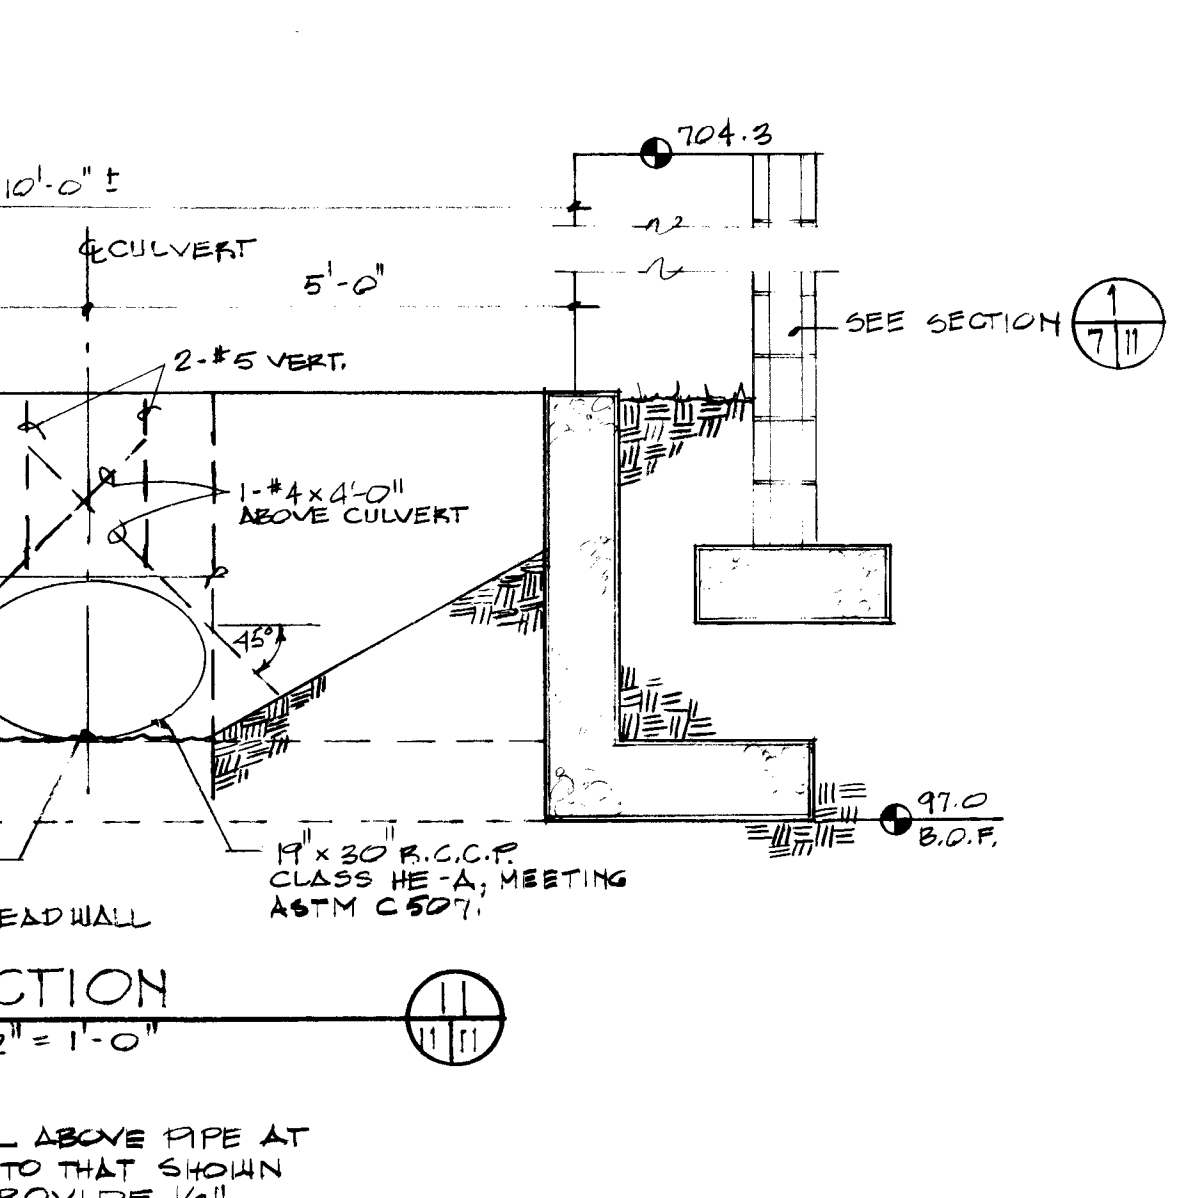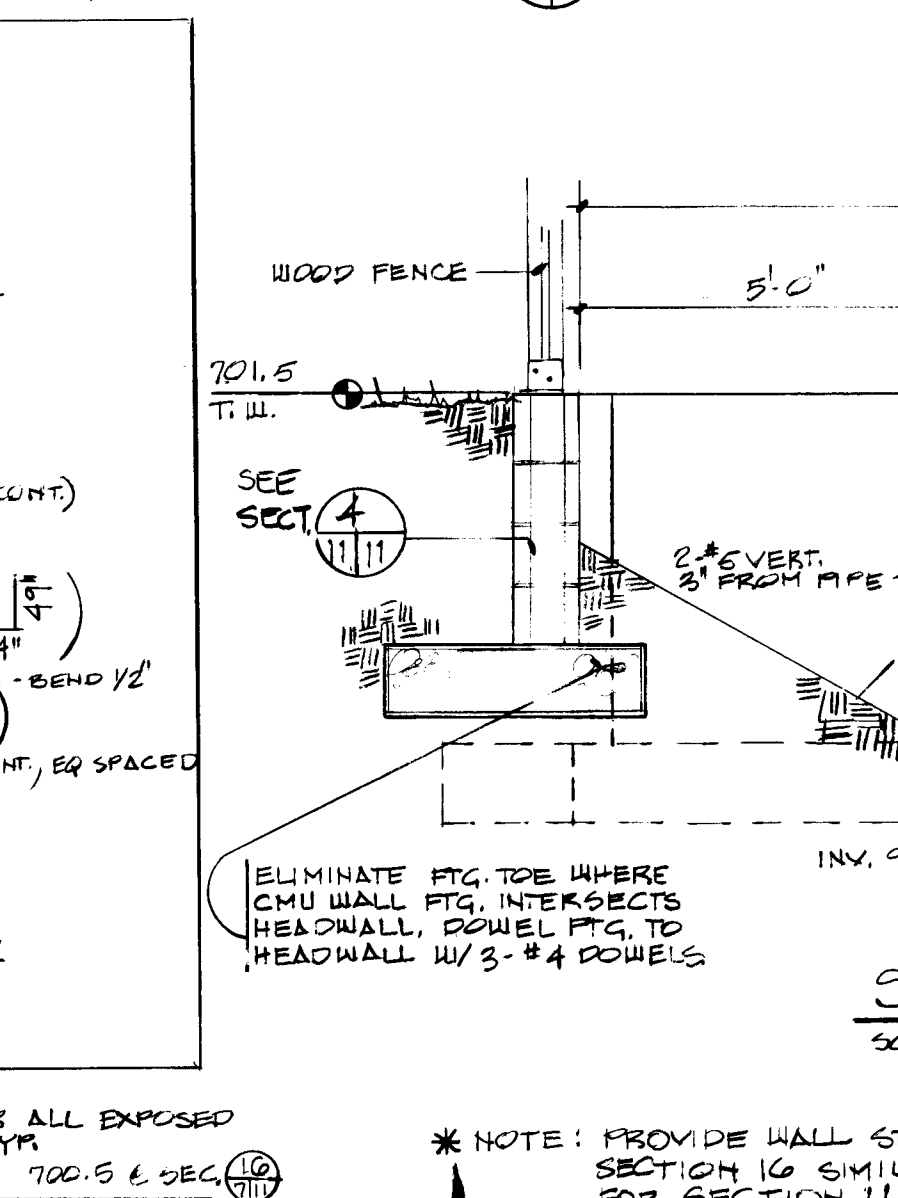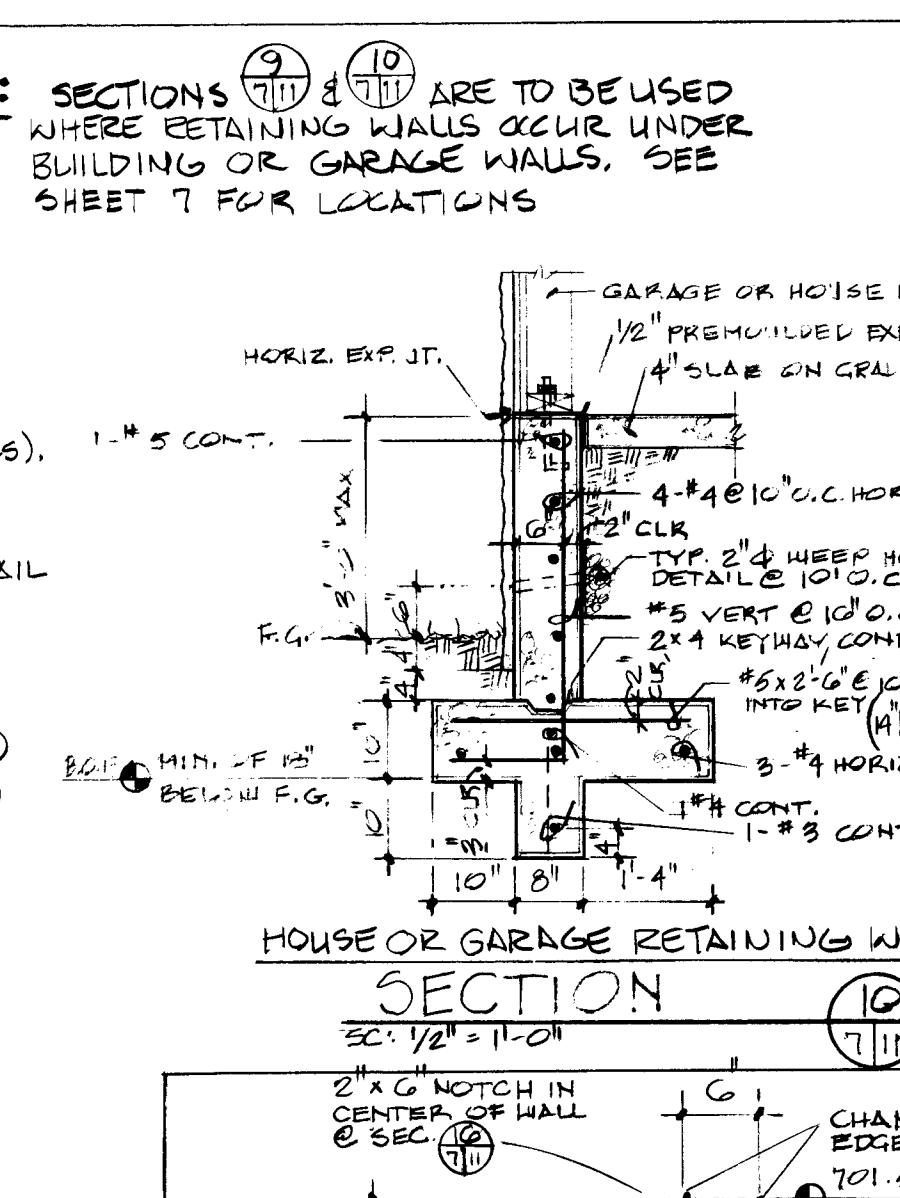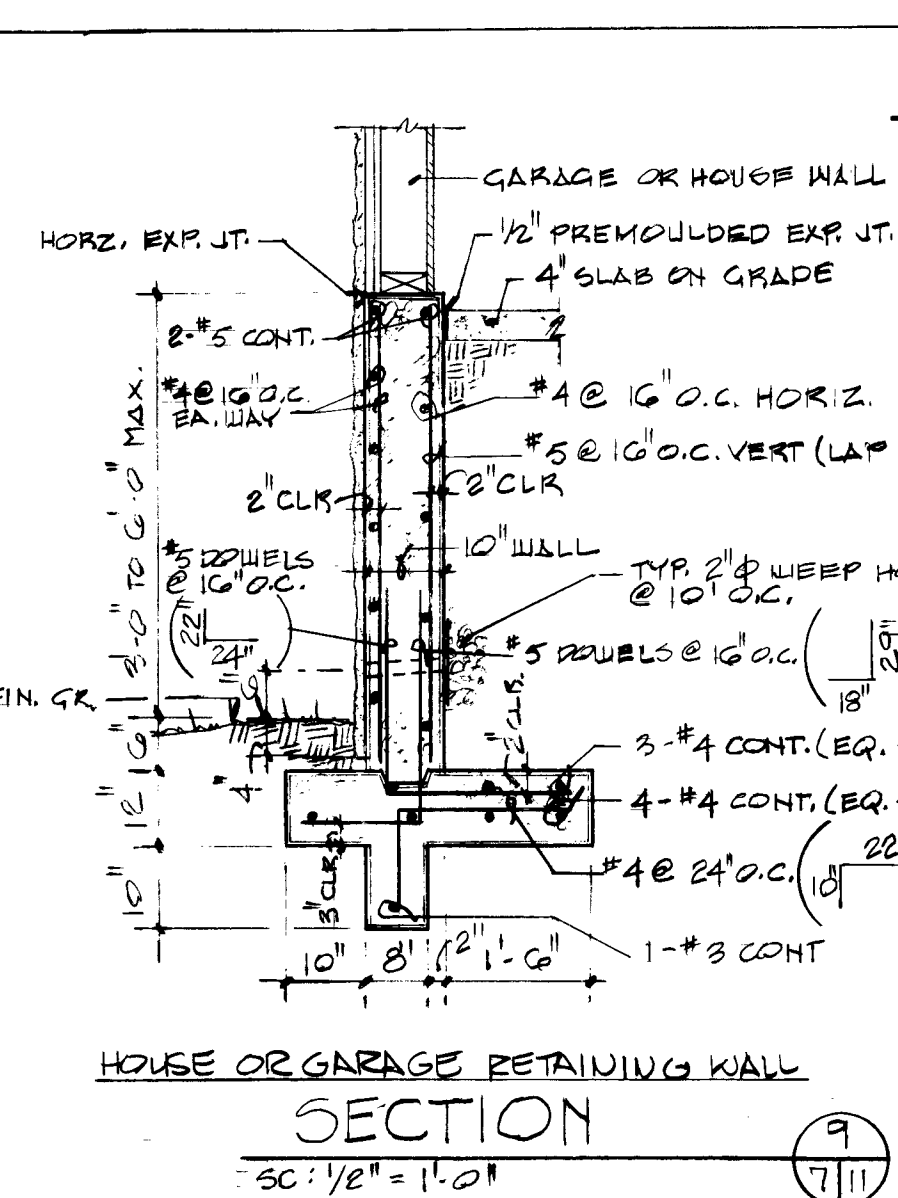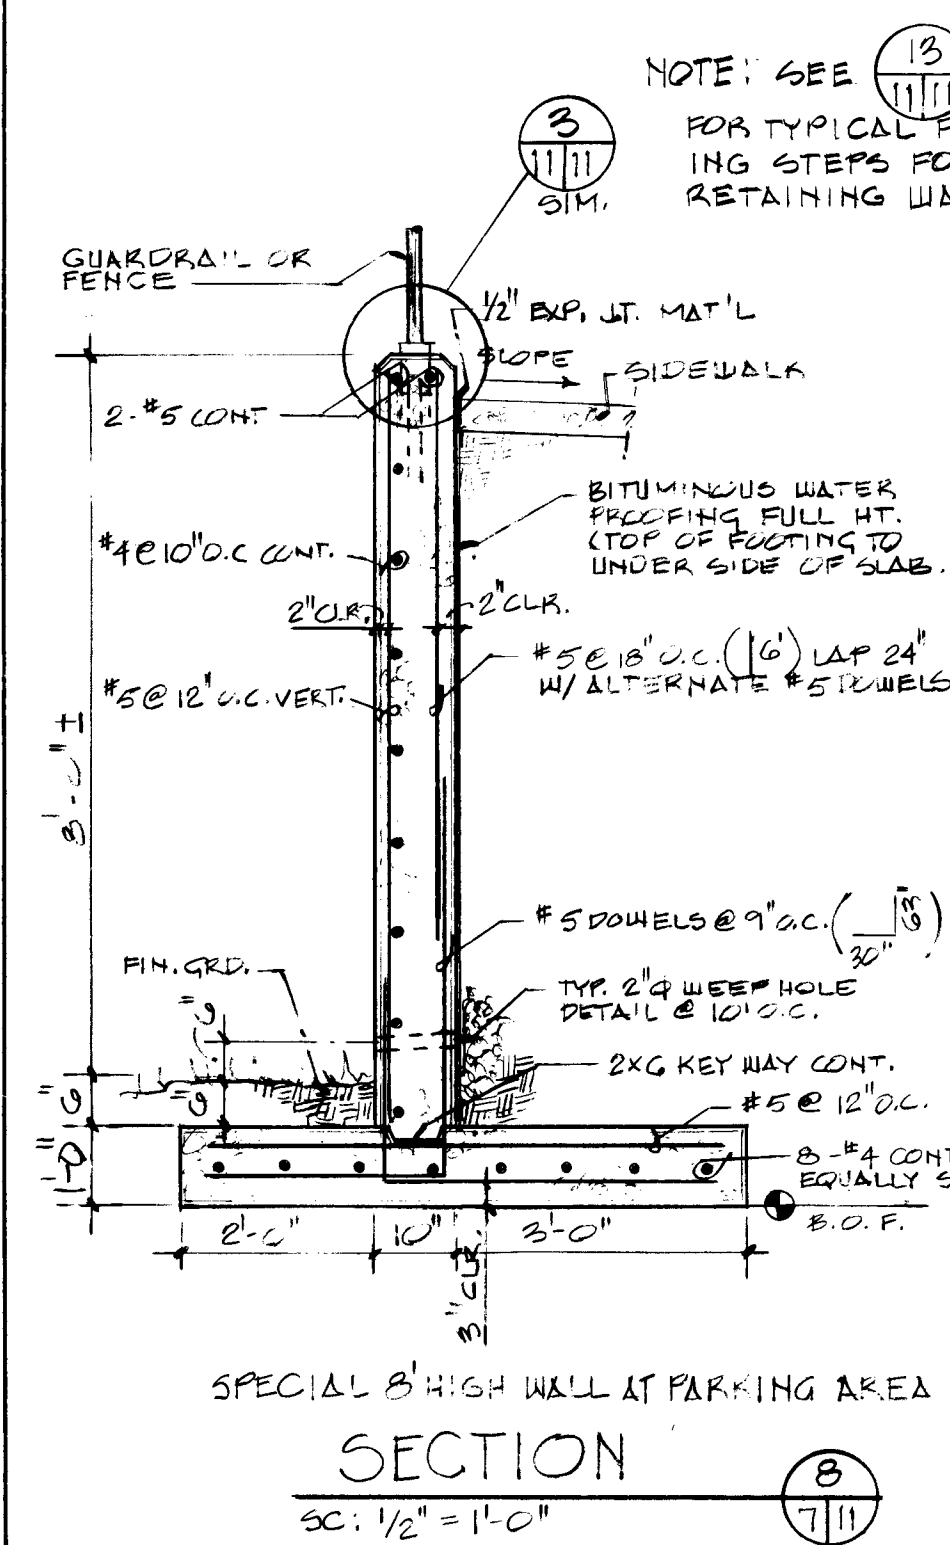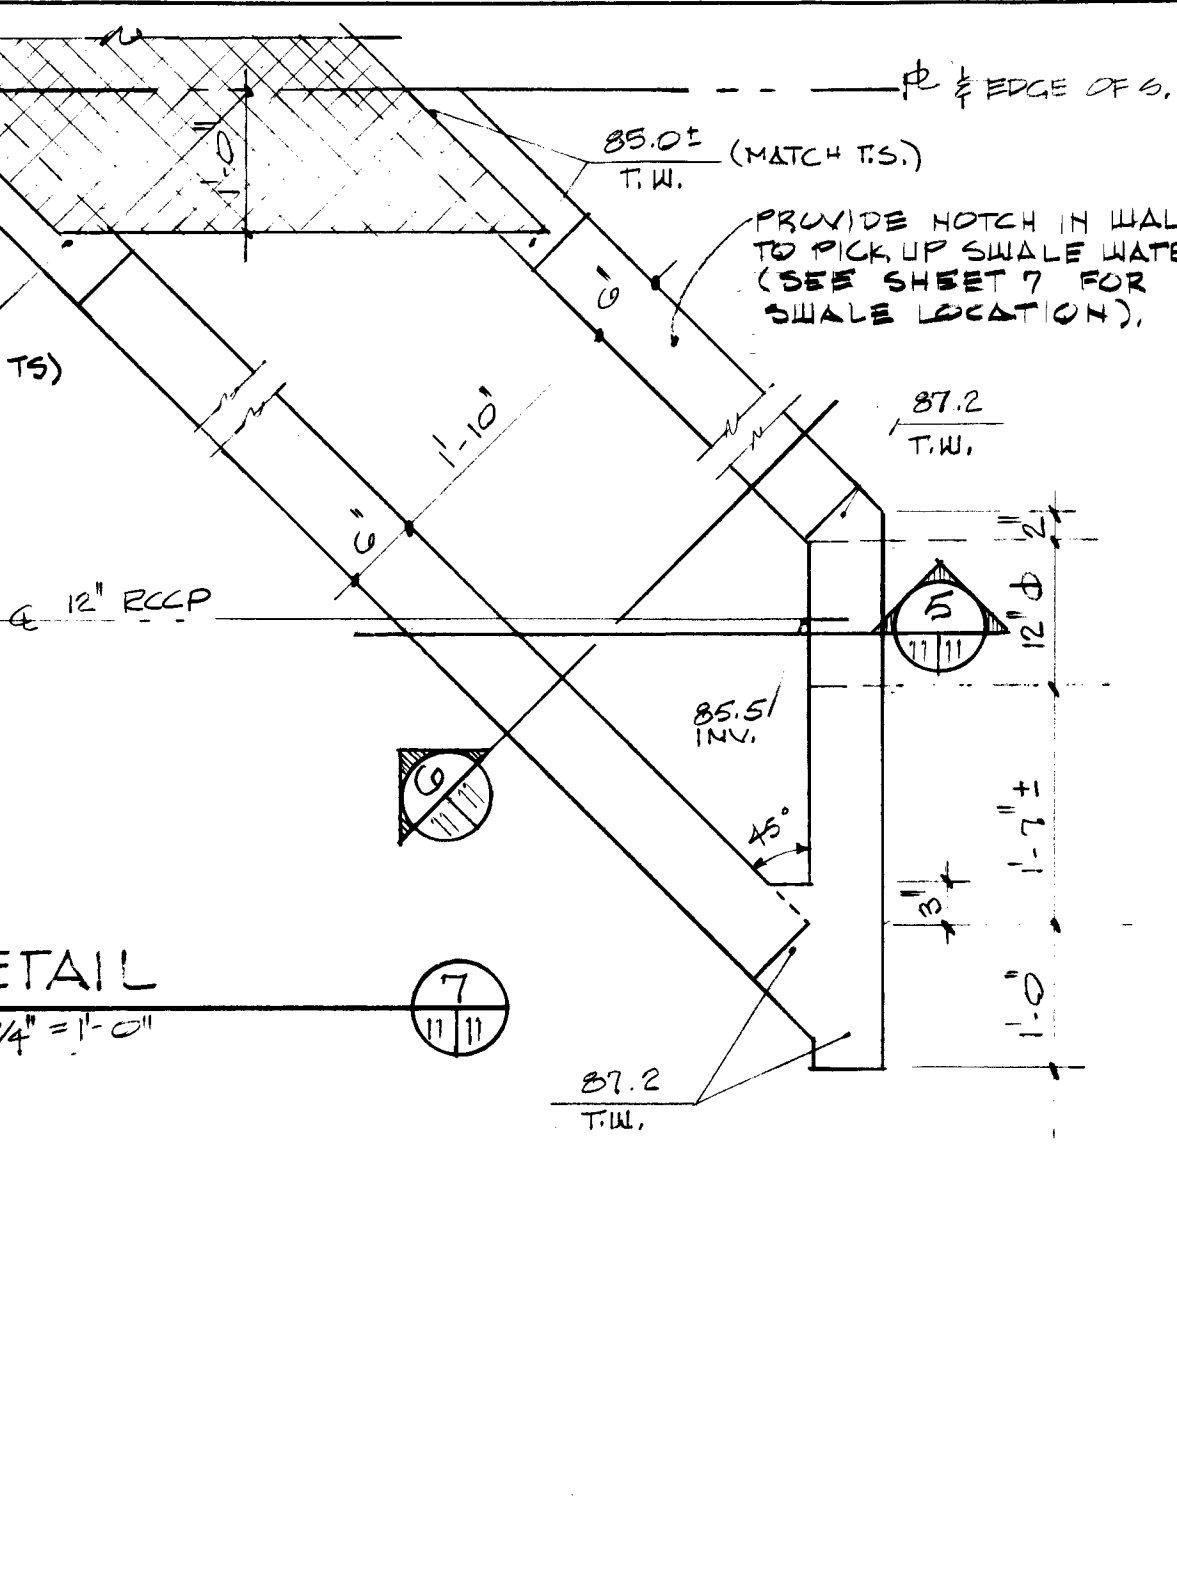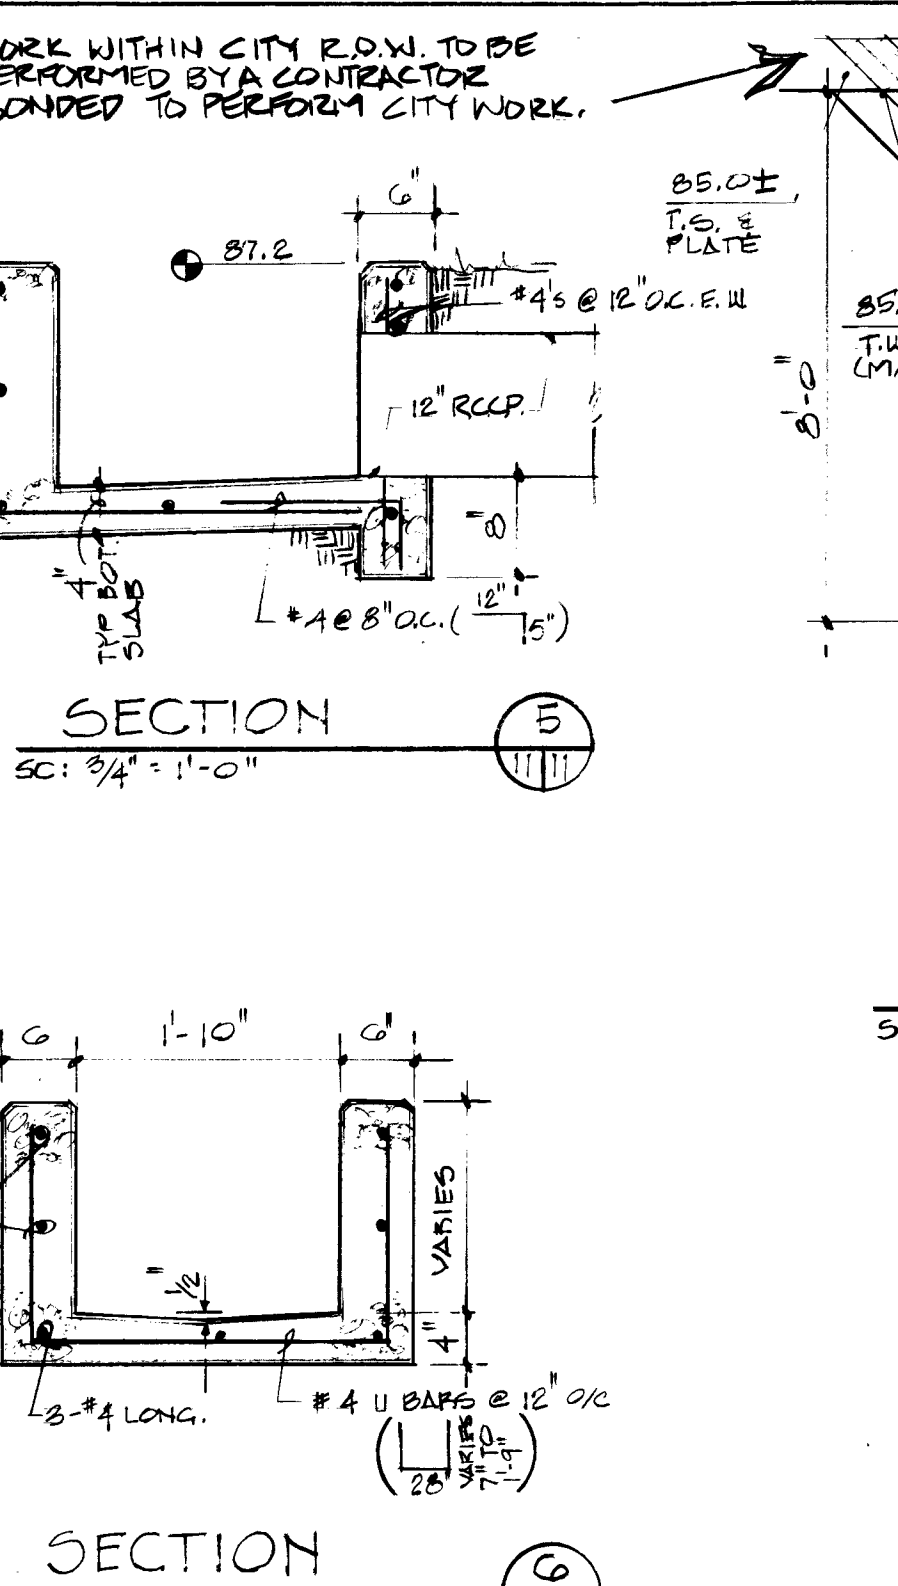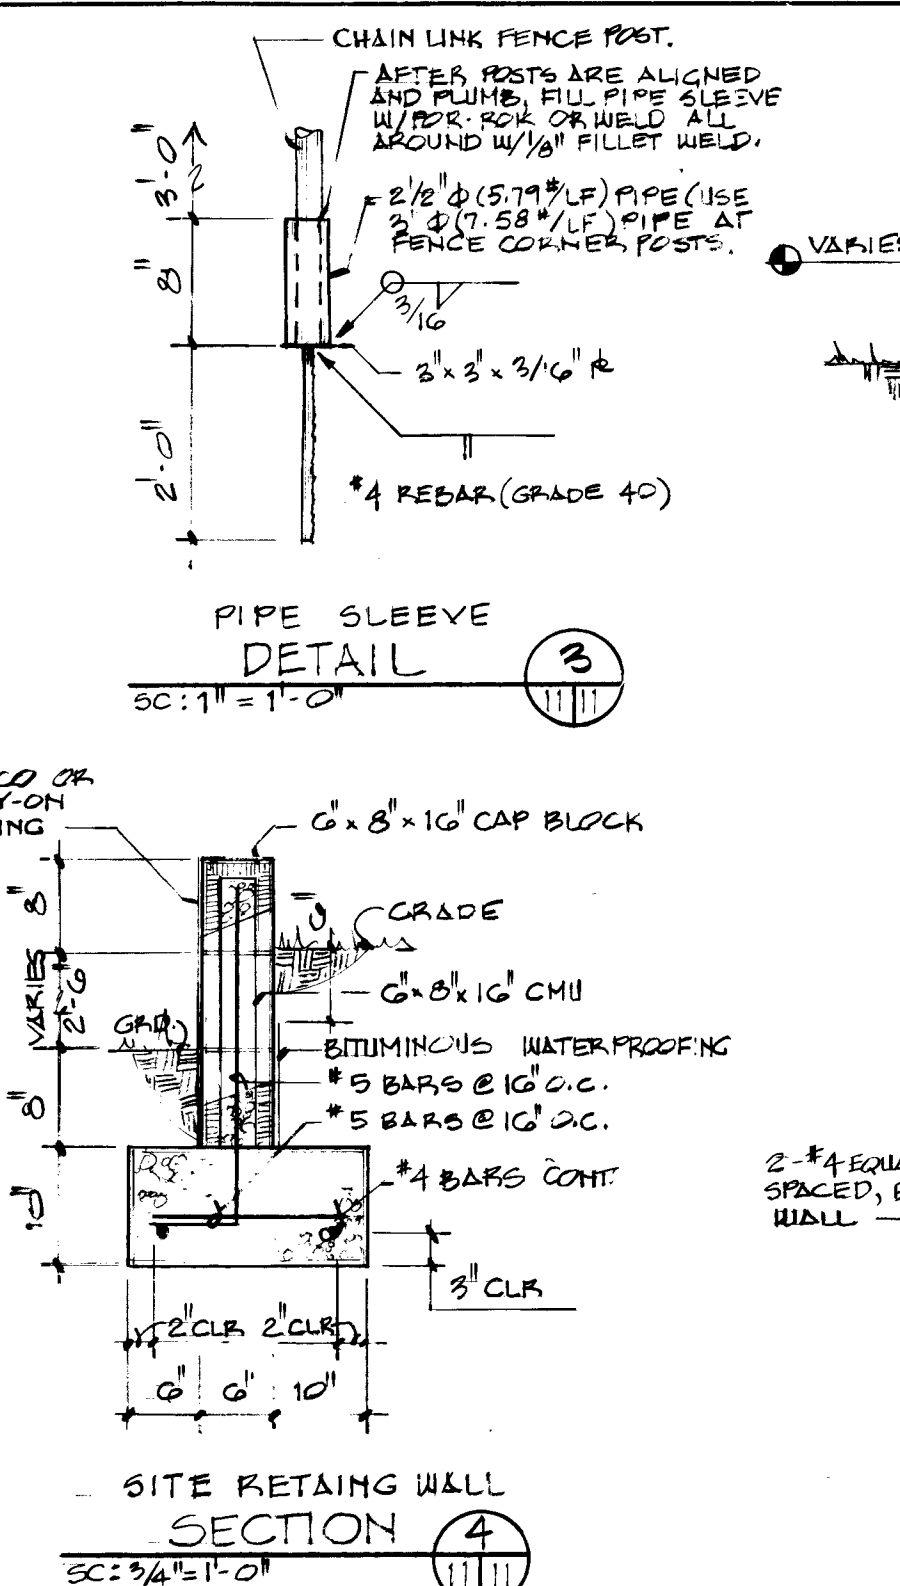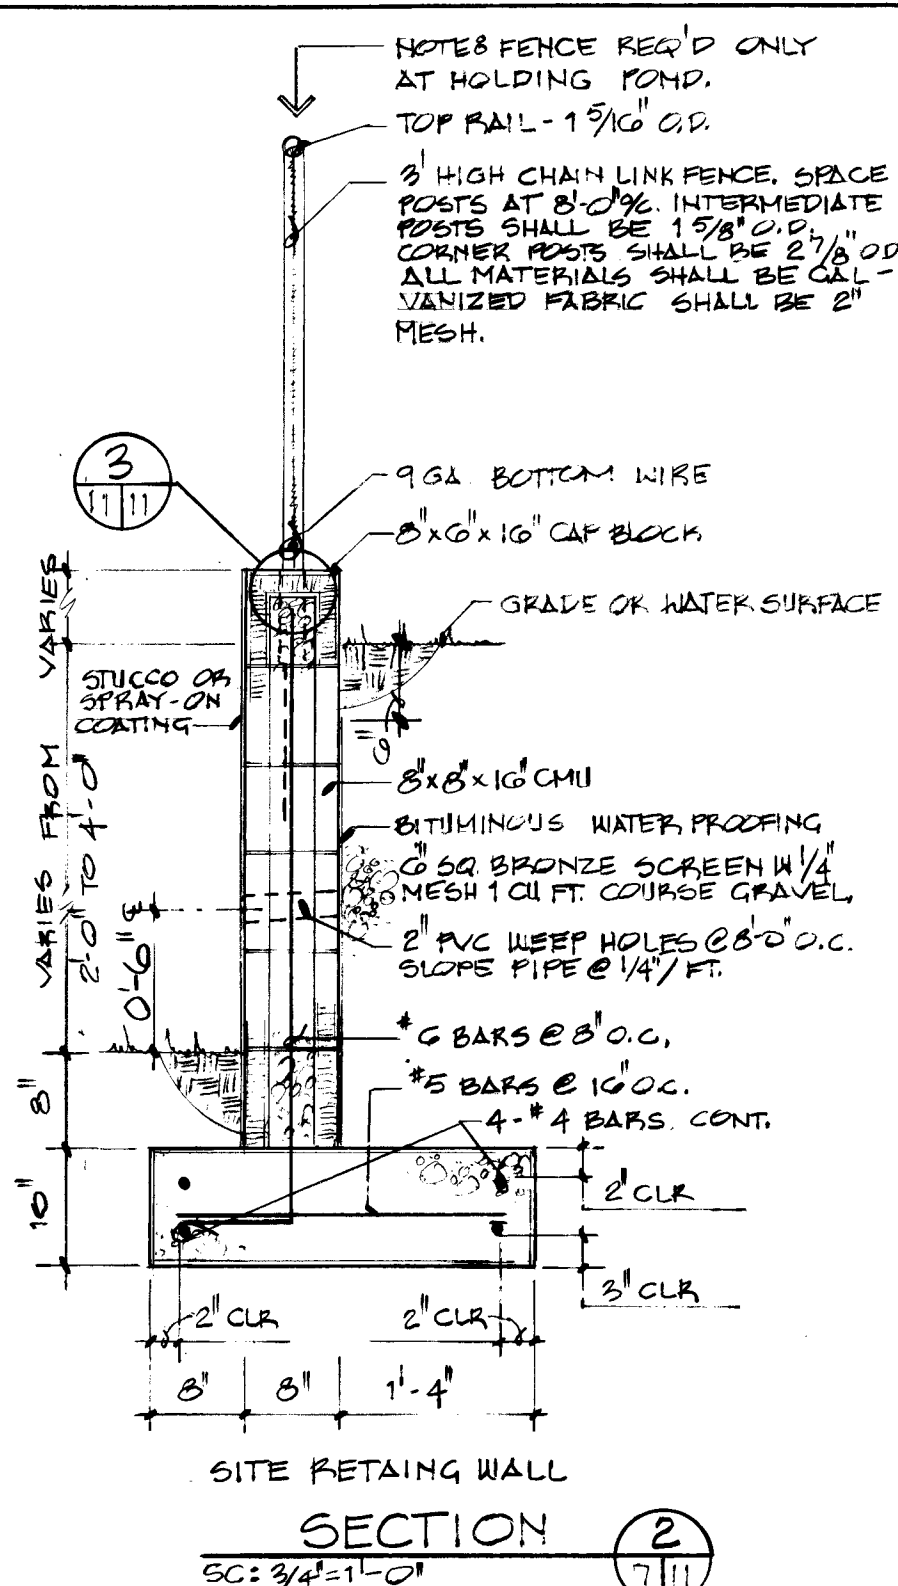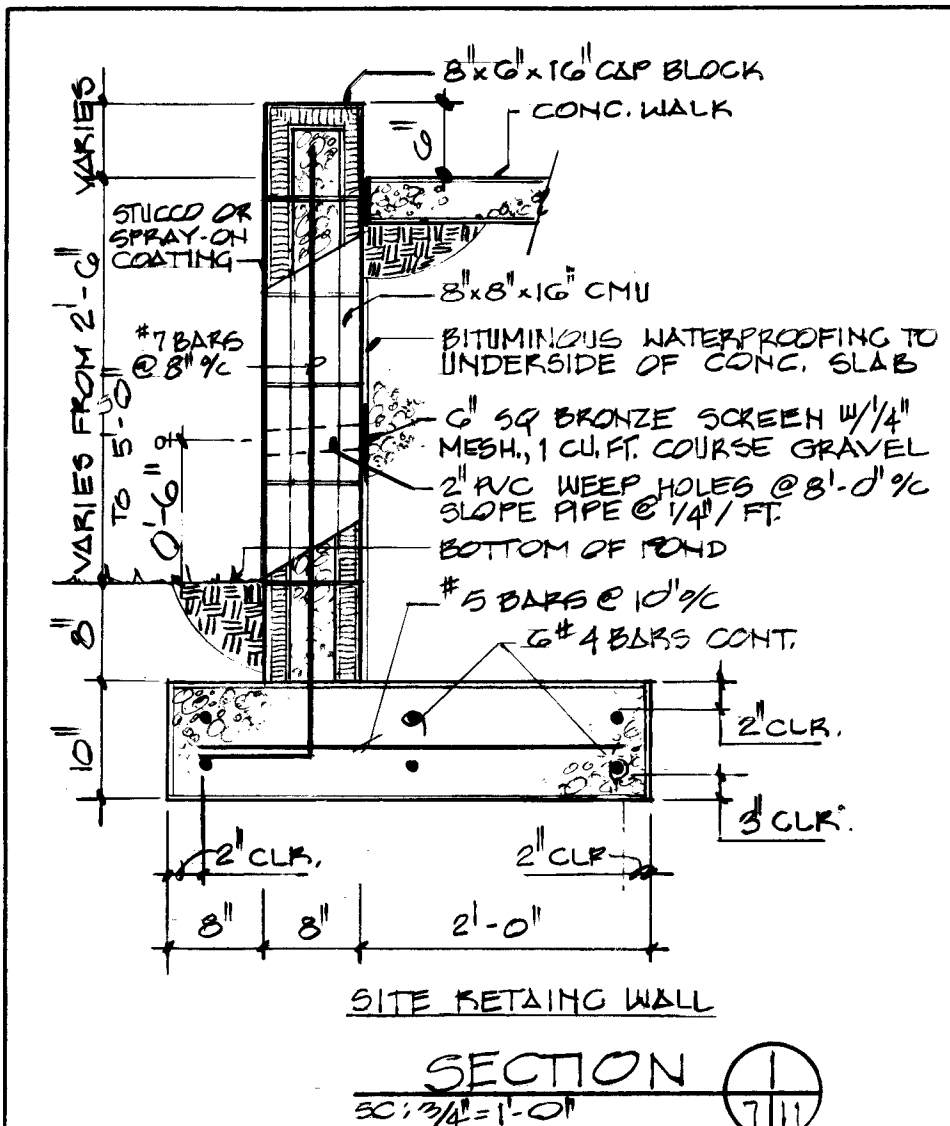

GENERAL NOTES:

- FINISH FLOOR ELEVATIONS (F.F.) ARE PRESENTED AS MEAN SEA LEVEL ELEVATIONS.
- MAXIMUM SLOPE ON LANDSCAPED AREAS TO BE 3:1.
- SEE SHEET 12 FOR TYPICAL ROADWAY SECTION & CURB AND GUTTER SECTION.
- MATERIALS FOR DRAINAGE FACILITIES AND THEIR INSTALLATION SHALL CONFORM TO THE REQUIREMENTS OF THE N.M. STANDARD SPECS. FOR PUBLIC WORKS CONSTRUCTION AND THE MOST CURRENT CITY OF ALBUQUERQUE CASH PAYING DOCUMENTS UNLESS OTHERWISE NOTED ON THE DRAWINGS. CONTACT THE ENGINEER BEFORE PROCEEDING SHOULD CONFLICTS ARISE BETWEEN THE REFERENCED STANDARDS.
- RUBBER GASKETED COMPRESSION JOINTS SHALL BE USED ON ALL CONCRETE PIPE. GASKETS SHALL BE FABRICATED IN ACCORDANCE WITH ASTM C443.

NOTE: CITY PROJECT NO. 1451 INCLUDES WATER & SEWER WORK, WATER & SEWER SERVICE LINE EXTENSIONS AND ASSOCIATED STUB OUTS. (SEE ESTIMATE QUANTITIES FOR BID ITEMS.)



NOTES FOR RETAINING WALLS:

- RETAINING WALL CONC. $f_c = 3000$ PSI.
- GROUT ALL CMU CELLS SOLID. GROUT STRENGTH = 2500 PSI.
- PROVIDE TRUSS TYPE JOINT REINFOR. IN ALTERNATE COURSES, ALL WIRE TO BE 9 GA. GALVANIZED.
- REINFOR. STEEL: GRADE 60. PROVIDE CORNER BARS (3#) IN FOOTING FOR LONGITUDINAL STEEL AT FOOTING INTERSECTIONS.
- SCAFFRY & RECOMPACT UPPER 6" OF SOIL AT BOTTOM OF FOOTING ELEV. TO 95% AS DETERMINED BY ASTM D-1557-78 (MODIFIED PROCTOR).
- BACKFILL BEHIND WALLS SHALL BE COMPACTED TO 90% AS DETERMINED BY ASTM D-1557-78. UPPER 10" TO BE LEFT LOOSE WHERE LANDSCAPING IS SCHEDULED.
- JOINTS SHALL BE STRUCK SMOOTH WHERE STUCCO OR WATERPROOFING IS TO BE APPLIED. WHERE WALLS ARE TO REMAIN EXPOSED, TOOL ALL JOINTS.
- VERIFY LOCATION OF FOOTING STEPS WITH ENGINEER PRIOR TO CONSTRUCTION. SEE DETAIL 13 THIS SHEET FOR TYPICAL STEP.
- LIMITS FOR RETAINING WALL HEIGHTS ARE SHOWN ON THE SECTIONS ON THIS SHEET. THE CONTRACTOR SHALL DETERMINE THE HEIGHT OF MATERIAL TO BE RETAINED AND UTILIZE THE APPLICABLE SECTION.
- CHAMFER ALL EXPOSED CONCRETE CORNERS.

RECORD DRAWINGS




















26 1451 1185

CITY OF ALBUQUERQUE MUNICIPAL DEVELOPMENT DEPARTMENT ENGINEERING DIVISION				
TITLE: EL PASO - PHASE II RETAINING WALLS & DRAINAGE DETAILS				
APPROVALS	ENGINEER	DATE	APPROVALS	ENGINEER
City Engineer	Rosa	11/1/02	Liquid Waste	N.A. Jomo 2
A.C.E.-Design	Shahel	11/1/02	Traffic	N.A. Jomo 2
A.C.E.-Hydrology	Rosa	11/1/02	Water	N.A. Jomo 2
DESIGNED	BY DESIGN PROFESSIONAL	DATE	DRAWN	BY J.S.
CHECKED	BY J.S.	DATE	CHECKED	BY J.S.
DRAWING NO.	1451	MAP NO.	E 214	SHEET 11 OF 12

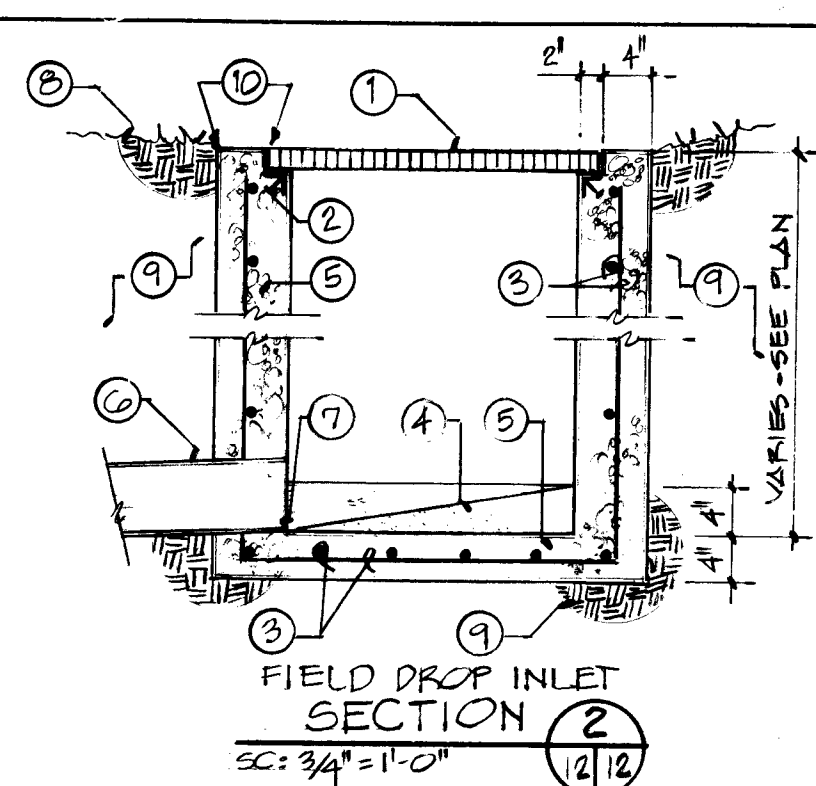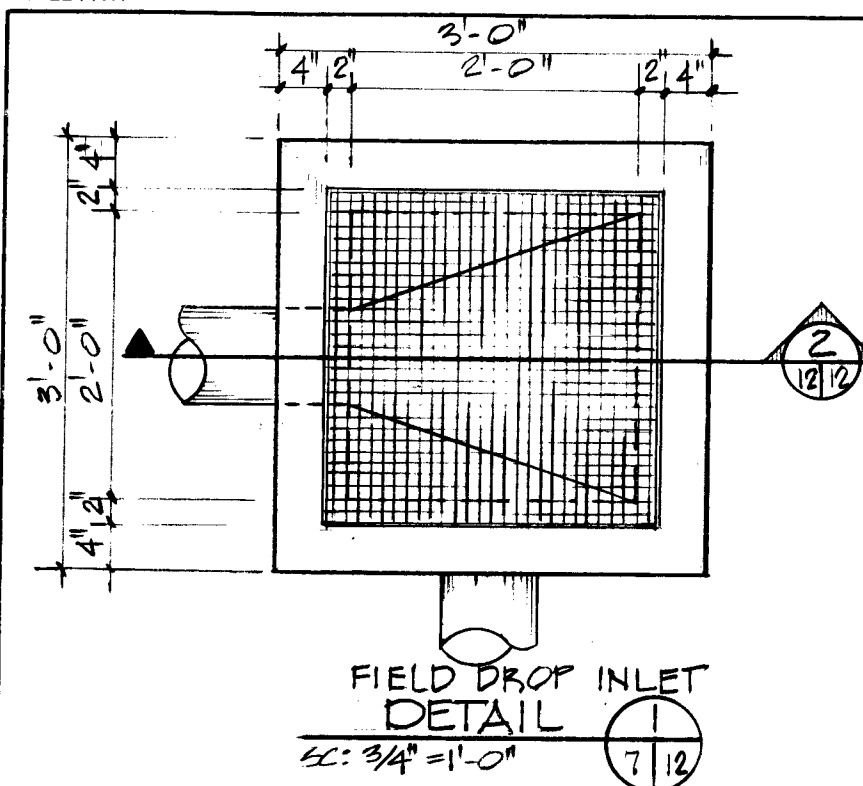

KEYED NOTES

1. GRATE W/ 1" OPENINGS. SEE SHEET 7 FOR TOP OF GRATE ELEVATIONS.
2. 2" x 2" x 1/4" x 2" WELDED HEADED STUDS EA. SIDE.
3. #4 BARS @ 6" O.C. EA. WAY.
4. 3000 PSI CONC. FILL - SLOPE TO OUTLET PIPE.
5. 3000 PSI CONC. TYPICAL FOR SITE WORK CONC.
6. PIPE SIZE Varies.
7. INVERT ELEVATION SHOWN.
8. LANDSCAPED AREA.
9. COMPACT TO 90% PER ASTM D1557-78.
10. CHAMFER ALL EXPOSED EDGES.

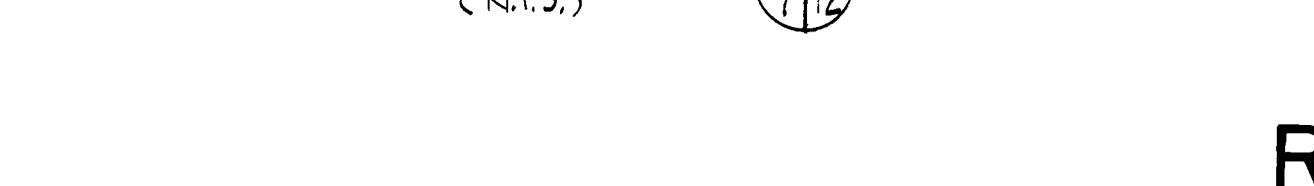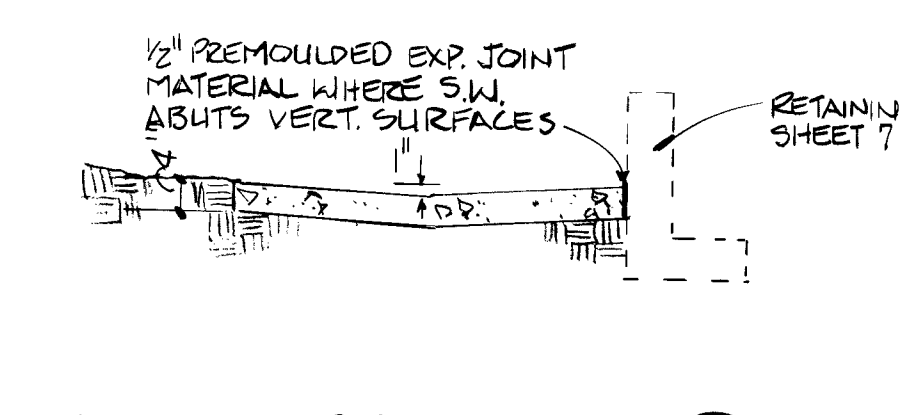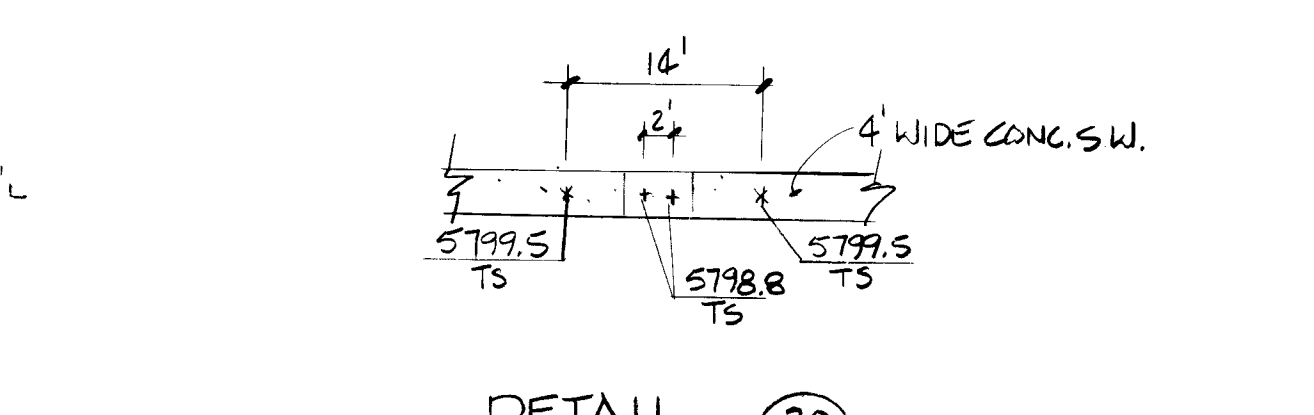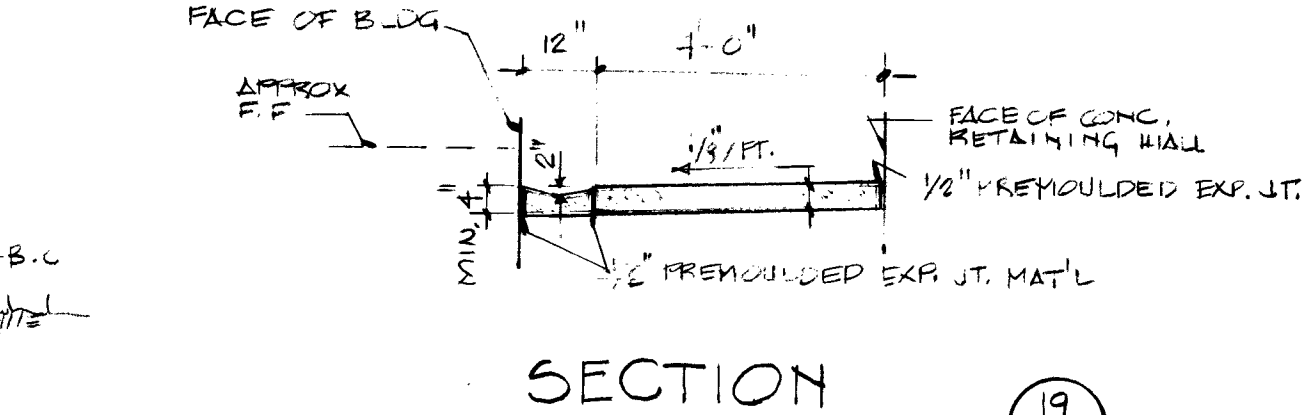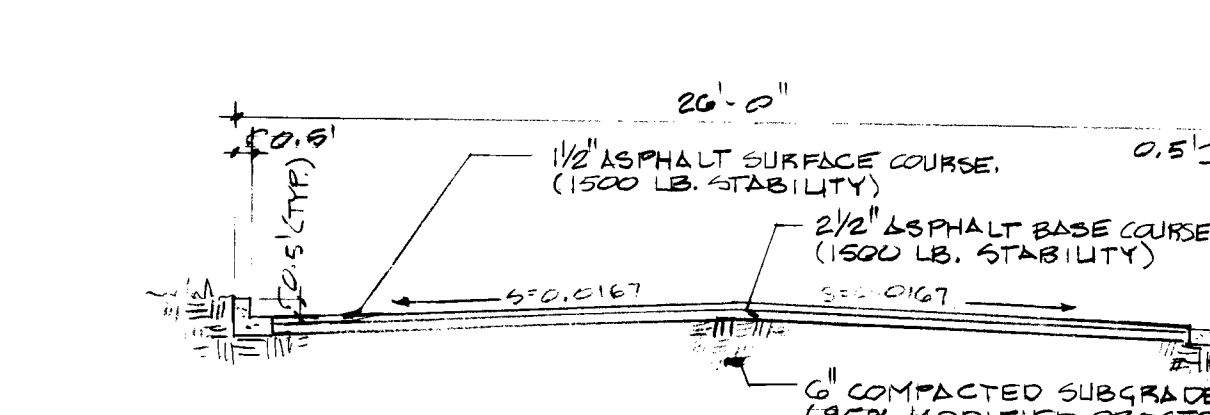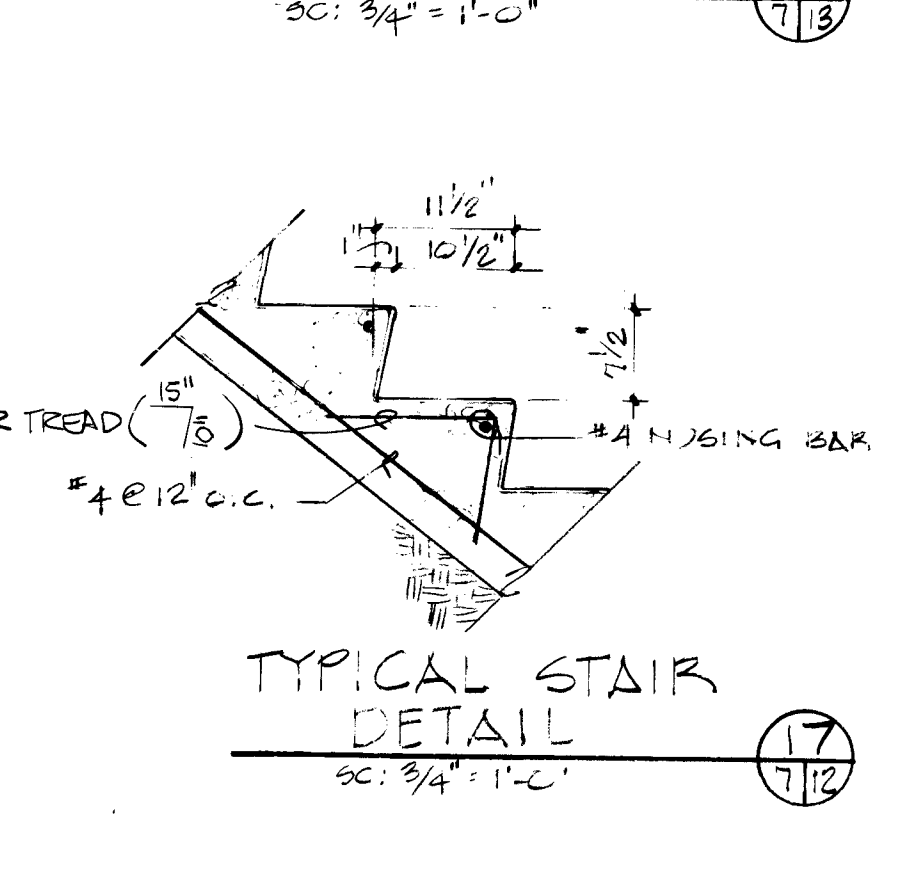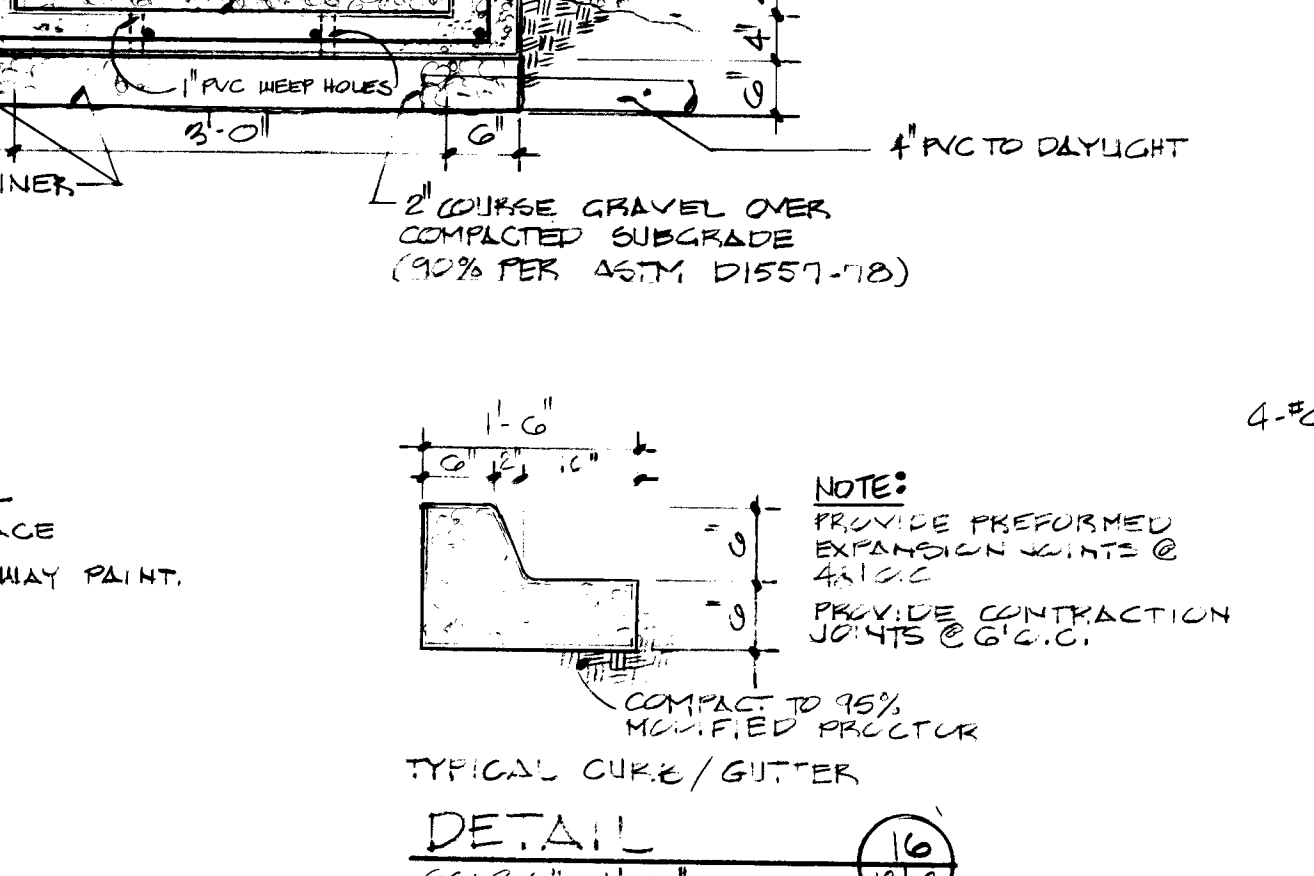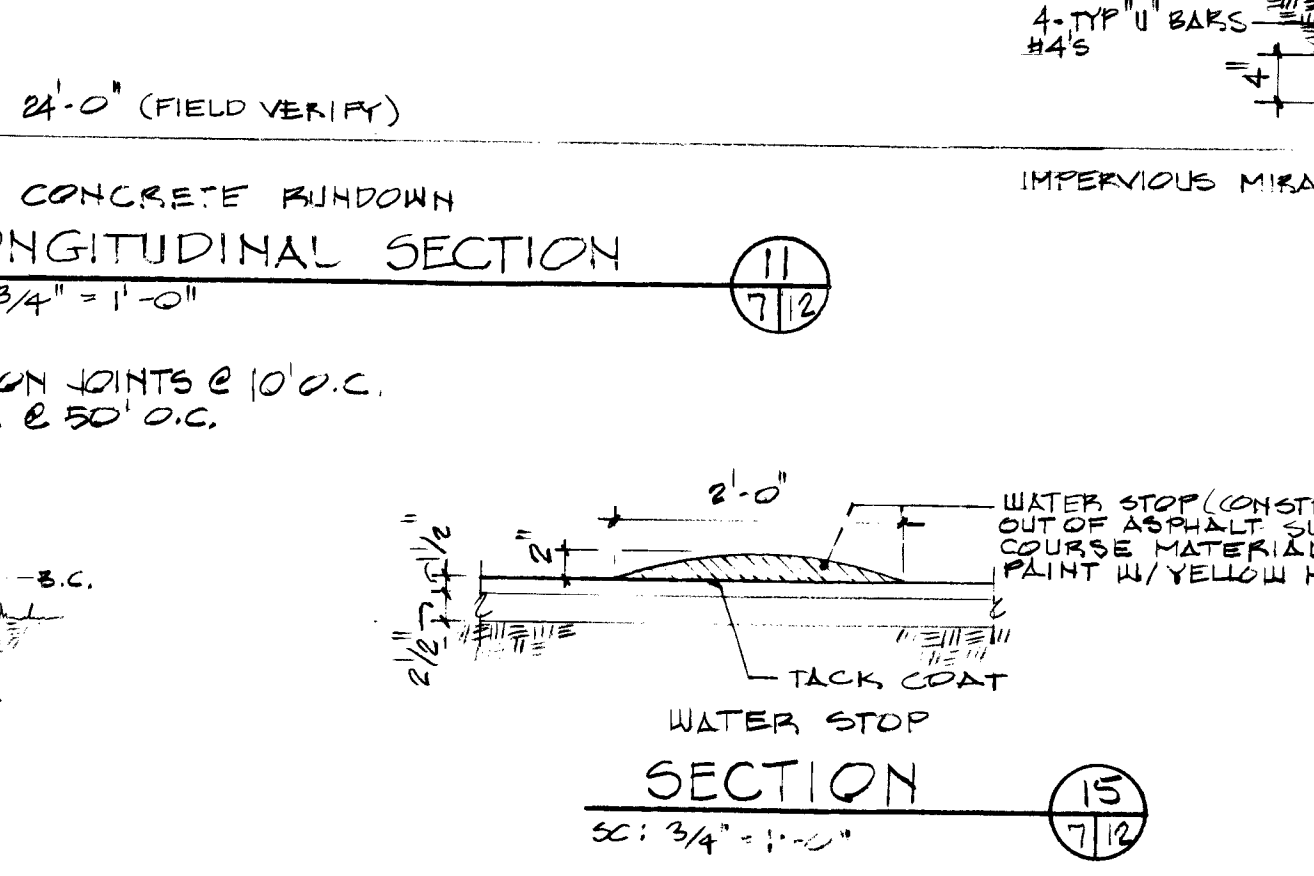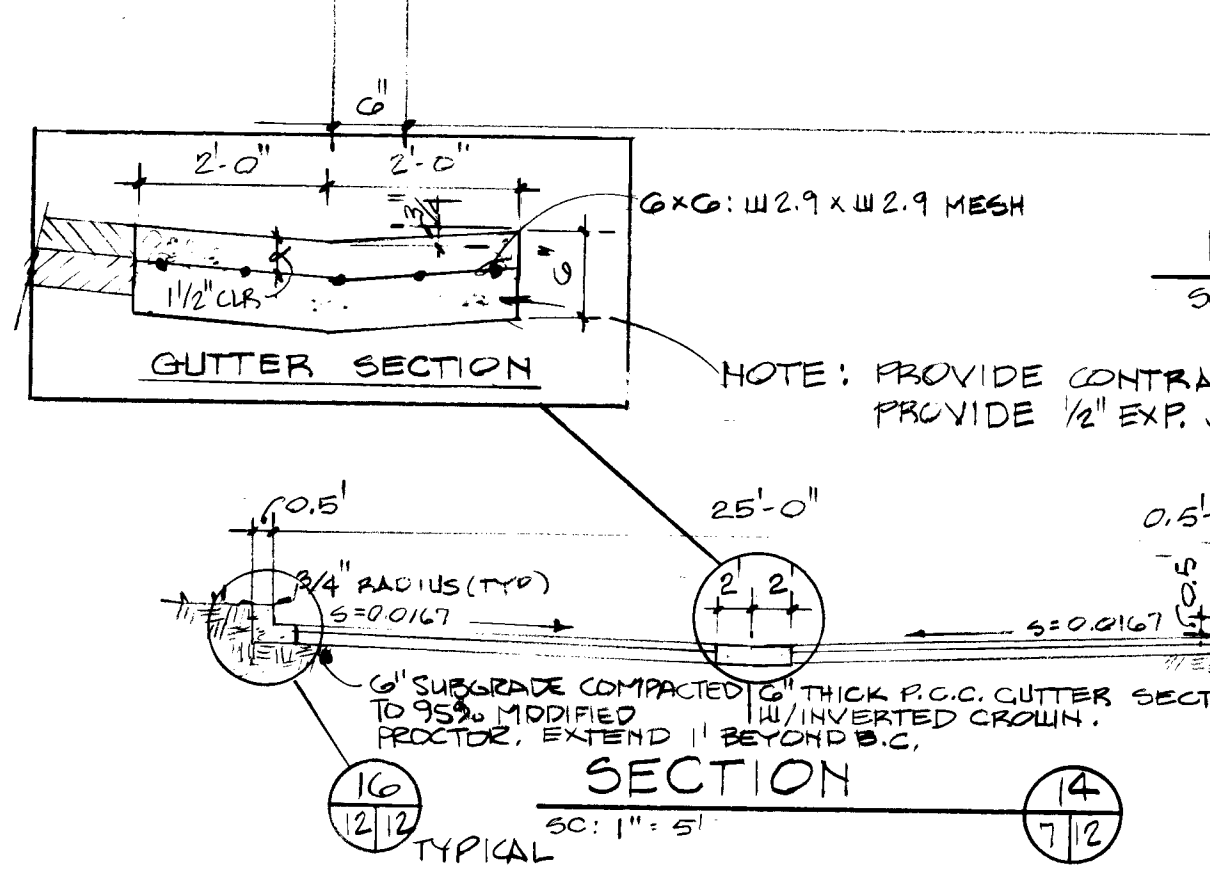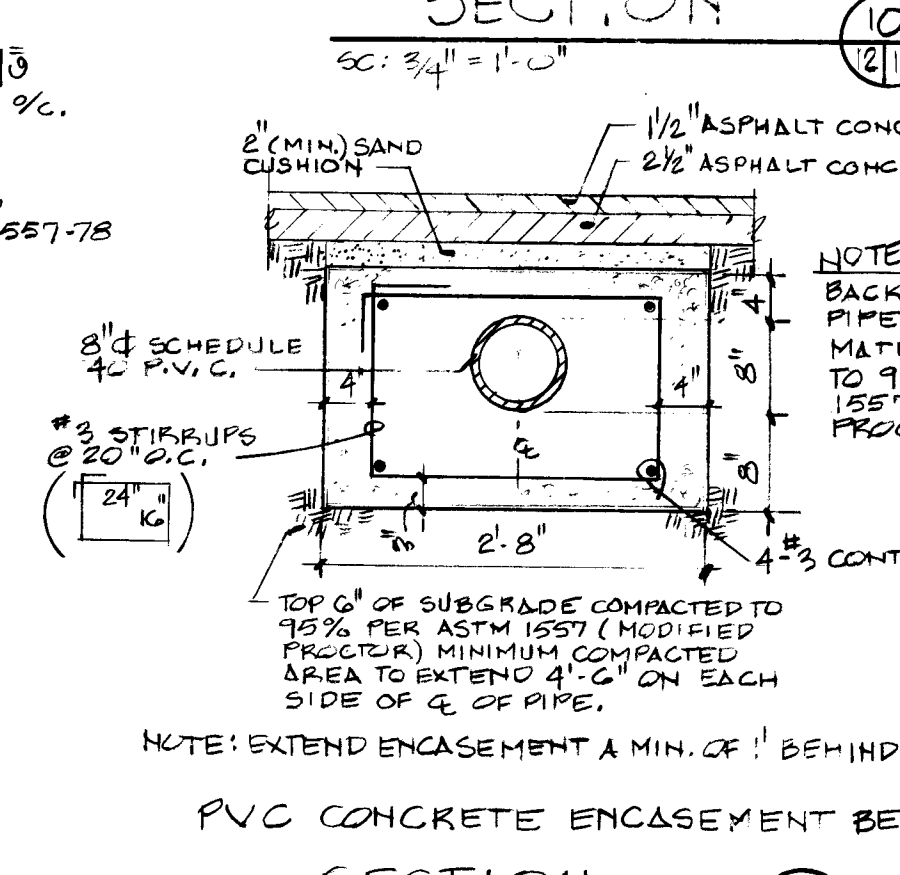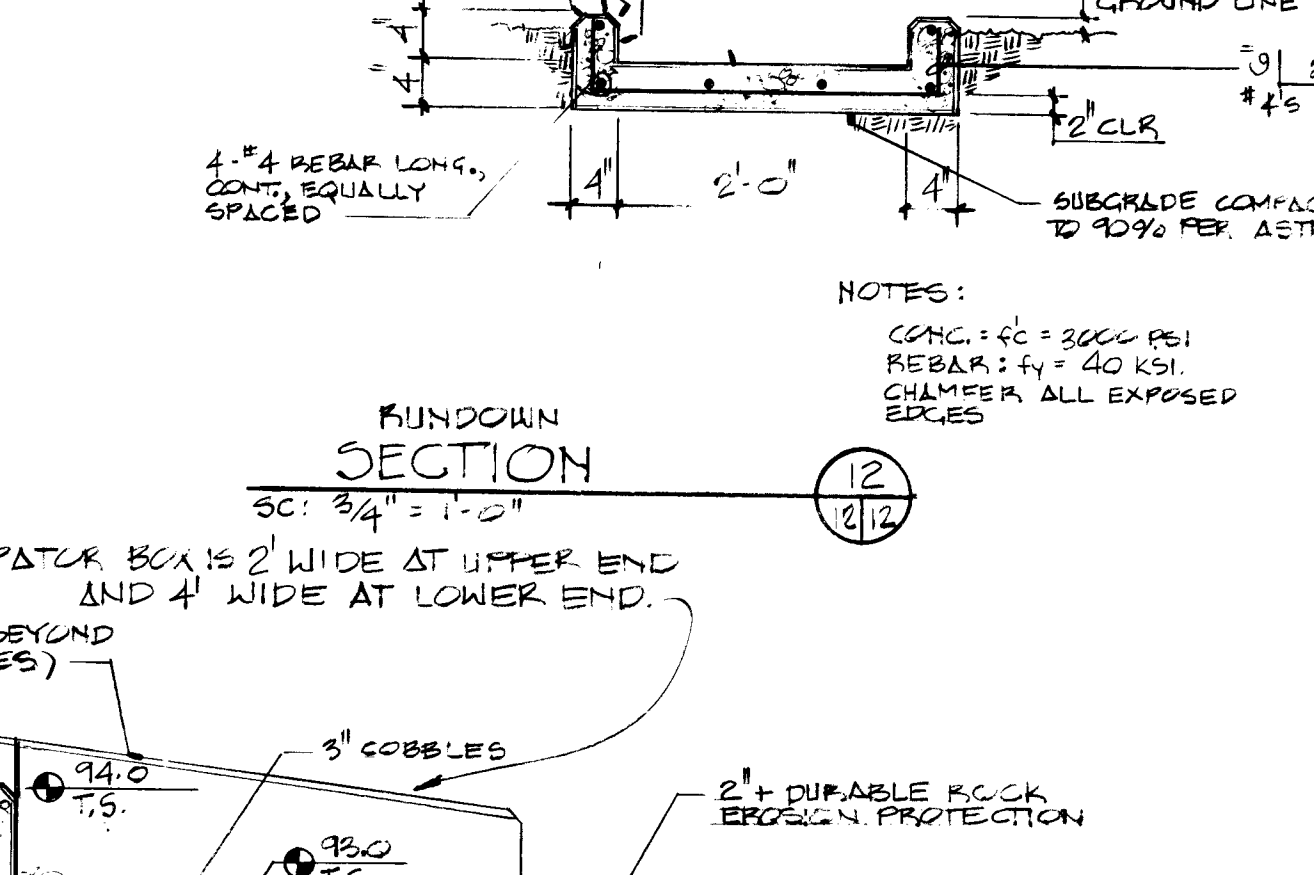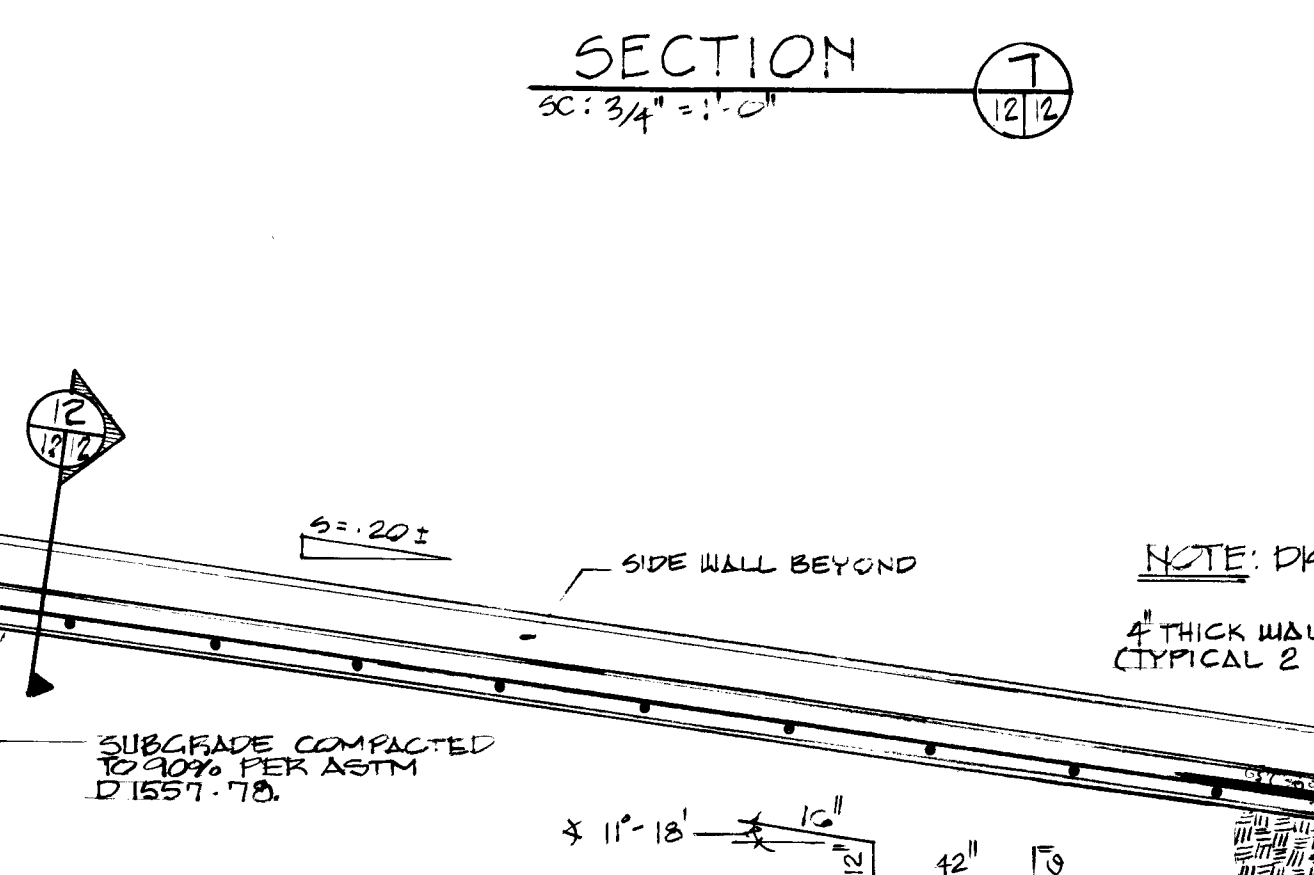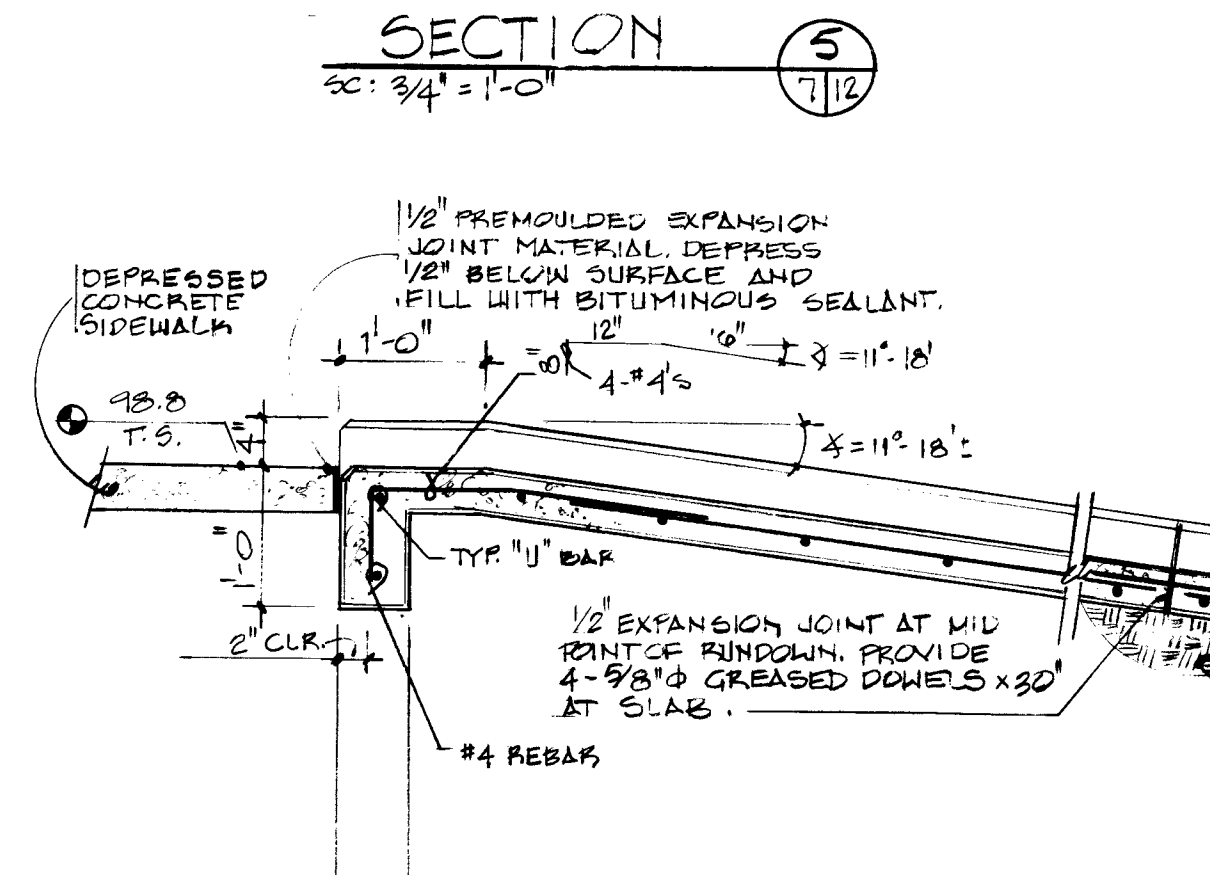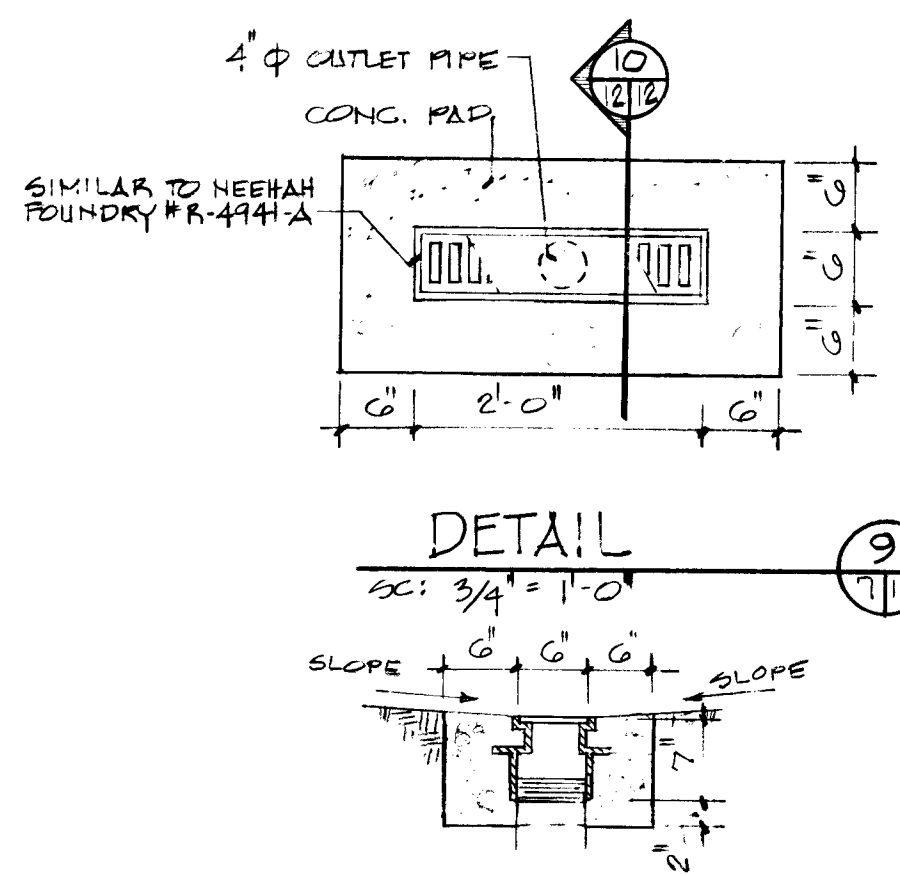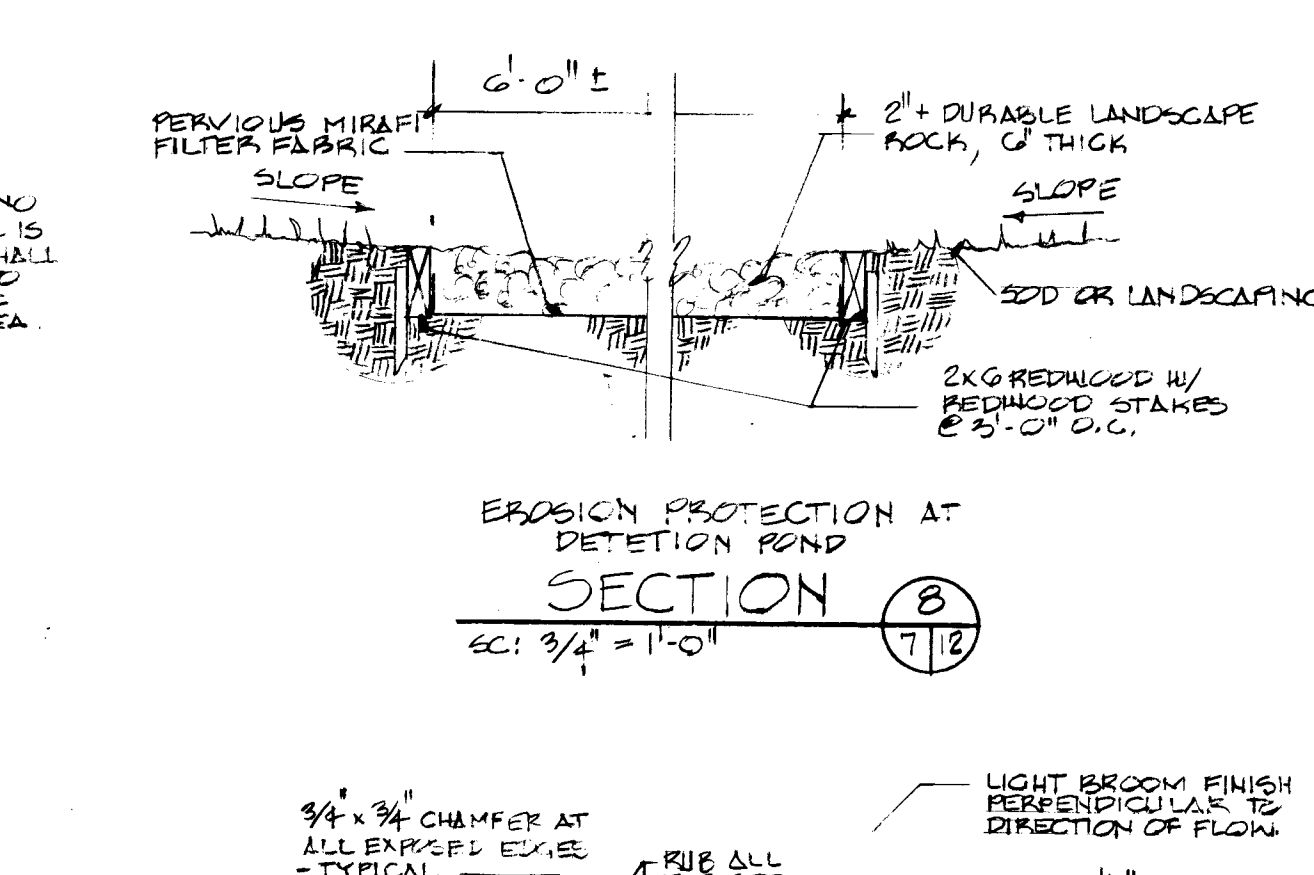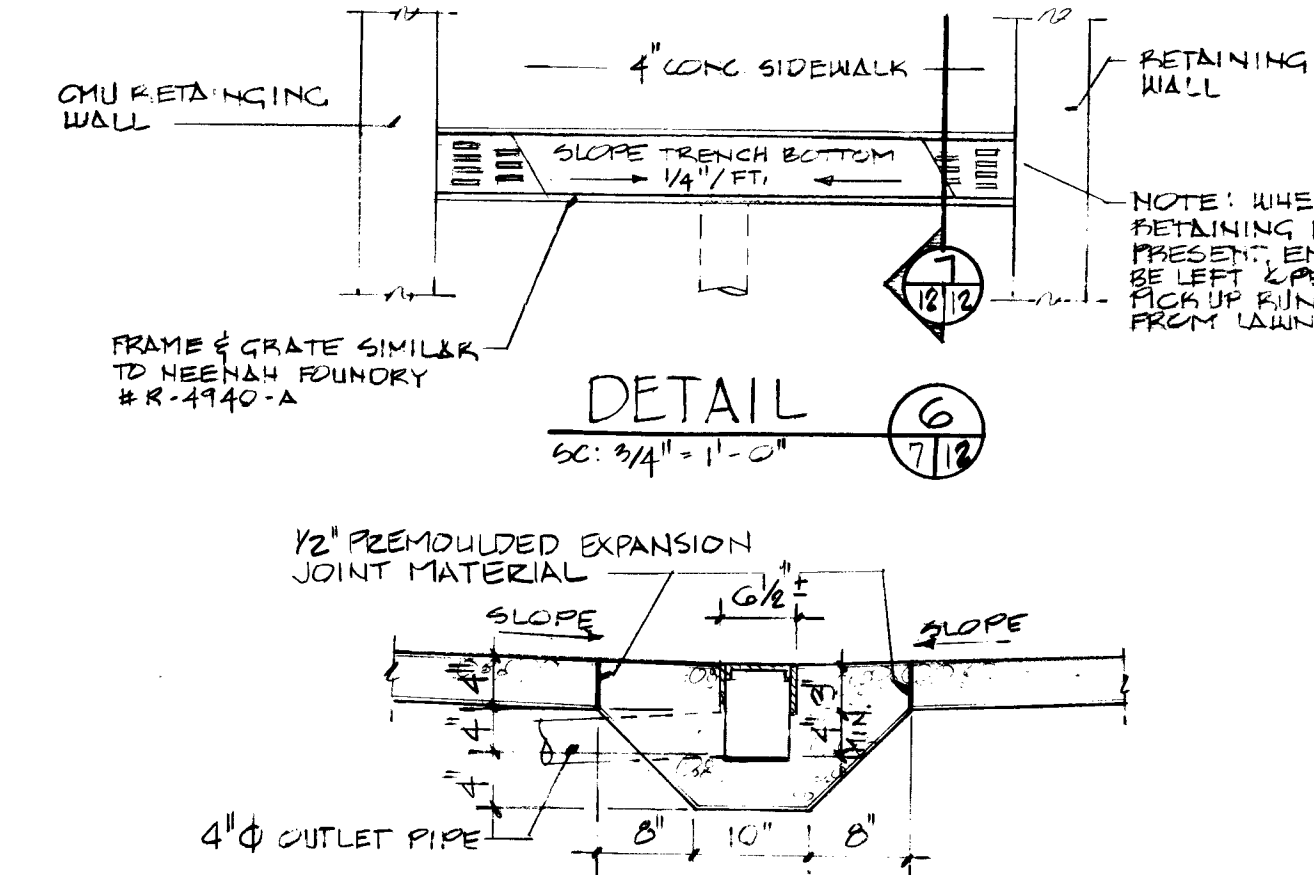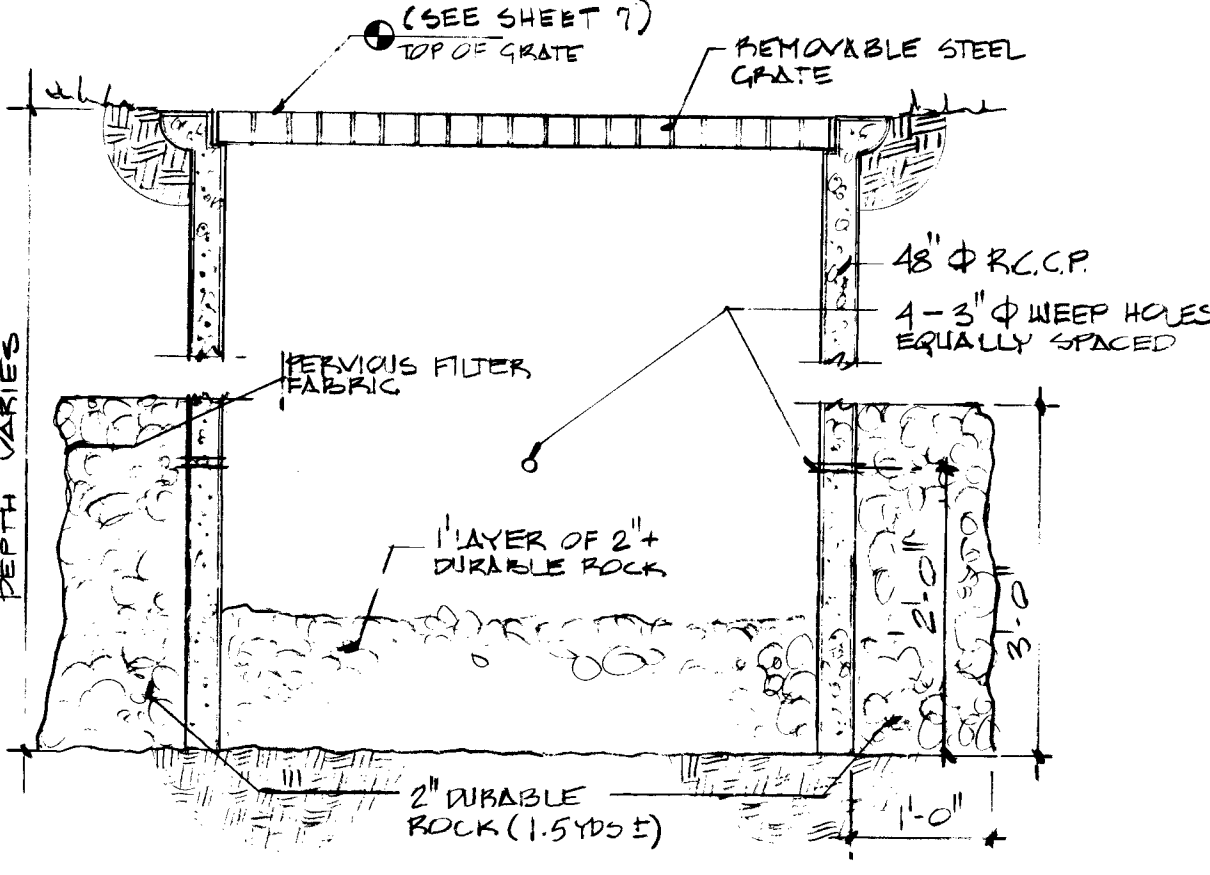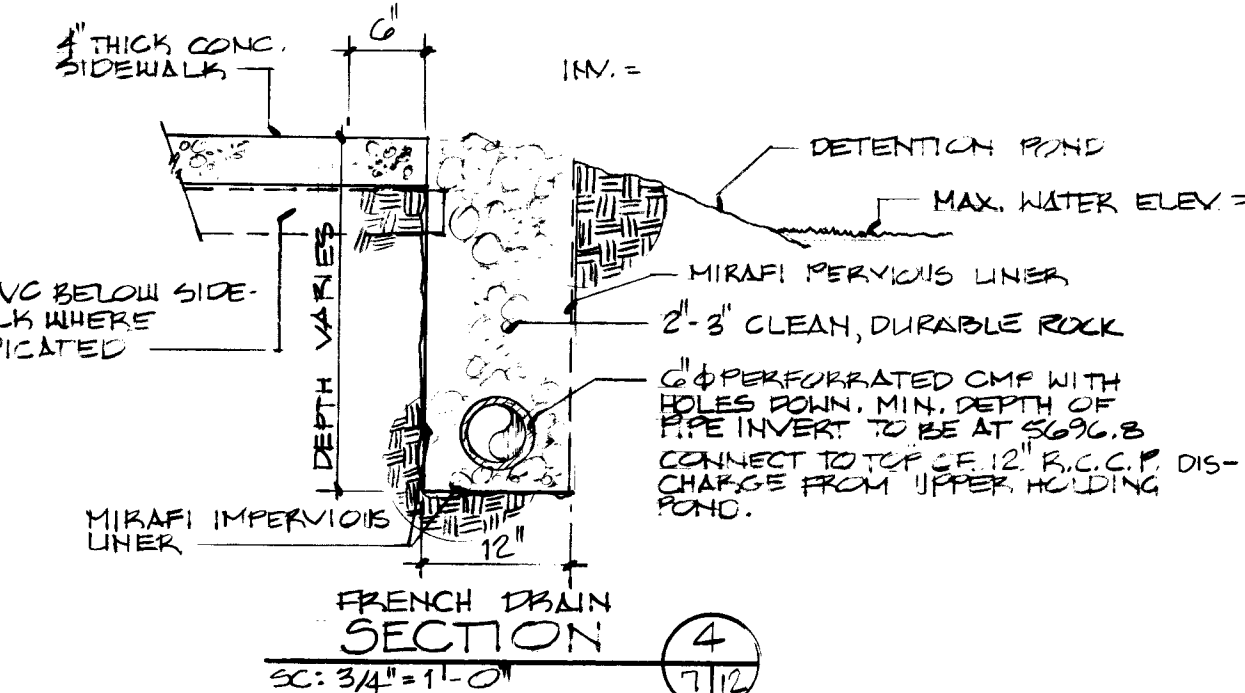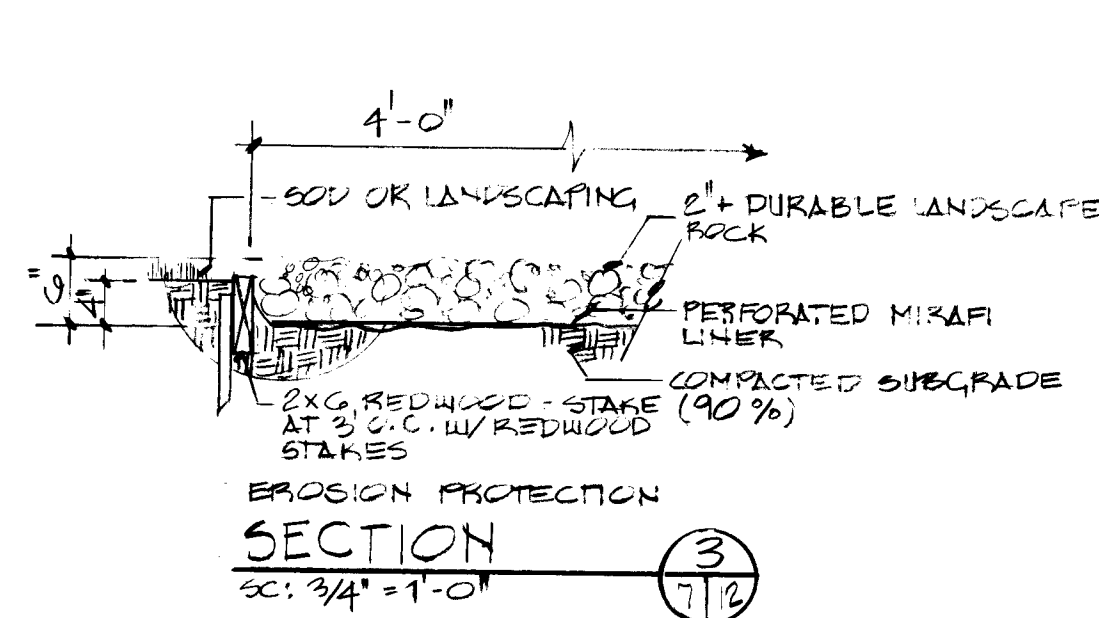

NOTE:
SEE SHEET 11 FOR DRAINAGE
GENERAL NOTES.

AS BUILT INFORMATION		BENCH MARKS		SURVEY INFORMATION		ENGINEER'S SEAL		REVISIONS		DESIGN		DATE	
NO.	DATE	NO.	DATE	NO.	DATE	NO.	DATE	NO.	DATE	NO.	DATE	NO.	DATE
1	10/1/82	1	10/1/82	1	10/1/82	1	10/1/82	1	10/1/82	1	10/1/82	1	10/1/82
2	10/1/82	2	10/1/82	2	10/1/82	2	10/1/82	2	10/1/82	2	10/1/82	2	10/1/82
3	10/1/82	3	10/1/82	3	10/1/82	3	10/1/82	3	10/1/82	3	10/1/82	3	10/1/82
4	10/1/82	4	10/1/82	4	10/1/82	4	10/1/82	4	10/1/82	4	10/1/82	4	10/1/82
5	10/1/82	5	10/1/82	5	10/1/82	5	10/1/82	5	10/1/82	5	10/1/82	5	10/1/82
6	10/1/82	6	10/1/82	6	10/1/82	6	10/1/82	6	10/1/82	6	10/1/82	6	10/1/82
7	10/1/82	7	10/1/82	7	10/1/82	7	10/1/82	7	10/1/82	7	10/1/82	7	10/1/82
8	10/1/82	8	10/1/82	8	10/1/82	8	10/1/82	8	10/1/82	8	10/1/82	8	10/1/82
9	10/1/82	9	10/1/82	9	10/1/82	9	10/1/82	9	10/1/82	9	10/1/82	9	10/1/82
10	10/1/82	10	10/1/82	10	10/1/82	10	10/1/82	10	10/1/82	10	10/1/82	10	10/1/82
11	10/1/82	11	10/1/82	11	10/1/82	11	10/1/82	11	10/1/82	11	10/1/82	11	10/1/82
12	10/1/82	12	10/1/82	12	10/1/82	12	10/1/82	12	10/1/82	12	10/1/82	12	10/1/82
13	10/1/82	13	10/1/82	13	10/1/82	13	10/1/82	13	10/1/82	13	10/1/82	13	10/1/82
14	10/1/82	14	10/1/82	14	10/1/82	14	10/1/82	14	10/1/82	14	10/1/82	14	10/1/82
15	10/1/82	15	10/1/82	15	10/1/82	15	10/1/82	15	10/1/82	15	10/1/82	15	10/1/82
27	10/1/82	27	10/1/82	27	10/1/82	27	10/1/82	27	10/1/82	27	10/1/82	27	10/1/82
28	10/1/82	28	10/1/82	28	10/1/82	28	10/1/82	28	10/1/82	28	10/1/82	28	10/1/82
29	10/1/82	29	10/1/82	29	10/1/82	29	10/1/82	29	10/1/82	29	10/1/82	29	10/1/82
30	10/1/82	30	10/1/82	30	10/1/82	30	10/1/82	30	10/1/82	30	10/1/82	30	10/1/82

26 1451 1285

CITY OF ALBUQUERQUE
MUNICIPAL DEVELOPMENT DEPARTMENT
ENGINEERING DIVISION

TITLE:
EL PASO - PHASE II
DRAINAGE AND PAVING DETAILS

APPROVALS	ENGINEER	DATE	APPROVALS	ENGINEER	DATE
City Engineer	<i>[Signature]</i>	11/6/82	Liquid Waste	<i>[Signature]</i>	10/7/82
A.C.E. - Design	<i>[Signature]</i>	11/6/82	Traffic	<i>[Signature]</i>	10/7/82
A.C.E. - Hydrology	<i>[Signature]</i>	10/6/82	Water	<i>[Signature]</i>	10/7/82
QA	<i>[Signature]</i>	11/6/82			
DRAWING NO.	1451	MAP NO.	E 21 N	SHEET	OF 12

RECORD DRAWINGS