


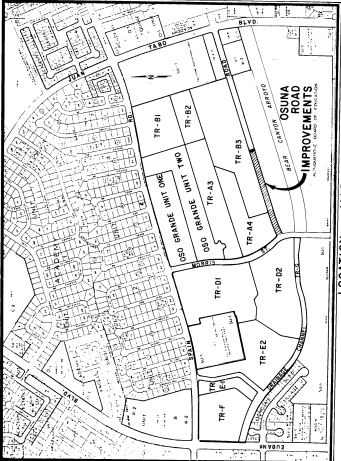

OSO GRANDE SUBDIVISION OSUNA ROAD IMPROVEMENTS ALBUQUERQUE, NEW MEXICO

△ STA. 0+00 TO 12+50

INDEX TO DRAWINGS

- △ 1 TITLE SHEET
- 2 PLATS OF GEOMETRY
- 3 PAVING PLAN & PROFILE - STA. 0+00.00 — STA. 10+50.00
12+50
- △ 4 PAVING PLAN & PROFILE - STA. 10+50.00 — STA. ~~20+01.63~~
24+00
- △ 5 UTILITY PLAN & PROFILE - STA. 0+00.00 — STA. 10+50.00
12+50
- △△ 6 UTILITY PLAN & PROFILE - STA. 10+50.00 — STA. ~~22+03.51~~
24+00
- 7 STORM SEWER PLAN & PROFILE

RE-ENTRY	DATE
Lighting	1/25/84
WATER RESOURCES	1/25/84
TRAFFIC	1/25/84
HYDROLOGY	1/25/84
ASBESTOS	1/25/84
CITY ENGINEER	1/25/84

NOTICE TO CONTRACTOR

- All work detailed on these plans to be performed under contract shall, except as otherwise stated or provided for herein, be constructed in accordance with the New Mexico Standard Specifications for Highway Construction, 1979 Edition (referred to herein as the Standard Specifications) and the Contract Documents for Citywide Utilities and Cash Paying No. 1.
- Two (2) working days prior to any excavation, contractor must contact line locating Service, 765-1234, for location of existing utilities.
- Prior to construction, the contractor shall excavate and verify the horizontal and vertical alignment of the existing road and utilities. If the contractor shall notify the engineer or surveyor so that the conflict can be resolved with minimum amount of delay.
- All utilities and utility service lines shall be installed prior to paving.
- Backfill compaction shall be according to specified street use.
- Tack coat requirements shall be determined by the City Engineer.
- Sidewalks and shoulders shall be constructed within the curb returns shall be constructed wherever a new curb return is constructed.
- If curb is damaged for a driveway or a handicap ramp, the driveway or ramp shall be constructed prior to acceptance of the curb and gutter.
- All storm drainage facilities shall be completed prior to final acceptance.

△ is This project shall be done in conjunction with Project 2008.

SUBMITTED BY:	CITY ENGINEER	DATE	5/11/82
KENT H. WHITMAN, PE		DATE	



△ COMPANION PROJECT: 2008


1452

26 1452 0184

DATE	DESCRIPTION
FEB 1982	COMPANION PROJECTS
MAY 1982	CIP-82-0184
CIP	
WES	
10/12/82	





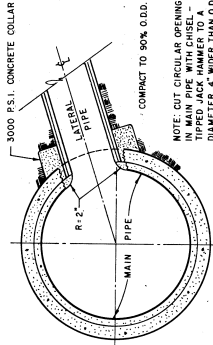

LATERAL CONNECTION DETAIL VOIR

RECORD DRAWING
I, Claude A.L. Pilley, M.M.P.E. & L.S. No. 4981,
hereby certify that this drawing has been
revised in accordance with information furnished
by K.N.C. Inc. Field surveys and that both the
revisions and field surveys were done under
my personal direction and control.

Mr. Claude G. F.

[illegible][illegible]

PROFILE	SURVEYED	STRUCTURE NOTAINS CHWD
	PLOTTED	
	GRADES CHECKED	
	B. M. NOTED	
	DATE	

PLAN	SUMMERED		
	PLOTTED		
	ALIGNMENT CHECKED		
	BY OF WAY CHECKED		
	NO		
		BY	DATE

PLATE 1 SINGLE PLAN - PROFILE - DOTTED
CHARLES BEILING COMPANY

1425

