




PLAN
SCALE: 1"=20'

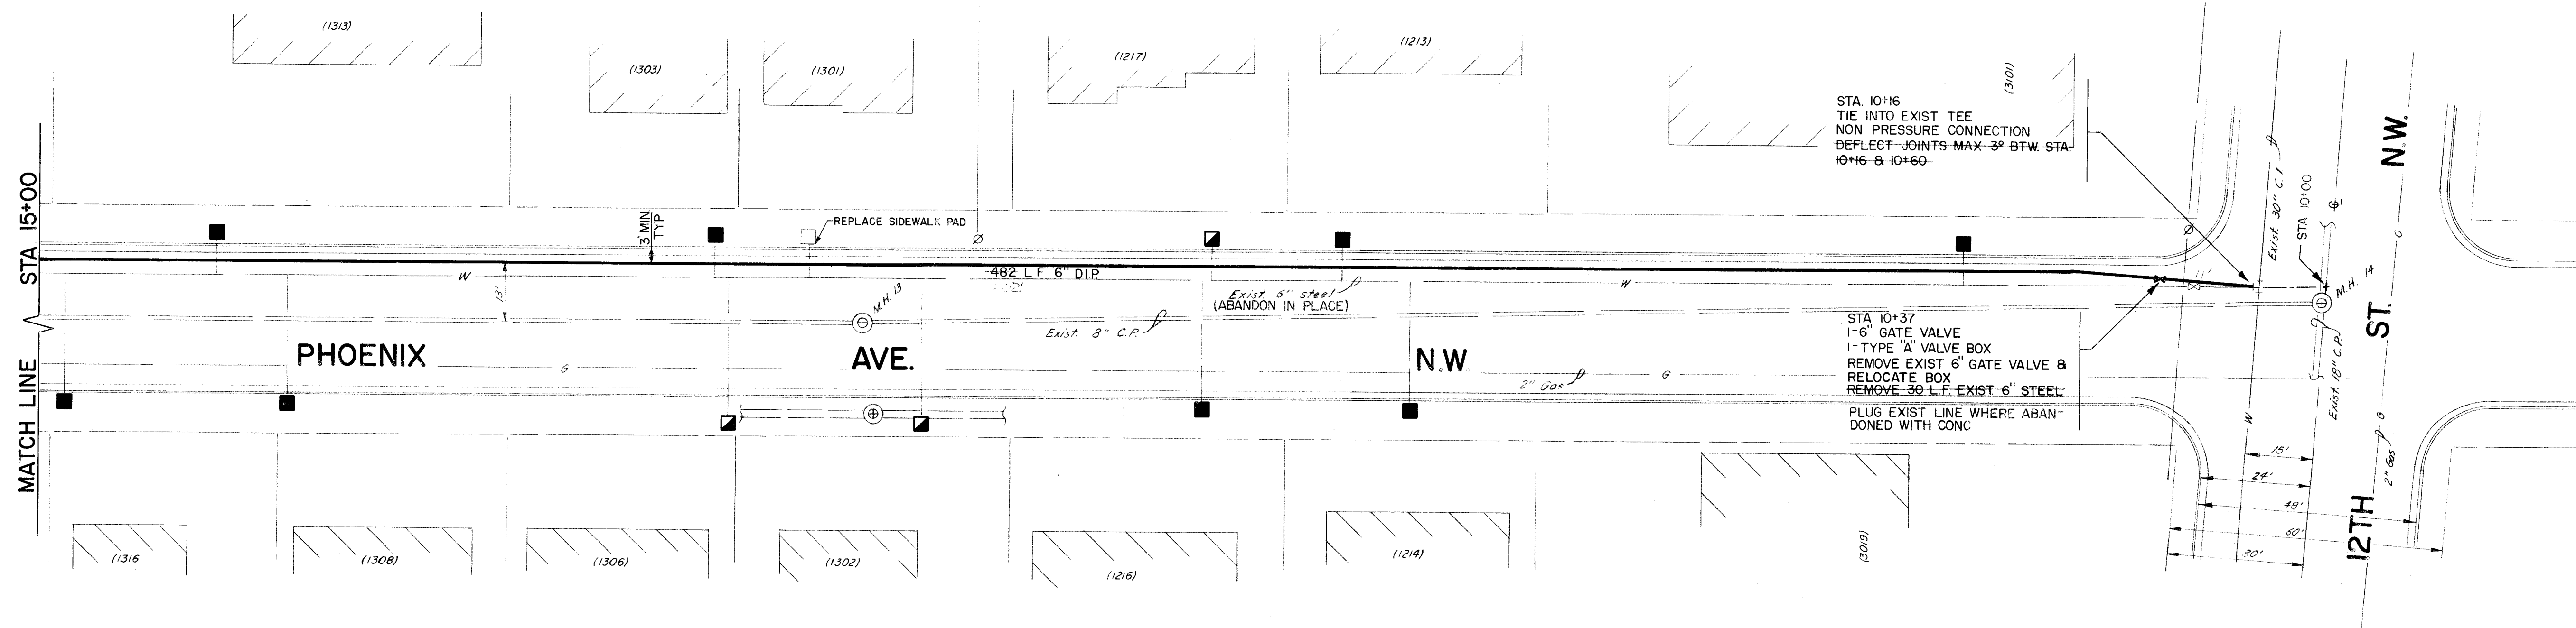

PLAN
SCALE: 1"=20'

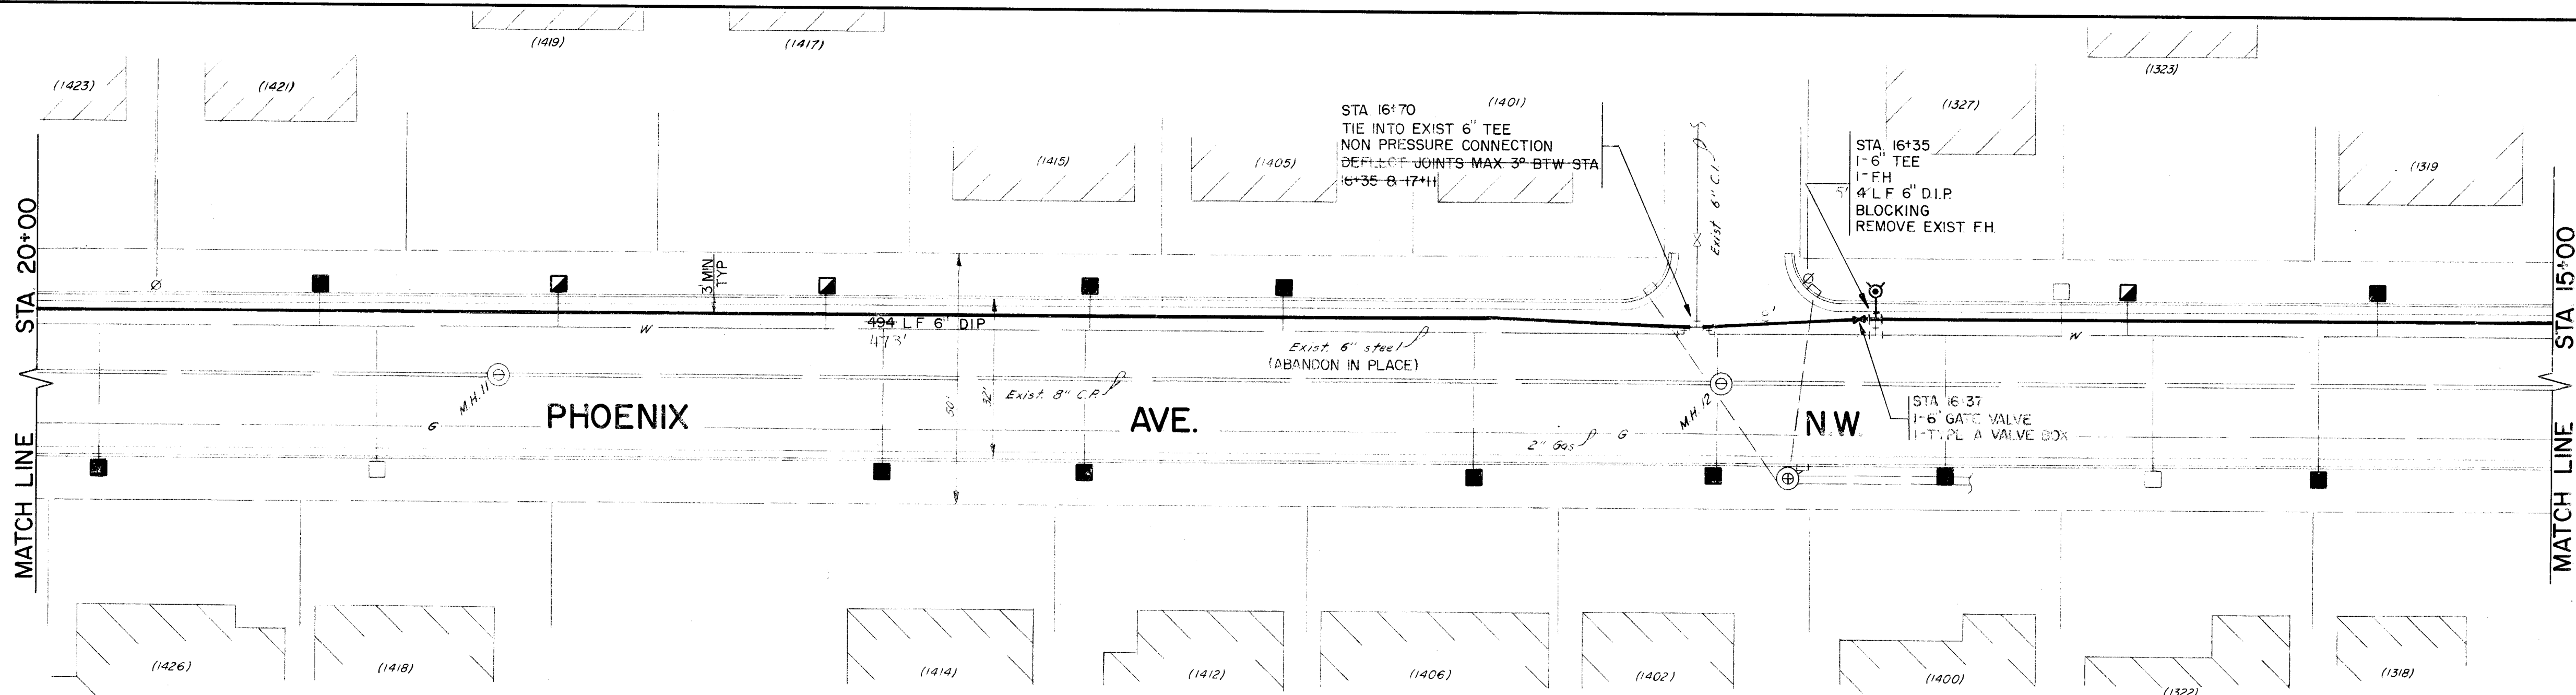

PLAN
SCALE: 1"=20'

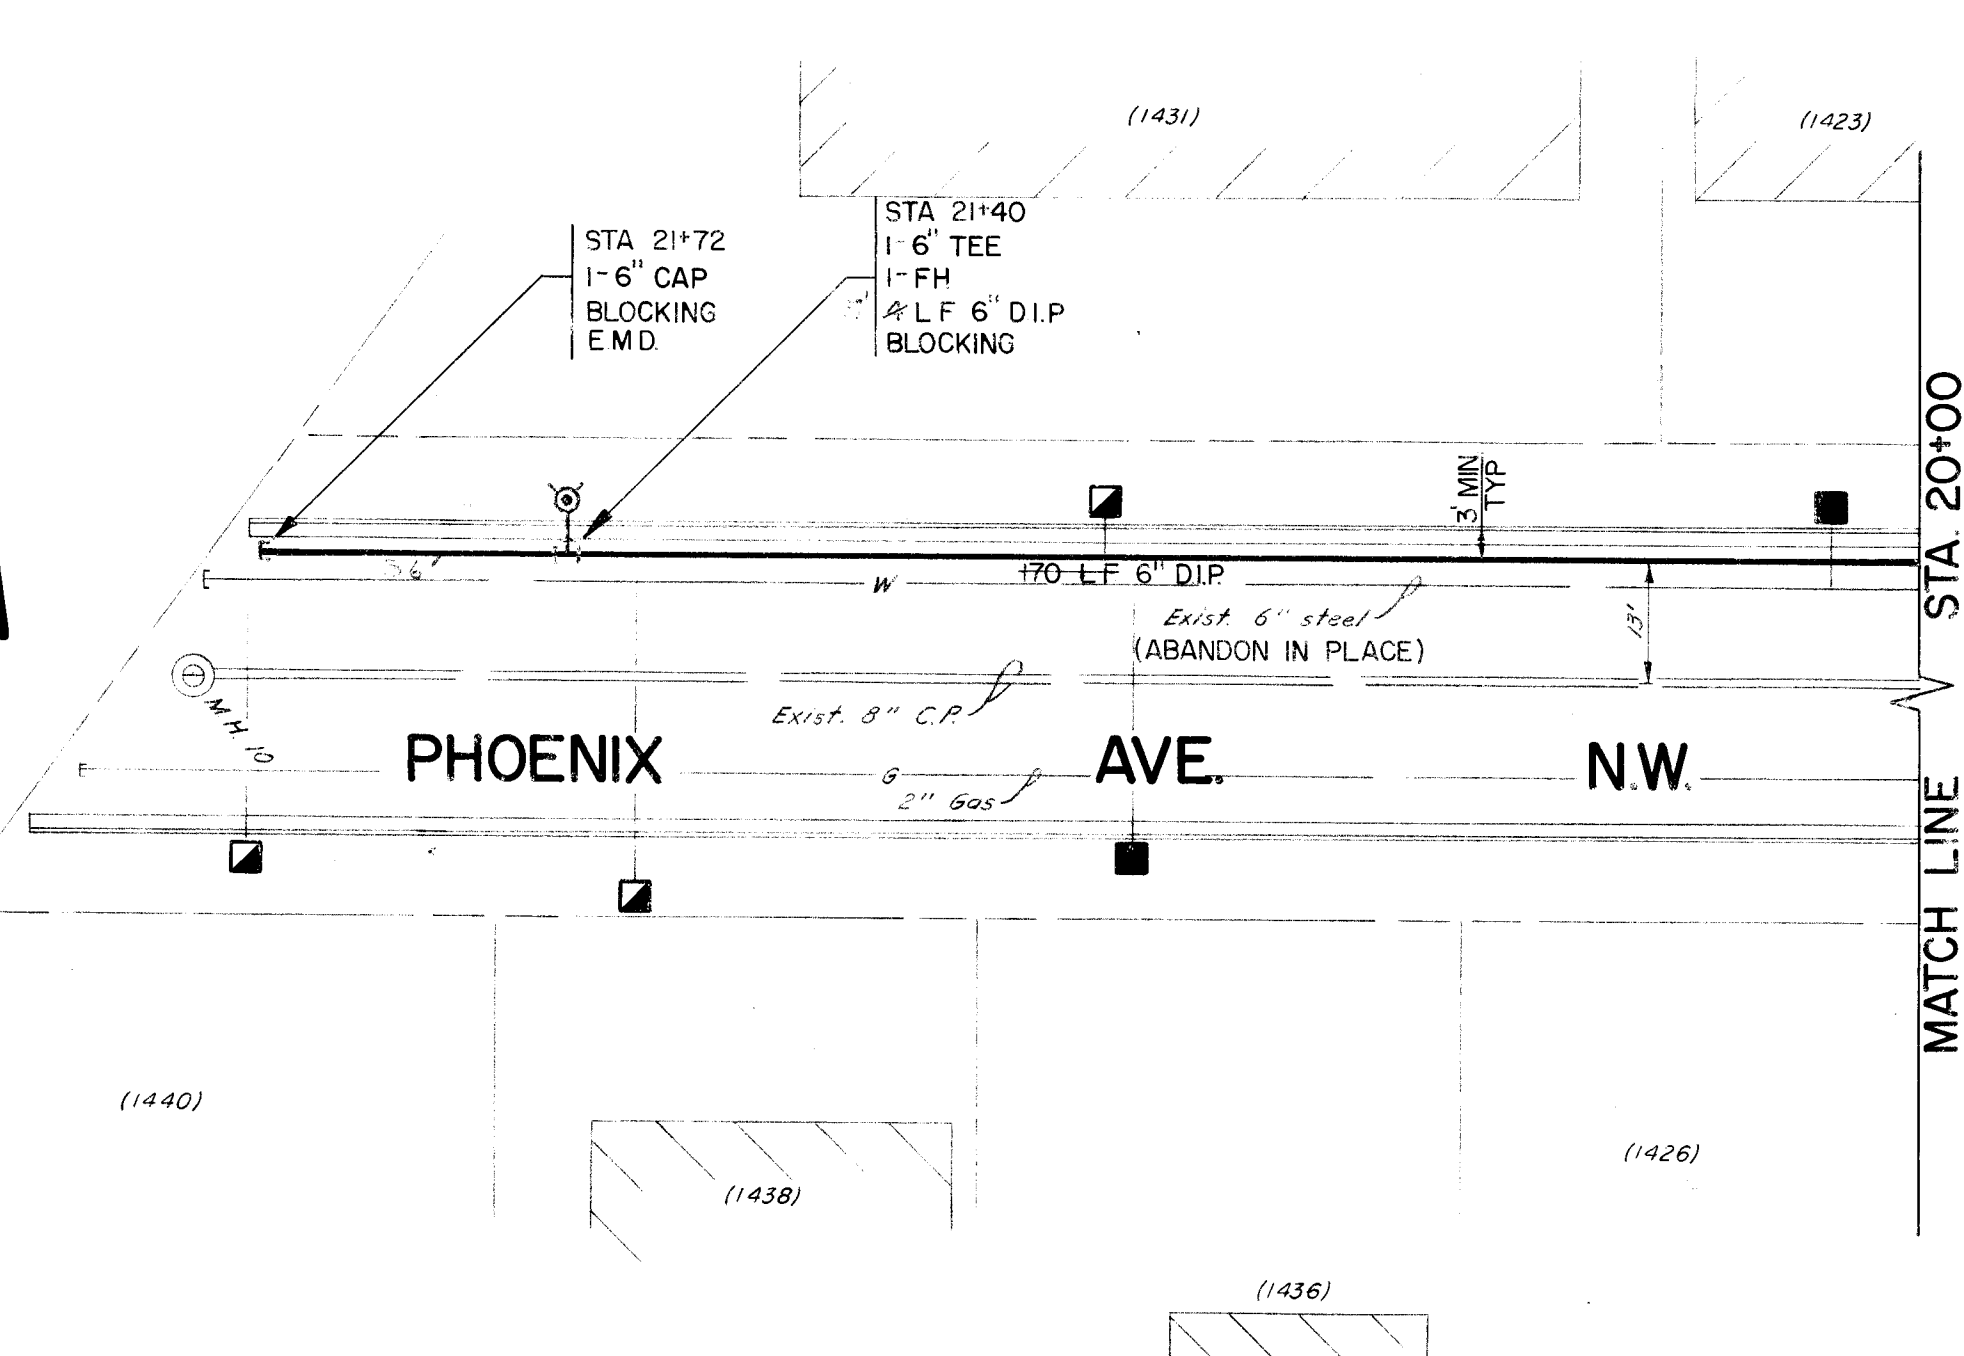

- NOTICE TO CONTRACTORS**
- 1) New Mexico Standards Specifications for Public Works Construction-1979 Edition will be referred to herein as the "Standard Specifications".
 - 2) All work detailed on these plans to be performed under contract shall, except as otherwise stated or provided for herein, be constructed in accordance with "Standard Documents for City-Wide Utilities and Sanitary Sewerage" and the Standard Specifications.
 - 3) Two working days prior to any excavation, contractor shall contact Line Locating Service, 765-1234, for location of existing utilities.
 - 4) Prior to construction, the contractor shall excavate and verify the horizontal and vertical location of all obstructions. Should a conflict exist, the contractor shall notify the engineer or surveyor so that the conflict can be resolved with minimum amount of delay.


- THE FOLLOWING NOTES APPLY WHEN CHECKED**
- ☒ All utilities and utility service lines shall be installed prior to paving.
 - ☒ All construction shall be according to specified street use.
 - ☐ Total cost requirements shall be determined by the City Engineer.
 - ☐ Sidewalk and wheelchair ramps within the curb return shall be constructed whenever a new curb return is constructed.
 - ☐ If cut is necessary for a driveway, the driveway shall be constructed prior to acceptance of the curb and gutter.
 - ☐ Storm drainage facilities shall be completed prior to final acceptance.

LEGEND

- REPLACE EXISTING BOX WITH NEW BOX AND PLATE. REPAIR SIDEWALK
- ▣ RELOCATE METER INTO SIDEWALK AREA, AND INSTALL NEW BOX AND PLATE
- EXISTING METER
- ⊗ UTILITY POLE
- ⊕ EXISTING SANITARY SEWER MANHOLE
- ⊕ EXISTING STORM DRAIN MANHOLE

NOTES

- 1) TRANSFER ALL 3/4" WATER SERVICE LINES TO NEW 6" WATER LINE ON PHOENIX AVE.
- 2) MINIMUM 3' COVER OVER NEW 6" WATERLINE FROM FLOWLINE OF GUTTER.
- 3) EXISTING METERS & BOXES TO REMAIN IN PLACE UNLESS OTHERWISE DESIGNATED.

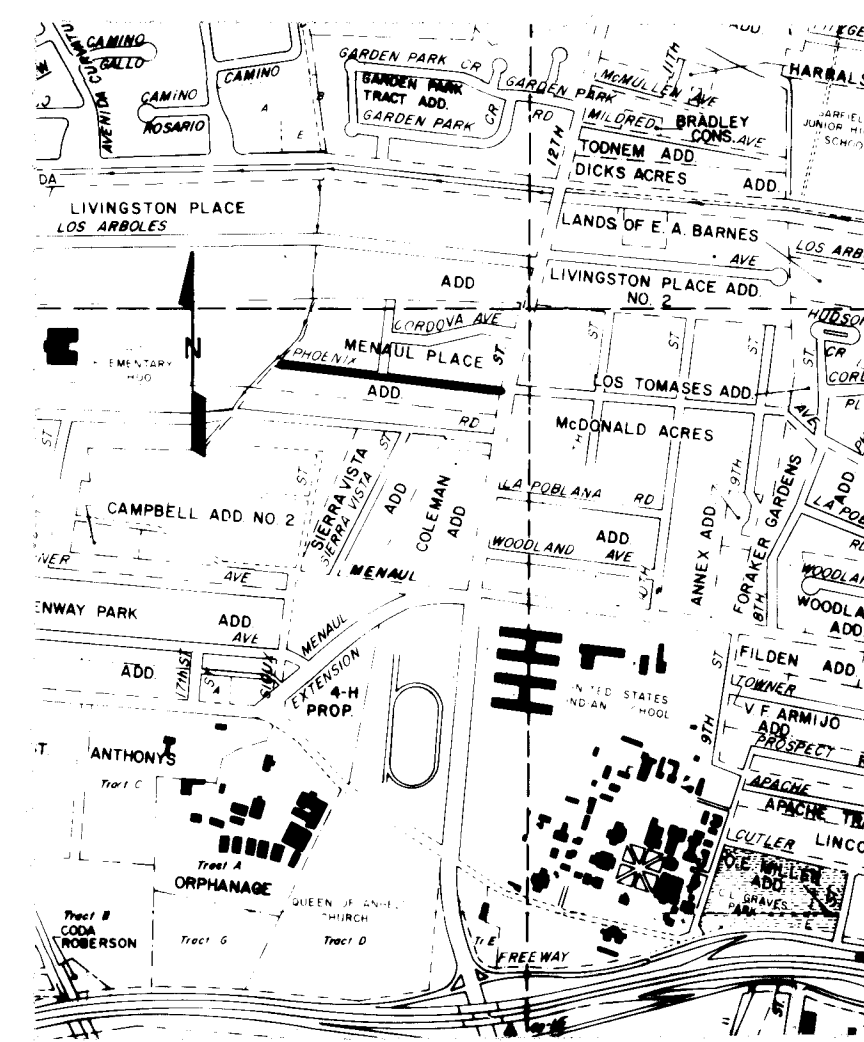

David M. Marshall
DATE 4/11/82

EMERGENCY WATERLINE REPLACEMENT
PHOENIX AVE. NW
FROM 12TH ST WEST TO DITCH

APPROVED FOR CONSTRUCTION
Richard S. Allen 7/21/82
CITY ENGINEER

BN: 8 644 ELEV: 4966 39
A SQUARE CUT IN THE SIDEWALK IN THE SE COR
OF THE INTERSECTION OF 12TH ST & CANDELARIA RD NW

4/82
4/82
4/82
TYASERA
TYASERA
WF ZIMMERMAN