

1+03
STA. 1+00, 5' R.
REMOVE EXIST. 6" CAP AND BLOCKING &
CONNECT NEW 6" WATER
MAIN. PLACE EXIST. 6" CAP
ON END OF NEW LINE.

PROBABLE EXISTENCE OF SEWER SERVICE
TO BACK OF CURB AS INDICATED BY AN
'S' CHISELED ON TOP OF CURB 39.5' NORTH
OF S.W. PROP. COR. MARK ON TOP OF CURB.
IF CONTRACTOR CANNOT VERIFY EXISTENCE
OF SERVICE, THEN 4" SEWER SERVICE SHALL
BE CONSTRUCTED AND CONNECTED TO EXIST.
8" SEWER LINE IN JUAN TABO BLVD IF
NECESSARY TO REMOVE & REPLACE
PAVEMENT, MEDIAN CURB OR STD. CURB
& GUTTER, CONTRACTOR MUST SUBMIT
A BARRICADE PLAN & OBTAIN A
BARRICADE PERMIT PRIOR TO
CONSTRUCTION

HORI. 1" = 20'
VERT. 1" = 5'

NOTICE TO CONTRACTORS

1. New Mexico Standard Specifications for Public Works Construction -1979 Edition will be referred to hereon as the "Standard Specification".
2. All work detailed on these plans to be performed under contract shall, except as otherwise stated or provided for hereon, be constructed in accordance with "Contract Documents for City-Wide Utilities and Cash Paving No.30 and the Standard Specification."

- * All utilities and utility service lines shall be installed prior to paving.
- * Backfill compaction shall be according to specified street use.(ARTERIAL)
- * Tack coat requirements shall be determined by the City Engineer.
- Sidewalk and wheelchair ramps within the curb returns shall be constructed wherever a new curb return is constructed.
- If curb is depressed for a driveway, the driveway shall be constructed prior to acceptance of the curb and gutter.
- * Two working days prior to any excavation, contractor must contact Line Locating Service, 765-1234, for location of existing utilities.
- * Prior to construction, the contractor shall excavate and verify the horizontal and vertical locations of all obstructions. Should a conflict exist, the contractor shall notify the engineer or surveyor so that the conflict can be resolved with a minimum amount of delay.


ESTIMATED QUANTITIES

6" A.C. WATER	100	LF
1" WATER SERVICE	5	LF
METER BOX	1	EA
4" SEWER SERVICE	33	LF
REM. & REPL. WALK	60	SF

SEWER SERVICE NOT PRESENT IN JUAN TABO


4" SEWER SERVICE	75	LF
REM. & REPL. ART. PAVE	21	SY
REM. & REPL. C & G	10	LF
REM. & REPL. ASPH. CURB (MEDIAN)	10	LF

JUAN TABO BLVD.

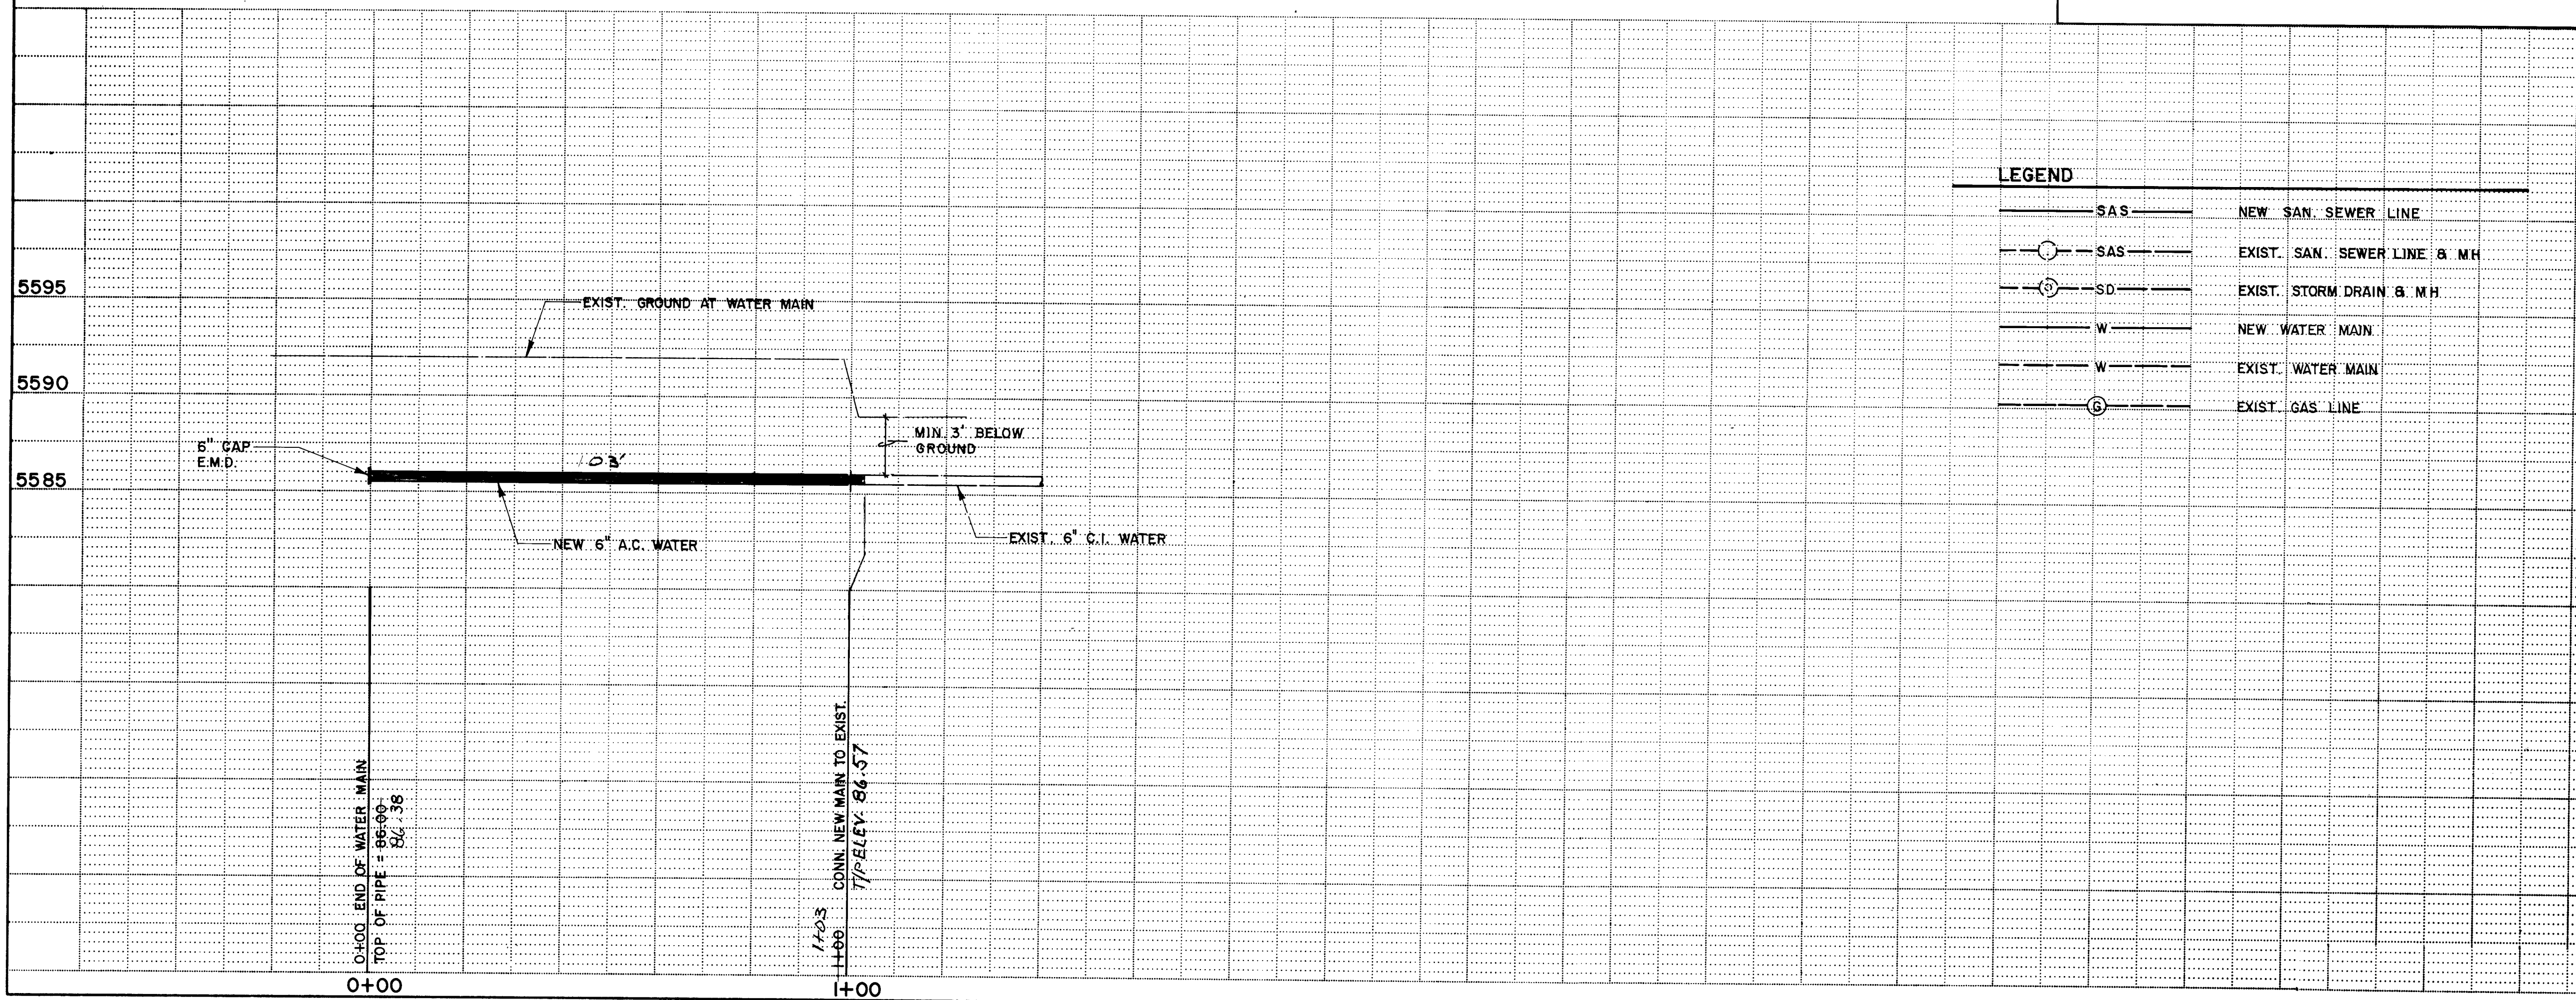

LEGEND

SAS	NEW SAN. SEWER LINE
SAS	EXIST. SAN. SEWER LINE & MH
SD	EXIST. STORM DRAIN & MH
W	NEW WATER MAIN
W	EXIST. WATER MAIN
G	EXIST. GAS LINE

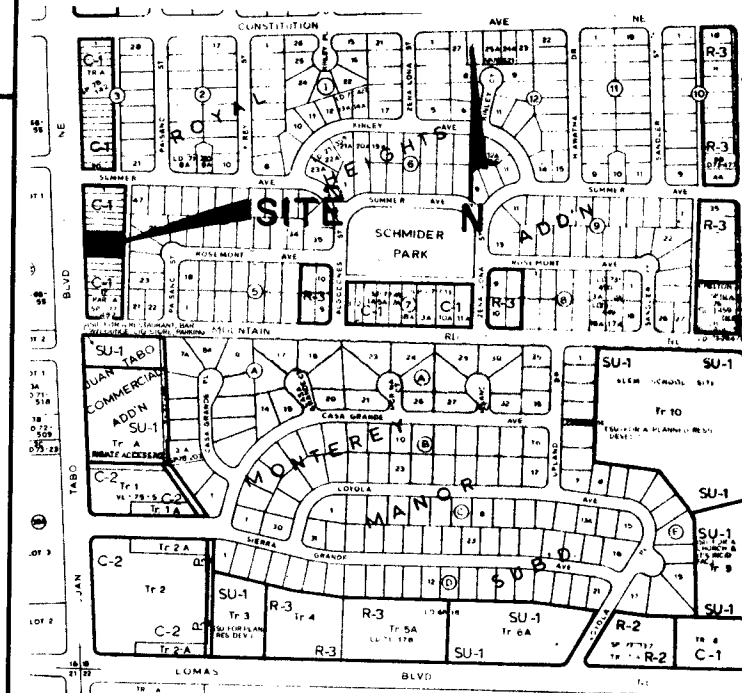

VICINITY MAP

NOTES

- STATIONING IS ALONG EAST R/W OF JUAN TABO BLVD.
- CONTRACTOR TO FIELD VERIFY DEPTH OF EXISTING 6" WATER MAIN.
- SEE CITY DWG. NO. W-158-71 FOR EXIST. 6" C.I. WATER MAIN.
- SEE CITY DWG. E-184 a FOR EXISTING 8" SANITARY SEWER LINE INFORMATION.
- SEE SHEET 12 OF 21 OF CITY PAVING DISTRICT NO.140 FOR PAVING AND STORM DRAIN INFORMATION.
- FIRE HYDRANT AT JUAN TABO BLVD AND MOUNTAIN RD. 230' SOUTH OF S.W. PROP. COR. OF LOT 11

AS BUILT INFORMATION	CONTRACTOR	DATE
WORK	5-J-22 A	5585.052
STAKED BY	SQ. CHISELED IN S.S.E. CURB RETURN AT	
ACCEPTANCE BY	JUAN TABO & MOUNTAIN	
DATE		
REVISIONS		
NO.	DATE	BY
1	1/10/82	



ENGINEER'S SEAL	REGISTERED PROFESSIONAL
CHRISTOPHER L. KELSO	REGISTERED PROFESSIONAL
1053	

REVISIONS	DESIGN
NO.	DATE
1	1/10/82

DESIGNED BY	DATE
D.E.C.	6-82

DRAWN BY	DATE
D.E.C.	6-82

CHECKED BY	DATE
C.L.W.	6-82

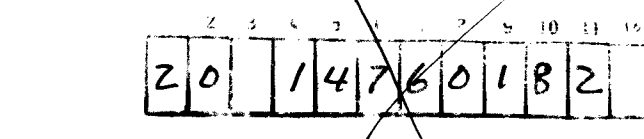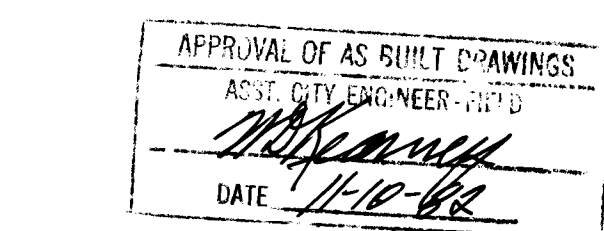

APPROVALS	ENGINEER	DATE
City Engineer	Richard S. Keller	8/2/82
A.C.E. - Design		
A.C.E. - Hydrology		

APPROVALS	ENGINEER	DATE
City Engineer	Richard S. Keller	8/2/82
A.C.E. - Design		
A.C.E. - Hydrology		

TITLE:	6" WATER LINE EXTENSION
ALONG JUAN TABO BLVD., BETWEEN MOUNTAIN RD. AND SUMMER AVE. N.E.	

APPROVALS	ENGINEER	DATE
City Engineer	Richard S. Keller	8/2/82
A.C.E. - Design		
A.C.E. - Hydrology		

DRAWING NO.	1476
MAP NO.	J-22 S
SHEET	1
OF	1