
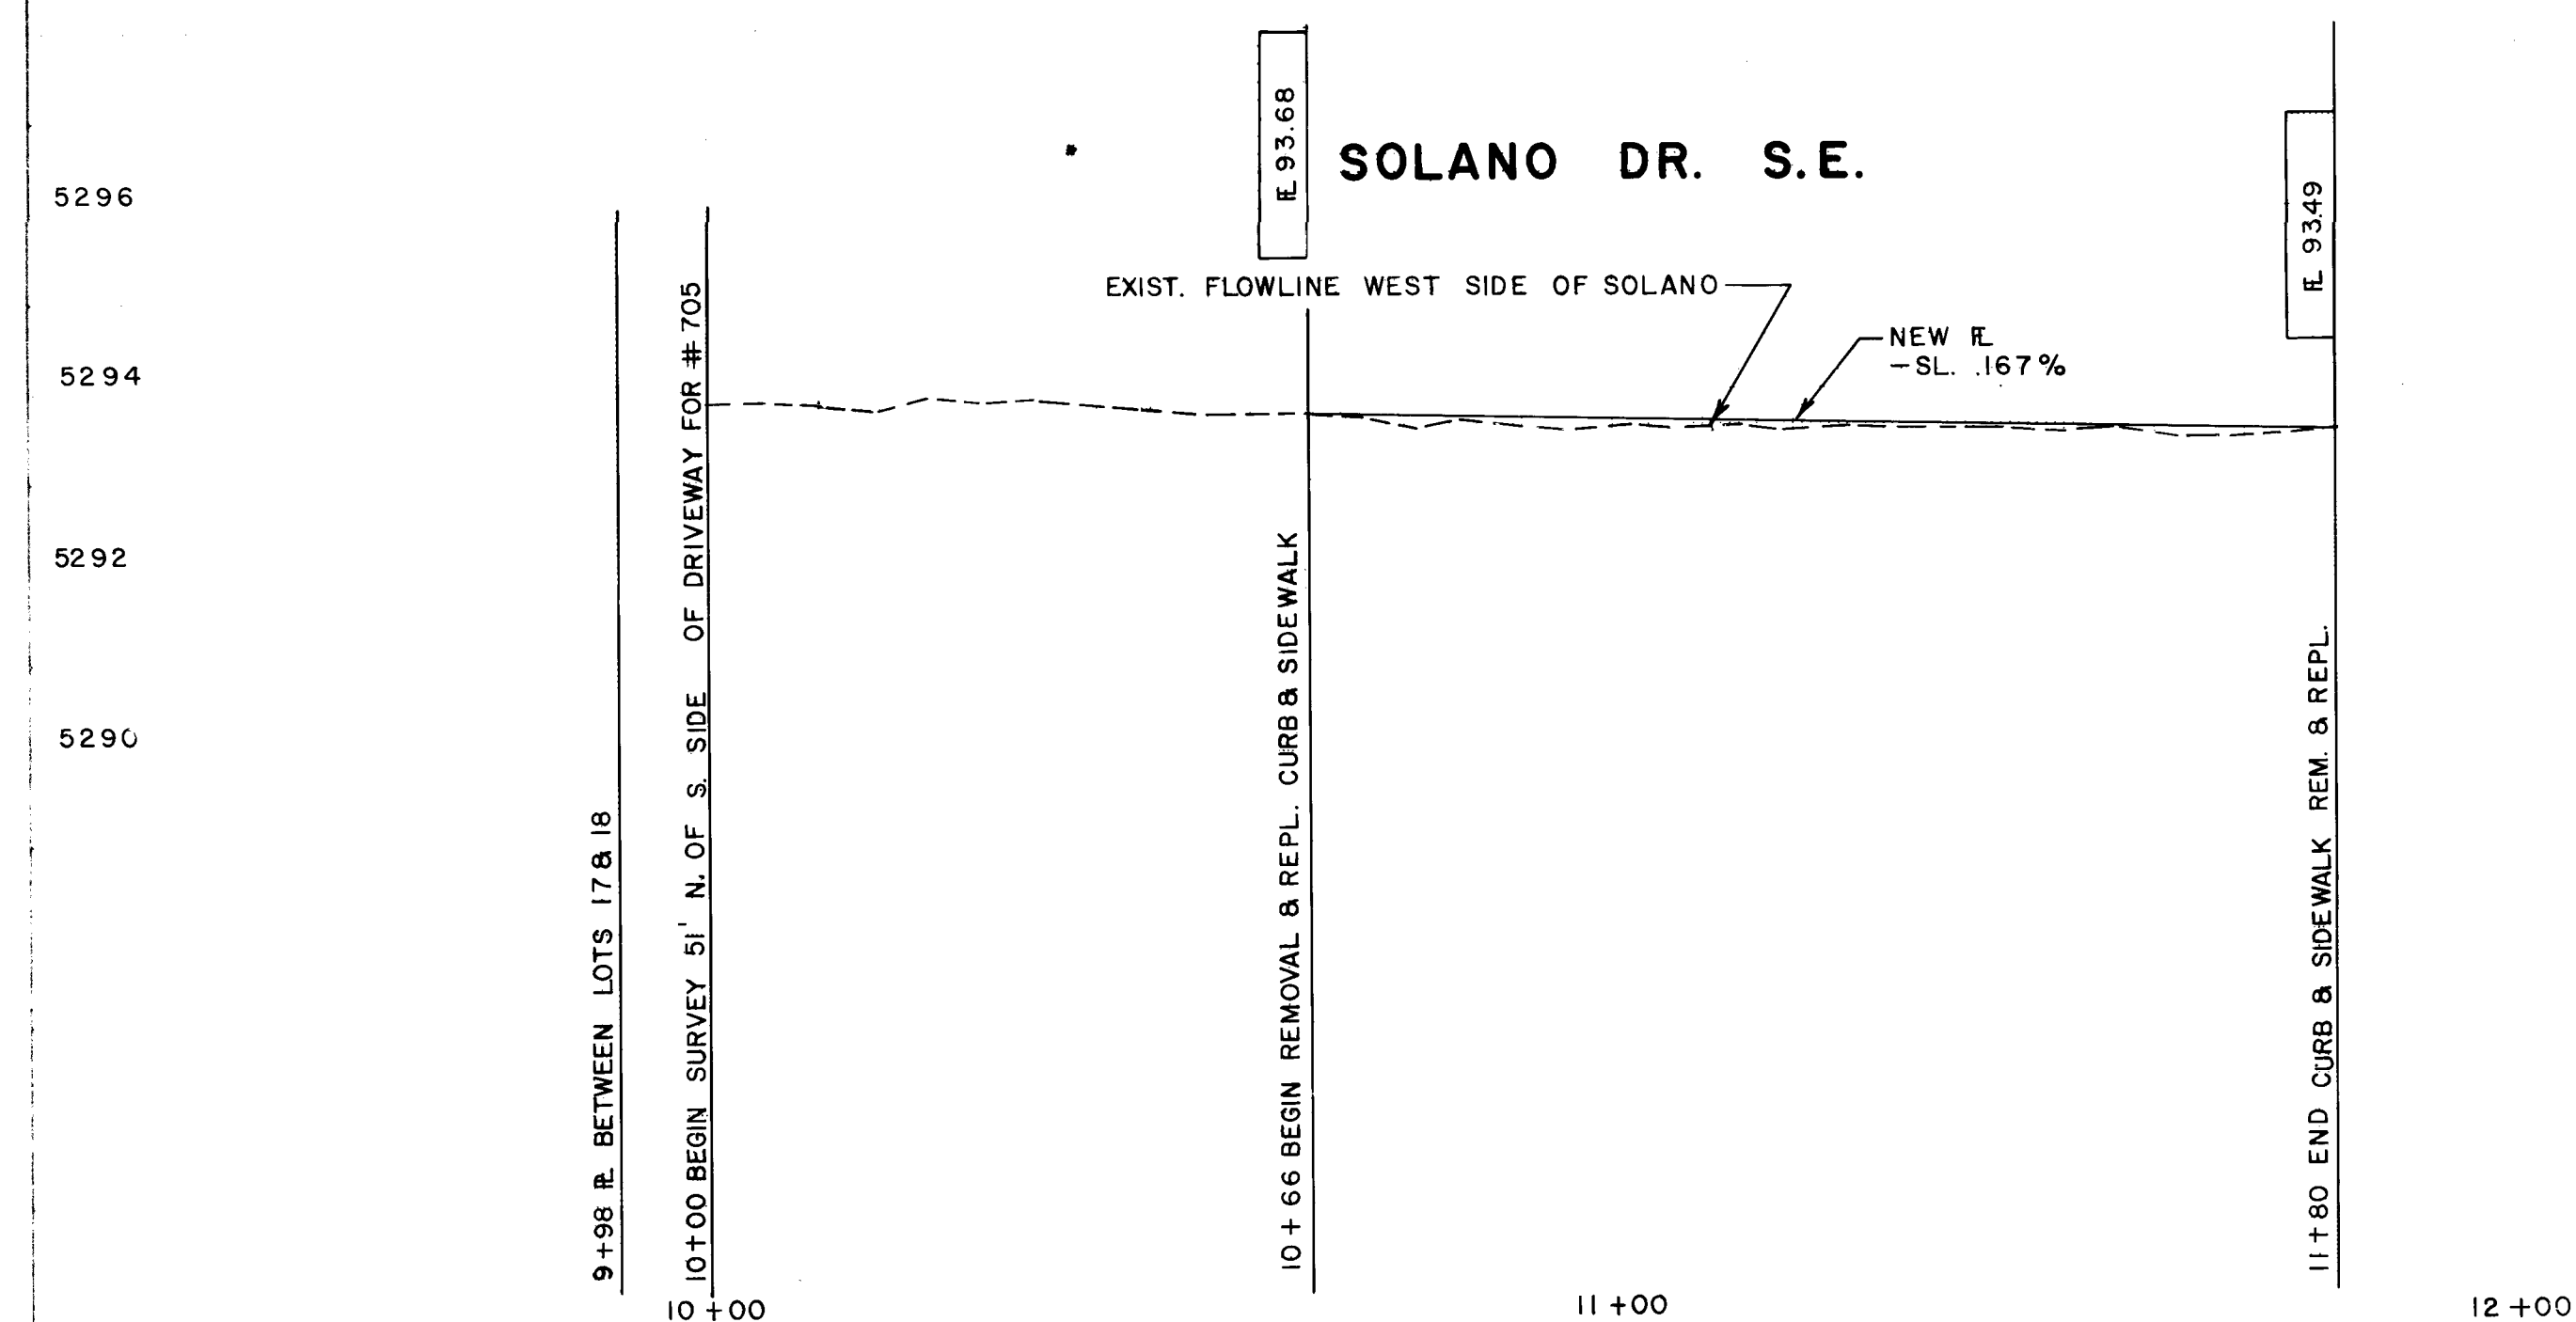
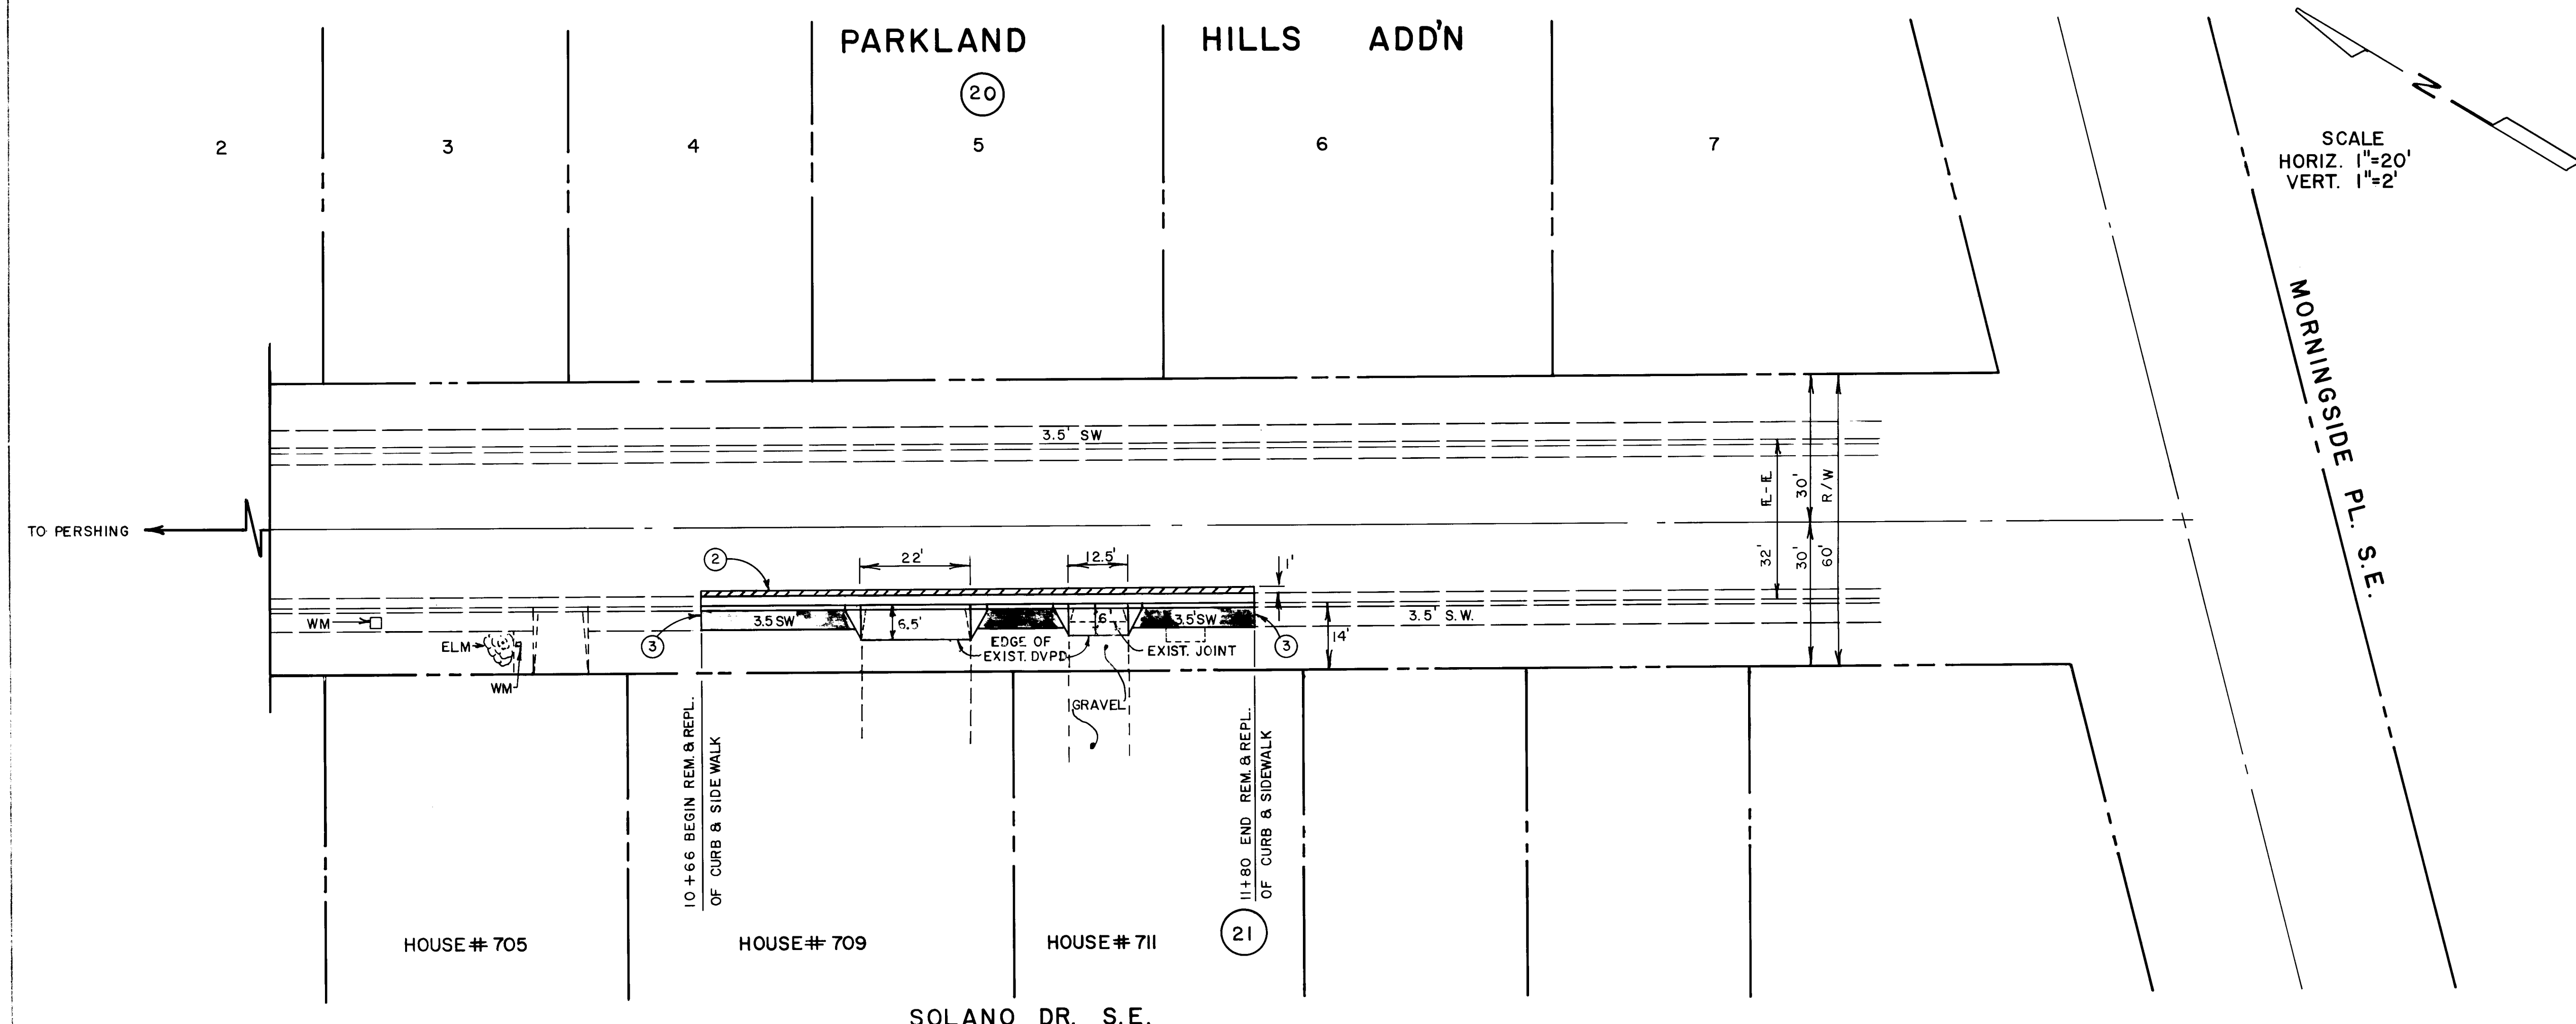


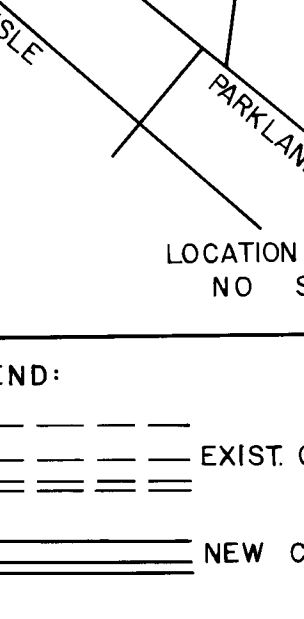

 LOCATION MAP NO SCALE		AS BUILT INFORMATION	
LEGEND: ===== EXIST. CURB & GUTTER & SIDEWALK ===== NEW CURB & GUTTER ===== 3.5' SW NEW SIDEWALK ===== REPLACE PAVING TO MATCH NEW CURB. 5/17 ELEV 5295.17 ☐ OUT WNW RET PURSHING & RIDGECREST S.E.		AS BUILT INFORMATION DATE: 10/21/02 FILE: 10-21-02 REVISION: 10-21-02 CHECKED BY: R. F. FENNETT DATE: 10/21/02 DATE: 10/21/02 FILE: 10-21-02 REVISION: 10-21-02 CHECKED BY: R. F. FENNETT DATE: 10/21/02	
"NOTICE TO CONTRACTORS" 1) New Mexico Standard Specification for Public Works Construction - 1979 Edition will be referred to hereon as the "Standard Specification." 2) All work detailed on these plans to be performed under contract shall, except as otherwise stated or provided for hereon, be constructed in accordance with "Contract Documents for City-Wide Utilities and Cash Paving No. 31" and the "Standard Specification." 3) Two working days prior to any excavation, contractor must contact Line Locating Service, 703-1234, for location of existing utilities. 4) Prior to construction, the contractor shall excavate and verify the horizontal and vertical locations of all obstructions. Should a conflict exist, the contractor shall notify the engineer or surveyor so that the conflict can be resolved with minimum amount of delay.		SURVEY INFORMATION FIELD NOTES BY NO. PS-29 DATE: 10/21/02	
THE FOLLOWING NOTES APPLY WHEN CHECKED ☐ All utilities and utility service lines shall be installed prior to paving. ☐ Backfill compaction shall be according to specified street use. ☒ Tack coat requirements shall be determined by the City Engineer (RESIDENTIAL) ☒ Sidewalks and wheelchair ramps within the curb returns shall be constructed wherever a new curb return is constructed. ☒ If curb is depressed for a driveway, the driveway shall be constructed prior to acceptance of the curb and gutter. ☐ All storm drainage facilities shall be completed prior to final acceptance.		ENGINEER'S SEAL DESIGNED BY: S. MIRANDA DRAWN BY: A. SALAS CHECKED BY: R. F. FENNETT DATE: 10/21/02 DATE: 10/21/02	
NOTES: ① REMOVE CURB, SIDEWALK AND DRIVEPADS FROM STA. 10+66 TO 11+80 AND REPLACE TO GRADES SHOWN. ② REMOVE AND REPLACE 1' RESIDENTIAL PAVEMENT TO MATCH NEW GRADES. ③ MATCH EXISTING.		REVISIONS NO. DATE	
APPROVED FOR CONSTRUCTION <i>2854</i> 10/25/02		DESIGNED BY: S. MIRANDA DRAWN BY: A. SALAS CHECKED BY: R. F. FENNETT DATE: 10/21/02	
CITY OF ALBUQUERQUE MUNICIPAL DEVELOPMENT DEPARTMENT ENGINEERING DIVISION			
TITLE CURB REPLACEMENT AT 709 SOLANO DR. S.E.			
APPROVALS CITY ENGINEER: <i>RAJ</i> A.C.E. Design: <i>SR. J. G. J. G.</i> A.C.E. Hydrology: <i>RAJ</i> Street Maintenance: <i>RAJ</i>	ENGINEER DATE: 10/21/02	APPROVALS DATE: 10/21/02	ENGINEER DATE: 10/21/02
DRAWING NO. 1479		MAP NO. L-17	
STREET MAINTENANCE		STREET MAINTENANCE	