


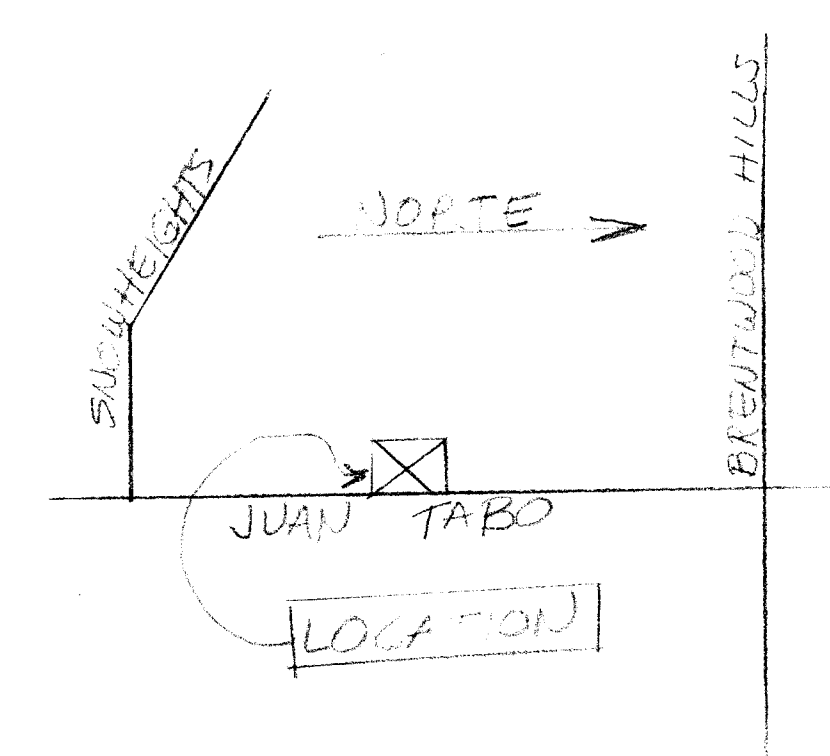

NOTES:
1. For construction and inspection see
City of Albuquerque standard details
for fire hydrant installation.
2. F.H.V.E. to be 5" above existing curb.

LEGEND:

- Proposed fire hydrant
- W— Existing Water Line
- SAS— Existing Sewer Line
- G— Existing Gas Line

**48 HOURS PRIOR TO ANY
EXCAVATION, CONTRACTOR
MUST CONTACT LINE AND
CABLE LOCATING SERVICE,
765-1234, FOR LOCATION
OF EXISTING UTILITIES.**

SCANNED BY
BY LASON

APPROVAL OF AS BUILT DRAWINGS
ASST. CITY ENGINEER - FIELD
[Signature]
DATE 11-26-82

1	2	3	4	5	6	7	8	9	10	11
23				148			0177			

APPROVED FOR
CONSTRUCTION
[Signature] 3-10-71
CITY ENGINEER DATE

CITY OF ALBUQUERQUE PUBLIC WORKS DEPARTMENT ENGINEERING DIVISION					
TITLE: PROPOSED FIRE HYDRANT ON JUAN TABO BLVD. SNOW HEIGHTS ADD. BLK. 95A					
APPROVALS	ENGINEER	DATE	APPROVALS	ENGINEER	DATE
City Engineer	<i>[Signature]</i>	8-12-77	Liquid Waste	<i>[Signature]</i>	9/26/77
A.C.E.-Design	<i>[Signature]</i>	8-22-77	Traffic		
A.C.E.-Roadway			Water	<i>[Signature]</i>	9/26/77
DRAWING NO. W-148-77			SHEET OF		

[illegible]