



PLAN	BY	DATE
SURVEYED		
GRADES CHECKED		
ALIGNMENT CHECKED		
RT OF WAY CHECKED		
NOTE BOOK NO.		

PROFILE	BY	DATE
SURVEYED		
GRADES CHECKED		
STRUCTURE NOTATIONS CHKD		
NOTE BOOK NO.		

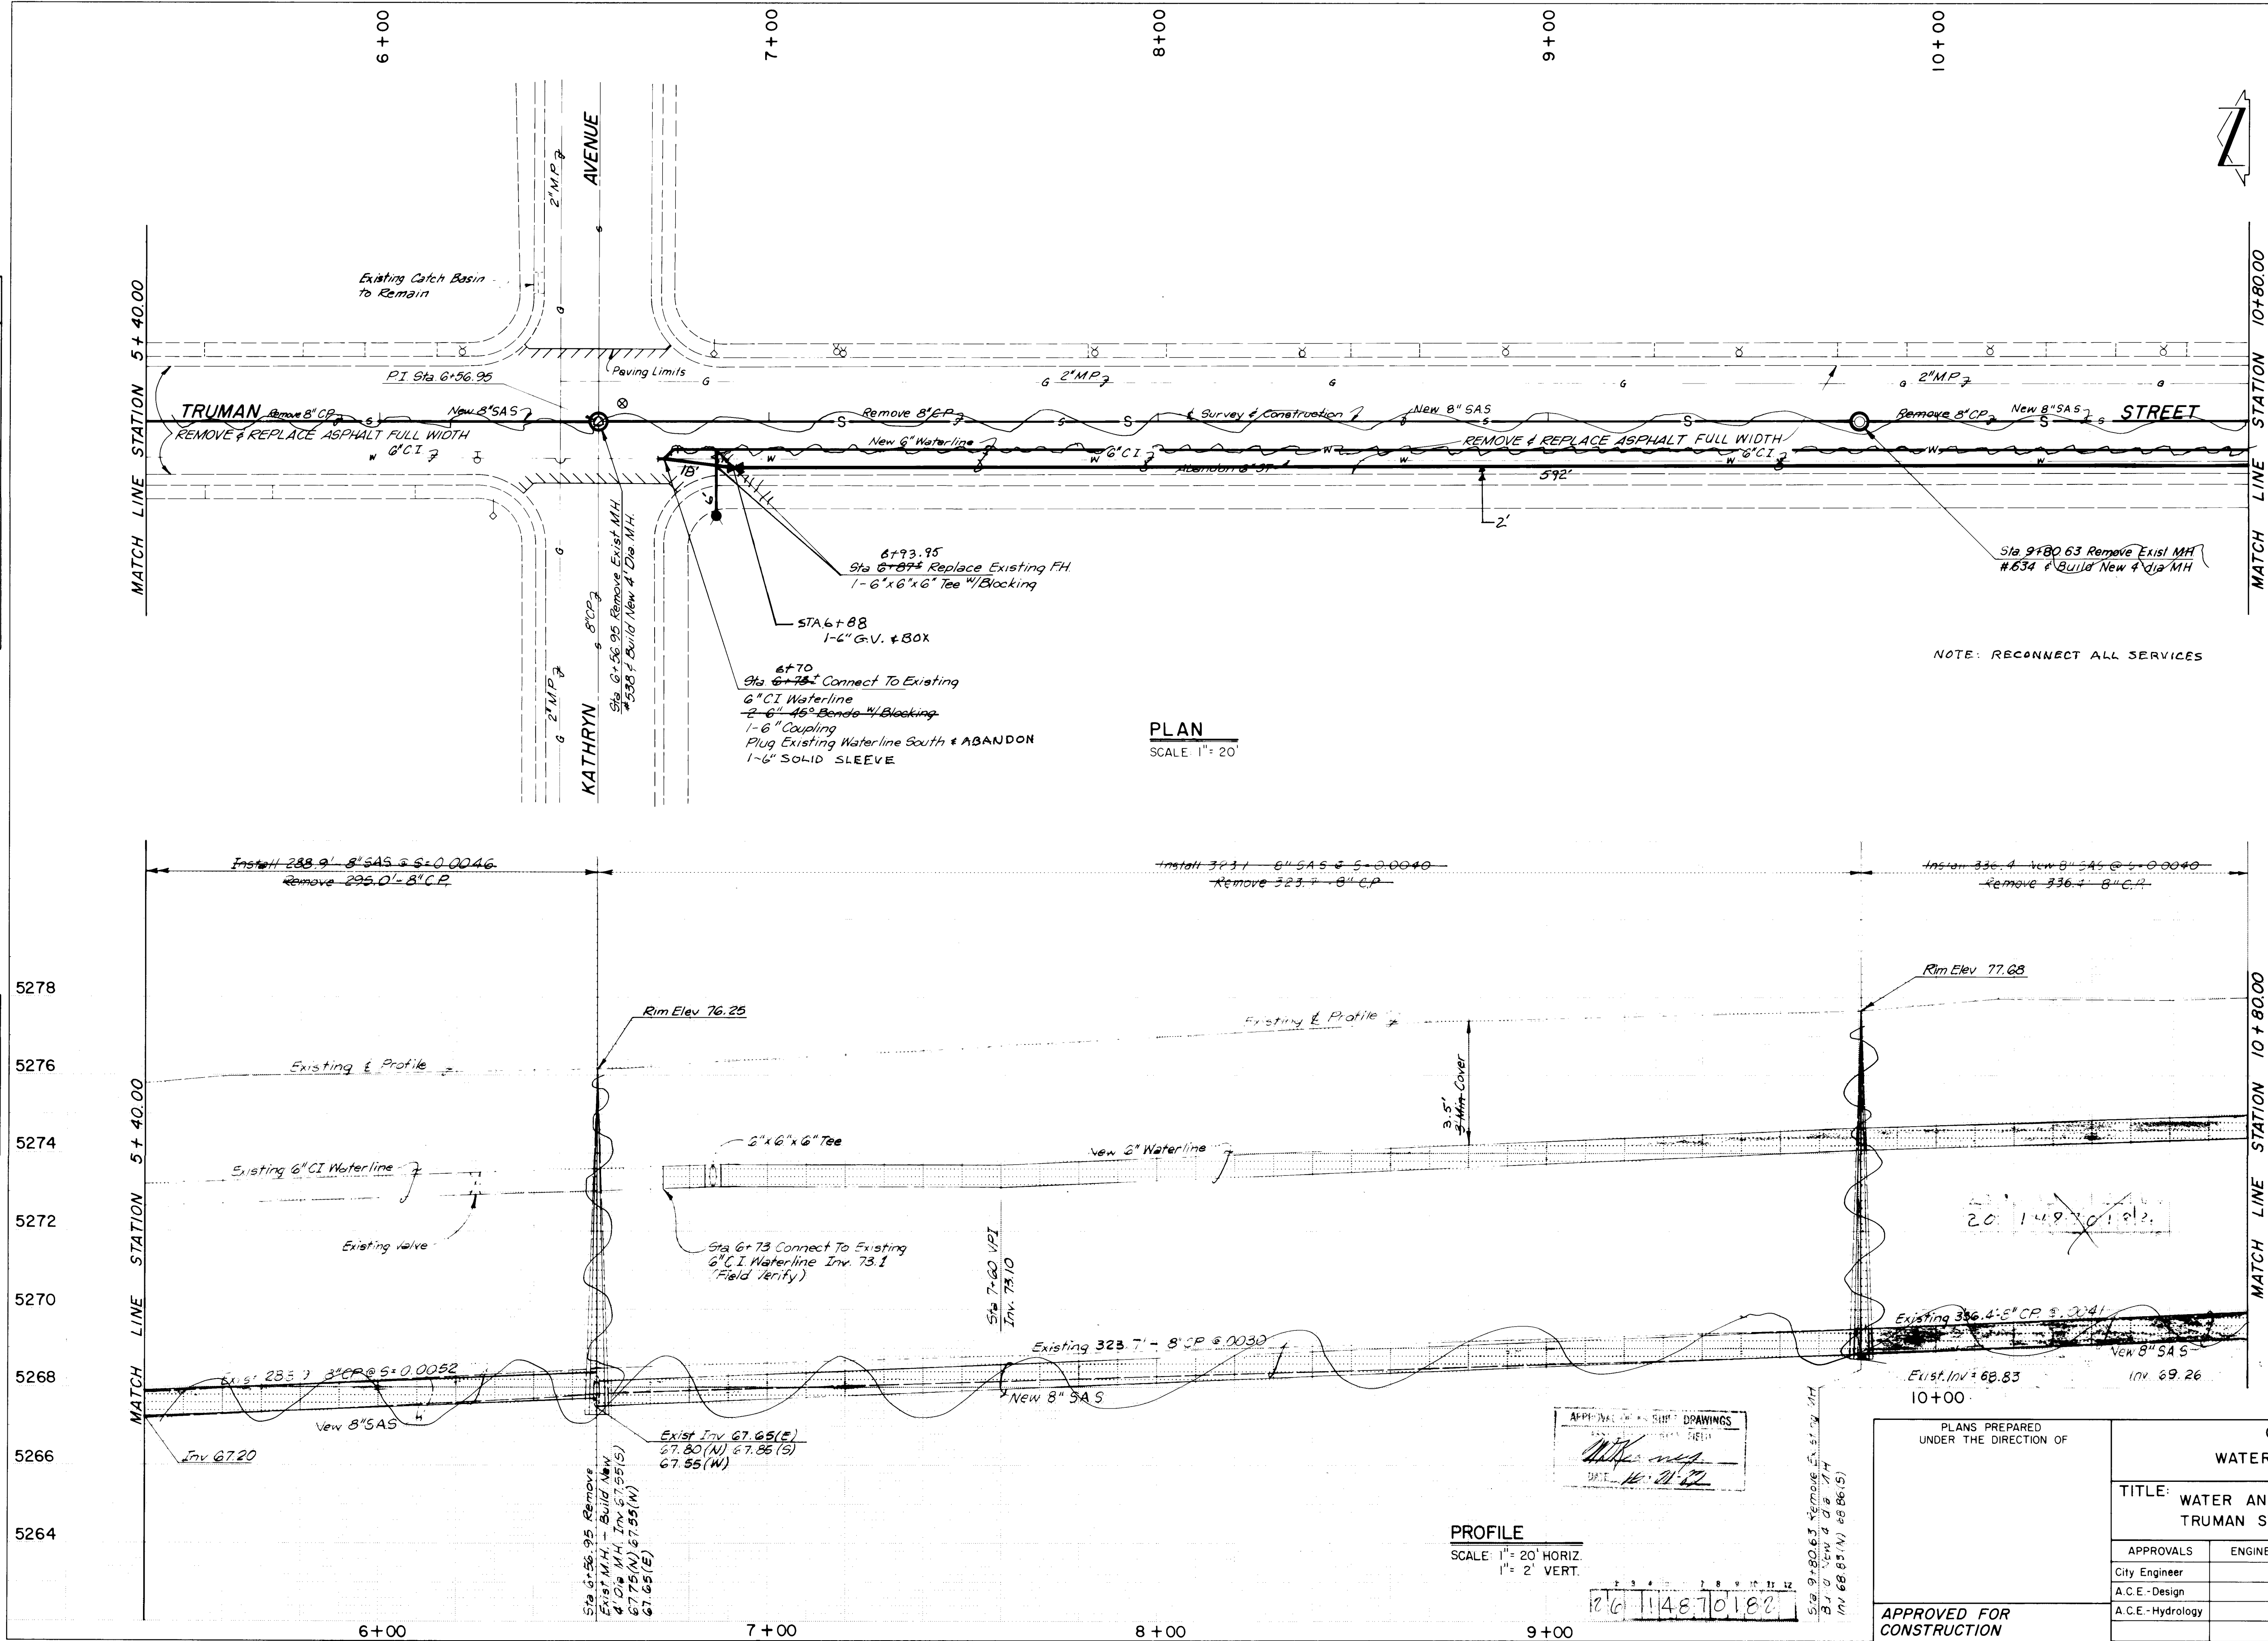

PLAN
SCALE 1" = 20'

PROFILE
SCALE: 1" = 20' HORIZ
1" = 2' VERT.


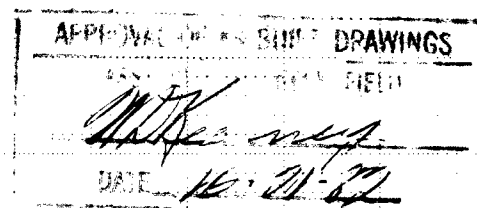


126-114870182

PLANS PREPARED UNDER THE DIRECTION OF			CITY OF ALBUQUERQUE WATER RESOURCES DEPARTMENT		
TITLE: WATER AND SEWER REPLACEMENT TRUMAN STREET					
APPROVALS	ENGINEER	DATE	APPROVALS	ENGINEER	DATE
City Engineer			Liquid Waste		
A.C.E.-Design			Traffic		
A.C.E.-Hydrology			Water		
APPROVED FOR CONSTRUCTION			DRAWING NO. 1487		
CITY ENGINEER DATE			SHEET 1 OF 2		

PLAN	SURVEYED.....		BY	DATE
	PLOTTED.....			
	ALIGNMENT CHECKED.....			
	RT. OF WAY CHECKED.....			
NOTE BOOK				
NO.				

PROFILE	SURVEYED _____	BY _____	DATE _____
NOTE BOOK	PLOTTED _____		
N^{O.}	B. M.'S CHECKED B. M.* NOTED STRUCTURE NOTAT'NS CHK'D		

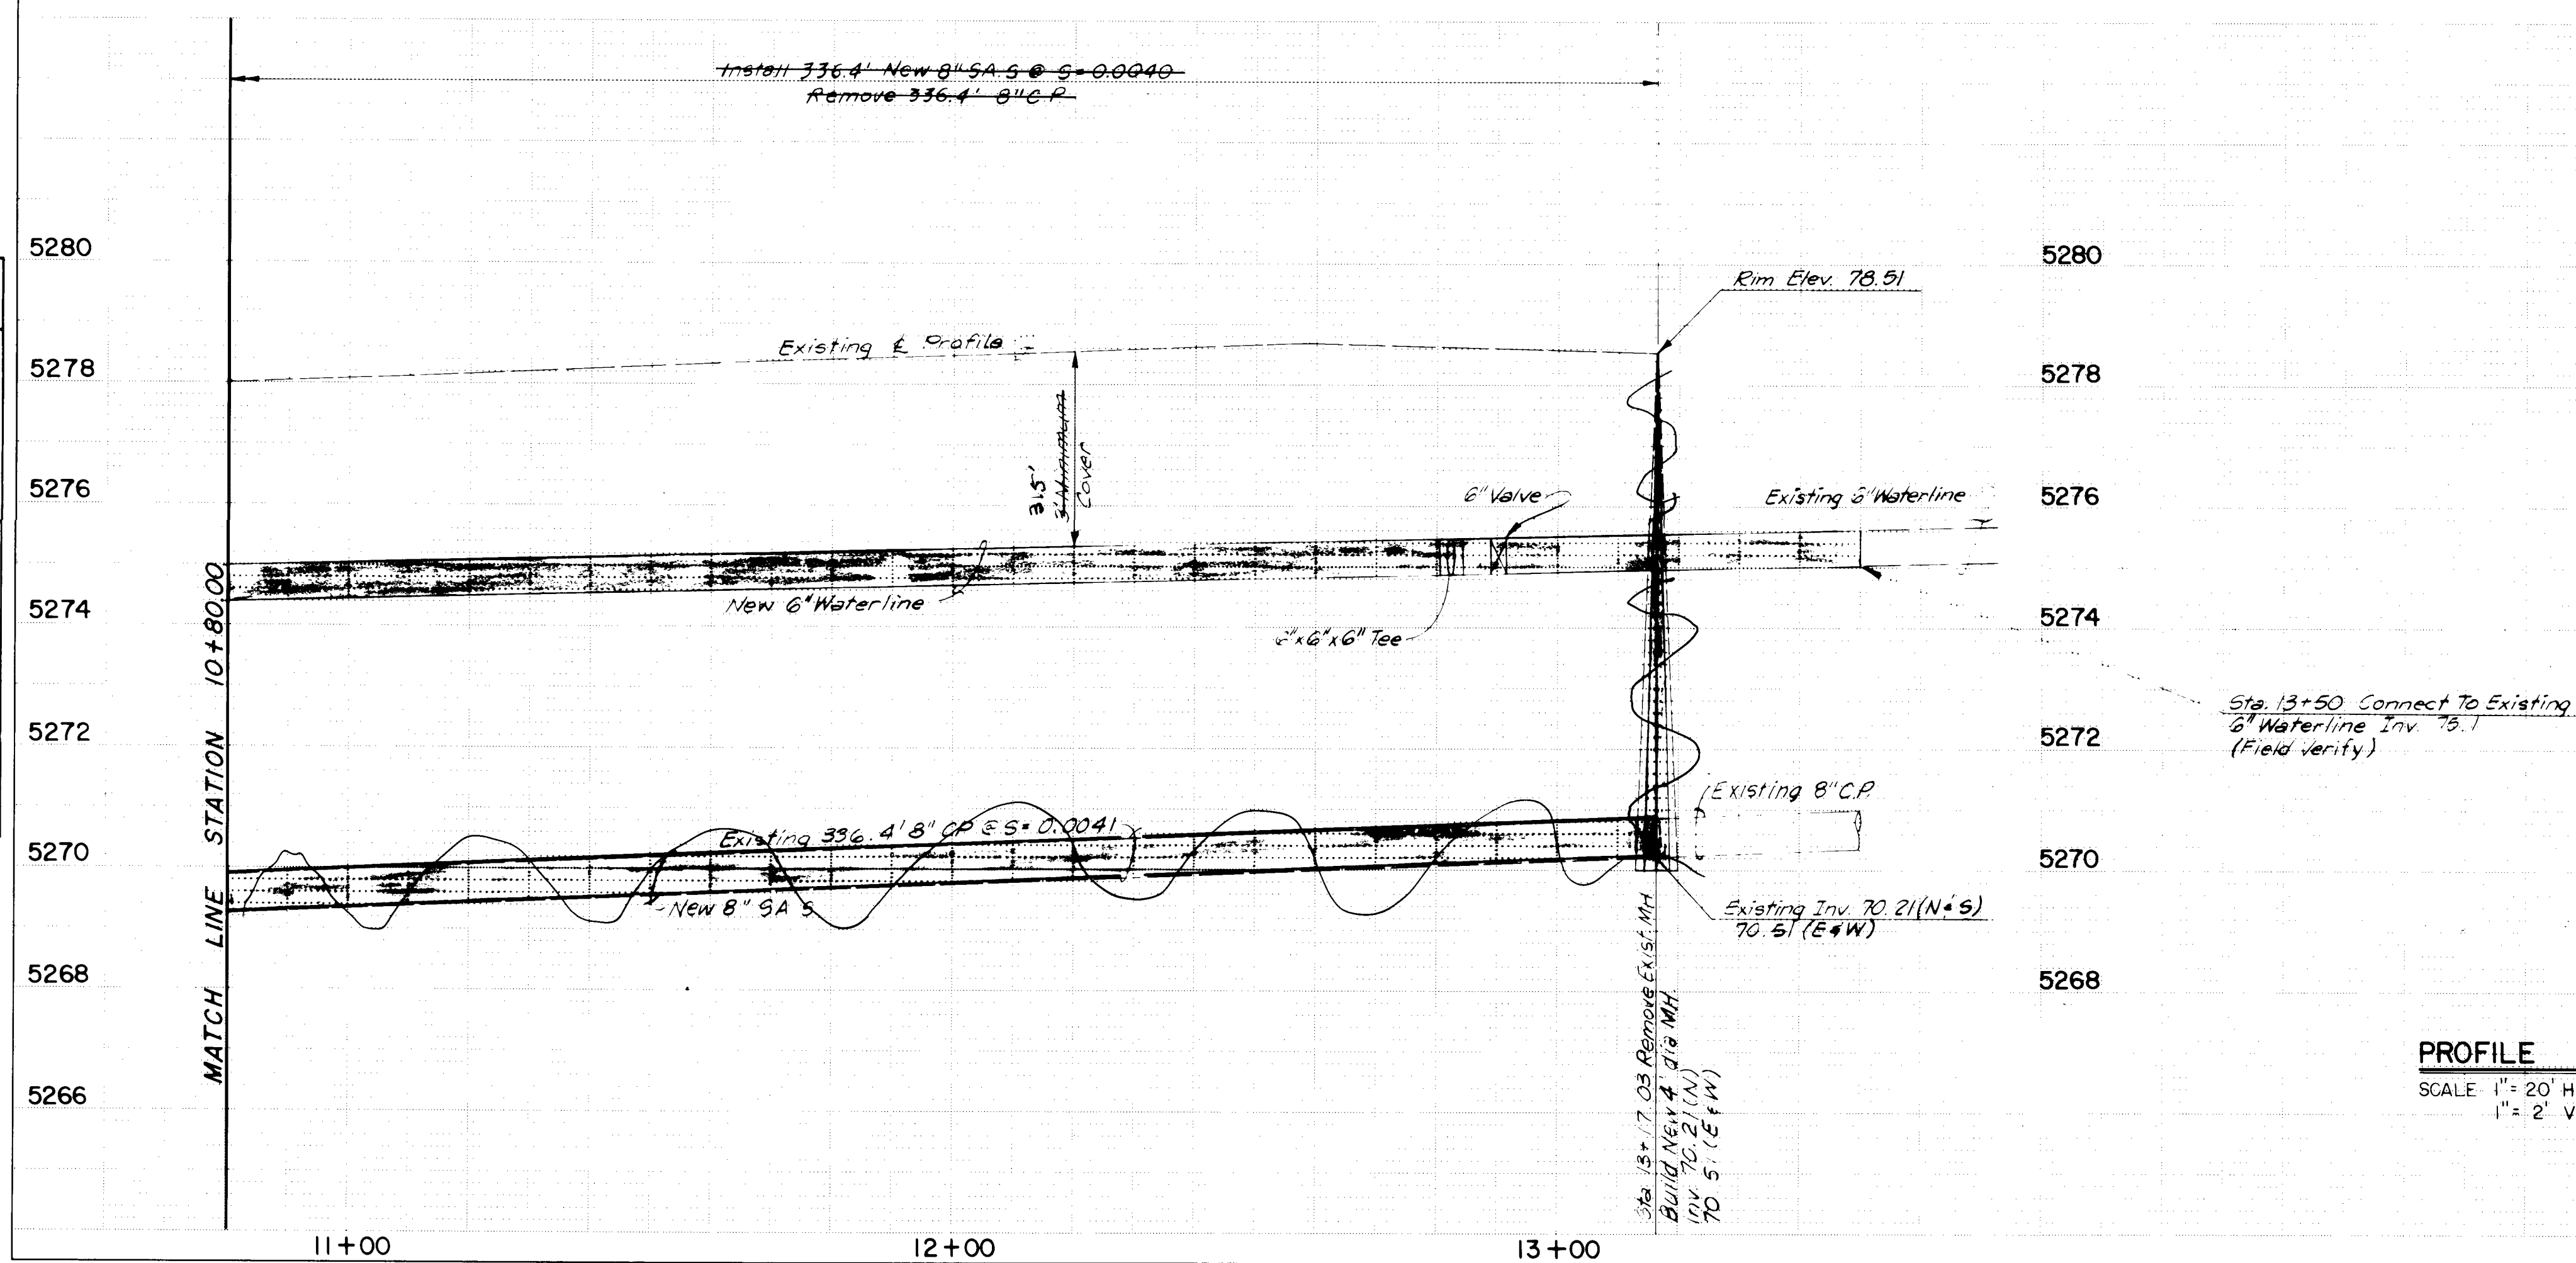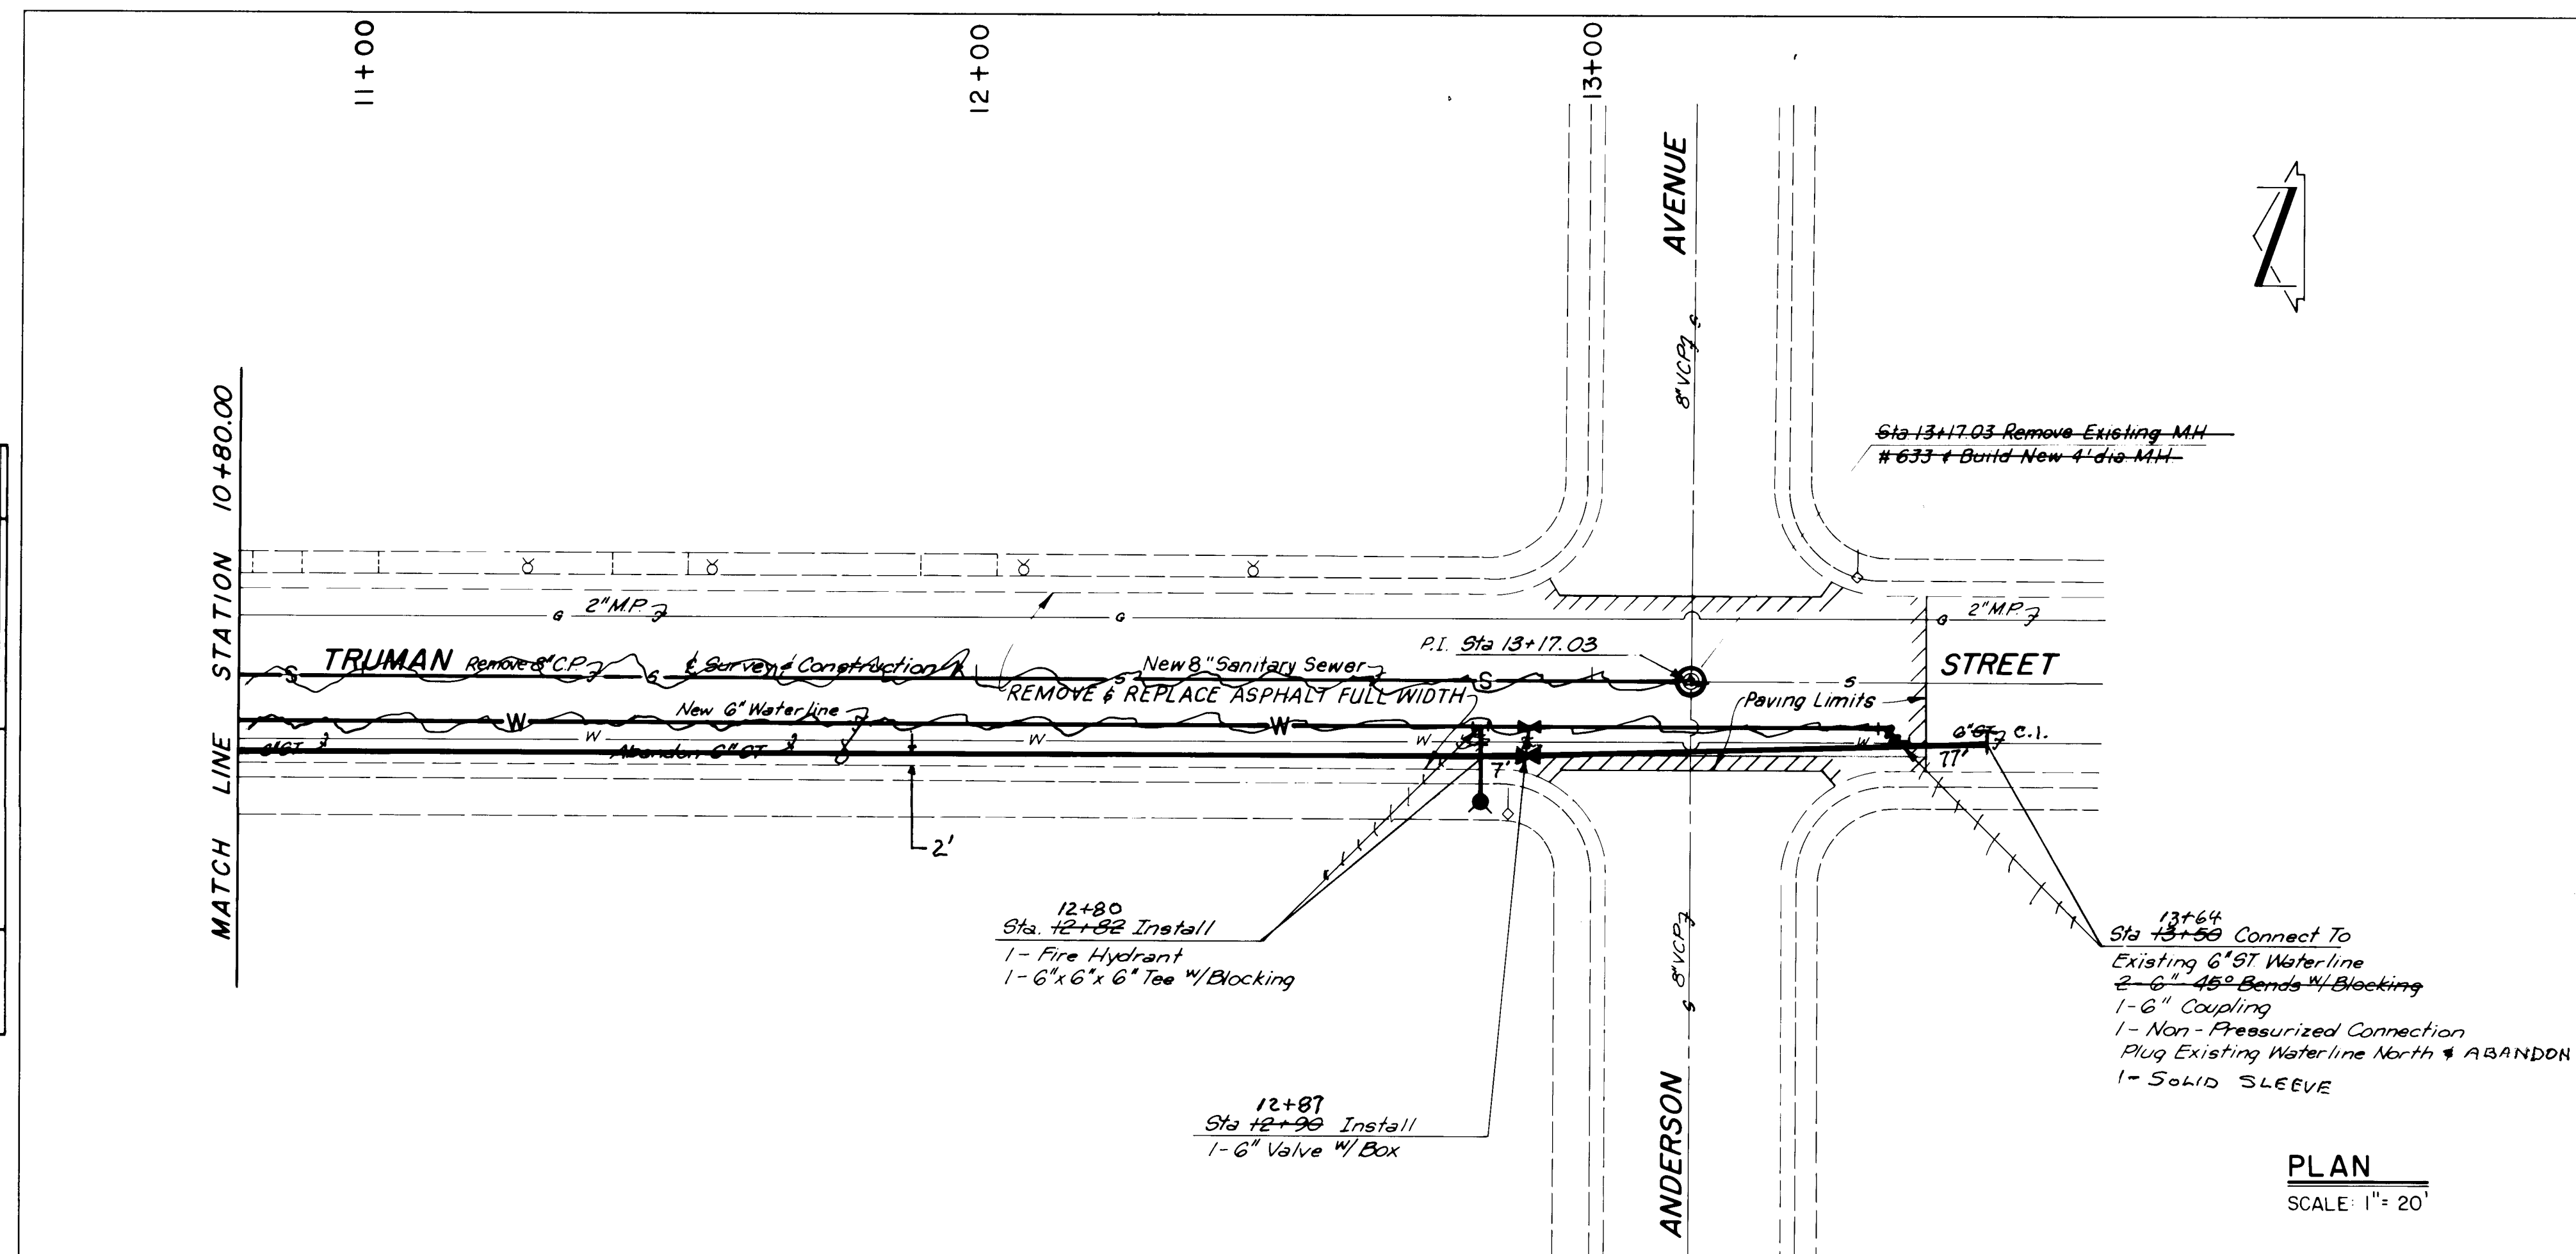

PLANS PREPARED UNDER THE DIRECTION OF	CITY OF ALBUQUERQUE					
	WATER RESOURCES DEPARTMENT					
	TITLE: WATER AND SEWER REPLACEMENT TRUMAN STREET					
	APPROVALS	ENGINEER	DATE	APPROVALS	ENGINEER	DATE
	City Engineer			Liquid Waste		
APPROVED FOR CONSTRUCTION	A.C.E. - Design			Traffic		
	A.C.E. - Hydrology			Water		
CITY ENGINEER	DATE	DRAWING NO. 1487			SHEET 2 OF 2	

				REFERENCES		SURVEY INFORMATION		BENCH MARKS		AS BUILT INFORMATION	
				MAP NO. <i>L-175</i>		FIELD NOTES				CONTRACTOR	
				EST. NO.		W.O. NO.		NO.		BY	
										DATE	
NO.	DATE	REMARKS		BY							
REVISIONS											
DESIGN											
DESIGNED BY		DATE									
DRAWN BY		DATE									
NO.											
RECORDED BY											
DATE											
MICRO-FILM INFORMATION											
DRAWINGS CORRECTED BY <i>3/17/82</i> DATE <i>10/82</i>											
FIELD VERIFICATION BY											
ACCEPTANCE BY <i>M. Neplew</i> DATE <i>9/82</i>											
WORK STARTED BY											
DATE											