

CENTRAL BUSINESS DISTRICT

INSTALLATION OF ALLEY DRIVEPADS, SIDEWALK AND CURB & GUTTER AT VARIOUS LOCATIONS

INDEX

SHEET	1 of 4
TITLE	SHEET
SHEET	2 of 4
1-10th BETWEEN CENTRAL & PARK AVE.	
2-10th BETWEEN PARK AVE & GOLD ST.	
3-9th BETWEEN GOLD & PARK AVE (EAST SIDE)	
4-9th BETWEEN GOLD & PARK AVE (WEST SIDE)	
5-4th BETWEEN CENTRAL & GOLD AVE.	
6-7th BETWEEN ROMA & MARQUETTE AVE. (EAST & WEST)	
SHEET	3 of 4
7-2nd BETWEEN COPPER & CENTRAL AVE.	
8-7th BETWEEN MARQUETTE & TIJERAS	
9-FRUIT BETWEEN 4th ST. & 5th ST.	
10-FRUIT & 4th ST. EAST SIDE	
11-LOMAS BLVD BETWEEN 4TH ST. & 5TH ST.	
12-LOMAS BLVD BETWEEN 3RD ST. & 4TH ST.	
SHEET	4 of 4
13-3rd BETWEEN CENTRAL & COPPER AVE.	
14-ROMA BETWEEN 1st & 2nd ST.	
15-MARQUETTE BETWEEN 1st & 2nd ST.	
16-8th BETWEEN LOMAS & FRUIT AVE.	
17-MARQUETTE BETWEEN 3rd & 4th ST.	
18-ROMA BETWEEN 3rd & 4th ST.	

LEGEND

PROJECT

LOCATION MAP

NOTICE TO CONTRACTORS

1. All work detailed on these plans to be performed under contract shall, except as otherwise stated or provided for hereon, be constructed in accordance with the New Mexico Standard Specifications for Public Works Construction-1979 Edition (referred to herein as the Standard Specifications) and the Contract Documents for City-Wide Utilities and Cash Paving No. 31.

2. Two (2) working days prior to any excavation, contractor must contact Line Locating Service, 765-1234, for location of existing utilities.

3. Prior to construction, the contractor shall excavate and verify the horizontal and vertical locations of all obstructions. Should a conflict exist, the contractor shall notify the engineer or surveyor so that the conflict can be resolved with minimum amount of delay.

THE FOLLOWING NOTES ALSO APPLY WHEN CHECKED

☐ All utilities and utility service lines shall be installed prior to paving.

☒ Backfill compaction shall be according to specified street use (ARTERIAL & RESIDENTIAL)

☐ Tack coat requirements shall be determined by the City Engineer.

☒ Sidewalks and wheelchair ramps within the curb returns shall be constructed wherever a new curb return is constructed.

☒ If curb is depressed for a drivepad or a handicap ramp, the drivepad or ramp shall be constructed prior to acceptance of the curb and gutter.

☐ All storm drainage facilities shall be completed prior to final acceptance.


APPROVAL OF AS BUILT DRAWING

AS BUILT DRAWING


[Signature]

DATE 10/1/83


REV	SHEETS	CITY ENGR.	DATE	USER DEPT.	DATE	USER DEPT.	DATE
APPROVAL OF REVISIONS							
		126 1491 0183		APPROVED FOR CONSTRUCTION			
		CITY OF ALBUQUERQUE		<i>[Signature]</i>		CITY ENGR	
		1491				SHEET 1 OF 4	

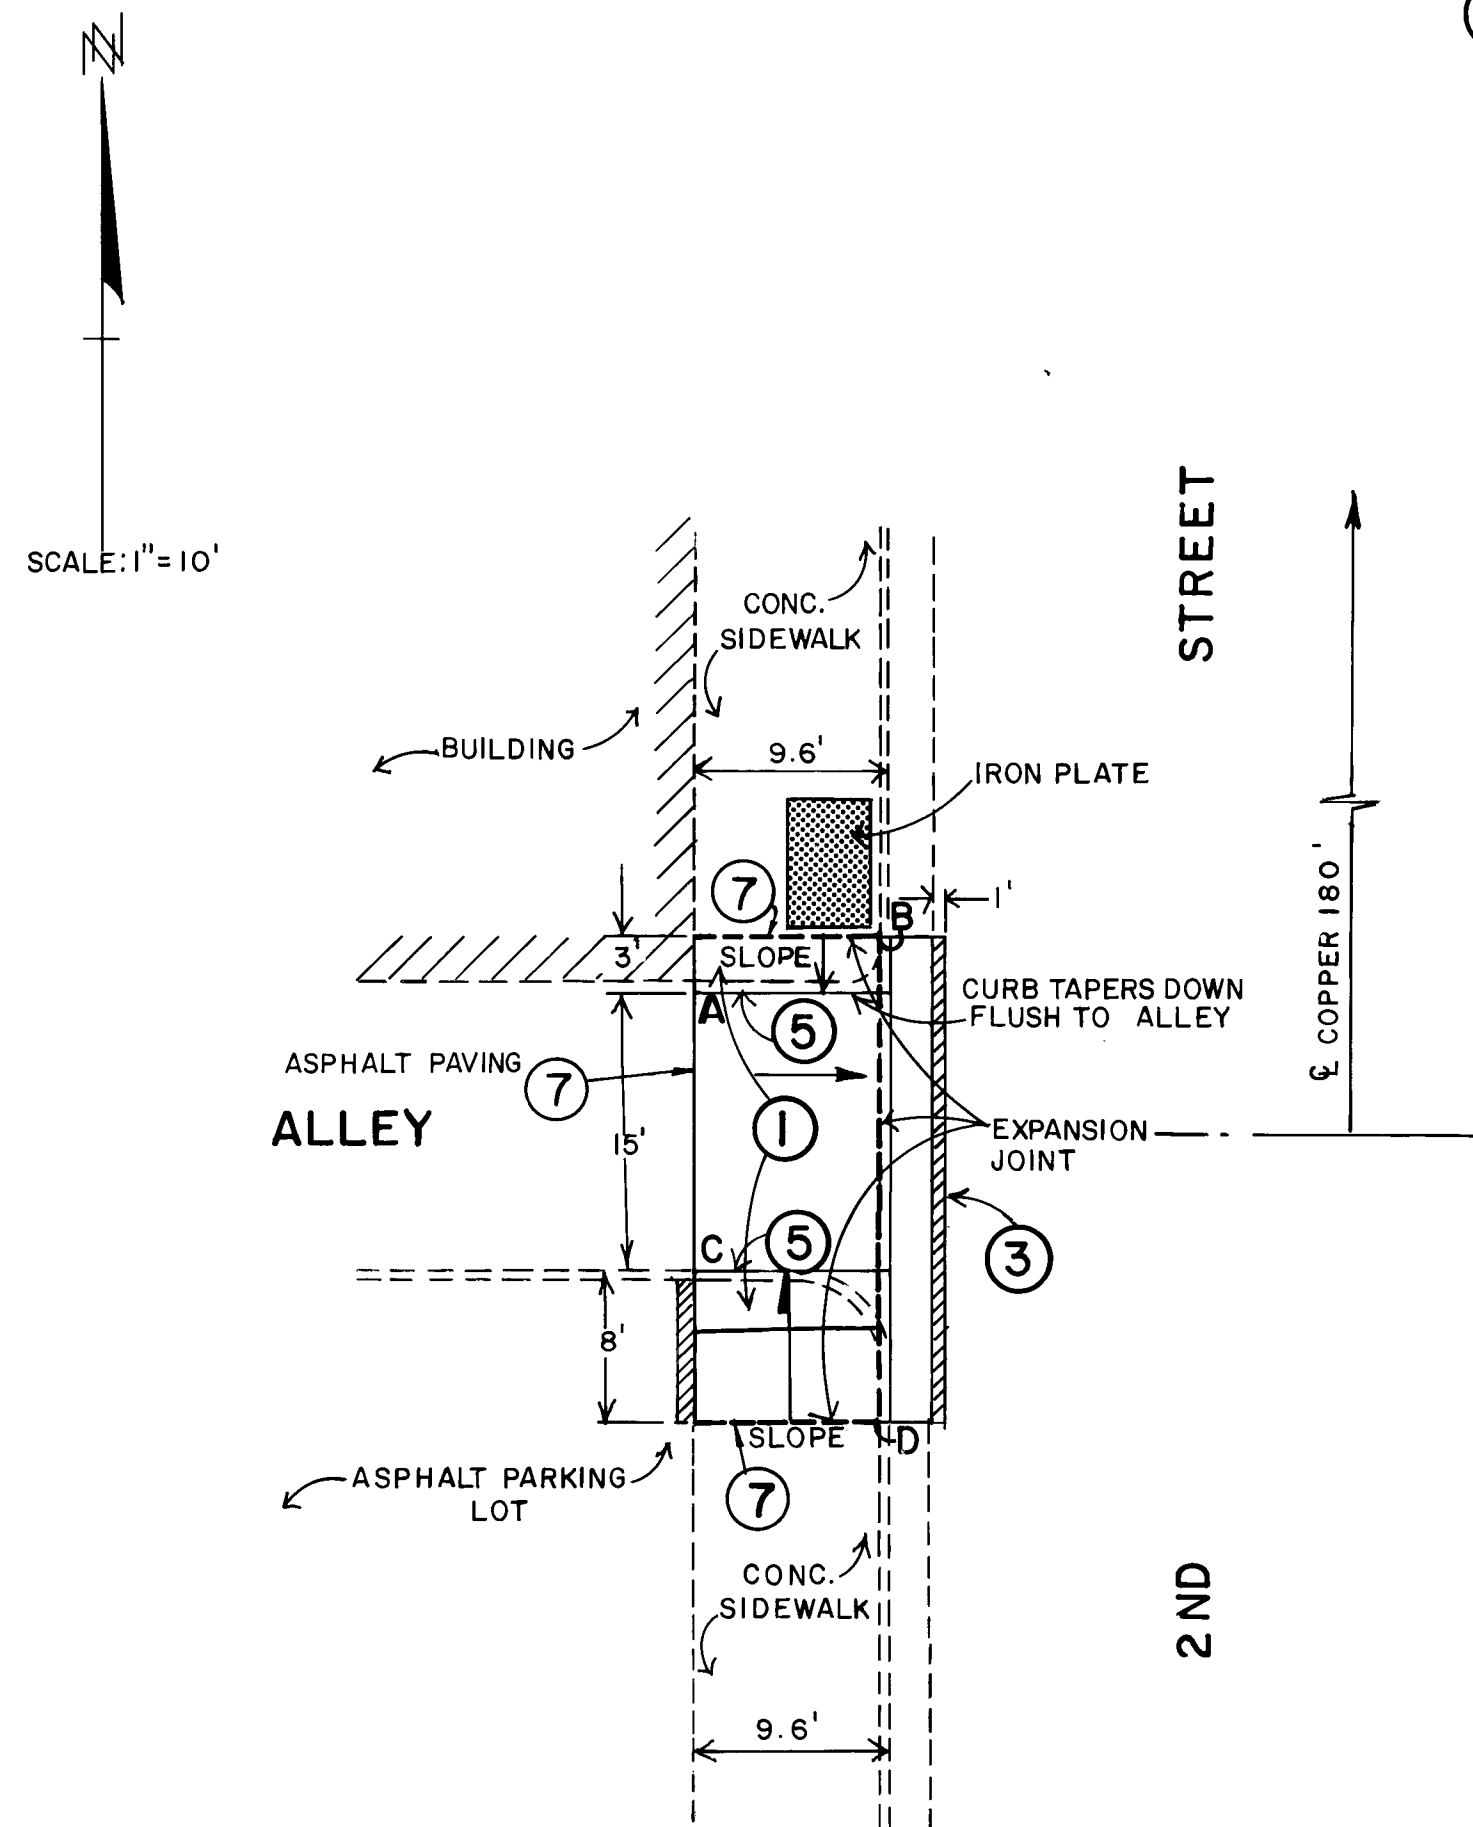


2ND STREET BETWEEN COPPER & CENTRAL AVE

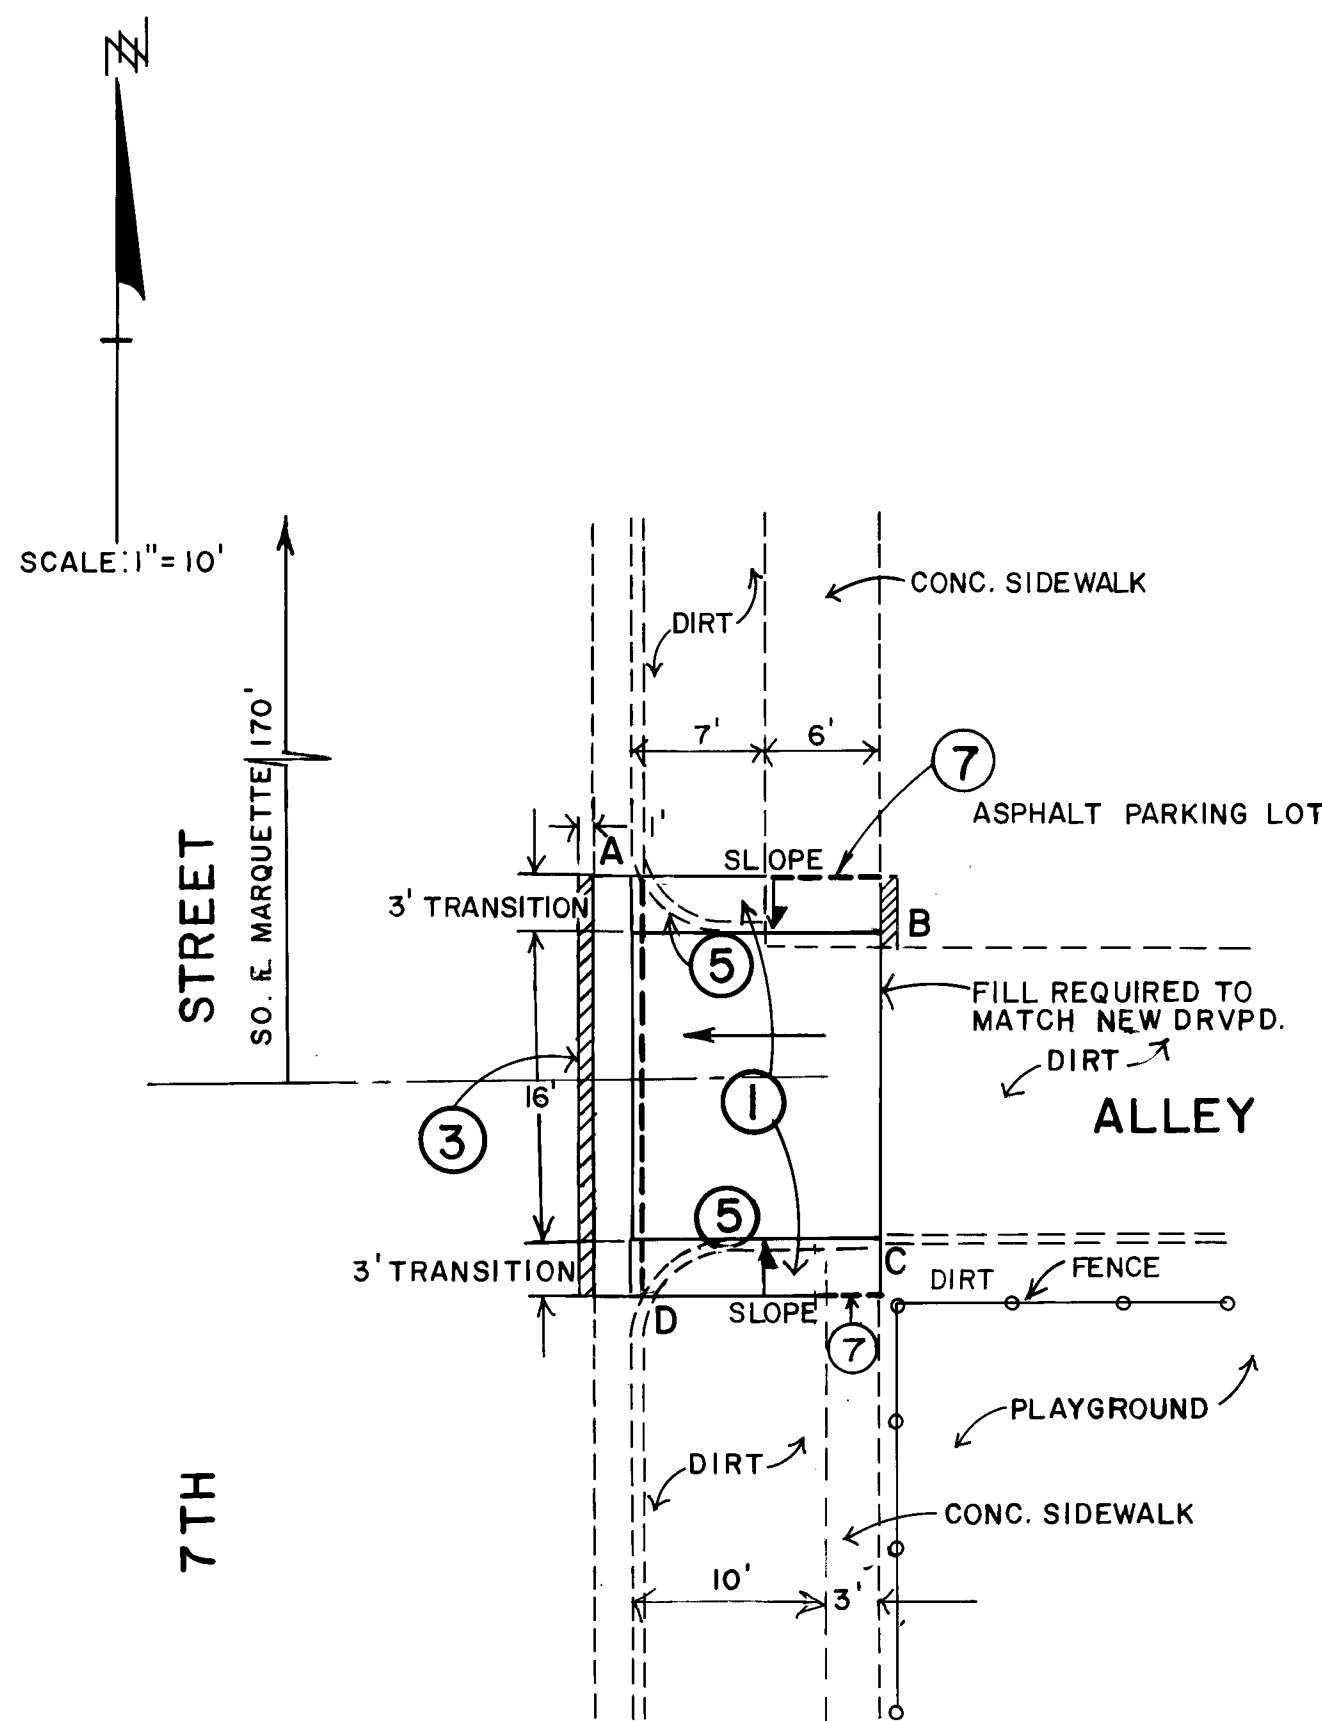


7TH STREET BETWEEN MARQUETTE & TIJERAS AVE

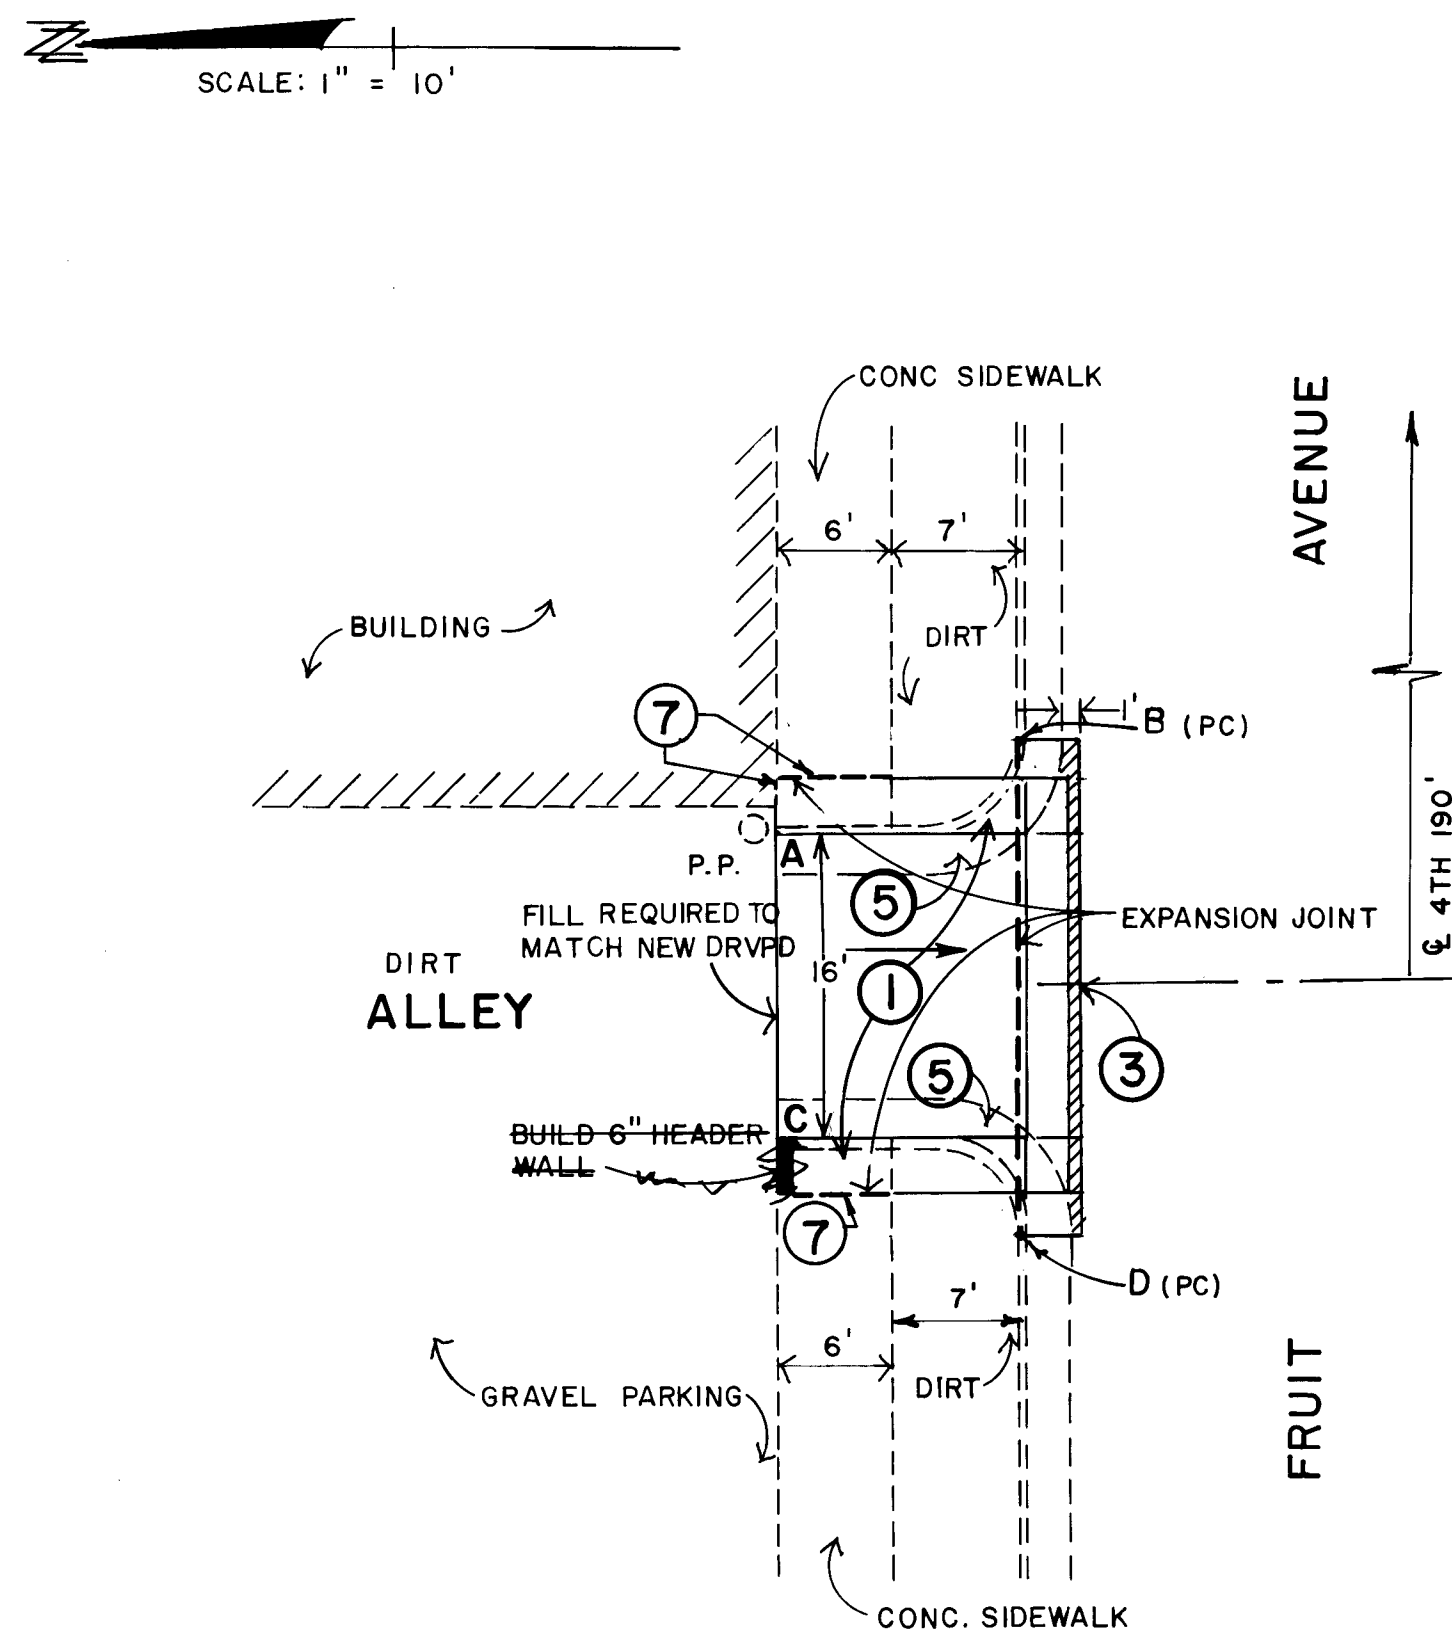


FRUIT AVE BETWEEN 4TH STREET & 5TH STREET

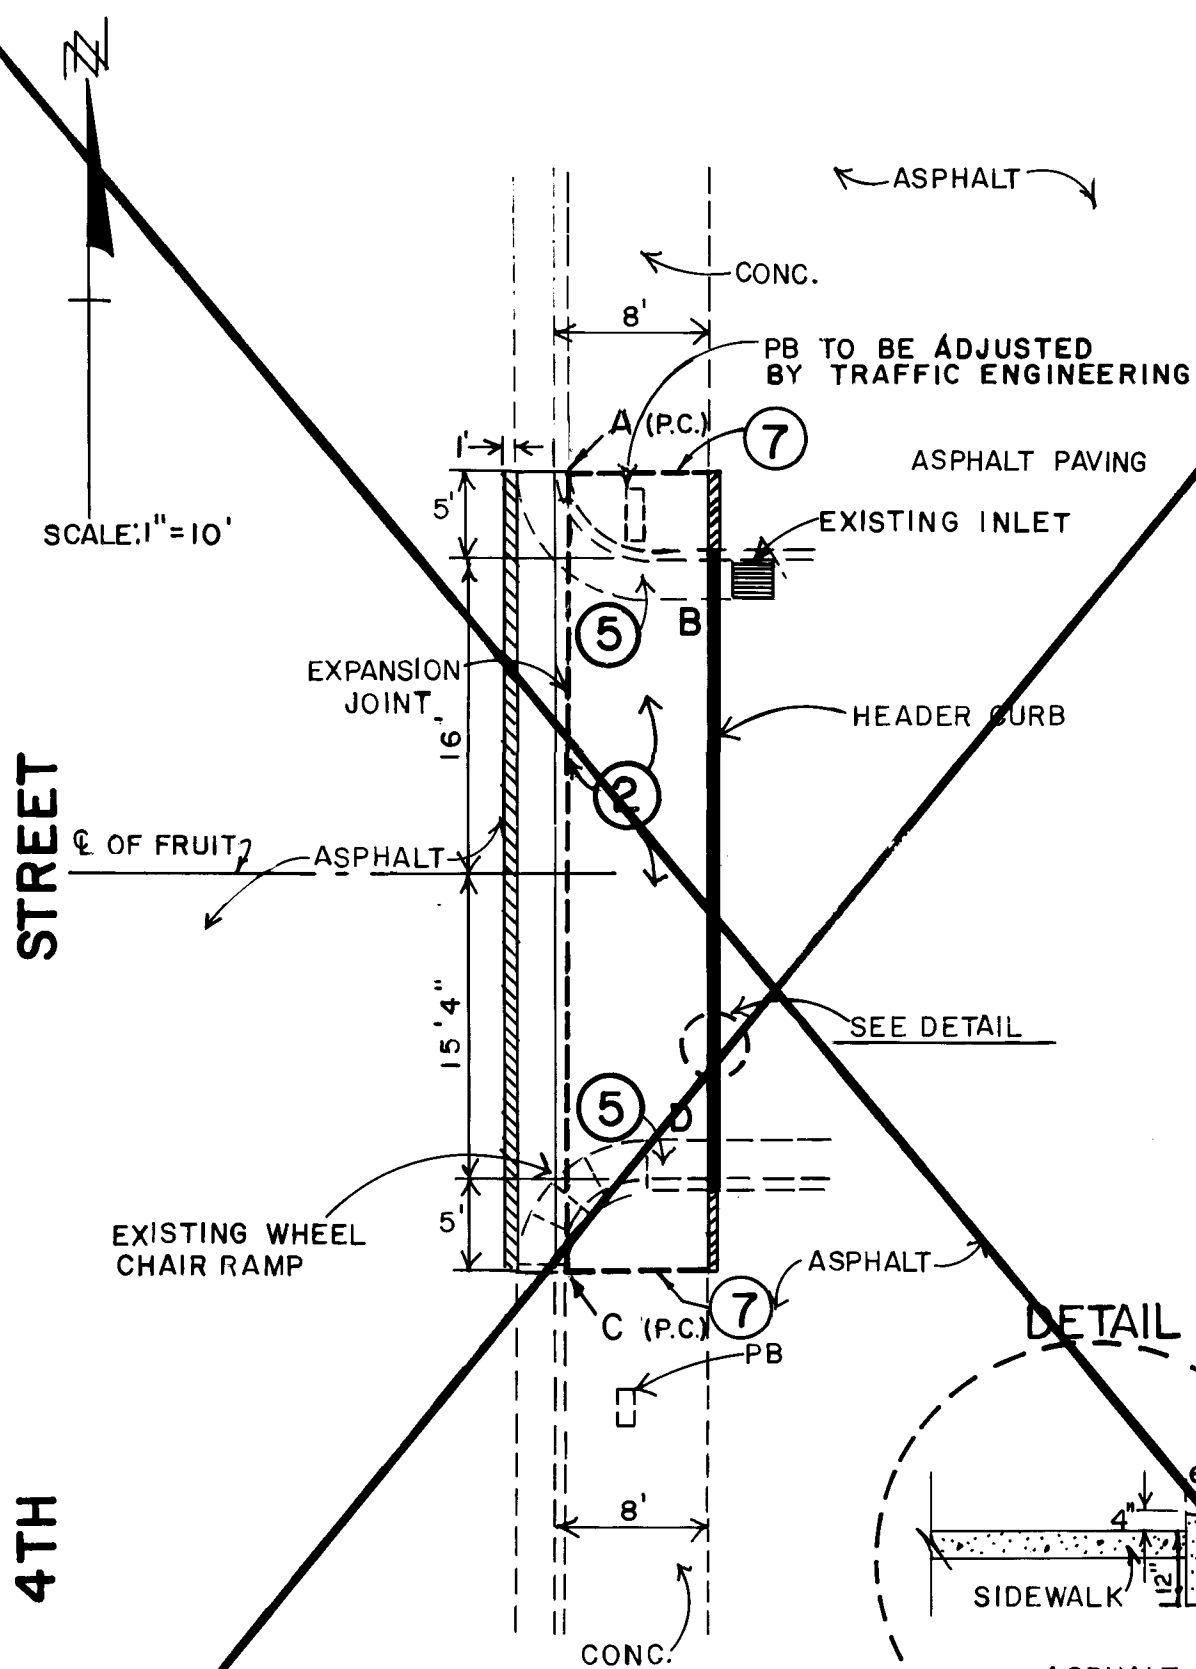

FRUIT & FOURTH EAST SIDE

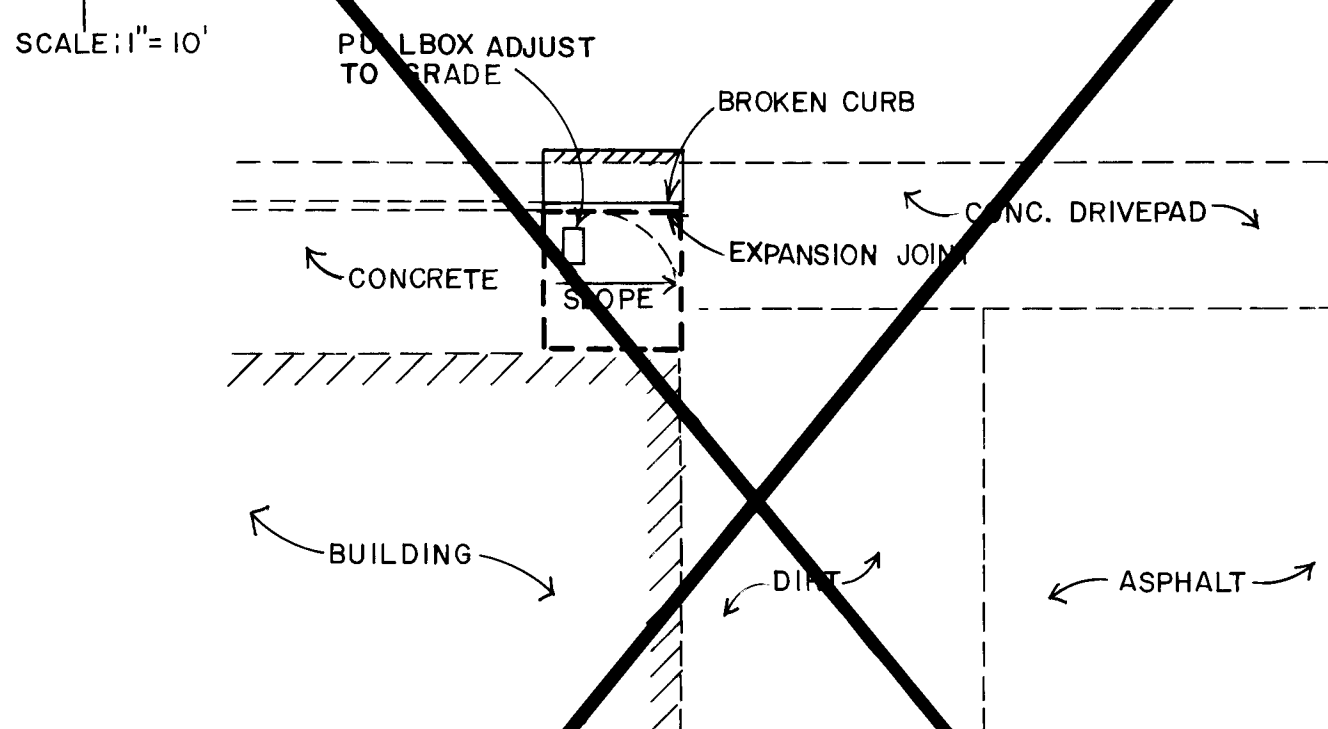

LOMAS BLVD BETWEEN 4TH ST. & 5TH ST.

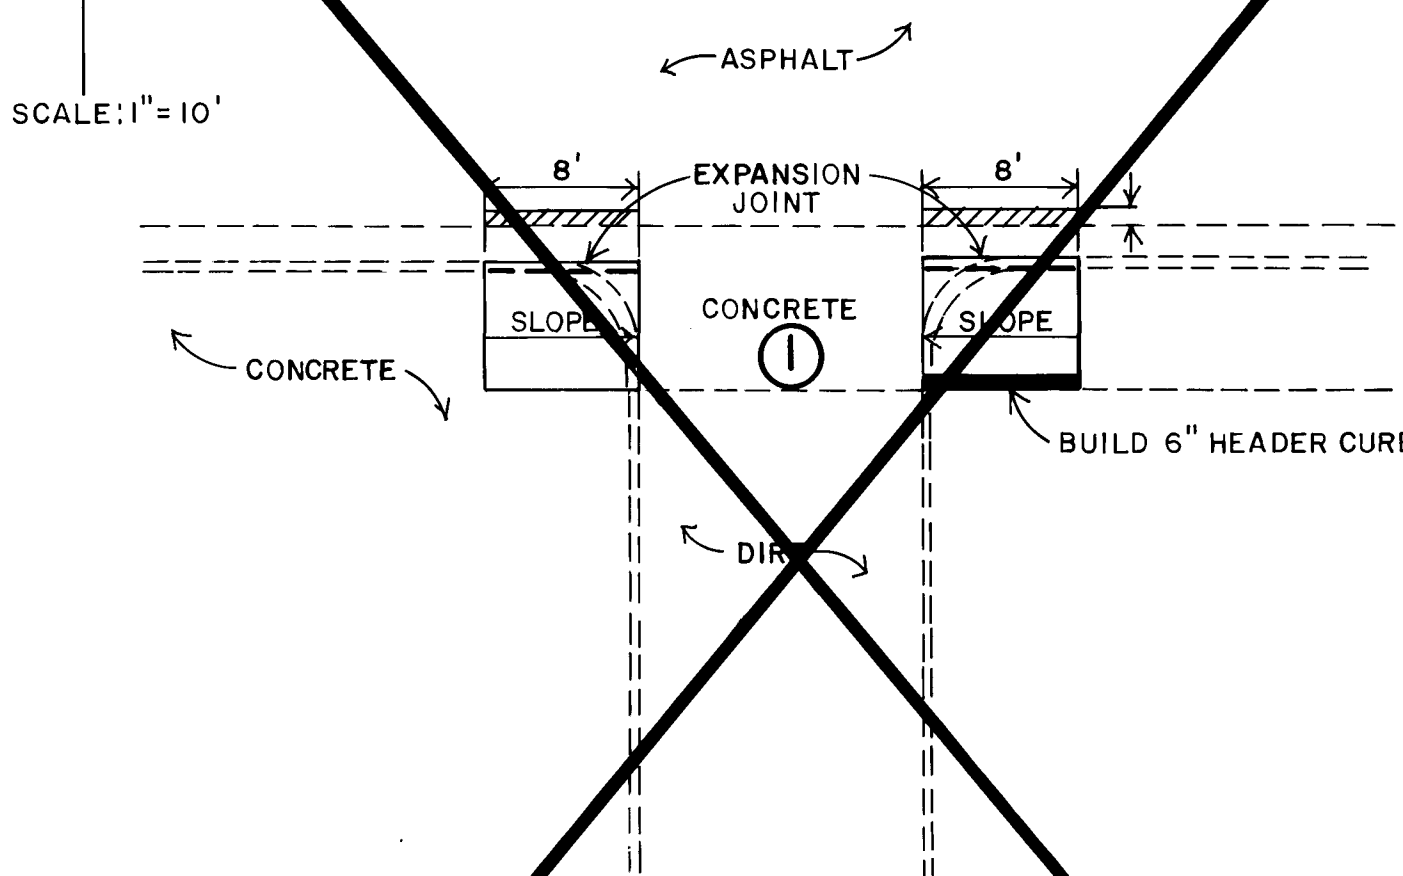


LOMAS BLVD BETWEEN 3RD ST. & 4TH ST.

GENERAL NOTES:


- BUILD 6" CONC. DRIVEPAD
- BUILD STANDARD CURB, GUTTER & SIDEWALK.
- REMOVE AND REPLACE ONE FOOT OF ASPHALT PAVING TO ALL NEW CURB & GUTTER.
- BUILD NEW WHEEL CHAIR RAMP AS SHOWN.
- REMOVE EXISTING CURB & GUTTER BETWEEN A & B AND C & D
- REMOVE SIDEWALK TO NEAREST JOINT.
- MATCH EXISTING.

LEGEND

- EXISTING CURB & GUTTER
- EXPANSION JOINT
- REM. & REPL. ASPHALT PAVING
- HEADER CURB

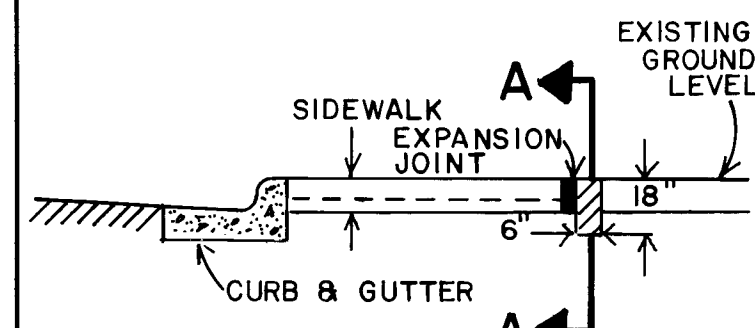

HEADERWALL DETAIL

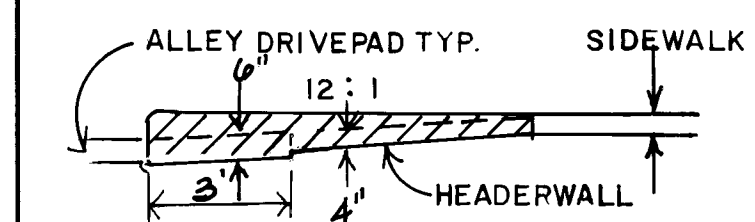

SECTION A-A

240 1491 0383


CITY OF ALBUQUERQUE
MUNICIPAL DEVELOPMENT DEPARTMENT
ENGINEERING DIVISION

TITLE: INSTALLATION OF ALLEY DRIVEPADS, SIDEWALK AND CURB & GUTTER AT VARIOUS LOCATION IN THE CENTRAL BUSINESS DISTRICT


APPROVALS	ENGINEER	DATE	APPROVALS	ENGINEER	DATE
City Engineer	C. R.	Liquid Waste
A.C.E. - Design	Traffic
A.C.E. - Hydrology	Water

DRAWING NO. 1491 MAP NO. J-14 SHEET 3 OF 4
K-13, K-14 T.T.


AS BUILT INFORMATION		BENCH MARKS		SURVEY INFORMATION		ENGINEER'S SEAL	
CONTRACTOR	DATE	NO.	DATE	NO.	DATE	NO.	DATE
INSPECTOR	DATE	NO.	DATE	NO.	DATE	NO.	DATE
ACCEPTANCE BY	DATE	NO.	DATE	NO.	DATE	NO.	DATE
VERIFICATION BY	DATE	NO.	DATE	NO.	DATE	NO.	DATE
RECORDED BY	DATE	NO.	DATE	NO.	DATE	NO.	DATE
MICRO-FILM INFORMATION		REVISIONS		DESIGN		REVISIONS	
		NO.		DATE		DATE	
		BY		BY		BY	
		REMARKS		REMARKS		REMARKS	
		DESIGNED BY S. MIRANDA		DATE 11-18-82		DATE 11-18-82	
		DRAWN BY R. SALAZAR		DATE 11-18-82		DATE 11-18-82	
		CHECKED BY		CHECKED BY		CHECKED BY	

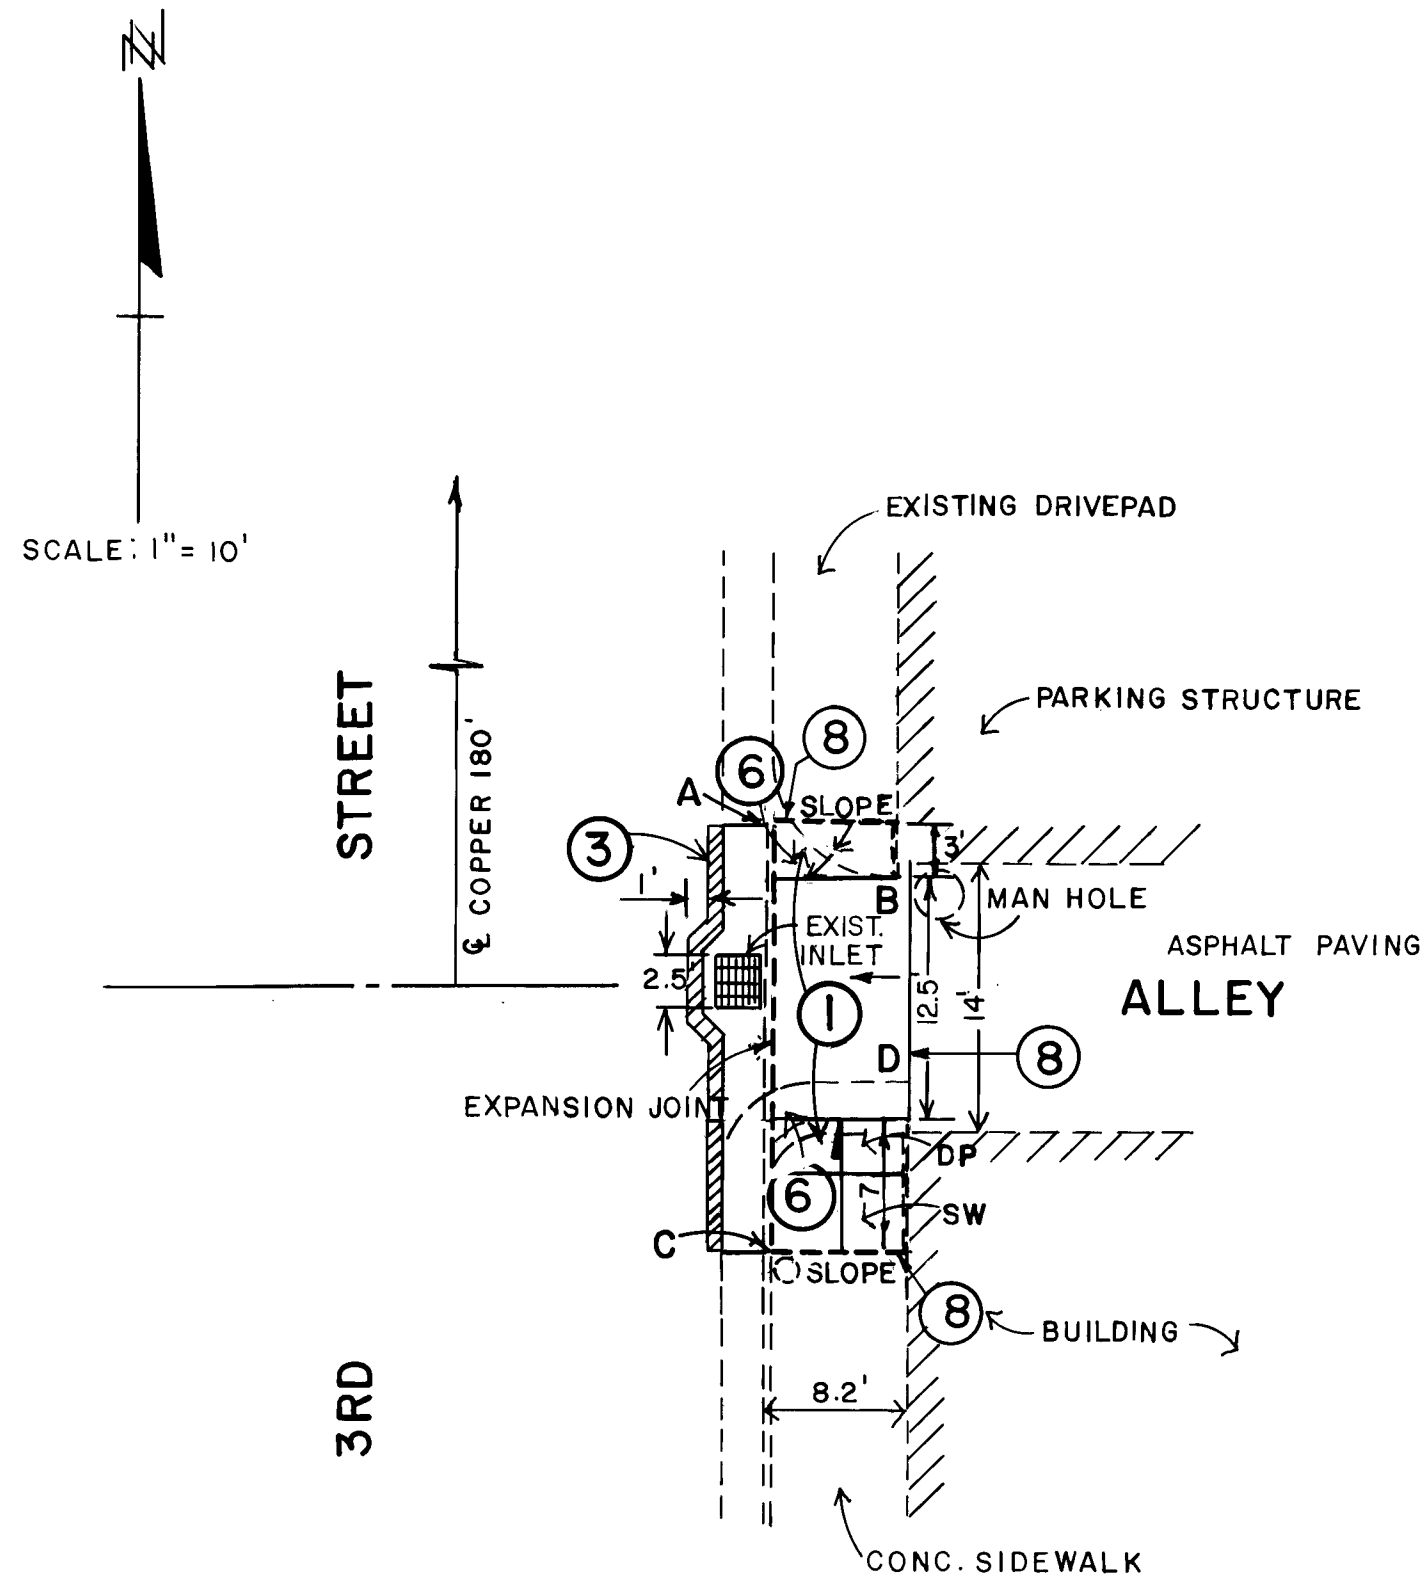


3RD STREET BETWEEN CENTRAL & COPPER

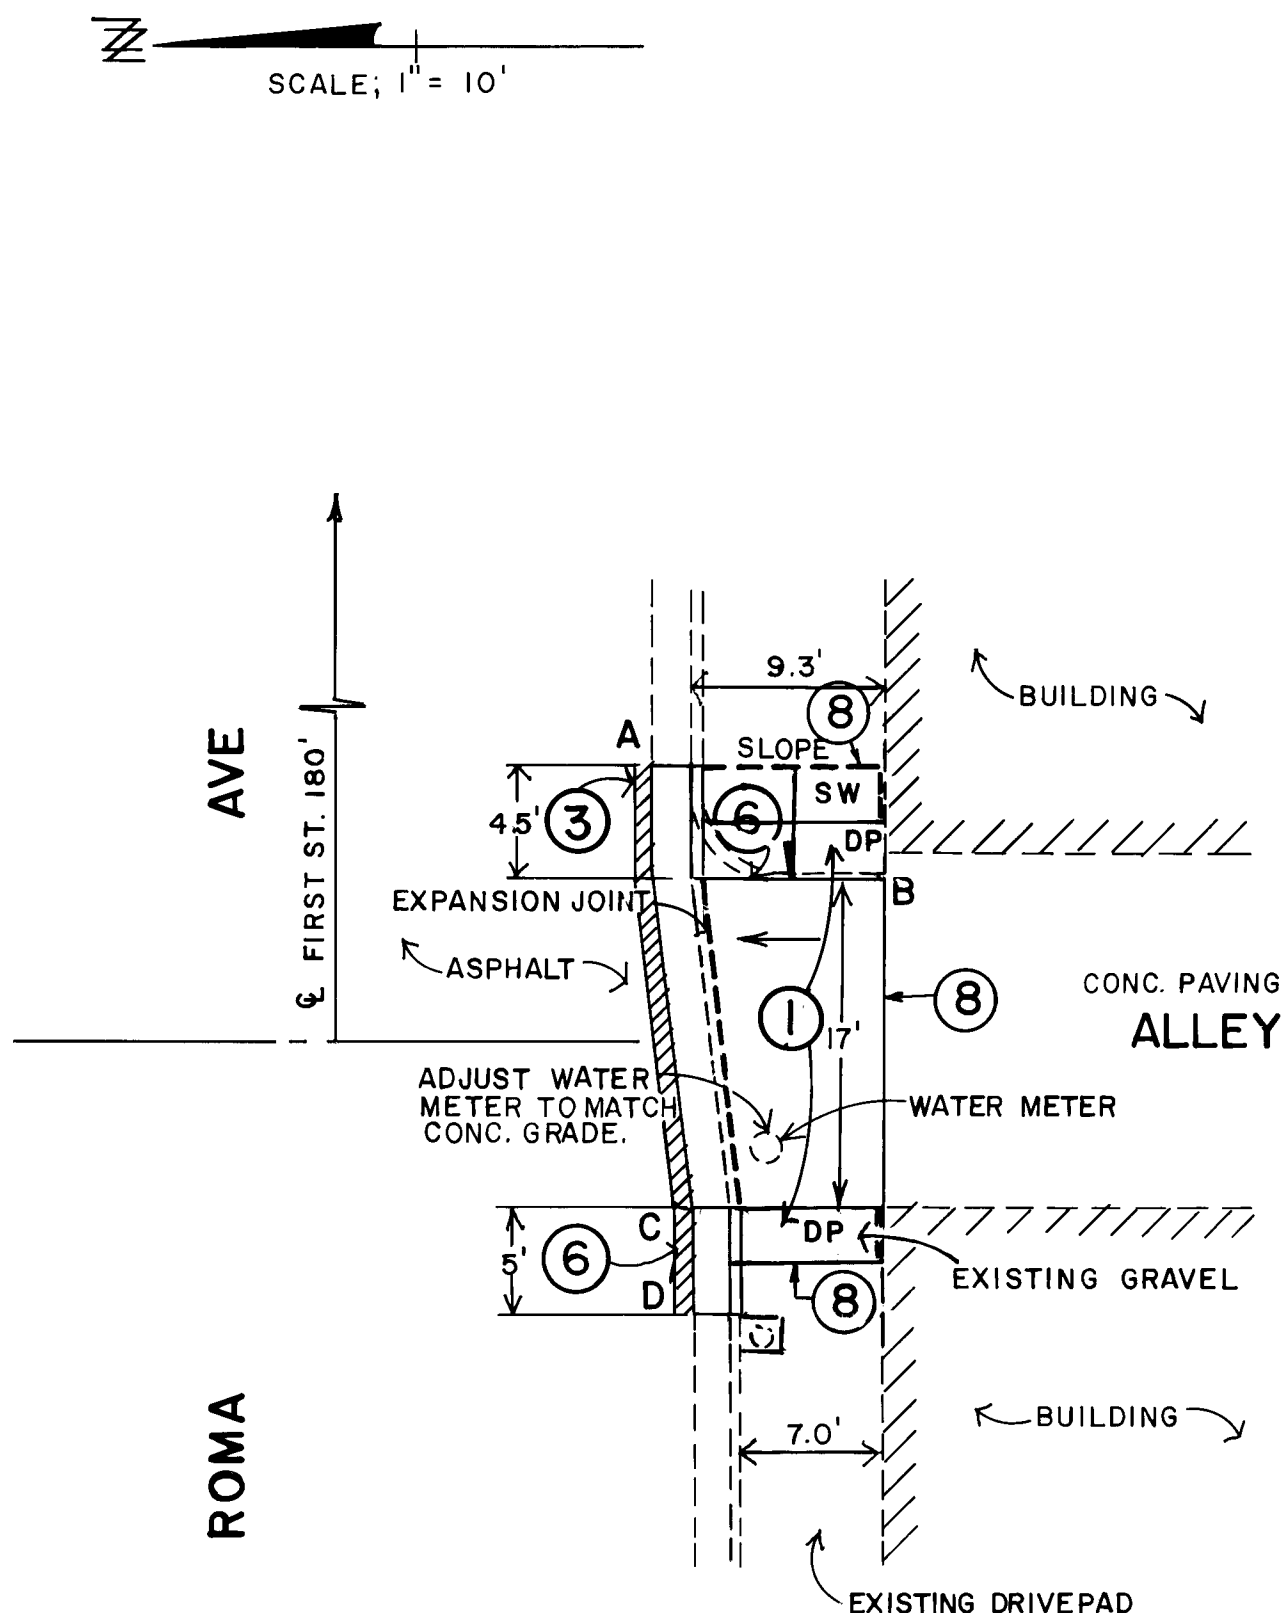


ROMA AVE BETWEEN 1ST. & 2ND ST.

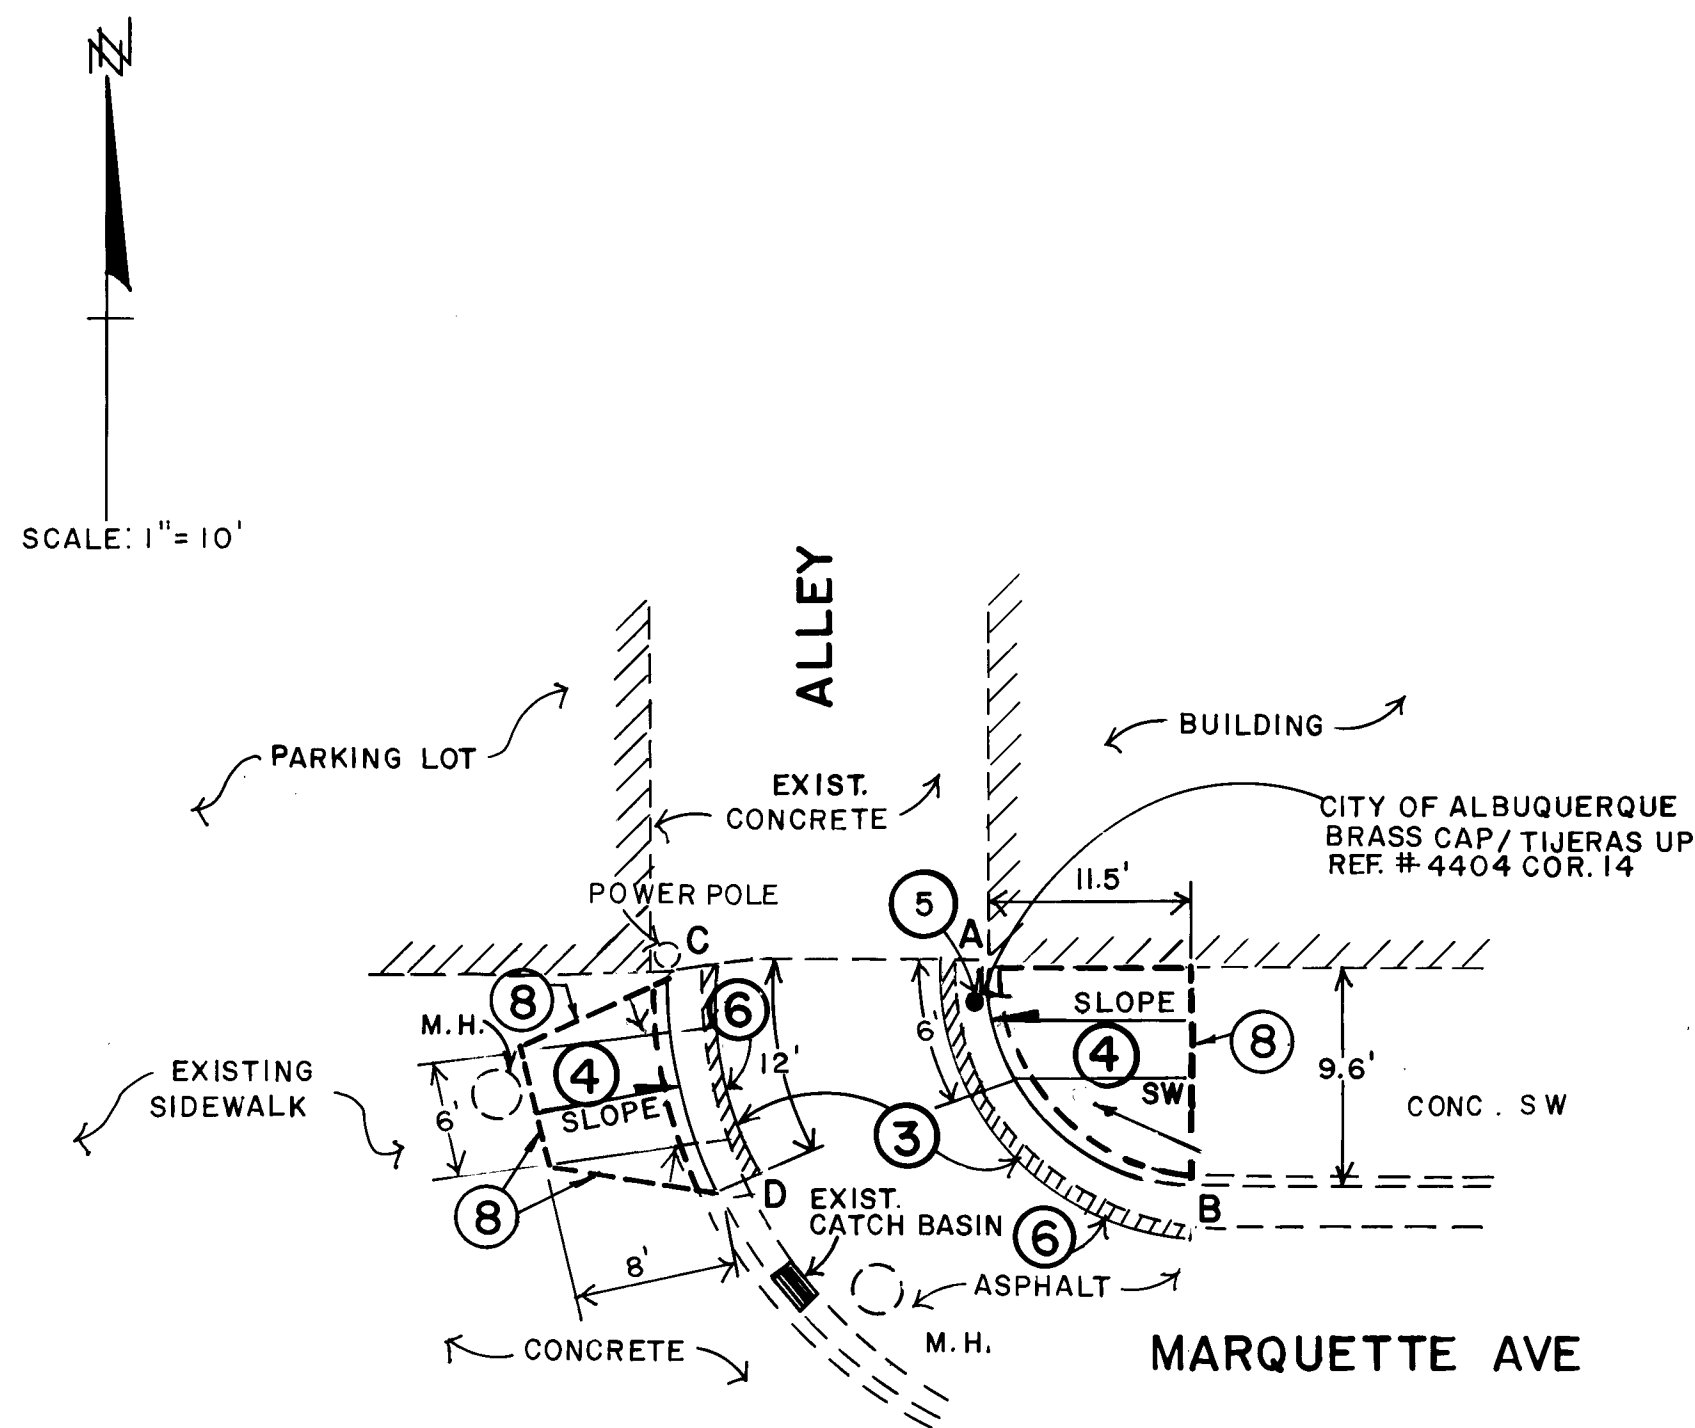


MARQUETTE BETWEEN 1ST. & 2ND ST.

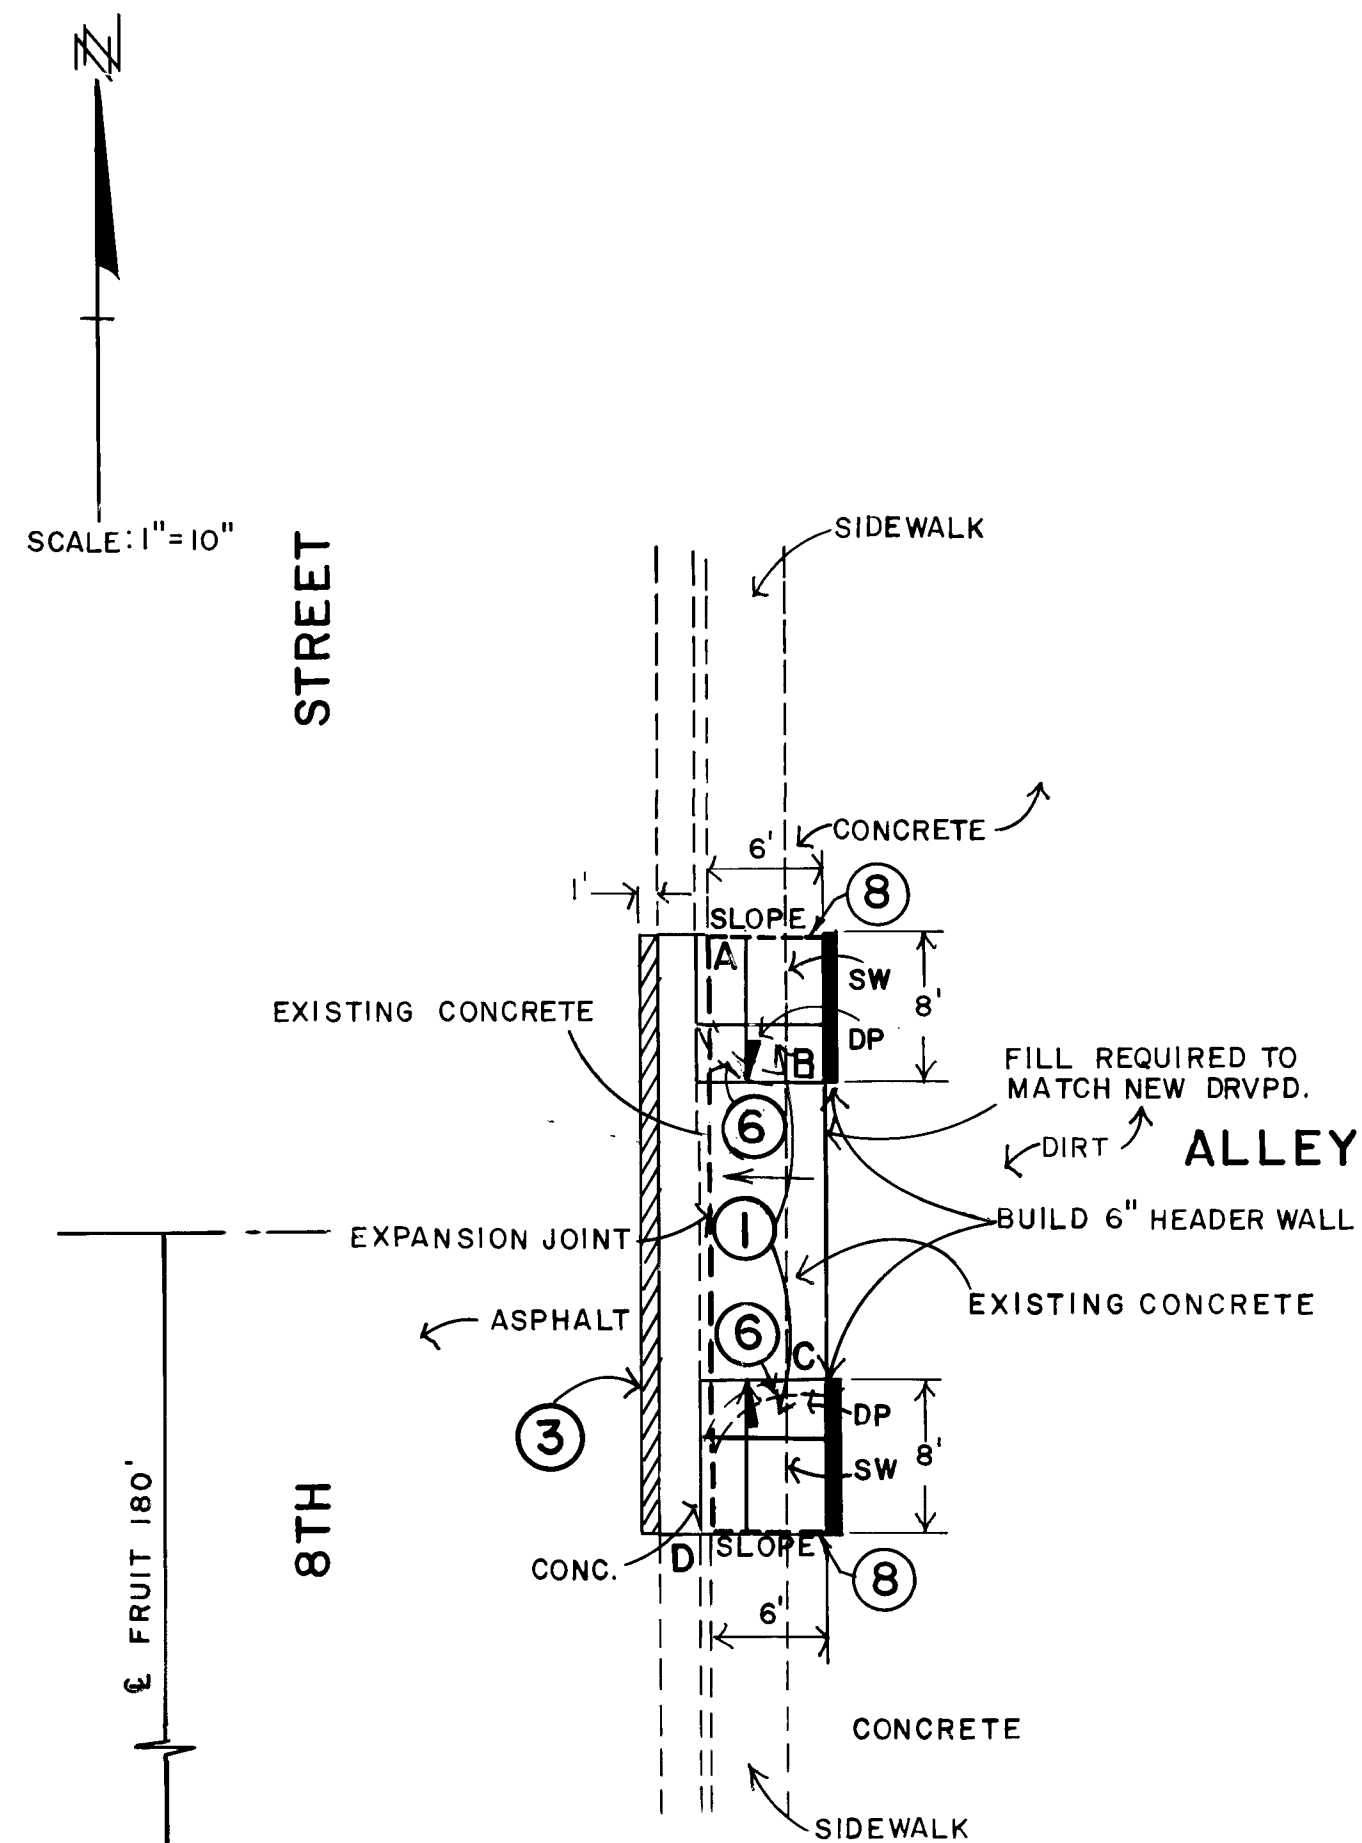

8TH BETWEEN LOMAS BLVD & FRUIT AVE

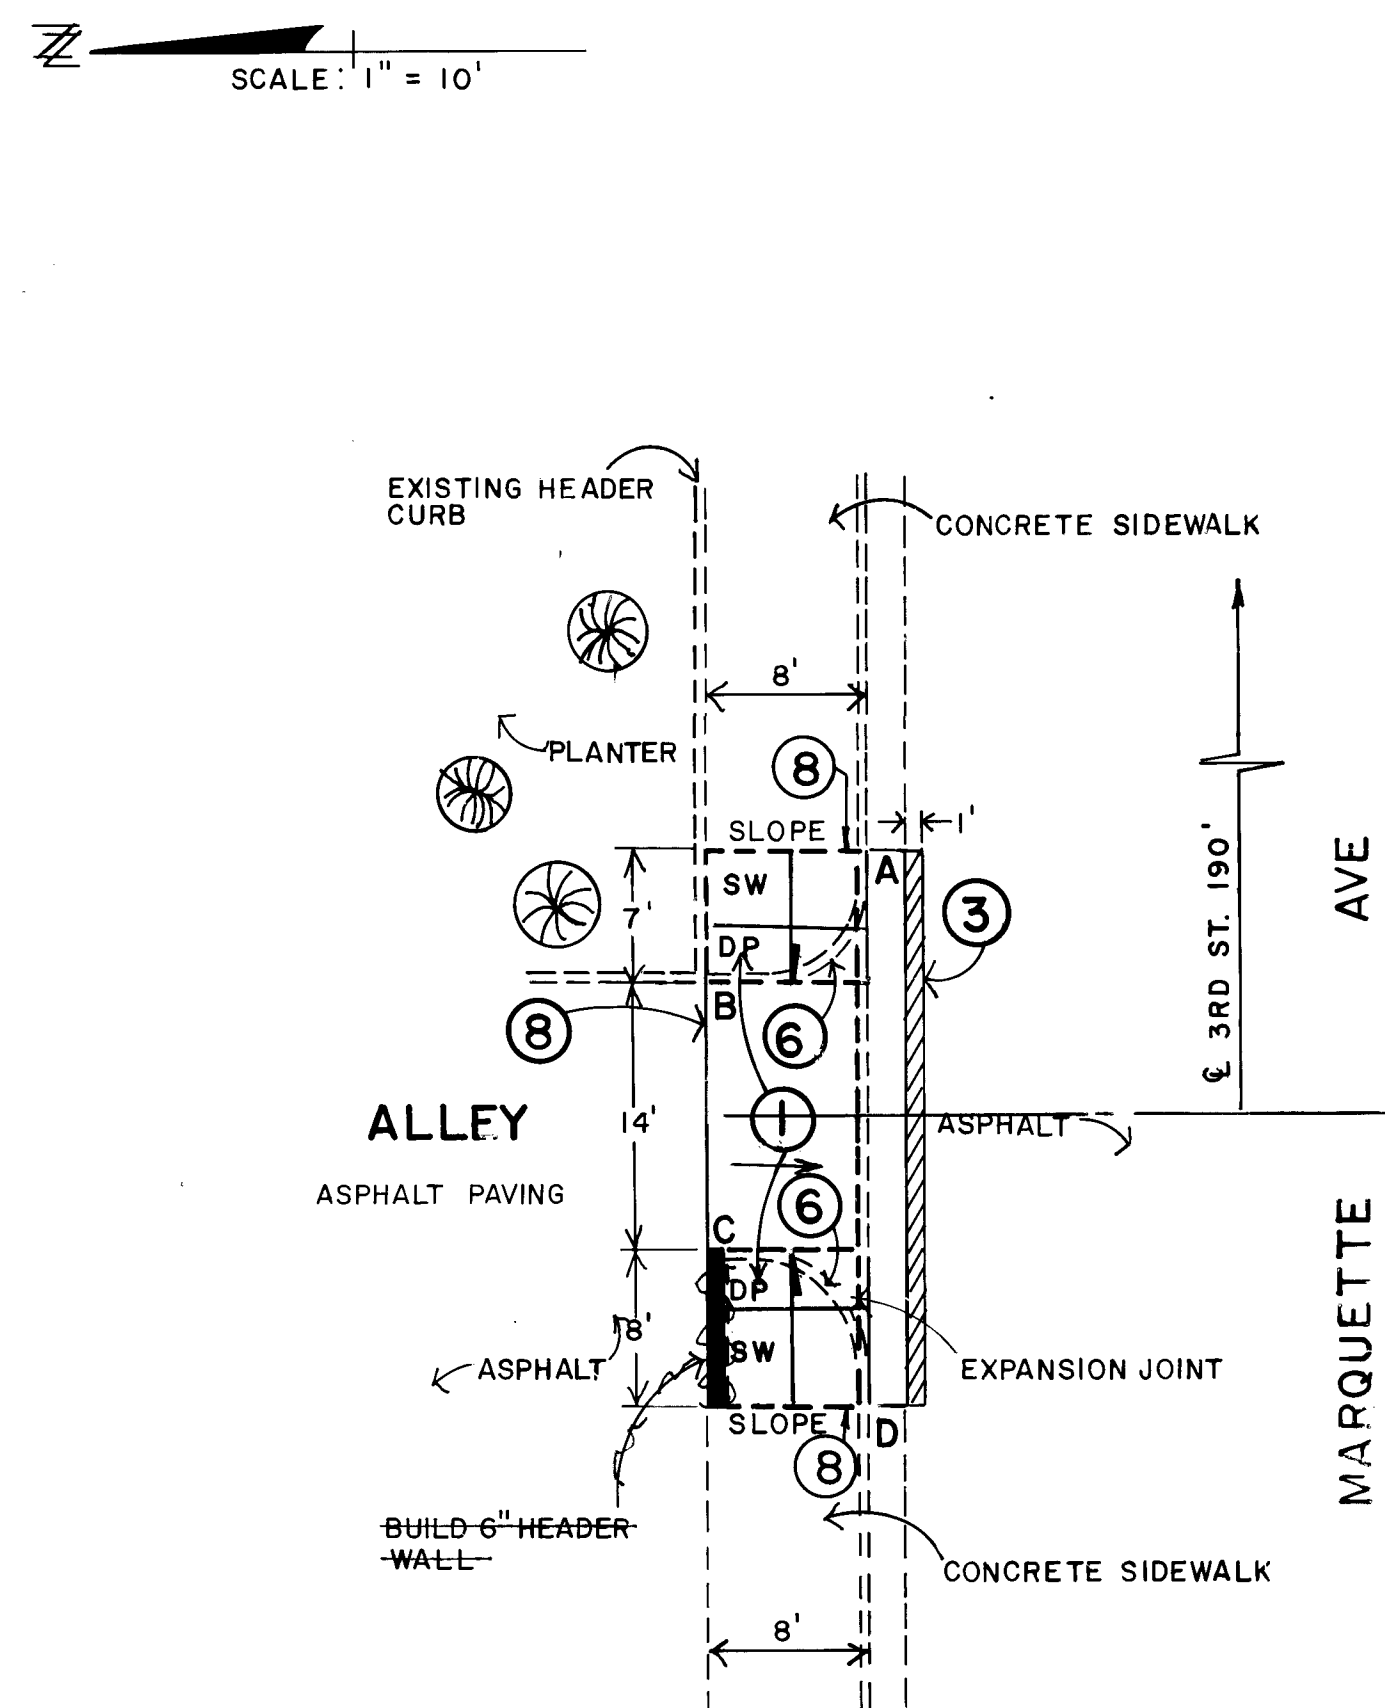


MARQUETTE BETWEEN 3RD ST. & 4TH ST.

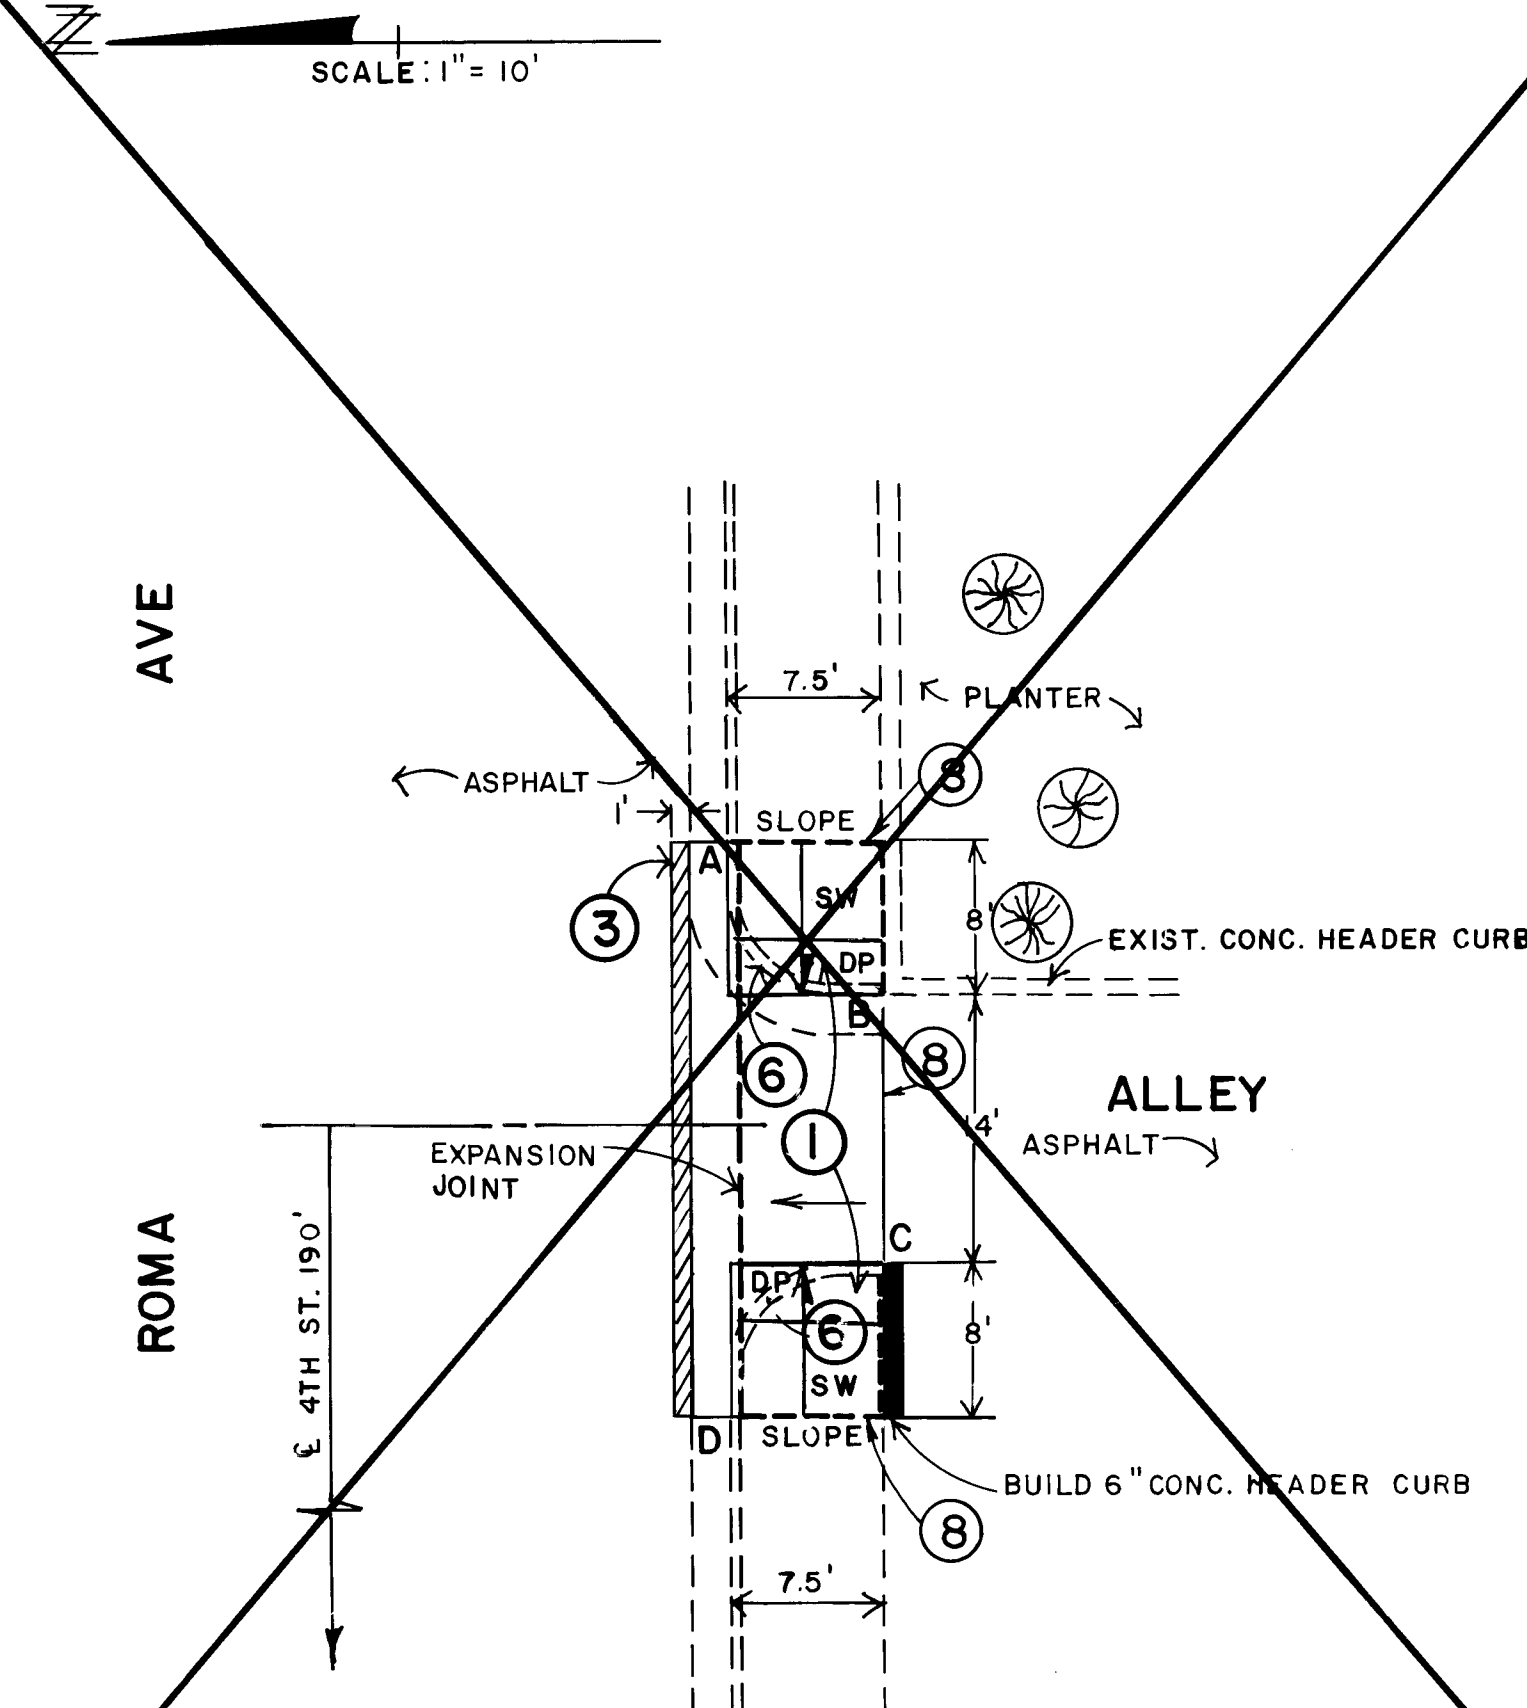


ROMA BETWEEN 3RD ST. & 4TH ST.

- GENERAL NOTES:**
- 1 BUILD CONCRETE DRIVEPAD
 - 2 BUILD STANDARD CURB, GUTTER & SIDEWALK.
 - 3 REMOVE AND REPLACE ONE FOOT OF ASPHALT PAVING NEXT TO ALL NEW CURB & GUTTER.
 - 4 BUILD NEW WHEEL CHAIR RAMP AS SHOWN.
 - 5 REFERENCE BRASS CAP BEFORE CONSTRUCTION AND REPLACE AFTER CONSTRUCTION.
 - 6 REMOVE EXISTING CURB & GUTTER BETWEEN A&B AND C&D.
 - 7 REMOVE SIDEWALK TO NEAREST JOINT.
 - 8 MATCH EXISTING

- LEGEND**
- EXISTING CURB & GUTTER
 - EXPANSION JOINT
 - ASPHALT PAVEMENT
 - HEADER CURB

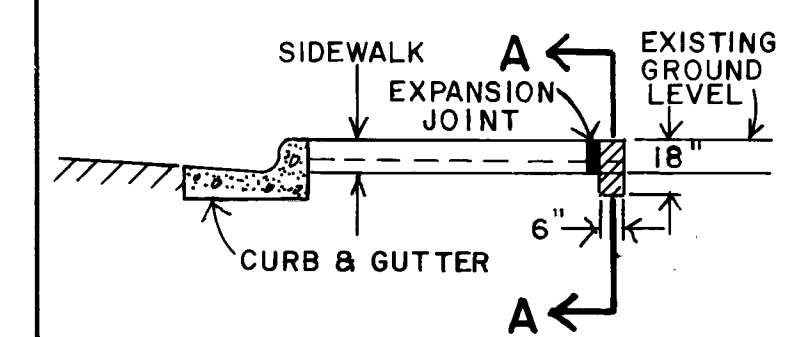

HEADERWALL DETAIL

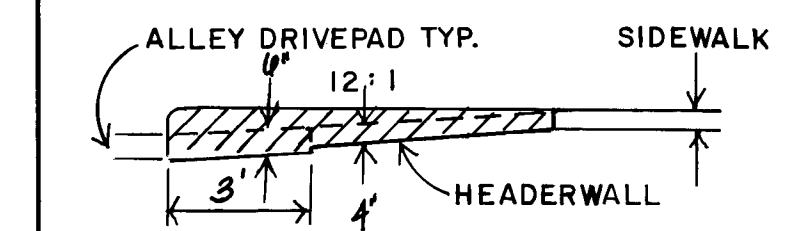

SECTION A - A

REVISIONS		REVISIONS	
NO.	DATE	NO.	DATE

CITY OF ALBUQUERQUE
MUNICIPAL DEVELOPMENT DEPARTMENT
ENGINEERING DIVISION

TITLE: INSTALLATION OF ALLEY DRIVEPADS, SIDEWALK AND CURB & GUTTER AT VARIOUS LOCATIONS IN THE CENTRAL BUSINESS DISTRICT.

APPROVALS	ENGINEER	DATE	APPROVALS	ENGINEER	DATE
City Engineer	<i>[Signature]</i>	7-27-83	Liquid Waste	<i>[Signature]</i>	7/27/83
A.C.E. - Design	<i>[Signature]</i>	7-27-83	Traffic	<i>[Signature]</i>	7/27/83
A.C.E. - Hydrology	<i>[Signature]</i>	7-27-83	Water	<i>[Signature]</i>	7/27/83

DRAWING NO. 1491 MAP NO. J-14 SHEET 4 OF 4
K-13, K-14