


PENNSYLVANIA WIDENING SOUTH OF MENAUL, CATCH BASIN RELOCATION

INDEX

SHEET	TITLE	PAGE
SHEET 1	PLAN	
SHEET 2	CROSS SECTIONS	

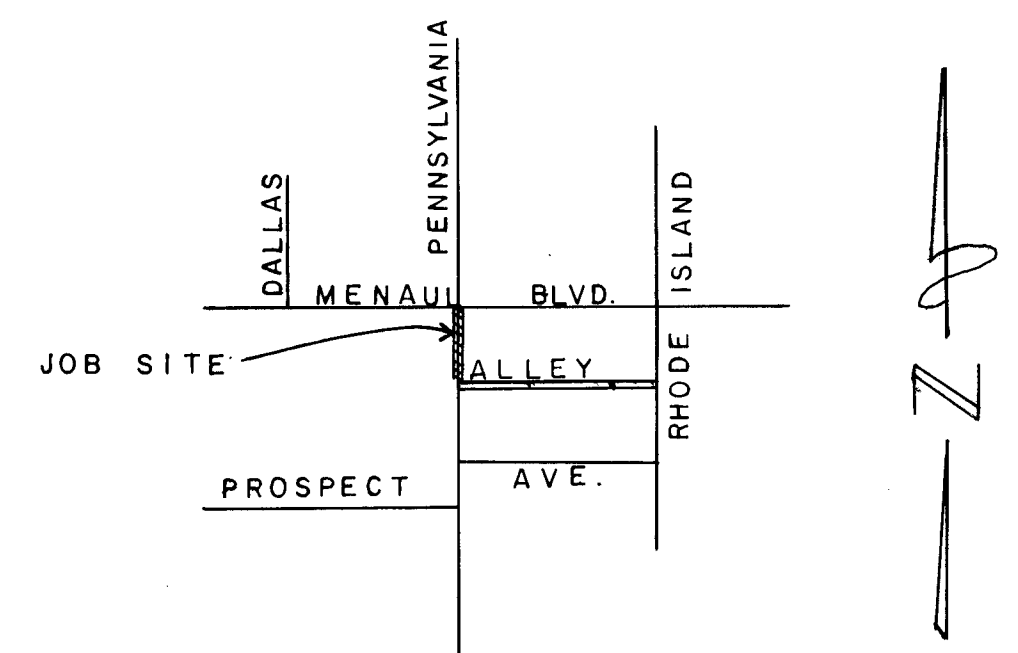

LOCATION MAP

"NOTICE TO CONTRACTOR"

- All work detailed on these plans to be performed under contract shall, except as otherwise stated or provided for herein, be constructed in accordance with the New Mexico Standard Specifications for Public Works Construction (1979 Edition) (referred to herein as the Standard Specifications) and the Contract Documents for City-Wide Utilities and Cash Paving No. 31.
- Two (2) working days prior to any excavation, contractor must contact Line Locating Service, 765-1234, for location of existing utilities.
- Prior to construction, the contractor shall excavate and verify the horizontal and vertical locations of all proposed work. Should a conflict exist, the contractor shall notify the engineer in writing so that the conflict can be resolved with minimum amount of delay.

THE FOLLOWING NOTES APPLY WHEN CHECKED

- ☐ All utilities and utility service lines shall be located prior to paving.
- ☒ Backfill and compact shall be according to specification when used.
- ☒ Tack coat requirements shall be determined by the City Engineer.
- ☒ Sidewalks and wheelchair ramps will be constructed with or without curb and gutter.
- ☒ If curb is depressed for a depressed or a raised ramp, the depressed or ramp shall be constructed prior to construction of the curb and gutter.
- ☒ All storm drainage facilities shall be constructed prior to final construction.

APPROVAL OF AS BUILT DRAWINGS
ASST. CITY ENGINEER - FIELD
<i>[Signature]</i>
DATE 12/28/84

REV.	SHEETS	CITY ENGR.	DATE	USER DEPT.	DATE	USER DEPT.	DATE
26	2 of 3						
26	2 of 3						

CITY OF ALBUQUERQUE

APPROVED FOR
CONSTRUCTION
[Signature]
CITY ENGR. 12/28/84

1498

SHEET 1 OF 3

26 1498 0184

26 1498 0182



1. CONTRACTOR MUST SUBMIT A CONSTRUCTION SIGNING AND BARRICADING PLAN TO TRAFFIC ENGINEERING DIVISION AND RECEIVE A BARRICADING PERMIT PRIOR TO CONSTRUCTION.
2. ALL CONSTRUCTION SIGNING AND BARRICADING TO COMPLY WITH MANUAL ON UNIFORM TRAFFIC CONTROL DEVICES, 1978 EDITION.
3. CONTRACTOR'S OPERATION, BARRICADING AND SIGNING SHALL NOT AFFECT THRU LANES OF PENNSYLVANIA BETWEEN 7 AM AND 9 AM OR 4 PM AND 6 PM.

JOB LOCATION			AS BUILT INFORMATION		
NOTICE TO CONTRACTORS 1 New Mexico Standard Specifications for Public Works Construction -1979 Edition will be referred to hereon as the "Standard Specifications." 2 All work detailed on these plans to be performed under contract shall, except as otherwise stated or provided for hereon, be constructed in accordance with "Contract Documents for City-Wide Utilities and Cash Paving No. 3/" and the Standard Specifications. 3 Two working days prior to any excavation, contractor must contact Line Locating Service, 765-1234, for location of existing utilities. 4 Prior to construction, the contractor shall excavate and verify the horizontal and vertical locations of all obstructions. Should a conflict exist, the contractor shall notify the engineer or survey so that the conflict can be resolved with minimum of delay. THE FOLLOWING NOTES APPLY WHEN CHECKED : ☐ All utilities and utility service lines shall be installed prior to paving. ☒ Backfill compaction shall be according to specified street use. (<i>ARTERIAL</i>) ☒ Tack coat requirements shall be determined by the City Engineer. ☒ Sidewalks and wheelchair ramps within the curb returns shall be constructed wherever a new curb return is constructed. ☒ If curb is depressed for a driveway, the driveway shall be constructed prior to acceptance of the curb and gutter. ☒ All storm drain facilities shall be completed prior to final acceptance.			BENCH MARKS		
			SURVEY INFORMATION		
			ENGINEER'S SEAL		
			REVISIONS		
			DESIGN		
DESIGNED BY S. MIRANDA DRAWN BY D. PETTE, A. SALAZAR CHECKED BY [Signature]			DATE 6-29-82 DATE 1/11/82 DATE 12-28-82		
NO. DATE REMARKS BY PS-2 H. MERCER 8-5-82 D. KERR R. SANCHEZ			FIELD NOTES		
1-H-19 ENE COR. PENNSYLVANIA & INDIAN SCHOOL RD., BRASS CAP BACK OF SIDEWALK SET OF 4. PENNSYLVANIA ELEV. 5323.896 8-H-19 BRASS CAP IN SE RETT PENNSYLVANIA & MENAUL ELEV. 5341.93			DATE		
CONTRACTOR NEW CONCEPTS			WORK ORDER BY INSPECTORS ACCEPTANCE BY DATE		
VERIFICATION BY REGINALD DATES-84			DATE		
CORRECTED BY ROBERTO DATES-84			DATE		
MICRO-FILM INFORMATION			RECORDED BY NO.		

26 1498 0284

CITY OF ALBUQUERQUE MUNICIPAL DEVELOPMENT DEPARTMENT ENGINEERING DIVISION					
					GD 82-5
TITLE: PENNSYLVANIA WIDENING SOUTH OF MENAUL, CATCH BASIN RELOCATION					
APPROVALS	ENGINEER	DATE	APPROVALS	ENGINEER	DATE
City Engineer	[Signature]	4/24/83	Liquid Waste	[Signature]	12-28-82
A.C.E.-Design	[Signature]	12 Apr 83	Traffic	[Signature]	1/11/82
A.C.E.-Hydrology	[Signature]	12-28-82	Water	[Signature]	12-28-82
QA	[Signature]	4-11-83			
DRAWING NO.	1498		MAP NO.	H-19	
			SHEET	2 OF 3	