

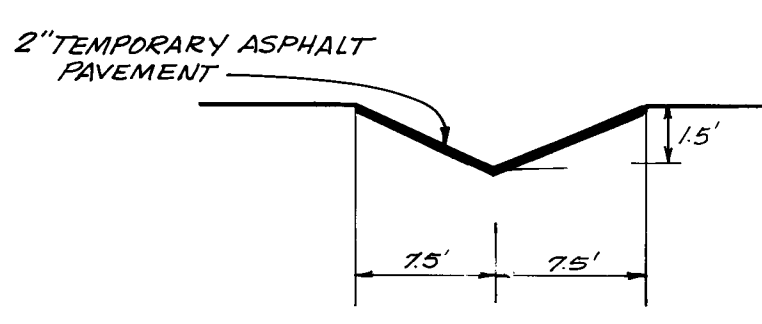


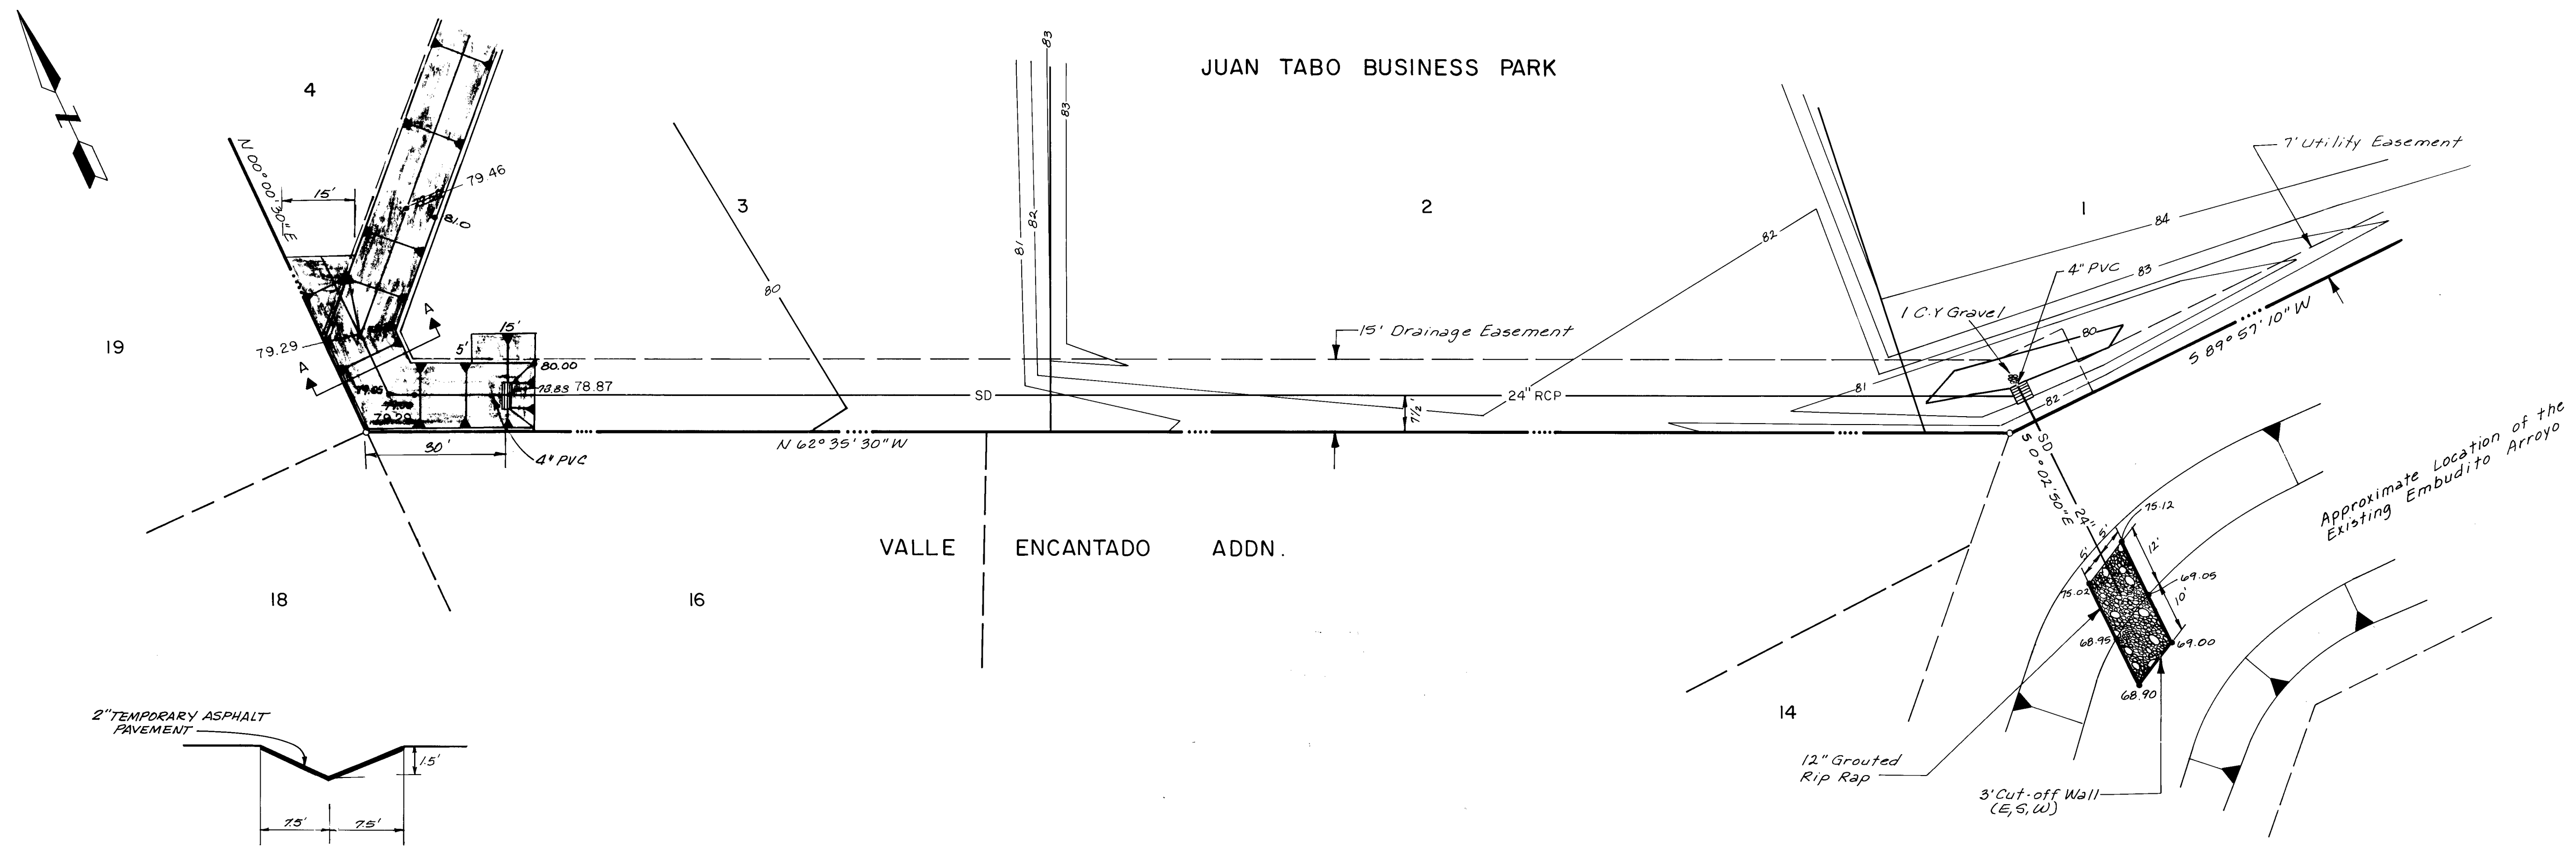

SECTION A-A

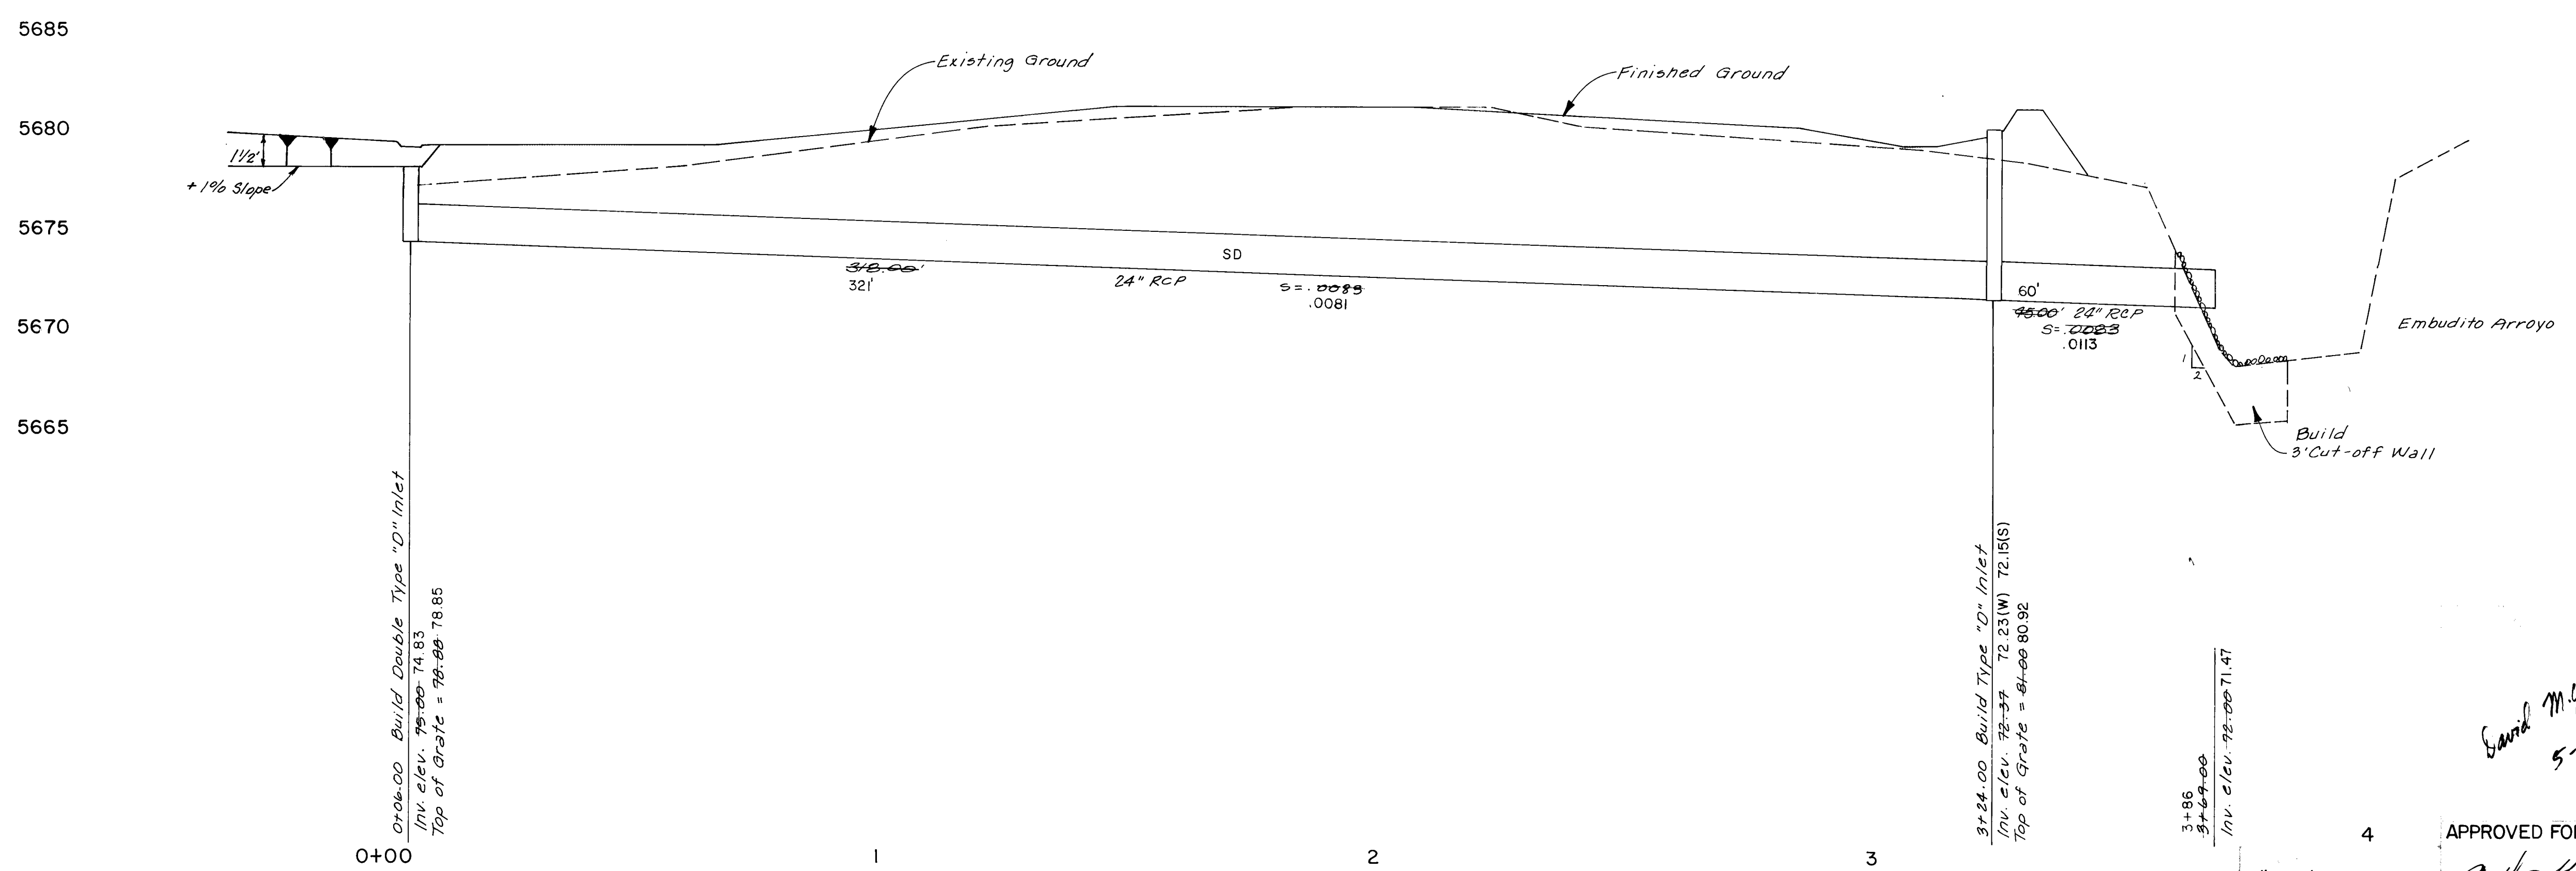

Good Mfg. Machine
5-17-82

APPROVED FOR CONSTRUCTION
C. H. [Signature]
CITY ENGINEER
DATE 1/10/82

MUNICIPAL DEVELOPMENT DEPARTMENT
ENGINEERING DIVISION
JUAN TABO BUSINESS PARK
STORM DRAIN

City Engineer	cm [Signature]	Liquid Waste	N.A. [Signature]
A.C.E. Design	1/10/82	Traffic	N.A. [Signature]
A.C.E. Hydrology	1/10/82	Water	N.A. [Signature]

1504

STANDARD ACS BRASS TABLET STAMPED
"ACS JI-1A", SET IN TOP OF A CONCRETE
POST FLUSH WITH CURB. THE STATION IS
LOCATED AT THE INTERSECTION OF
MONTGOMERY BLVD. N.E. AND JUAN TABO
BLVD N.E. ON THE SOUTH MEDIAN.
ELEV. 5721.25