


CITY OF ALBUQUERQUE
COMMUNITY DEVELOPMENT PROGRAM
OLD TOWN AREA PAVING PROJECT CD-4D

TOHATCHI TRAIL
THOMPSON ROAD

INDEX
SHT. 1 - TITLE SHEET
SHT. 2 - STREET P&P's
SHT. 3 - UTILITY P&P

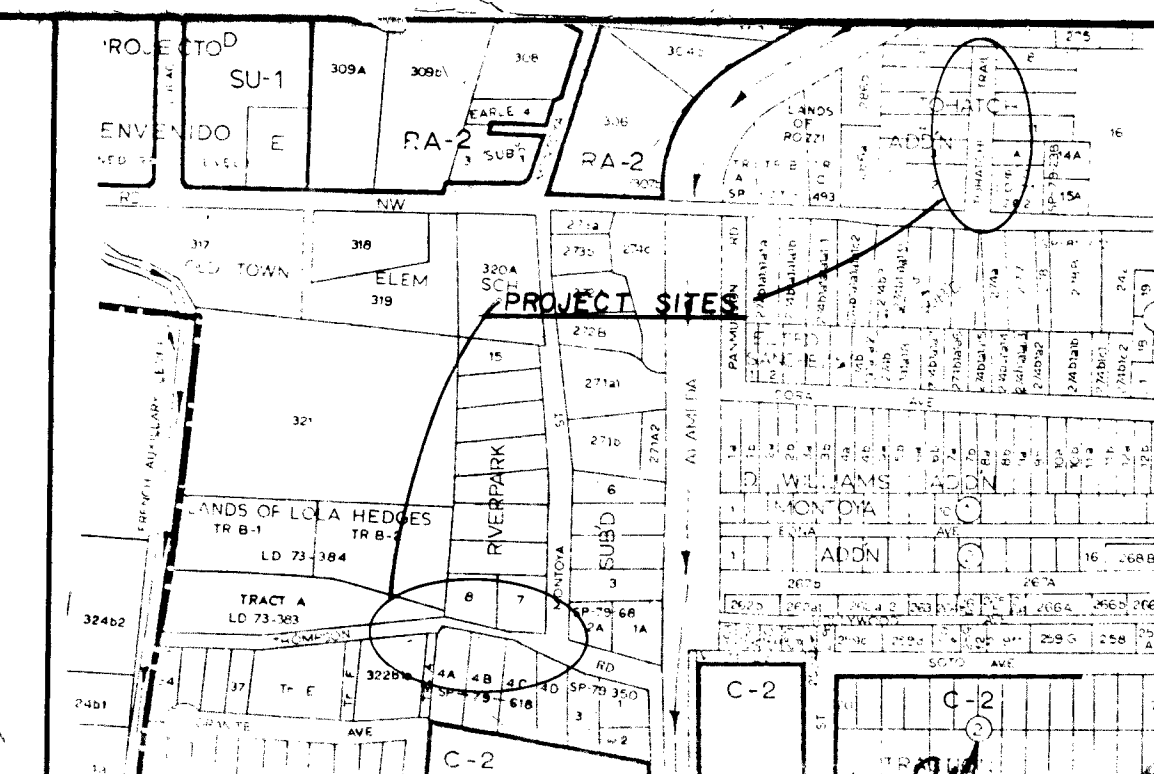

LOCATION MAP J-12

"NOTICE TO CONTRACTOR"

- All work detailed on these plans to be performed under contract shall, except as otherwise stated or provided for herein, be constructed in accordance with the New Mexico Standard Specifications for Public Works Construction-1975 Edition (referred to herein as the "Standard Specifications") and the Contract Documents for City-Wide Utilities and Curb Paving No. 31.
- Two (2) working days prior to any excavation, contractor must contact Line Locating Service, 765-1234, for location of existing utilities.
- Prior to construction, the contractor shall excavate and verify the horizontal and vertical locations of all obstructions. Should a conflict exist, the contractor shall notify the engineer or surveyor so that the conflict can be resolved with minimum amount of delay.

THE FOLLOWING NOTES APPLY WHEN CHECKED

- ☒ All utilities and utility service lines shall be installed prior to paving.
- ☐ Backfill compaction shall be according to specified street use.
- ☒ Tack coat requirements shall be determined by the City Engineer.
- ☐ Sidewalks and wheelchair ramps within the curb returns shall be constructed wherever a new curb return is constructed.
- ☐ If curb is depressed for a driveway or a handicap ramp, the driveway or ramp shall be constructed prior to acceptance of the curb and gutter.
- ☐ All storm drainage facilities shall be completed prior to final acceptance.


26 1505 0183

APPROVAL OF AS BUILT DRAWINGS
CITY ENGINEER-FIELD
W. J. McNamee
DATE 11-14-82
Rev'd - 11/19/84

REV.	SHEETS	CITY ENGR.	DATE	USER DEPT.	DATE	USER DEPT.	DATE
APPROVAL OF REVISIONS							
		CITY OF ALBUQUERQUE		APPROVED FOR CONSTRUCTION			
		1505		<i>R. Smith</i> 11/13/82			
				CITY ENGR.			
				SHEET 1		OF 3	


PLAN	DATE	BY	CHECKED	DATE
NO. 1				
NO. 2				
NO. 3				
NO. 4				
NO. 5				
NO. 6				
NO. 7				
NO. 8				
NO. 9				
NO. 10				

PROFILE	DATE	BY	CHECKED	DATE
NO. 1				
NO. 2				
NO. 3				
NO. 4				
NO. 5				
NO. 6				
NO. 7				
NO. 8				
NO. 9				
NO. 10				

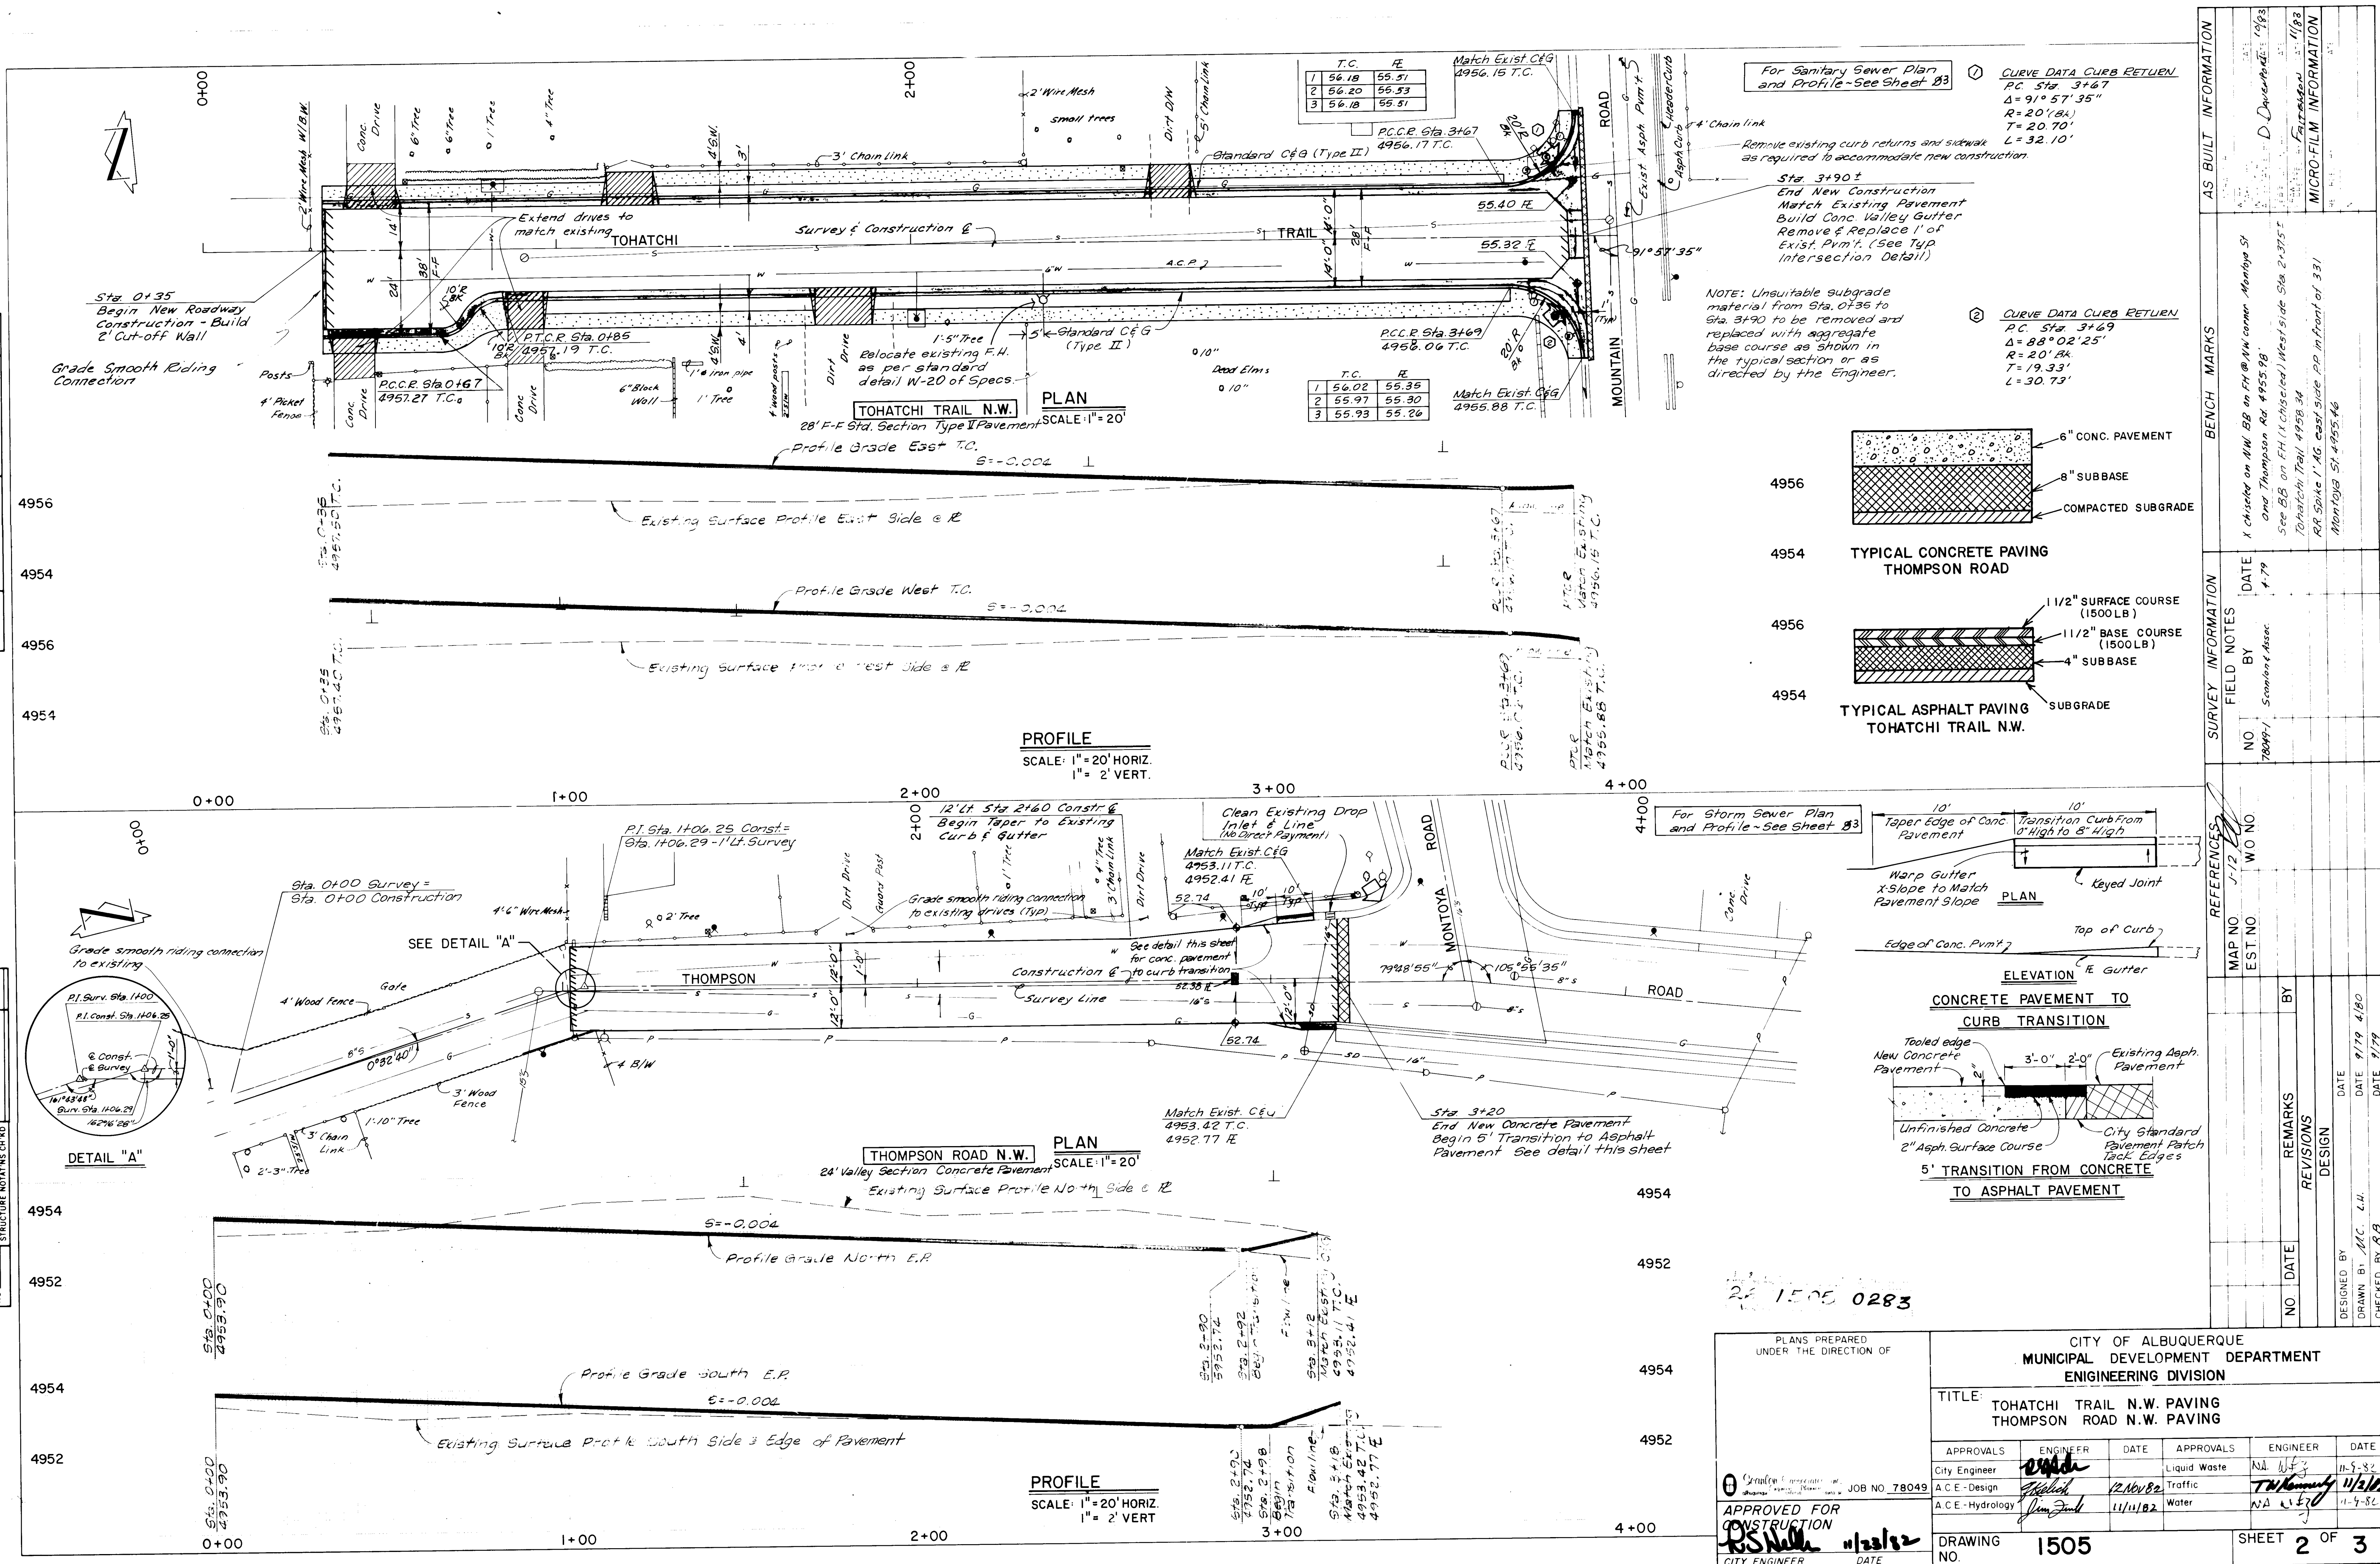

PLANS PREPARED UNDER THE DIRECTION OF		CITY OF ALBUQUERQUE MUNICIPAL DEVELOPMENT DEPARTMENT ENGINEERING DIVISION			
TITLE		TOHATCHI TRAIL N.W. PAVING THOMPSON ROAD N.W. PAVING			
APPROVALS	ENGINEER	DATE	APPROVALS	ENGINEER	DATE
City Engineer	11/1/82	11/1/82	Liquid Waste	11/1/82	11/1/82
A.C.E. Design	11/1/82	11/1/82	Traffic	11/1/82	11/1/82
A.C.E. Hydrology	11/1/82	11/1/82	Water	11/1/82	11/1/82
DRAWING NO.		1505		SHEET 2 OF 3	
CITY ENGINEER		DATE		DESIGNED BY	
11/1/82		11/1/82		CHECKED BY	
11/1/82		11/1/82		11/1/82	

PROFILE	SURVIVED	BY	DATE
	PLOTTED		
NOTE BOOK	GRAPHS CHECKED		
NO	B. M. : NOTED		
	STRUCTURE NOTATIONS CH'ED		

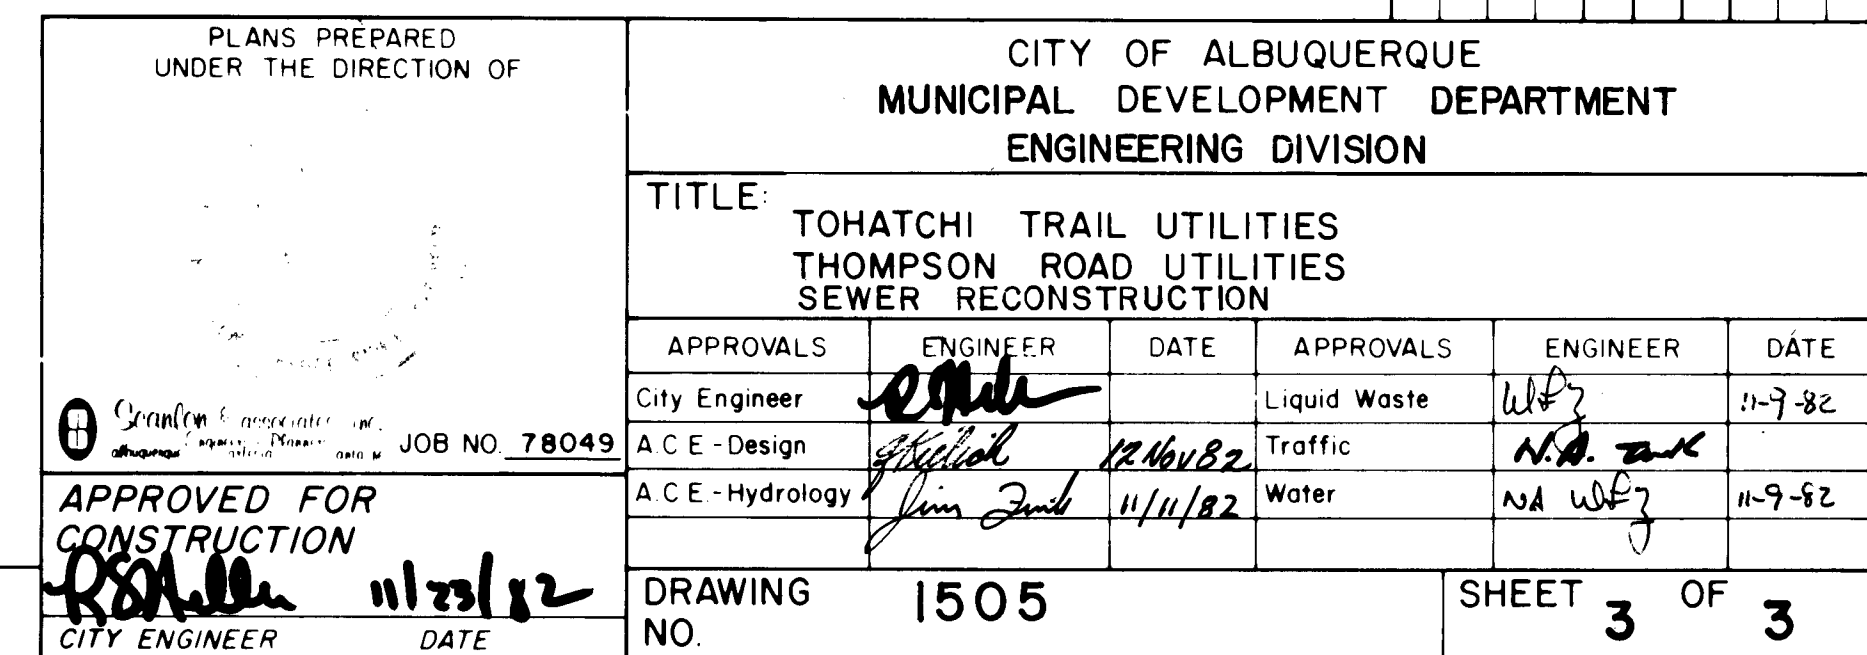[illegible]