



48 HOURS PRIOR TO ANY EXCAVATION, CONTRACTOR MUST CONTACT LINE AND CABLE LOCATING SERVICE, 765-1234, FOR LOCATION OF EXISTING UTILITIES.

32' STANDARD SECTION
REGINA CIRCLE J-II

PLAN
SCALE: 1" = 40'

LOCATION MAP




MAP NO. J-11
APPROVED FOR CONSTRUCTION
C. R. Shepard
City Engineer
Date: 10/17/78

TITLE: WATER EXTENSION ON REGINA ROAD AND REGINA CIRCLE

APPROVALS	ENGINEER	DATE	APPROVALS	ENGINEER	DATE
City Engineer	Shepard	10/17/78	Liquid Waste		
ACE Design	Kubik	10/17/78	Traffic		
ACE Hydrology			Water		

DRAWING NO. W-150-78

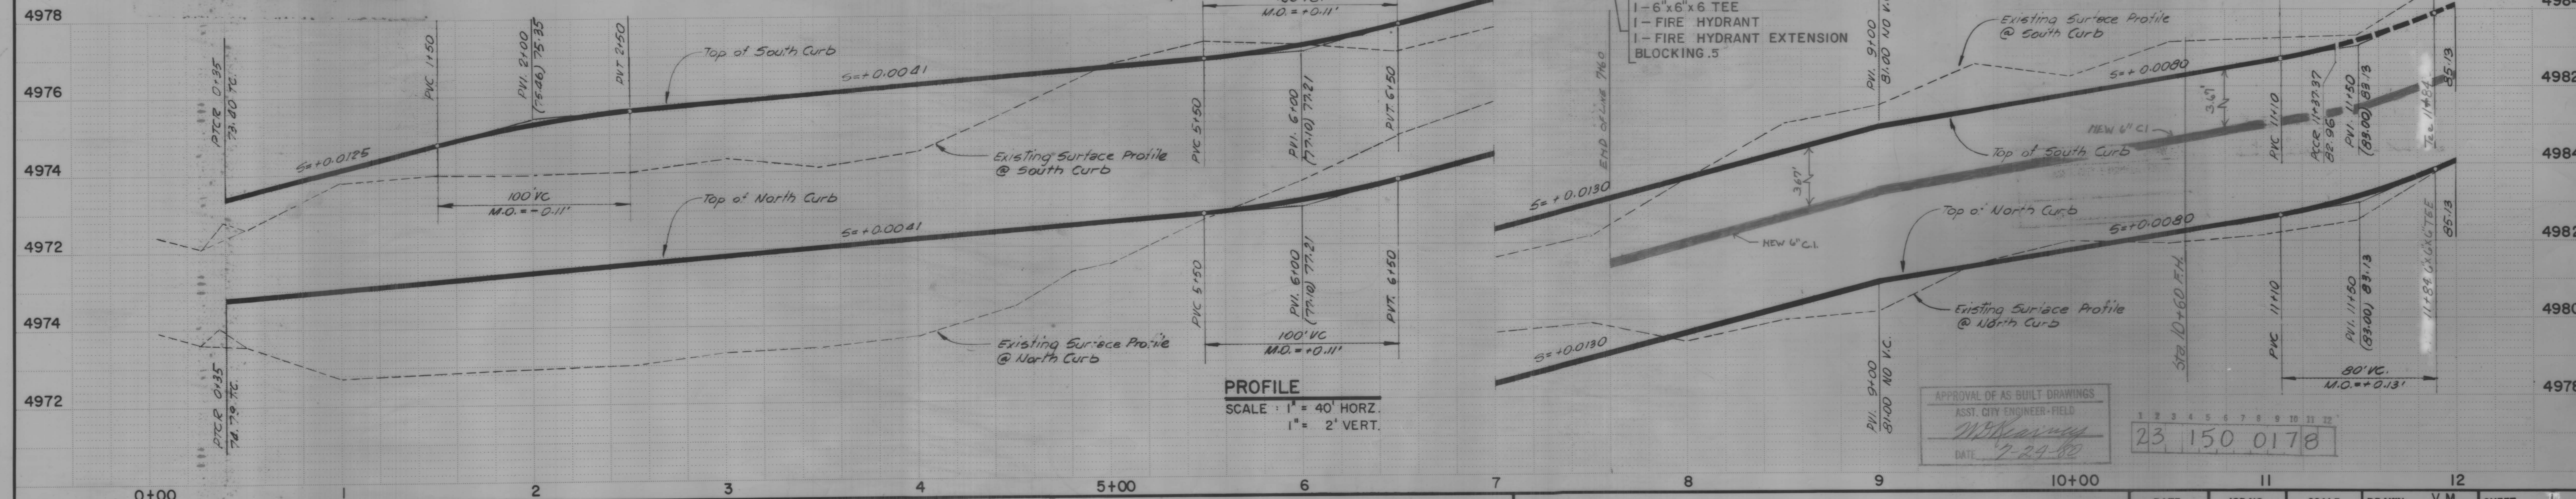

PROFILE
SCALE: 1" = 40' HORZ.
1" = 2' VERT.

APPROVAL OF AS-BUILT DRAWINGS
ASST. CITY ENGINEER - FIELD
M. R. Shepard
DATE: 7-29-80

23 150 0178



COMMUNITY DEVELOPMENT PROGRAM
ALBUQUERQUE CD-35
albuquerque bernalillo county new mexico

WEST MESA
REGINA CIRCLE

SCANNED BY
BY LASON

DATE	JOB NO.	SCALE	DRAWN:	SHEET
FEB. 78	77054	AS SHOWN	V.M.	1
			CHK'D: R.L.	OF 3

Scanlon & associates, inc.
Engineers-Planners
albuquerque artesa santa fe



32' STANDARD SECTION
REGINA ROAD J-11

PLAN
SCALE: 1" = 40'

48 HOURS PRIOR TO ANY EXCAVATION, CONTRACTOR **MUST** CONTACT LINE AND CABLE LOCATING SERVICE, 765-1234, FOR LOCATION OF EXISTING UTILITIES.



APPROVAL OF AS BUILT DRAWINGS
ASST. CITY ENGINEER-FIELD
[Signature]
DATE 8-9-88

1 2 3 4 5 6 7 8 9 10 11 12
23 150 0278

APPROVED FOR CONSTRUCTION
[Signature]
Serving City Engineer Date 10/12/88

TITLE: WATER EXTENSION ON REGINA ROAD AND REGINA CIRCLE

APPROVALS	ENGINEER	DATE	APPROVALS	ENGINEER	DATE
City Engineer	<i>[Signature]</i>	8/9/88	Liquid Waste		
ACE Design	<i>[Signature]</i>	8/14/88	Traffic		
ACE-Hydrology	<i>[Signature]</i>		Water	<i>[Signature]</i>	

DRAWING NO. W-150-78



COMMUNITY DEVELOPMENT PROGRAM
ALBUQUERQUE CD-38
albuquerque bernalillo county new mexico

WEST MESA
REGINA ROAD

SCANNED BY
BYLASON

DATE FEB. 78	JOB NO. 77054	SCALE AS SHOWN	DRAWN: V.M. CHK'D: R.L.	SHEET OF 3
-----------------	------------------	-------------------	----------------------------------	------------------

Scanlon & associates, inc.
albuquerque Engineers-Planners artists santa fe




32' STANDARD SECTION
REGINA CIRCLE J-II



32' STANDARD SECTION
REGINA DRIVE J-II

PLAN
SCALE: 1" = 40'

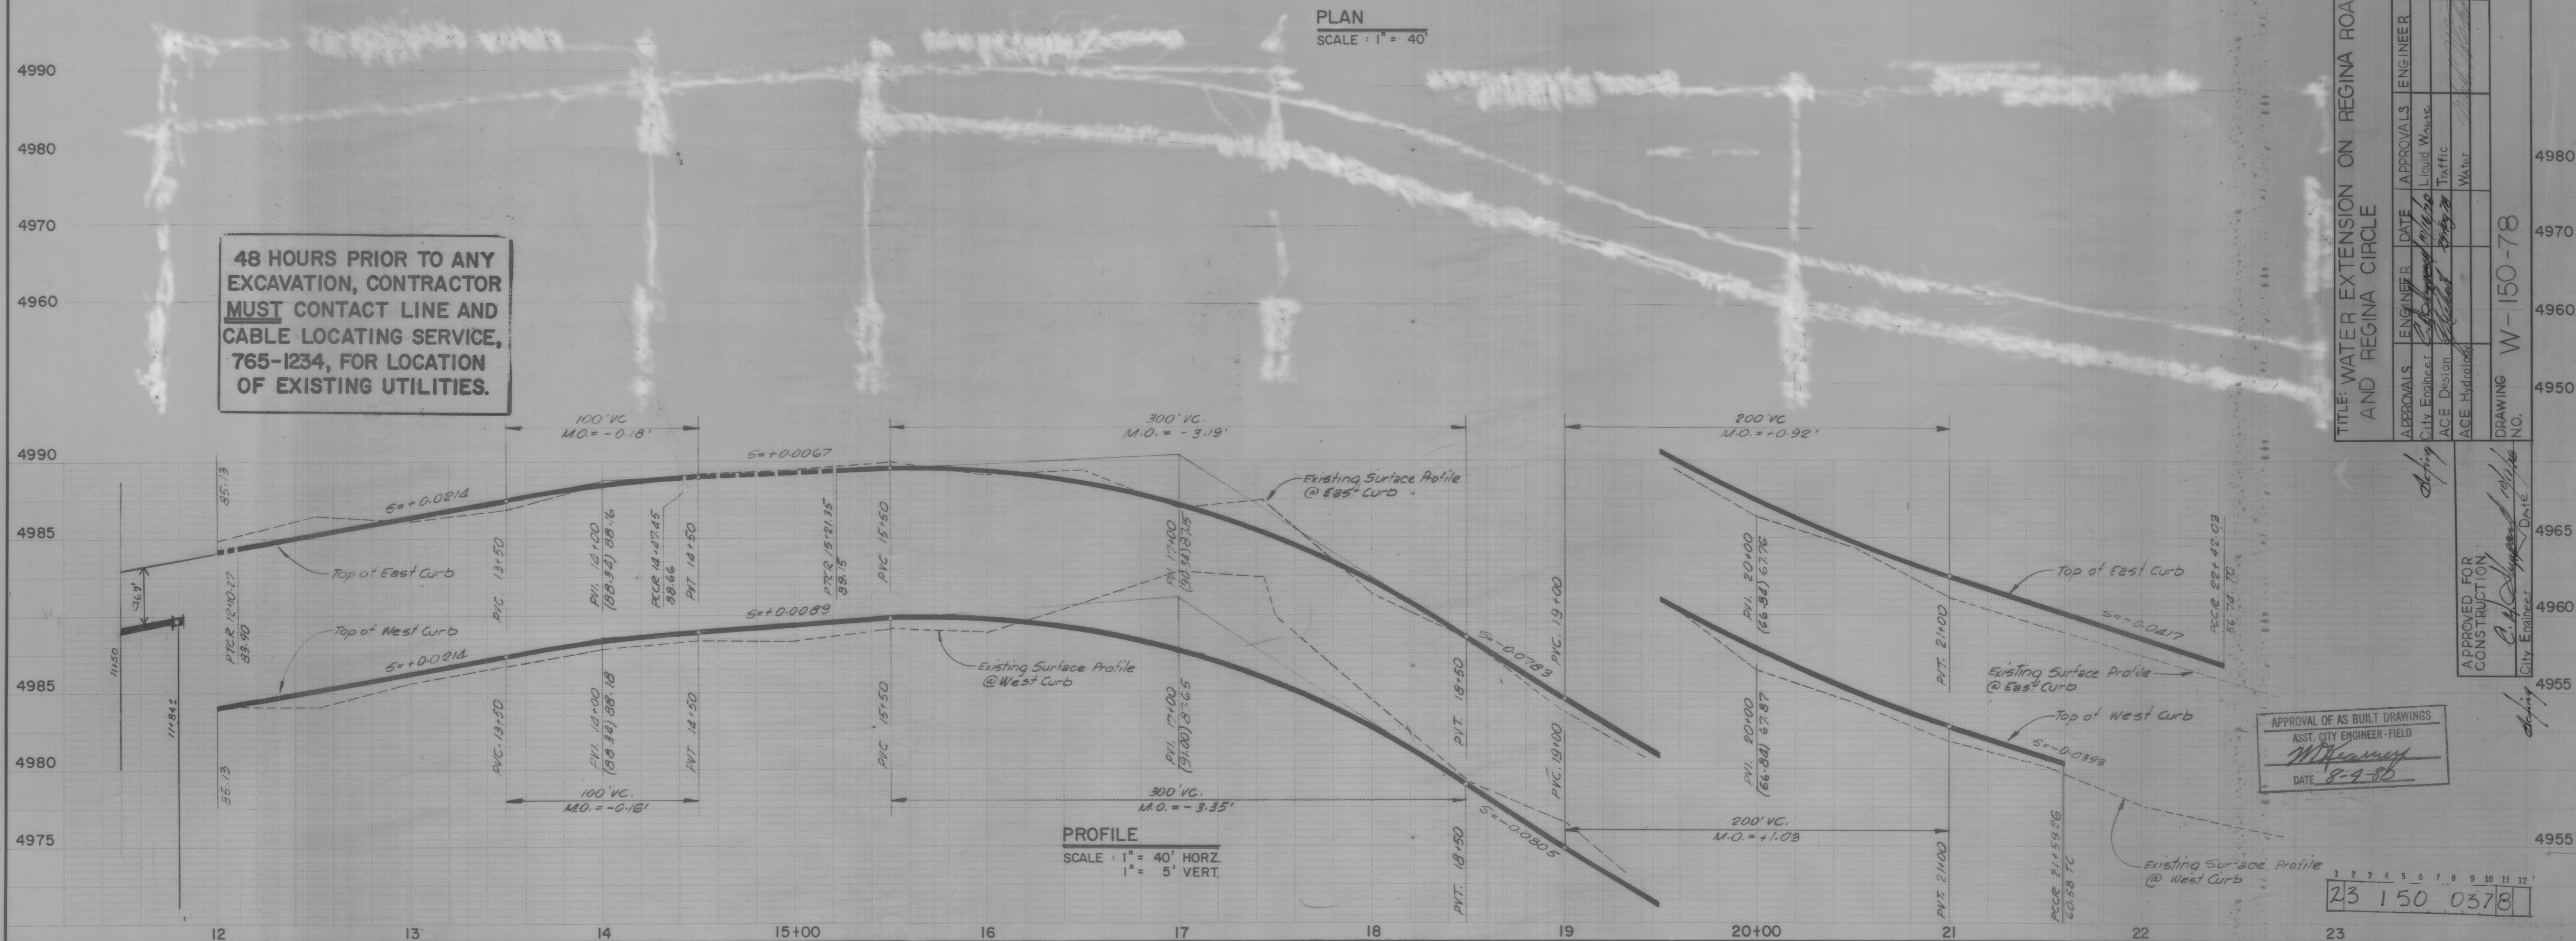

TITLE: WATER EXTENSION ON REGINA ROAD AND REGINA CIRCLE

APPROVALS	ENGINEER	DATE	APPROVALS	ENGINEER	DATE
CITY Engineer	<i>[Signature]</i>	8-9-80	CITY Engineer	<i>[Signature]</i>	8-9-80
ACE Design	<i>[Signature]</i>	8-9-80	ACE Design	<i>[Signature]</i>	8-9-80
ACE Hydraulic	<i>[Signature]</i>	8-9-80	ACE Hydraulic	<i>[Signature]</i>	8-9-80

DRAWING NO. W-150-78

APPROVAL OF AS BUILT DRAWINGS
ASST. CITY ENGINEER - FIELD
[Signature]
DATE 8-9-80

23 150 0378



COMMUNITY DEVELOPMENT PROGRAM
ALBUQUERQUE CD 3B
albuquerque bernalillo county new mexico

WEST MESA
REGINA CIRCLE - REGINA DRIVE

SCANNED BY
BY LASON

DATE FEB. 78	JOB NO. 77054	SCALE AS SHOWN	DRAWN: V.M. CHK'D: R.L.	SHEET 3 OF 3
-----------------	------------------	-------------------	----------------------------	-----------------

Scanlon & associates, inc.
albuquerque engineers-planners architects santa fe