


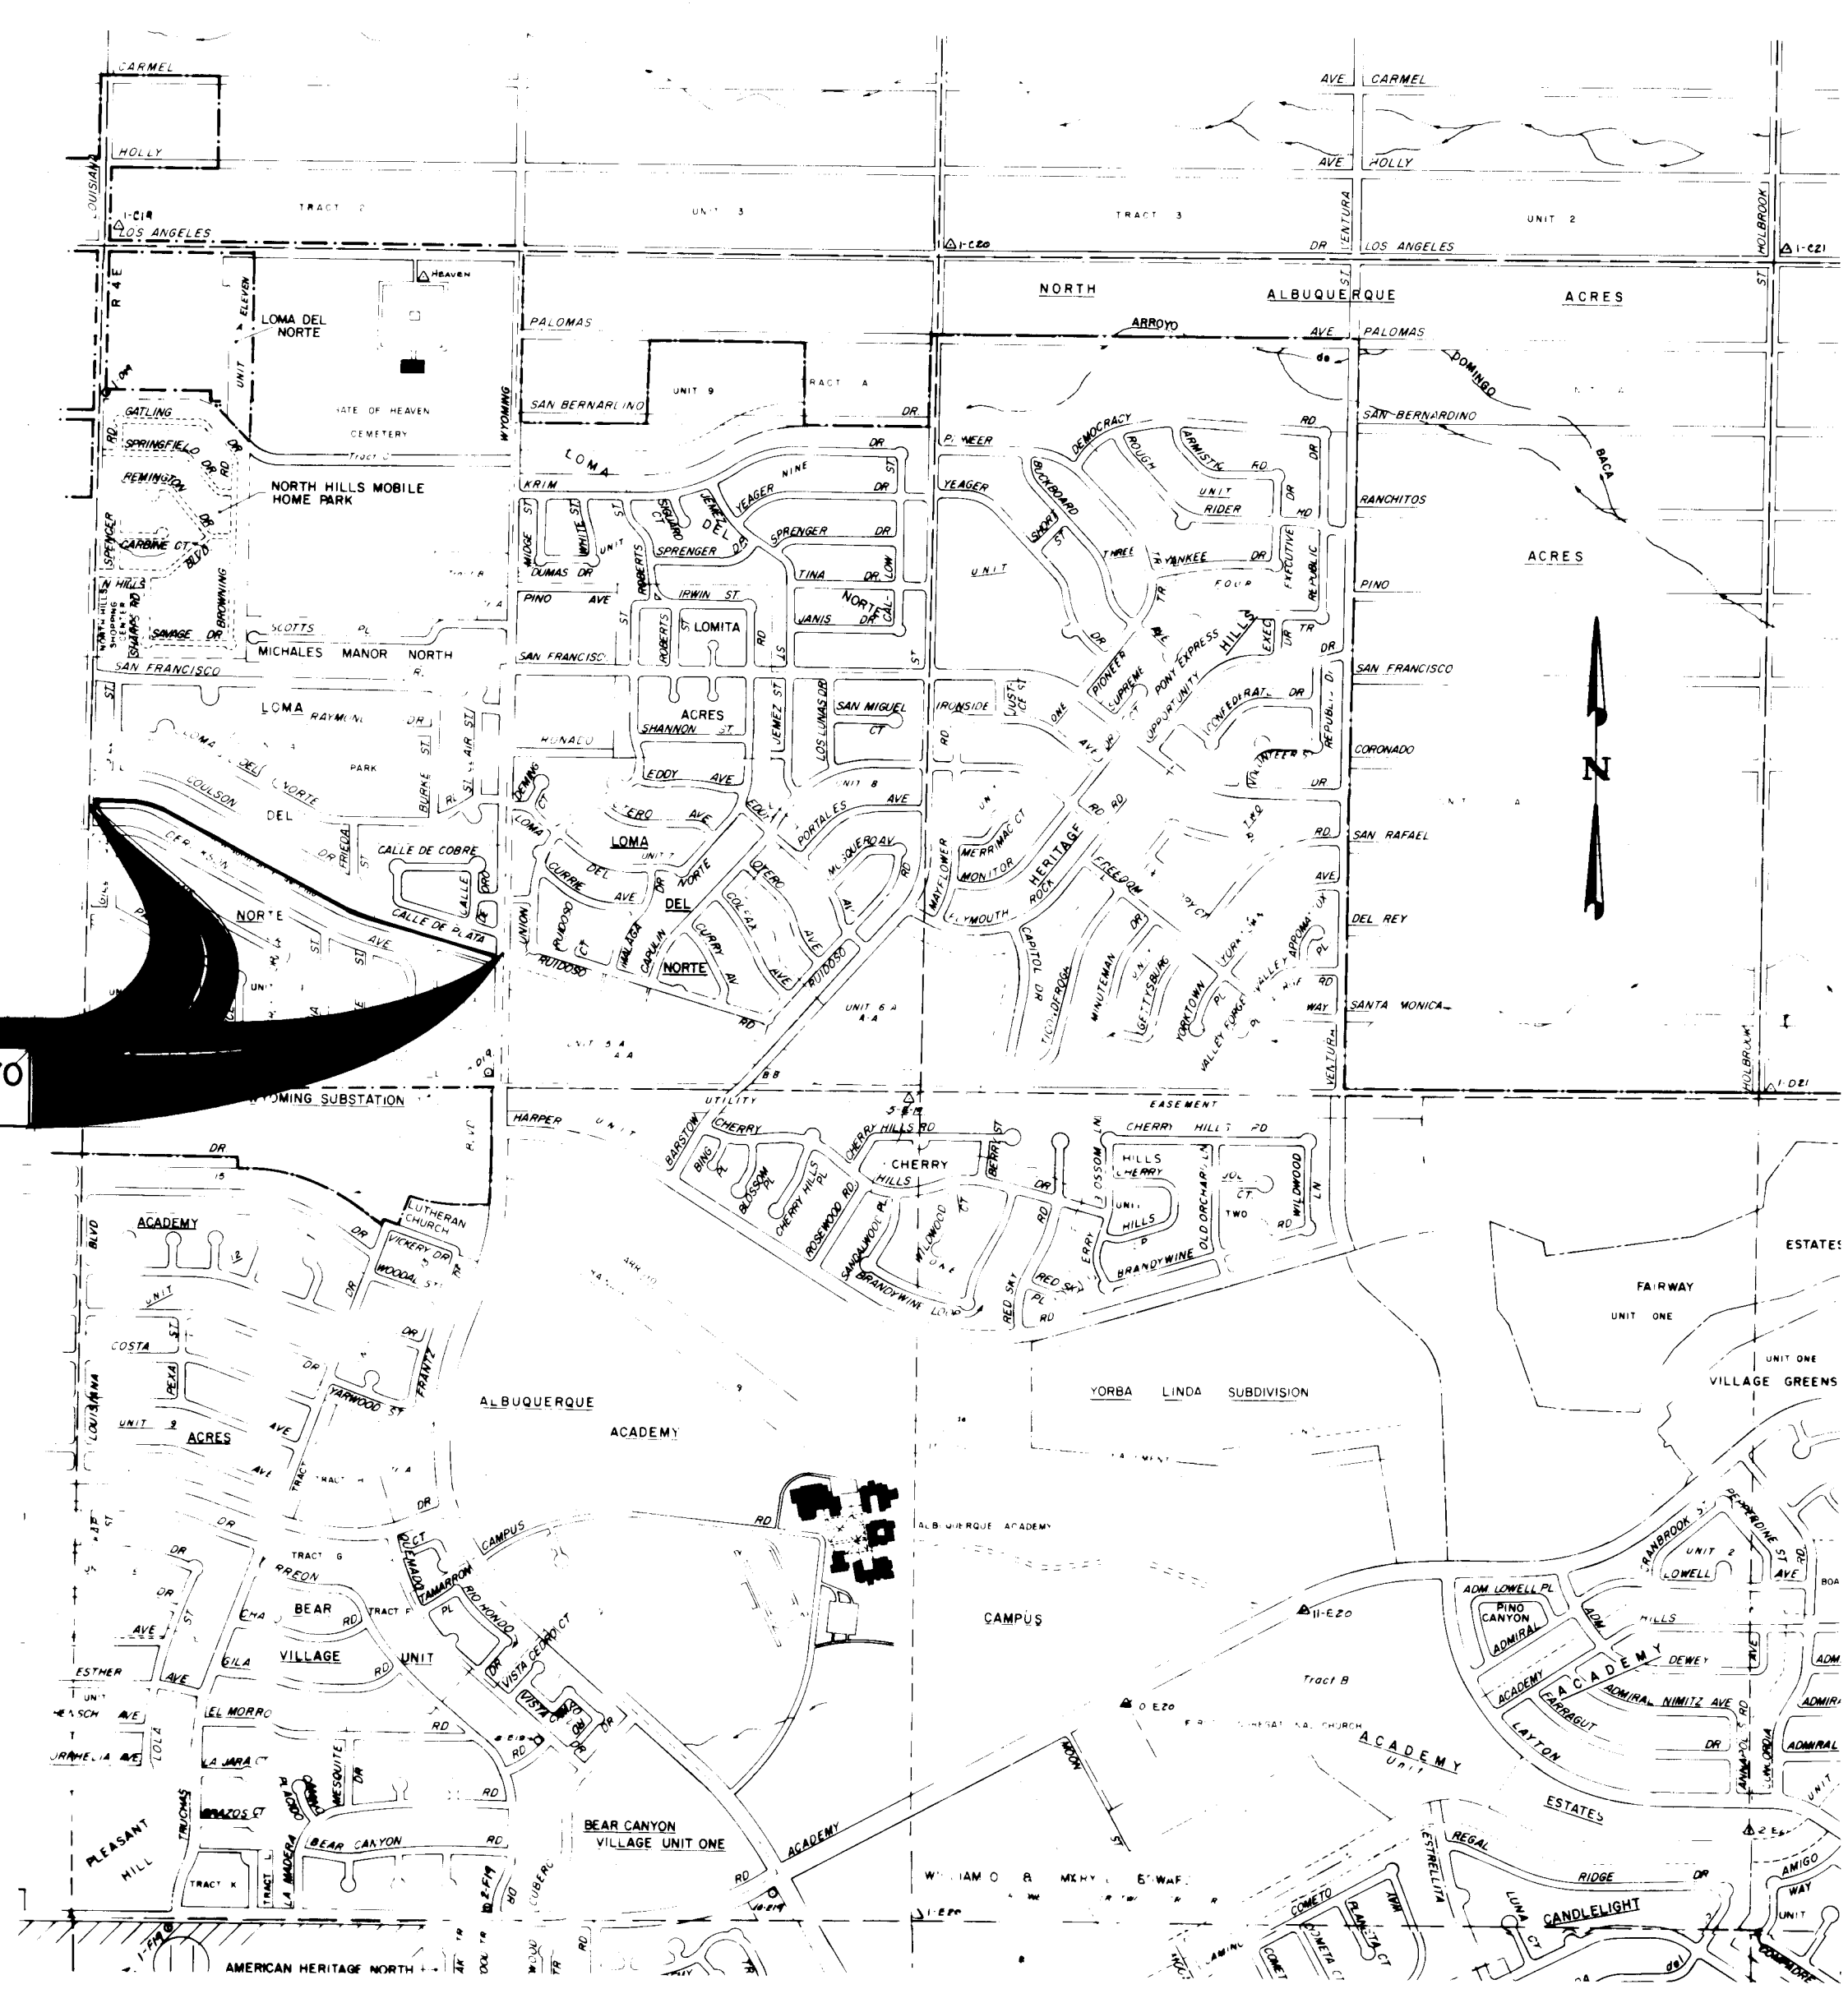


LOCATION MAP
SCALE: 1"=1000'

NORTH PINO ARROYO SLOPE PAVING

INDEX TO SHEETS

SHEET NO.	TITLE
1 OF 8	TITLE SHEET, LOCATION MAP AND INDEX
2 OF 8	PLAN AND PROFILE STA. 0+00 TO STA. 5+00
3 OF 8	PLAN AND PROFILE STA. 5+00 TO STA. 10+60
4 OF 8	PLAN AND PROFILE STA. 10+60 TO STA. 16+20
5 OF 8	PLAN AND PROFILE STA. 16+20 TO STA. 21+80
6 OF 8	PLAN AND PROFILE STA. 21+80 TO STA. 27+40
7 OF 8	PLAN AND PROFILE STA. 27+40 TO STA. 29+00 AND DETAILS
8 OF 8	CROSS SECTIONS

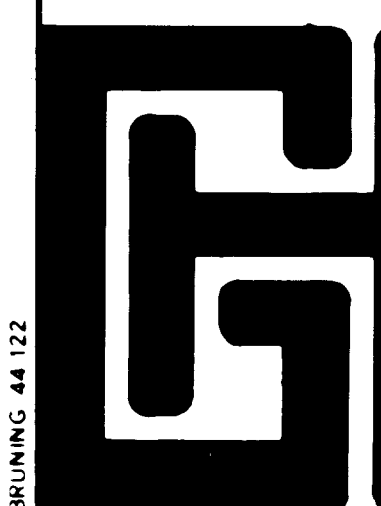


GORDON HERKENHOFF & ASSOCIATES, INC.
302 Eighth Street, N.W.
Albuquerque, New Mexico 87102
(505) 247-0294

HOBBS FARMINGTON SANTA FE

APPROVAL OF AS BUILT DRAWINGS
ASST. CITY ENGINEER - FIELD
[Signature]
DATE 7-15-82


1 2 3 4 5 6 7 8 9 10 11 12
26 15 100 182 JOB 541.21


CITY OF ALBUQUERQUE PUBLIC WORKS DEPARTMENT ENGINEERING DIVISION					
TITLE: TITLE SHEET, LOCATION MAP AND INDEX					
APPROVALS	ENGINEER	DATE	APPROVALS	ENGINEER	DATE
City Engineer			Liquid Waste		
A.C.E. - Design	<i>[Signature]</i>	7/15/82	Traffic		
A.C.E. - Hydrology			Water		
DRAWING NO. 1510			SHEET 1 OF 8		

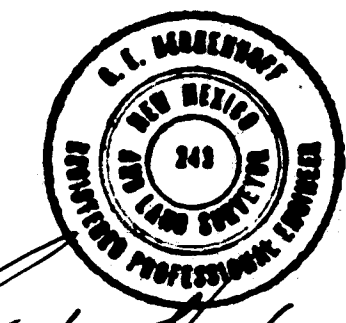



APPROVED FOR
CONSTRUCTION
[Signature] 7/15/82
CITY ENGINEER DATE

 1210



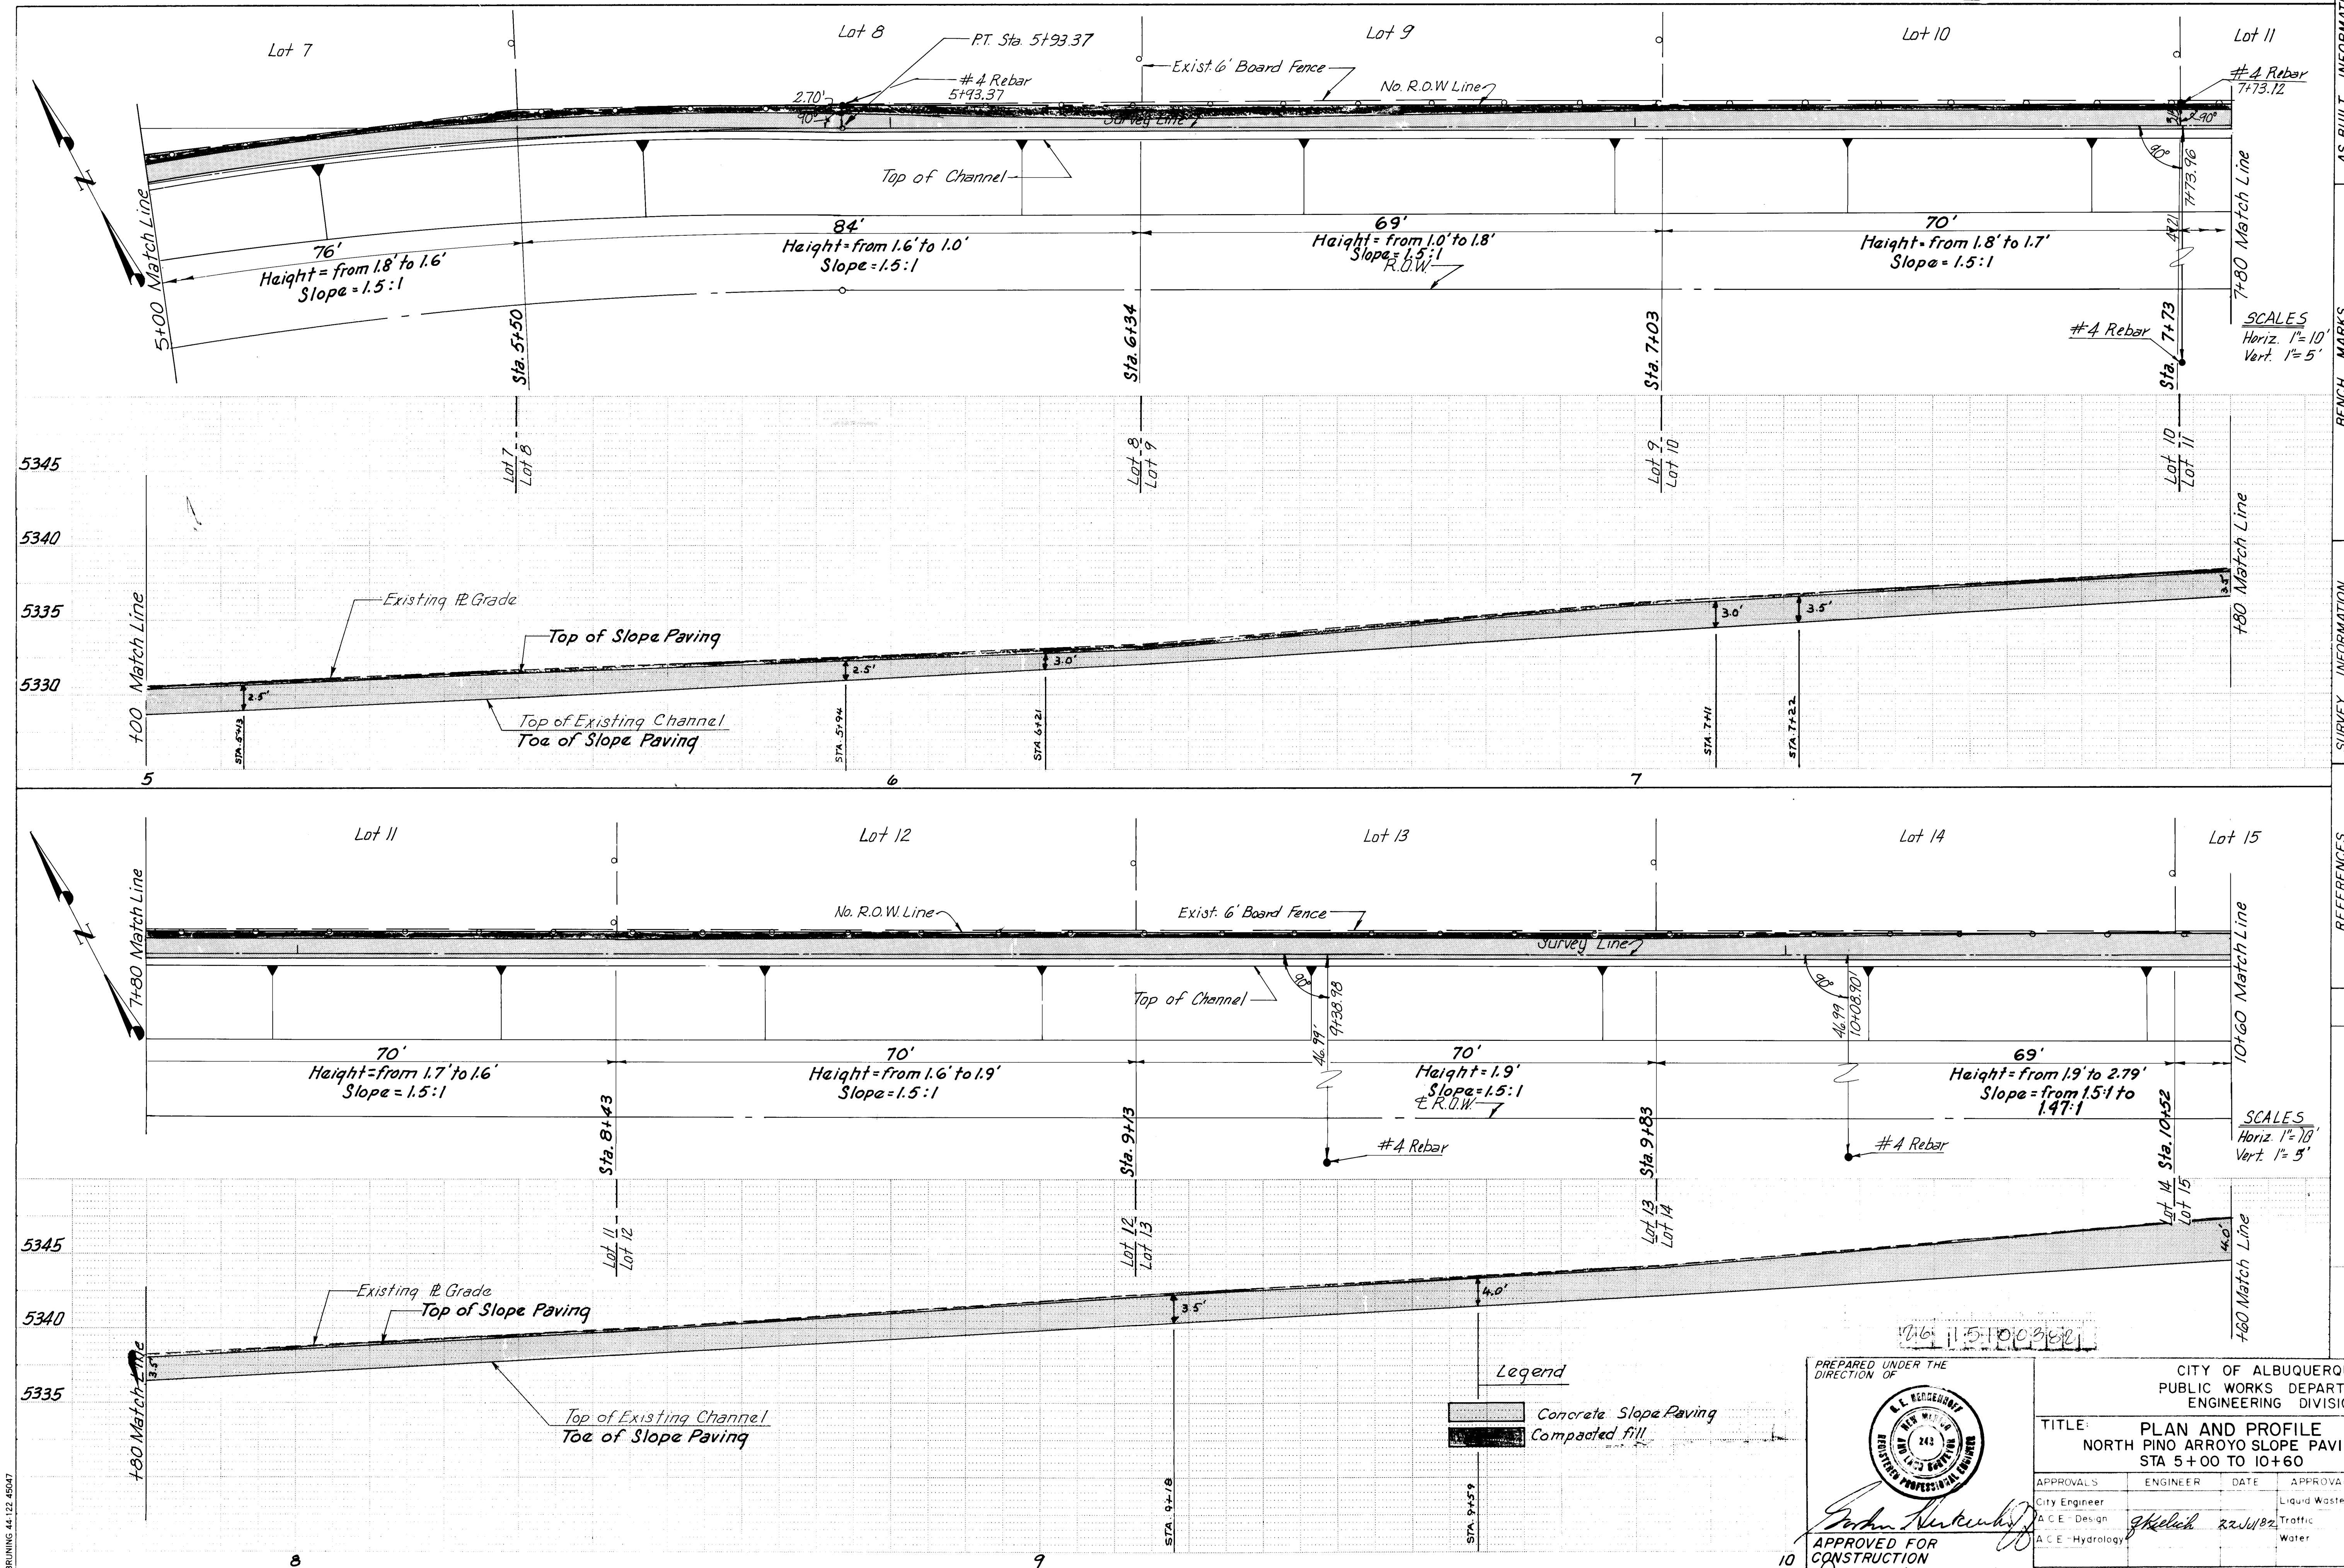[illegible]

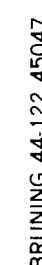[illegible]

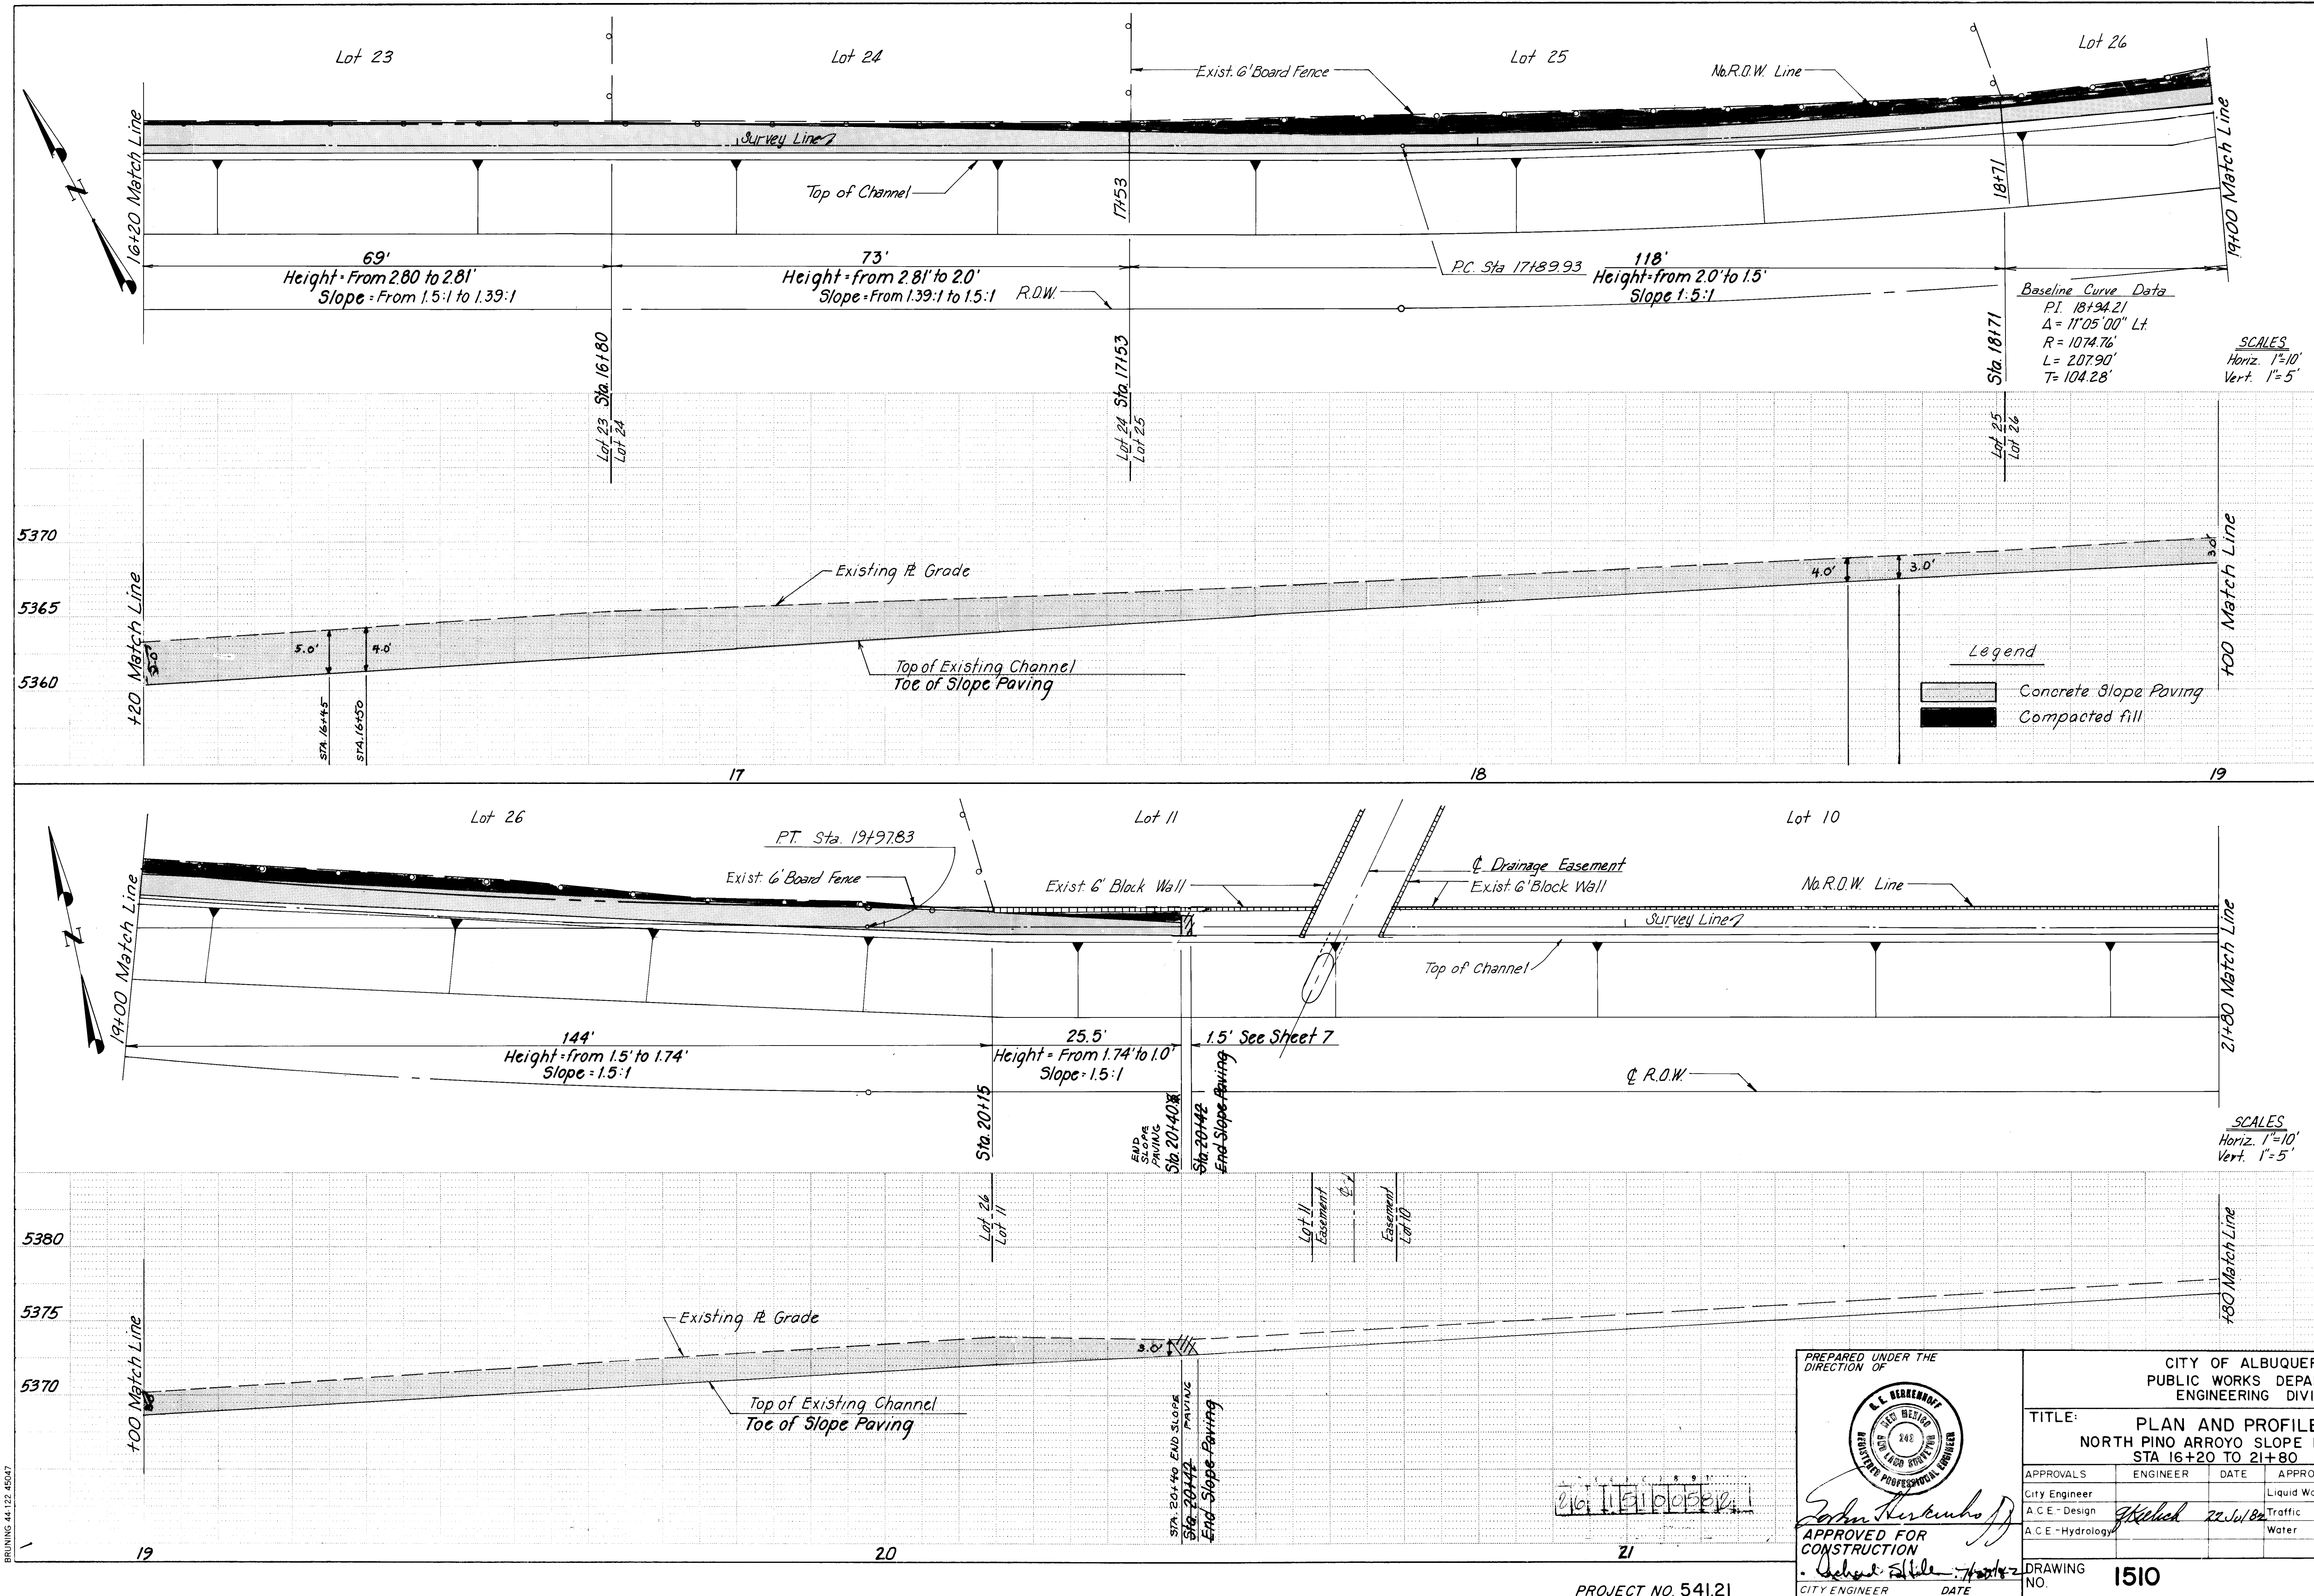

AS BUILT INFORMATION			BENCH MARKS		
CONTRACTOR	DATE	BY	CONTRACTOR	DATE	BY
INSPECTED BY	DATE	BY	CONTRACTOR	DATE	BY
ACCEPTANCE BY	DATE	BY	CONTRACTOR	DATE	BY
REVISIONS	DATE	BY	CONTRACTOR	DATE	BY
DESIGNED BY	DATE	BY	CONTRACTOR	DATE	BY
DRAWN BY	DATE	BY	CONTRACTOR	DATE	BY
CHECKED BY	DATE	BY	CONTRACTOR	DATE	BY

SURVEY INFORMATION			REFERENCES		
FIELD NOTES	DATE	BY	MAP NO.	EST. NO.	BY
NO.	DATE	BY	MAP NO.	EST. NO.	BY

REVISIONS			DESIGN		
NO.	DATE	REMARKS	NO.	DATE	REMARKS
1			1		
2			2		
3			3		
100			100		

PREPARED UNDER THE DIRECTION OF

John Kerkumbo

APPROVED FOR CONSTRUCTION

CITY ENGINEER

DATE

CITY OF ALBUQUERQUE

PUBLIC WORKS DEPARTMENT


ENGINEERING DIVISION

TITLE: **PLAN AND PROFILE NORTH PINO ARROYO SLOPE PAVING STA 16+20 TO 21+80**

APPROVALS	ENGINEER	DATE	APPROVALS	ENGINEER	DATE
City Engineer			Liquid Waste		
A.C.E. - Design			Traffic		
A.C.E. - Hydrology			Water		

DRAWING NO. **1510**

SHEET **5** OF **8**

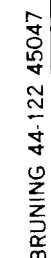

PREPARED UNDER THE
DIRECTION OF



Edna Kirtan

APPROVED FOR
CONSTRUCTION





Richard S. Allen

CITY ENGINEER

DATE


APPROVALS	ENGINEER	DATE	APPROVALS	ENGINEER	DATE
City Engineer			Liquid Waste		
A C E - Design	<i>Handwritten Signature</i>	22 Jul 80	Traffic		
A C E - Hydrology			Water		

SHEET 6 OF 8

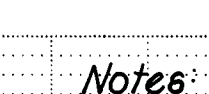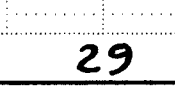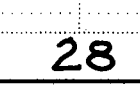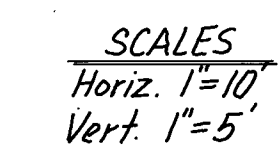


- [illegible]

PROJECT NO. 541.21

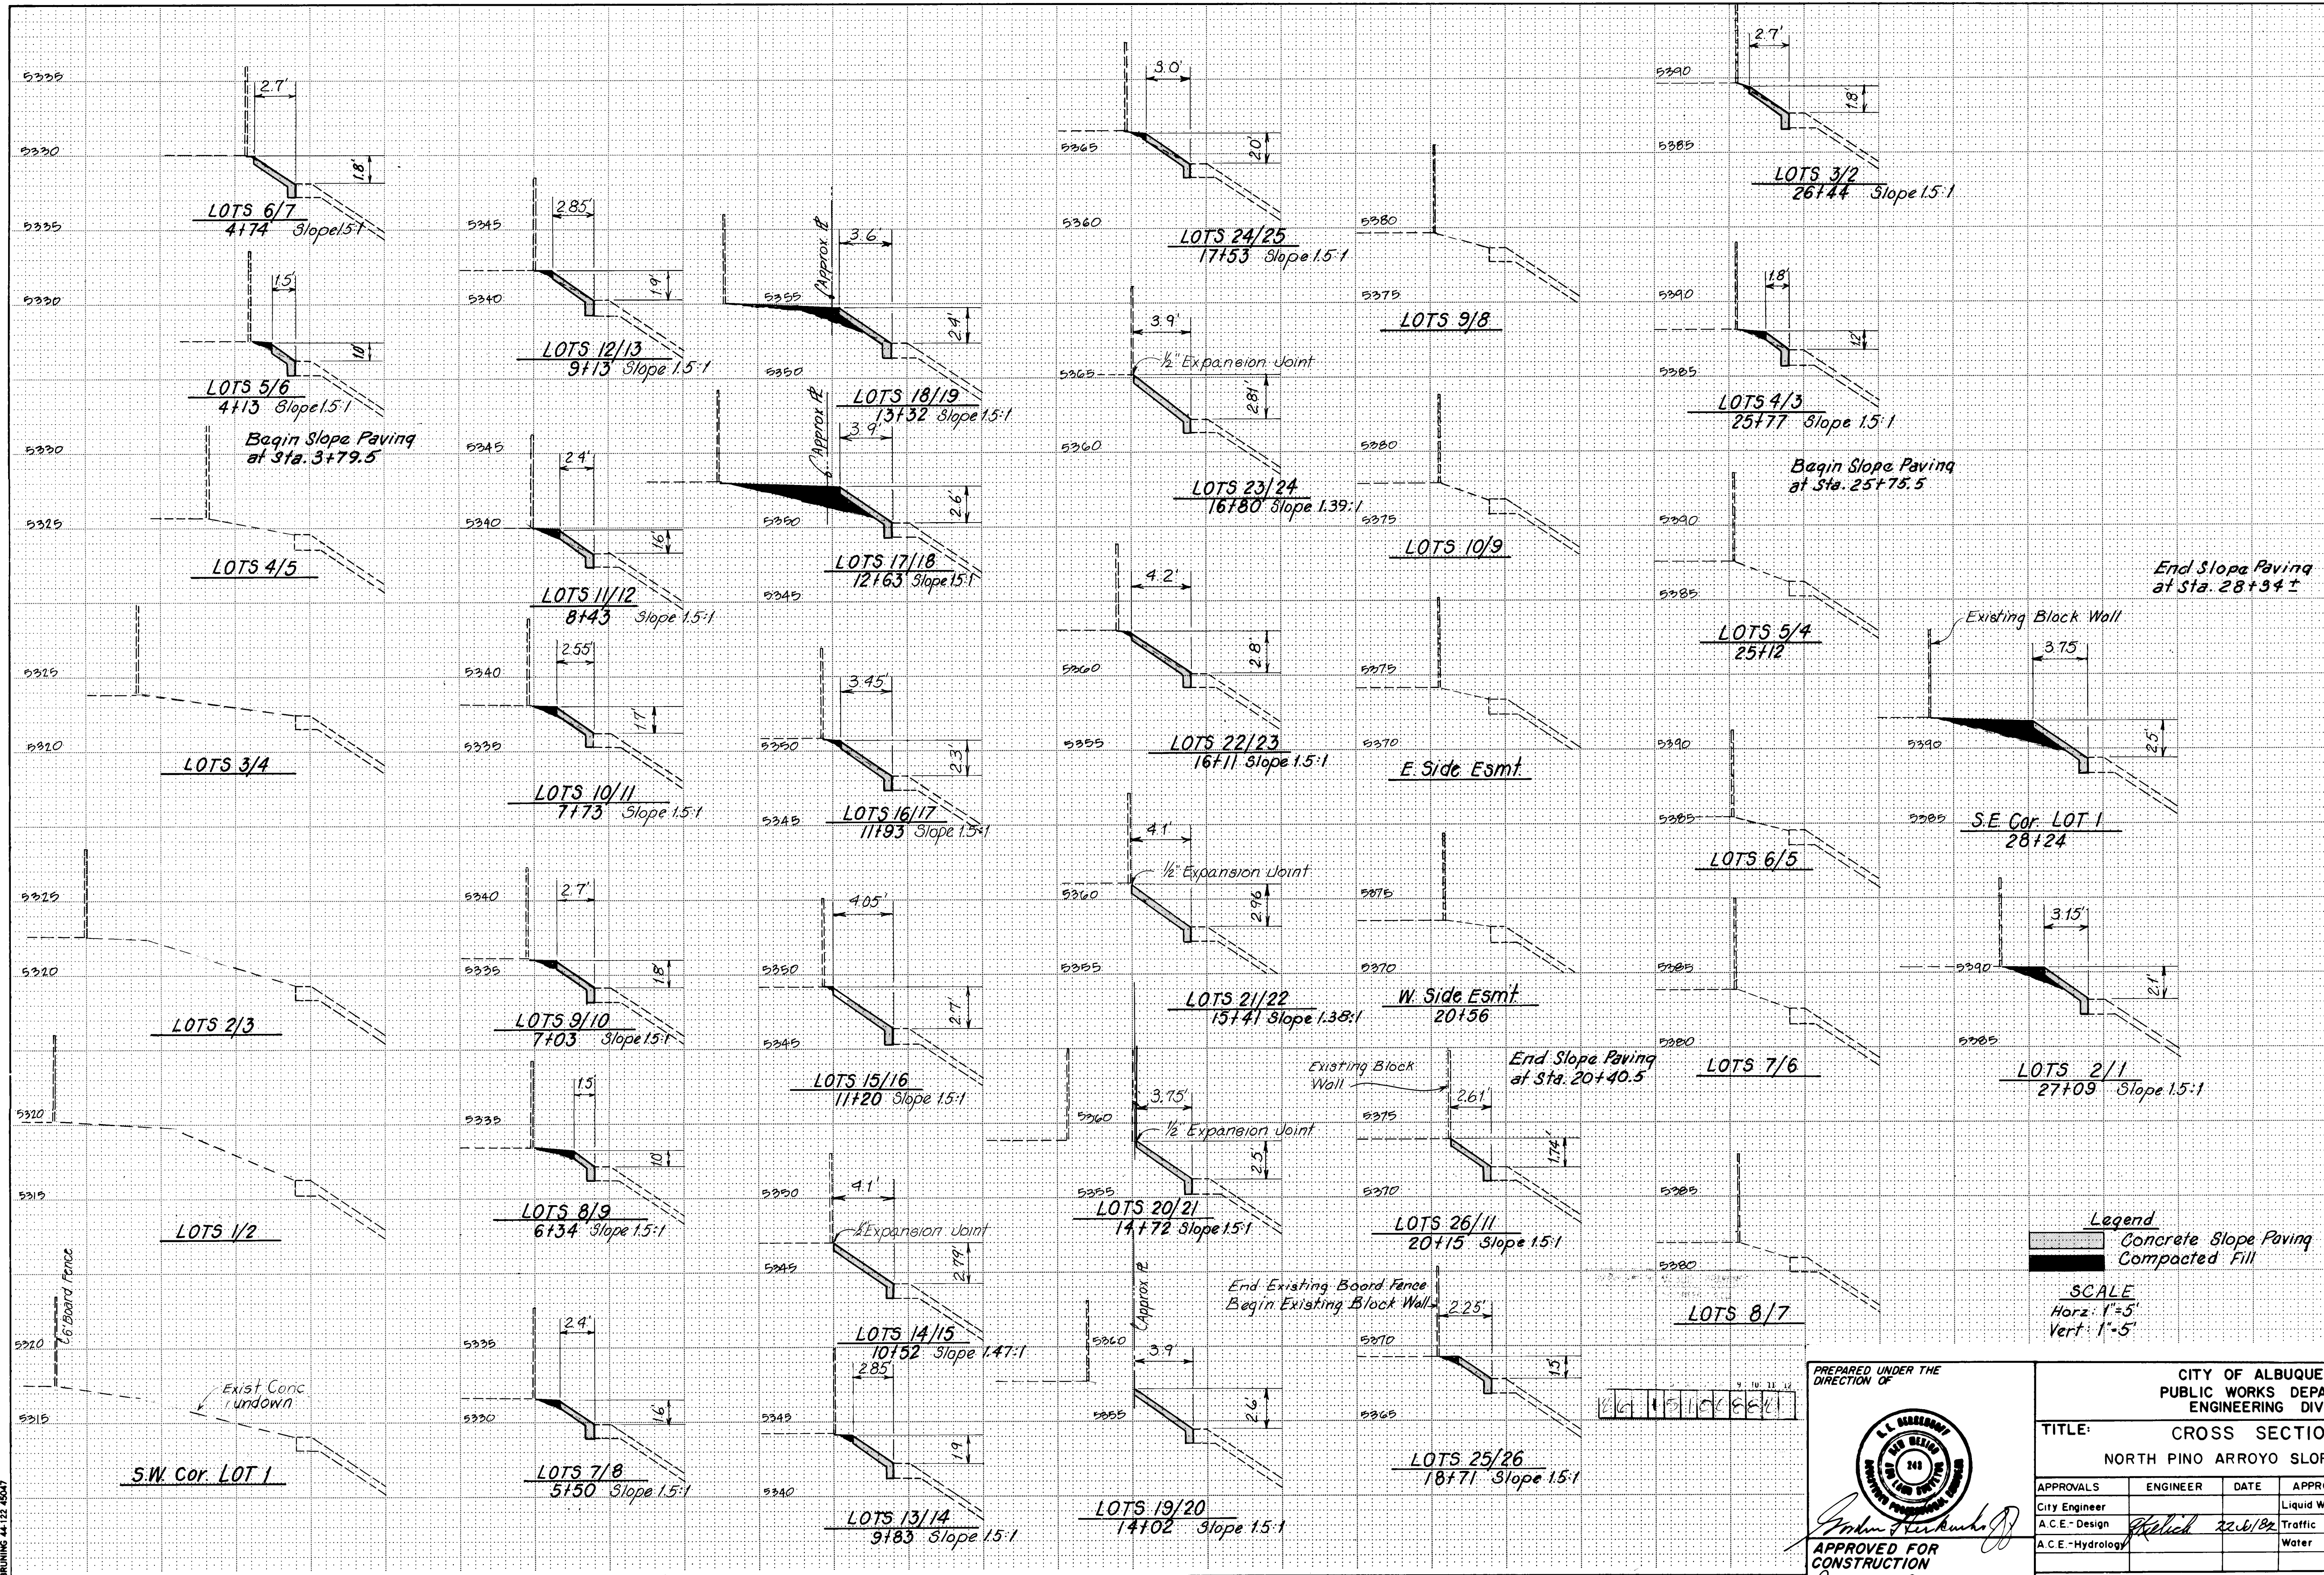

AS BUILT INFORMATION			BENCH MARKS			SURVEY INFORMATION			REFERENCES			REVISIONS		
CONTRACTOR	DATE	NO.	CONTRACTOR	DATE	NO.	MAP NO.	EST. NO.	W.O. NO.	NO.	DATE	BY	NO.	DATE	BY
WORKED BY	DATE		Broken-off Conc. Wall in South end of East Wingwall of Conc. Drain @ N.E. Corner of Wyoming & Arroyo.	DATE		D-19								
INSPECTED BY	DATE													
ACCEPTANCE BY	DATE													
EL=5397.808														
DESIGNED BY	DATE													
DRAWN BY	DATE													
CHECKED BY	DATE													
RECORDED BY	DATE													
NO.														

PREPARED UNDER THE
DIRECTION OF

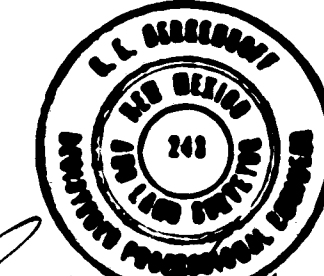

APPROVED FOR
CONSTRUCTION
CITY ENGINEER
DATE 7/23/82

CITY OF ALBUQUERQUE PUBLIC WORKS DEPARTMENT ENGINEERING DIVISION					
TITLE: CROSS SECTIONS NORTH PINO ARROYO SLOPE PAVING					
APPROVALS	ENGINEER	DATE	APPROVALS	ENGINEER	DATE
City Engineer			Liquid Waste		
A.C.E.-Design			Traffic		
A.C.E.-Hydrology			Water		
DRAWING NO. 1510			SHEET 8 OF 8		

PROJECT NO.

1210