



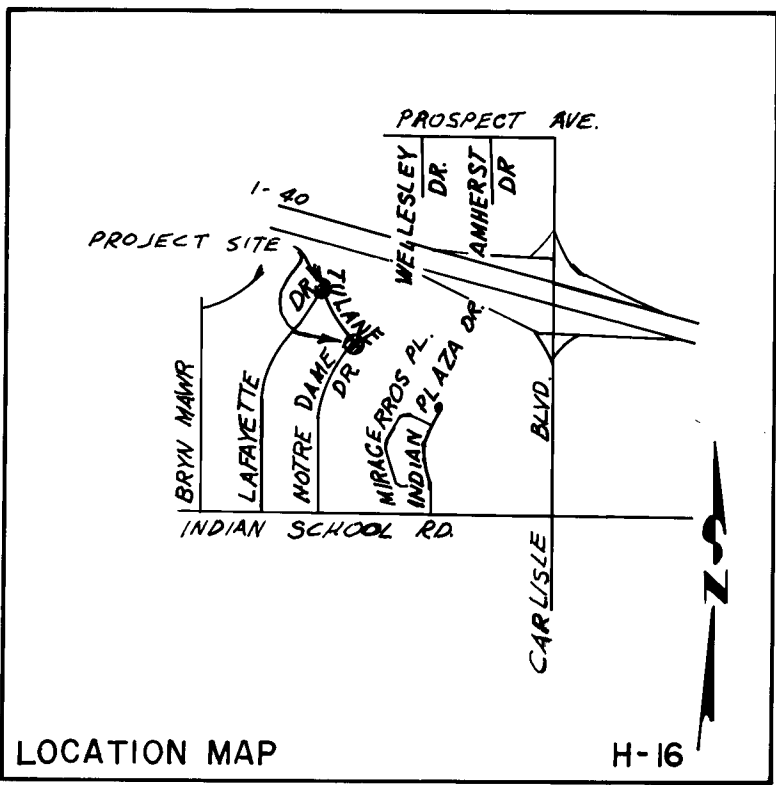


SCALE: 1" = 20'

NOTE: UNLESS OTHERWISE INDICATED, ALL SPOT ELEVATIONS ARE PROPOSED FINISH GRADES @ INSIDE FLAT CURB OR FLOWLINE. FLAT CURB SHALL HAVE A 2% CROSS SLOPE, AS SHOWN IN DETAIL.

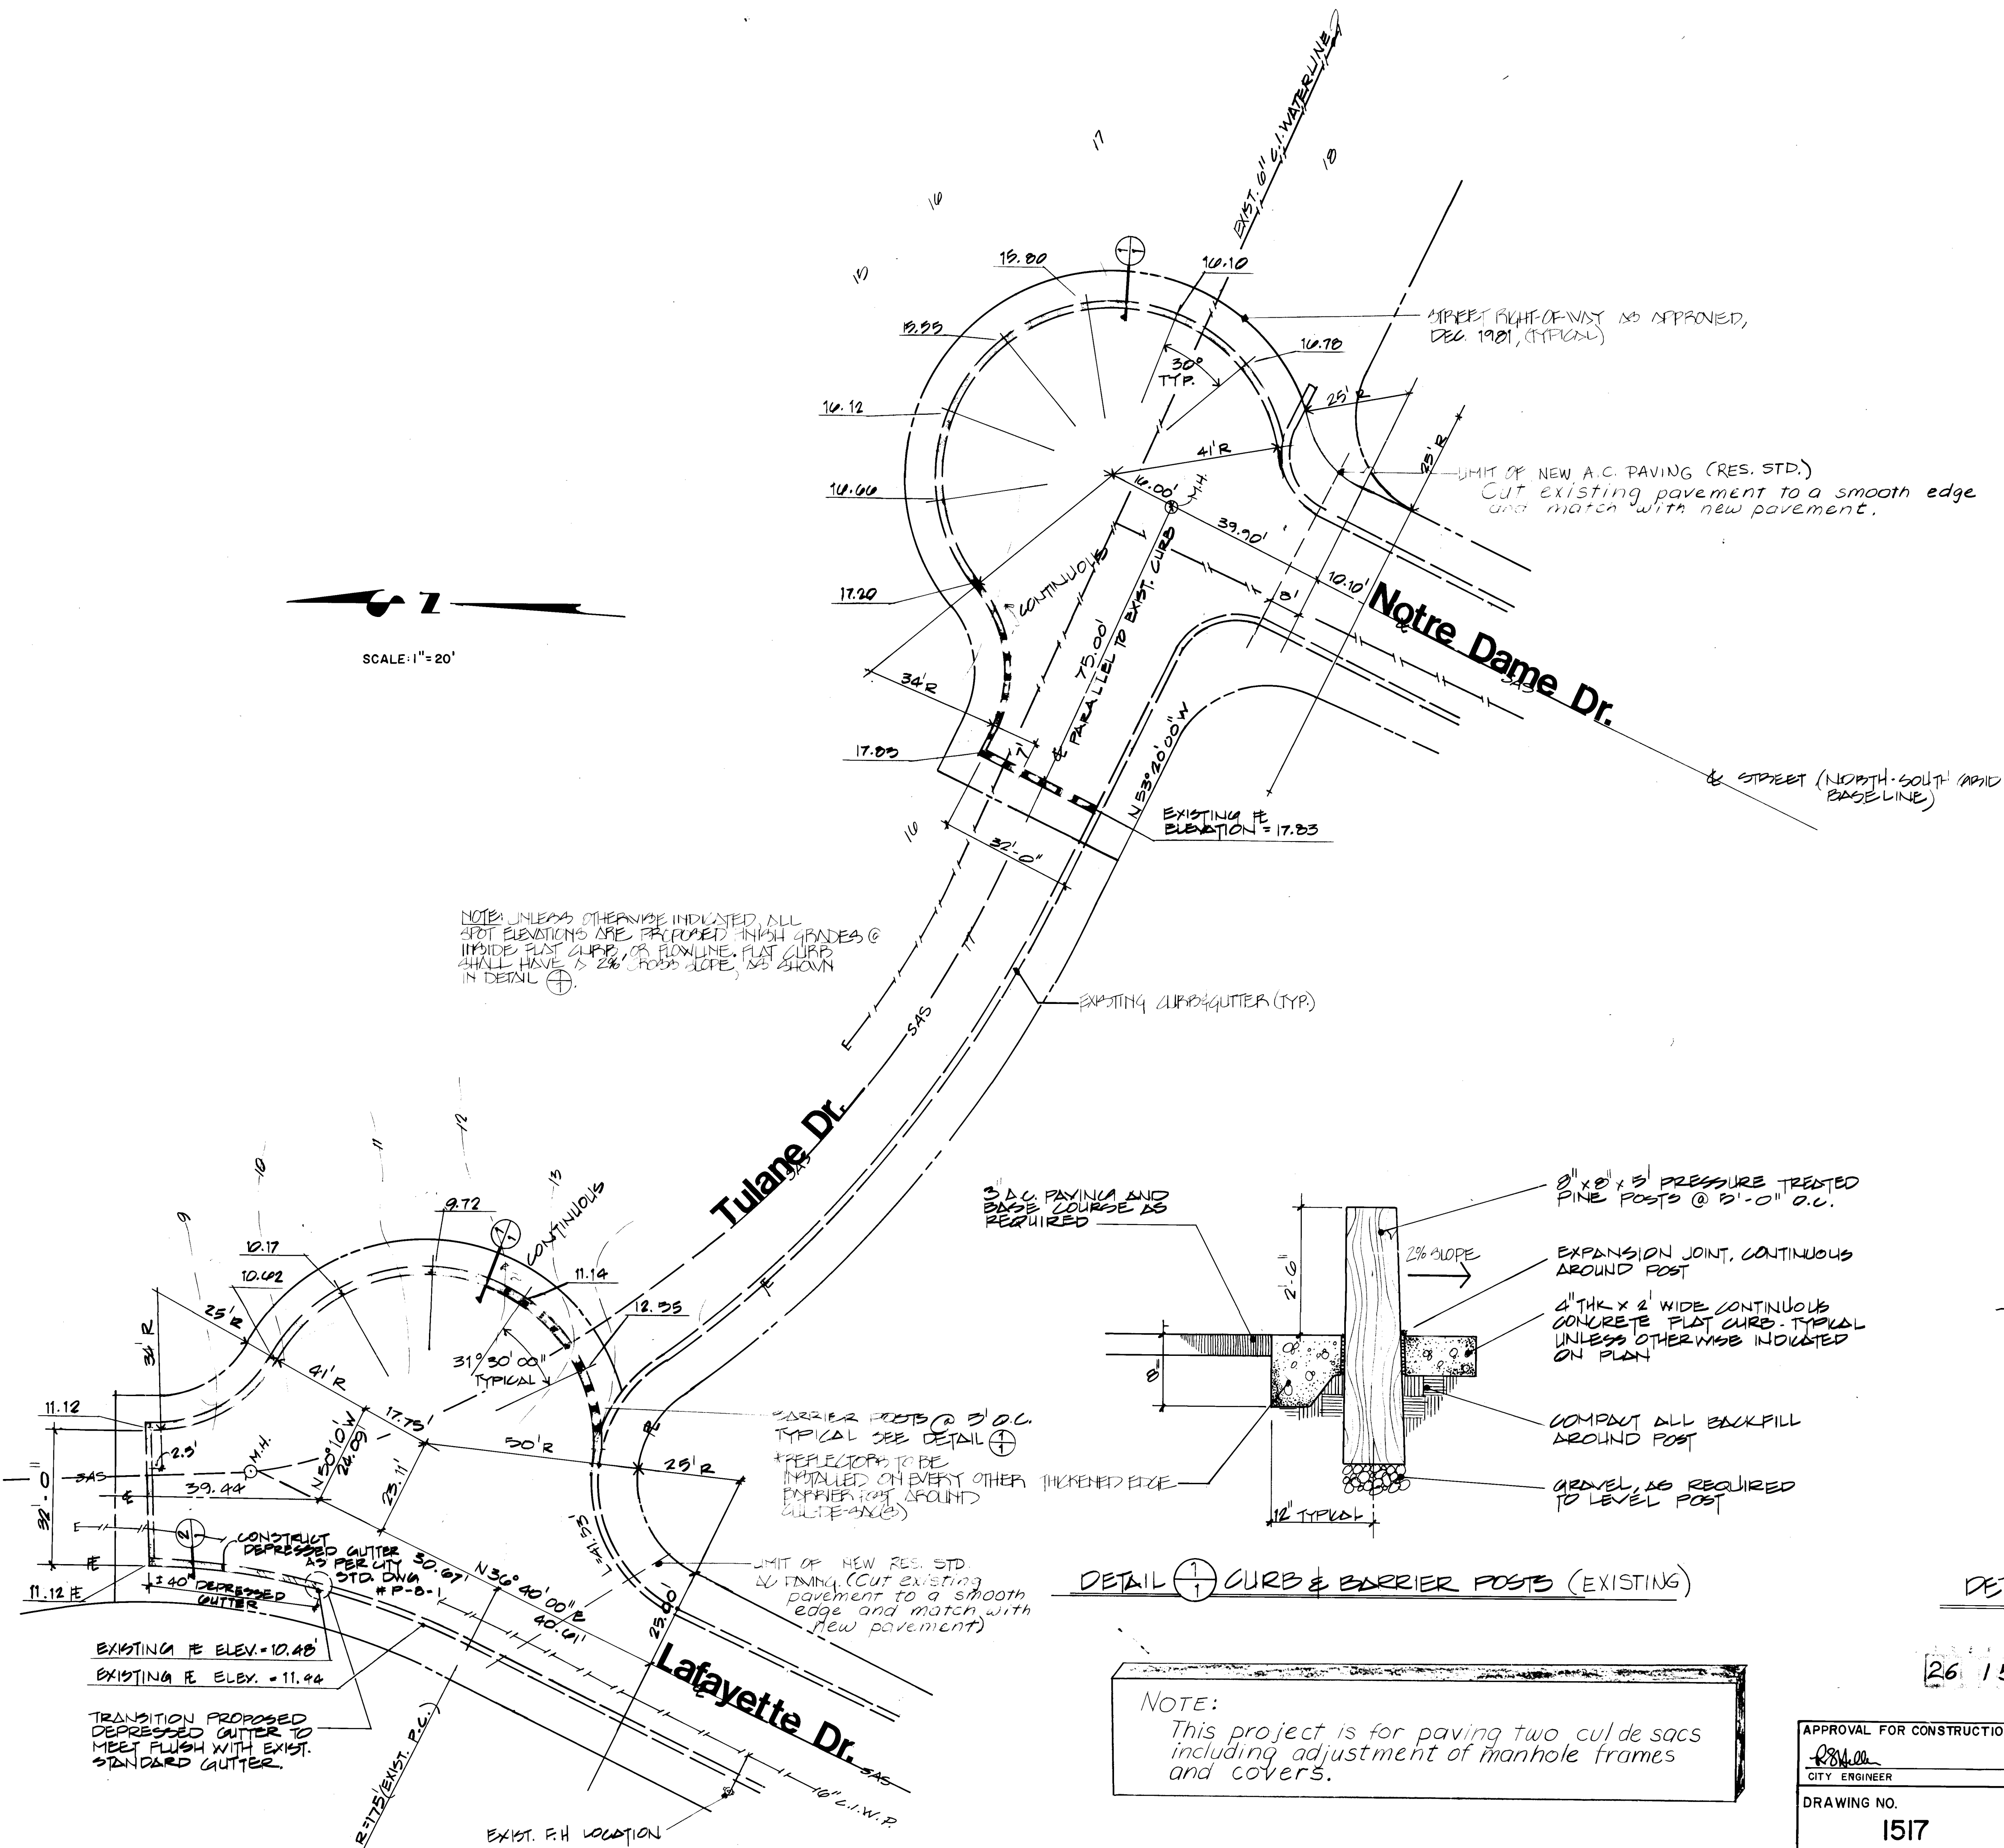


3" A.C. PAVING AND BASE COURSE AS REQUIRED

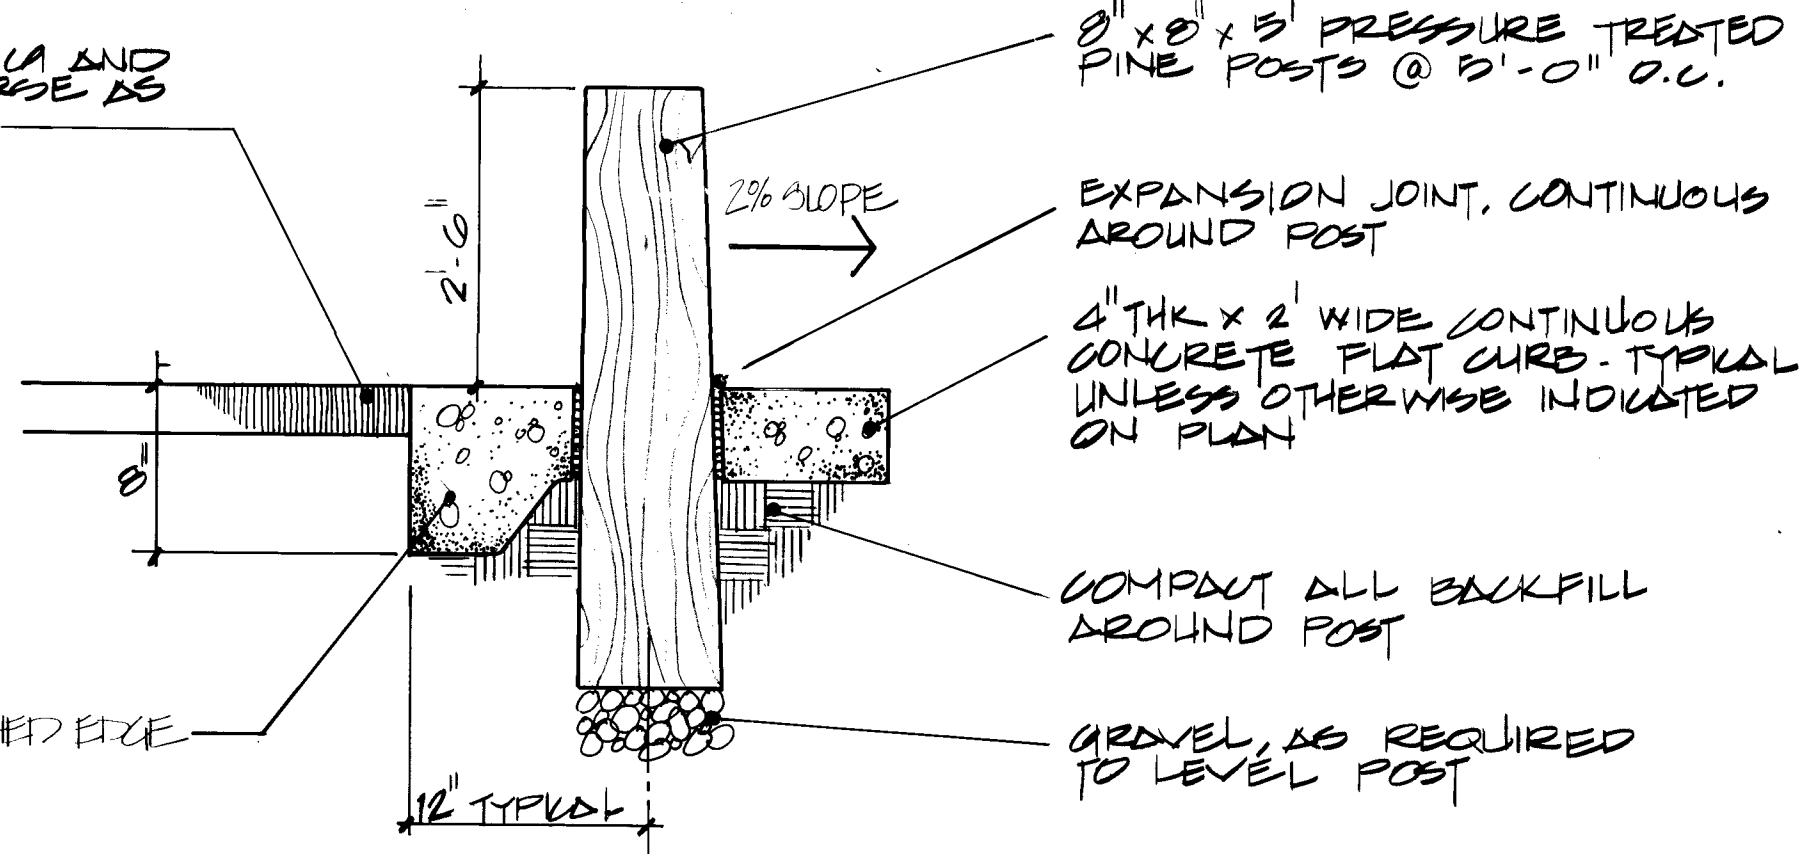

DETAIL 1 CURB & BARRIER POSTS (EXISTING)

NOTE:
This project is for paving two cul de sacs including adjustment of manhole frames and covers.

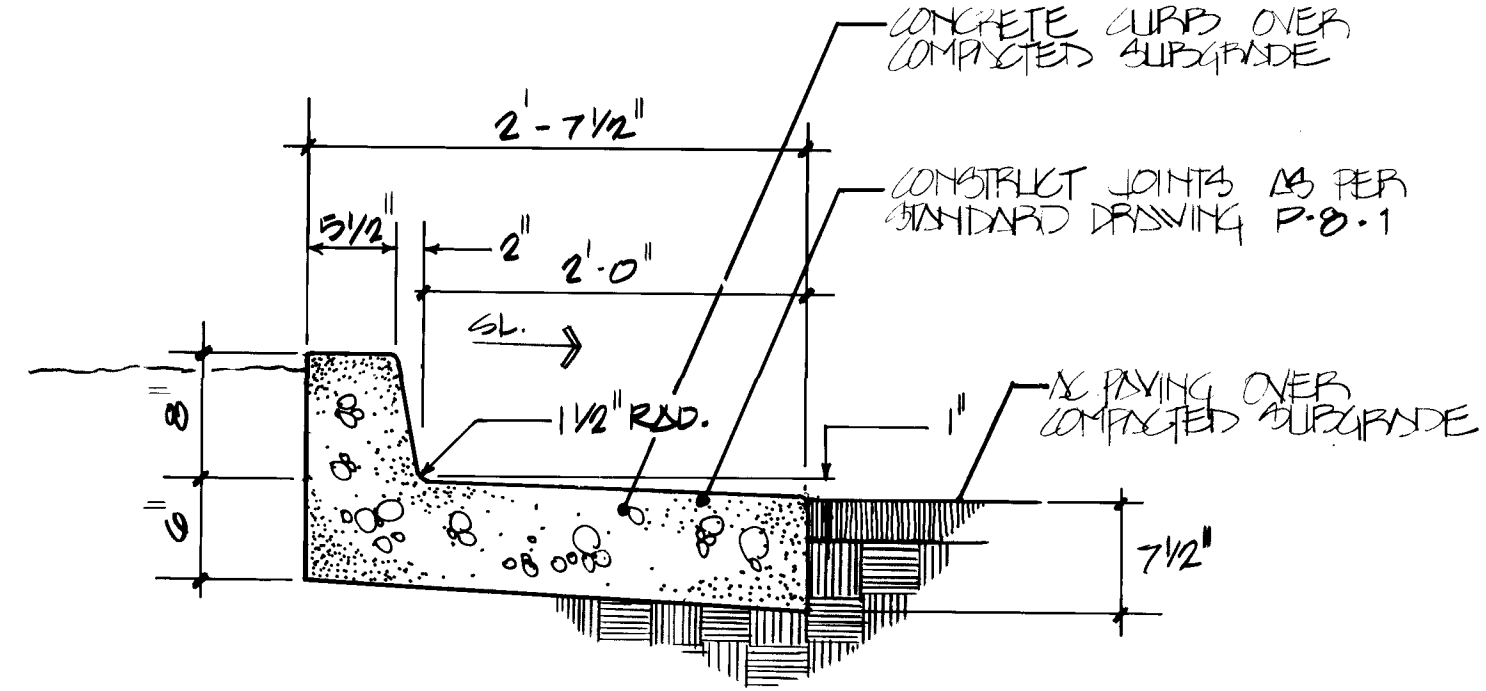


DETAIL 2 CITY STD. DEPRESSIONED GUTTER (EXISTING)

NOTE: ALL CONSTRUCTION TO BE IN ACCORDANCE WITH CITY STANDARD DRAWING P-8-1

26.151.7 P.183

APPROVAL FOR CONSTRUCTION	
CITY ENGINEER	DATE 8/30/82
DRAWING NO. 1517	MAP NO. H-16

APPROVAL OF AS BUILT DRAWING	
ASST. CITY ENGINEER - FIELD	DATE 8/22/82

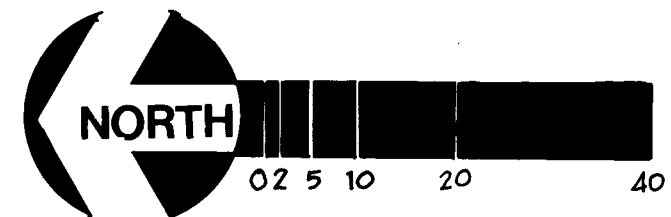

URBAN FOREST PARK

CONSTRUCTION DETAILS Cul-De-Sac LAYOUT

CITY OF ALBUQUERQUE - PARKS AND RECREATION DEPARTMENT

SHEET #
1
OF 1 SHTS.

JANUARY 1982