

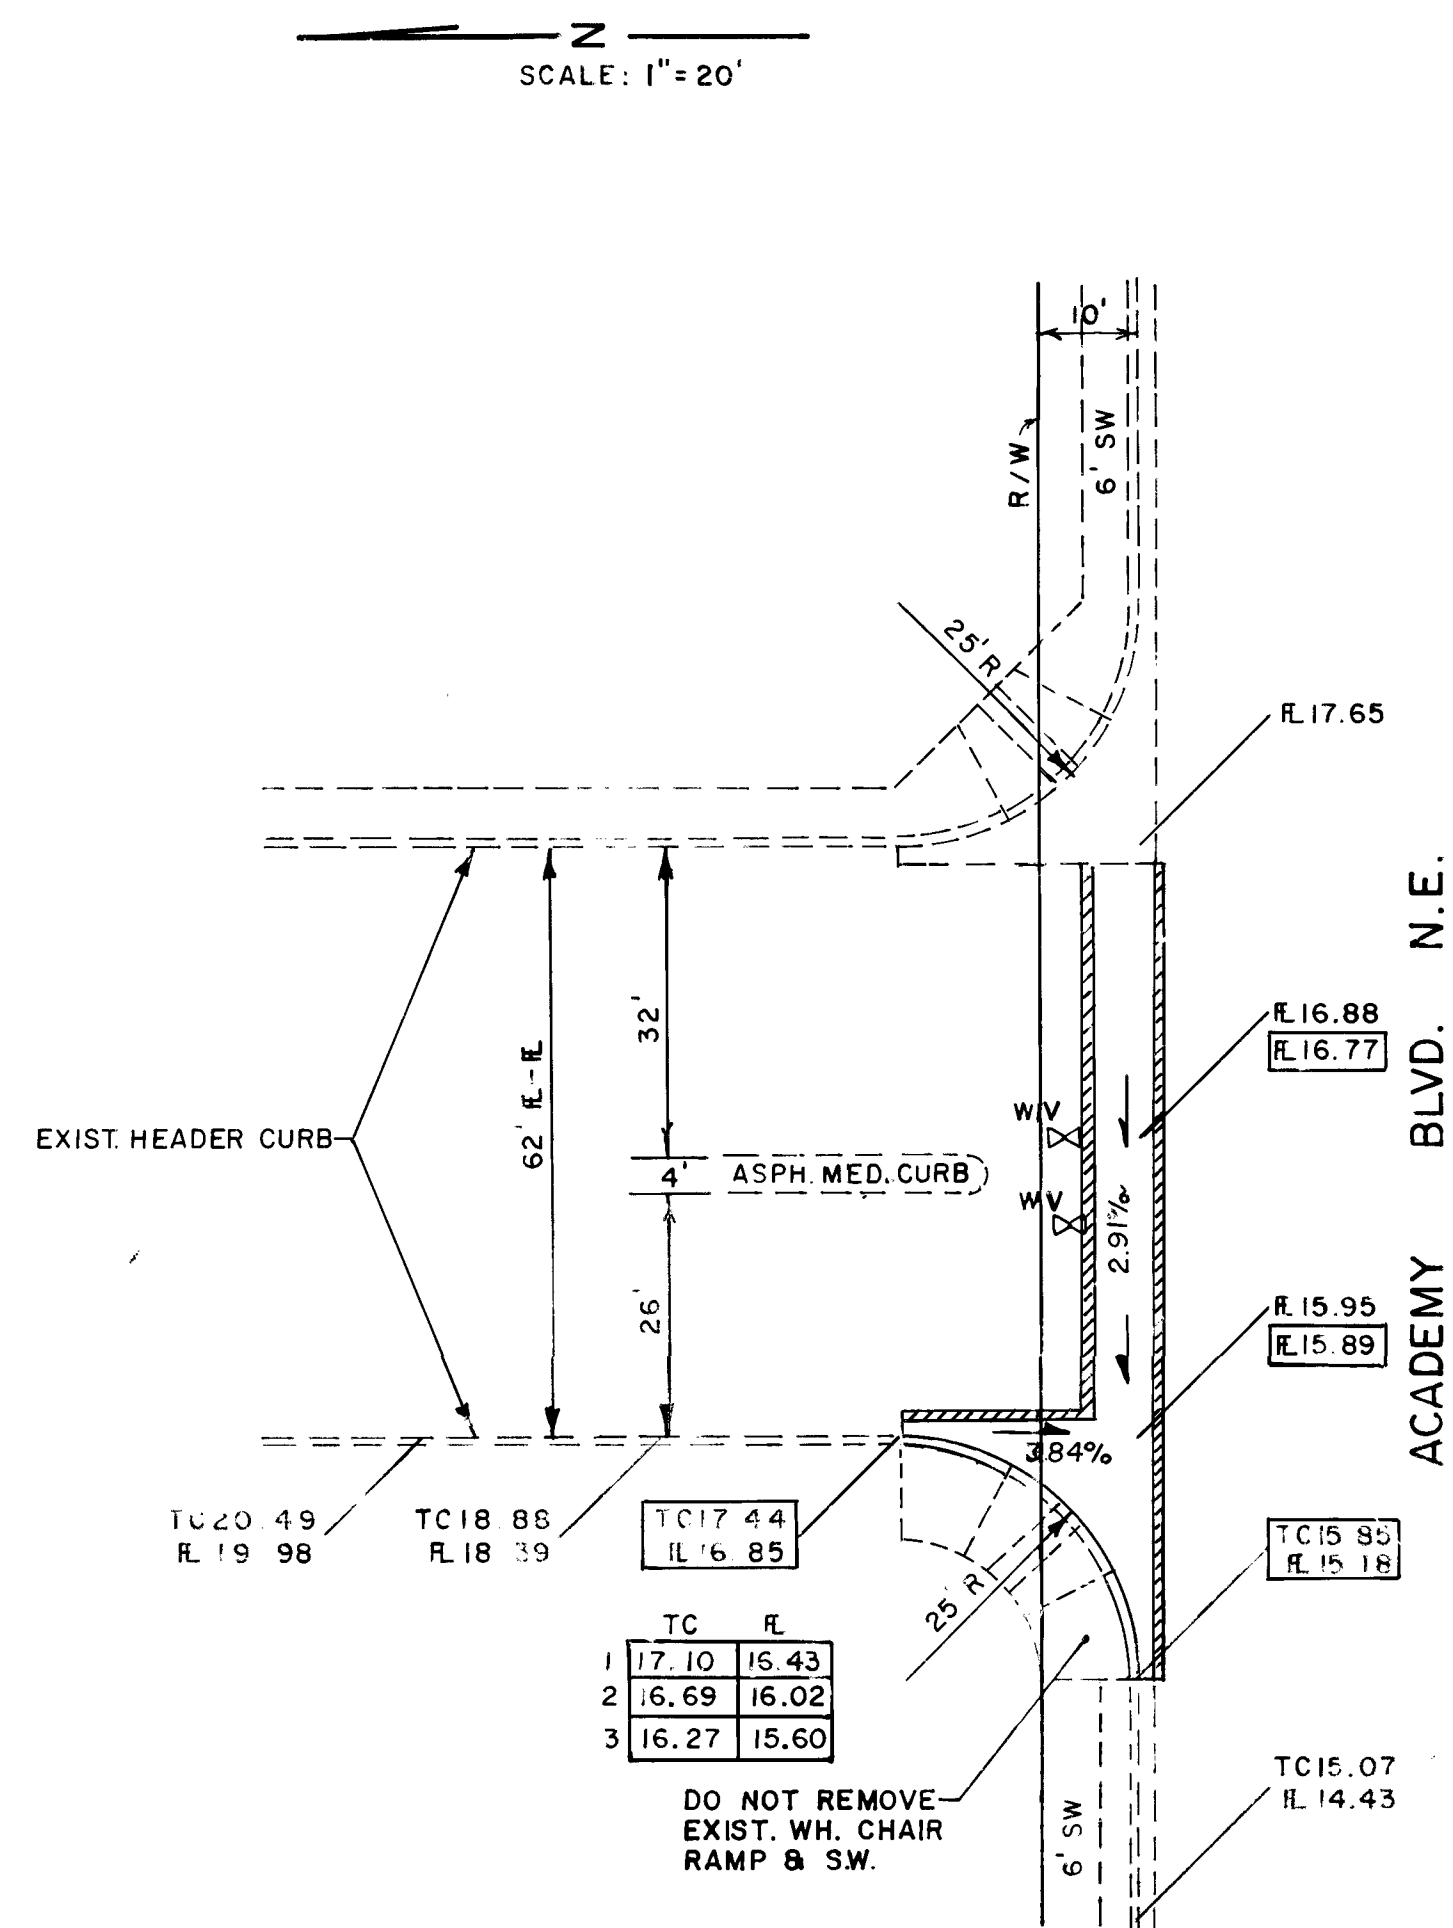
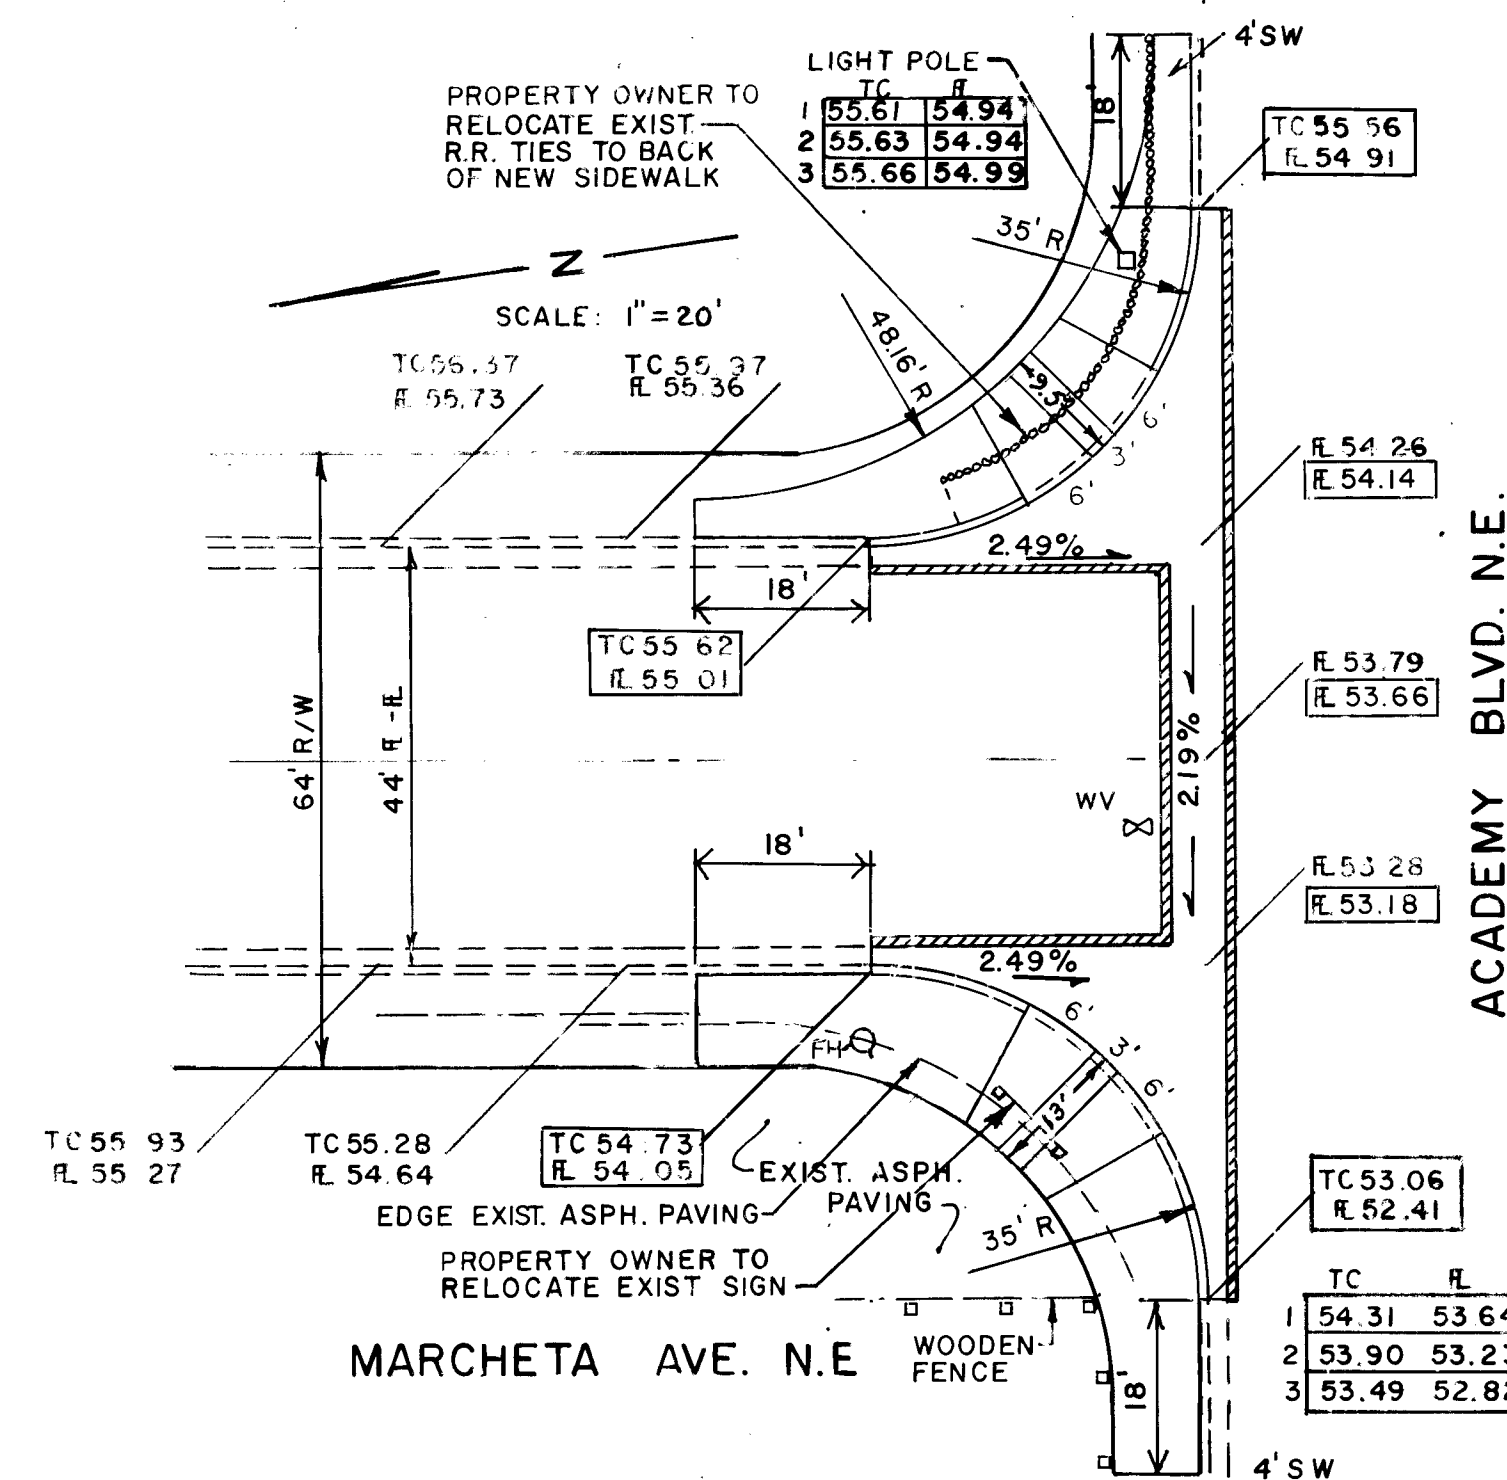
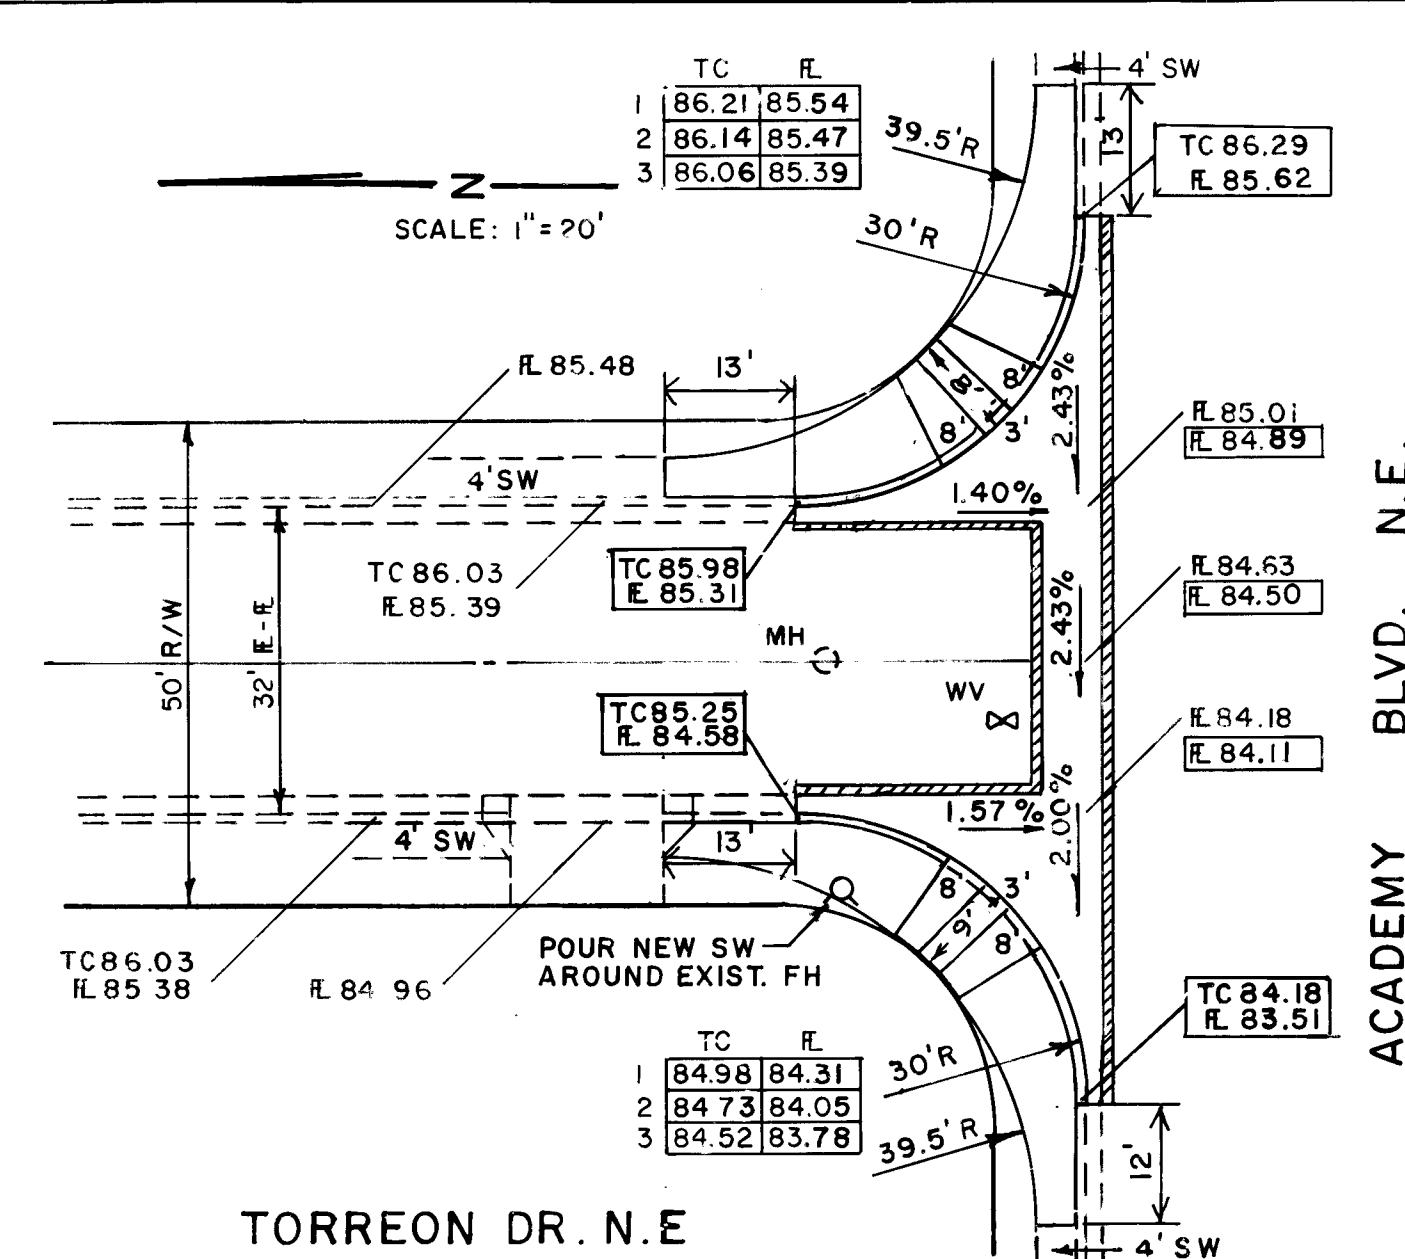
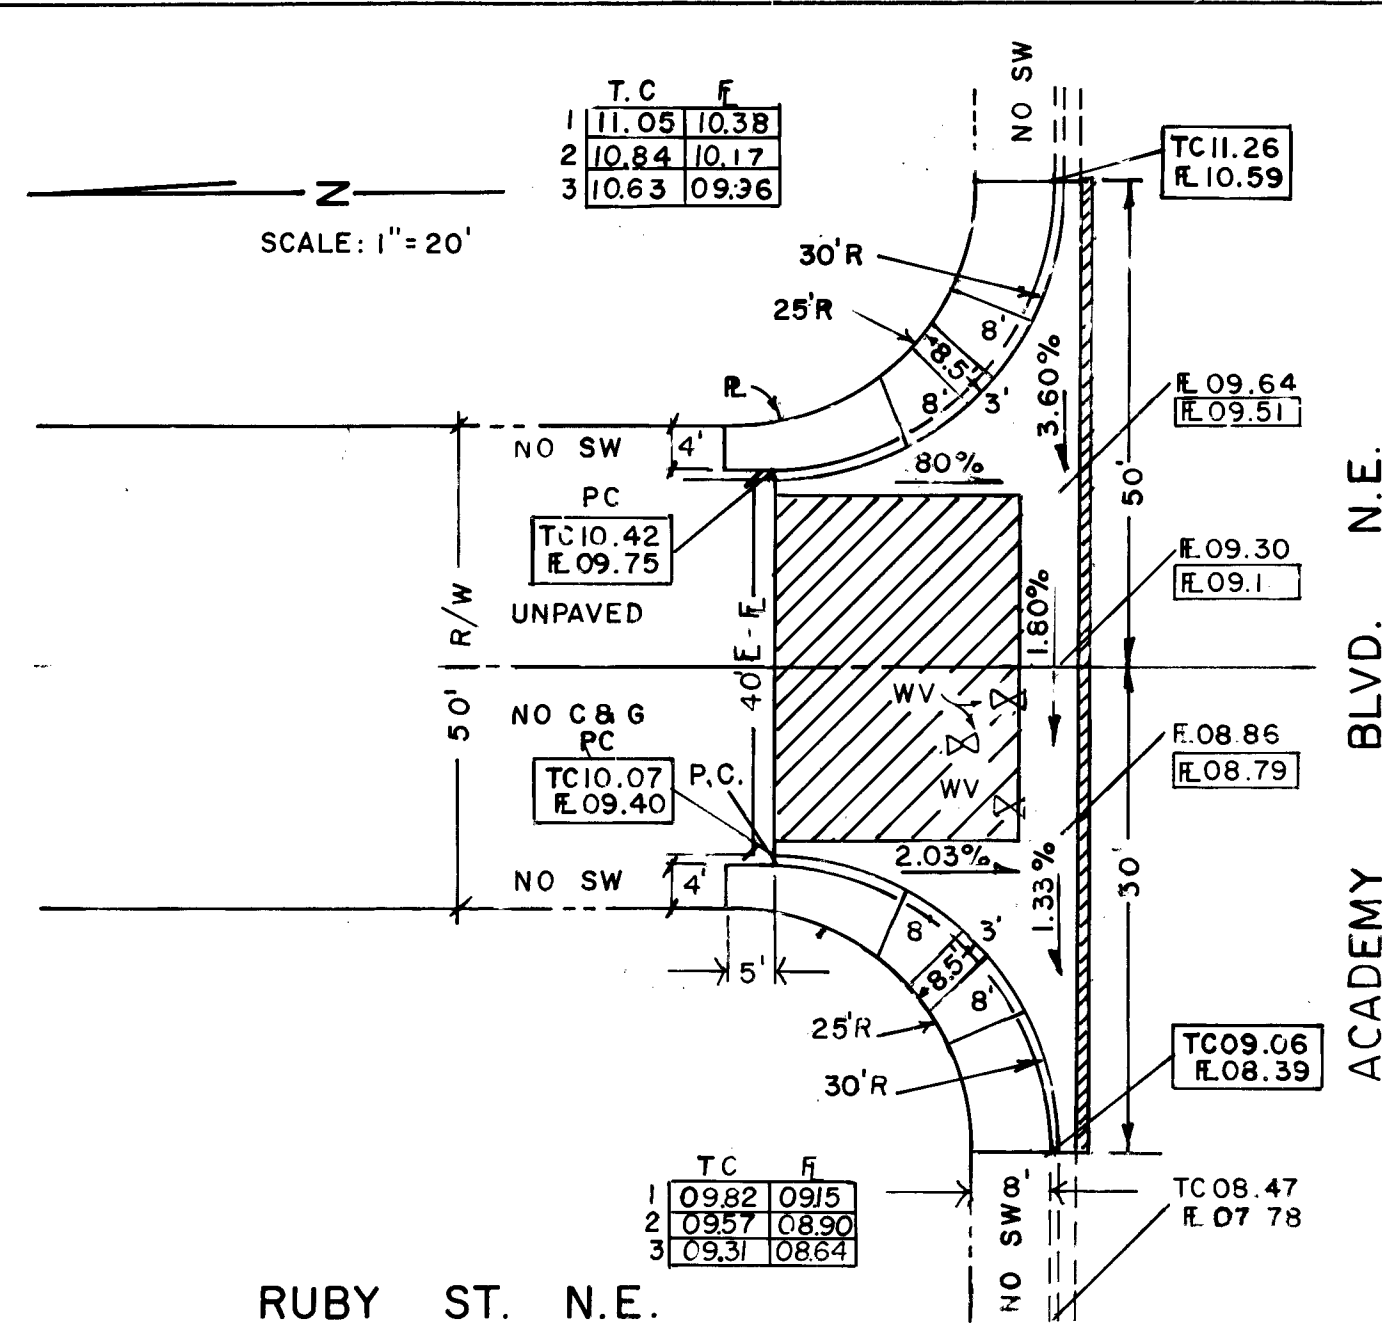


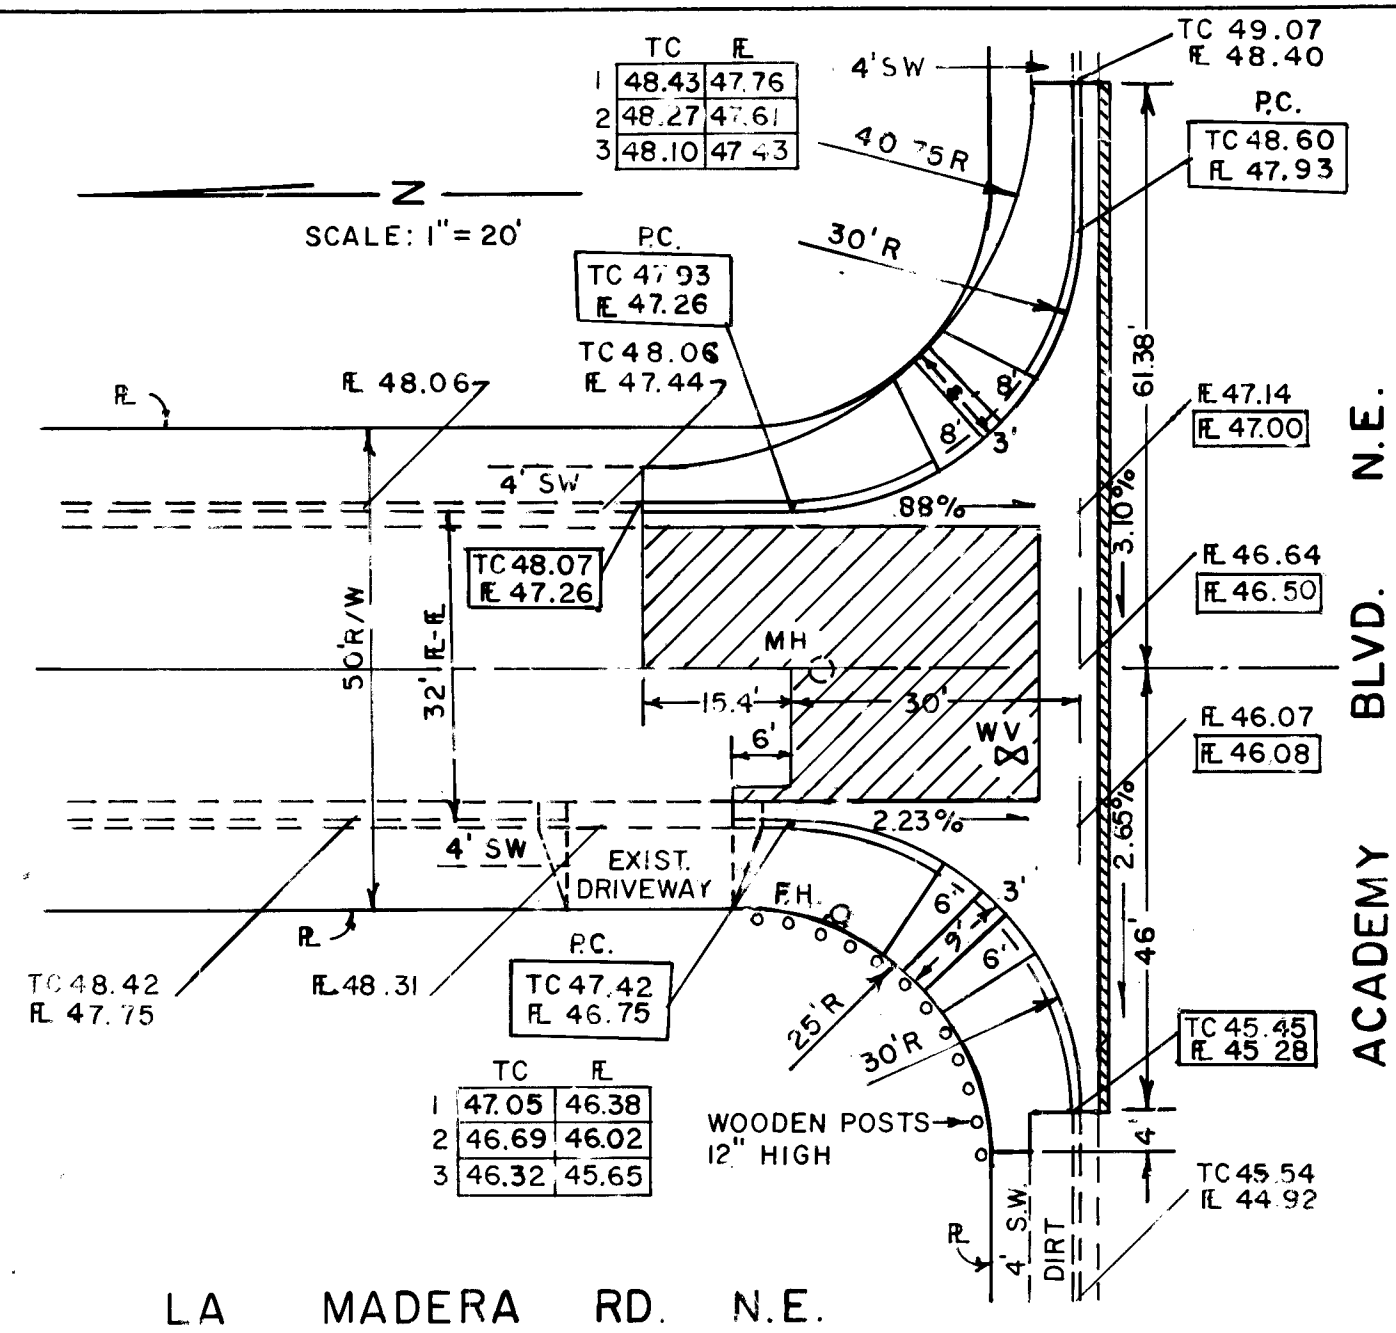

Construction Sites

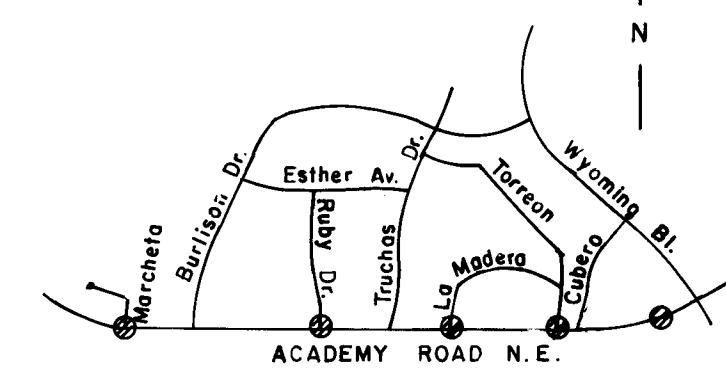

LOCATION MAP E18-19

"NOTICE TO CONTRACTORS"

1. New Mexico Standard Specifications for Public Works Construction - 1979 Edition will be referred to hereon as the "Standard Specification."
2. All work detailed on these plans to be performed under contract shall, except as otherwise stated or provided for hereon, be constructed in accordance with "Contract Documents for City-Wide Utilities and Cash Paving No. 31" and the Standard Specification.
3. Two working day prior to any excavation, contractor must contact Line Locating Service, 765-1234, for location of existing utilities.
4. Prior to construction, the contractor shall excavate and verify the horizontal and vertical location of all obstructions. Should a conflict exist, the contractor shall notify engineer or surveyor so that the conflict can be resolved with minimum amount of delay.

THE FOLLOWING NOTES APPLY WHEN CHECKED

- ☐ All utilities and utility service lines shall be installed prior to paving.
- ☒ Backfill compaction shall be according to specified street use. (Arterial)
- ☒ Tack coat requirement shall be determined by the City Engineer.
- ☒ Sidewalk and wheelchair ramp within the curb returns shall be constructed wherever a new curb return is constructed.
- ☐ If curb is depressed for a driveway, the driveway shall be constructed prior to acceptance of the curb and gutter.
- ☐ All storm drainage facilities shall be completed prior to final acceptance.

LEGEND

- NEW CURB & GUTTER
- EXISTING CURB & GUTTER
- EXISTING WATER VALVE
- EXISTING SAN. SEWER MANHOLE
- EXISTING FIRE HYDRANT
- NEW WHEEL CHAIR RAMP PER STD. DWG. P-17
- NEW CONCRETE VALLEY GUTTER STD. DWG. P-9-2
- EXISTING ELEVATION
- NEW ELEVATION
- REMOVE AND REPLACE EXIST. PAVING TO NEW GRADES

CITY OF ALBUQUERQUE
MUNICIPAL DEVELOPMENT DEPARTMENT
ENGINEERING DIVISIONTITLE: VALLEY GUTTERS - ON ACADEMY BLVD. BETWEEN
WYOMING BLVD. AND MARCHETA AVE.

APPROVALS	ENGINEER	DATE	APPROVALS	ENGINEER	DATE
City Engineer	<i>[Signature]</i>	4/6/83	Liquid Waste	<i>[Signature]</i>	3-8-83
A.C.E.-Design	<i>[Signature]</i>	4/6/83	Traffic	<i>[Signature]</i>	3-26-83
A.C.E.-Hydrology	<i>[Signature]</i>	3-29-83	Water	<i>[Signature]</i>	3-8-83

DRAWING NO. 1524 MAP NO. E 18-9 SHEET 1 OF 1

APPROVAL OF AS BUILT DRAWINGS
ASST. CITY ENGINEER - FIELD
[Signature]
DATE 4/29/83APPROVED FOR
CITY ENGINEER
[Signature] 4/29/83
DATE 5/5/83