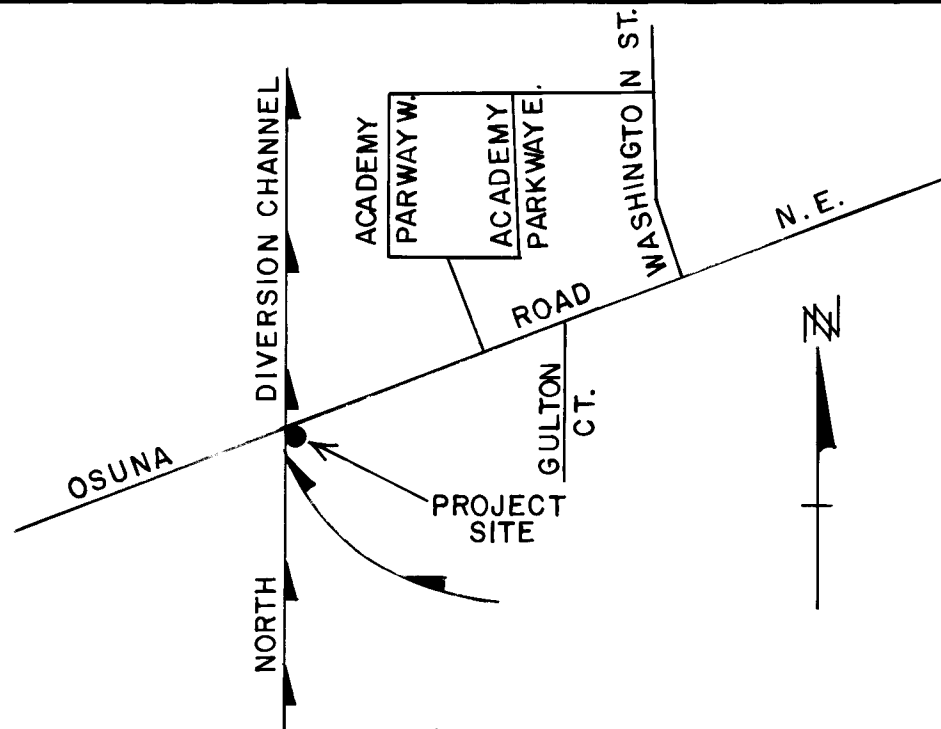


RUNDOWN - SOUTH SIDE OF OSUNA ROAD
TO NORTH DIVERSION CHANNEL

INDEX			
Sheet No.			Description
1	of	3	TITLE SHEET
2	of	3	PLAN & PROFILE
3	of	3	DETAILS



LOCATION MAP
(E-17)

NOTICE TO CONTRACTORS

- All work detailed on these plans to be performed under contract shall, except as otherwise stated or provided for hereon, be constructed in accordance with the New Mexico Standard Specifications for Public Works Construction - 1979 Edition (referred to herein as the Standard Specifications) and the Contract Documents for City Wide Utilities and Cash Paving No. 31.
- Two(2) working days prior to any excavation, the contractor must contact Line Locating Service, 765-1234 for location of existing utilities.
- Prior to construction, the contractor shall excavate and verify the horizontal and vertical locations of all obstructions. Should a conflict exist, the contractor shall notify the engineer or surveyor so that the conflict can be resolved with minimum amount of delay.

THE FOLLOWING NOTES ALSO APPLY
WHEN CHECKED

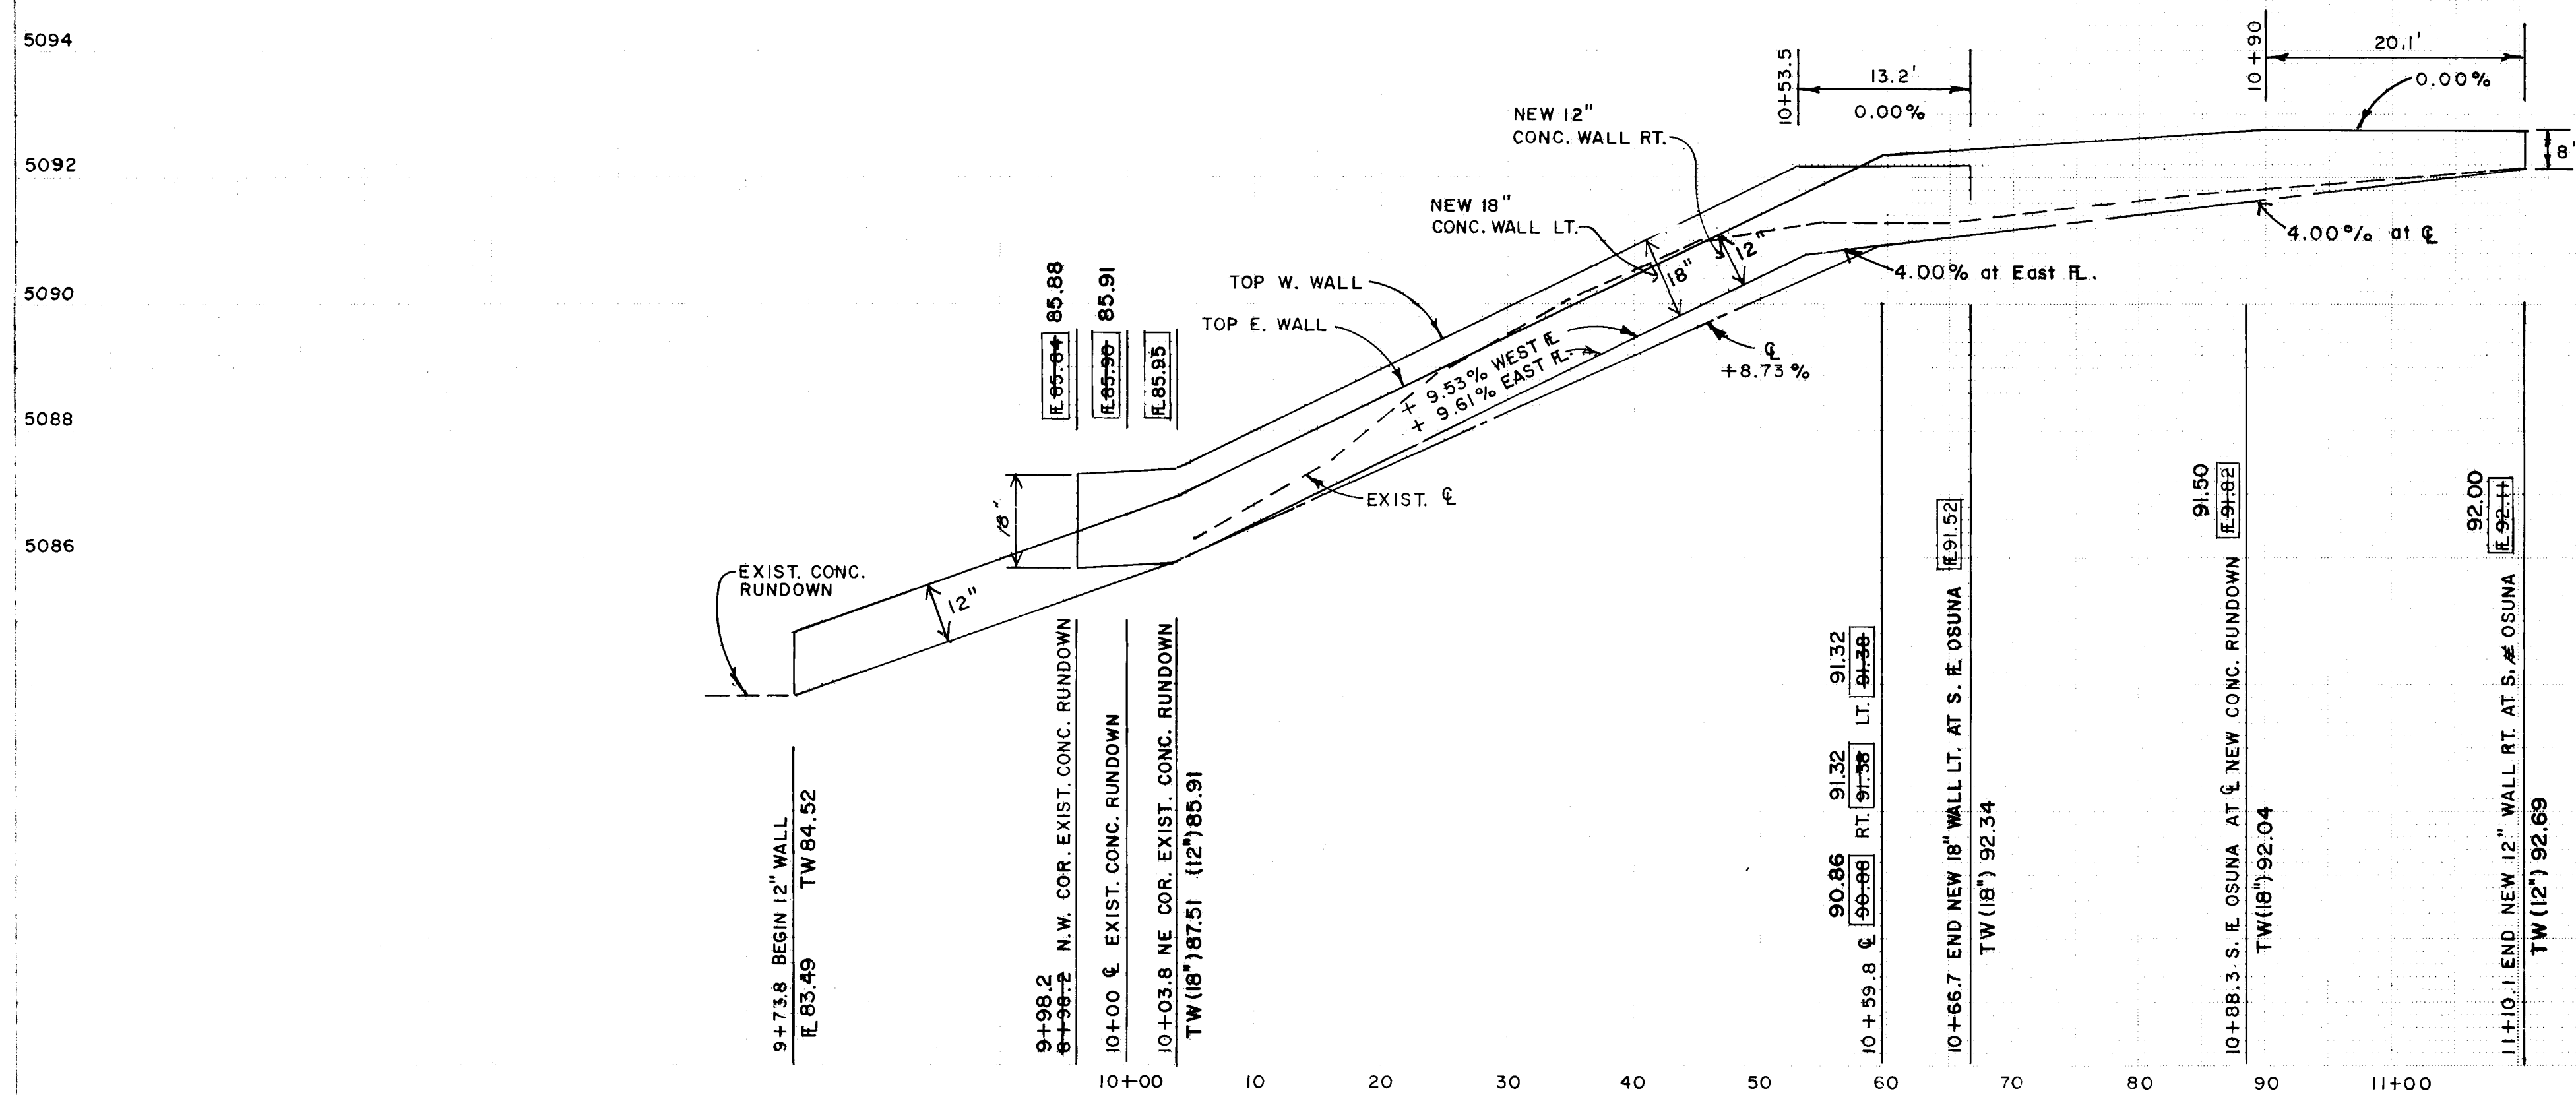
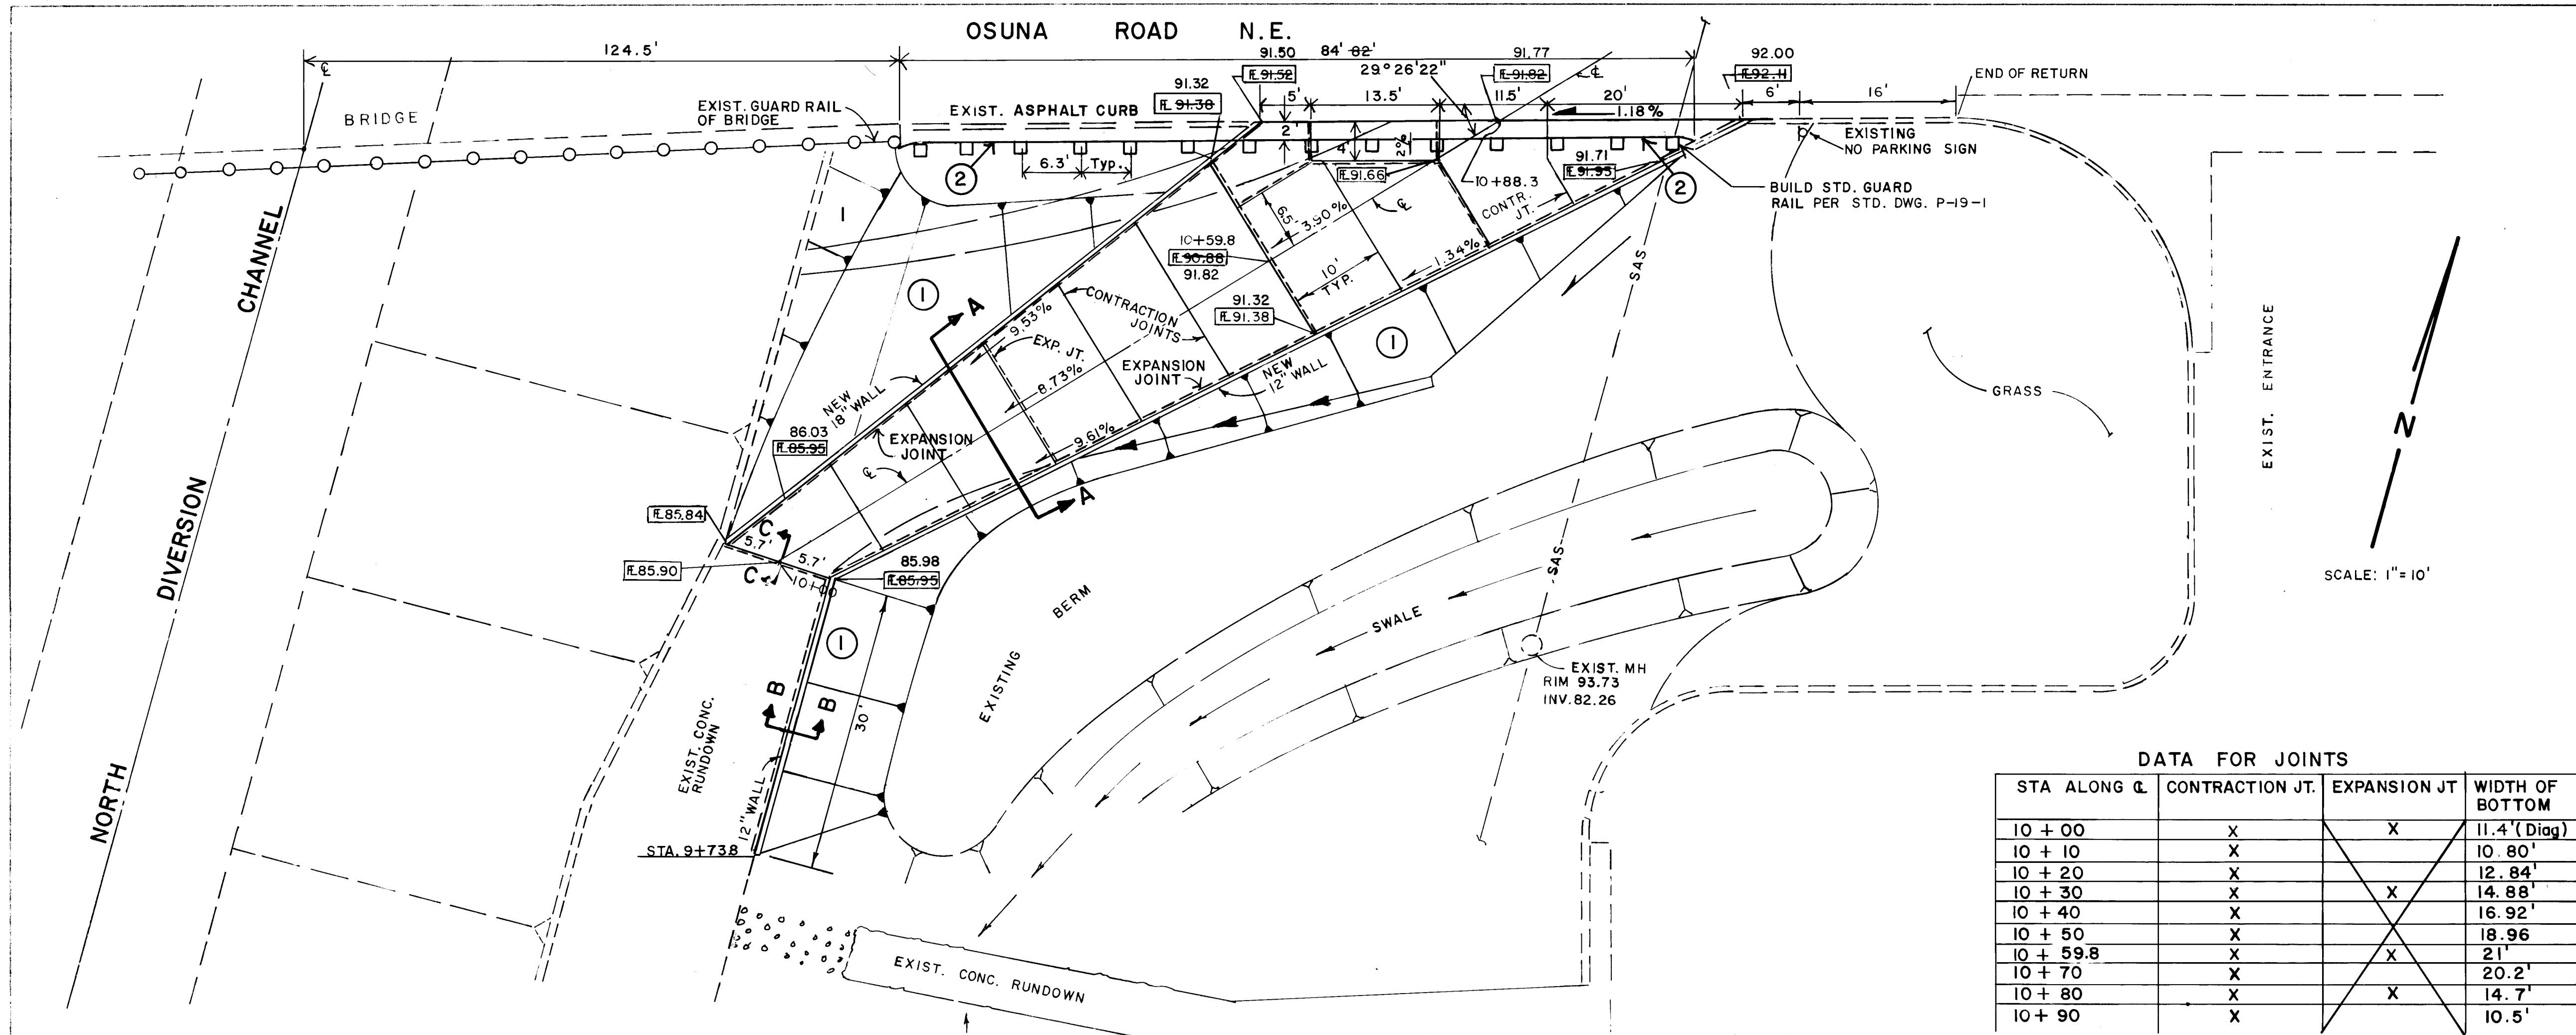
- ☐ All utilities and utility service lines shall be installed prior to paving.
- ☒ Backfill compaction shall be according to specified street use. (Arterial)
- ☐ Tack coat requirements shall be determined by the City Engineer.
- ☐ Sidewalks and wheelchair ramps within the curb returns shall be constructed wherever a new curb return is constructed.
- ☐ If curb is depressed for a driveway or a handicap ramp, the driveway or ramp shall be constructed prior to acceptance of the curb and gutter.
- ☒ All storm drainage facilities shall be completed prior to final acceptance.

NOTE:
Notify AMAFCA (884-2215) Before starting work.

APPROVAL OF AS BUILT DRAWINGS
ASST. CITY ENGINEER - FIELD
[Signature]
DATE 8/18/83

REV.	SHEETS	CITY ENGR.	DATE	USER DEPT.	DATE	USER DEPT.	DATE
APPROVAL OF REVISIONS							

	CITY OF ALBUQUERQUE	APPROVED FOR CONSTRUCTION <i>[Signature]</i> CITY ENGR. 8/18/83
	DRAWING NO. 1533	SHEET OF 1 3



NOTES:

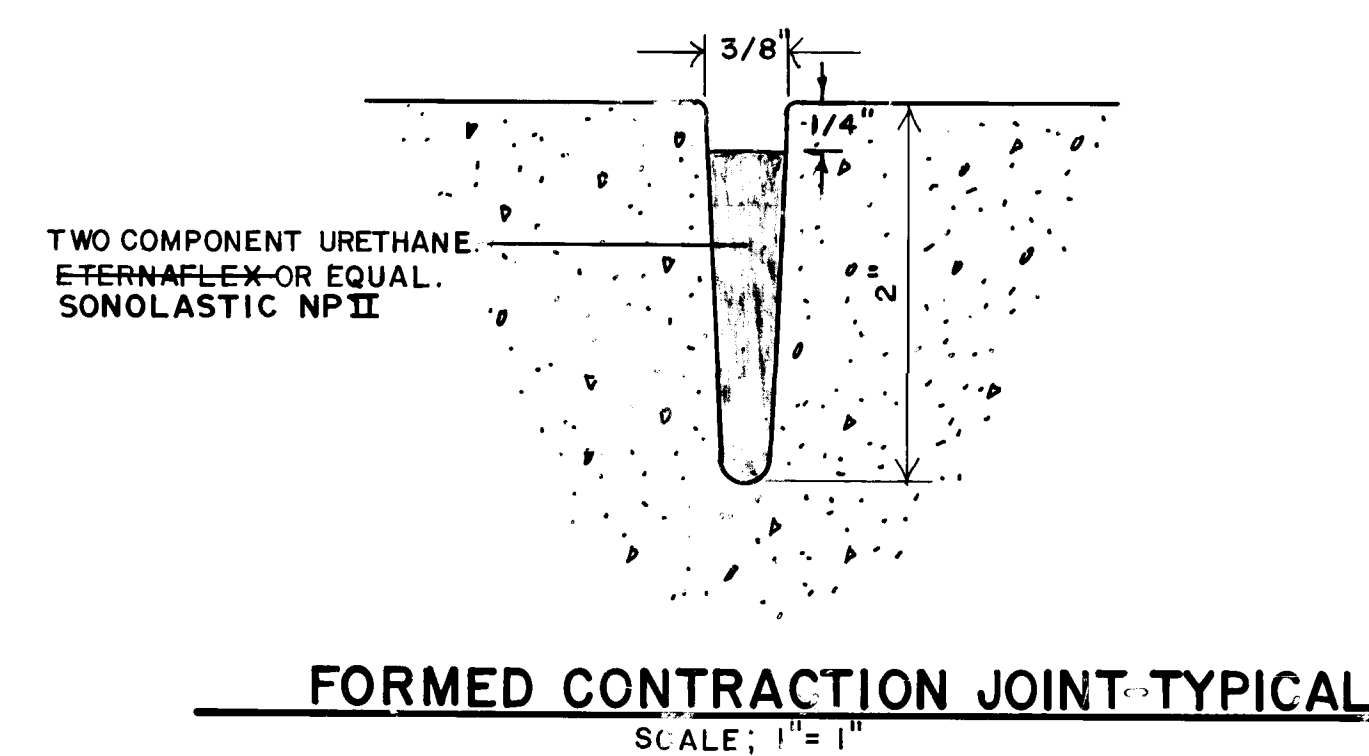
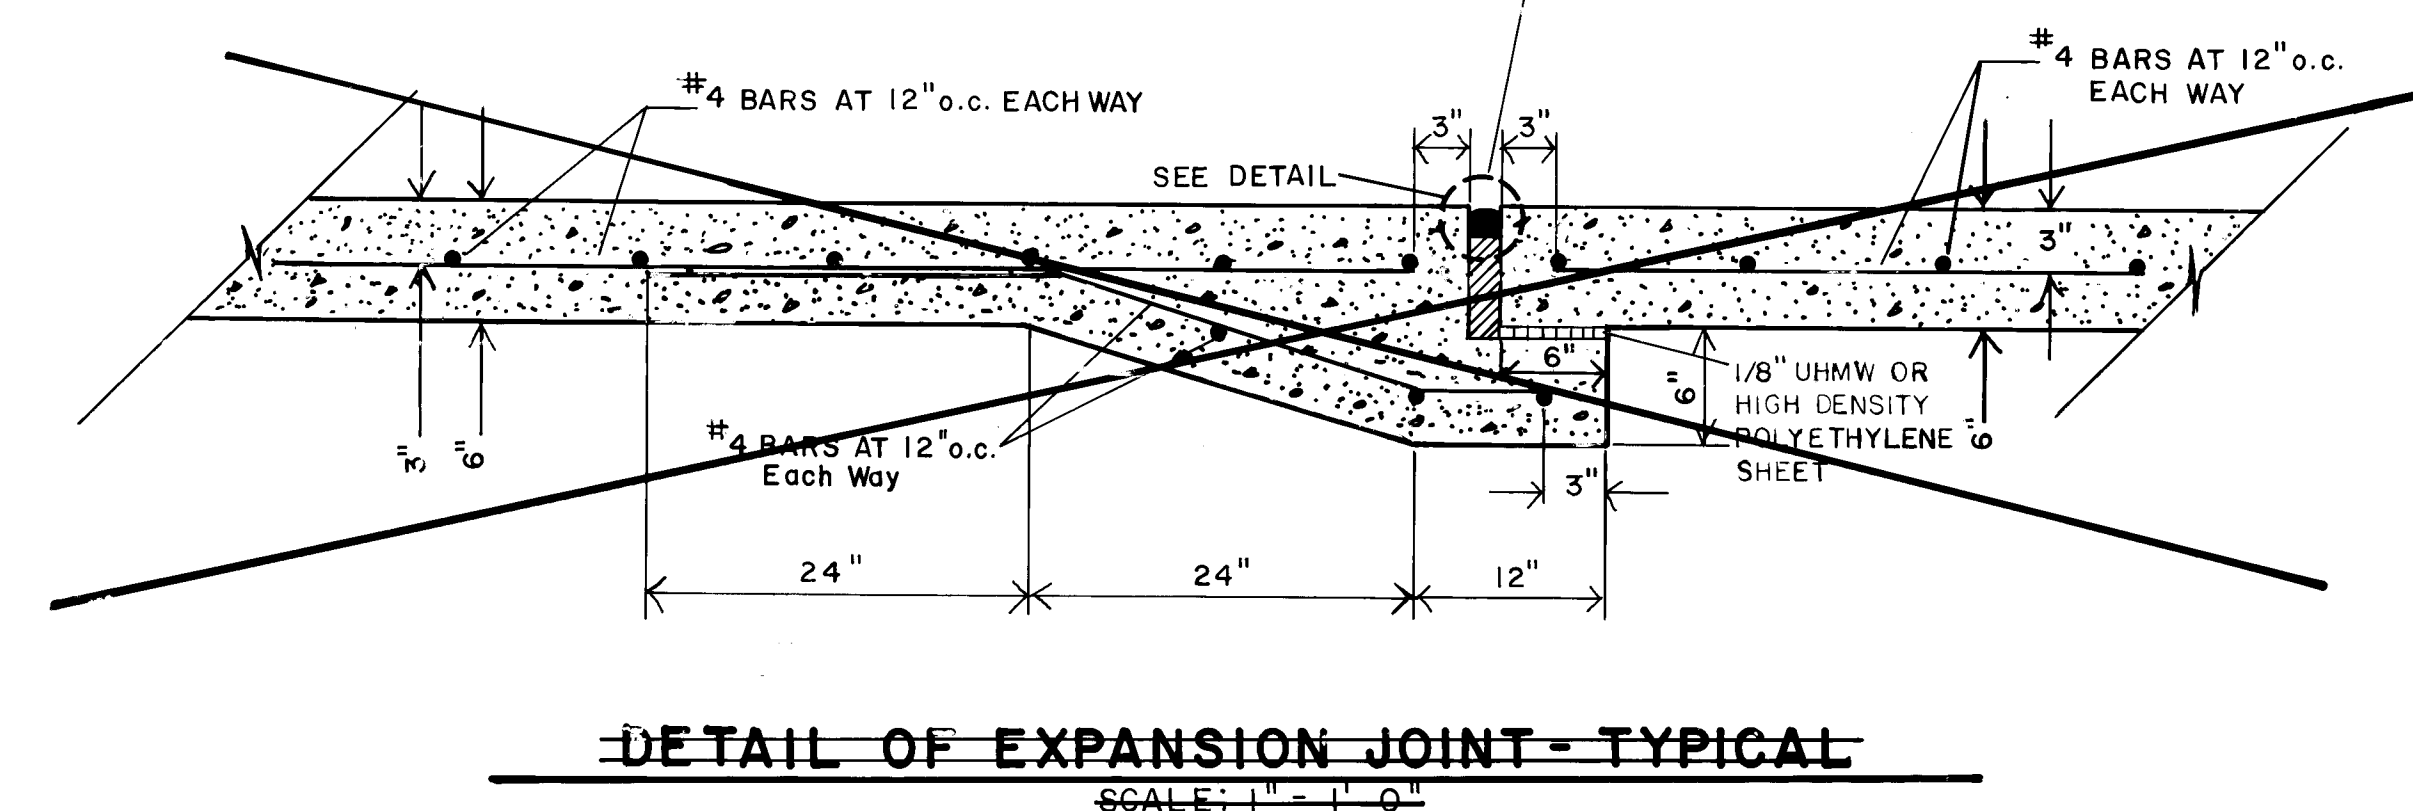
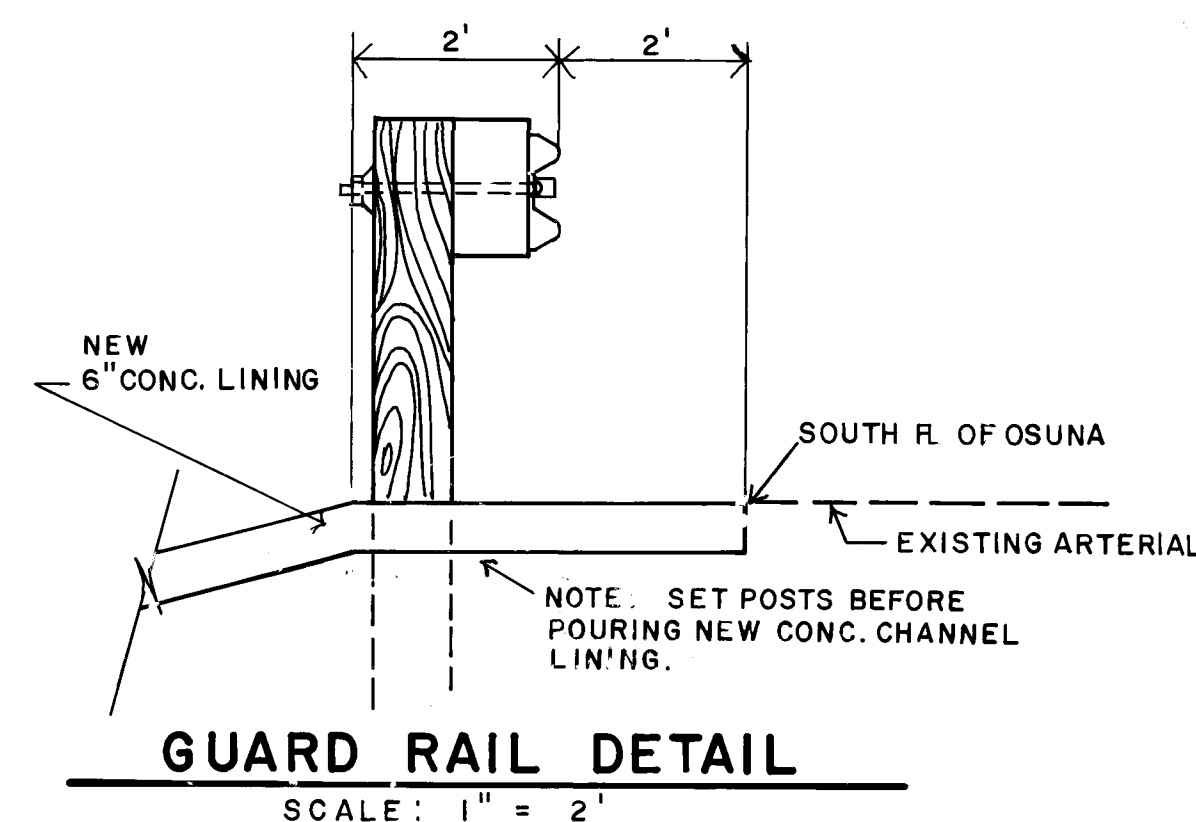
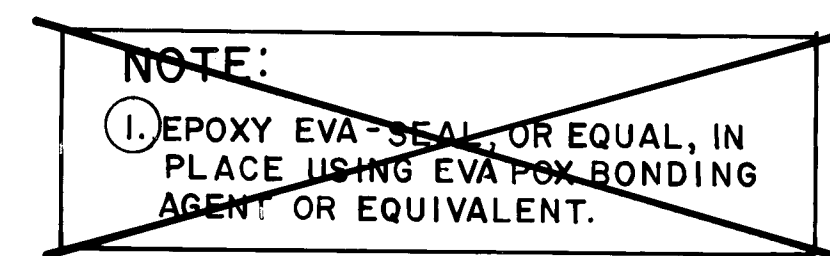
- Shaping of embankments to be done by AMAFCA after construction of concrete rundown.
- Build standard guard rail per std. dwg. P-19-1.
- Contraction Joints not to be sawcut.

TRAFFIC HANDLING NOTES

- Contractor must submit a construction signing and barricading plan to Traffic Engineering Division and receive a barricading permit prior to construction.
- All construction signing and barricading to comply with manual on uniform traffic control devices, 1978 Edition.
- Contractor's operation, barricading and signing shall not affect thru lanes of Osuna Rd. between 7a.m. and 9a.m. or 4p.m. and 6p.m.

CITY OF ALBUQUERQUE MUNICIPAL DEVELOPMENT DEPARTMENT ENGINEERING DIVISION					
TITLE: RUNDOWN-SOUTH SIDE OF OSUNA RD. TO NORTH DIVERSION CHANNEL					
APPROVALS	ENGINEER	DATE	APPROVALS	ENGINEER	DATE
City Engineer	<i>[Signature]</i>	5/1/13	Liquid Waste		
A C E - Design	<i>[Signature]</i>	2/6/08	Traffic		
A C E - Hydrology	<i>[Signature]</i>	4-6-83	Water		
AMAFCA					
DRAWING NO.	1533	MAP NO.	E-17	SHEET	2 OF 3

AS BUILT INFORMATION		BENCH MARKS		SURVEY INFORMATION		ENGINEER'S SEAL	
DATE	BY	DATE	BY	NO.	BY	NO.	BY
8/8/83	M. G. Aguilar	9/20/82	C. Lucero	PS-31			
5-EIT A SQUARE, CHISELED ON TOP OF SOUTH CURB OF OSUNA ROAD NE, ABOUT 950 FT. EAST OF THE CROSSING OF THE NORTH DIVERSION CHANNEL. ELEV. 5099.06				REVISIONS NO. DATE 1 5-3-83 DESIGNED BY: Q.R. KIELICH DRAWN BY: TONY SANCHEZ CHECKED BY: <i>[Signature]</i>			

[illegible]

CITY OF ALBUQUERQUE MUNICIPAL DEVELOPMENT DEPARTMENT ENGINEERING DIVISION					
TITLE: RUNDOWN - SOUTH SIDE OF OSUNA RD. TO NORTH DIVERSION CHANNEL DETAILS.					
APPROVALS	ENGINEER	DATE	APPROVALS	ENGINEER	DATE
City Engineer	<i>[Signature]</i>	<i>4/6/83</i>	Liquid Waste		
A.C.E. - Design	<i>[Signature]</i>	<i>26 Apr 83</i>	Traffic		
A.C.E. - Hydrology	<i>[Signature]</i>	<i>4-6-83</i>	Water		
A.M.A.F.C.A.					
DRAWING NO.		1533	MAP NO.		1533
			E-17		
			SHEET 3 OF 3		