
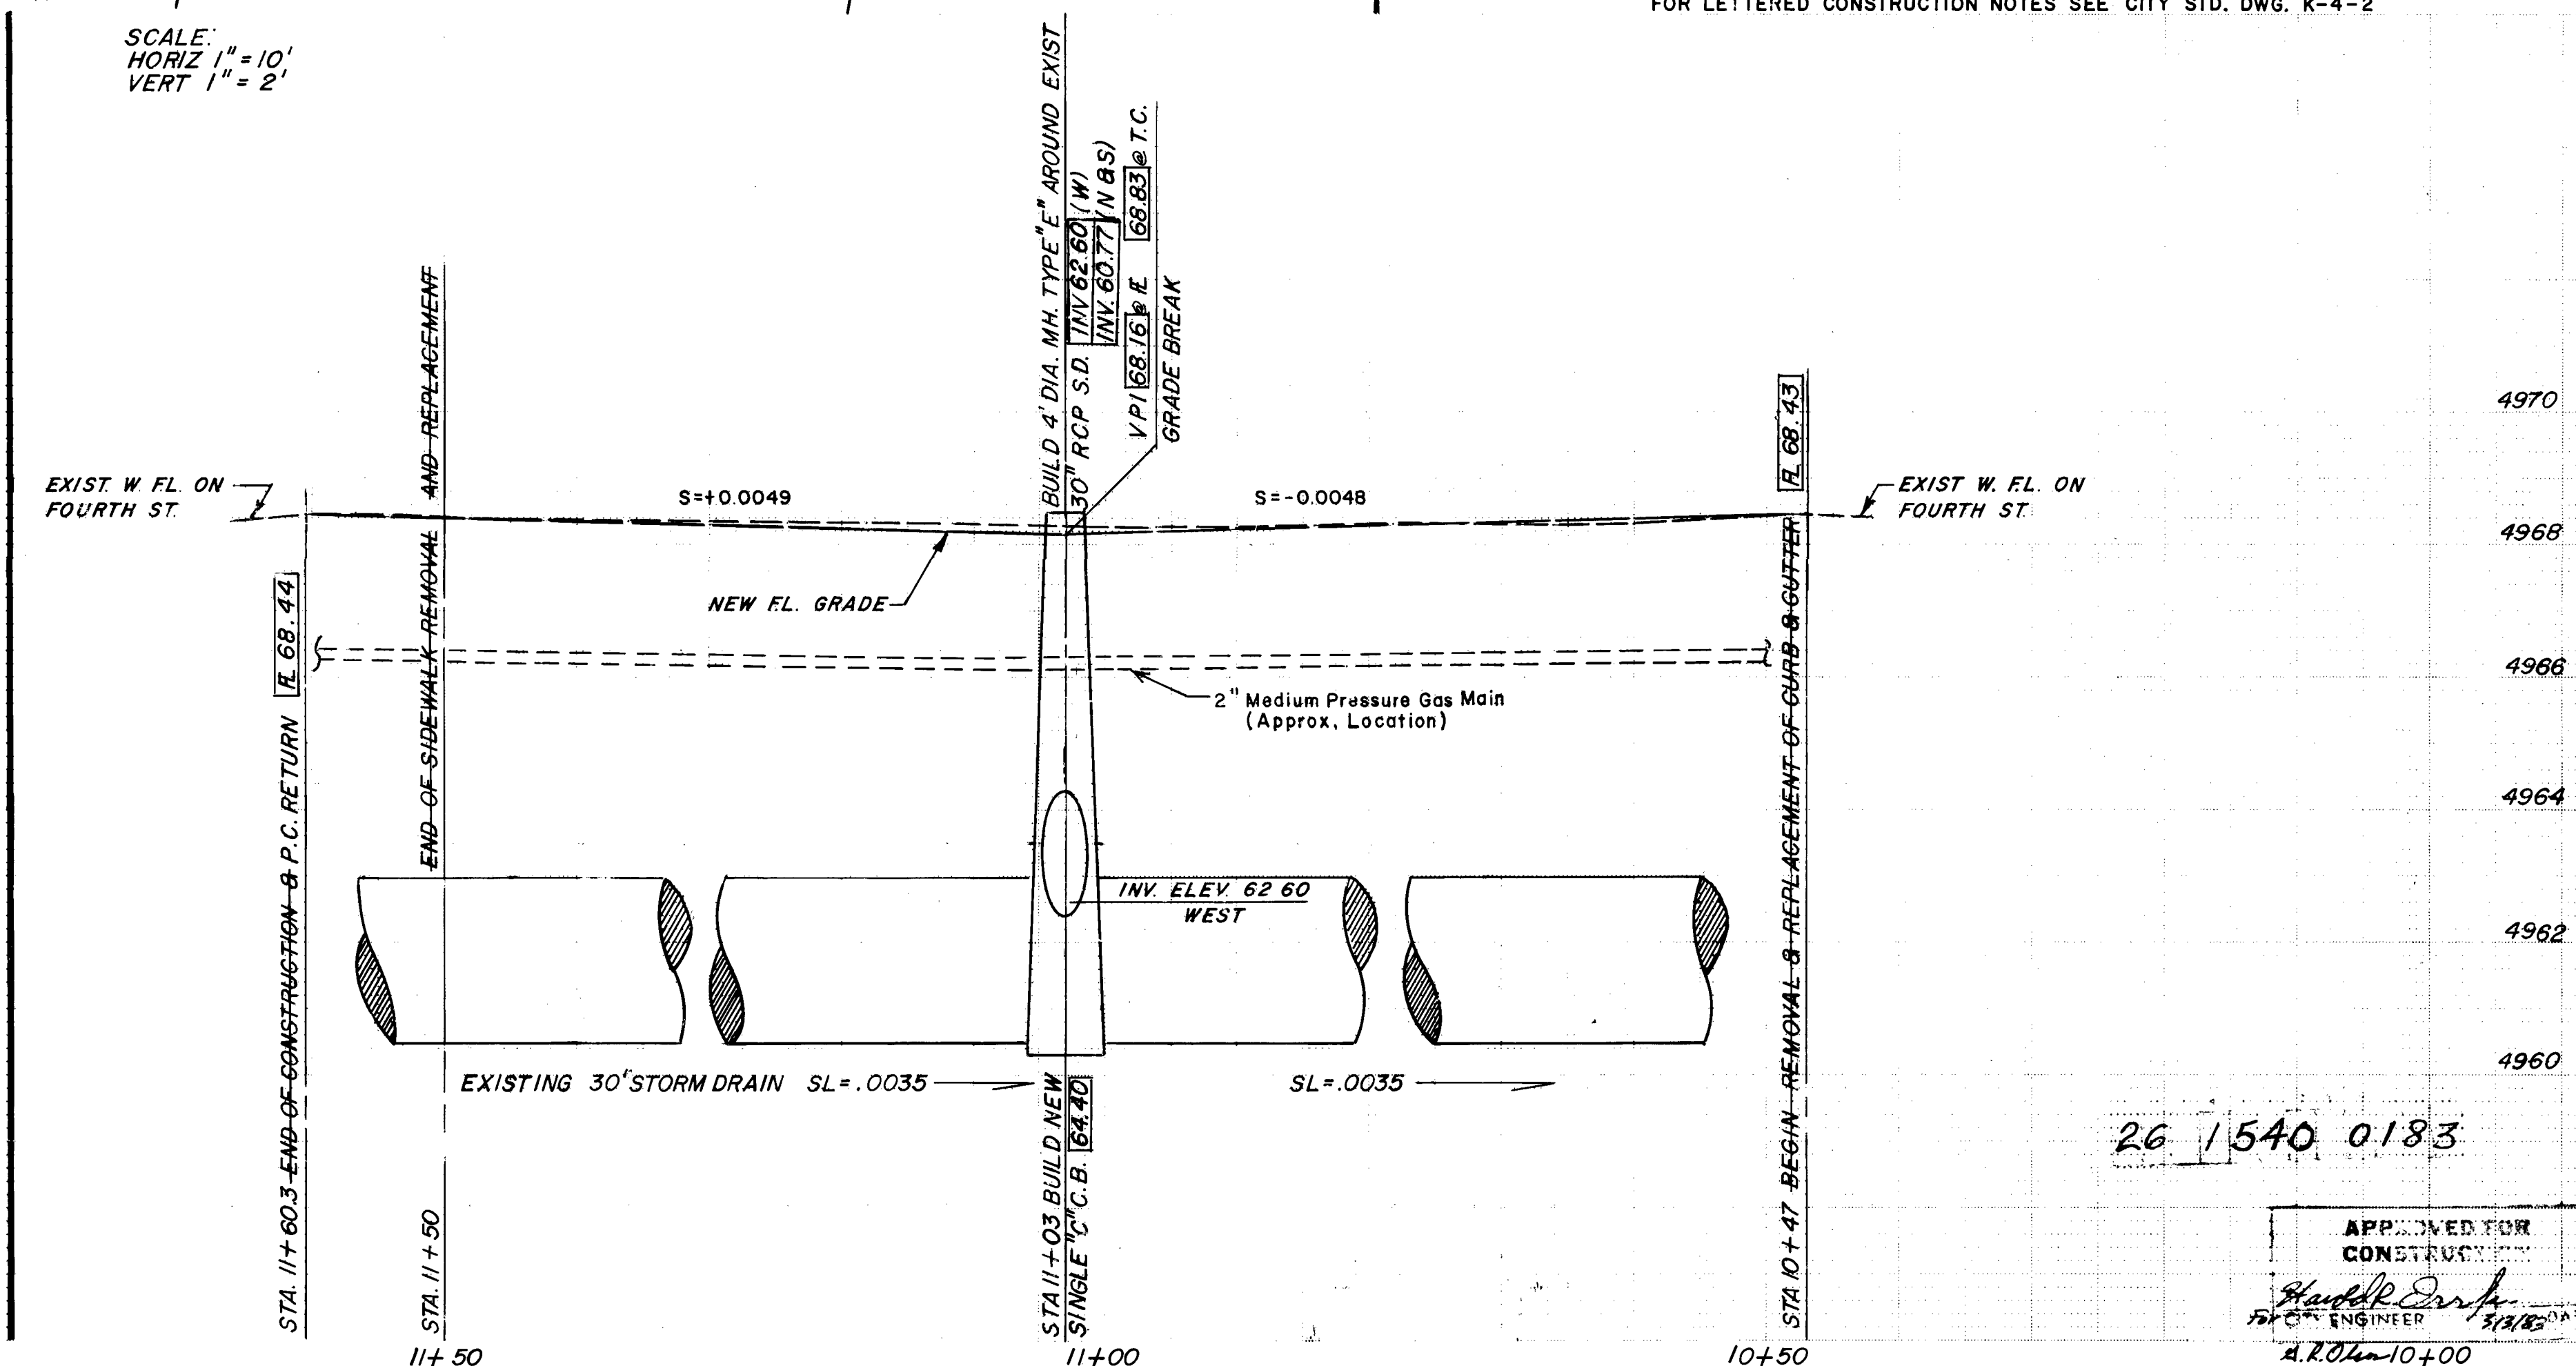
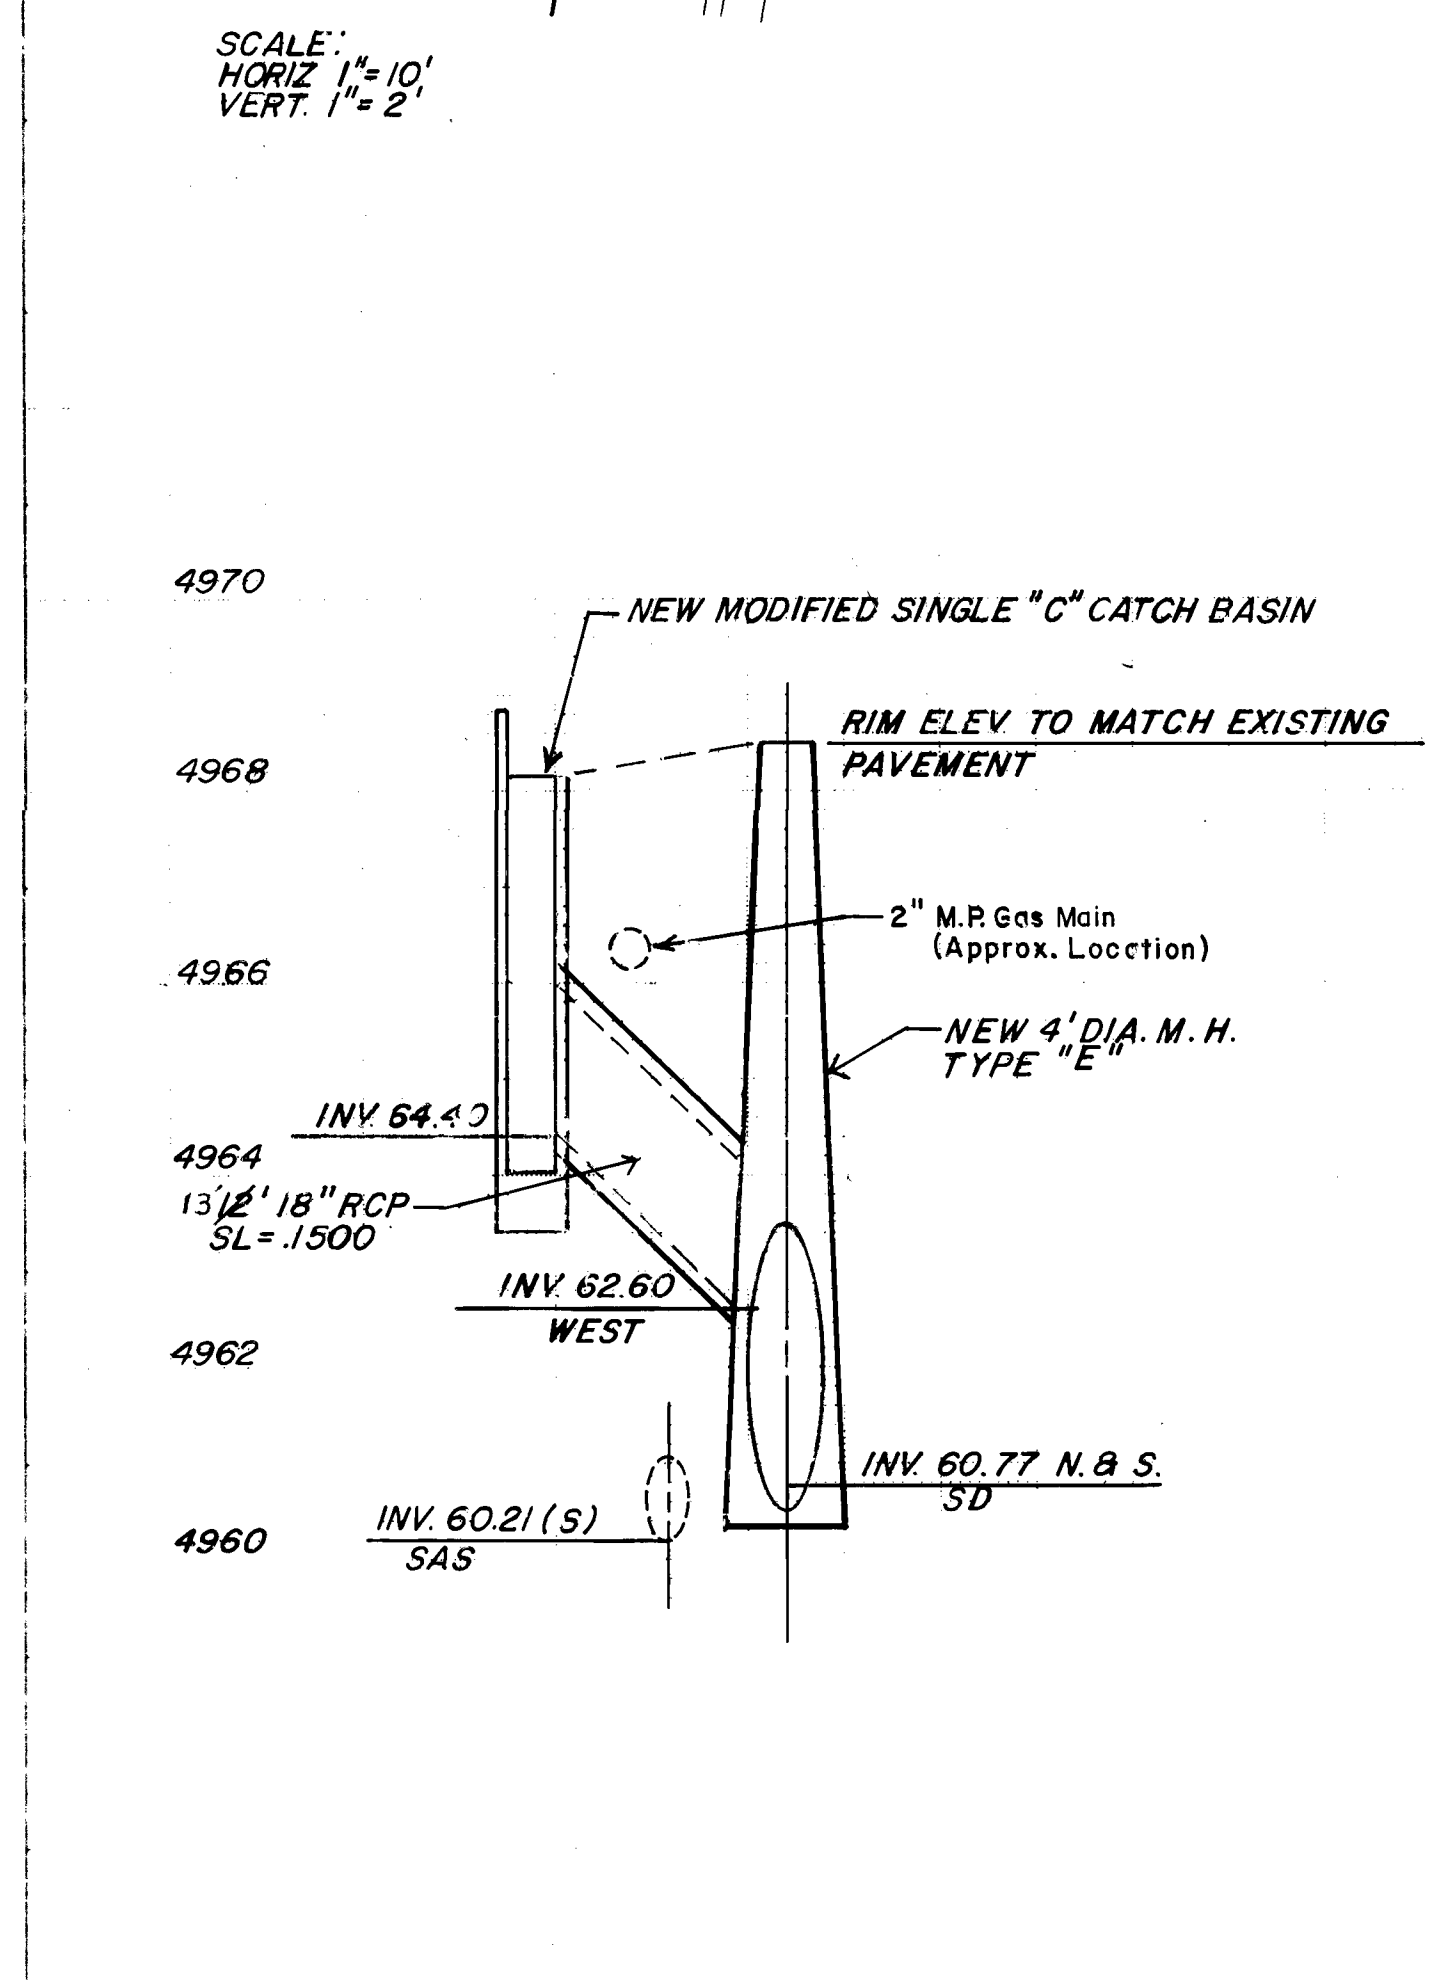


1240

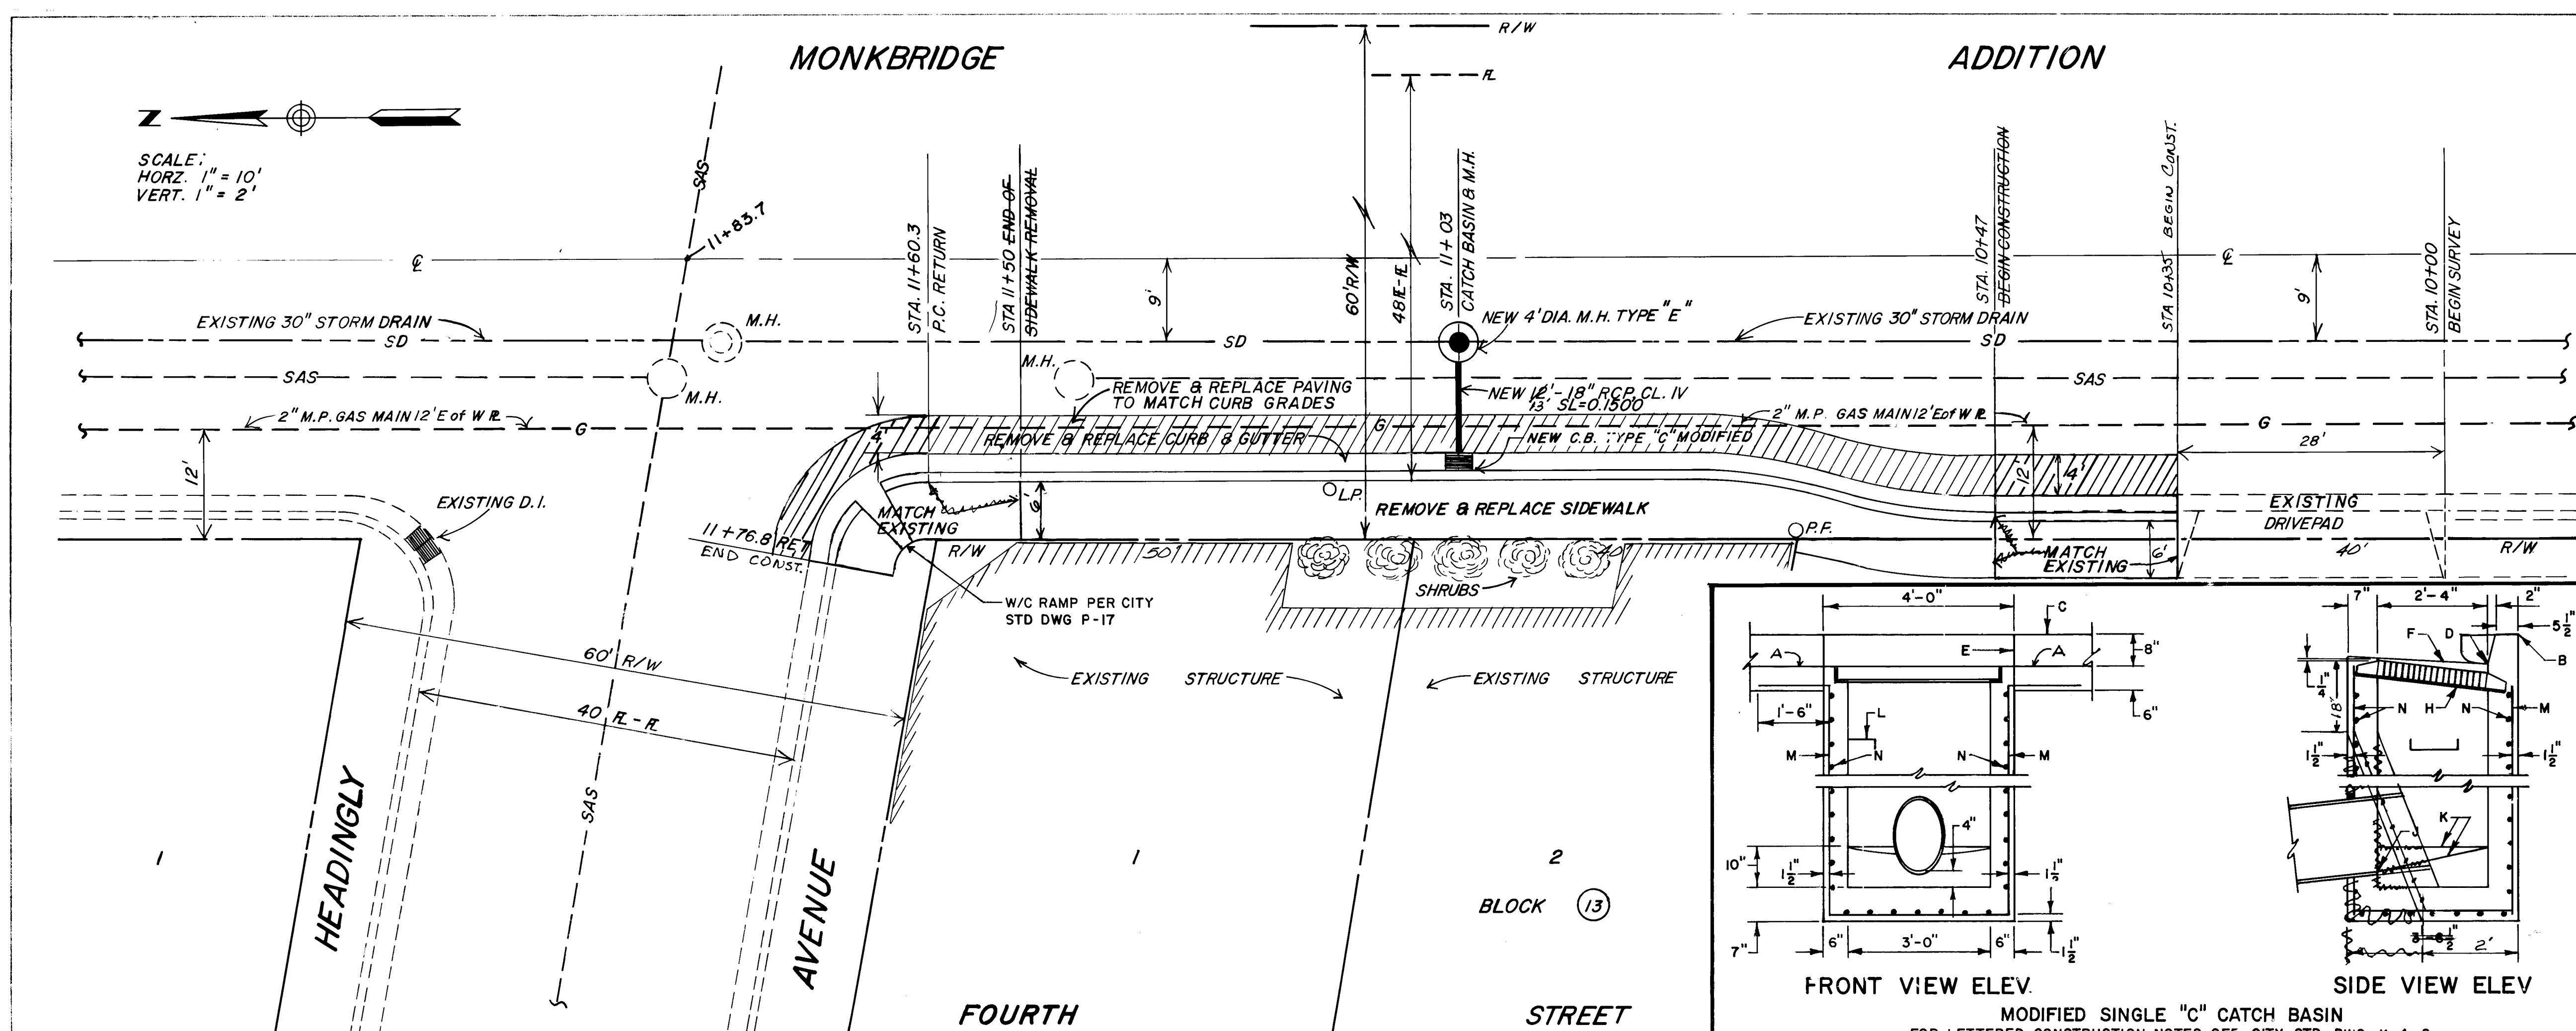

AS BUILT INFORMATION

DATE: 11/14/83

BY: S. MIRANDA

PROJECT SITE

LOCATION KEY MAP G-14

AS BUILT INFORMATION

DATE: 11/14/83

BY: S. MIRANDA

"NOTICE TO CONTRACTORS"

1) New Mexico Standard Specifications for Public Works Construction - 1979 Edition will be referred to herein as the Standard Specification.

2) All work detailed on these plans to be performed under contract shall, except as otherwise stated or provided, for hereon, be constructed in accordance with "Contract Documents for City-Wide Utilities and Gas Paving No. 3" and the Standard Specification.

3) Two working days prior to any excavation, contractor must contact Line Locating Service, 765-1234, for location of existing utilities.

4) Prior to construction, the contractor shall excavate and verify the horizontal and vertical locations of all obstructions. Should a conflict exist, the contractor shall notify the engineer or surveyor so that the conflict can be resolved with minimum amount of delay.

THE FOLLOWING NOTES APPLY WHEN CHECKED

☐ All utilities and utility service lines shall be installed prior to paving.

☒ Backfill compaction shall be according to specified street use. (ARTESIAL)

☒ Tack coat requirements shall be determined by the City Engineer.

☐ Sidewalks and wheelchair ramps within the curb returns shall be constructed wherever a new curb return is constructed.

☐ If curb is depressed for a driveway, the driveway shall be constructed prior to acceptance of the curb and gutter.

☒ All storm drainage facilities shall be completed prior to final acceptance.

LEGEND

--- EXISTING CURB & GUTTER

--- NEW CURB & GUTTER

--- EXISTING STORM SEWER

--- EXISTING SAS SEWER

--- NEW 18" RCP CL. IV

○ EXISTING MAN HOLE

● NEW MAN HOLE

▭ NEW SIDEWALK

▨ REMOVE & REPLACE PAVING

APPROVAL OF AS BUILT DRAWINGS

DATE: 11/14/83

BY: S. MIRANDA

CITY OF ALBUQUERQUE

MUNICIPAL DEVELOPMENT DEPARTMENT

ENGINEERING DIVISION

TITLE: NEW D.I. ON WEST SIDE OF 4th STREET & SOUTH OF HEADINGLY AVE

APPROVALS	ENGINEER	DATE	APPROVALS	ENGINEER	DATE
City Engineer	S. Miranda	3/2/83	Liquid Waste	NA	6/2/80
ACE Design	John Smith	9/2/83	Traffic	NA	11/1/83
ACE Hydrology	John Smith	11/7/83	Water	NA	12/2/80

DRAWING NO. 1540

MAP NO. 6-14

SHEET 1 OF 1

1240