



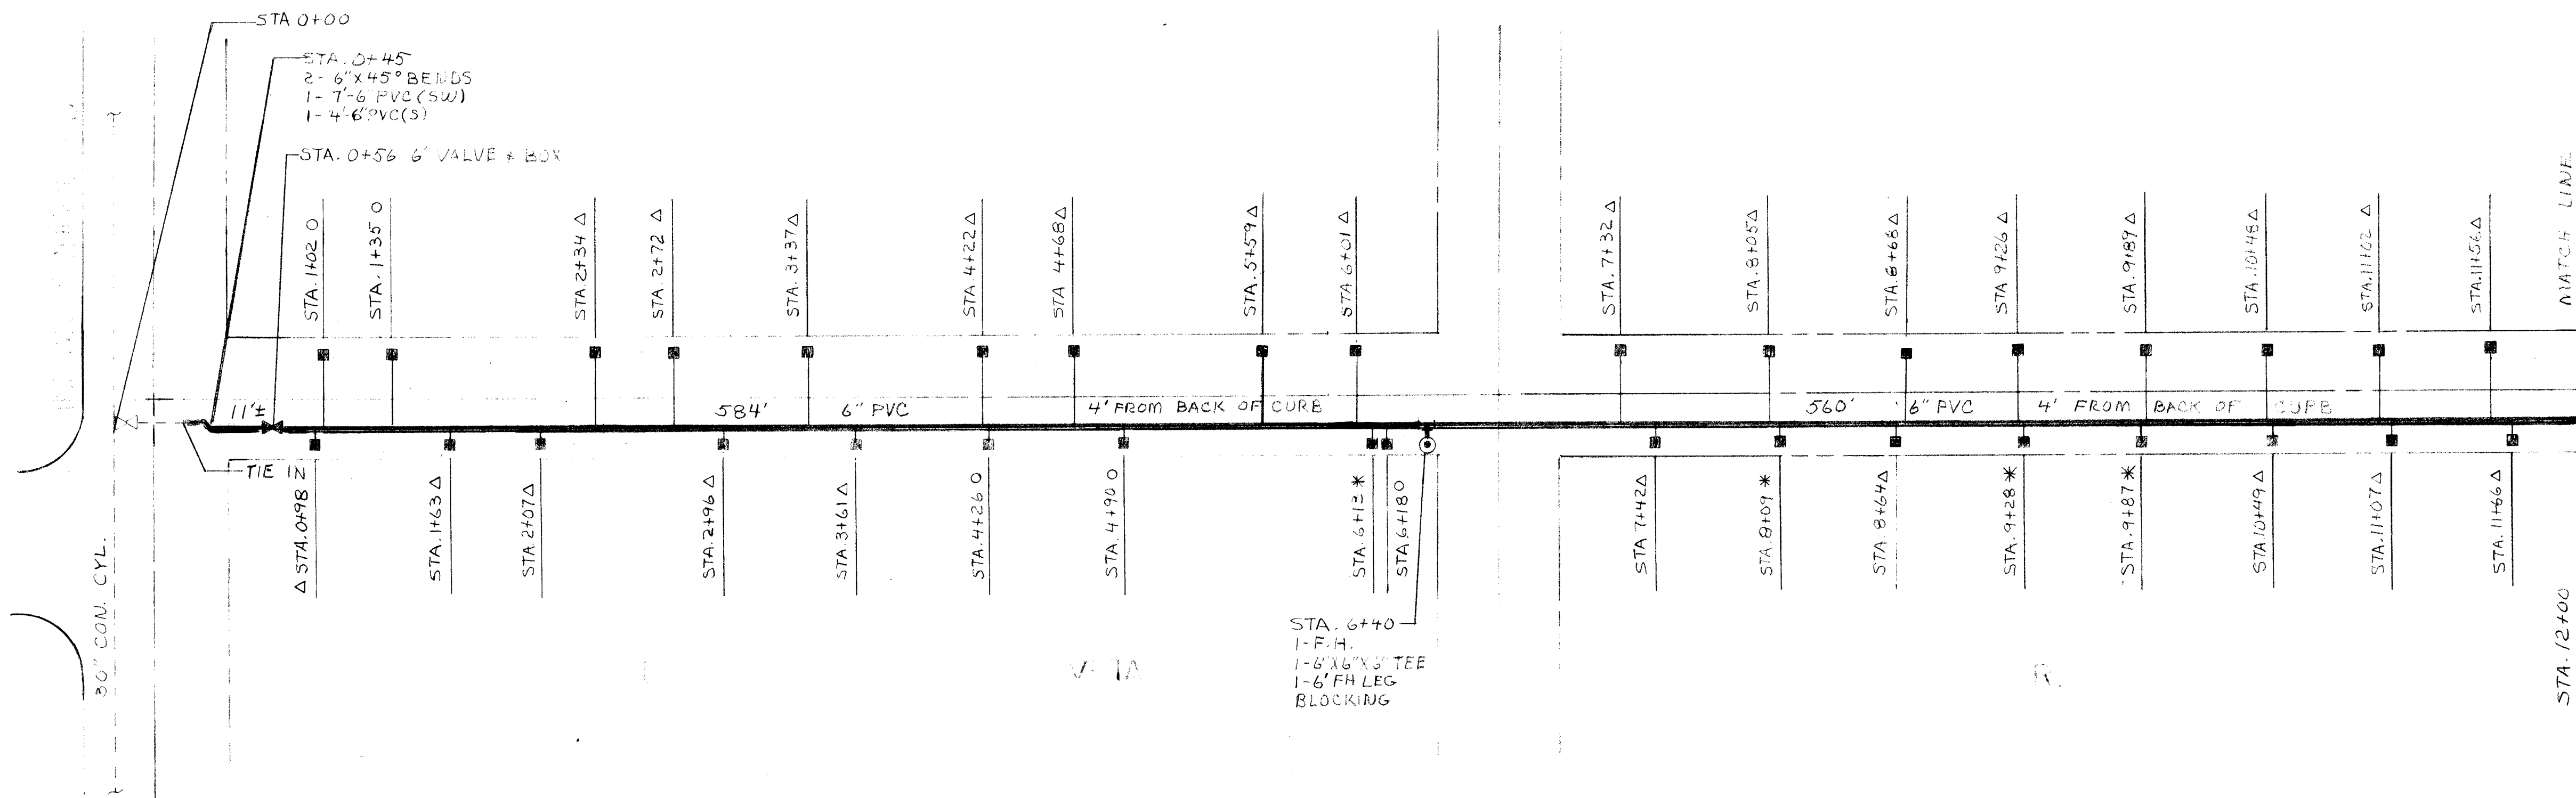

SCALE: 1"=50'

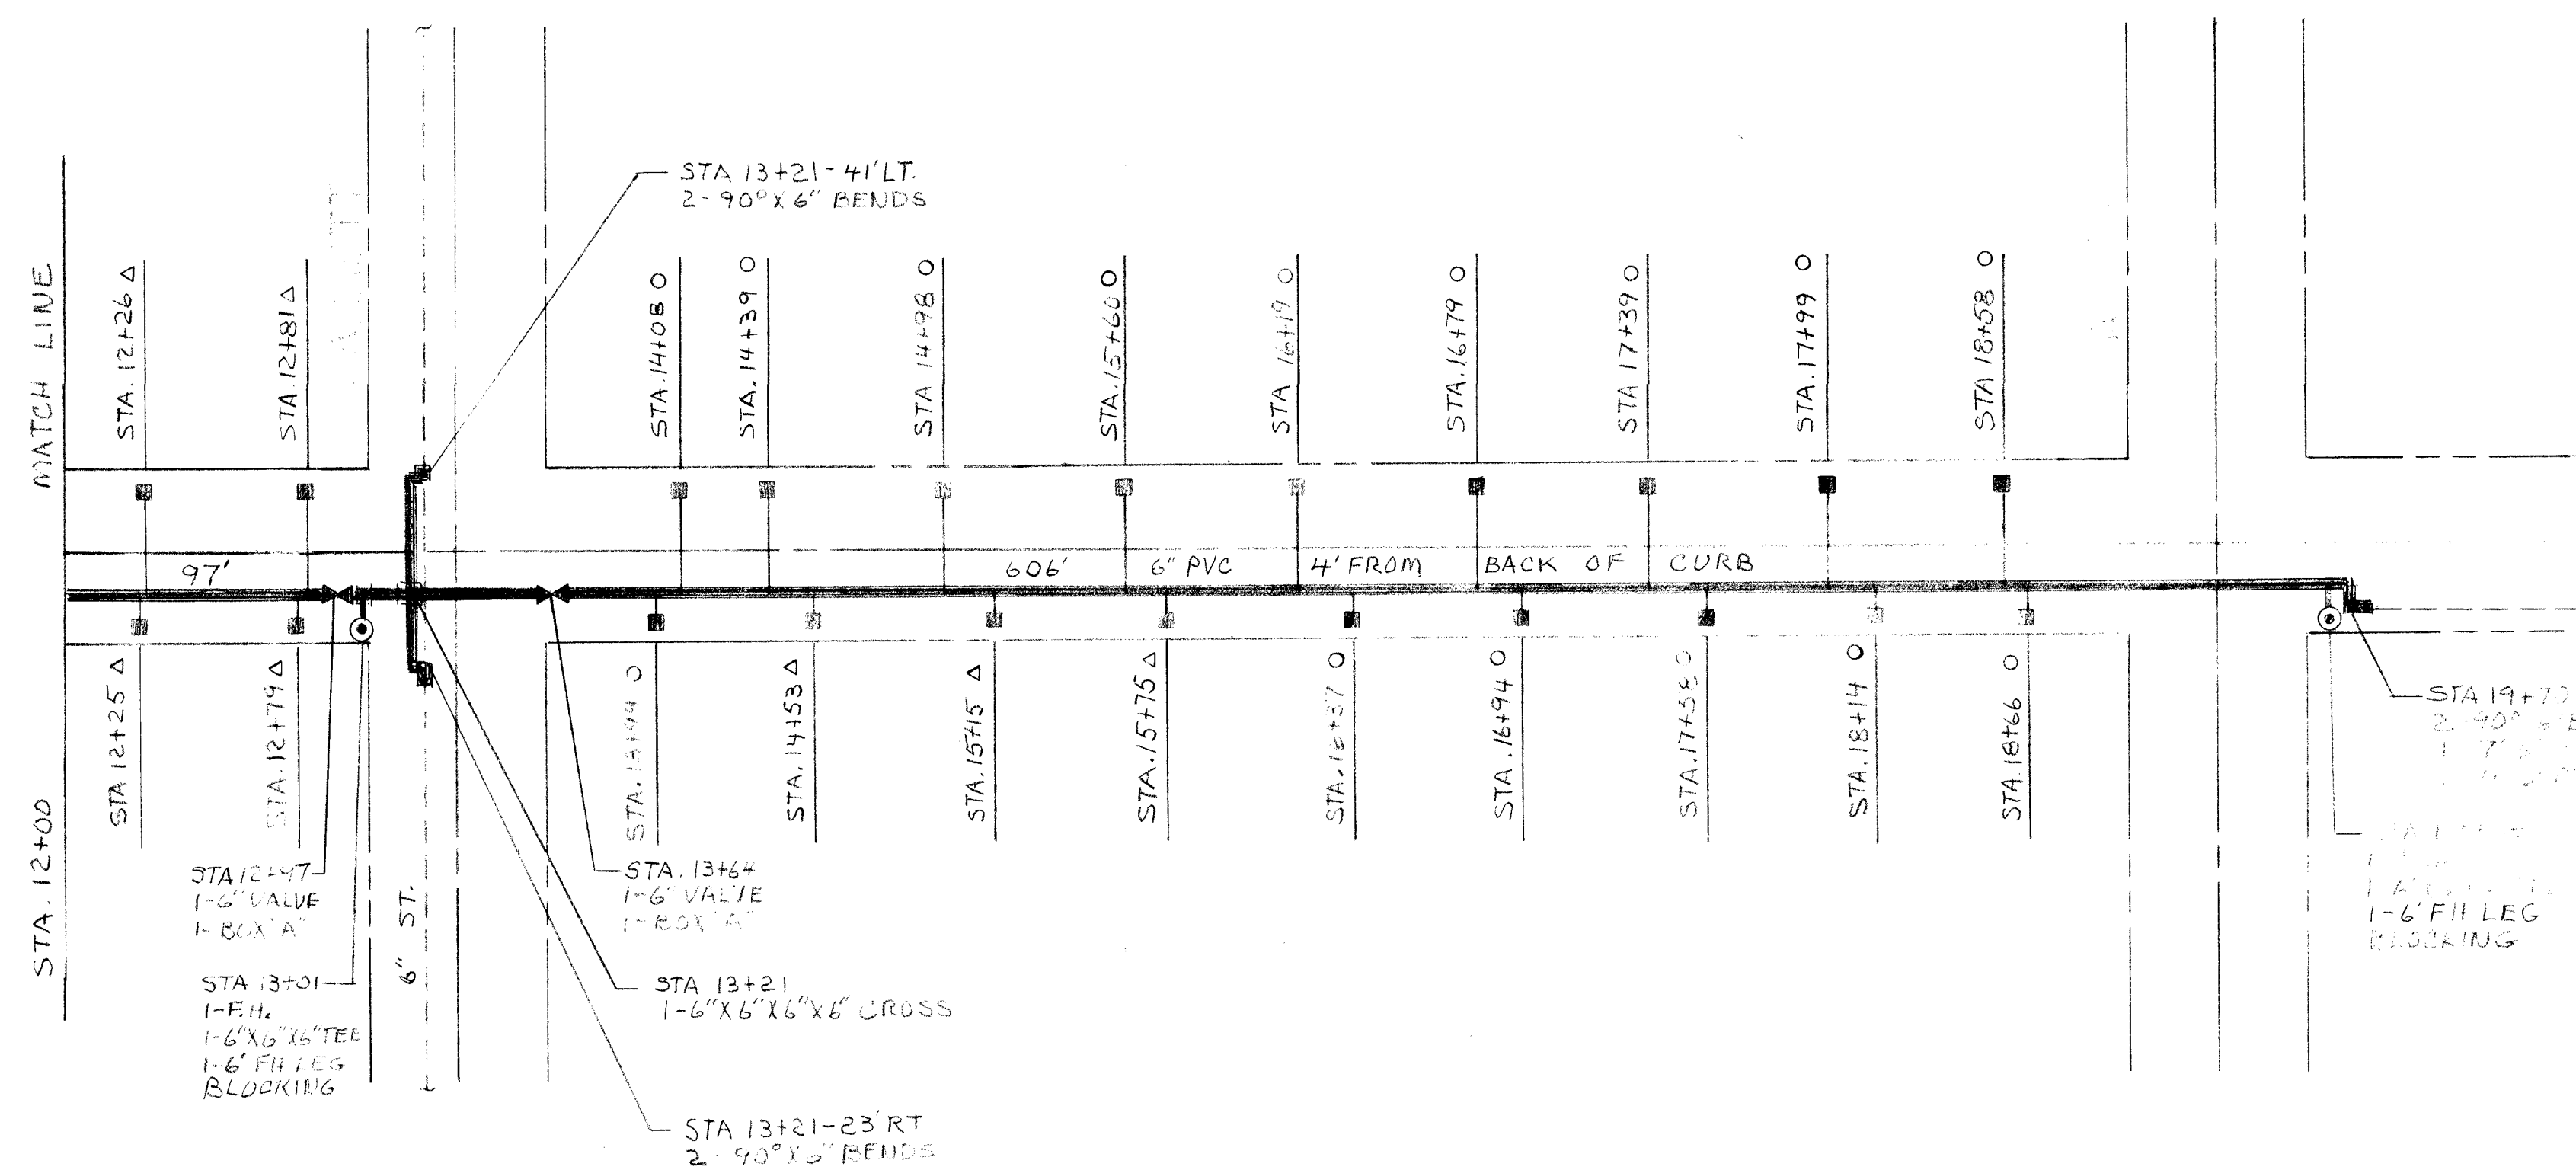

APPROVAL OF AS BUILT DRAWINGS
 ASST. CITY ENGINEER FIELD
 DATE 2/20/82

1 2 3 4 5 6 7 8 9 10 11 12
 24 11552 01 82

NOTES:

1. INSTALL DIRT COVER LINE 5-6\"/>

THIS AS BUILT DRAWING IS FOR FIELD USE ONLY. IT IS NOT TO BE USED FOR CONSTRUCTION.

CITY OF ALBUQUERQUE MUNICIPAL DEVELOPMENT DEPARTMENT ENGINEERING DIVISION			
TITLE: WATER LINE RELOCATION ON LA VETA DRIVE FROM INDIAN SCHOOL RD. TO LA VETA			
DESIGNED BY	DATE	CHECKED BY	DATE
DRAWN BY	DATE	APPROVED BY	DATE
DRAWING NO. 1552		SHEET 1 OF 1	

AS BUILT INFORMATION	
NO.	DATE
REVISIONS	
NO.	DATE
MICRO-FILM INFORMATION	
NO.	DATE

SURVEY INFORMATION	
NO.	DATE
BENCH MARKS	
NO.	DATE