


SCANNED BY Larson

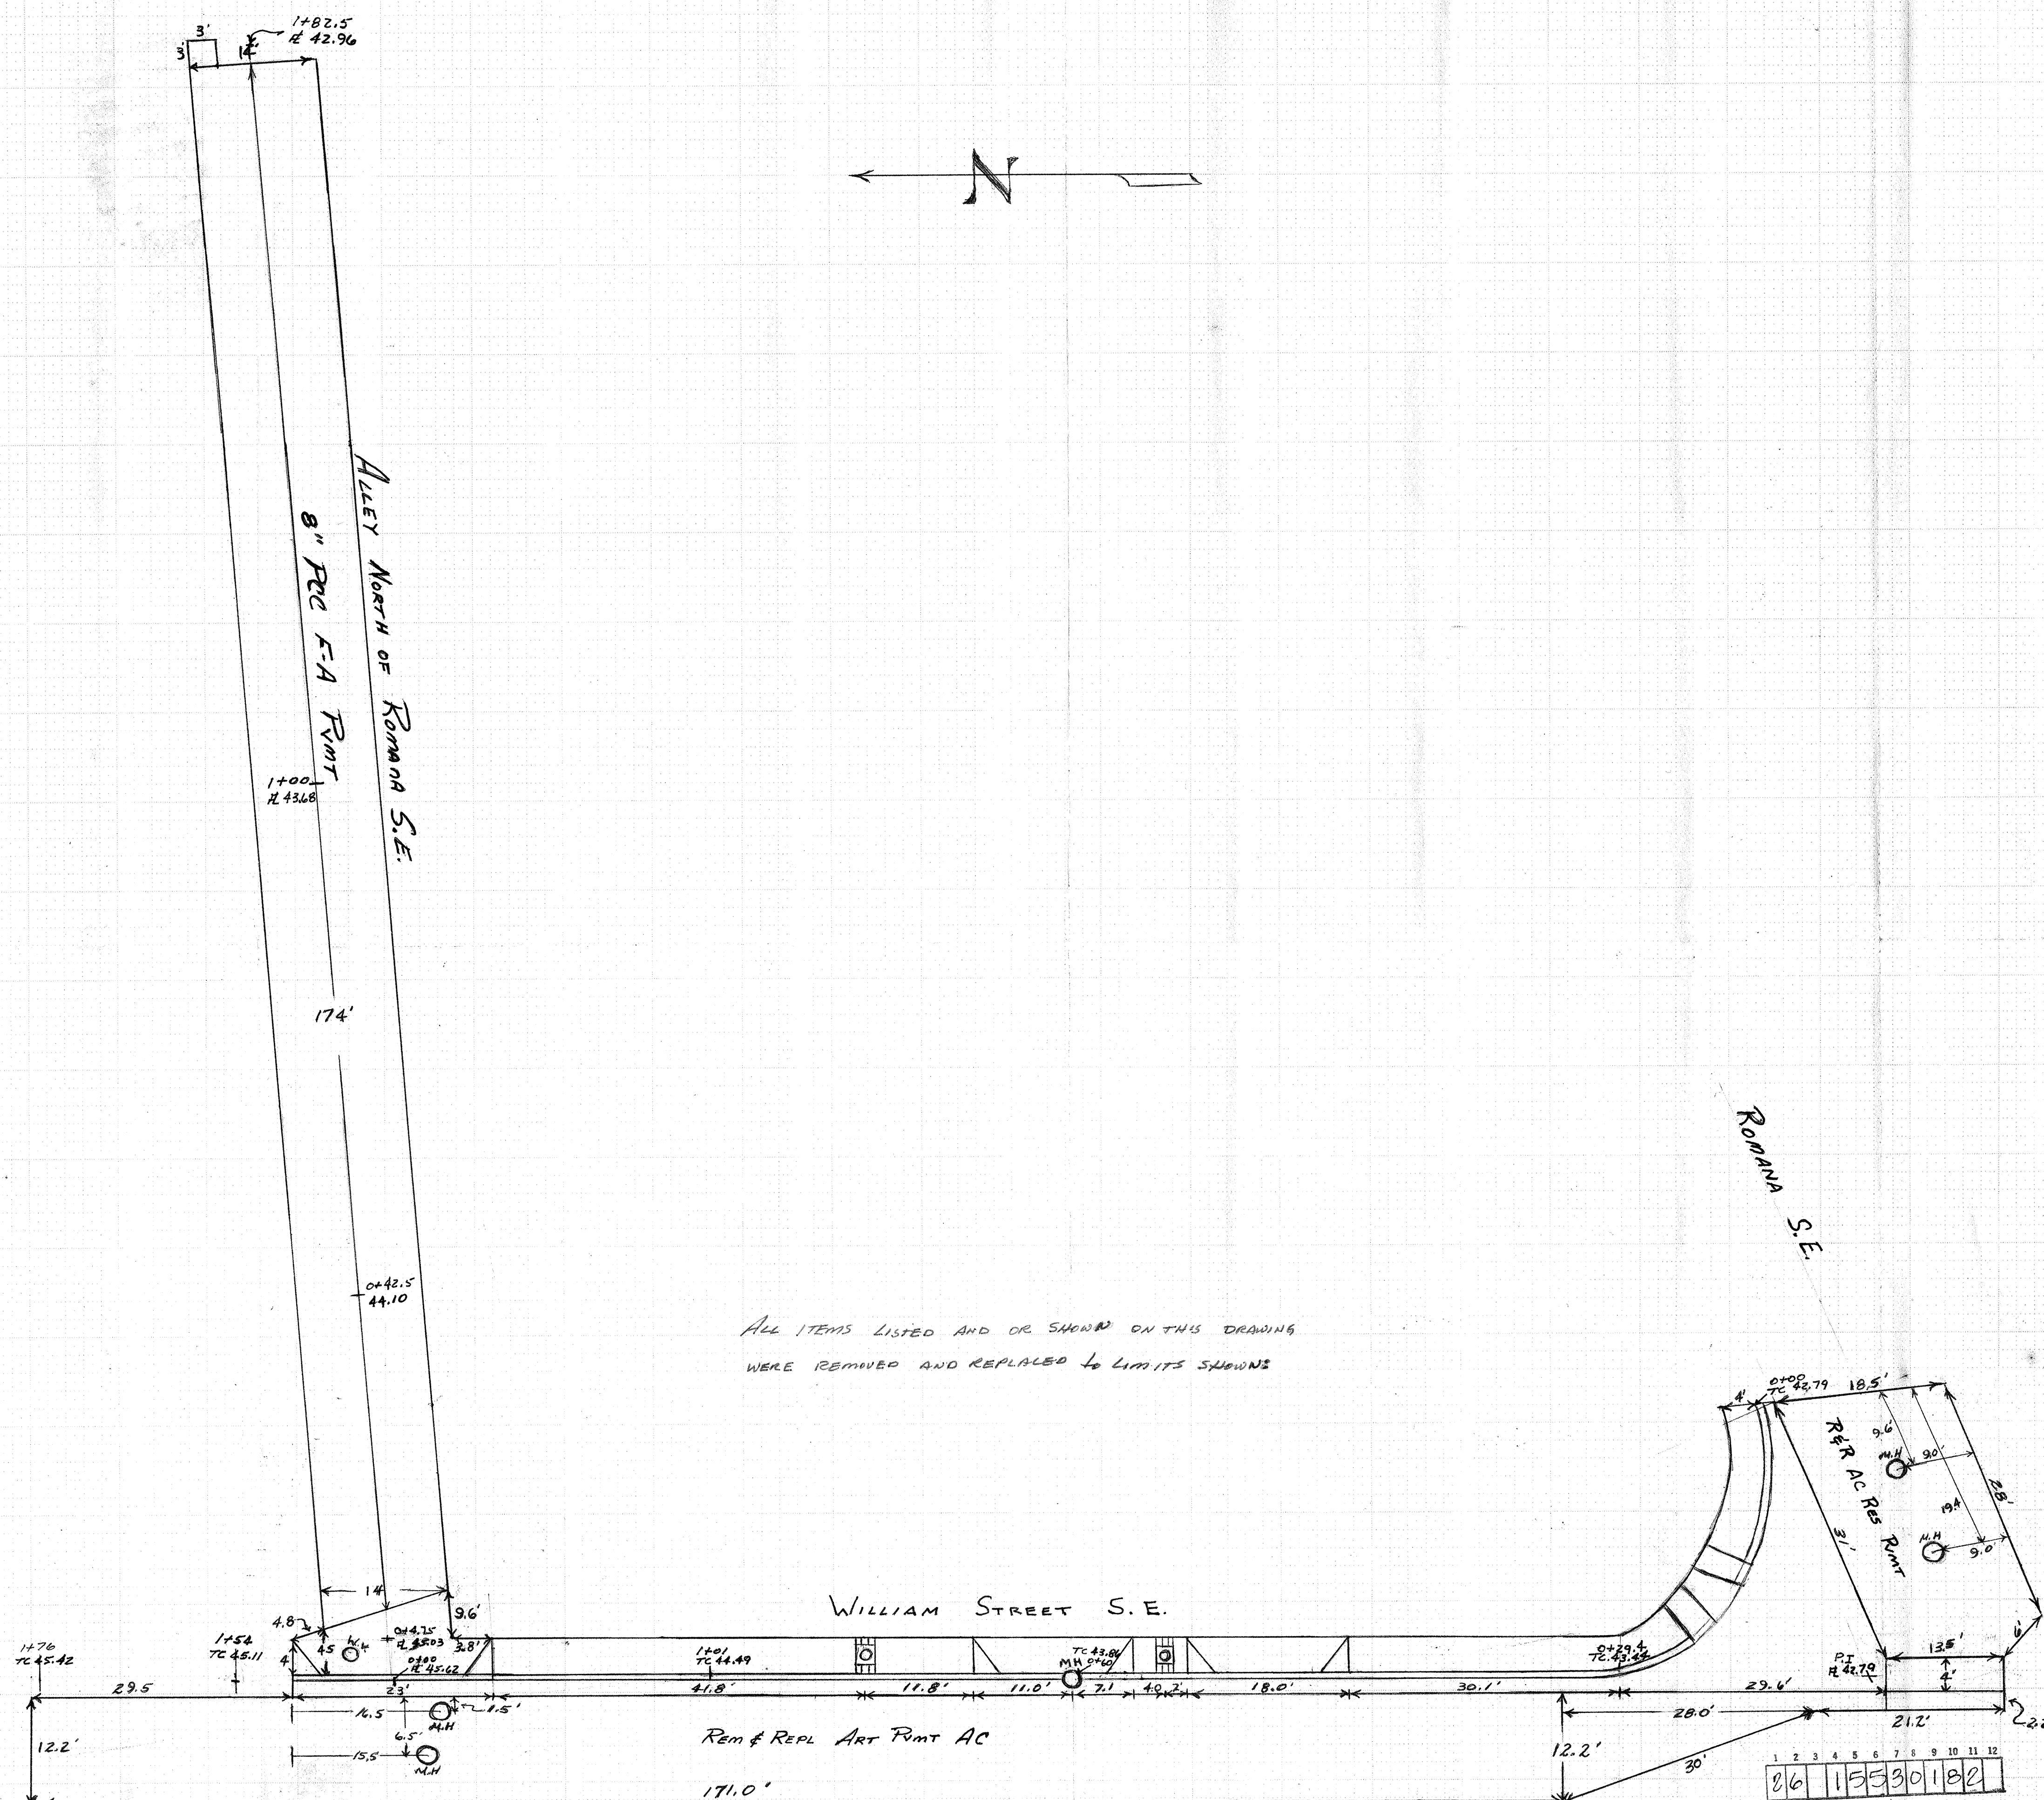

ALL ITEMS LISTED AND OR SHOWN ON THIS DRAWING  
WERE REMOVED AND REPLACED TO LIMITS SHOWN:

APPROVAL OF AS BUILT DRAWINGS  
ASST. CITY ENGINEER - FIELD  
*M. J. Kurney*  
DATE *12.2.82*

THIS AS-BUILT COMPILED FROM  
FIELD NOTES AND IS FOR  
RECORD PURPOSE

ALL INFORMATION CONTAINED  
HEREIN IS UNCLASSIFIED  
DATE 29 Oct 82 BY [signature]

CONTRACTOR: NEW CONCEPTS.  
W.O. No. 31-1553

CITY OF ALBUQUERQUE  
PUBLIC WORKS DEPARTMENT  
ENGINEERING DIVISION

TITLE: EMERGENCY STREET REPAIRS INTERSECTION:  
ALLEY NORTH OF ROMANA AND WILLIAM STREET S.E.,  
WILLIAM STREET AND ROMANA S.E.

| APPROVALS          | ENGINEER | DATE | APPROVALS    | ENGINEER | DATE |
|--------------------|----------|------|--------------|----------|------|
| City Engineer      |          |      | Liquid Waste |          |      |
| A.C.E. - Design    |          |      | Sludge       |          |      |
| A.C.E. - Hydrology |          |      | Water        |          |      |
| DRAWING NO. 1553   |          |      | SHEET 1 OF 1 |          |      |

[illegible]