
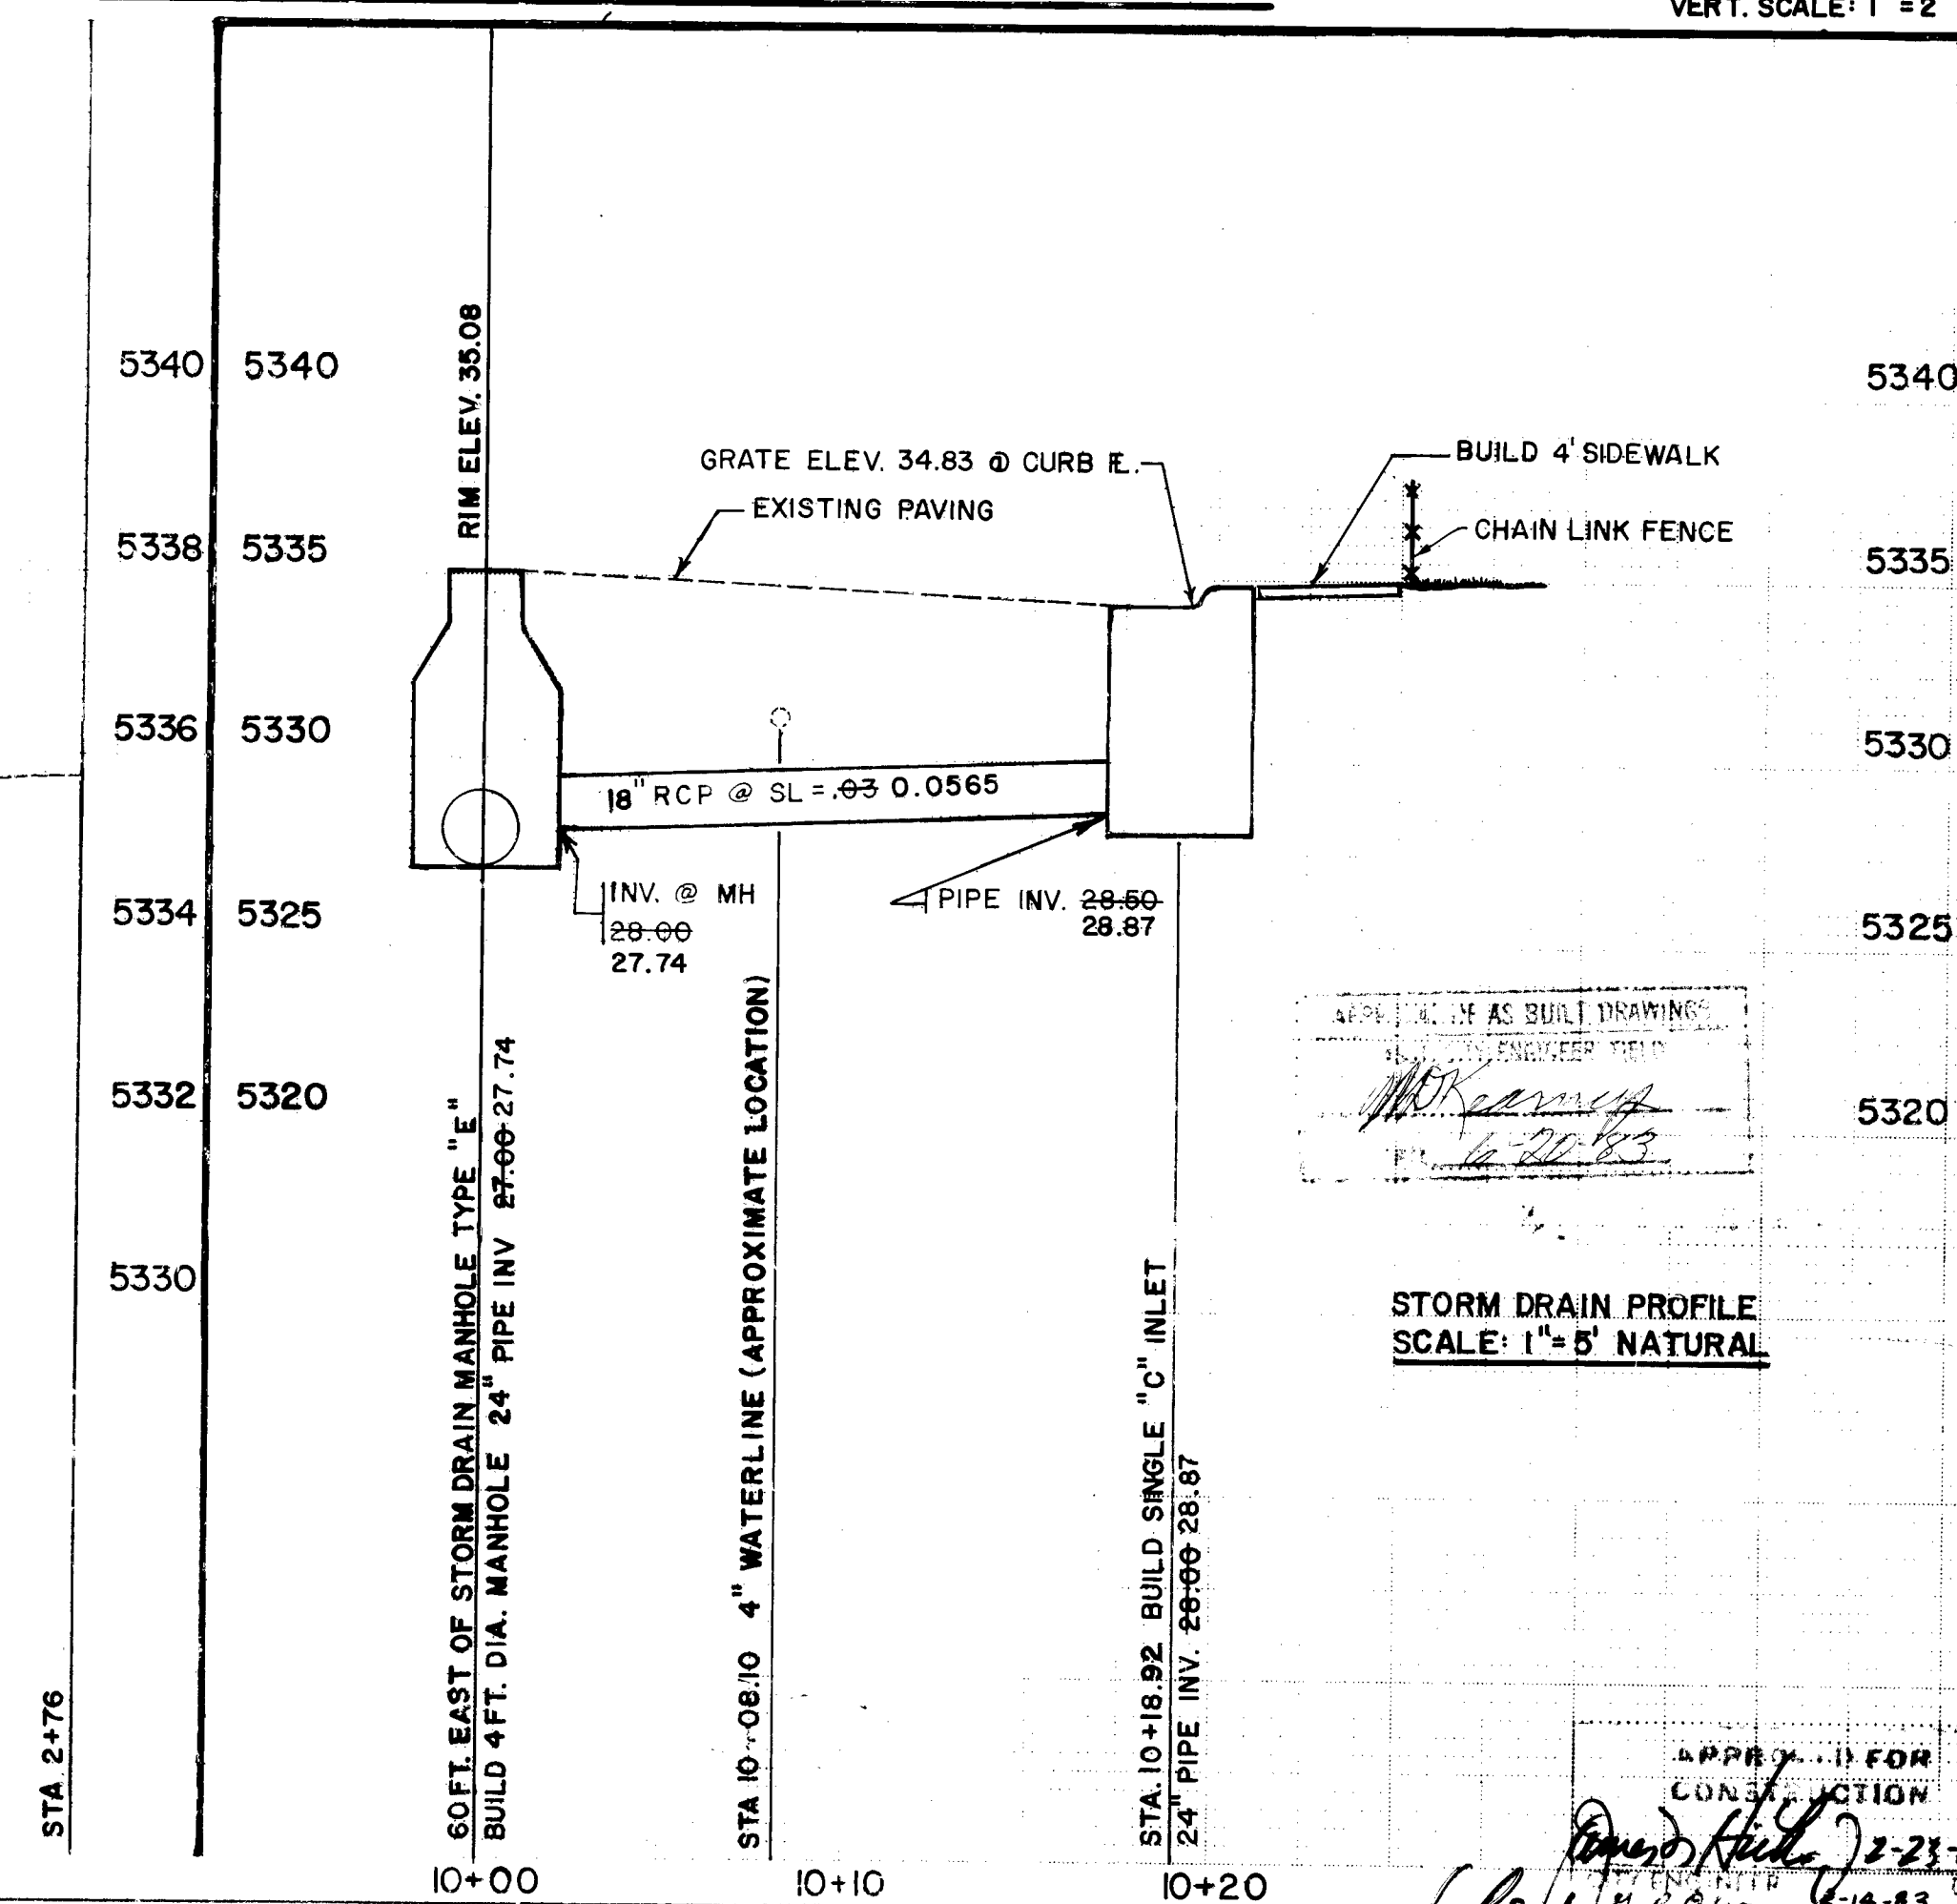
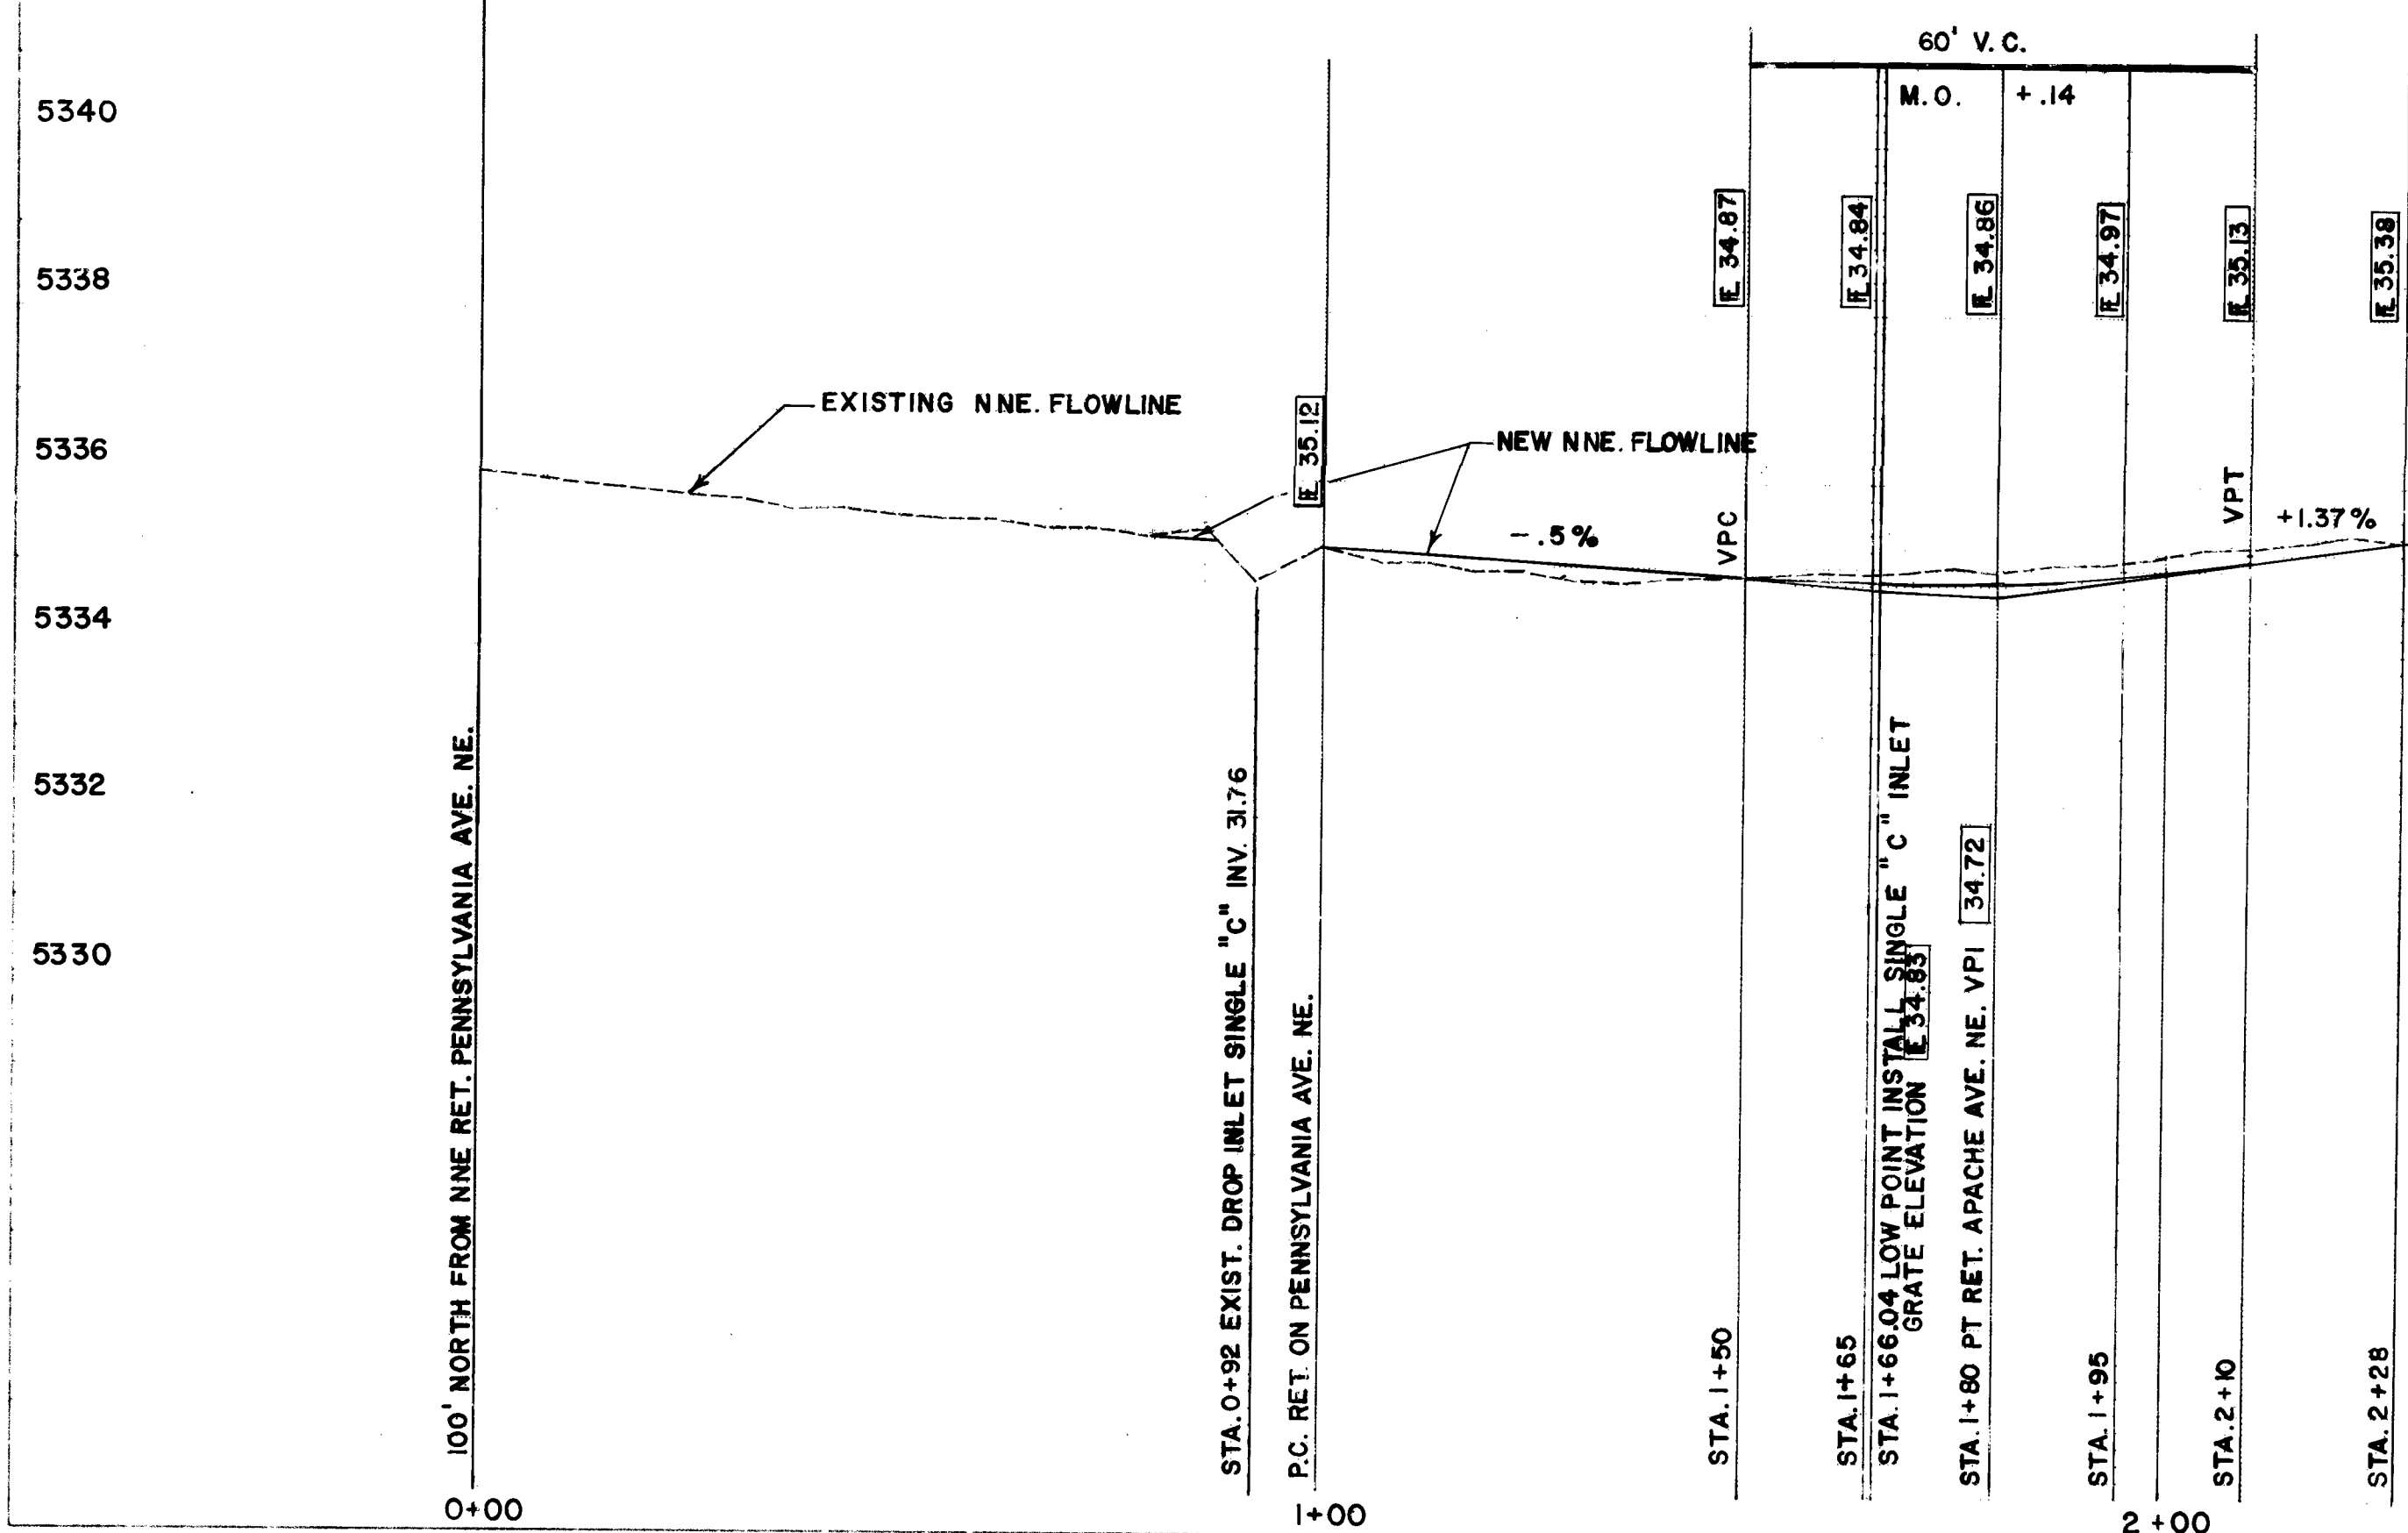
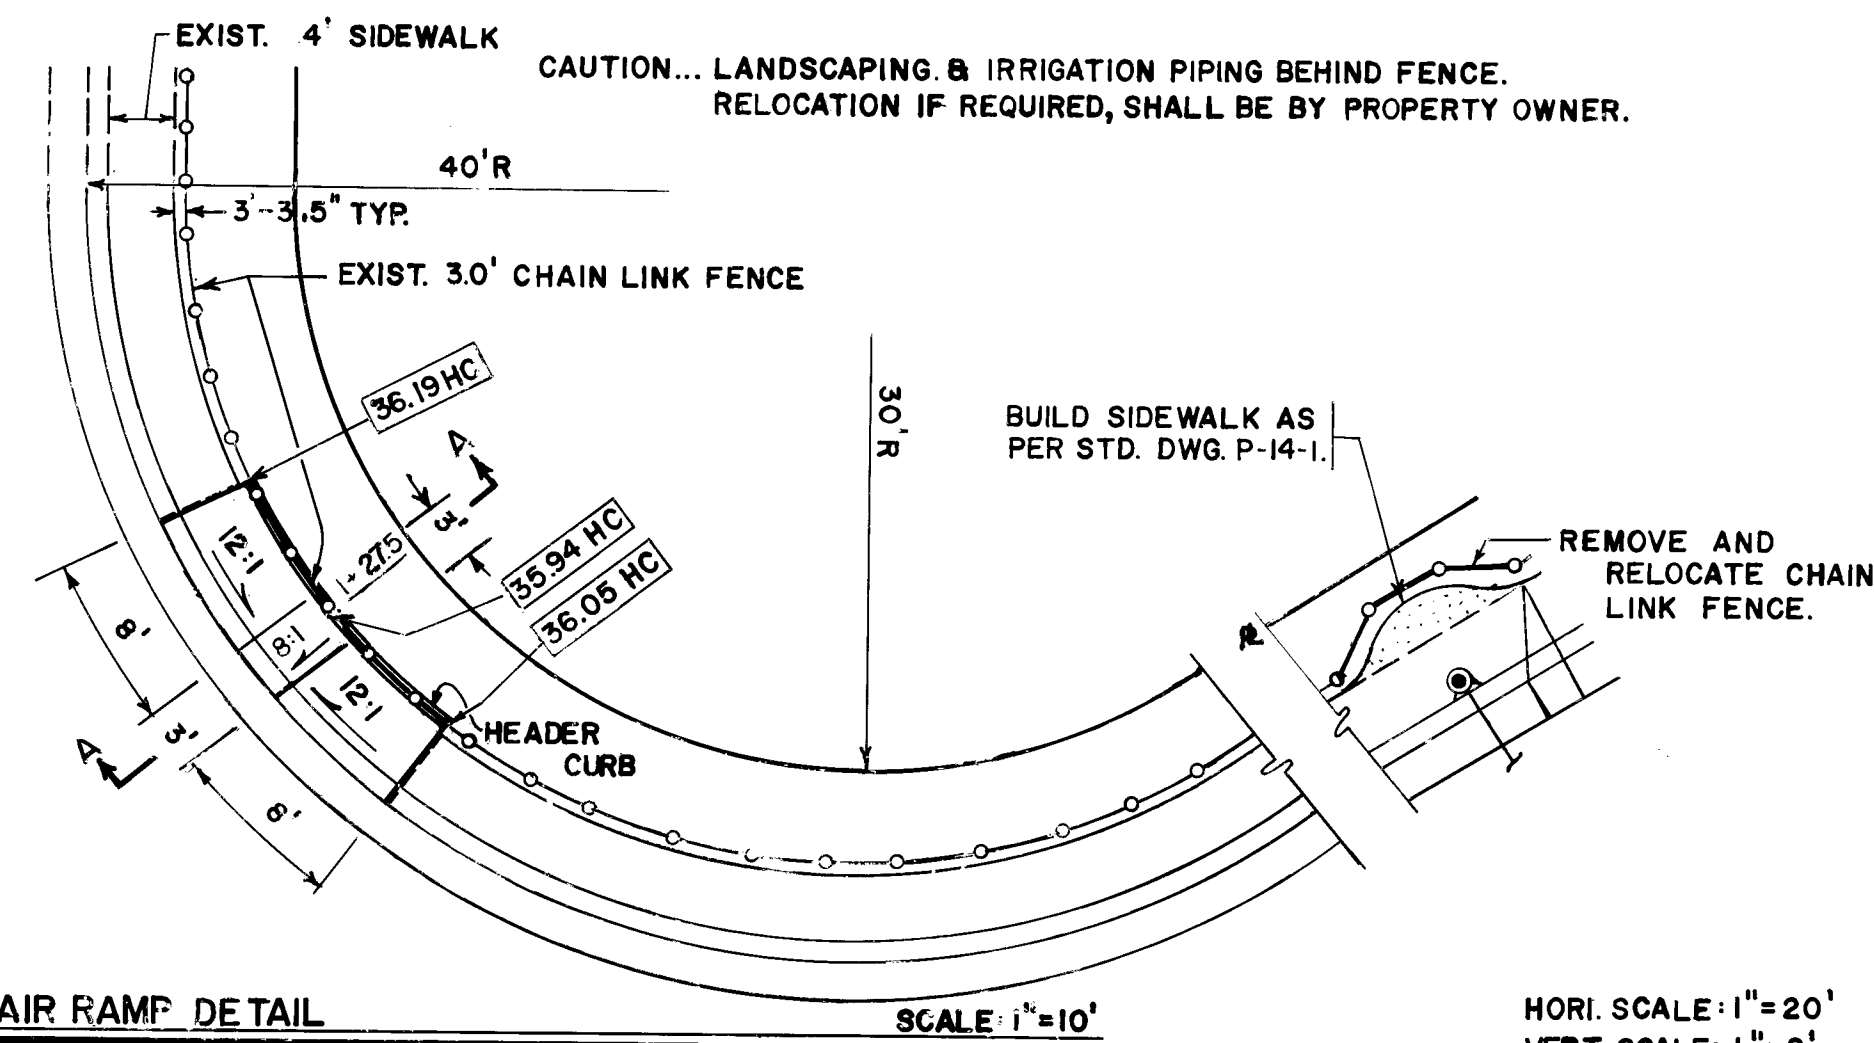
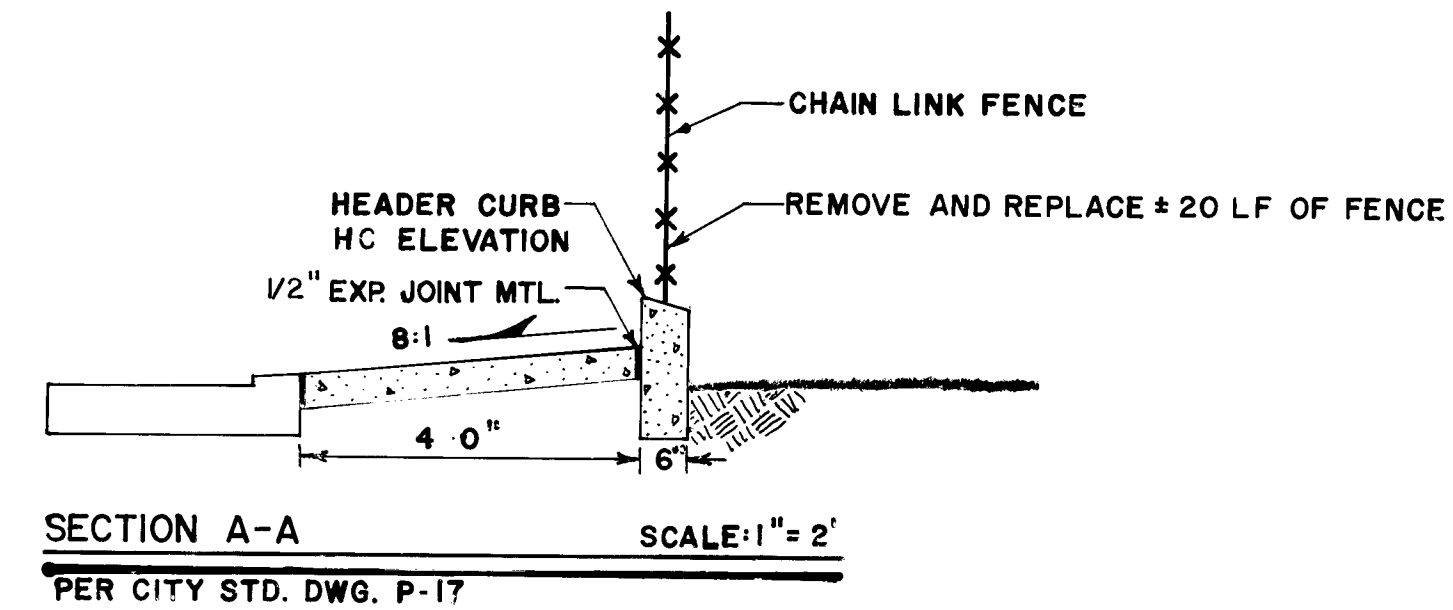


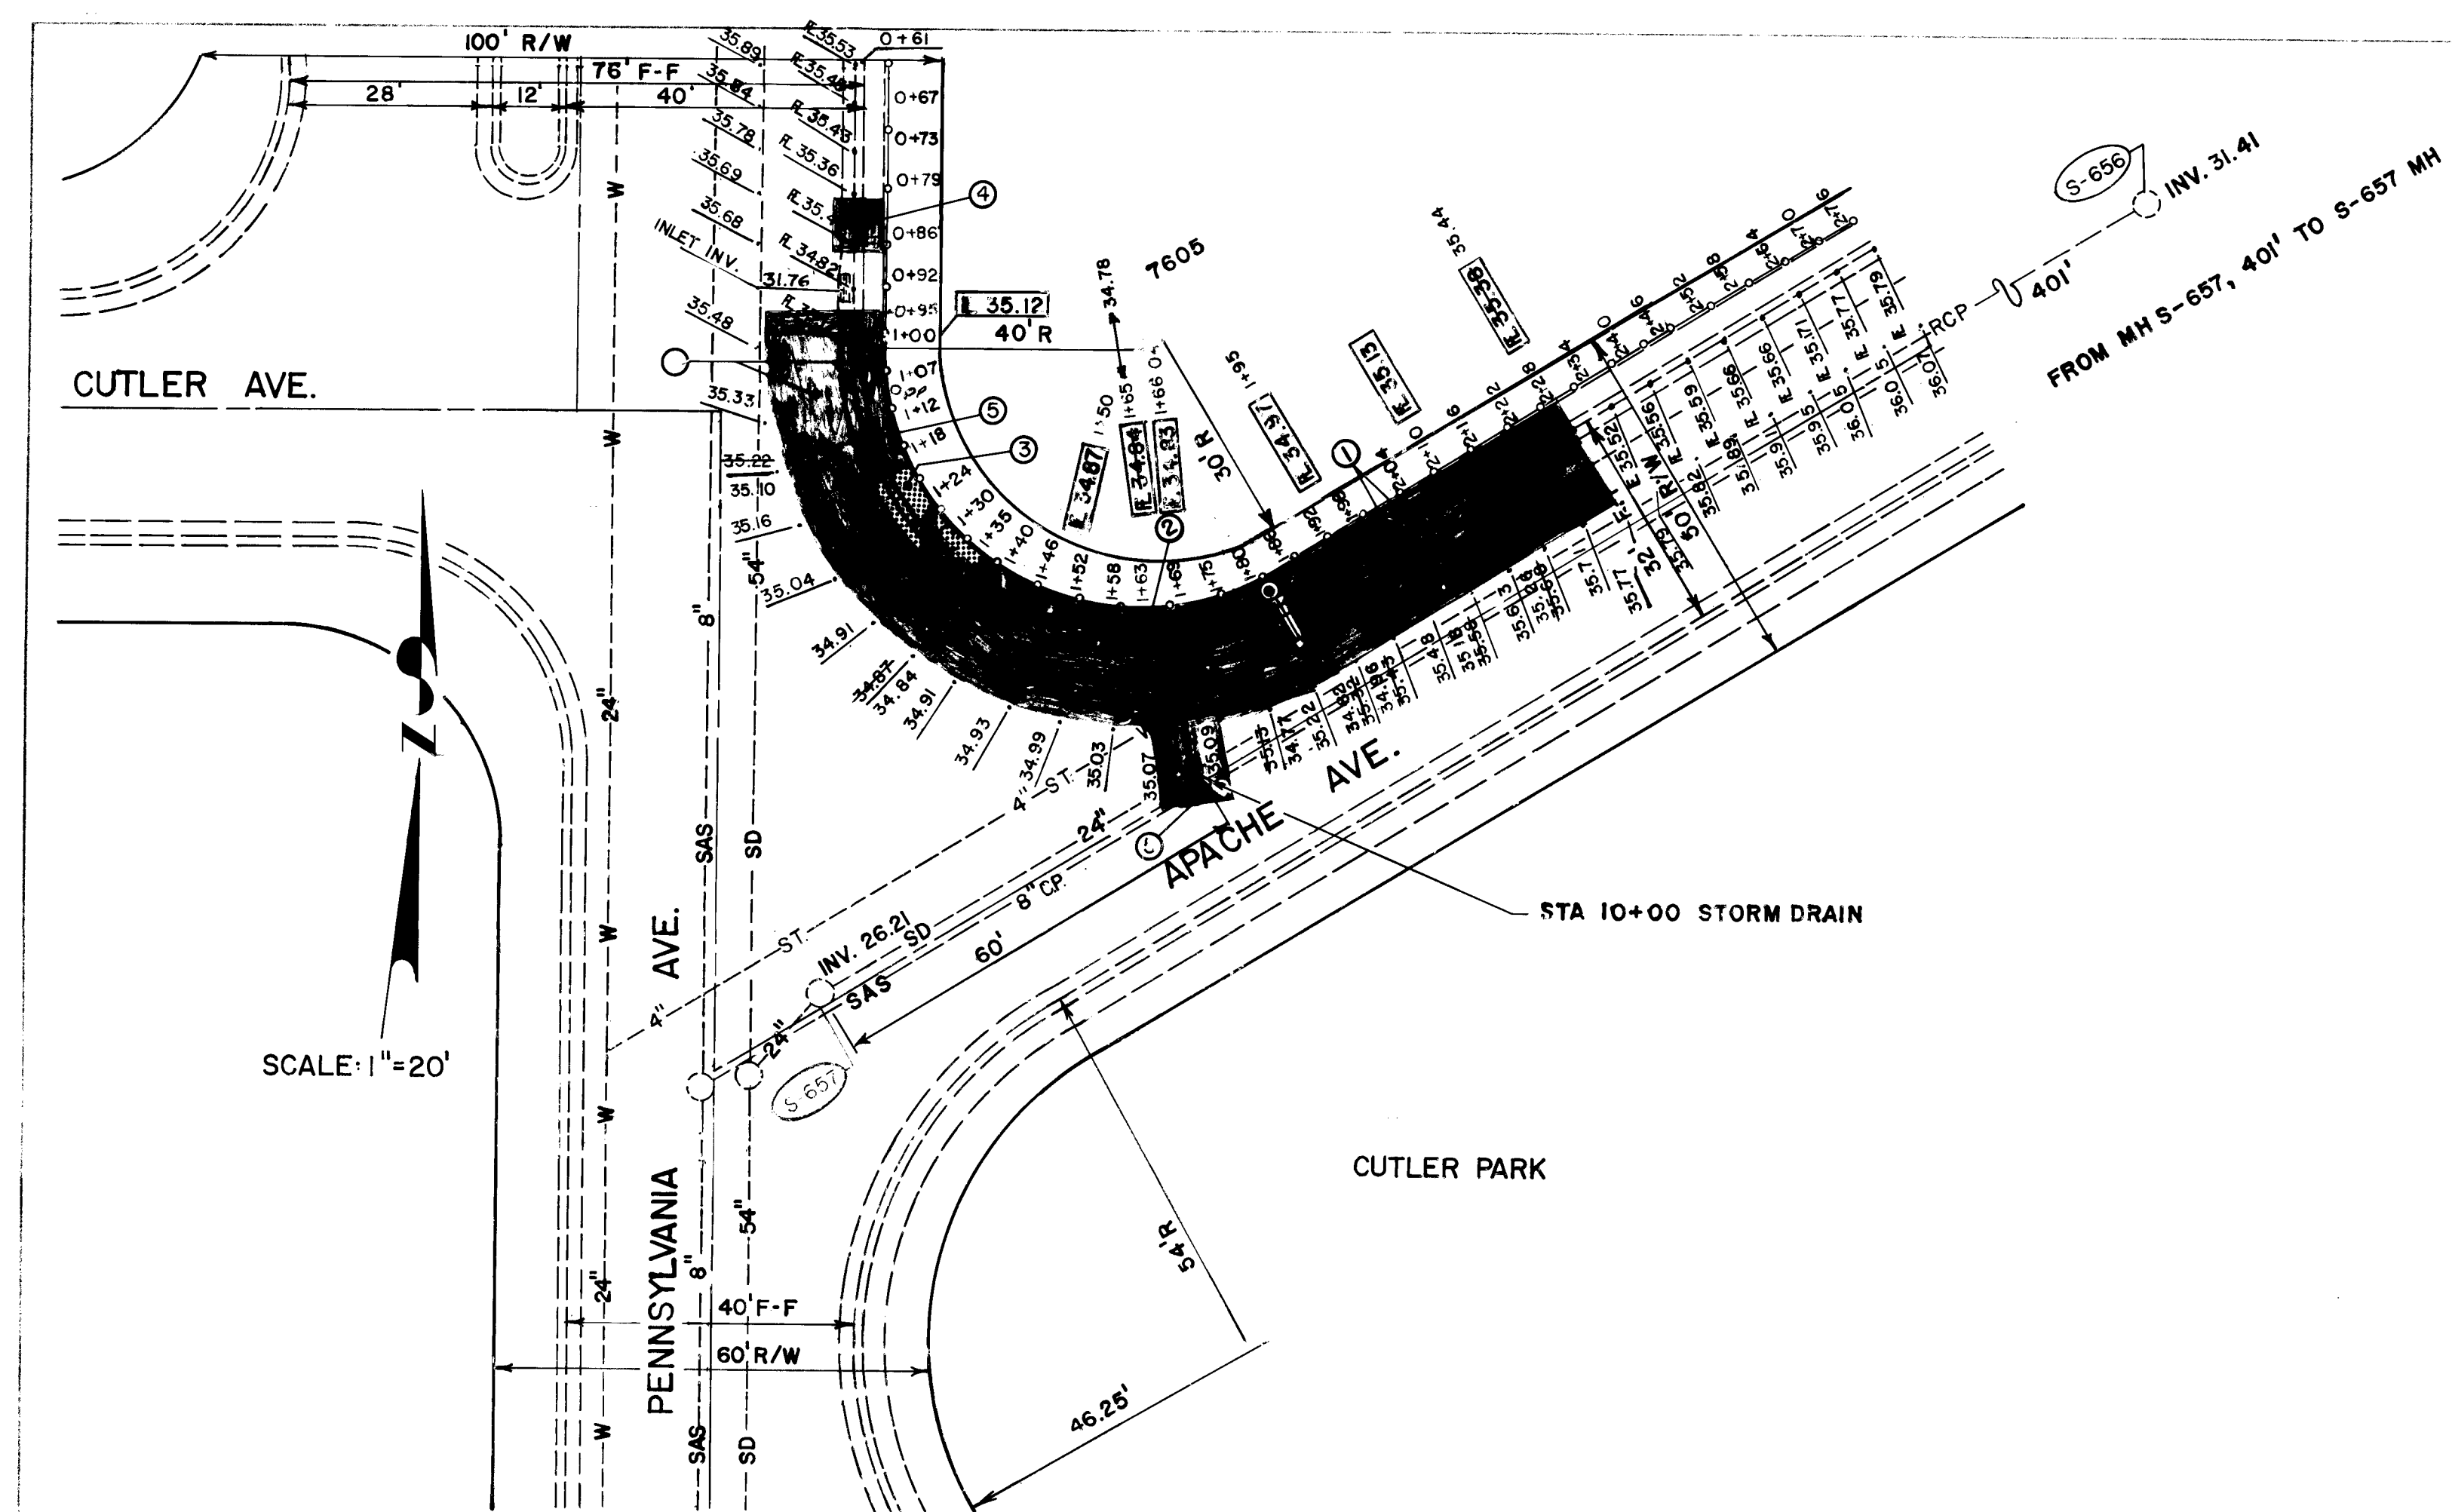

AS BUILT INFORMATION		BENCH MARKS		SURVEY INFORMATION		ENGINEER'S SEAL	
PROJECT SITE	LOCATION MAP	NO.	DATE	NO.	DATE	NO.	DATE
CUTLER PARK	H-19 ZONE ALTAS	PS-31	10-25-82				
APACHE AVE.							
PENNSYLVANIA PL.							
SKYCOURT CIR.							
LEAH DR.							
"NOTICE TO CONTRACTORS" 1) New Mexico Standard Specifications for Public Works Construction - 1979 Edition will be referred to herein as the Standard Specification. 2) All work detailed on these plans to be performed under contract shall, except as otherwise stated or provided, for hereon, be constructed in accordance with Contract Documents for City-Wide Utilities and Cash Paving No. 31 and the Standard Specification. 3) Two working days prior to any excavation, contractor must contact Line Locating Service, 765-1234, for location of existing utilities. 4) Prior to construction, the contractor shall excavate and verify the horizontal and vertical locations of all obstructions. Should a conflict exist, the contractor shall notify the engineer or surveyor so that the conflict can be resolved with minimum amount of delay.		THE FOLLOWING NOTES APPLY WHEN CHECKED ☐ All utilities and utility service lines shall be installed prior to paving. ☐ Backfill compaction shall be according to specified street use. (RESIDENTIAL) ☒ Tack coat requirements shall be determined by the City Engineer. ☒ Sidewalks and wheelchair ramps within the curb returns shall be constructed wherever a new curb return is constructed. ☒ If curb is depressed for a driveway, the driveway shall be constructed prior to acceptance of the curb and gutter. ☒ All storm drainage facilities shall be completed prior to final acceptance.		CONSTRUCTION NOTES ① Remove Curb and Gutter, Sidewalk, and 10-foot Wide Paving from Sta. 0+35 to Sta. 2+28. ② Build Single "C" Catch Basin and Storm Drain @ Sta. 1+66.04. SEE PROFILE for Details. ③ Build Wheelchair Ramp per Details. Center @ Sta. 1+27.5. ④ Remove and Replace Curb and Gutter and Sidewalk 7 Feet North of North Transition or Existing Catch Basin. ⑤ Build Arterial Standard Pavement on All "Pavement Removal and Replacement" Areas.		LEGEND - PAVEMENT, CURB & GUTTER AND SIDEWALK REMOVAL AND REPLACEMENT. - WHEELCHAIR RAMP E-0000 NEW FLOWLINE ELEVATION E-10.00 EXISTING FLOWLINE ELEVATION E-20.00 NEW HEADER CURB ELEVATION	
CITY OF ALBUQUERQUE MUNICIPAL DEVELOPMENT DEPARTMENT ENGINEERING DIVISION TITLE: DRAINAGE IMPROVEMENT AT INTERSECTION OF APACHE AVE. NE, AND PENNSYLVANIA AVE. NE.							
APPROVALS	ENGINEER	DATE	APPROVALS	ENGINEER	DATE		
City Engineer	R. S. Wilson	10/10/83	Liquid Waste	R. S. Wilson	10/10/83		
ACE - Design	Michael	10/20/83	Traffic	R. S. Wilson	10/20/83		
ACE - Hydrology	Michael	11/30/83	Water	R. S. Wilson	11/30/83		
ST. MAINT.	R. S. Wilson	11/30/83					
DRAWING NO.	1557		MAP NO.	H-19		SHEET 1 OF 1	